


PAVEMENT MARKING LAYOUT

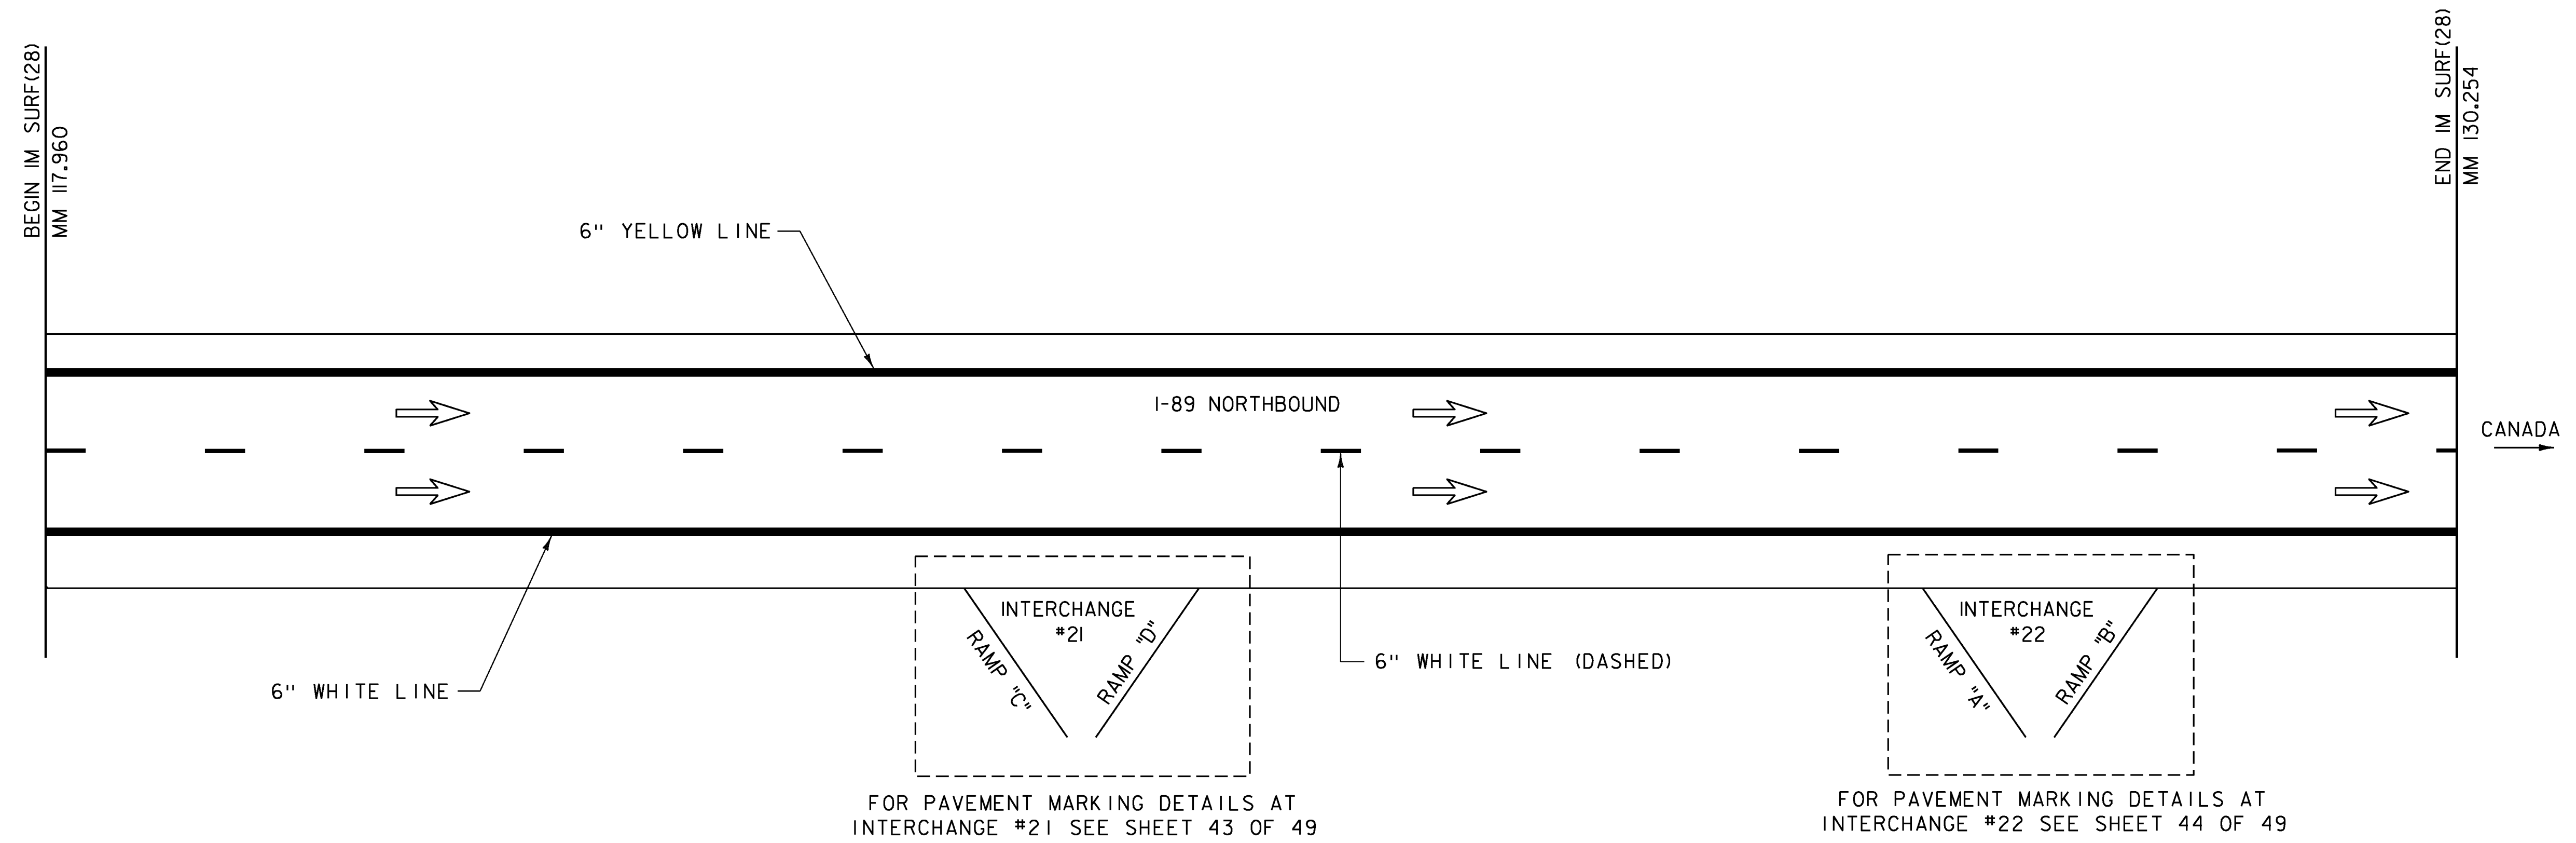

6" WHITE LINE
MM 117.960 - MM 130.254 SOLID RT.
MM 117.960 - MM 130.254 DASHED CENTERLINE

TEMPORARY 6" WHITE LINE
MM 117.960 - MM 130.254 SOLID RT.
MM 117.960 - MM 130.254 DASHED CENTERLINE

6" YELLOW LINE
MM 117.960 - MM 130.254 SOLID LT.

TEMPORARY 6" YELLOW LINE
MM 117.960 - MM 130.254 SOLID LT.

- NOTE:
- TWO (2) APPLICATIONS OF FINAL PAVEMENT MARKINGS WILL BE REQUIRED. SEE SPECIAL PROVISIONS FOR COMPLETION DATE REQUIREMENTS.
 - FOR PAVEMENT MARKING DETAIL AT BORDER, SEE SHEET 45.

LEGEND

= DIRECTION OF TRAFFIC FLOW

NOT TO SCALE

PAVEMENT MARKING LAYOUT

PROJECT NAME: SWANTON-HIGHGATE	
PROJECT NUMBER: IM SURF (28)	
FILE NAME: Ila024/Ila024.dgn	PLOT DATE: 12-APR-2012
PROJECT LEADER: M. FOWLER	DRAWN BY: L. BULLOCK
DESIGNED BY: L. BULLOCK	CHECKED BY: M. FOWLER
Ila024pml.t	SHEET 42 OF 49