

STATE OF VERMONT
AGENCY OF TRANSPORTATION

2 TITLE SHEET
3 COMMON NOTES TO BOTH ALTERNATES
4 ALTERNATE A TYPICAL SHEET
5 ALTERNATE B TYPICAL SHEET
6 BRIDGE DETAIL SHEET # 1
7 BRIDGE DETAIL SHEET # 2
8 QUANTITY SHEET
9 PAVEMENT MARKING DETAIL SHEET
10 MAINLINE PAVEMENT MARKING SHEET
11 EXIT 14 PAVEMENT MARKING SHEET
12 EXIT 15 PAVEMENT MARKING SHEET
13 EXIT 16 PAVEMENT MARKING SHEET
14 ROUGHNESS DATA INFORMATION
15 RUTTING DATA INFORMATION
16 CONSTRUCTION APPROACH SIGNING EXIT 14
17 CONSTRUCTION APPROACH SIGNING EXIT 15
18 CONSTRUCTION APPROACH SIGNING EXIT 16
19 CONSTRUCTION APPROACH MAINLINE SIGNING SHEET
20 TRAFFIC CONTROL NOTE SHEET



PROPOSED IMPROVEMENT
TOWNS OF NORWICH, THETFORD, FAIRLEE AND BRADFORD
COUNTIES OF WINDSOR AND ORANGE
INTERSTATE 91 SOUTHBOUND

LENGTH OF ROADWAY = 116,091.36 FT = (21.987 MILES) (SOUTHBOUND LANE)
 LENGTH OF PROJECT = 116,091.36 FT = (21.987 MILES) (SOUTHBOUND LANE)

WORK TO BE PERFORMED UNDER THIS PROJECT INCLUDES SURFACE PREPARATION INVOLVING PATCHING, POT HOLE REPAIR, AND CRACK-SEALING; OVERLAYING WITH A THIN BITUMINOUS CONCRETE WEARING COURSE ON THE EXISTING INTERSTATE TYPICAL AND APPLICABLE PAVEMENT MARKINGS.

F-100	01/02/2004
F-100A	01/02/2004
F-101	05/30/2003
F-102	06/30/2003
F-102A	05/01/2004
F-103	03/01/2004
F-105	05/01/2004
F-106	05/01/2004
F-107A	06/08/2005
F-108	06/08/2005
F-108A	06/08/2005
F-110	08/08/1995
F-120	08/08/1995
F-121	08/08/1995
F-150	05/01/2004
F-164	06/08/2009
F-191	02/01/1999
F-193	08/18/1995

RECORD PLANS	FORMAN GROUP, LLC - ALBANY, NY
CONTRACTOR:	PAUL PERRY
CONTRACT ENGINEER:	APRIL 16, 2012
CONSTRUCTION BEGAN:	SEPTEMBER 20, 2012
CONSTRUCTION COMPLETE:	PAUL PERRY & J. HYDE
RECORD PLANS BY:	
I HEREBY CERTIFY THAT ALL THE CONSTRUCTION REQUIRED BY THIS SET OF DRAWINGS HAS BEEN ACCOMPLISHED AS INDICATED HEREIN.	
BY	<i>Paul K. Perry</i> RESIDENT ENGINEER
DATE	<i>04/02/13</i>
NOTE: Any further information concerning final quantities, amounts or other details relative to this project may be found at Central Files in the electronic archives.	

MM 76.443
BEGIN PROJECT IM SURF (3)


I-9I - SOUTHBOUND	2012 AADT	2022 AADT	2012 DHV	2022 DHV	FLEXIBLE ESALS (2012 - 2022)	FLEXIBLE ESALS (2012 - 2032)
BEGIN PROJECT TO EXIT 14	6,200	6,900	880	980	3,530,000	8,425,000
EXIT 14 TO EXIT 15	4,900	5,600	660	750	1,958,000	4,804,000
EXIT 15 TO EXIT 16	4,000	4,600	560	640	2,658,000	6,452,000
EXIT 16 TO END PROJECT	4,000	3,200	390	440	2,839,000	6,795,000

CONVENTIONAL SYMBOLS

COUNTY LINE
TOWN LINE
LIMITS OF ACCESS
POINT OF ACCESS
FENCE LINE
STONE WALL
TRAVELED WAY
GUARD RAIL
RAILROAD
SURVEY LINE
CULVERT
POWER POLE
TELEPHONE POLE
TREES
CONTROL OF ACCESS
PROPERTY LINE
R.O.W. TAKING LINE
SLOPE RIGHTS
TOP OF CUT
TOE OF SLOPE

SURVEYED BY :
SURVEYED DATE :

DATUM
VERTICAL
HORIZONTAL

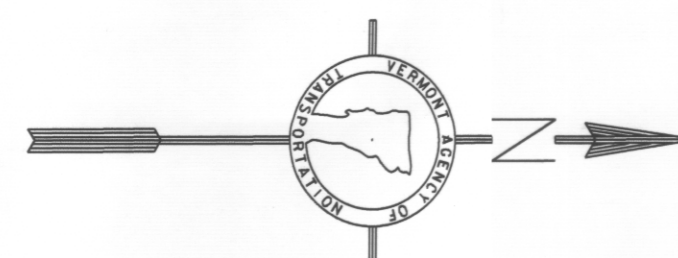

MM 98.43
END PROJECT IM SURF (31)

THESE PLANS ARE SUBJECT TO SUCH ENGINEERING CHANGES AS MAY BE REQUIRED BY THE FEDERAL HIGHWAY ADMINISTRATION OR THE DIRECTOR OF PROGRAM DEVELOPMENT.

CONSTRUCTION IS TO BE CARRIED ON IN ACCORDANCE WITH THESE PLANS AND THE STANDARD SPECIFICATIONS FOR CONSTRUCTION DATED 2011, AS APPROVED BY THE FEDERAL HIGHWAY ADMINISTRATION ON JULY 20, 2011 FOR USE ON THIS PROJECT, INCLUDING ALL SUBSEQUENT REVISIONS AND SUCH REVISED SPECIFICATIONS AND SPECIAL PROVISIONS AS ARE INCORPORATED IN THESE PLANS.

DIRECTOR OF PROGRAM DEVELOPMENT

APPROVED Richard J. Petrucci DATE 2/2/12

PROJECT MANAGER : MIKE FOWLER

PROJECT NAME : NORWICH - BRADFORD
PROJECT NUMBER : 1M SURF (31)

SHEET 1 OF 19 SHEETS