


BRIDGE 56S

MM 91.539

LENGTH OF ASPHALTIC PLUG JOINTS:

TOTAL = 0' 80.2

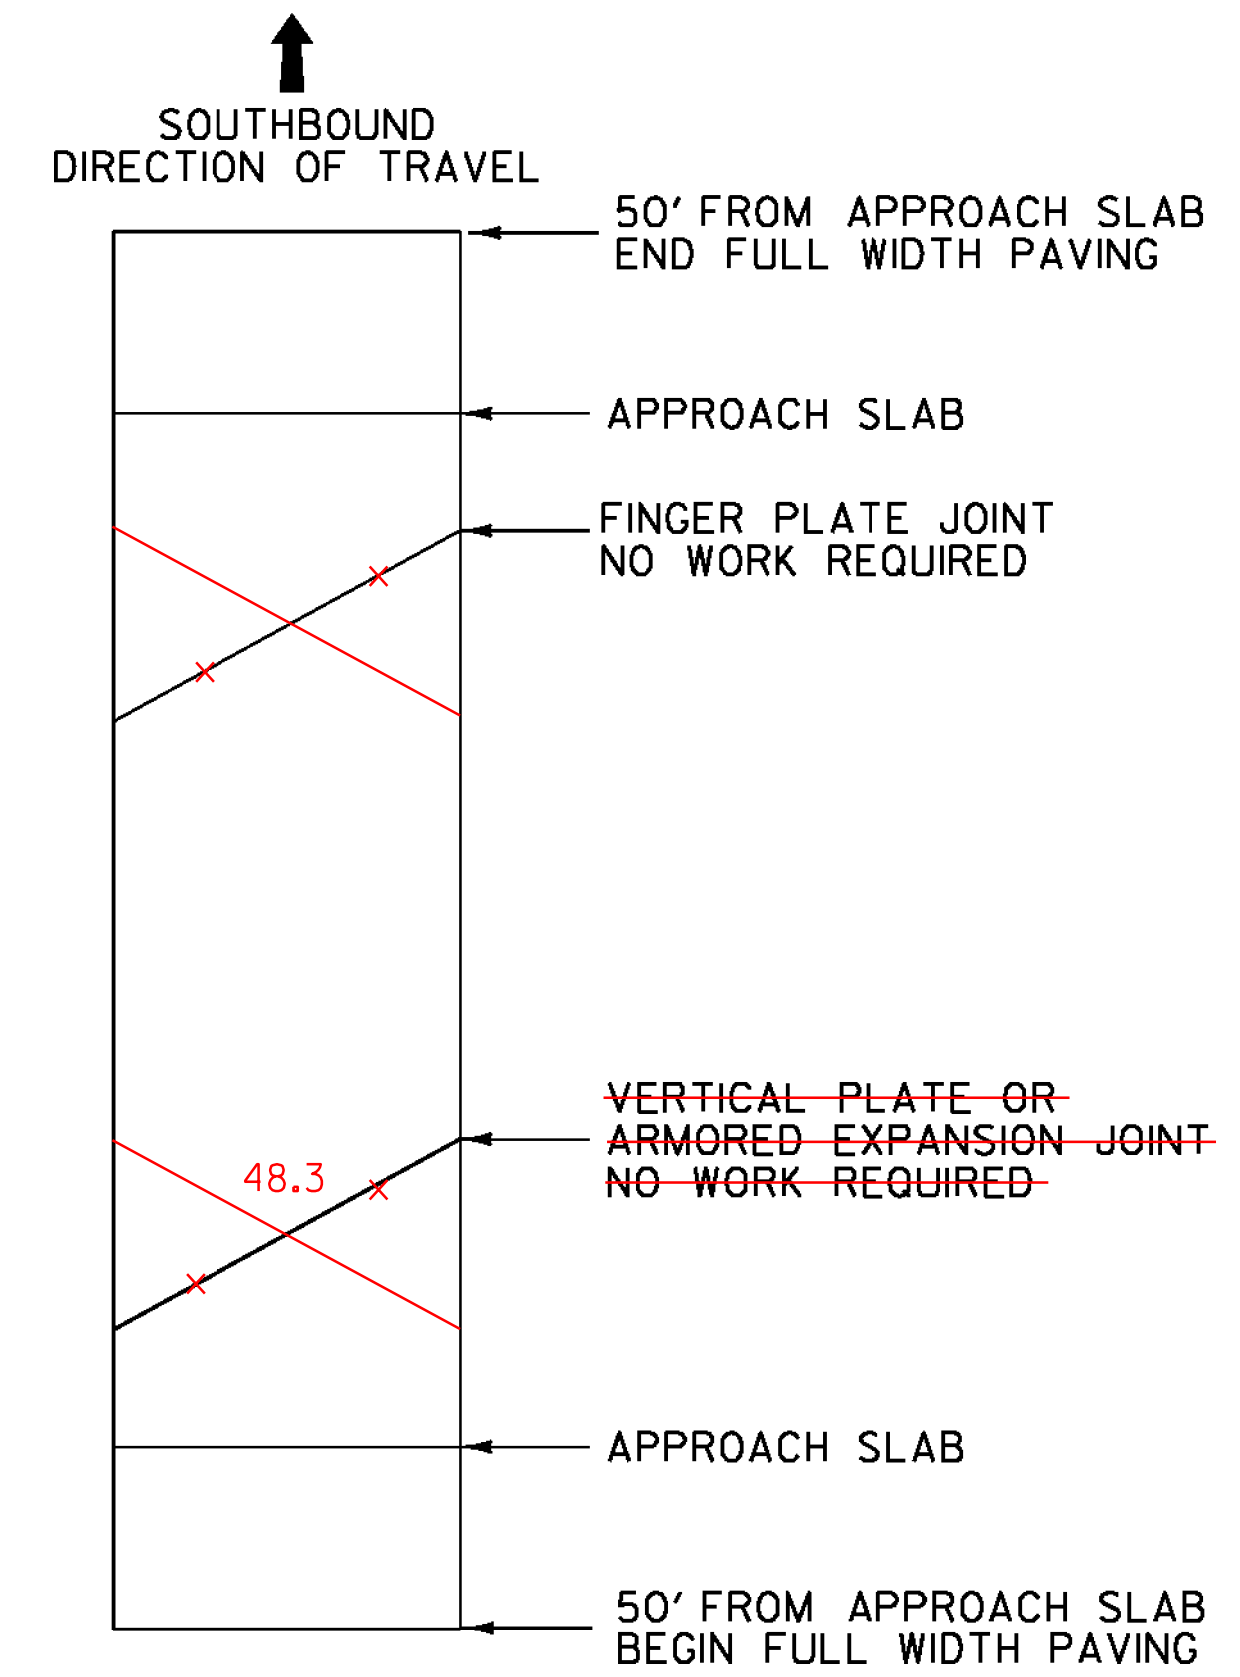

BRIDGE 58S

MM 97.243

LENGTH OF ASPHALTIC PLUG JOINTS:

TOTAL = 0' 48.3

NOT TO SCALE

**BRIDGE
DETAIL SHEET
2**

PROJECT NAME: NORWICH - BRADFORD
PROJECT NUMBER: IM SURF (31)

FILE NAME: /pave/lla030/plla030.dgn	PLOT DATE: 06-FEB-2012
PROJECT LEADER: MIKE FOWLER	DRAWN BY: WILDER
DESIGNED BY: WILDER	CHECKED BY: PVMT MGMT
IPARM FILE NAME: plla030_06.i	SHEET 6 OF 19