
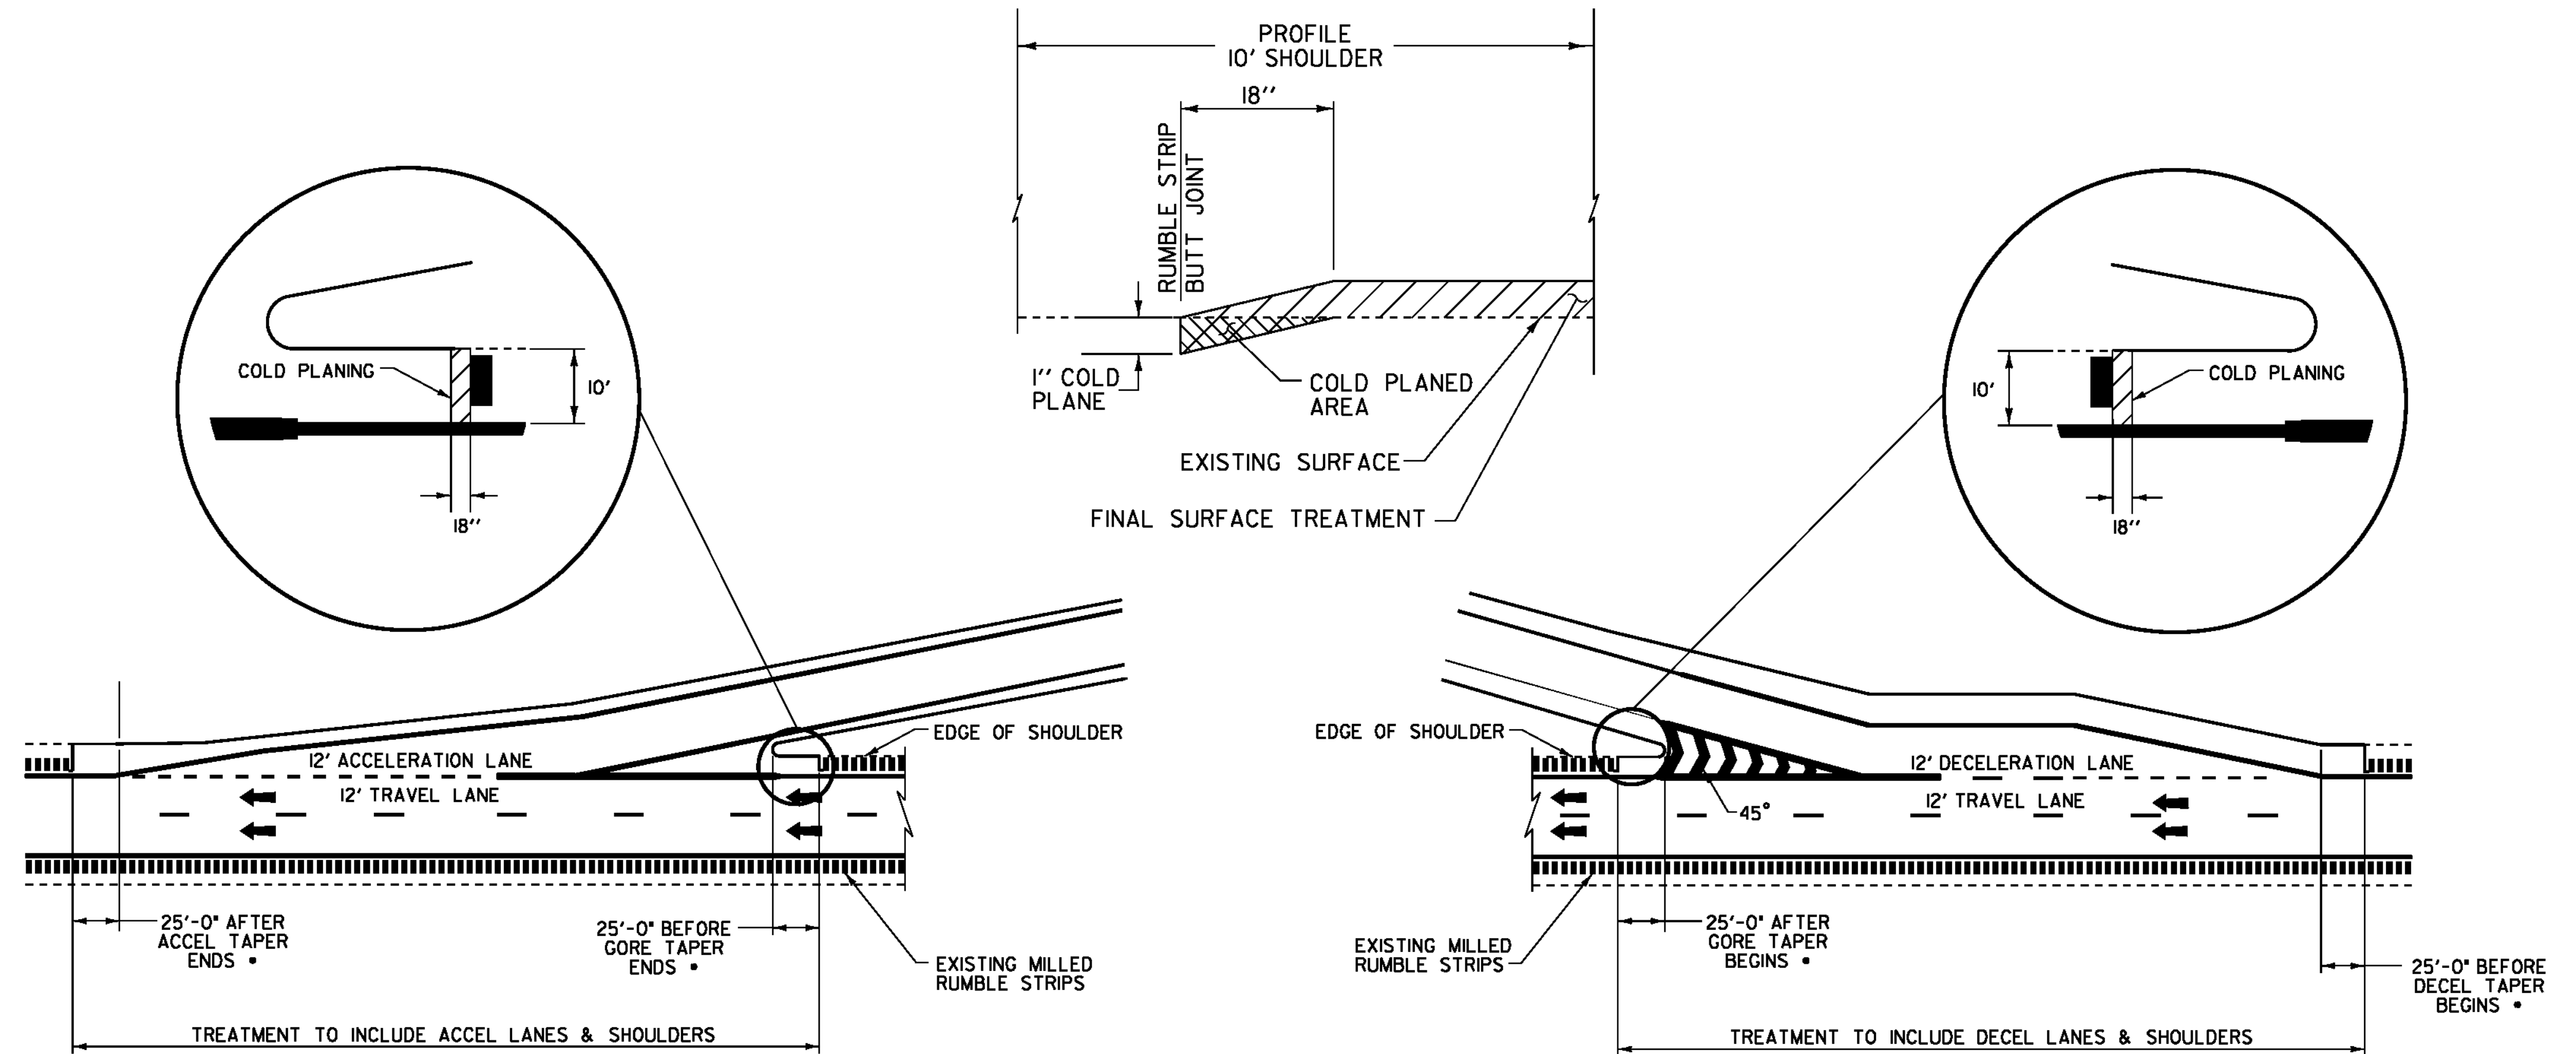
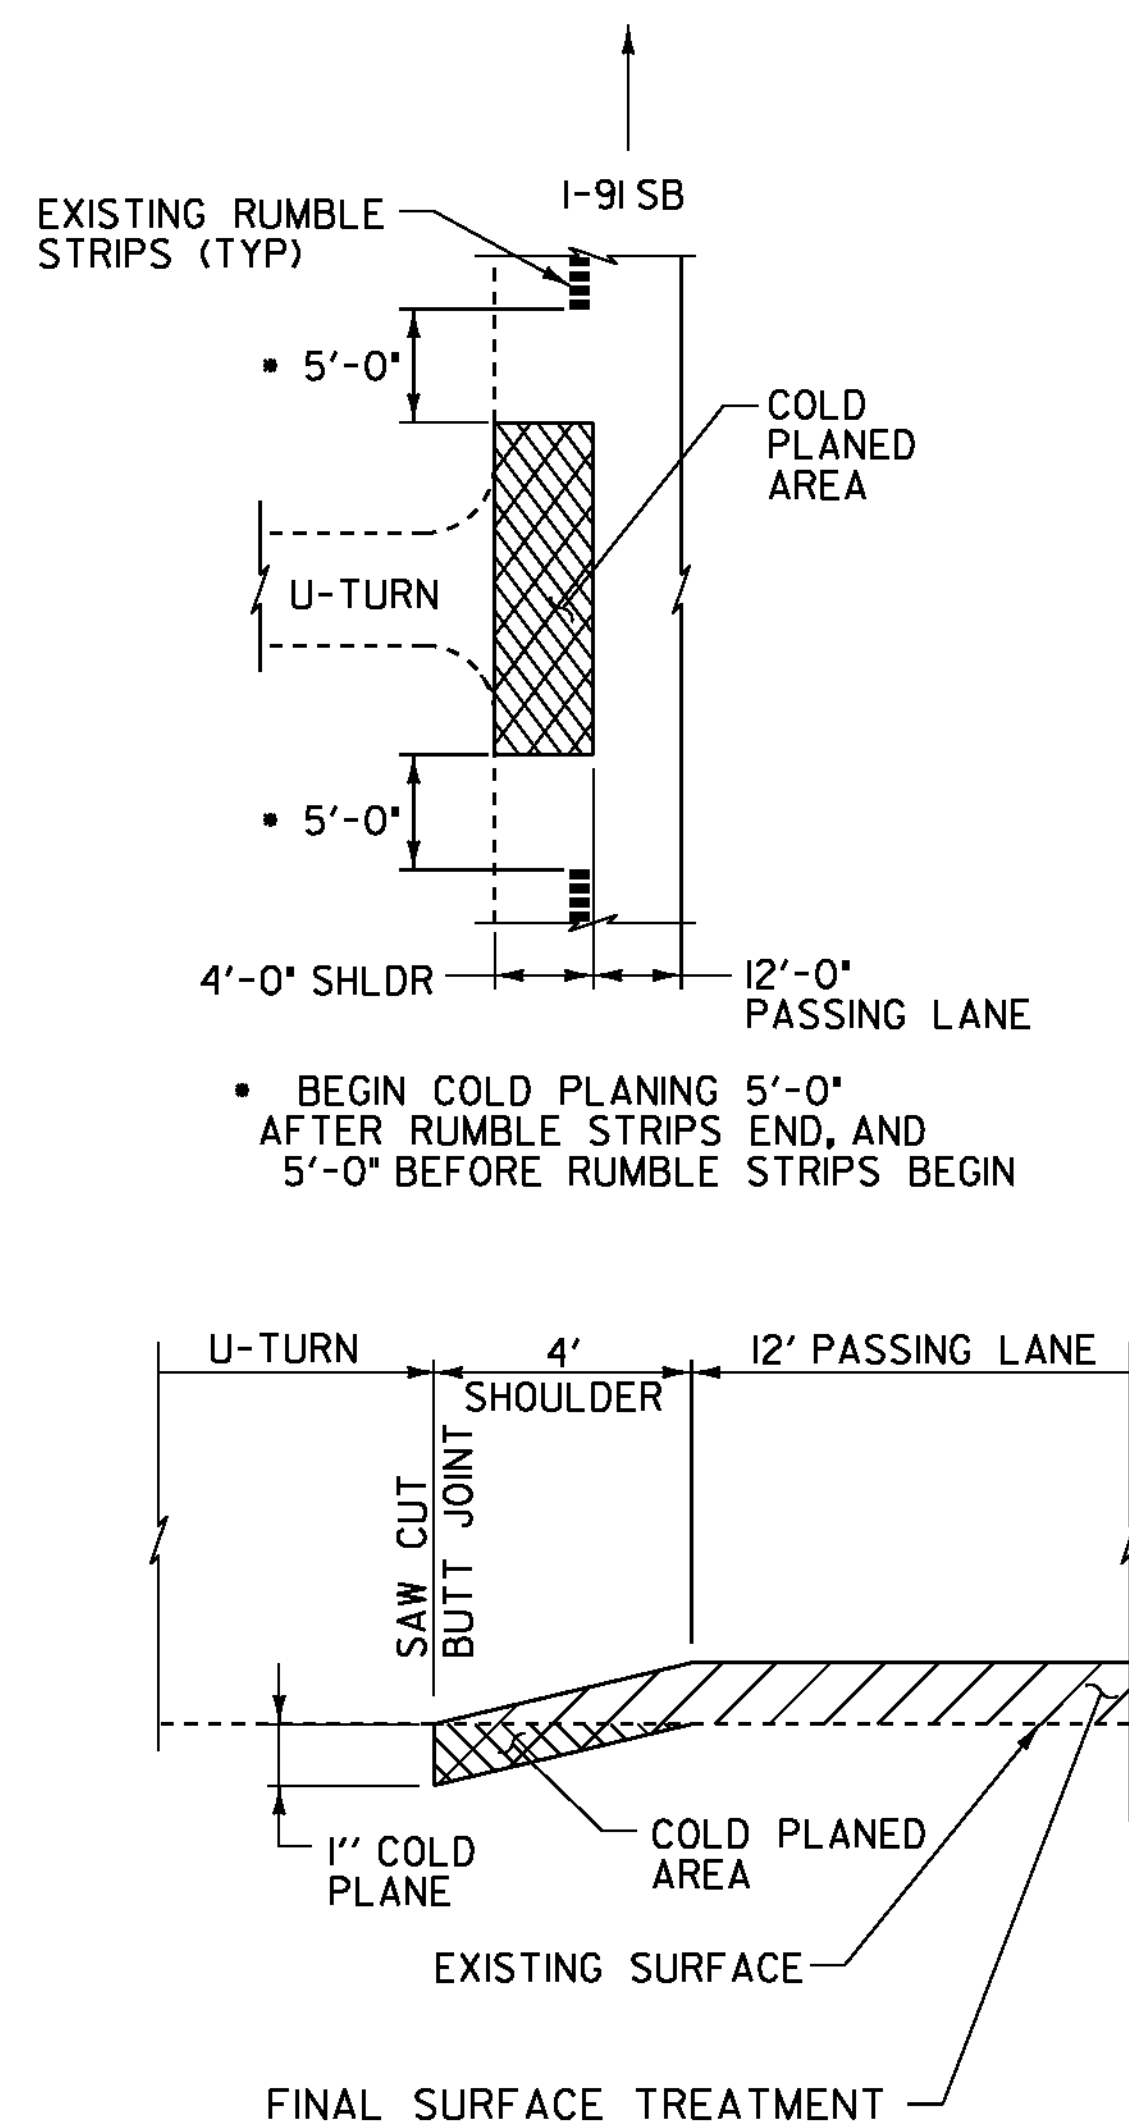


**INTERSTATE ROUTE 91 SB
(MM 76.443)
BEGIN PROJECT
IM SURF (31)**

6" WHITE LINE
M. M. 76.443 - M. M. 98.43 SB (SOLID RT)
M. M. 76.443 - M. M. 98.43 SB (DASH)
6" YELLOW LINE
M. M. 76.443 - M. M. 98.43 SB (SOLID LT)
TEMPORARY 6" WHITE LINE, PAINT
M. M. 76.443 - M. M. 98.43 SB (SOLID RT)
M. M. 76.443 - M. M. 98.43 SB (DASH)
TEMPORARY 6" YELLOW LINE, PAINT
M. M. 76.443 - M. M. 98.43 SB (SOLID LT)

**INTERSTATE ROUTE 91 SB
(MM 98.430)
END PROJECT
IM SURF (31)**

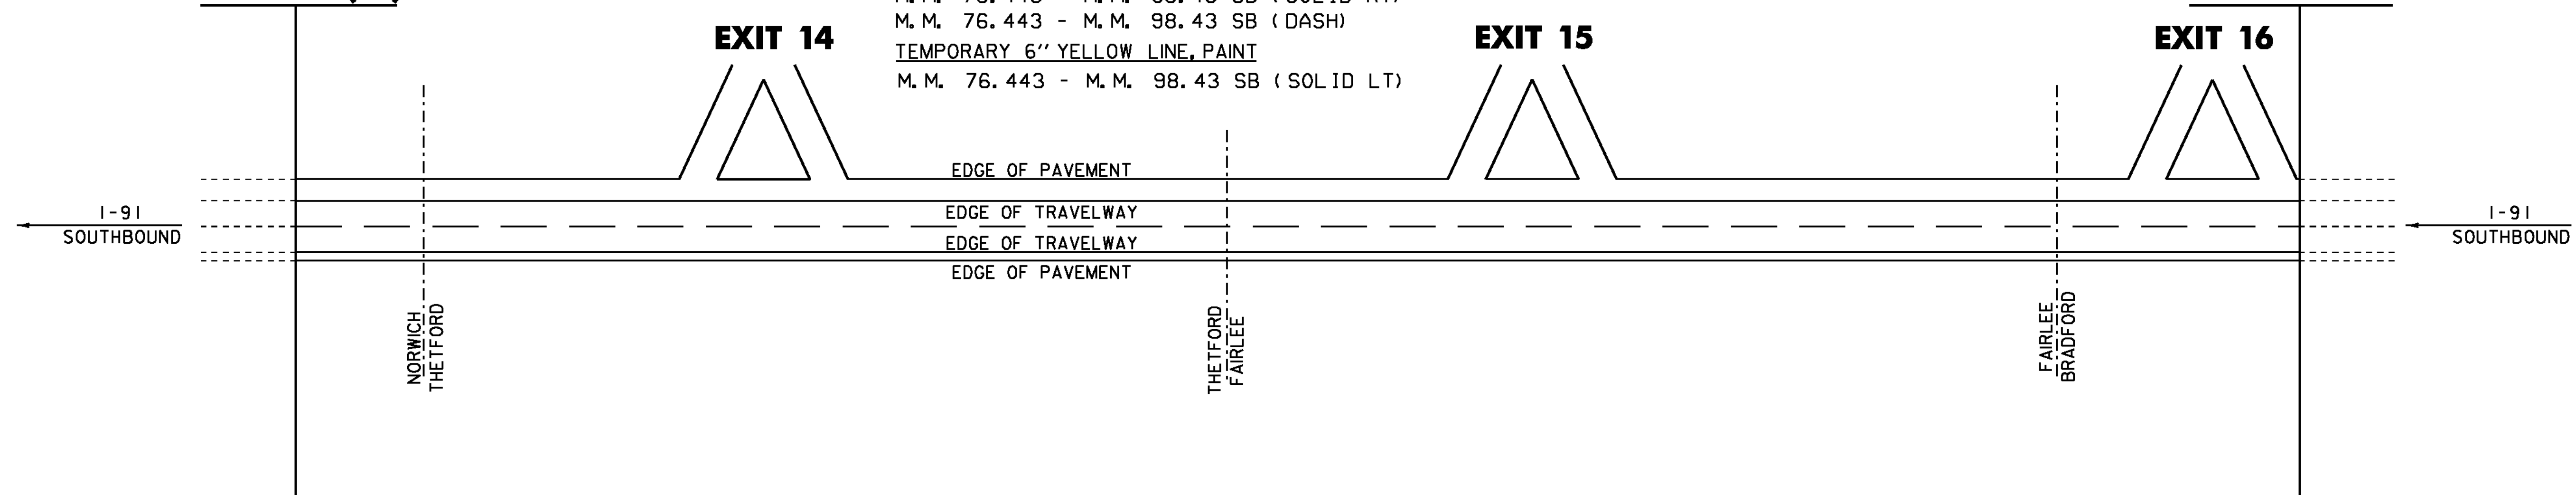

RAMP CONSTRUCTION DETAILS

• TO BE USED AS DIRECTED BY THE ENGINEER

**MAINLINE
PAVEMENT MARKING
SHEET**

PROJECT NAME: NORWICH - BRADFORD
PROJECT NUMBER: IM SURF (31)

FILE NAME: /pave/lla030/plla030.dgn
PROJECT MANAGER: MIKE FOWLER
DESIGNED BY: WILDER
IPARM FILE NAME: plla030_09.i

PLOT DATE: 06-FEB-2012
DRAWN BY: WILDER
CHECKED BY: PVMT MGMT
SHEET 9 OF 19

NOT TO SCALE

COLD PLANE DETAIL AT U-TURNS