


**BEGIN /END PROJECT  
CONSTRUCTION APPROACH SIGNING  
I-91 SOUTHBOUND**

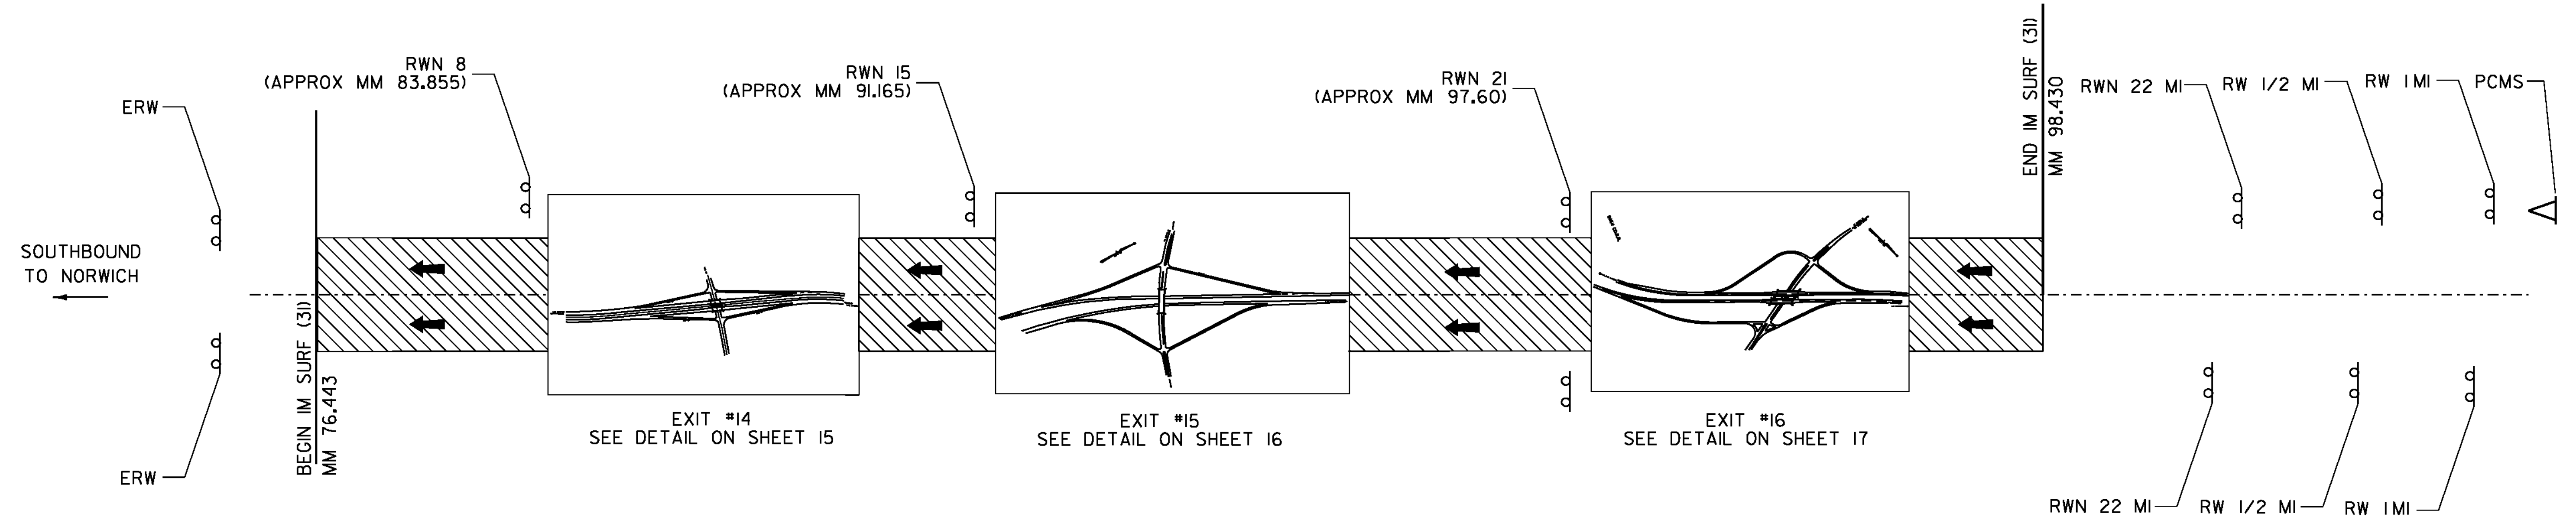

- LEGEND**
- RWN XX MILES = ROAD WORK NEXT XX MILES
  - ERW = END ROAD WORK
  - RW 1MI = ROAD WORK IN 1 MILE
  - RW 1/2 MI = ROAD WORK IN 1/2 MILE
  - △ = PORTABLE CHANGEABLE MESSAGE SIGN
  - ← = DIRECTION OF TRAFFIC FLOW
  - [Hatched Box] = WORK AREA

LIST OF CONSTRUCTION SIGNS - MAINLINE SB

LOCATION	RW 1MI	RW 1/2 MI	RWN 22 MILES	RWN 21 MILES	RWN 15 MILES	RWN 8 MILES	ERW	PCMS
I-91 SOUTHBOUND	2	2	2	1	1	1	2	1
TOTALS	2	2	2	1	1	1	2	1

**NOT TO SCALE**

<b>CONSTRUCTION APPROACH MAINLINE SIGNING SHEET</b>	PROJECT NAME: NORWICH - BRADFORD
	PROJECT NUMBER: 1M SURF (3I)
	FILE NAME: /pave/11a030/plla030.dgn
	PLOT DATE: 07-FEB-2012
PROJECT LEADER: MIKE FOWLER	DRAWN BY: WILDER
DESIGNED BY: WILDER	CHECKED BY: PVMT MGMT
IPARM FILE NAME: plla030_18.1	SHEET 18 OF 19