



**MAINLINE**

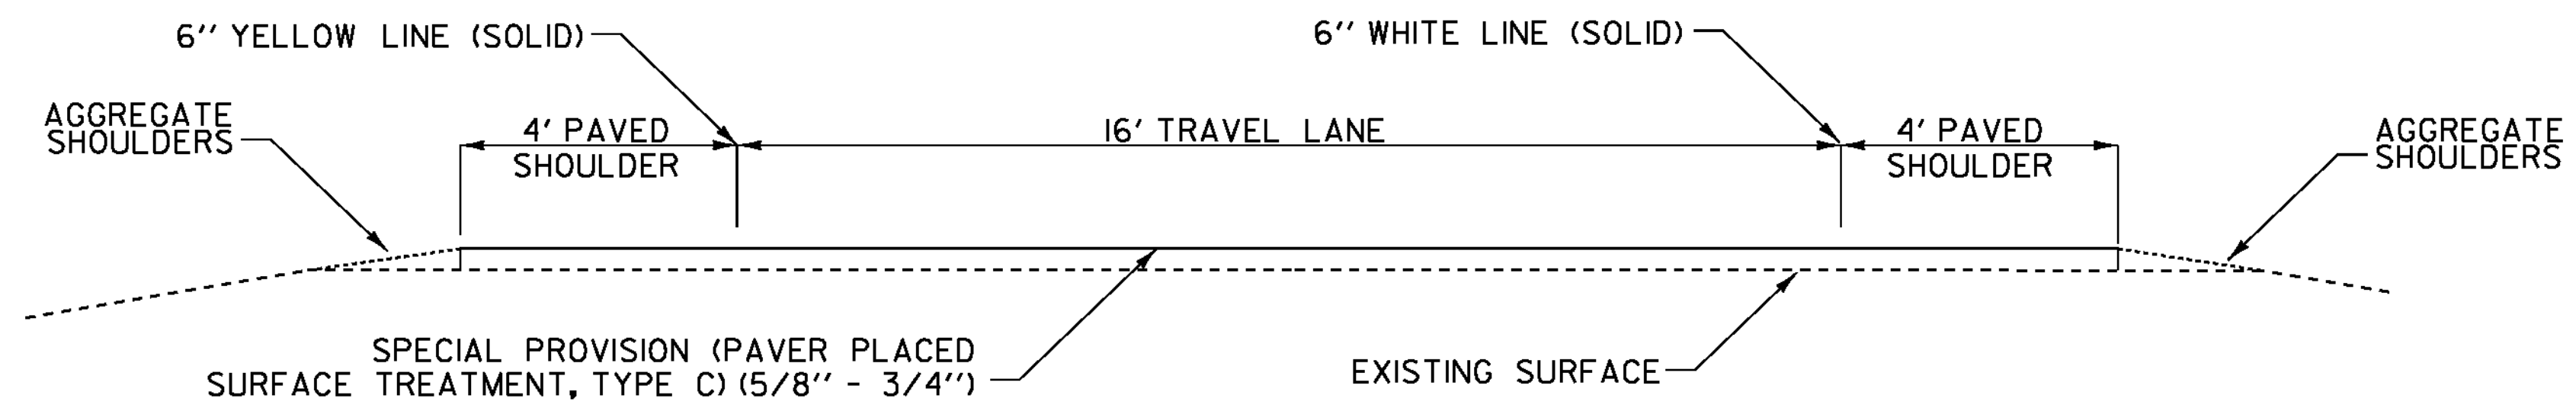


**TYPICAL RAMP SECTION  
ALTERNATE A**

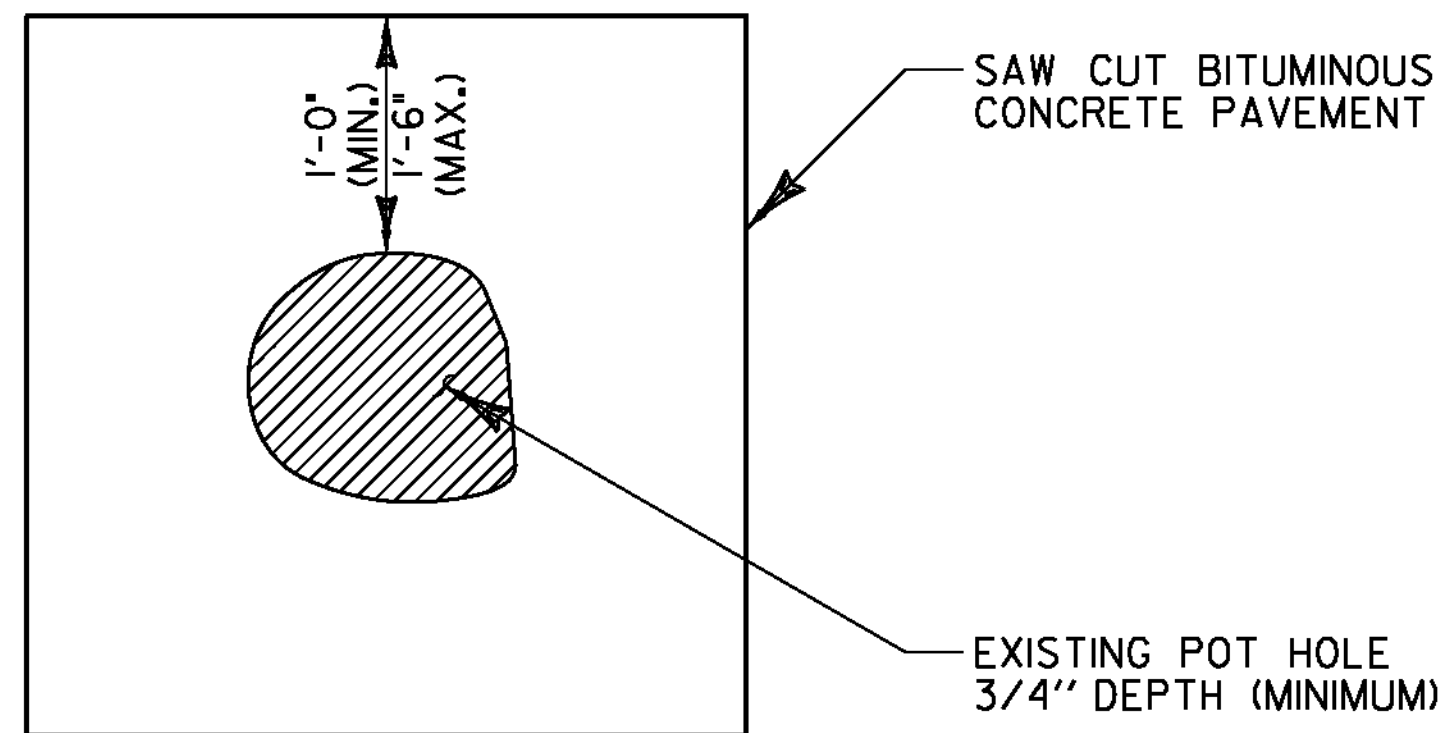

EMULSIFIED ASPHALT SHALL BE APPLIED AT ALL PATCH INTERFACES AT A RATE OF 0.25 - 0.5 GAL/SY, EMULSIFIED ASPHALT SHALL MEET THE REQUIREMENTS OF SECTION 404 AND WILL BE CONSIDERED INCIDENTAL TO THE PATCHING MATERIAL.

**TYPICAL - POT HOLE REPAIR**

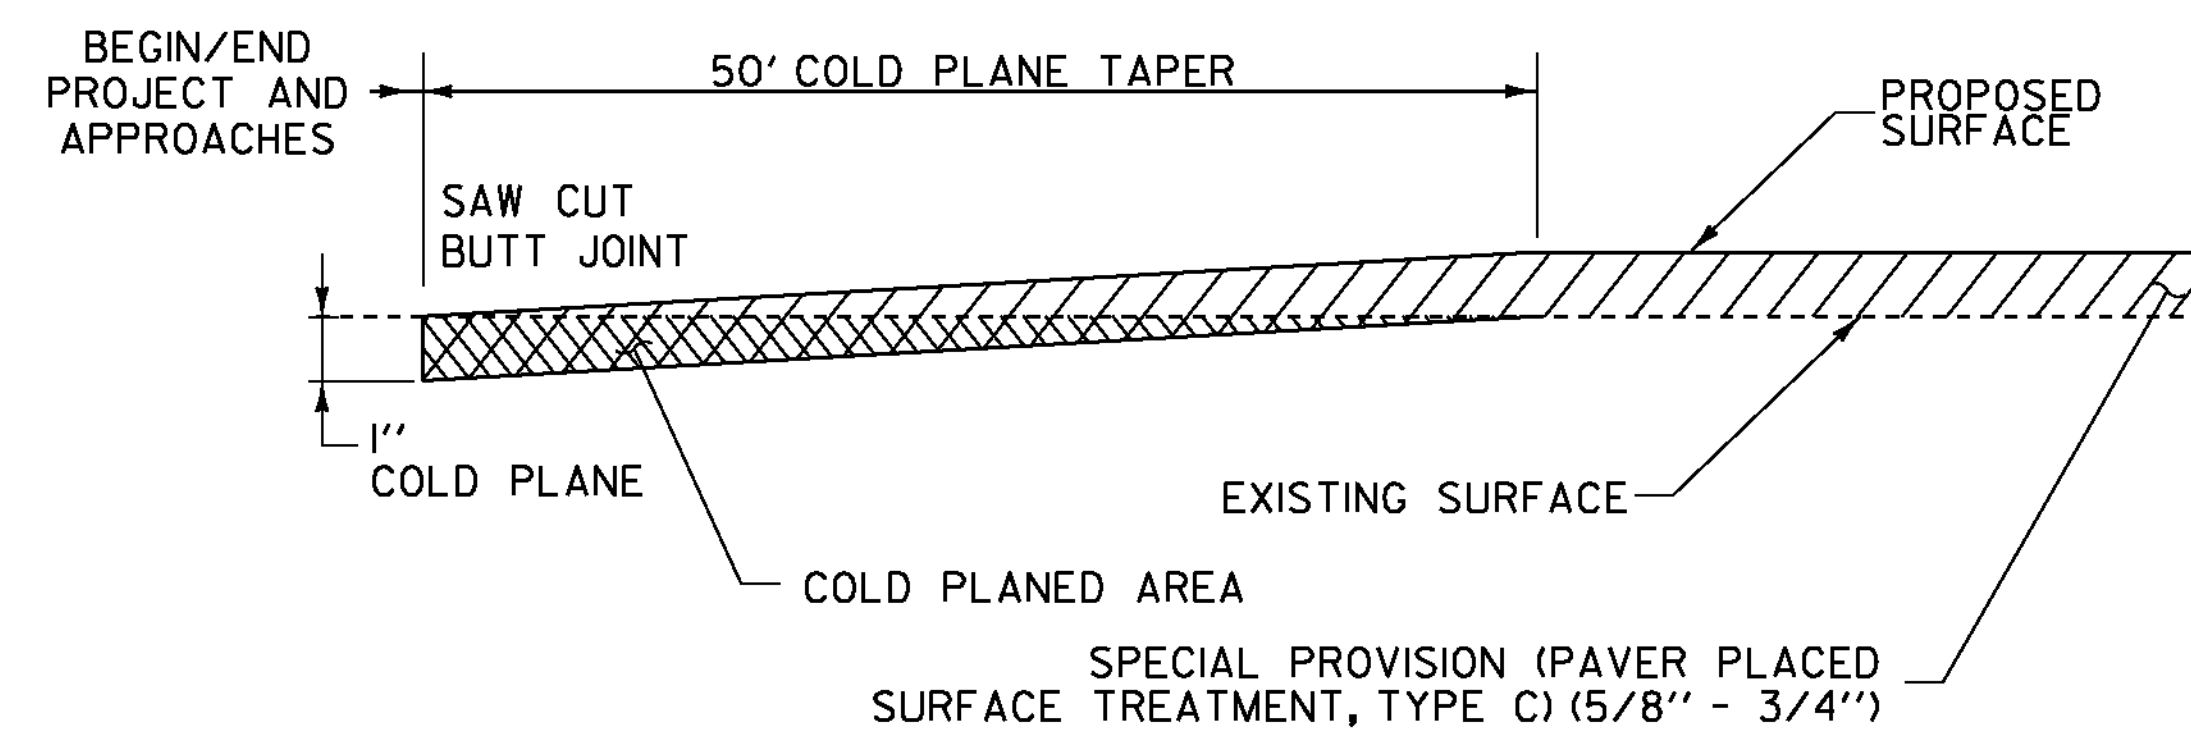

**TYPICAL APPROACH AREA DETAIL MAINLINE & RAMPS**

NOT TO SCALE

**ALTERNATE A  
TYPICAL  
SHEET**

PROJECT NAME: NORWICH - BRADFORD  
PROJECT NUMBER: IM SURF (3I)

FILE NAME: /pave/lla030/plla030.dgn PLOT DATE: 07-FEB-2012  
PROJECT LEADER: MIKE FOWLER DRAWN BY: WILDER  
DESIGNED BY: WILDER CHECKED BY: PVMT MGMT  
IPARM FILE NAME: plla030\_03.1 SHEET 3 OF 19