



BRIDGE COLD PLANE DETAIL

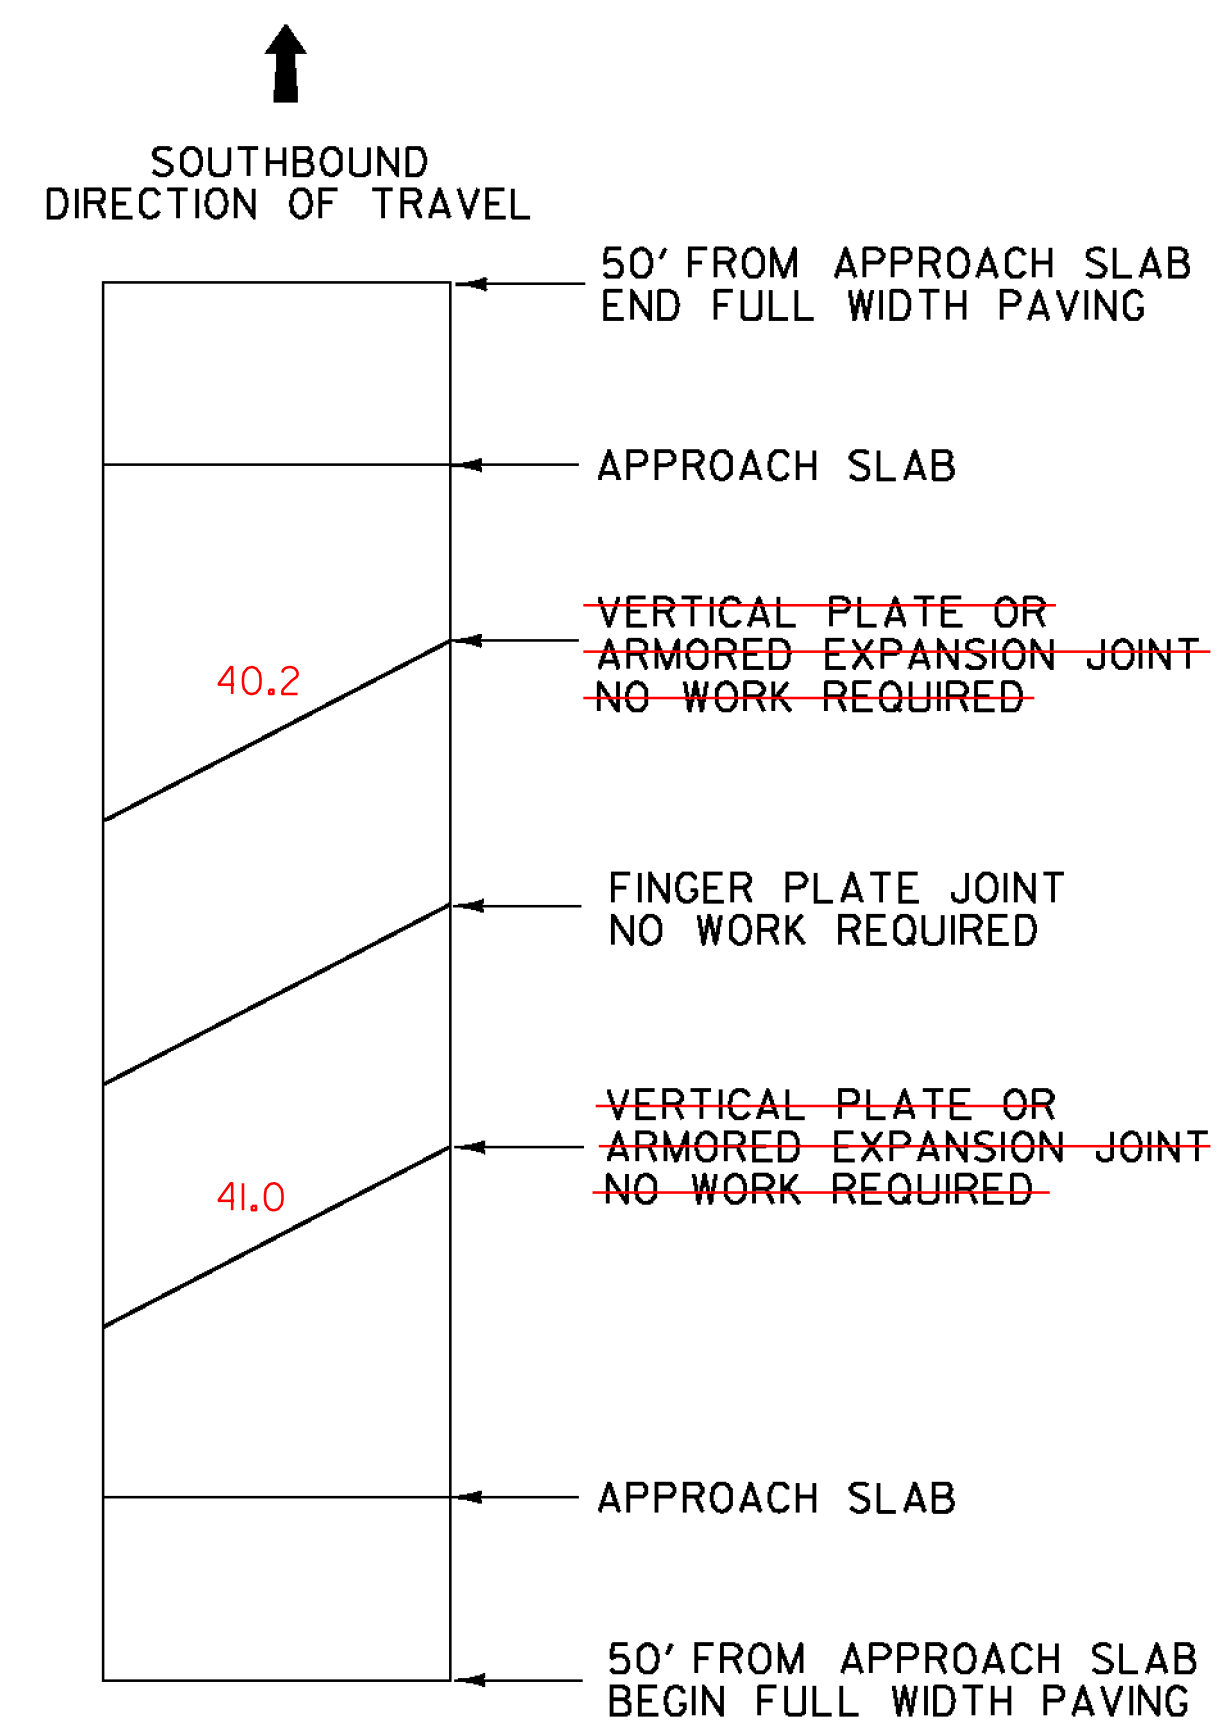


BRIDGE 51S
MM 80.217

LENGTH OF ASPHALTIC PLUG JOINTS:
TOTAL - ~~0'~~ 81.2

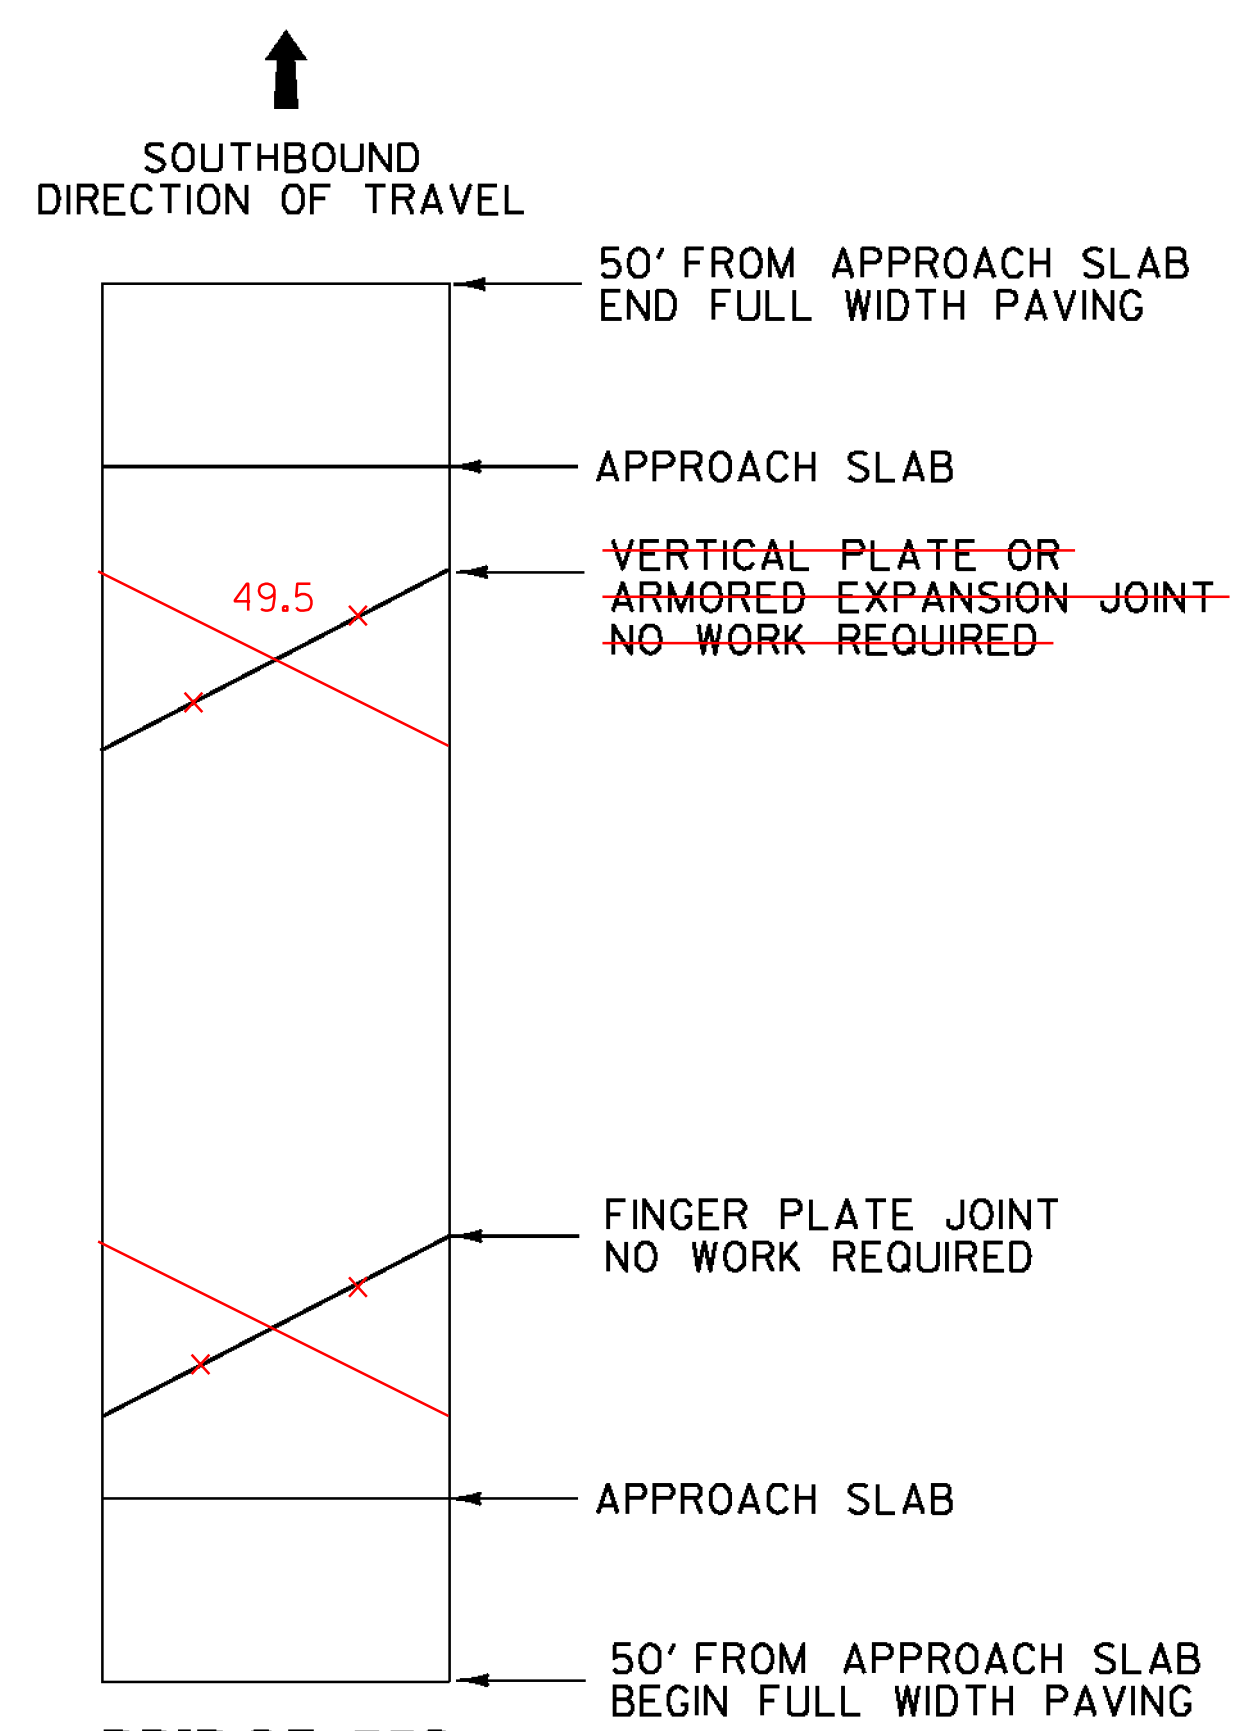

BRIDGE 55S
MM 89.266

LENGTH OF ASPHALTIC PLUG JOINTS:
TOTAL = 0'

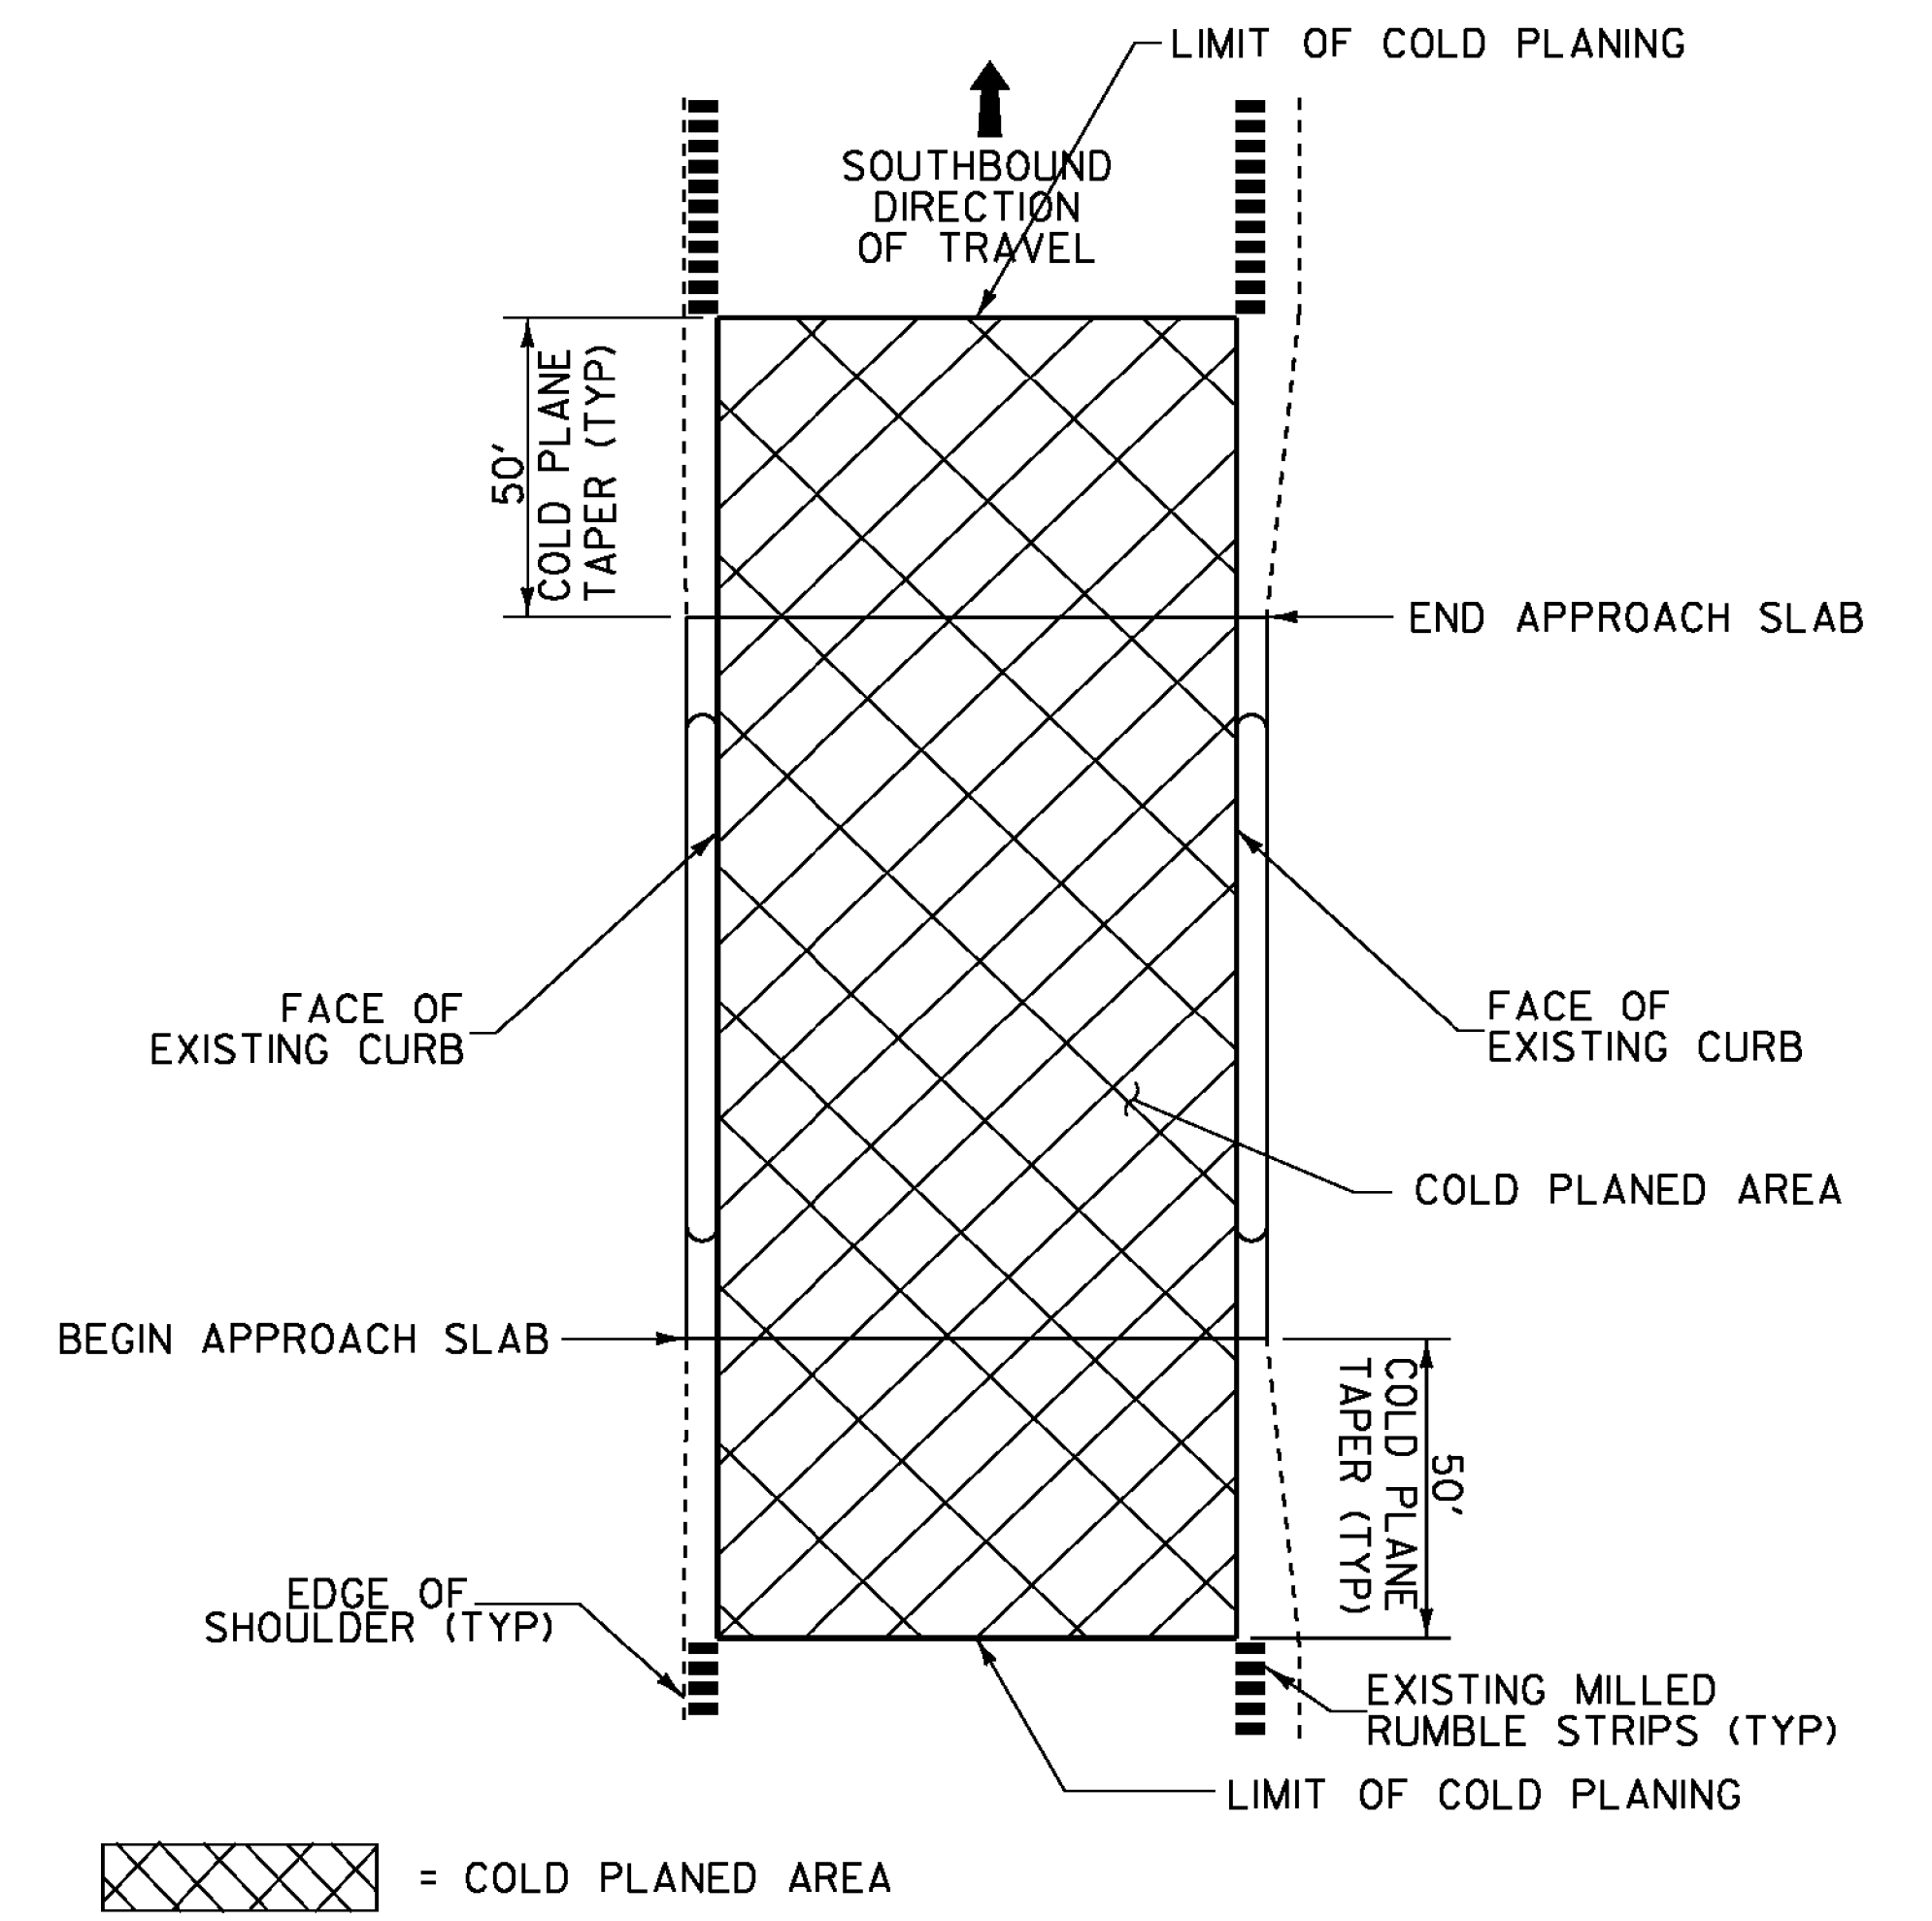

BRIDGE COLD PLANE TYPICAL PLAN

NOTES:

1. THE CONTRACTOR SHALL TAKE PRECAUTIONS TO AVOID DAMAGING DRAINAGE STRUCTURES AND EXPANSION JOINTS. ANY DAMAGE CAUSED BY THE CONTRACTOR SHALL BE REPAIRED BY THE CONTRACTOR AT THE SOLE EXPENSE OF THE CONTRACTOR.
2. THE CONTRACTOR SHALL TAKE PRECAUTIONS TO AVOID THE ACCUMULATION OF DEBRIS IN THE DRAINAGE STRUCTURES LOCATED AT CURB LINE AND IN THE EXPANSION JOINTS. THE CONTRACTOR SHALL EXAMINE THESE BRIDGE FEATURES ON A DAILY BASIS TO ENSURE THAT DEBRIS HAS NOT ACCUMULATED. ANY DEBRIS WHICH IS PRESENT SHALL BE REMOVED BY THE CONTRACTOR AT NO COST TO THE STATE.

NOT TO SCALE

BRIDGE DETAIL SHEET # 1	PROJECT NAME: NORWICH - BRADFORD	
	PROJECT NUMBER: IM SURF (31)	
FILE NAME: /pave/lla030/plla030.dgn	PLOT DATE: 07-FEB-2012	
PROJECT LEADER: MIKE FOWLER	DRAWN BY: WILDER	
DESIGNED BY: WILDER	CHECKED BY: PVMT MGMT	
IPARM FILE NAME: plla030_05.i	SHEET 5 OF 19	