

6 INCH WHITE LINE
 RAMP "A" 1,850' (SOLID)
 RAMP "A" 135' (DOTTED)
 RAMP "C" 1,600' (SOLID)
 RAMP "C" 95' (DOTTED)

6 INCH YELLOW LINE
 RAMP "A" 1,045' (SOLID)
 RAMP "C" 1,075' (SOLID)

12 INCH WHITE LINE
 RAMP "A" 475' (SOLID)
 RAMP "C" 300' (SOLID)
 RAMP "C" 115' (DIAGONALS)


LETTER OR SYMBOL
 RAMP "C" 10 EA (S,T,O,P) (A,H,E,A,D)
 (→)

TEMPORARY 6 INCH WHITE LINE, PAINT
 RAMP "A" 1,850' (SOLID)
 RAMP "A" 135' (DOTTED)
 RAMP "C" 1,600' (SOLID)
 RAMP "C" 95' (DOTTED)

TEMPORARY 6 INCH YELLOW LINE, PAINT
 RAMP "A" 1,045' (SOLID)
 RAMP "C" 1,075' (SOLID)

TEMPORARY 12 INCH WHITE LINE, PAINT
 RAMP "A" 475' (SOLID)
 RAMP "C" 300' (SOLID)
 RAMP "C" 115' (DIAGONALS)

TEMPORARY LETTER OR SYMBOL, PAINT
 RAMP "C" 10 EA (S,T,O,P) (A,H,E,A,D)
 (→)

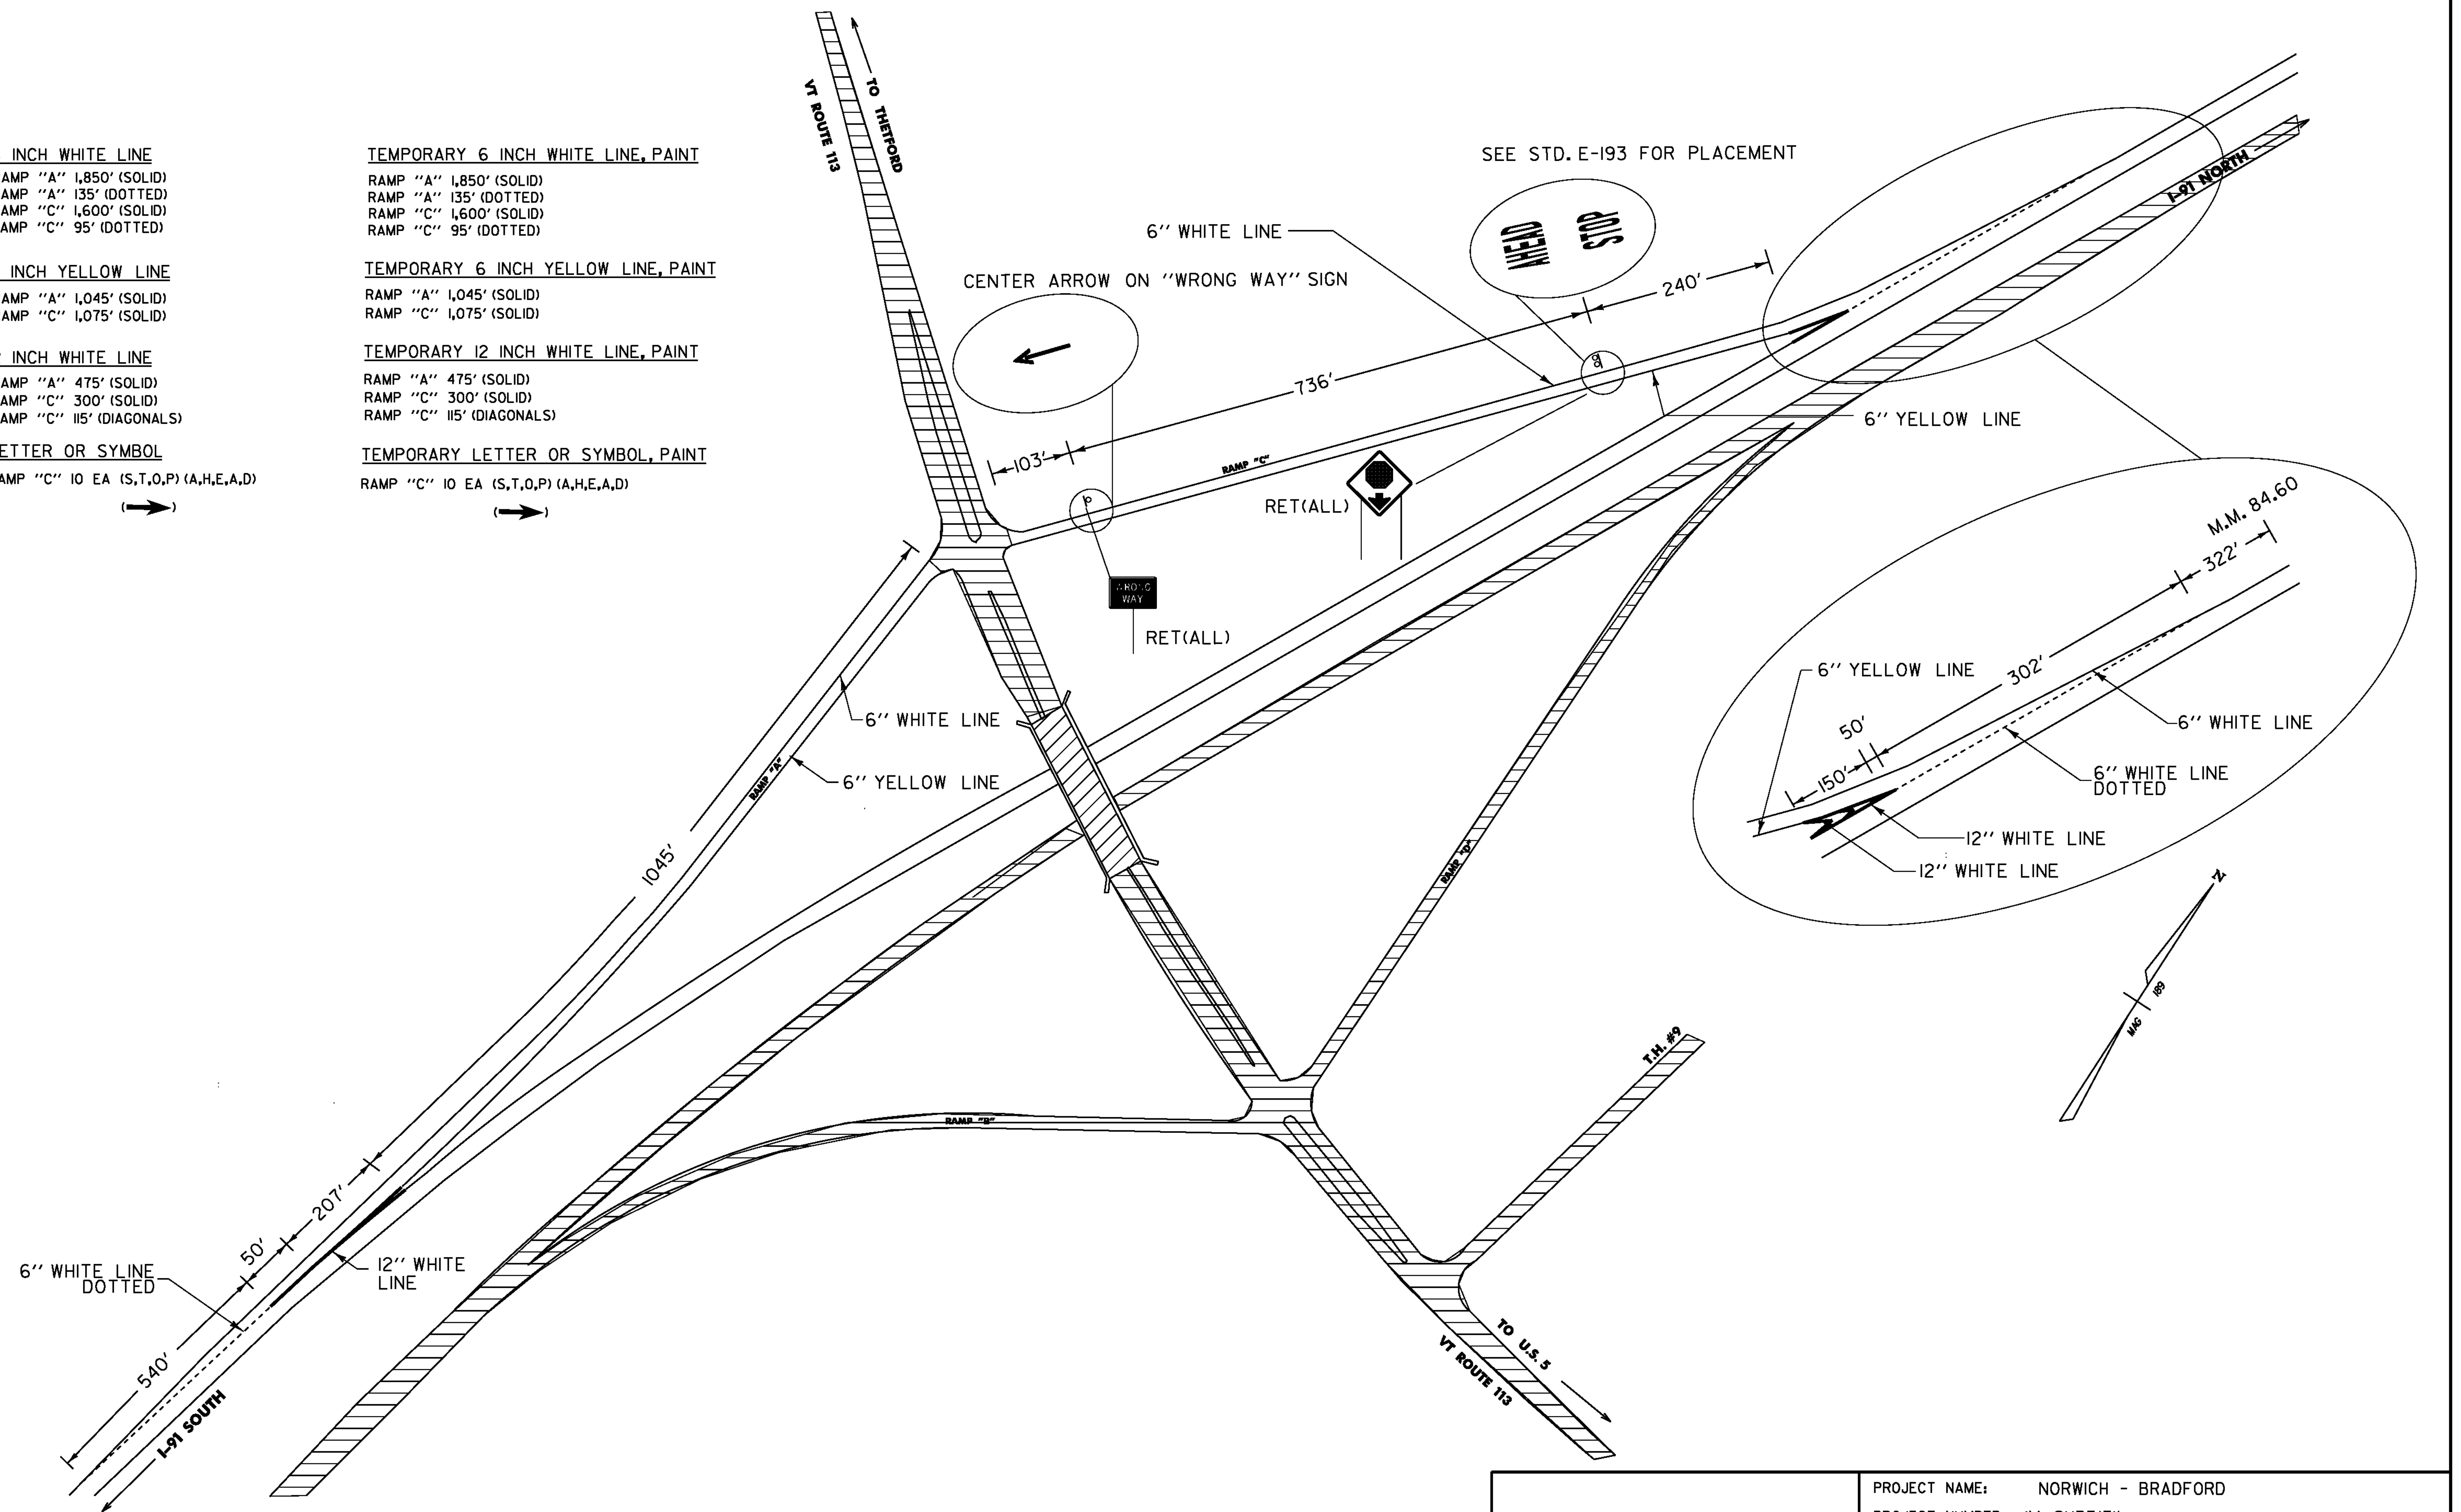

NOT TO SCALE

= NO WORK

**EXIT 14
 PAVEMENT MARKING
 SHEET**

PROJECT NAME: NORWICH - BRADFORD	PLOT DATE: 06-FEB-2012
PROJECT NUMBER: IM SURF(31)	DRAWN BY: WILDER
FILE NAME: /pave/11a030/plla030.dgn	CHECKED BY: PVMT MGMT
PROJECT MANAGER: MIKE FOWLER	SHEET 10 OF 19
DESIGNED BY: WILDER	
IPARM FILE NAME: plla030_10.1	