


INDEX OF SHEETS

- 1 TITLE SHEET
- 2 COMMON NOTES TO BOTH ALTERNATES
- 3 ALTERNATE A TYPICAL SHEET
- 4 ALTERNATE B TYPICAL SHEET
- 5 BRIDGE DETAIL SHEET # 1
- 6 BRIDGE DETAIL SHEET # 2
- 7 QUANTITY SHEET
- 8 PAVEMENT MARKING DETAIL SHEET
- 9 MAINLINE PAVEMENT MARKING SHEET
- 10 EXIT 14 PAVEMENT MARKING SHEET
- 11 EXIT 15 PAVEMENT MARKING SHEET
- 12 EXIT 16 PAVEMENT MARKING SHEET
- 13 ROUGHNESS DATA INFORMATION
- 14 RUTTING DATA INFORMATION
- 15 CONSTRUCTION APPROACH SIGNING EXIT 14
- 16 CONSTRUCTION APPROACH SIGNING EXIT 15
- 17 CONSTRUCTION APPROACH SIGNING EXIT 16
- 18 CONSTRUCTION APPROACH MAINLINE SIGNING SHEET
- 19 TRAFFIC CONTROL NOTE SHEET

STATE OF VERMONT AGENCY OF TRANSPORTATION



PROJECT LOCATION
NORWICH - BRADFORD IM SURF (31)

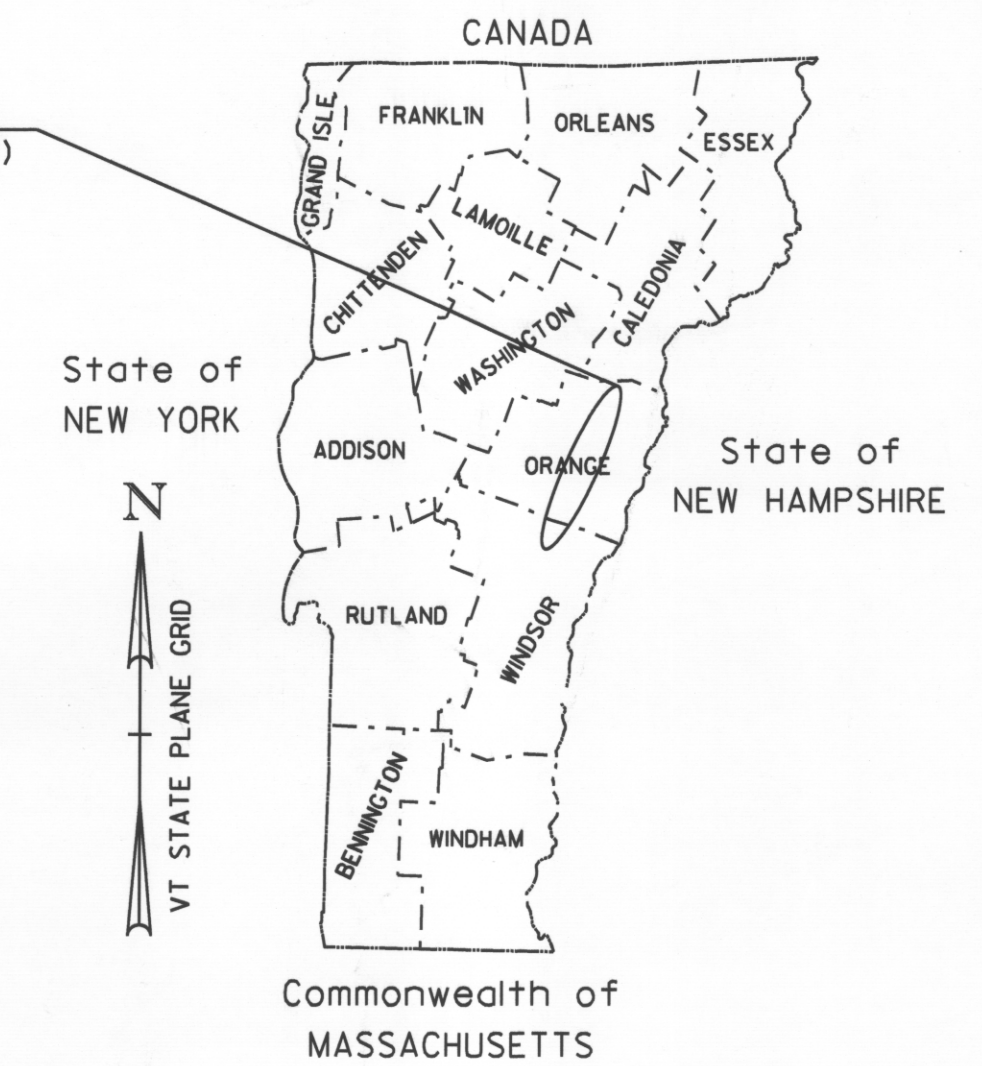

PROPOSED IMPROVEMENT TOWNS OF NORWICH, THETFORD, FAIRLEE AND BRADFORD COUNTIES OF WINDSOR AND ORANGE INTERSTATE 91 SOUTHBOUND

VAOT STANDARDS

-100	01/02/2004
-100A	01/02/2004
-101	05/30/2003
-102	06/30/2003
-102A	05/01/2004
-103	03/01/2004
-105	05/01/2004
-106	05/01/2004
-107A	06/08/2009
-108	06/08/2009
-108A	06/08/2009
-110	08/08/1995
-120	08/08/1995
-121	08/08/1995
-150	05/01/2004
-164	06/08/2009
-191	02/01/1999
-193	08/18/1995

RECORD PLANS

CONTRACTOR: GORMAN GROUP, LLC - ALBANY, NY

RESIDENT ENGINEER: PAUL PERRY

CONSTRUCTION BEGAN: APRIL 16, 2012

CONSTRUCTION COMPLETE: SEPTEMBER 20, 2012

RECORD PLANS BY: PAUL PERRY & J. HYDE

I HEREBY CERTIFY THAT ALL THE CONSTRUCTION REQUIRED BY THIS SET OF DRAWINGS HAS BEEN ACCOMPLISHED AS INDICATED HEREIN.

BY: *Paul Perry* RESIDENT ENGINEER

DATE: 04/02/13

NOTE: Any further information concerning final quantities, amounts or other details relative to this project may be found at Central Files in the electronic archives.

BEGINNING IN THE TOWN OF NORWICH IN THE SOUTHBOUND LANE AT MILE MARKER 76.443 AND EXTENDING NORTHERLY ALONG INTERSTATE 91 FOR A DISTANCE OF 116,091.36 FT (21.987 MILES) TO MILE MARKER 98.430 IN THE TOWN OF BRADFORD.

LENGTH OF ROADWAY = 116,091.36 FT = (21.987 MILES) (SOUTHBOUND LANE)
LENGTH OF PROJECT = 116,091.36 FT = (21.987 MILES) (SOUTHBOUND LANE)

WORK TO BE PERFORMED UNDER THIS PROJECT INCLUDES SURFACE PREPARATION INVOLVING PATCHING, POT HOLE REPAIR, AND CRACK-SEALING; OVERLAYING WITH A THIN BITUMINOUS CONCRETE WEARING COURSE ON THE EXISTING INTERSTATE TYPICAL, AND APPLICABLE PAVEMENT MARKINGS.

TRAFFIC DATA

I-91 - SOUTHBOUND	2012 AADT	2022 AADT	2012 DHV	2022 DHV	FLEXIBLE ESALS (2012 - 2022)	FLEXIBLE ESALS (2012 - 2032)
BEGIN PROJECT TO EXIT 14	6,200	6,900	880	980	3,530,000	8,425,000
EXIT 14 TO EXIT 15	4,900	5,600	660	750	1,958,000	4,804,000
EXIT 15 TO EXIT 16	4,000	4,600	560	640	2,658,000	6,452,000
EXIT 16 TO END PROJECT	4,000	3,200	390	440	2,839,000	6,795,000

MM 76.443
BEGIN PROJECT IM SURF (31)

MM 98.43
END PROJECT IM SURF (31)


QUALITY ASSURANCE PROGRAM: LEVEL 1

CONVENTIONAL SYMBOLS

COUNTY LINE	
TOWN LINE	
LIMITS OF ACCESS	
POINT OF ACCESS	
FENCE LINE	
STONE WALL	
TRAVELED WAY	
GUARD RAIL	
RAILROAD	
SURVEY LINE	
CULVERT	
POWER POLE	
TELEPHONE POLE	
TREES	
CONTROL OF ACCESS	
PROPERTY LINE	
R.O.W. TAKING LINE	
SLOPE RIGHTS	
TOP OF CUT	
TOE OF SLOPE	

SURVEYED BY :
SURVEYED DATE :

DATUM
VERTICAL
HORIZONTAL

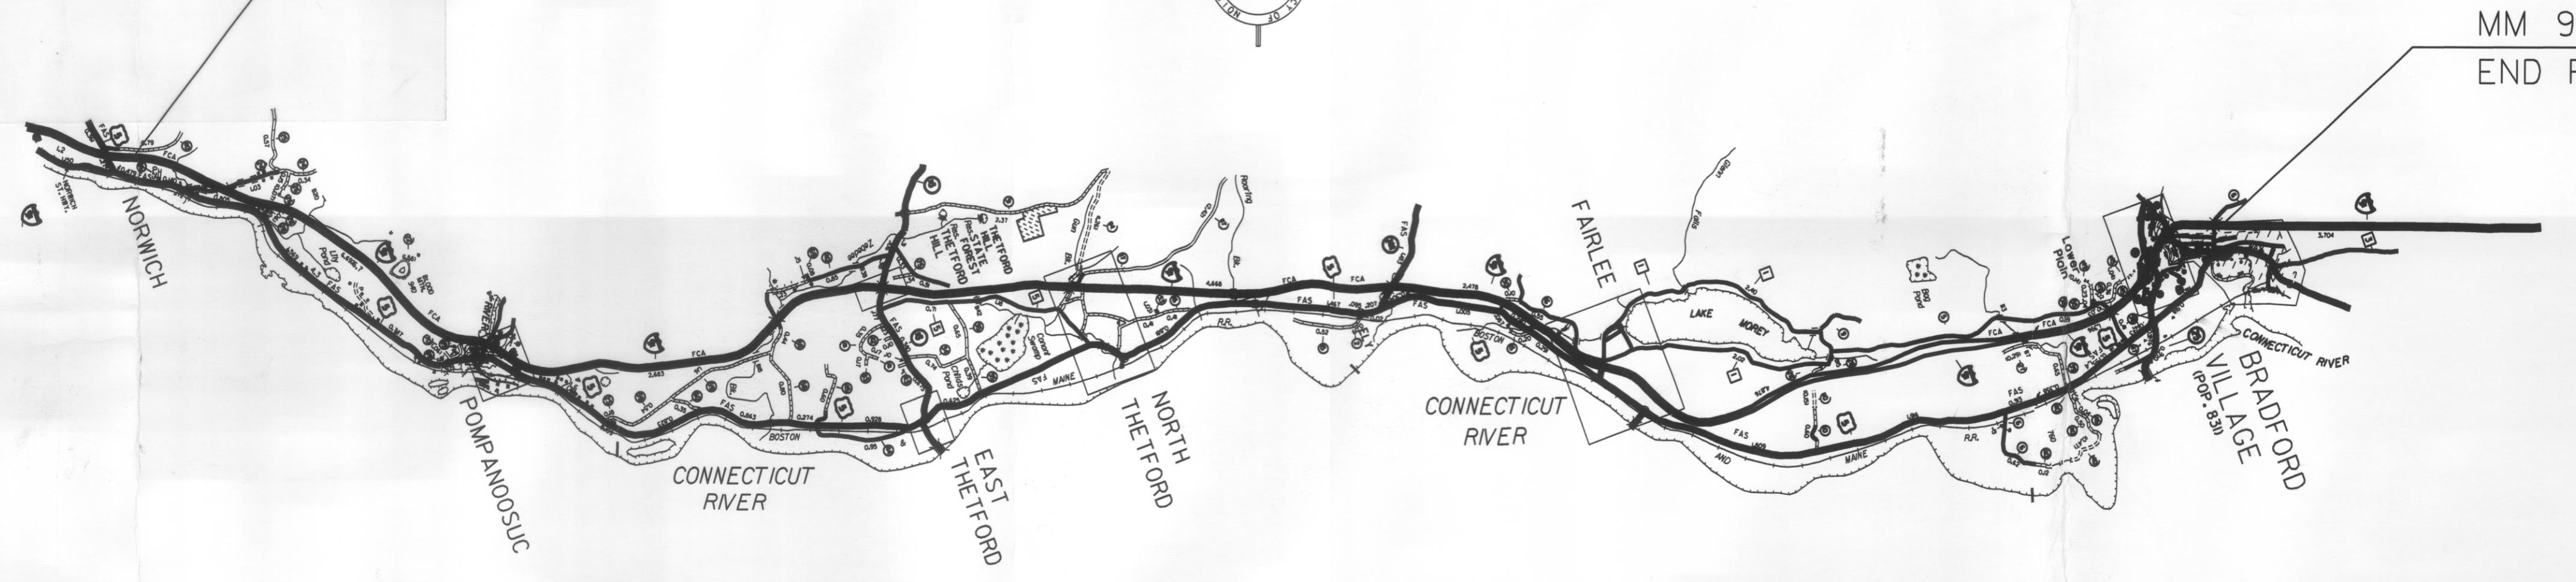

THESE PLANS ARE SUBJECT TO SUCH ENGINEERING CHANGES AS MAY BE REQUIRED BY THE FEDERAL HIGHWAY ADMINISTRATION OR THE DIRECTOR OF PROGRAM DEVELOPMENT.

CONSTRUCTION IS TO BE CARRIED ON IN ACCORDANCE WITH THESE PLANS AND THE STANDARD SPECIFICATIONS FOR CONSTRUCTION DATED 2011, AS APPROVED BY THE FEDERAL HIGHWAY ADMINISTRATION ON JULY 20, 2011 FOR USE ON THIS PROJECT, INCLUDING ALL SUBSEQUENT REVISIONS AND SUCH REVISED SPECIFICATIONS AND SPECIAL PROVISIONS AS ARE INCORPORATED IN THESE PLANS.

DIRECTOR OF PROGRAM DEVELOPMENT

APPROVED: *Paul Perry* DATE: 2/4/12

PROJECT MANAGER : MIKE FOWLER

PROJECT NAME : NORWICH - BRADFORD
PROJECT NUMBER : IM SURF (31)


SHEET 1 OF 19 SHEETS

NOTES:


1. ALL NECESSARY SURFACE PREPARATION INVOLVING PATCHING, POTHOLE REPAIR, AND CRACK-SEALING SHALL BE PERFORMED PRIOR TO APPLICATION OF THE PAVER PLACED SURFACE TREATMENT. ALL CRACKS GREATER THAN 0.10" AND UP TO 1.0" IN WIDTH SHALL BE SEALED USING THE "BLOW AND GO" FILL METHOD. ALL COSTS ASSOCIATED WITH THIS WORK SHALL BE PAID FOR UNDER ITEM 417.20, BITUMINOUS CRACK SEALING, "BLOW AND GO" METHOD. THE PATCHING OF ALL CRACKS GREATER THAN 1.0" AND ALL OTHER PATCHING AND POT-HOLE REPAIR SHALL BE COMPLETED USING BITUMINOUS CONCRETE PAVEMENT IN ACCORDANCE WITH ITEM 900.680 SPECIAL PROVISION (BITUMINOUS CONCRETE PAVEMENT SURFACE PREPARATION, TYPE I). AN ESTIMATED QUANTITY FOR THIS ITEM HAS BEEN INCLUDED TO COVER ALL COSTS ASSOCIATED WITH THIS WORK.
2. EXISTING SHOULDER PAVEMENT SURFACES BEYOND THE LIMITS OF THE PAVER PLACED SURFACE TREATMENT SHALL ALSO RECEIVE CRACK-SEALING AND RELATED PATCHING AND POTHOLE REPAIR TREATMENTS.
3. FOLLOWING COMPLETION OF COLD PLANING, THE MILLED SURFACE FOR ALL BRIDGES SHALL ALSO RECEIVE CRACK-SEALING AND RELATED PATCHING AND POTHOLE REPAIR TREATMENTS, AS DIRECTED BY THE ENGINEER.
4. ALL EXISTING PAVEMENT MARKINGS SHALL BE REMOVED PRIOR TO APPLYING ANY CRACK SEALING BEING PERFORMED AND PRIOR TO THE PAVER PLACED SURFACE TREATMENT. ALL LANE DELINEATION IS TO BE MAINTAINED DURING CONSTRUCTION BY THE USE OF LINE STRIPING TARGETS OR TEMPORARY PAINT.
5. A 50' COLD PLANED WEDGE SHALL BE CONSTRUCTED AT THE PROJECT BEGIN, PROJECT END, RAMPS AND AT ALL BRIDGE APPROACHES; A 25' COLD PLANED WEDGE AT ALL U-TURNS OR AS DIRECTED BY THE ENGINEER. THE LONGITUDINAL EDGES OF THE SURFACE TREATMENT SHALL BE FEATHERED AS SHOWN ON THE TYPICAL SECTION, OR AS DIRECTED BY THE ENGINEER. ANY SAWCUTTING AT BUTT JOINTS SHALL BE PAID INCIDENTAL TO ITEM 210.10, COLD PLANING, BITUMINOUS PAVEMENT. THE CONTRACTOR SHALL USE CAUTION WHEN COLD PLANING AND PAVING OPERATIONS OCCUR ADJACENT TO EXISTING DROP INLETS OR CATCH BASINS. ANY DAMAGE WHICH OCCURS TO THESE DRAINAGE STRUCTURES AS A RESULT OF THESE OPERATIONS SHALL BE THE RESPONSIBILITY OF THE CONTRACTOR AND SHALL BE REPAIRED BY THE CONTRACTOR AT NO COST TO THE STATE OF VERMONT.
6. IF IT IS DETERMINED IN AREAS ALONG THE BASE OF THE GUARDRAIL THAT WINTER SAND AND OTHER DEBRIS HAS ACCUMULATED SUFFICIENTLY TO AFFECT PROPER CRACK-SEALING AND RELATED PATCHING AND POTHOLE REPAIR TREATMENTS, THIS MATERIAL SHALL BE REMOVED PRIOR TO CRACK-SEALING, PATCHING, AND POTHOLE REPAIR AS DIRECTED BY THE ENGINEER. AN ESTIMATED QUANTITY FOR ITEM 203.40 SHOULDER BERM REMOVAL HAS BEEN INCLUDED TO COVER THE COSTS ASSOCIATED WITH THIS WORK.

**COMMON
NOTES
FOR BOTH
ALTERNATIVES**


PROJECT NAME: NORWICH - BRADFORD	
PROJECT NUMBER: IM SURF (3I)	
FILE NAME: /pave/11a030/plla030.dgn	PLOT DATE: 07-FEB-2012
PROJECT LEADER: MIKE FOWLER	DRAWN BY: WILDER
DESIGNED BY: WILDER	CHECKED BY: PVMT MGMT
IPARM FILE NAME: plla030_02.l	SHEET 2 OF 19

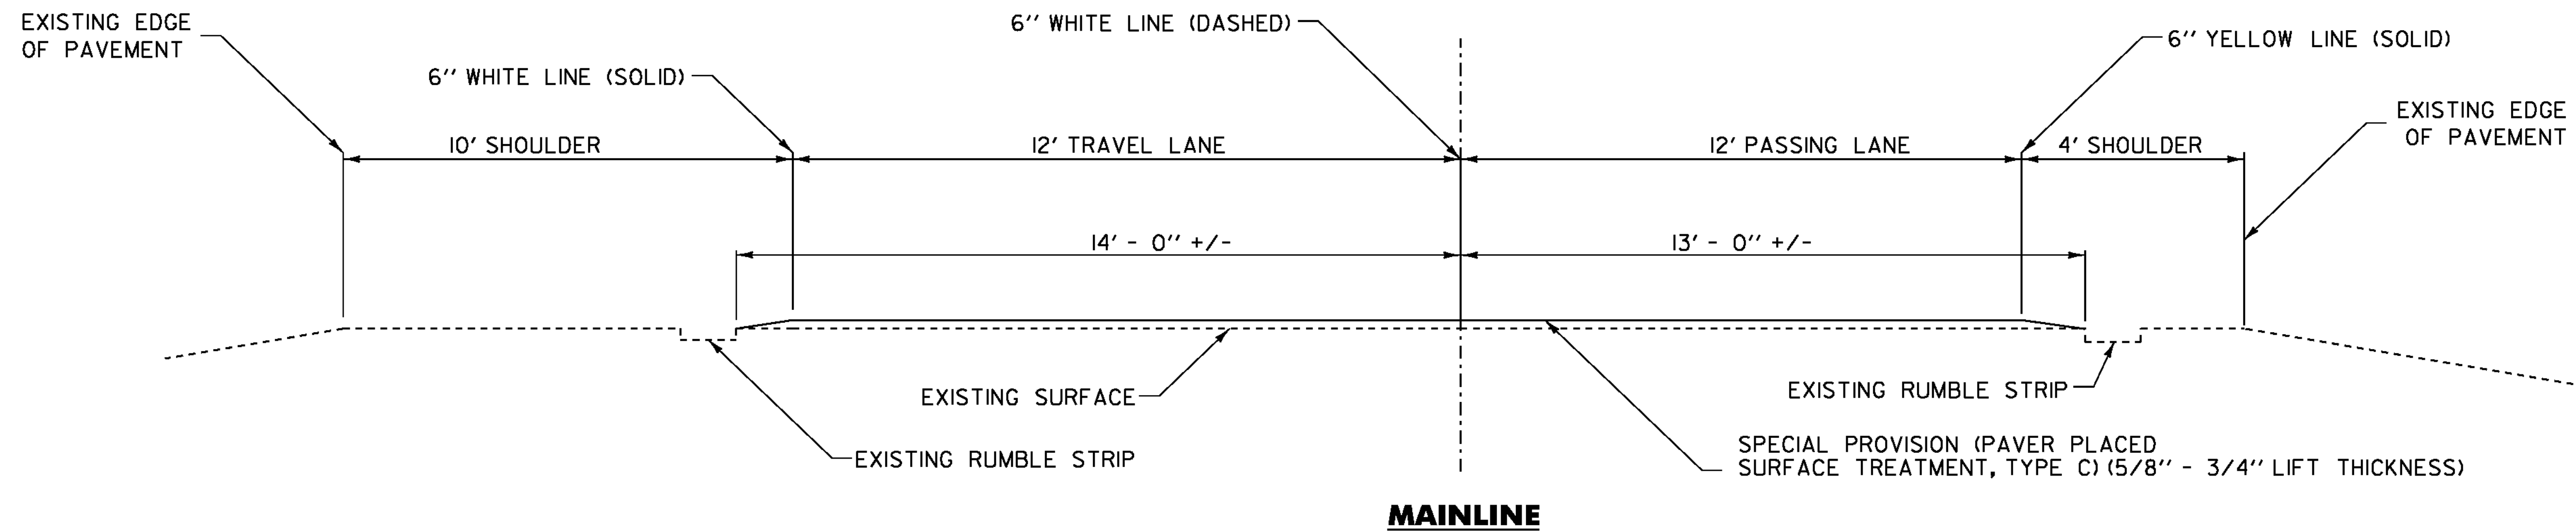

MAINLINE

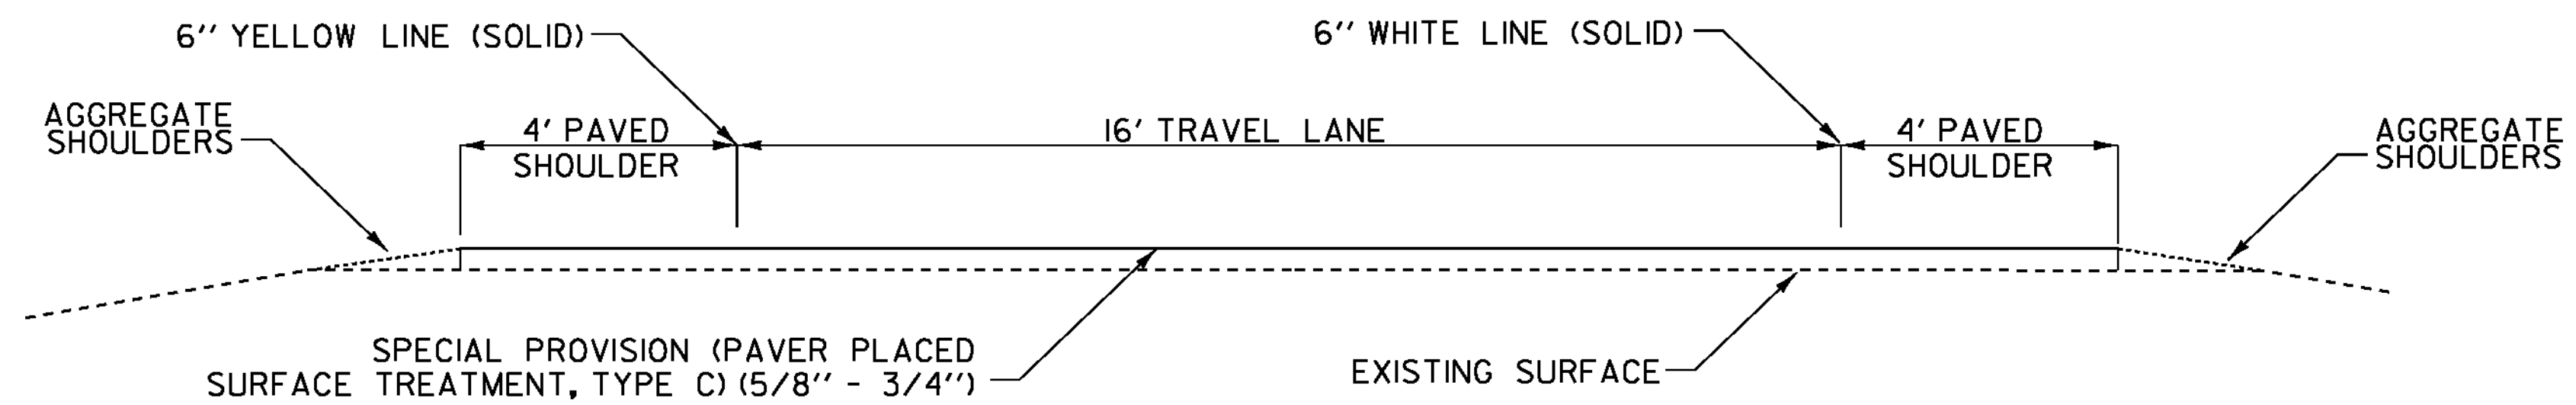


**TYPICAL RAMP SECTION
ALTERNATE A**

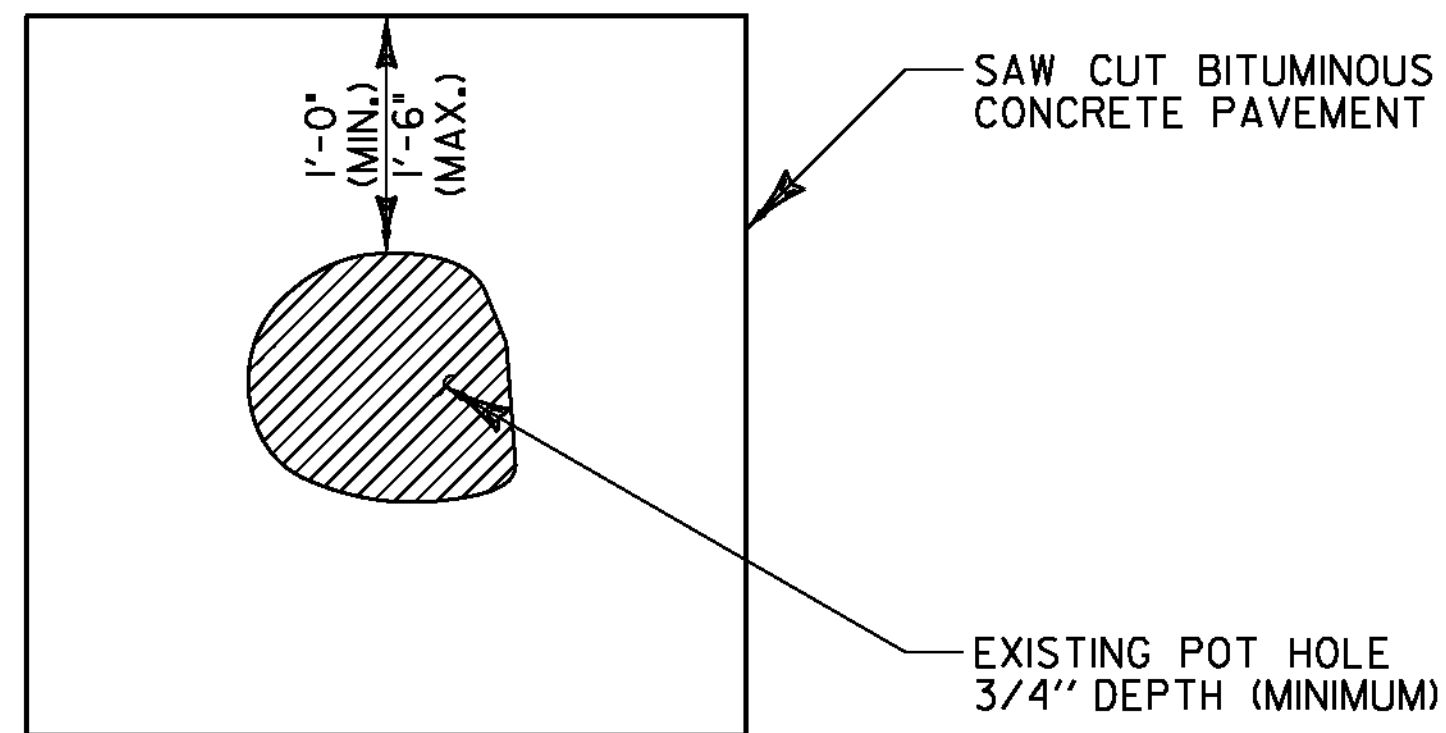

EMULSIFIED ASPHALT SHALL BE APPLIED AT ALL PATCH INTERFACES AT A RATE OF 0.25 - 0.5 GAL/SY, EMULSIFIED ASPHALT SHALL MEET THE REQUIREMENTS OF SECTION 404 AND WILL BE CONSIDERED INCIDENTAL TO THE PATCHING MATERIAL.

TYPICAL - POT HOLE REPAIR

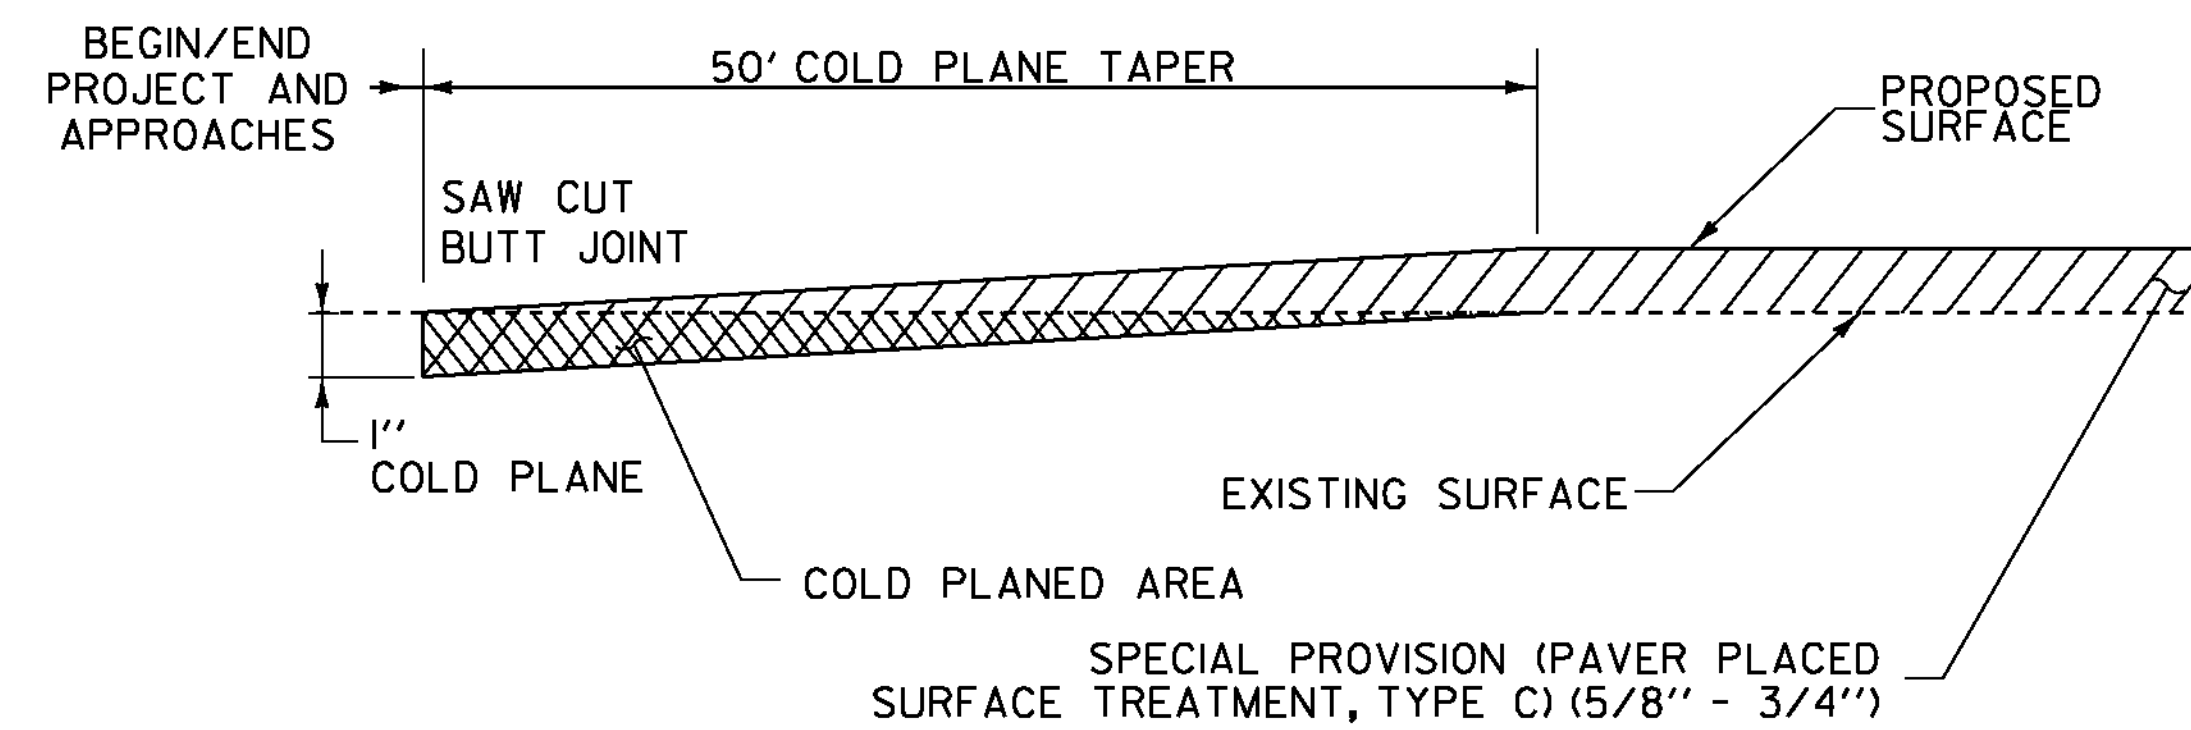




TYPICAL APPROACH AREA DETAIL MAINLINE & RAMPS

NOT TO SCALE

**ALTERNATE A
TYPICAL
SHEET**

PROJECT NAME: NORWICH - BRADFORD
PROJECT NUMBER: IM SURF (3I)

FILE NAME: /pave/lla030/plla030.dgn PLOT DATE: 07-FEB-2012
PROJECT LEADER: MIKE FOWLER DRAWN BY: WILDER
DESIGNED BY: WILDER CHECKED BY: PVMT MGMT
IPARM FILE NAME: plla030_03.1 SHEET 3 OF 19

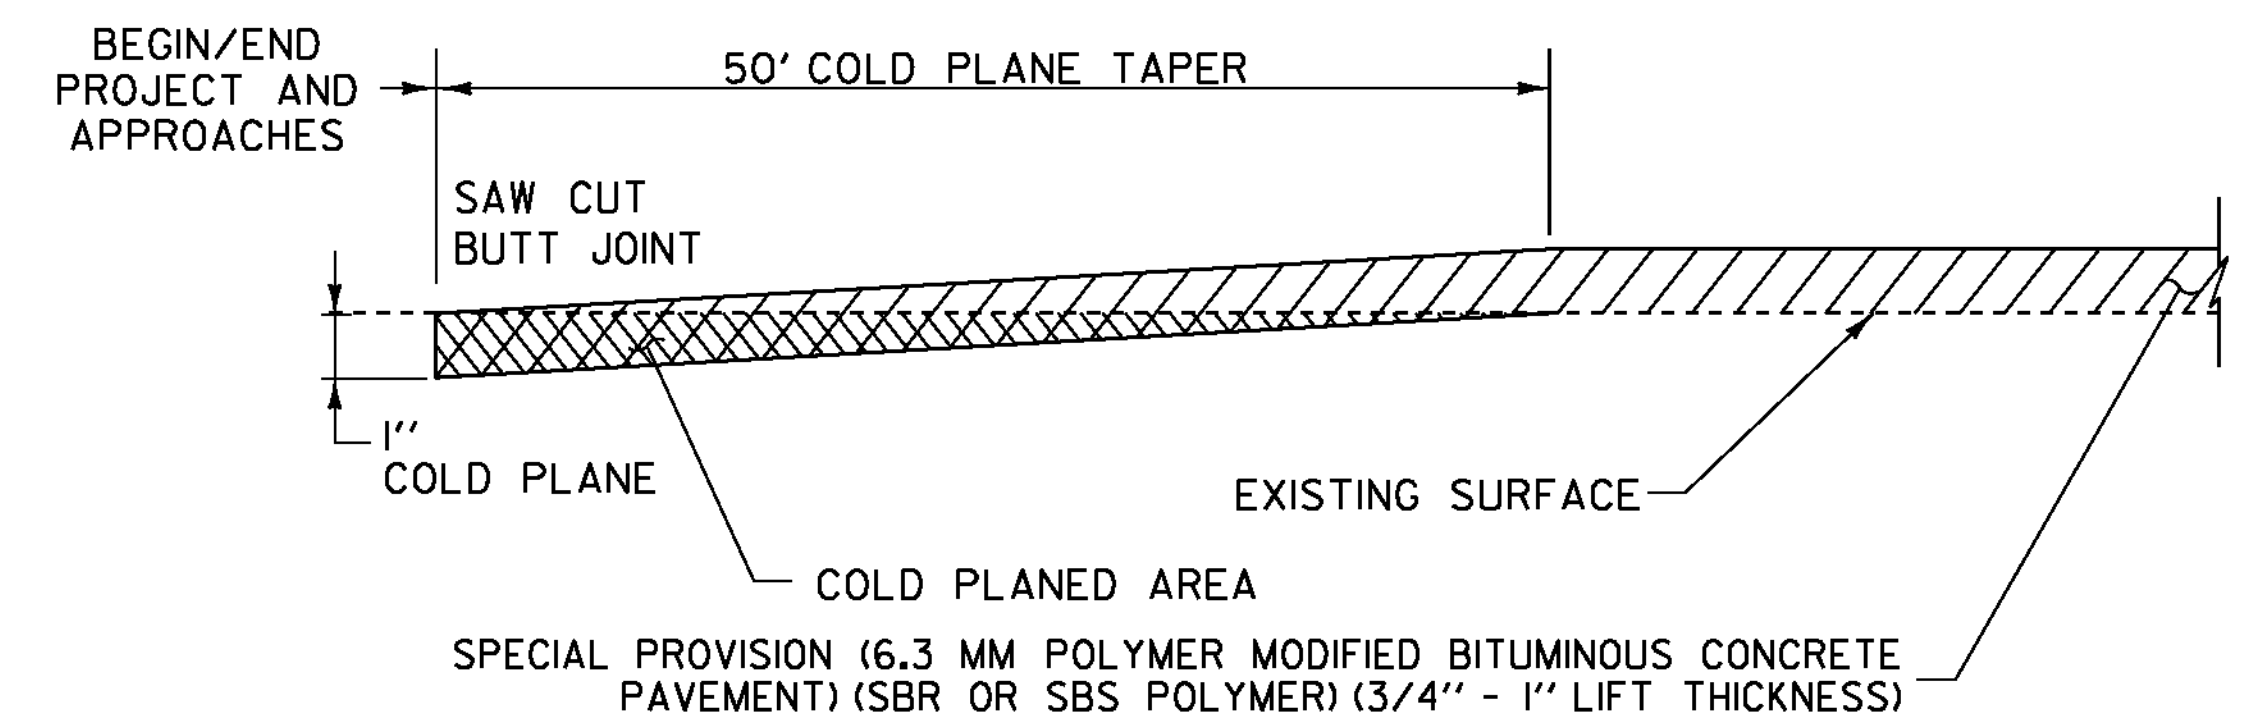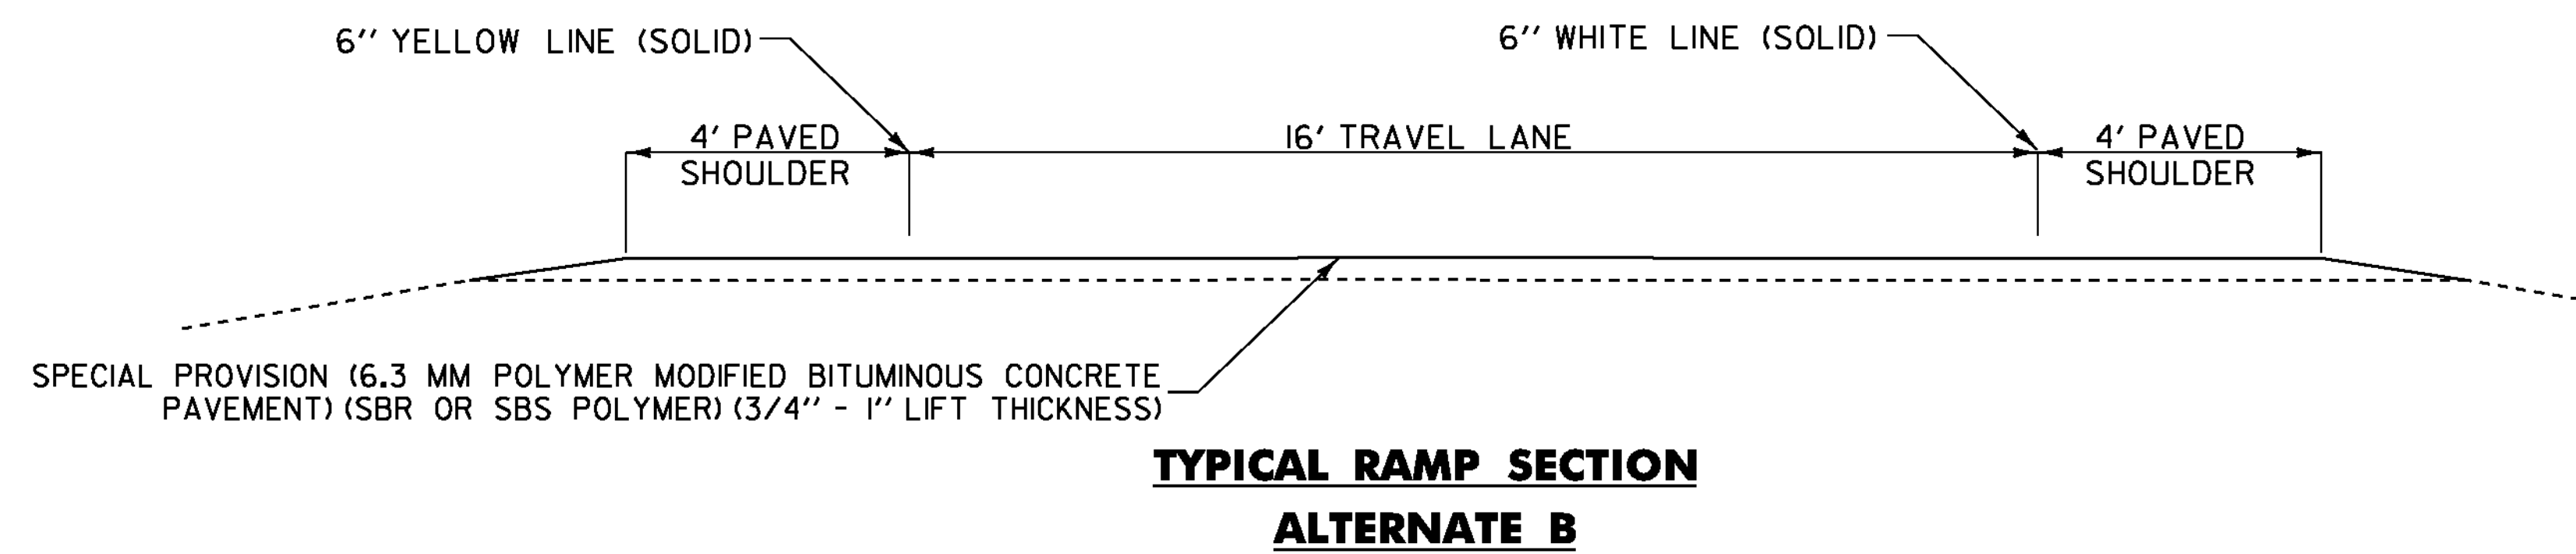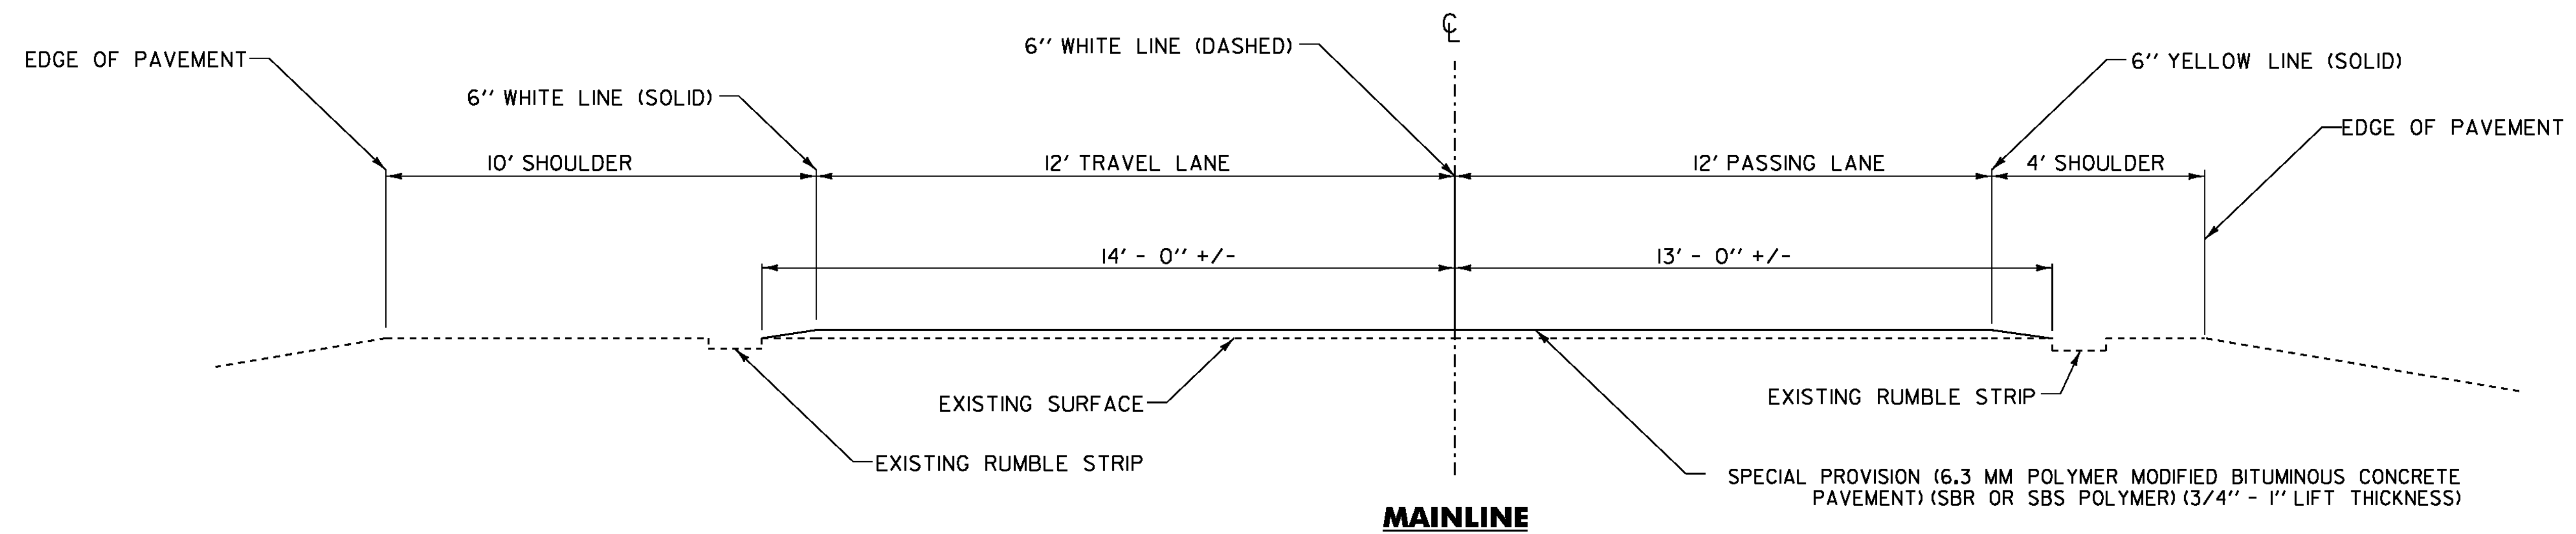

NOTES:


1. PRIOR TO THE PLACEMENT OF THE POLYMER MODIFIED SURFACE TREATMENT, EMULSIFIED ASPHALT SHALL BE APPLIED TO ALL EXISTING PAVEMENT SURFACES AND ON ALL COLD PLANED SURFACES AT A RATE OF 0.080 GAL/SY (+/- 0.01GAL/SY) OR AS DIRECTED BY THE ENGINEER. EMULSIFIED ASPHALT SHALL BE RS-IH OR CRS-IH PER THE MANUFACTURER'S RECOMMENDATION AND PAID UNDER ITEM 900.683 SPECIAL PROVISION (EMULSIFIED ASPHALT)(RS-IH OR CRS-IH).
2. THE GYRATION SPECIFICATION FOR THE 6.3 MM POLYMER - MODIFIED BITUMINOUS CONCRETE PAVEMENT SHALL BE 65.

NOT TO SCALE


**ALTERNATE B
TYPICAL
SHEET**

PROJECT NAME: NORWICH - BRADFORD
PROJECT NUMBER: IM SURF (31)

FILE NAME: /pave/lla030/plla030.dgn PLOT DATE: 07-FEB-2012
PROJECT LEADER: FOWLER DRAWN BY: WILDER
DESIGNED BY: WILDER CHECKED BY: PVMT MGMT
IPARM FILE NAME: plla030_04.i SHEET 4 OF 19

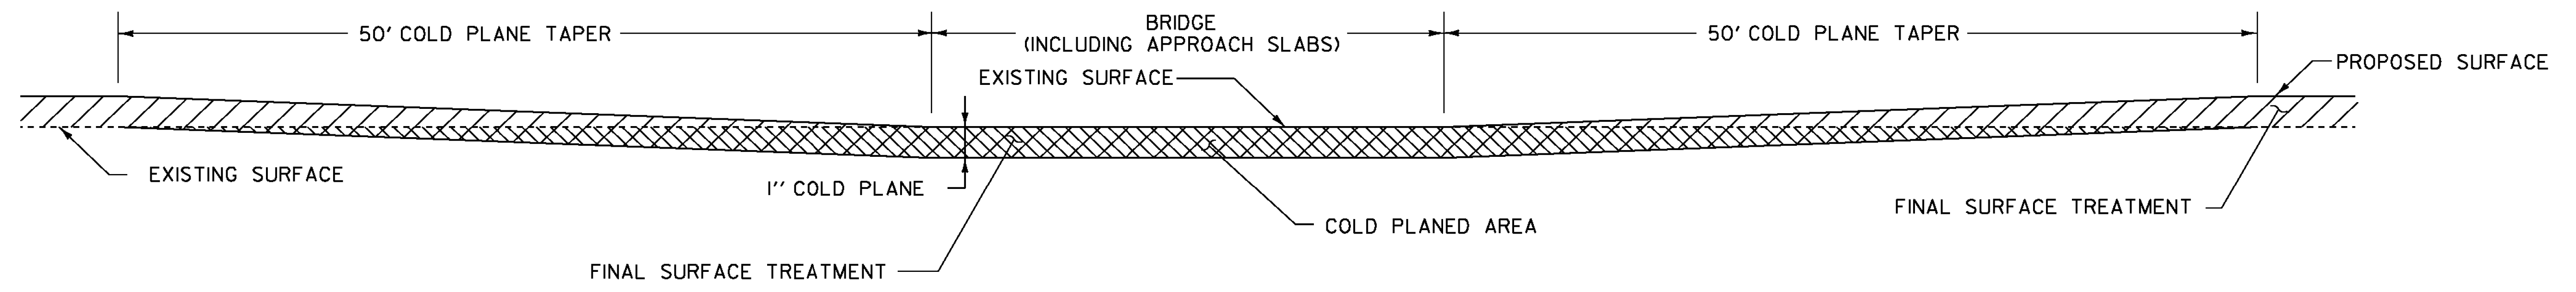


BRIDGE COLD PLANE DETAIL

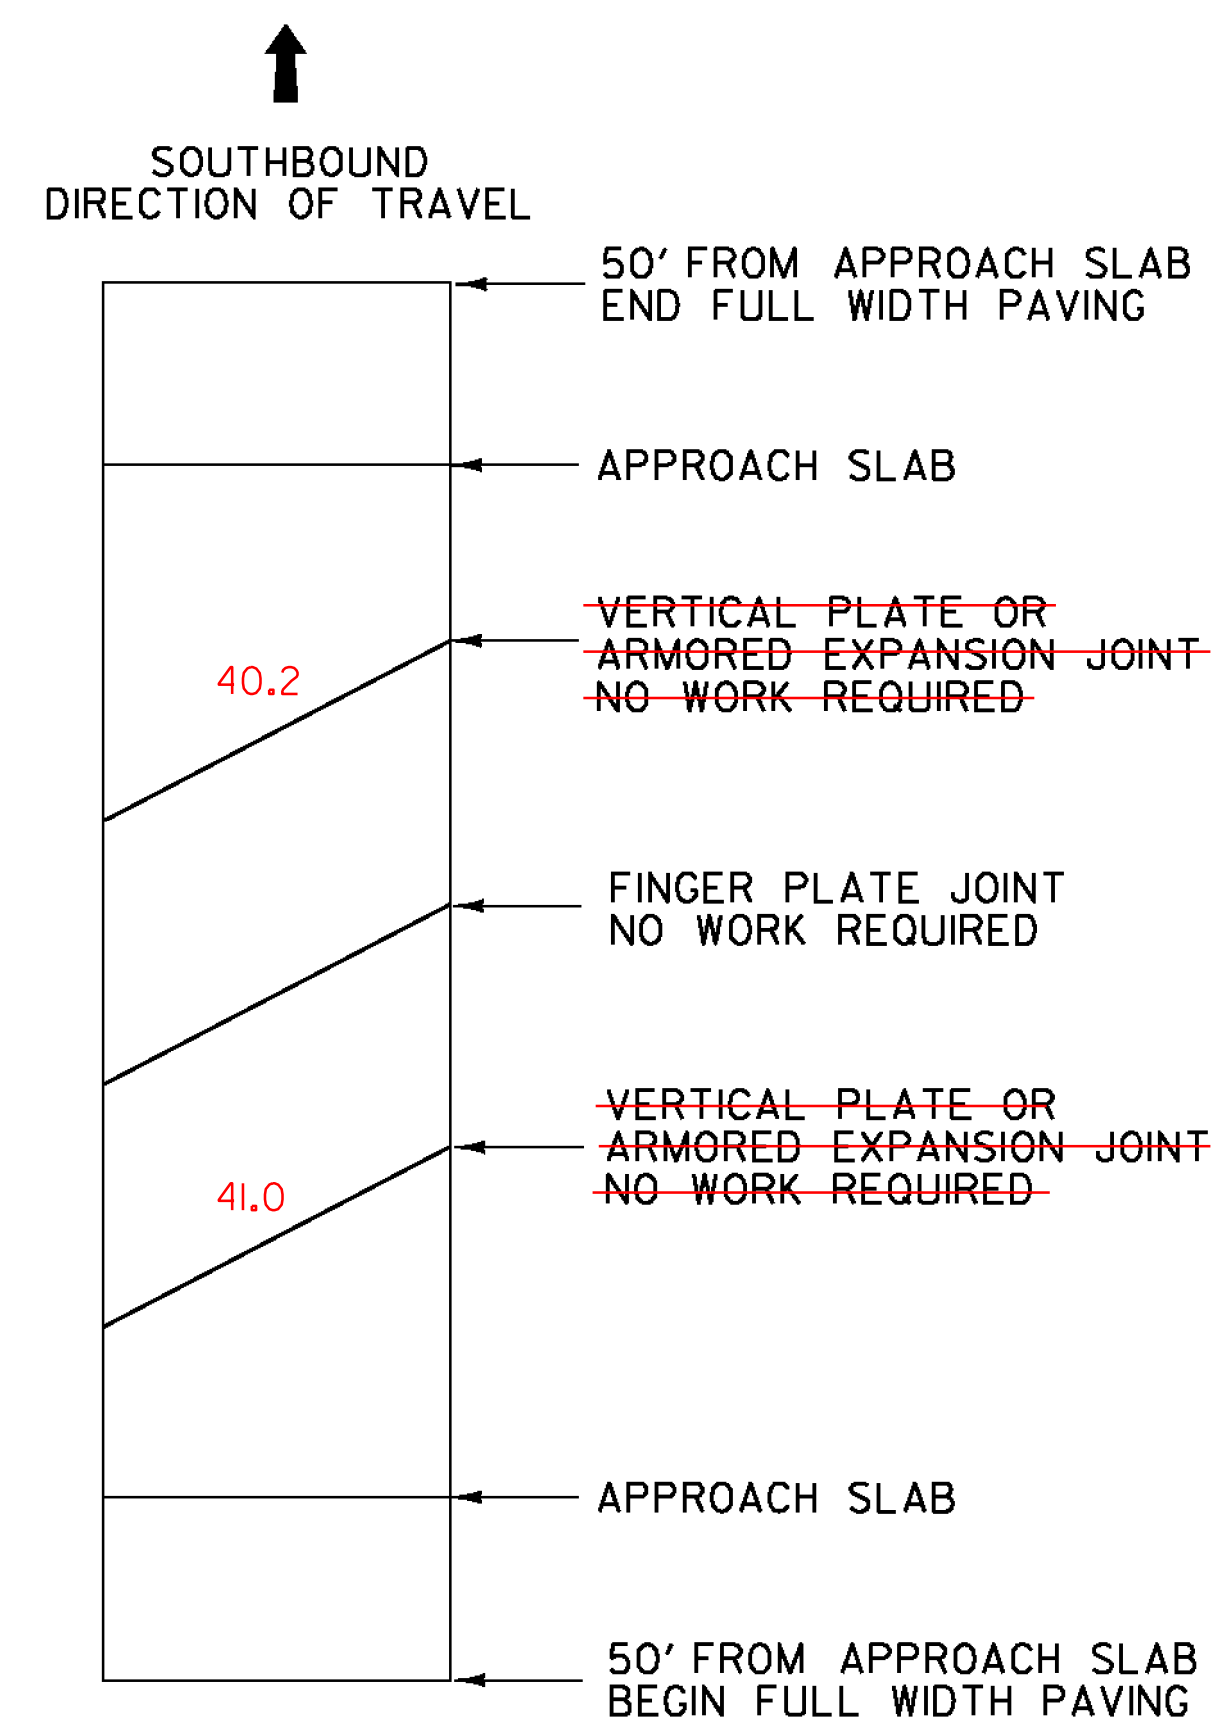


BRIDGE 51S
MM 80.217

LENGTH OF ASPHALTIC PLUG JOINTS:
TOTAL - ~~0'~~ 81.2

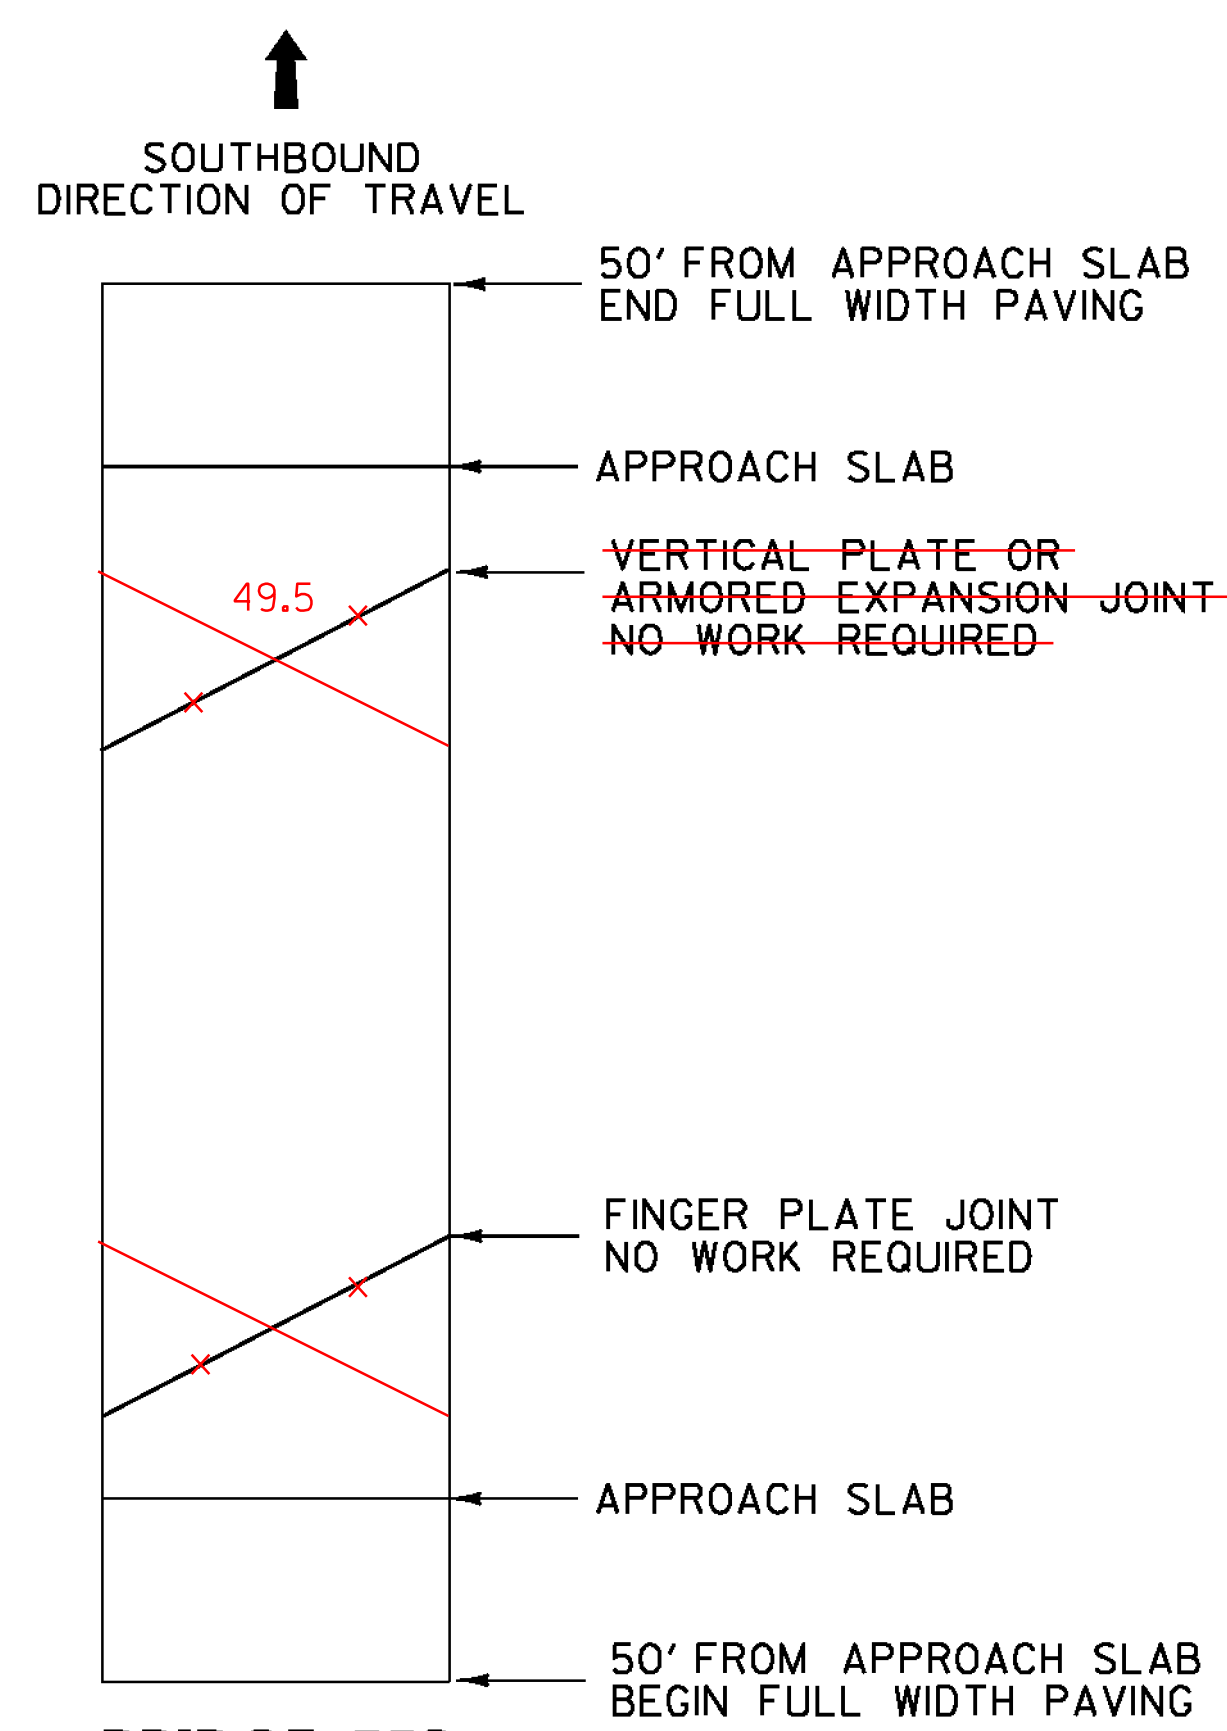

BRIDGE 55S
MM 89.266

LENGTH OF ASPHALTIC PLUG JOINTS:
TOTAL = 0'

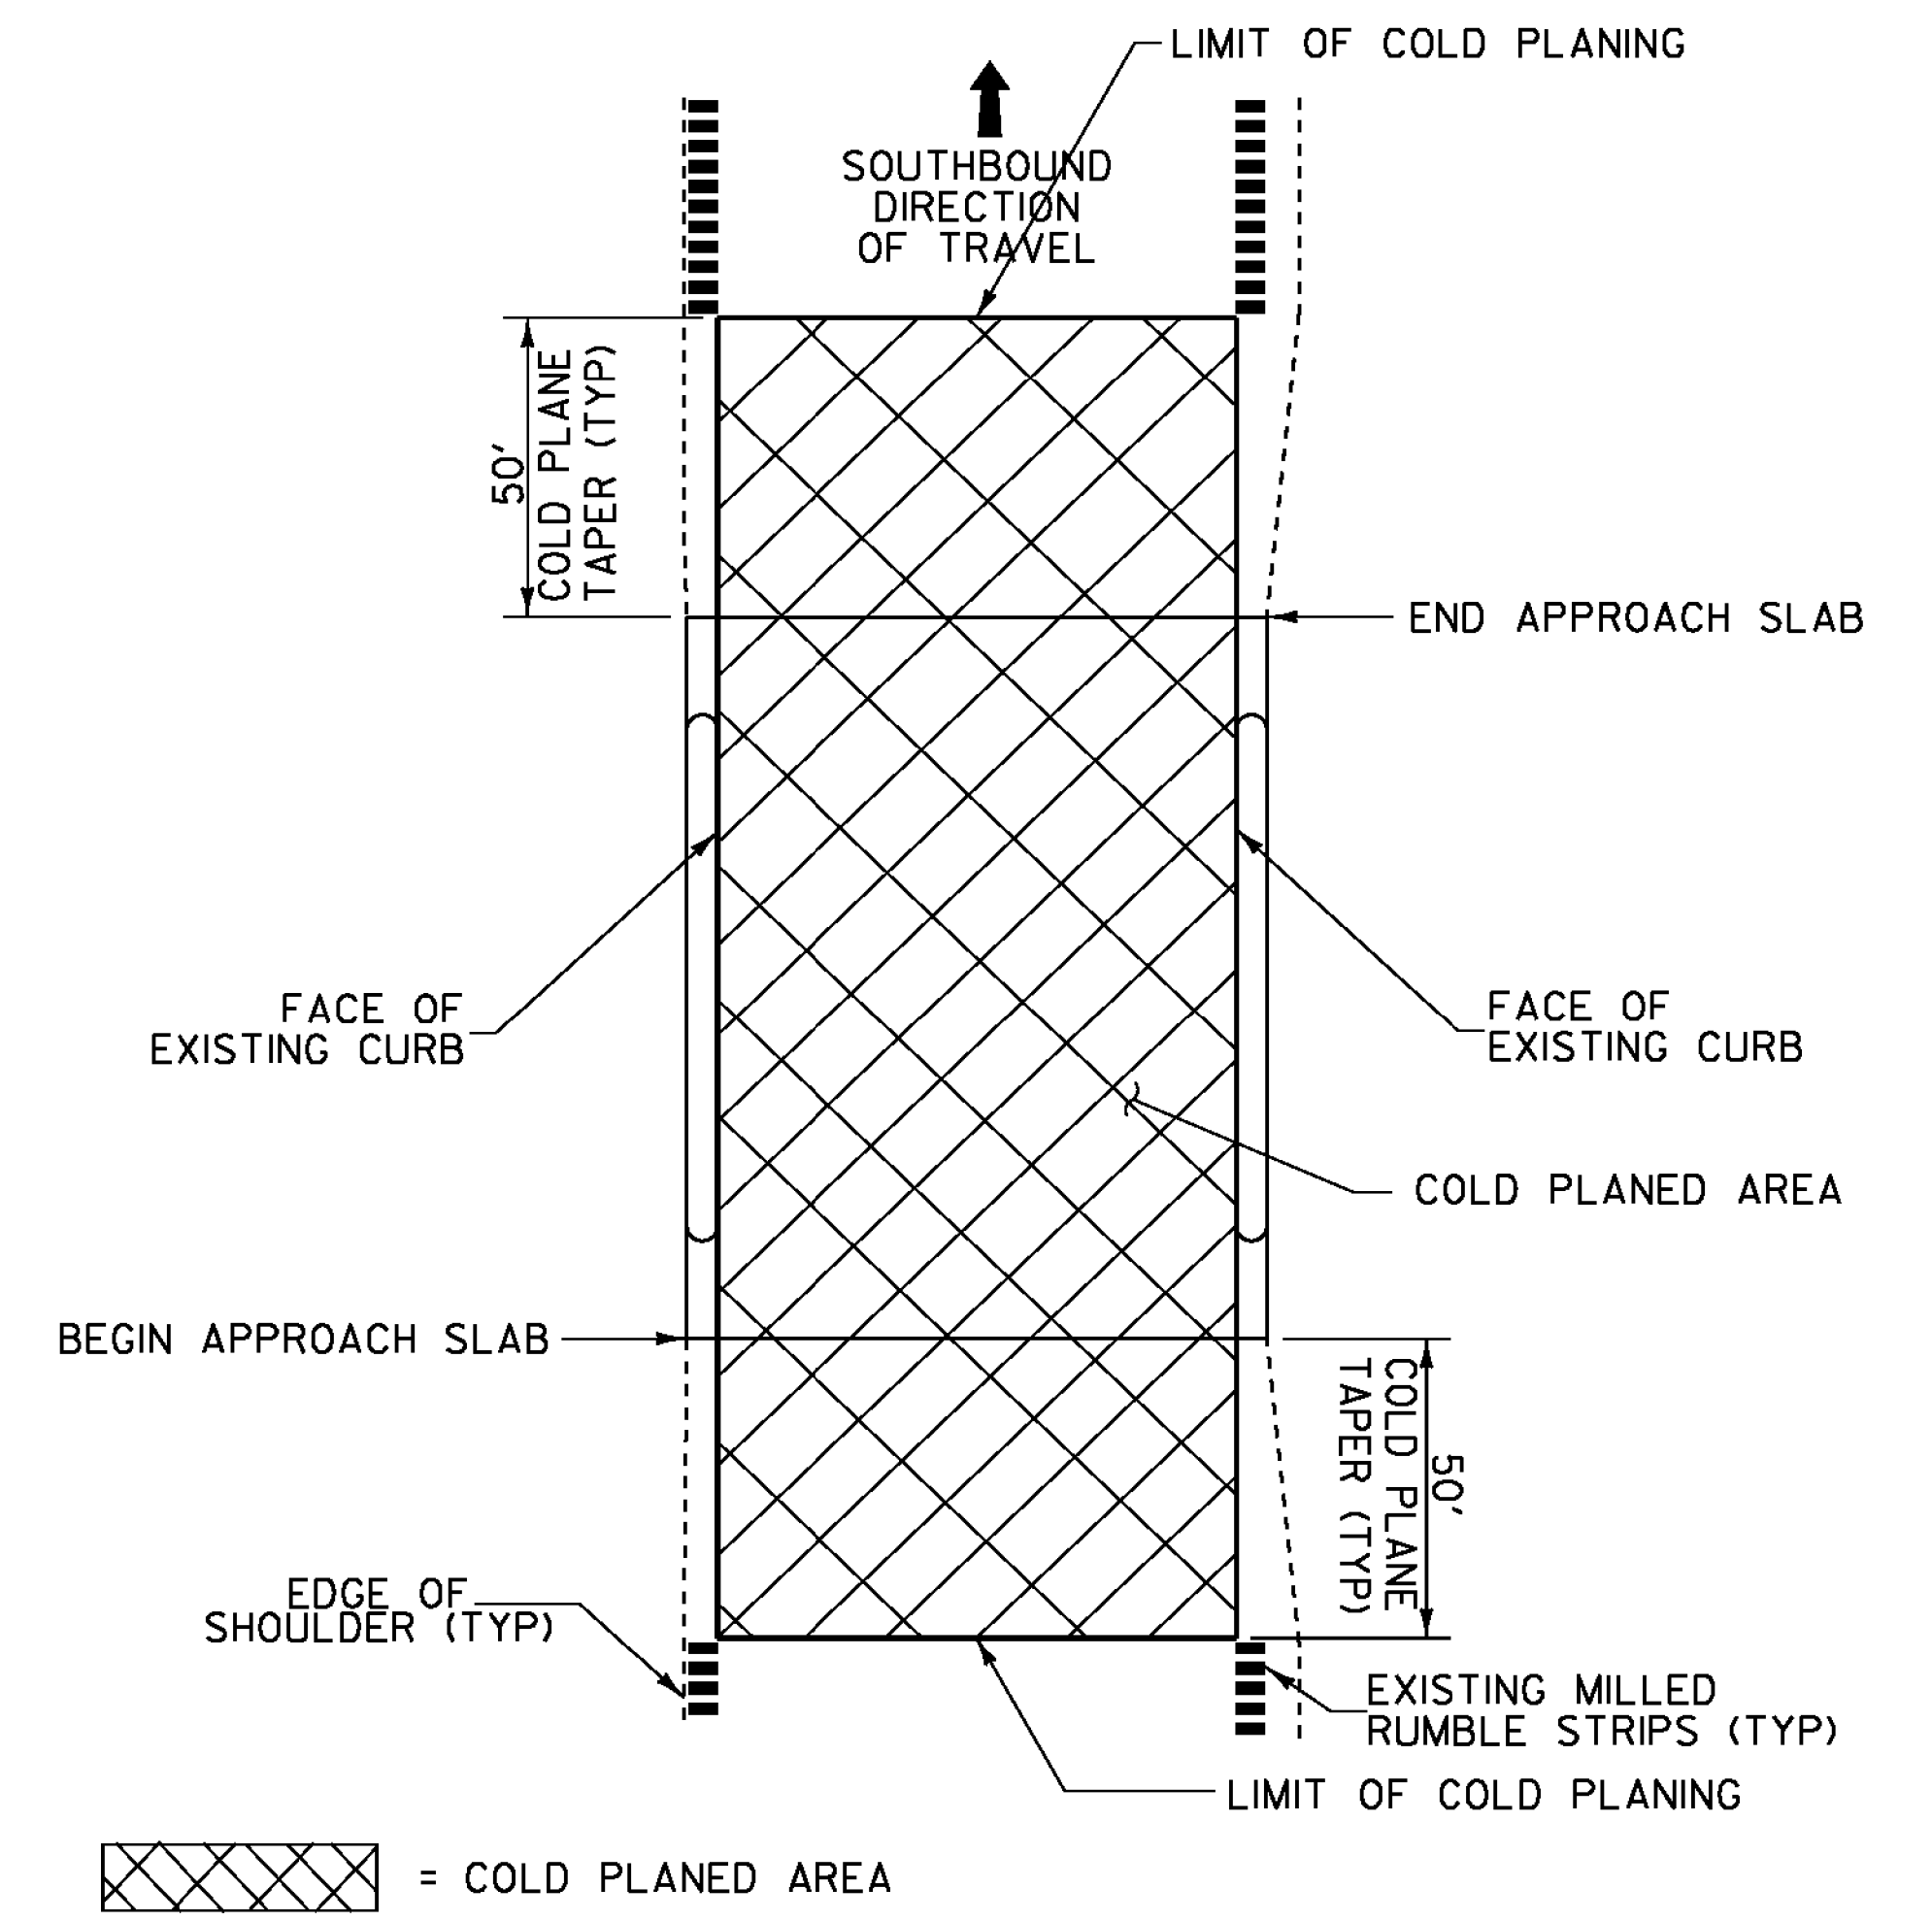


BRIDGE COLD PLANE TYPICAL PLAN

NOTES:

1. THE CONTRACTOR SHALL TAKE PRECAUTIONS TO AVOID DAMAGING DRAINAGE STRUCTURES AND EXPANSION JOINTS. ANY DAMAGE CAUSED BY THE CONTRACTOR SHALL BE REPAIRED BY THE CONTRACTOR AT THE SOLE EXPENSE OF THE CONTRACTOR.
2. THE CONTRACTOR SHALL TAKE PRECAUTIONS TO AVOID THE ACCUMULATION OF DEBRIS IN THE DRAINAGE STRUCTURES LOCATED AT CURB LINE AND IN THE EXPANSION JOINTS. THE CONTRACTOR SHALL EXAMINE THESE BRIDGE FEATURES ON A DAILY BASIS TO ENSURE THAT DEBRIS HAS NOT ACCUMULATED. ANY DEBRIS WHICH IS PRESENT SHALL BE REMOVED BY THE CONTRACTOR AT NO COST TO THE STATE.

NOT TO SCALE

BRIDGE DETAIL SHEET # 1	PROJECT NAME: NORWICH - BRADFORD	
	PROJECT NUMBER: IM SURF (31)	
FILE NAME: /pave/lla030/plla030.dgn	PLOT DATE: 07-FEB-2012	
PROJECT LEADER: MIKE FOWLER	DRAWN BY: WILDER	
DESIGNED BY: WILDER	CHECKED BY: PVMT MGMT	
IPARM FILE NAME: plla030_05.i	SHEET 5 OF 19	

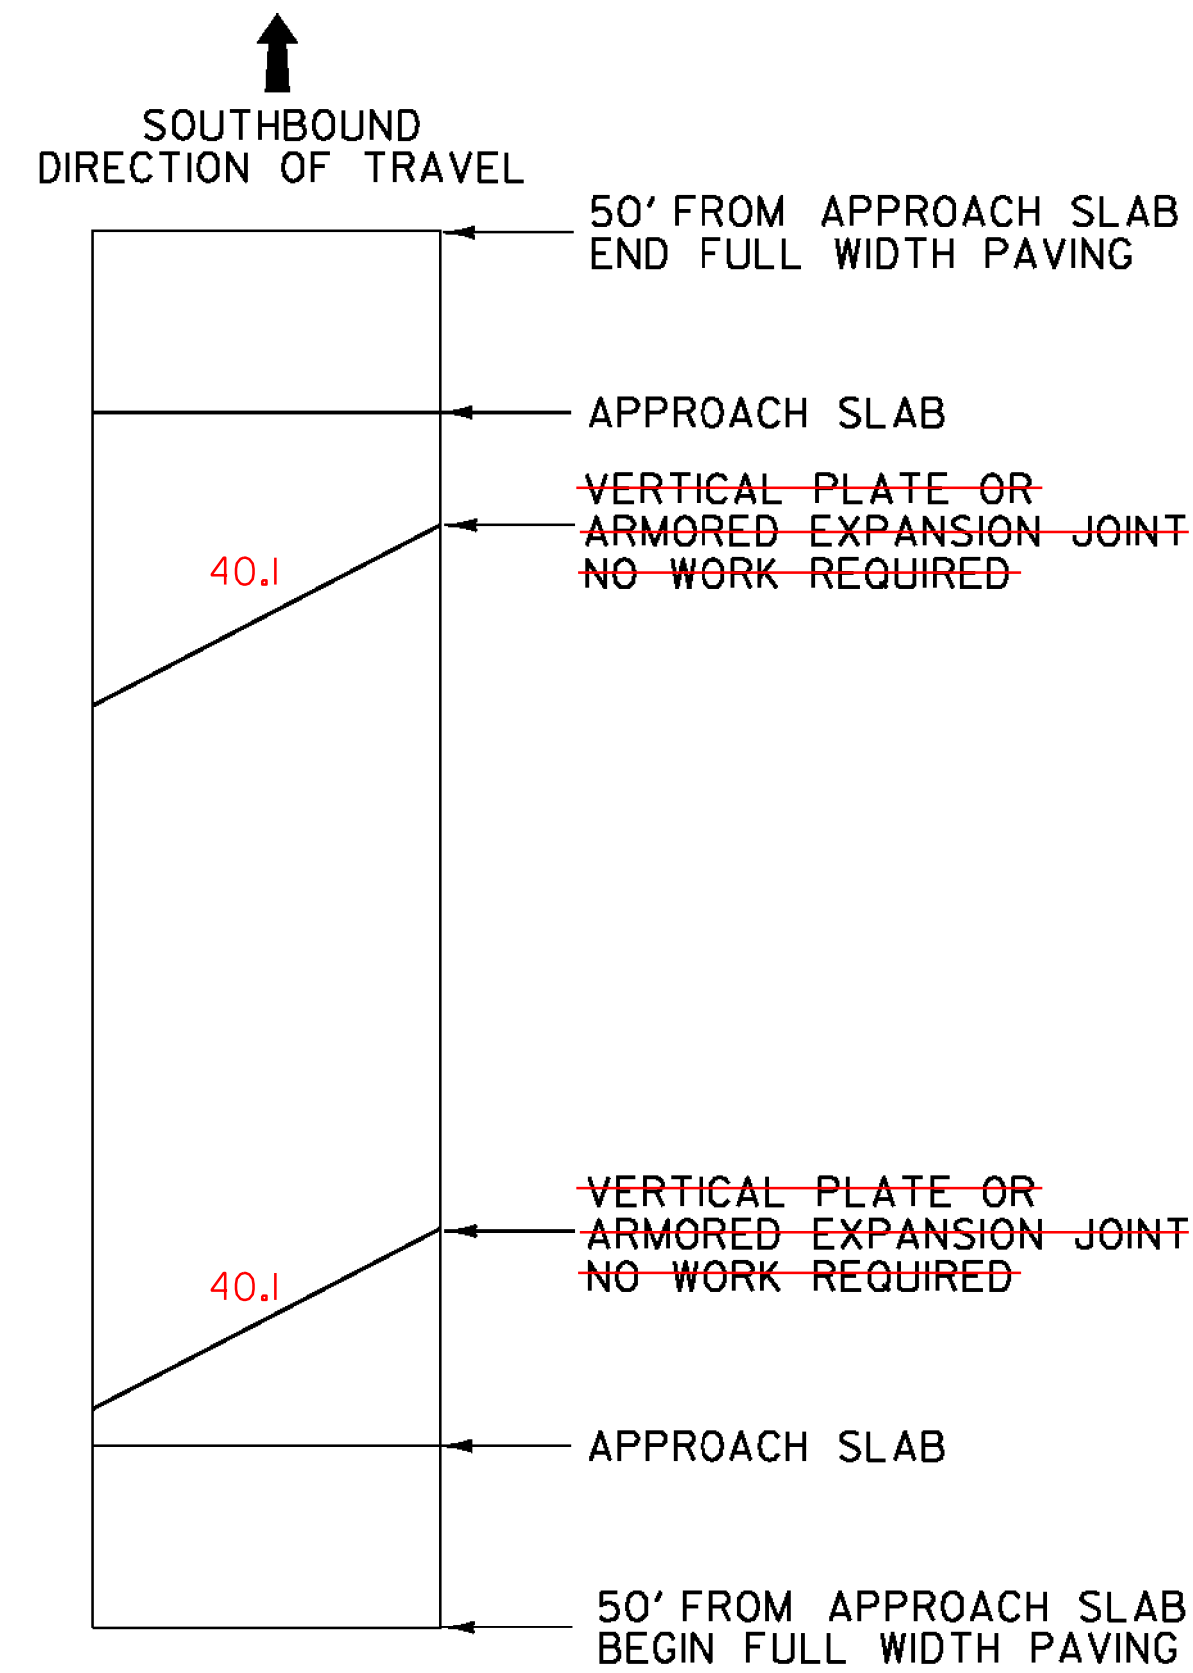


BRIDGE 56S

MM 91.539

LENGTH OF ASPHALTIC PLUG JOINTS:

TOTAL = 0' 80.2

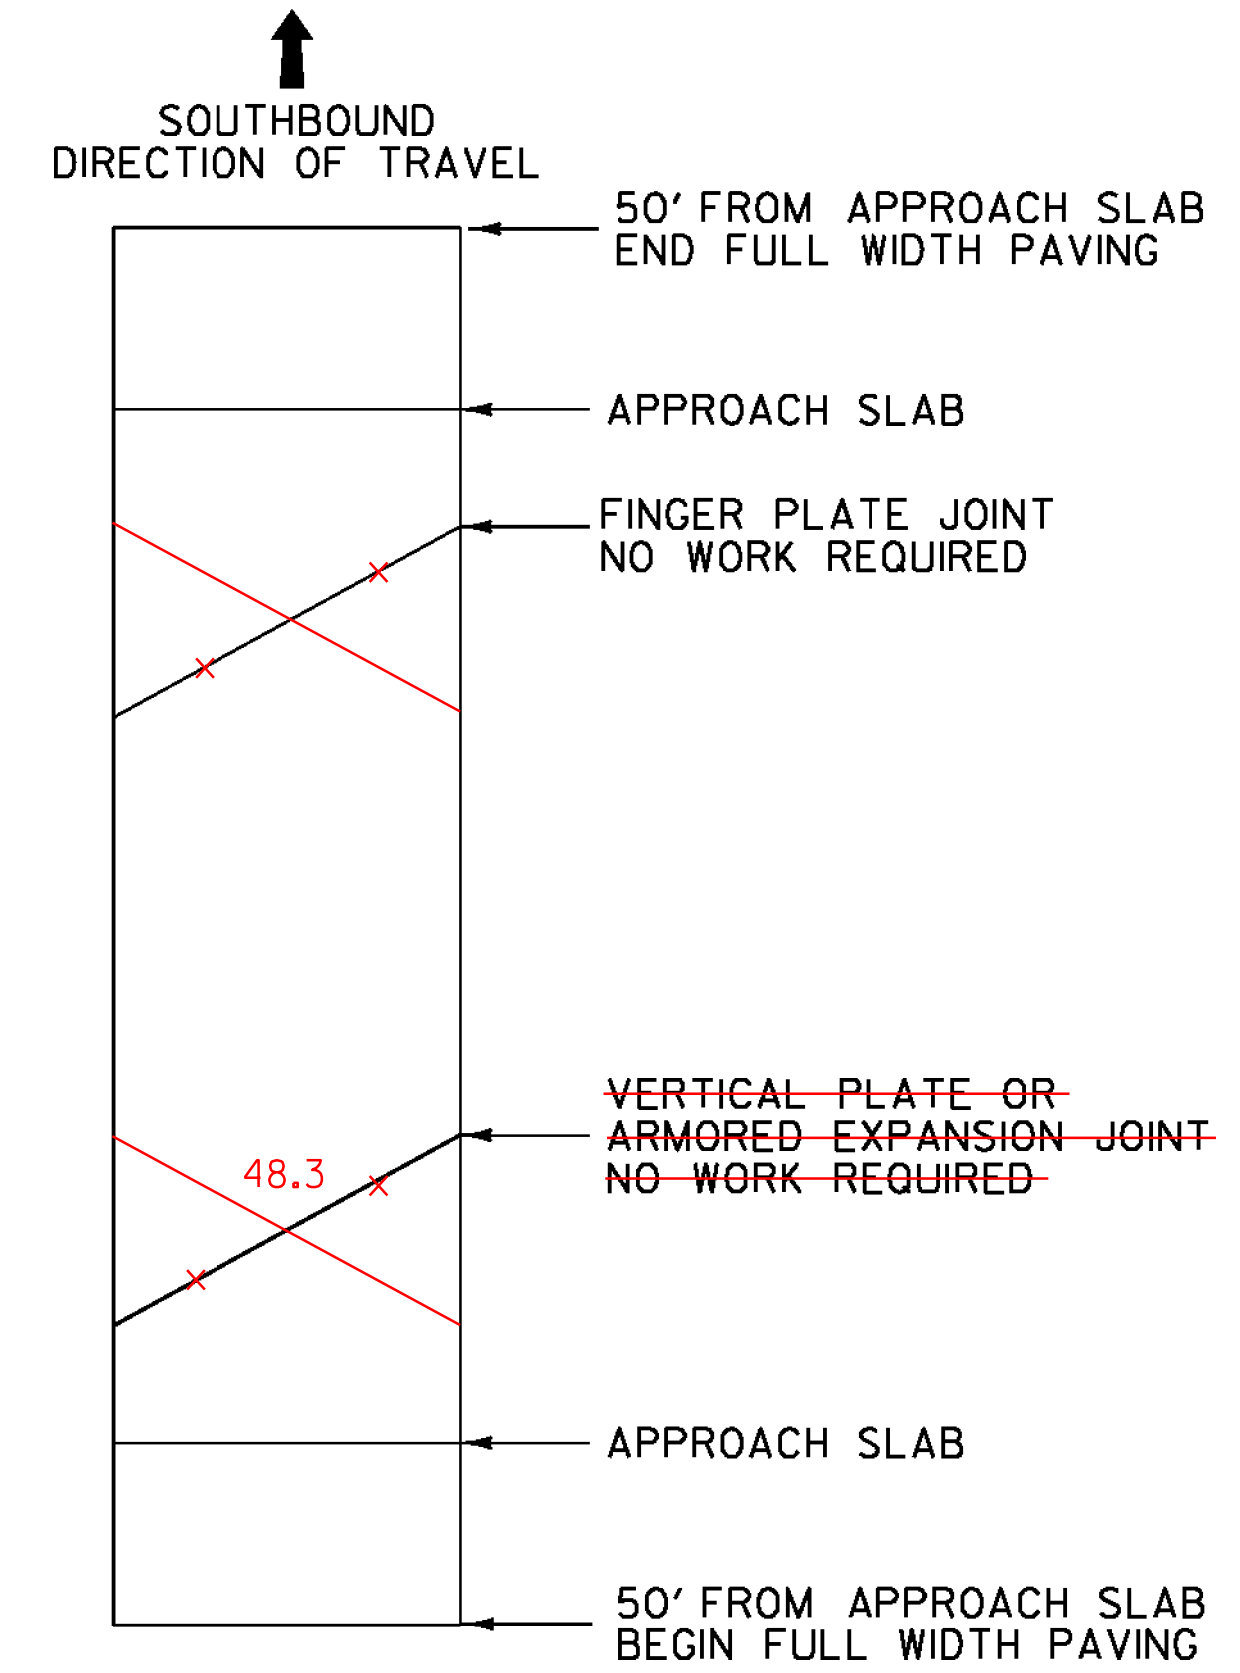

BRIDGE 58S

MM 97.243

LENGTH OF ASPHALTIC PLUG JOINTS:

TOTAL = 0' 48.3

NOT TO SCALE

**BRIDGE
DETAIL SHEET
2**

PROJECT NAME: NORWICH - BRADFORD
PROJECT NUMBER: IM SURF (31)

FILE NAME: /pave/lla030/plla030.dgn	PLOT DATE: 06-FEB-2012
PROJECT LEADER: MIKE FOWLER	DRAWN BY: WILDER
DESIGNED BY: WILDER	CHECKED BY: PVMT MGMT
IPARM FILE NAME: plla030_06.i	SHEET 6 OF 19

QUANTITY SHEET

**STATE OF VERMONT
AGENCY OF TRANSPORTATION**


SUMMARY OF ESTIMATED QUANTITIES							
BRIDGE	ROADWAY	FULL C.E.	QUANTITIES GRAND TOTAL	UNIT	ITEMS	ITEM NO.	ROUNDING
					BEGIN ITEMS COMMON TO ALL ALTERNATES		
	16,000		16,000	LF	SHOULDER BERM REMOVAL	203.40	EST
	1		1	CY	TRENCH EXCAVATION OF EARTH, EXPLORATORY (N.A.B.I.)	204.22	-
	7,500		7,500	SY	COLD PLANING, BITUMINOUS PAVEMENT	210.10	136
	350		350	TON	AGGREGATE SHOULDERS	402.12	70
	1		1	LU	PRICE ADJUSTMENT, ASPHALT CEMENT (N.A.B.I.)	406.50	-
	59,200		59,200	LB	BITUMINOUS CRACK SEALING, "BLOW AND GO" METHOD (AASHTO M 324 (ASTM D 6690) TYPE II)	417.20	EST
					▲		
	120		120	HR	POWER BROOM RENTAL, TYPE I	608.30	EST
	600		600	HR	UNIFORMED TRAFFIC OFFICERS	630.10	EST
	350		350	HR	FLAGGERS	630.15	EST
		1	1	LS	TESTING EQUIPMENT, BITUMINOUS	631.17	-
		1	1	LS	MOBILIZATION/DEMOBILIZATION	635.11	-
		1	1	LS	TRAFFIC CONTROL	641.10	-
	4		4	EA	PORTABLE CHANGEABLE MESSAGE SIGN	641.15	-
	312,000		312,000	LF	6 INCH WHITE LINE	646.214	1,143
	242,500		242,500	LF	6 INCH YELLOW LINE	646.215	665
	5,600		5,600	LF	12 INCH WHITE LINE	646.24	174
	60		60	EA	LETTER OR SYMBOL	646.30	-
	157,000		157,000	LF	TEMPORARY 6 INCH WHITE LINE, PAINT	646.622	1571
	121,500		121,500	LF	TEMPORARY 6 INCH YELLOW LINE, PAINT	646.632	583
	2,500		2,500	LF	TEMPORARY 12 INCH WHITE LINE, PAINT	646.662	216
	30		30	EA	TEMPORARY LETTER OR SYMBOL, PAINT	646.692	EST
	9,500		9,500	EA	LINE STRIPING TARGETS	646.76	EST
	380,000		380,000	SF	REMOVAL OF EXISTING PAVEMENT MARKINGS	646.85	511.2
		1	1	LU	PRICE ADJUSTMENT, FUEL (N.A.B.I.)	690.50	-
	100		100	TON	SPECIAL PROVISION (BITUMINOUS CONCRETE PAVEMENT SURFACE PREPARATION, TYPE I)	900.680	EST
					END ITEMS COMMON TO ALL ALTERNATES		
					BEGIN ALTERNATE A		
	390,000		390,000	SY	SPECIAL PROVISION (PAVER PLACED SURFACE TREATMENT, TYPE C)	900.675	6,415
					END ALTERNATE A		
					BEGIN ALTERNATE B		
		1	1	LU	AIR VOIDS PAY ADJUSTMENT (N.A.B.I.)	490.31	-
	23,000		23,000	TON	SPECIAL PROVISION (6.3 MM POLYMER MODIFIED BITUMINOUS CONCRETE PAVEMENT) (SBR OR SBS POLYMER)	900.680	424
	2,600		2,600	CWT	SPECIAL PROVISION (EMULSIFIED ASPHALT) (RS-IH OR CRS-IH)	900.683	57
					END ALTERNATE B		

DETAILED SUMMARY OF QUANTITIES		
QUANTITIES	UNIT	ITEMS
		COLD PLANING, BITUMINOUS PAVEMENT
150	SY	BEGIN PROJECT
150	SY	END PROJECT
1490	SY	BRIDGE 51S & APPROACHES
1647	SY	BRIDGE 55S & APPROACHES
1140	SY	BRIDGE 56S & APPROACHES
1338	SY	BRIDGE 58S & APPROACHES
140	SY	EXIT 14, RAMP "C"
135	SY	EXIT 14, RAMP "A"
160	SY	EXIT 15, RAMP "C"
135	SY	EXIT 15, RAMP "A"
160	SY	EXIT 16, RAMP "C"
160	SY	EXIT 16, RAMP "D"
559	SY	U-TURNS
7364	SY	SUBTOTAL
136	SY	ROUNDING
7,500	SY	TOTAL
		ALTERNATE A
		SPECIAL PROVISION (PAVER-PLACED SURFACE TREATMENT, TYPE C)
348,274	SY	MAINLINE
4,907	SY	EXIT 14, RAMP "A"
5,308	SY	EXIT 14, RAMP "C"
5,696	SY	EXIT 15, RAMP "A"
2,789	SY	EXIT 15, RAMP "C"
3,510	SY	EXIT 16, RAMP "C"
7,486	SY	EXIT 16, RAMP "D"
1,490	SY	BRIDGE 51S & APPROACHES
1,647	SY	BRIDGE 55S & APPROACHES
1,140	SY	BRIDGE 56S & APPROACHES
1,338	SY	BRIDGE 58S & APPROACHES
383,585	SY	TOTAL
6,415	SY	ROUNDING
390,000	SY	GRAND TOTAL
		ALTERNATE B
		SPECIAL PROVISION (6.3 MM POLYMER MODIFIED BITUMINOUS CONCRETE PAVEMENT) (SBR OR SBS POLYMER)
20,774	TON	MAINLINE
285	TON	EXIT 14, RAMP "A"
257	TON	EXIT 14, RAMP "C"
331	TON	EXIT 15, RAMP "A"
162	TON	EXIT 15, RAMP "C"
204	TON	EXIT 16, RAMP "C"
236	TON	EXIT 16, RAMP "D"
87	TON	BRIDGE 51S & APPROACHES
96	TON	BRIDGE 55S & APPROACHES
66	TON	BRIDGE 56S & APPROACHES
78	TON	BRIDGE 58S & APPROACHES
22,576	TON	TOTAL
424	TON	ROUNDING
23,000	TON	GRAND TOTAL


DETAILED SUMMARY OF QUANTITIES		
QUANTITIES	UNIT	ITEMS
		AGGREGATE SHOULDERS
54	TON	EXIT 14, RAMP "A"
50	TON	EXIT 14, RAMP "C"
44	TON	EXIT 15, RAMP "A"
30	TON	EXIT 15, RAMP "C"
27	TON	EXIT 16, RAMP "C"
75	TON	EXIT 16, RAMP "D"
280	TON	TOTAL
70	TON	ROUNDING
350	TON	GRAND TOTAL

REVISION BY DATE ▲ LSW 03/19/12	DELETED ITEM 580.20 RAPID SETTING CONCRETE REPAIR MATERIAL WITH COARSE AGGREGATE.
PROJECT NAME: NORWICH - BRADFORD PROJECT NUMBER: IM SURF (31)	
FILE NAME: /pave/11a030/plla030.dgn PROJECT LEADER: FOWLER DESIGNED BY: WILDER IPARM FILE NAME: plla030_07.1	PLOT DATE: 20-MAR-2012 DRAWN BY: WILDER CHECKED BY: PVMT MGMT SHEET 7 OF 19


TYPICAL PAVEMENT MARKINGS

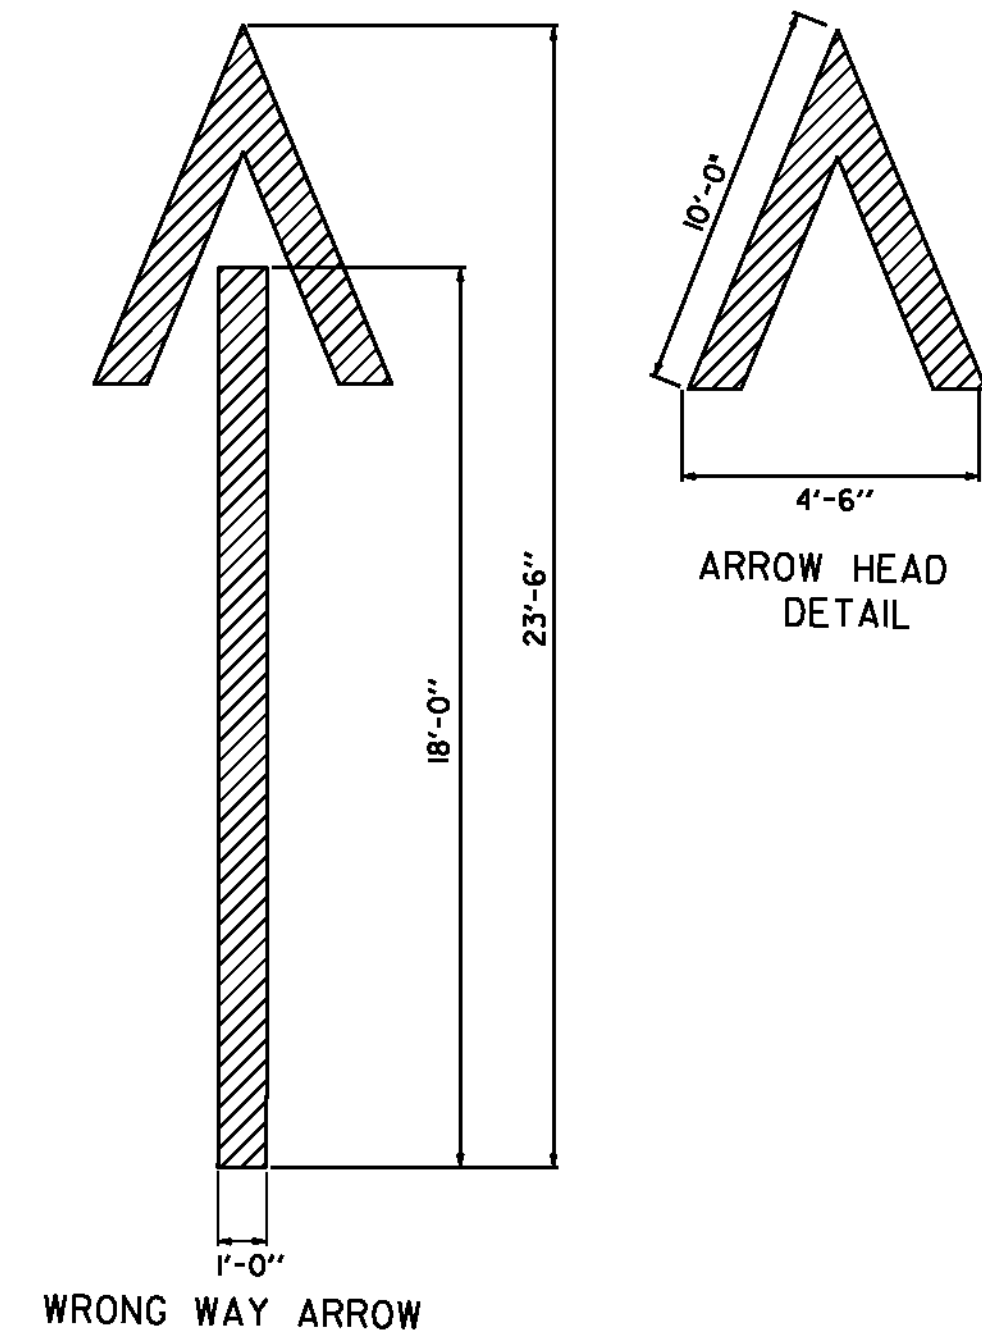


WRONG WAY ARROW DETAIL

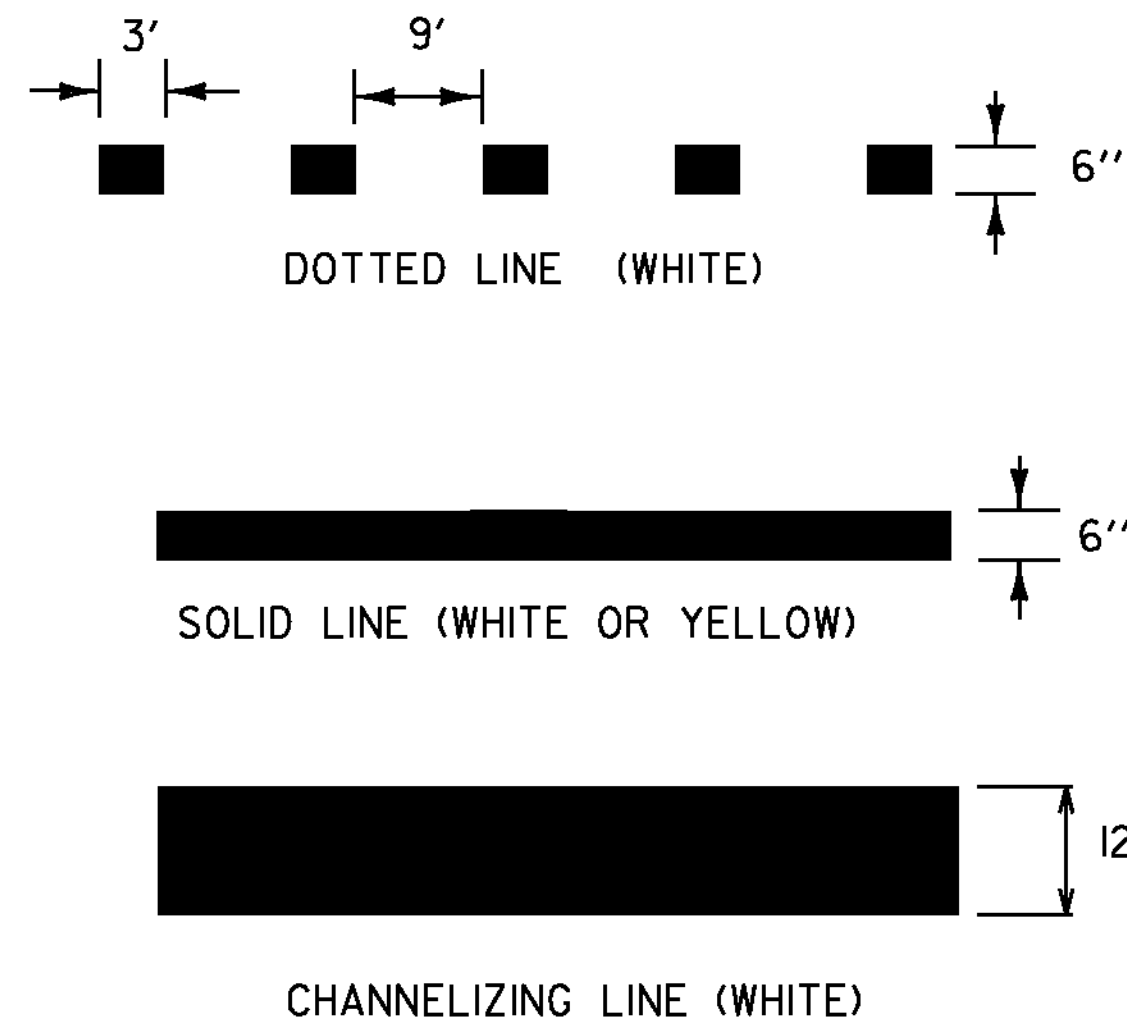

PAVEMENT MARKING LINE DETAILS

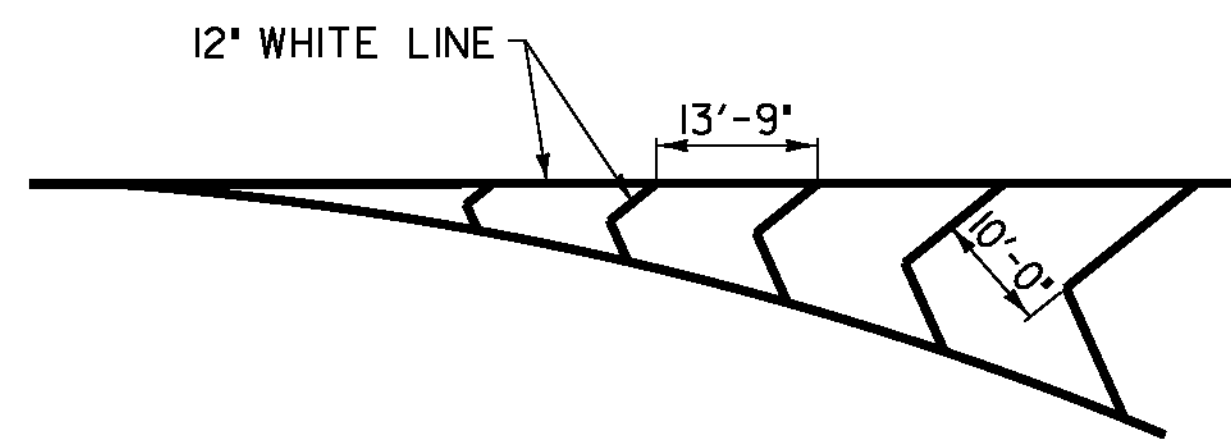

GORE MARKING DETAIL

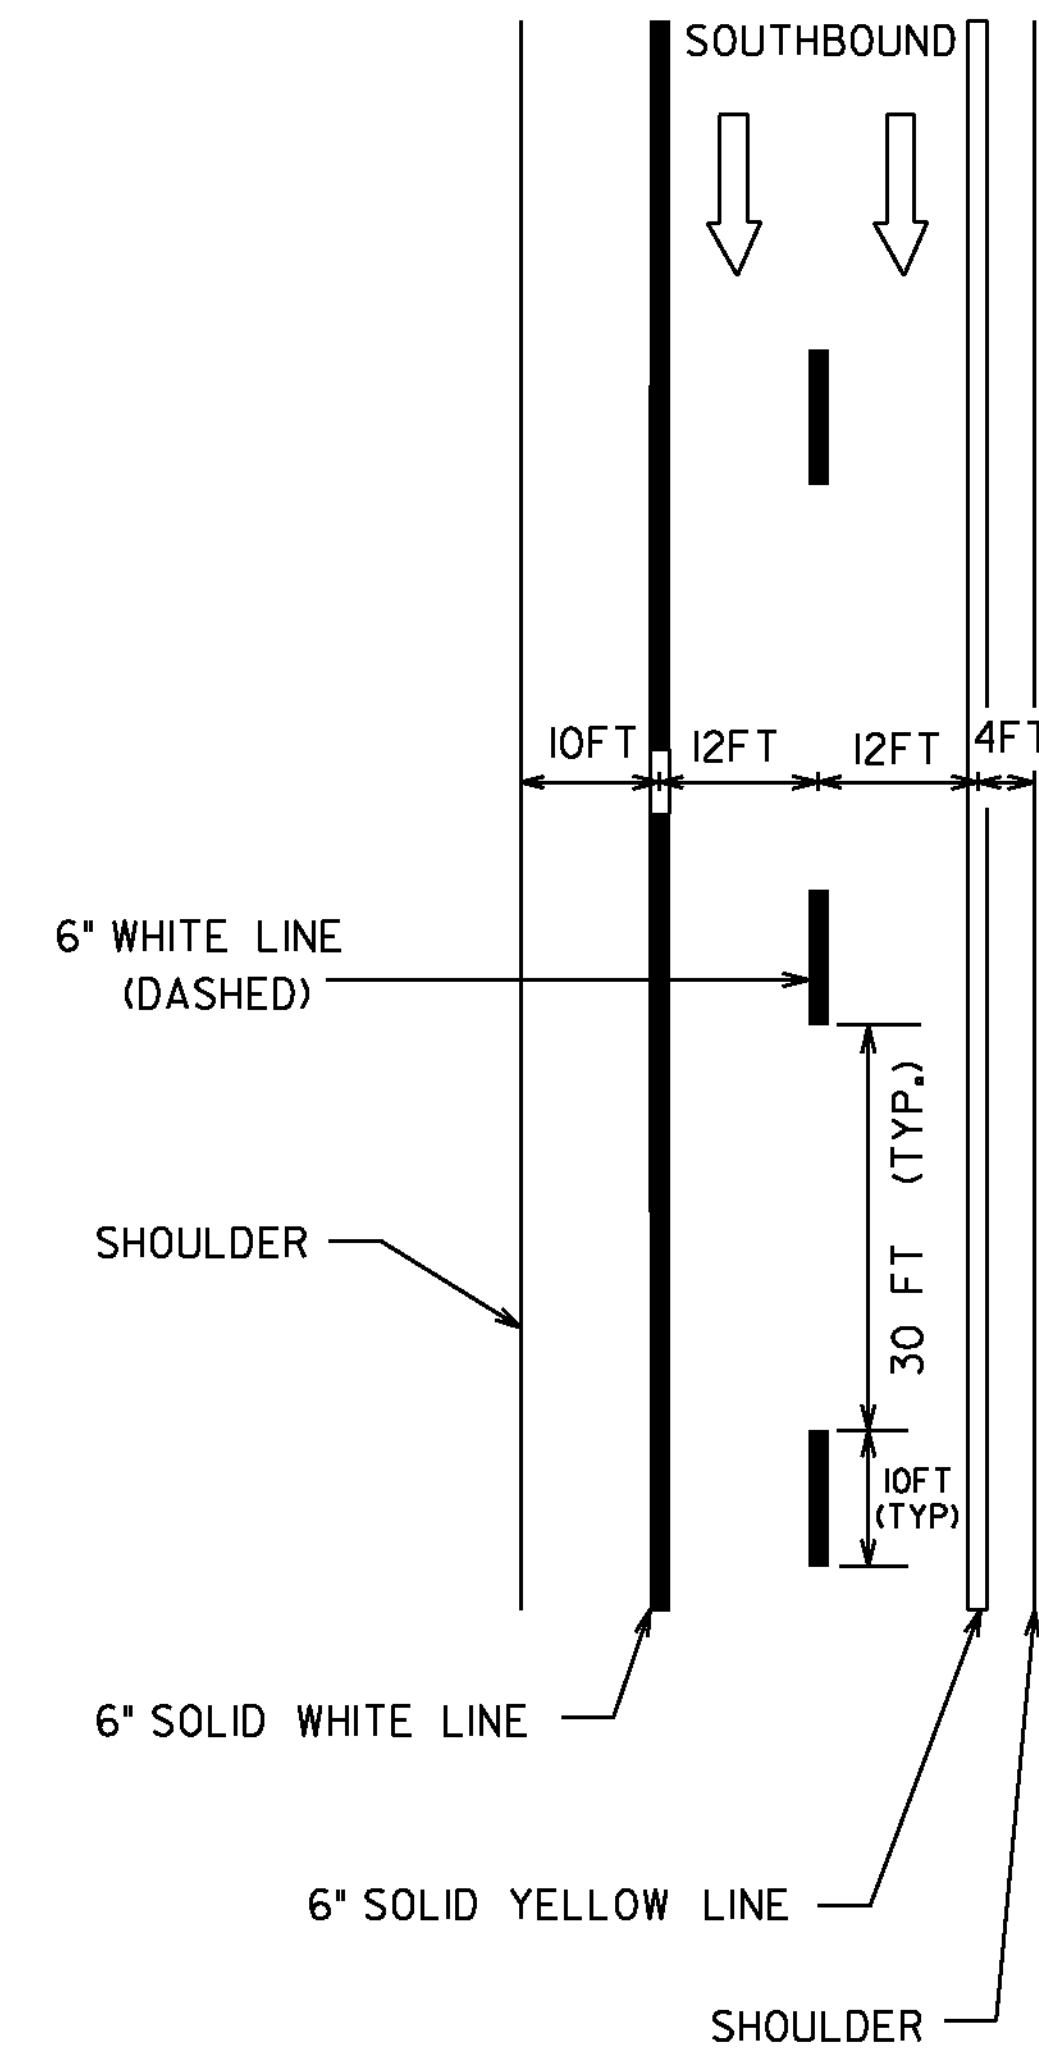

TYPICAL MAINLINE MARKING PLAN

LEGEND



NOTES:

1. TWO (2) APPLICATIONS OF FINAL PAVEMENT MARKINGS WILL BE REQUIRED. SEE SPECIAL PROVISIONS FOR COMPLETION DATE REQUIREMENTS.




NOT TO SCALE

PAVEMENT MARKING DETAIL SHEET	PROJECT NAME: NORWICH - BRADFORD
	PROJECT NUMBER: IM SURF (3I)
	FILE NAME: /pave/11a030/plla030.dgn
	PLOT DATE: 22-FEB-2012
PROJECT LEADER: MIKE FOWLER	DRAWN BY: WILDER
DESIGNED BY: WILDER	CHECKED BY: PVMT MGMT
IPARM FILE NAME: plla030_08.l	SHEET 8 OF 19

**INTERSTATE ROUTE 91 SB
(MM 76.443)
BEGIN PROJECT
IM SURF (31)**

6" WHITE LINE
M.M. 76.443 - M.M. 98.43 SB (SOLID RT)
M.M. 76.443 - M.M. 98.43 SB (DASH)
6" YELLOW LINE
M.M. 76.443 - M.M. 98.43 SB (SOLID LT)
TEMPORARY 6" WHITE LINE, PAINT
M.M. 76.443 - M.M. 98.43 SB (SOLID RT)
M.M. 76.443 - M.M. 98.43 SB (DASH)
TEMPORARY 6" YELLOW LINE, PAINT
M.M. 76.443 - M.M. 98.43 SB (SOLID LT)

**INTERSTATE ROUTE 91 SB
(MM 98.430)
END PROJECT
IM SURF (31)**

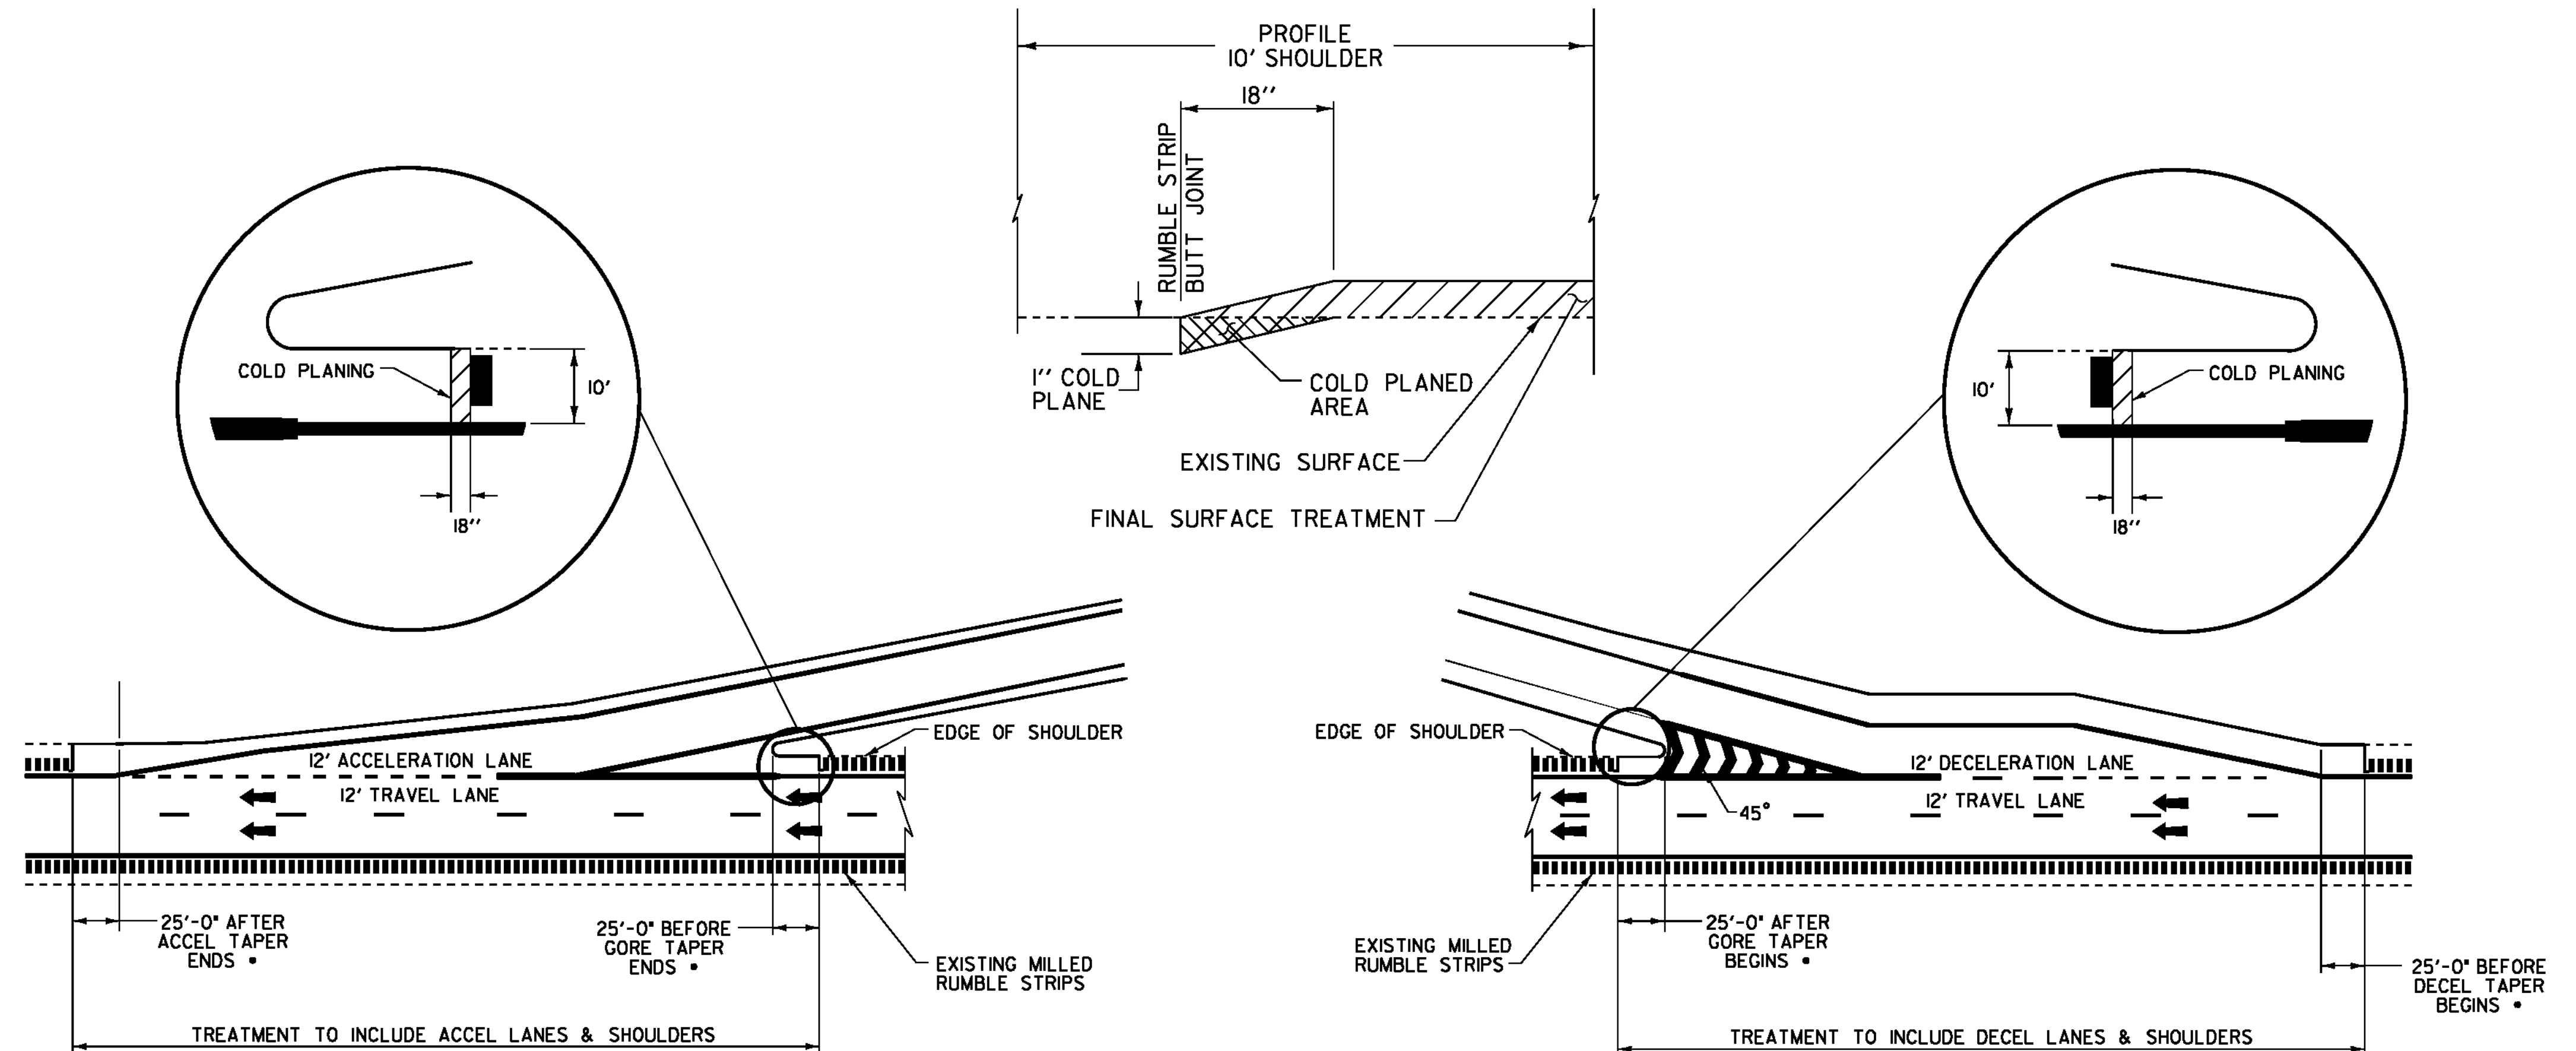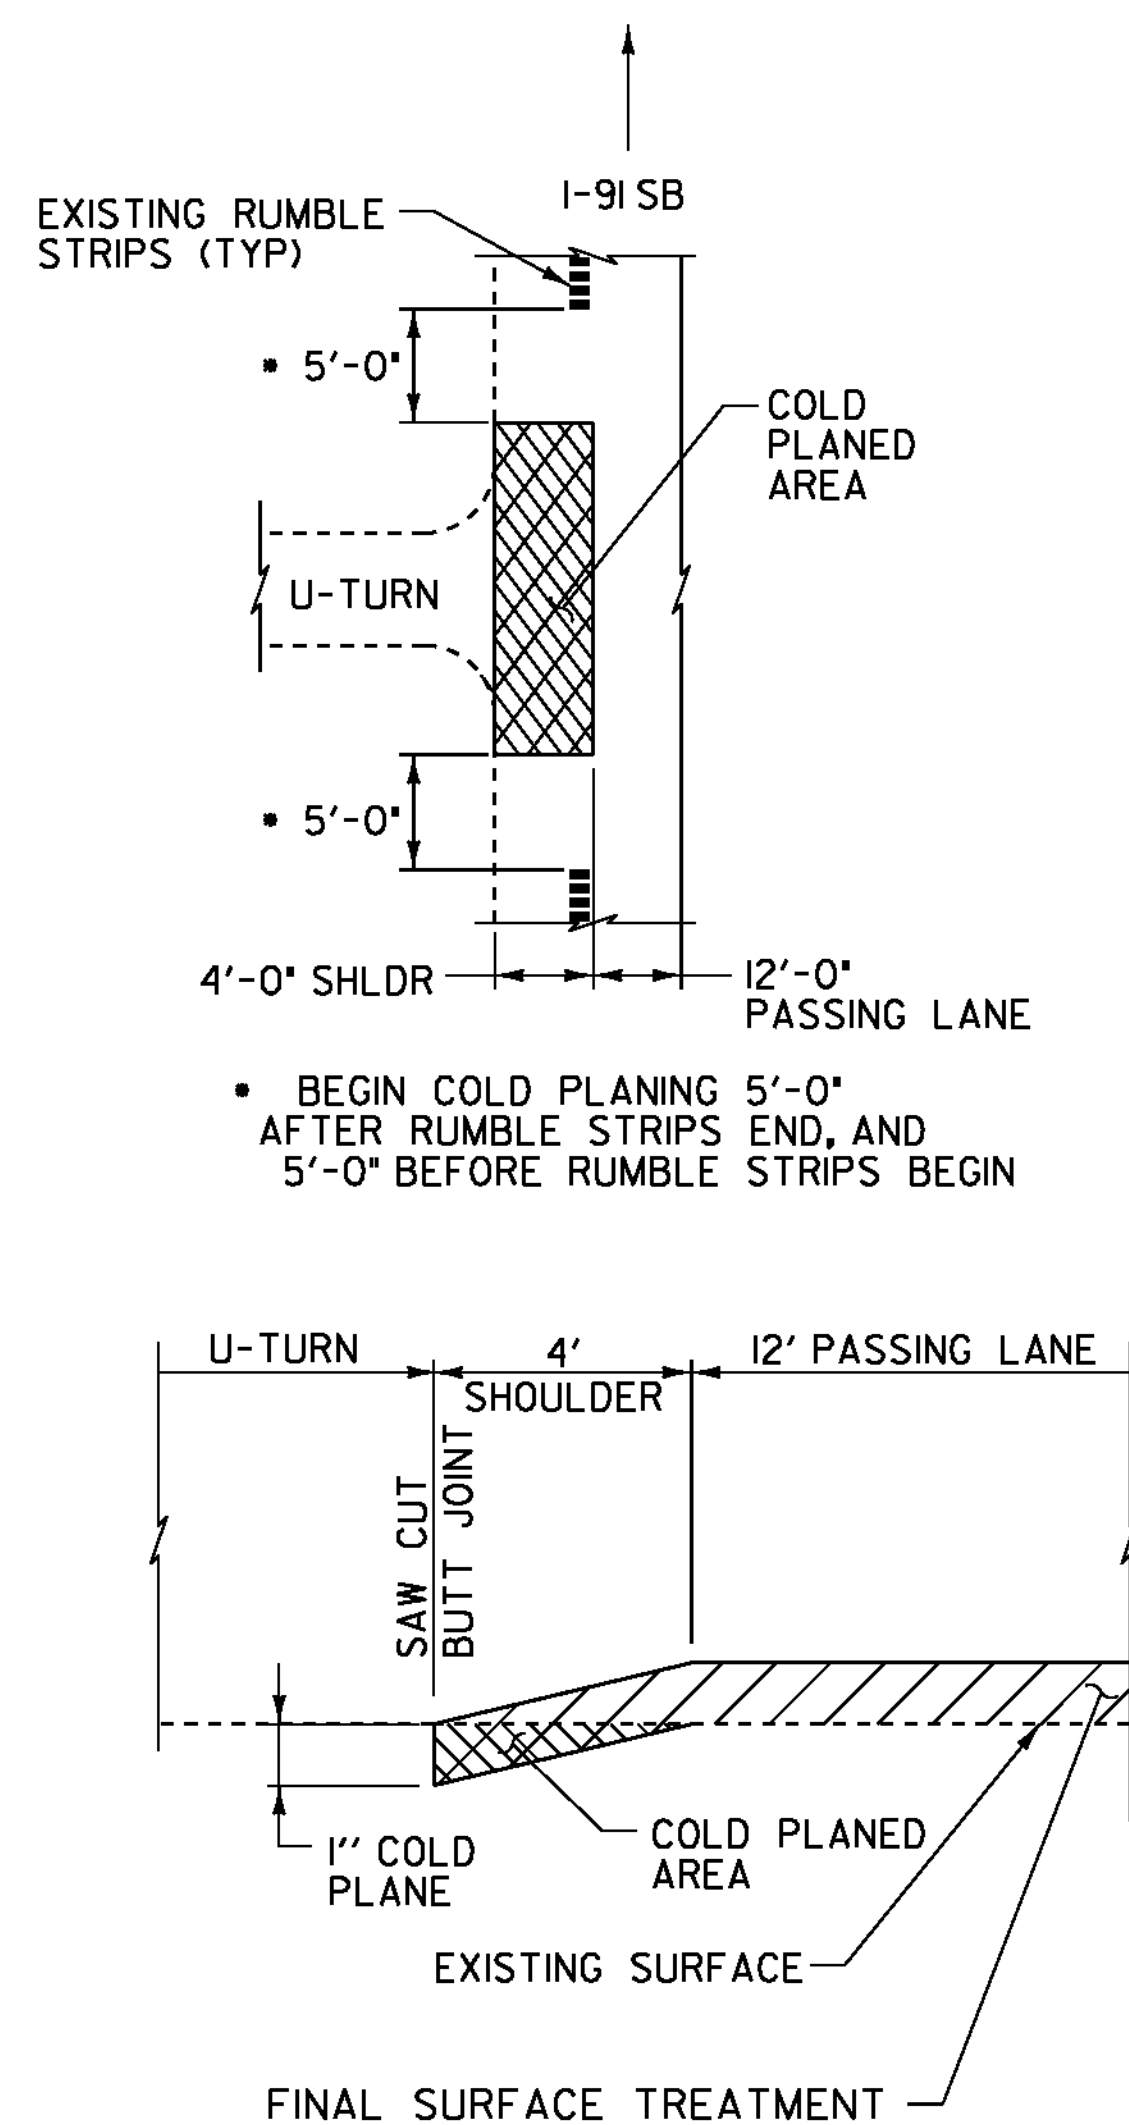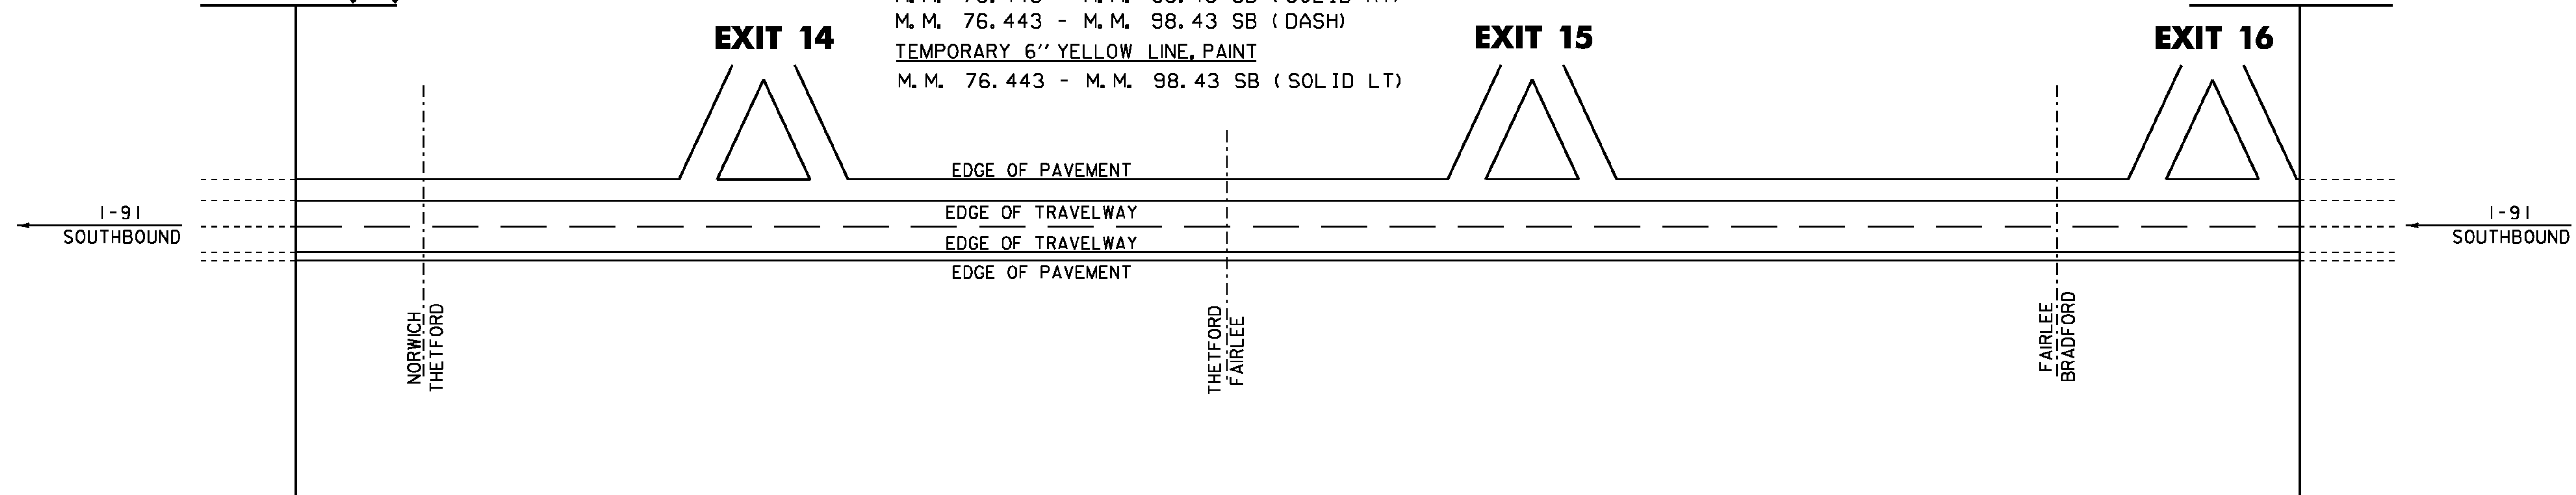

RAMP CONSTRUCTION DETAILS
• TO BE USED AS DIRECTED BY THE ENGINEER

NOT TO SCALE

MAINLINE PAVEMENT MARKING SHEET	PROJECT NAME: NORWICH - BRADFORD	
	PROJECT NUMBER: IM SURF (31)	
	FILE NAME: /pave/lla030/plla030.dgn	PLOT DATE: 06-FEB-2012
	PROJECT MANAGER: MIKE FOWLER	DRAWN BY: WILDER
DESIGNED BY: WILDER	CHECKED BY: PVMT MGMT	
IPARM FILE NAME: plla030_09.i	SHEET 9 OF 19	

6 INCH WHITE LINE
 RAMP "A" 1,850' (SOLID)
 RAMP "A" 135' (DOTTED)
 RAMP "C" 1,600' (SOLID)
 RAMP "C" 95' (DOTTED)

6 INCH YELLOW LINE
 RAMP "A" 1,045' (SOLID)
 RAMP "C" 1,075' (SOLID)

12 INCH WHITE LINE
 RAMP "A" 475' (SOLID)
 RAMP "C" 300' (SOLID)
 RAMP "C" 115' (DIAGONALS)


LETTER OR SYMBOL
 RAMP "C" 10 EA (S,T,O,P) (A,H,E,A,D)

TEMPORARY 6 INCH WHITE LINE, PAINT
 RAMP "A" 1,850' (SOLID)
 RAMP "A" 135' (DOTTED)
 RAMP "C" 1,600' (SOLID)
 RAMP "C" 95' (DOTTED)

TEMPORARY 6 INCH YELLOW LINE, PAINT
 RAMP "A" 1,045' (SOLID)
 RAMP "C" 1,075' (SOLID)

TEMPORARY 12 INCH WHITE LINE, PAINT
 RAMP "A" 475' (SOLID)
 RAMP "C" 300' (SOLID)
 RAMP "C" 115' (DIAGONALS)

TEMPORARY LETTER OR SYMBOL, PAINT
 RAMP "C" 10 EA (S,T,O,P) (A,H,E,A,D)

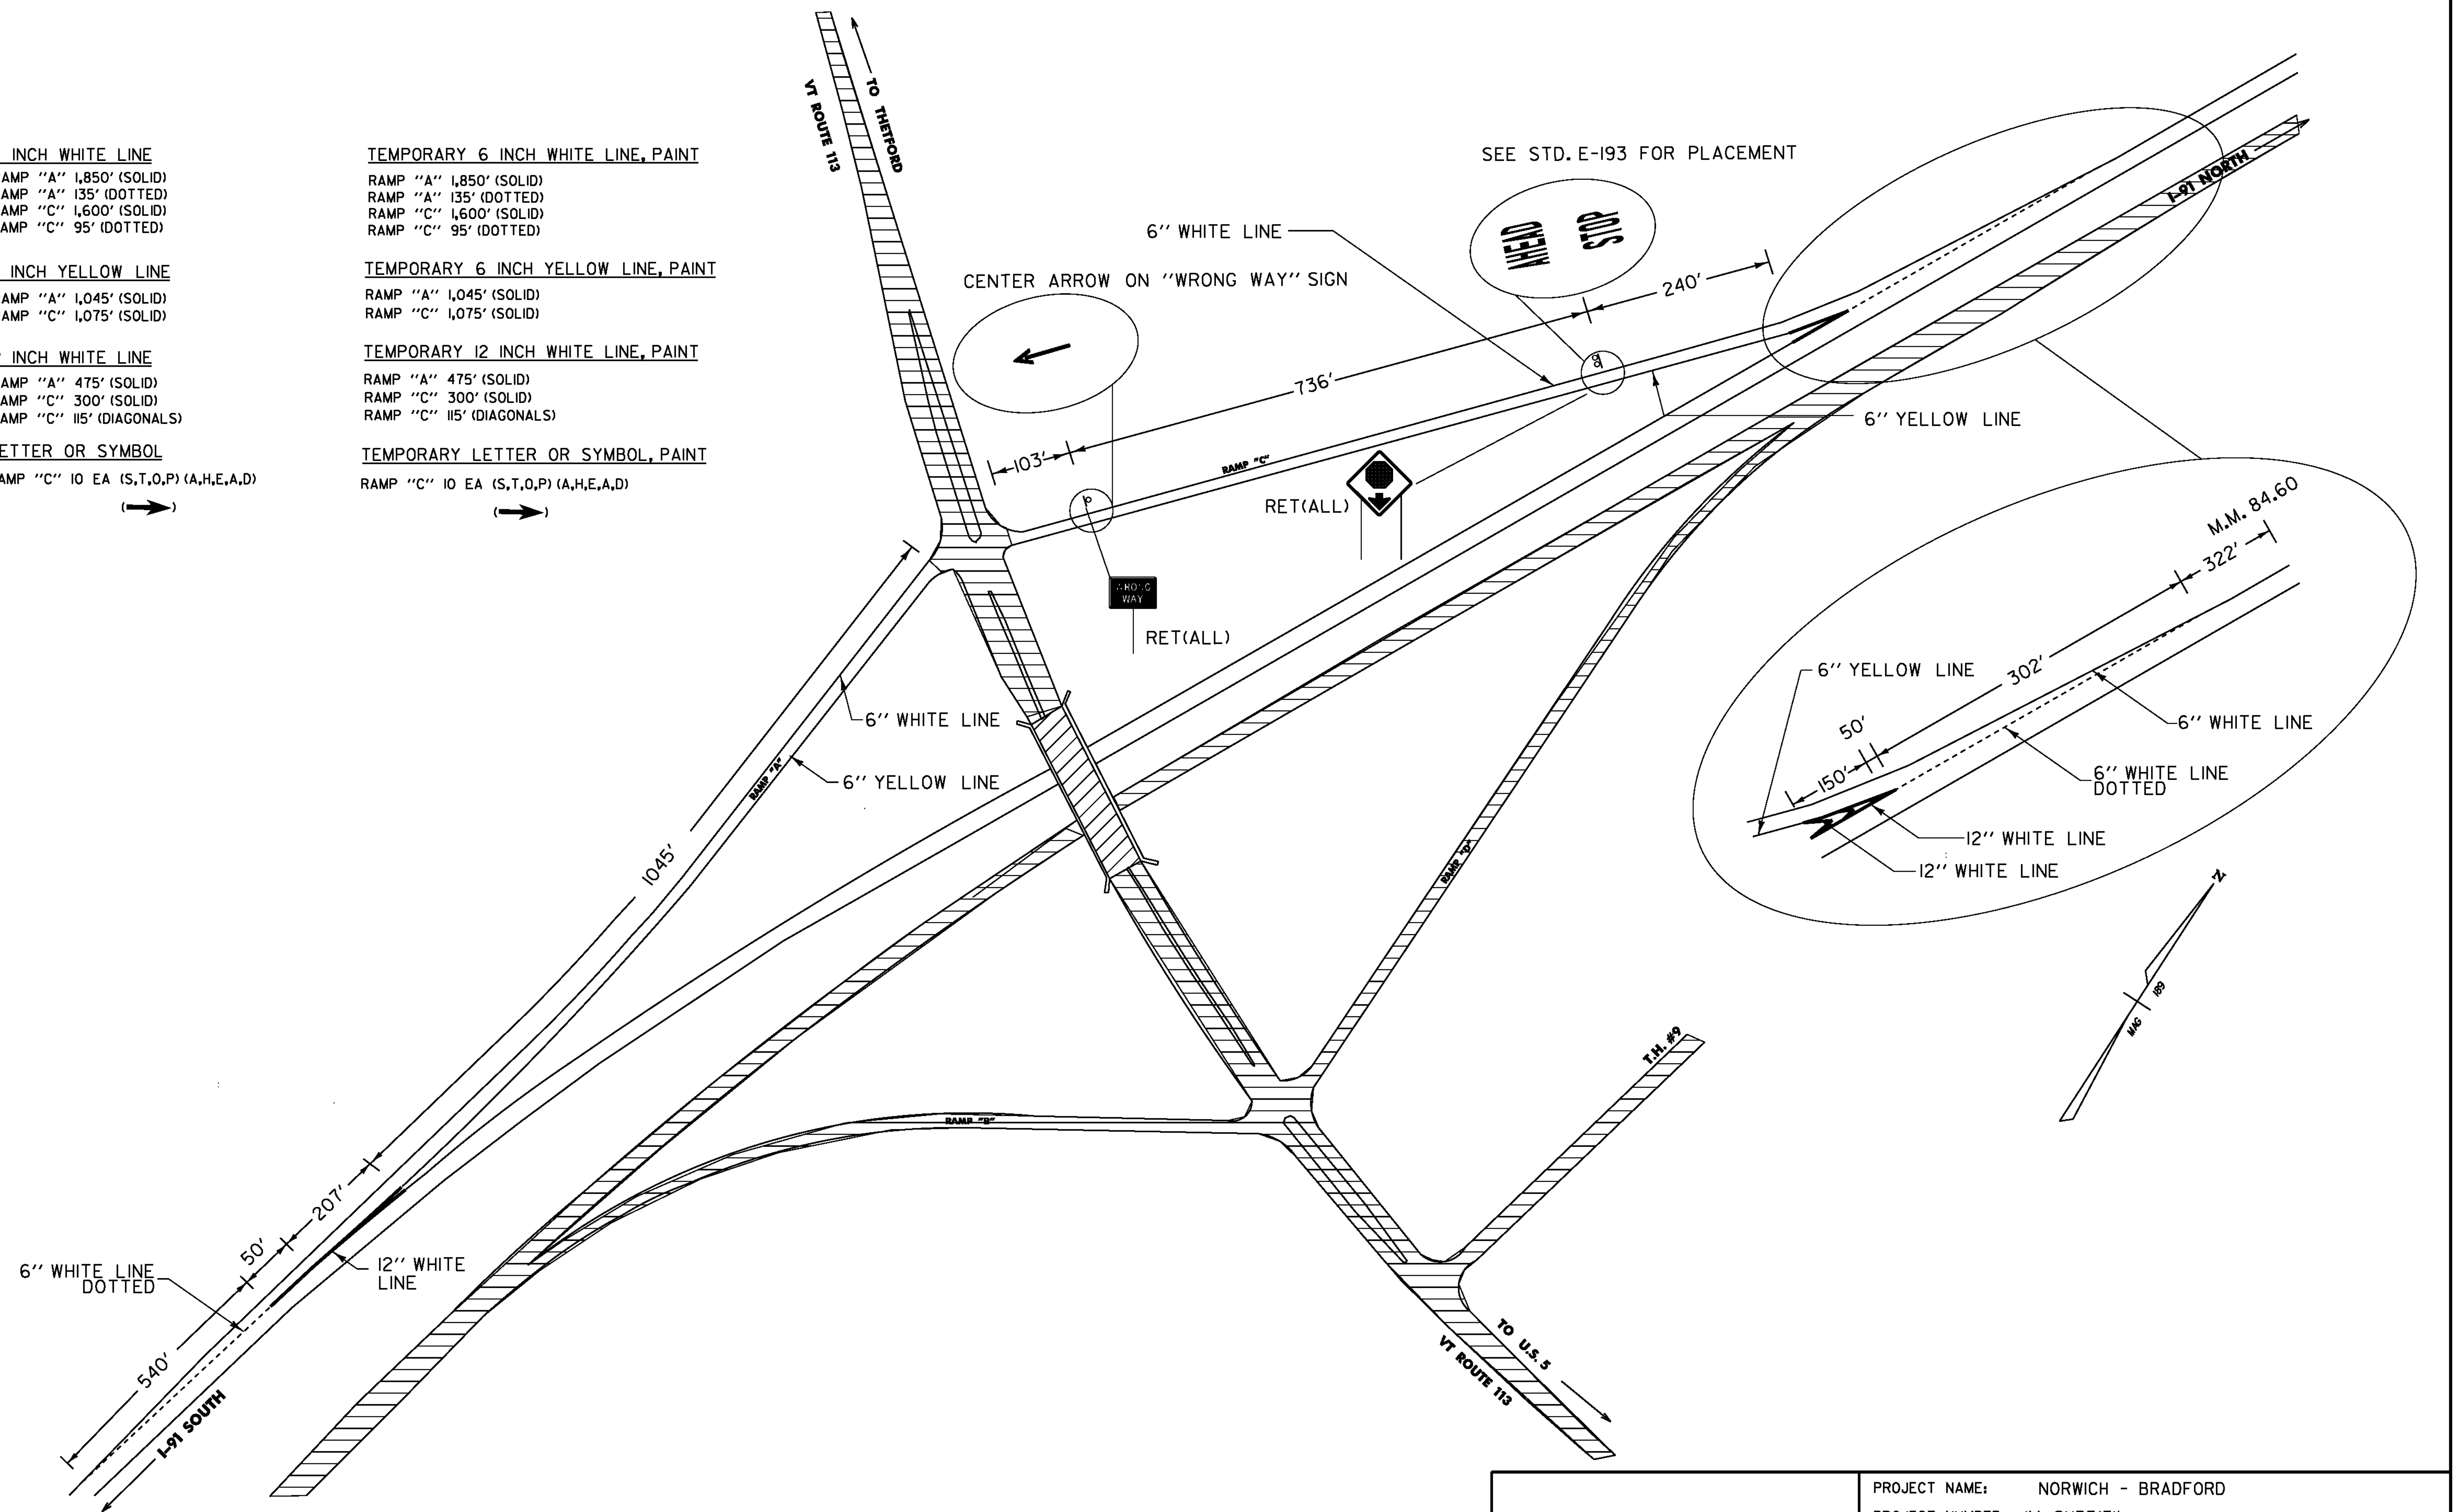

NOT TO SCALE

= NO WORK

**EXIT 14
 PAVEMENT MARKING
 SHEET**

PROJECT NAME: NORWICH - BRADFORD	PLOT DATE: 06-FEB-2012
PROJECT NUMBER: IM SURF(31)	DRAWN BY: WILDER
FILE NAME: /pave/11a030/pla030.dgn	CHECKED BY: PVMT MGMT
PROJECT MANAGER: MIKE FOWLER	SHEET 10 OF 19
DESIGNED BY: WILDER	
IPARM FILE NAME: pla030_10.1	

6 INCH WHITE LINE
 RAMP "A" 1,850' (SOLID)
 RAMP "A" 250' (DOTTED)
 RAMP "C" 1,050' (SOLID)
 RAMP "C" 75' (DOTTED)

6 INCH YELLOW LINE
 RAMP "A" 550' (SOLID)
 RAMP "C" 600' (SOLID)

12 INCH WHITE LINE
 RAMP "A" 575' (SOLID)
 RAMP "C" 475' (SOLID)
 RAMP "C" 200' (DIAGONALS)


LETTER OR SYMBOL
 RAMP "C" IO EA (S,T,O,P) (A,H,E,A,D)

TEMPORARY 6 INCH WHITE LINE, PAINT
 RAMP "A" 1,850' (SOLID)
 RAMP "A" 250' (DOTTED)
 RAMP "C" 1,050' (SOLID)
 RAMP "C" 75' (DOTTED)

TEMPORARY 6 INCH YELLOW LINE, PAINT
 RAMP "A" 550' (SOLID)
 RAMP "C" 600' (SOLID)

TEMPORARY 12 INCH WHITE LINE, PAINT
 RAMP "A" 575' (SOLID)
 RAMP "C" 475' (SOLID)
 RAMP "C" 200' (DIAGONALS)

TEMPORARY LETTER OR SYMBOL, PAINT
 RAMP "C" IO EA (S,T,O,P) (A,H,E,A,D)

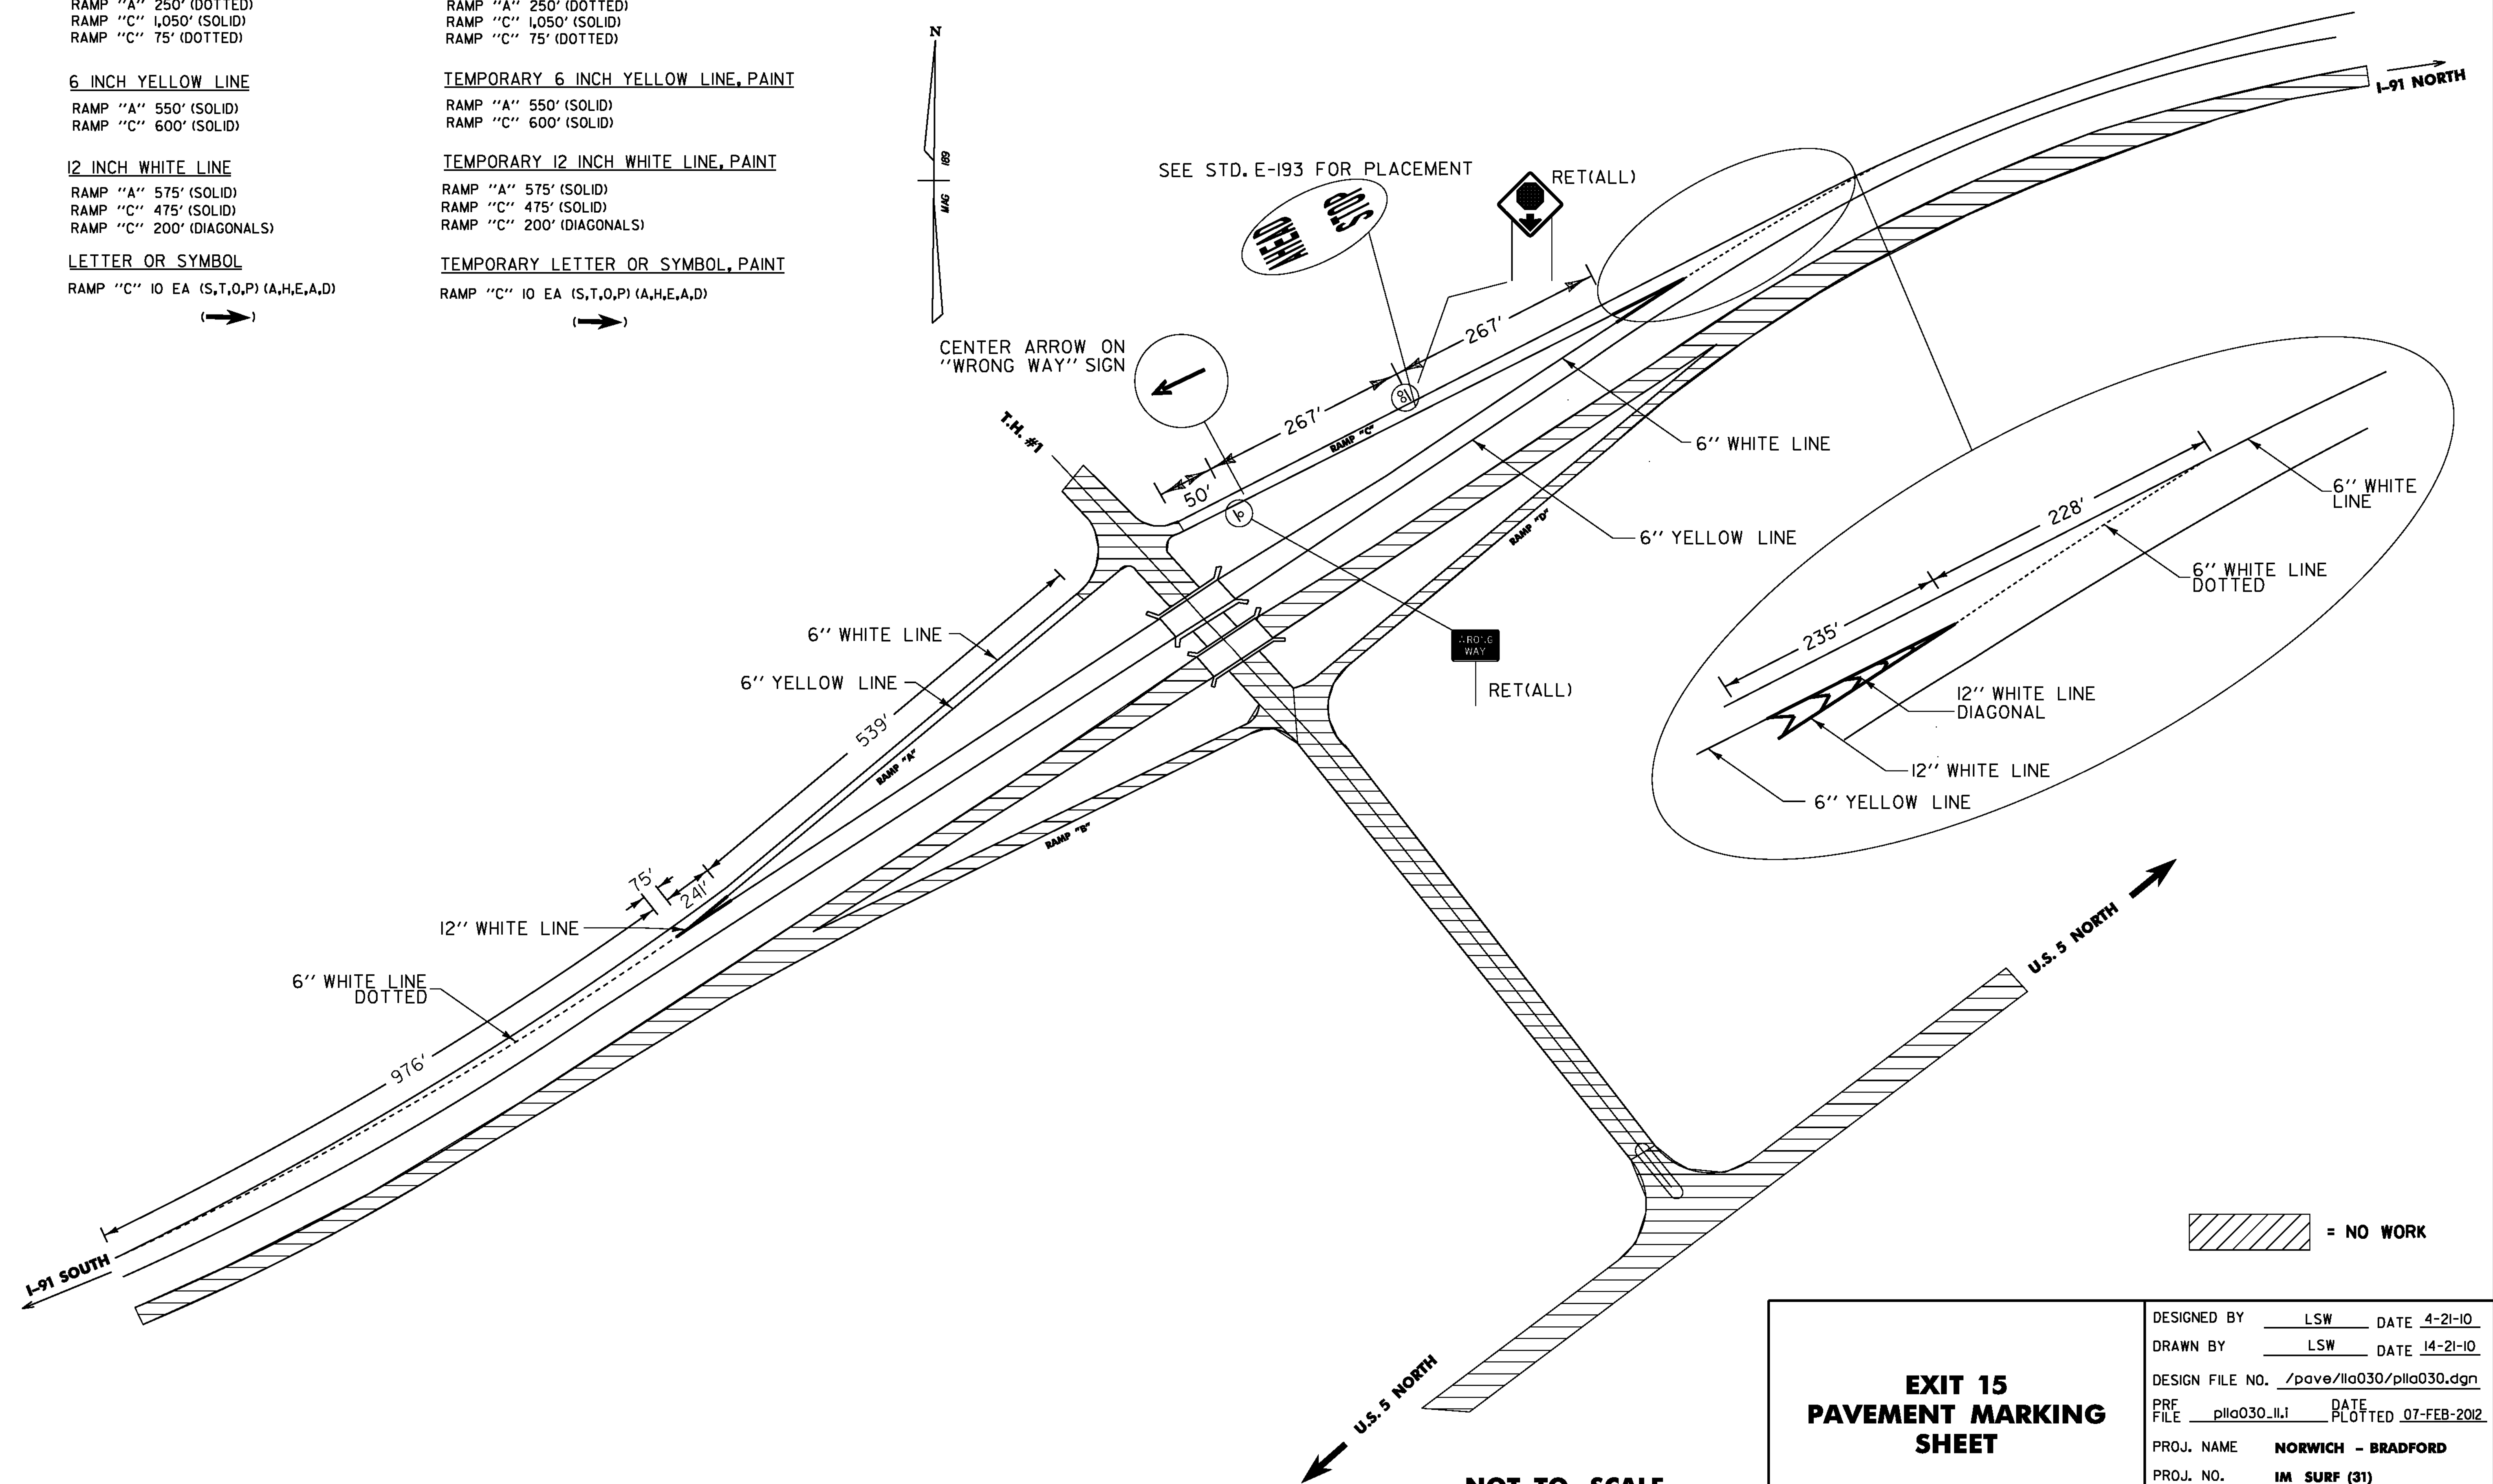

SEE STD. E-193 FOR PLACEMENT

CENTER ARROW ON "WRONG WAY" SIGN

ROAD WORK

= NO WORK

EXIT 15 PAVEMENT MARKING SHEET	DESIGNED BY	LSW	DATE	4-21-10
	DRAWN BY	LSW	DATE	14-21-10
	DESIGN FILE NO.	/pave/11a030/p11a030.dgn		
	PRF FILE	p11a030-11.i	DATE PLOTTED	07-FEB-2012
	PROJ. NAME	NORWICH - BRADFORD		
	PROJ. NO.	IM SURF (31)		
SHEET 11 OF 19 SHEETS				

NOT TO SCALE

6 INCH WHITE LINE
 RAMP "C" 1,170' (SOLID)
 RAMP "C" 130' (DOTTED)
 RAMP "D" 2,375' (SOLID)
 RAMP "D" 275' (DOTTED)

6 INCH YELLOW LINE
 RAMP "C" 505' (SOLID)
 RAMP "D" 1,085' (SOLID)

12 INCH WHITE LINE
 RAMP "C" 265' (SOLID)
 RAMP "C" 200' (DIAGONALS)
 RAMP "D" 370' (SOLID)


LETTER OR SYMBOL
 RAMP "C" 10 EA (S,T,O,P) (A,H,E,A,D)

TEMPORARY 6 INCH WHITE LINE, PAINT
 RAMP "A" 1,170' (SOLID)
 RAMP "C" 130' (DOTTED)
 RAMP "D" 2,375' (SOLID)
 RAMP "D" 275' (DOTTED)

TEMPORARY 6 INCH YELLOW LINE, PAINT
 RAMP "C" 505' (SOLID)
 RAMP "D" 1,085' (SOLID)

TEMPORARY 12 INCH WHITE LINE, PAINT
 RAMP "C" 265' (SOLID)
 RAMP "C" 200' (DIAGONALS)
 RAMP "D" 475' (SOLID)

TEMPORARY LETTER OR SYMBOL, PAINT
 RAMP "C" 10 EA (S,T,O,P) (A,H,E,A,D)

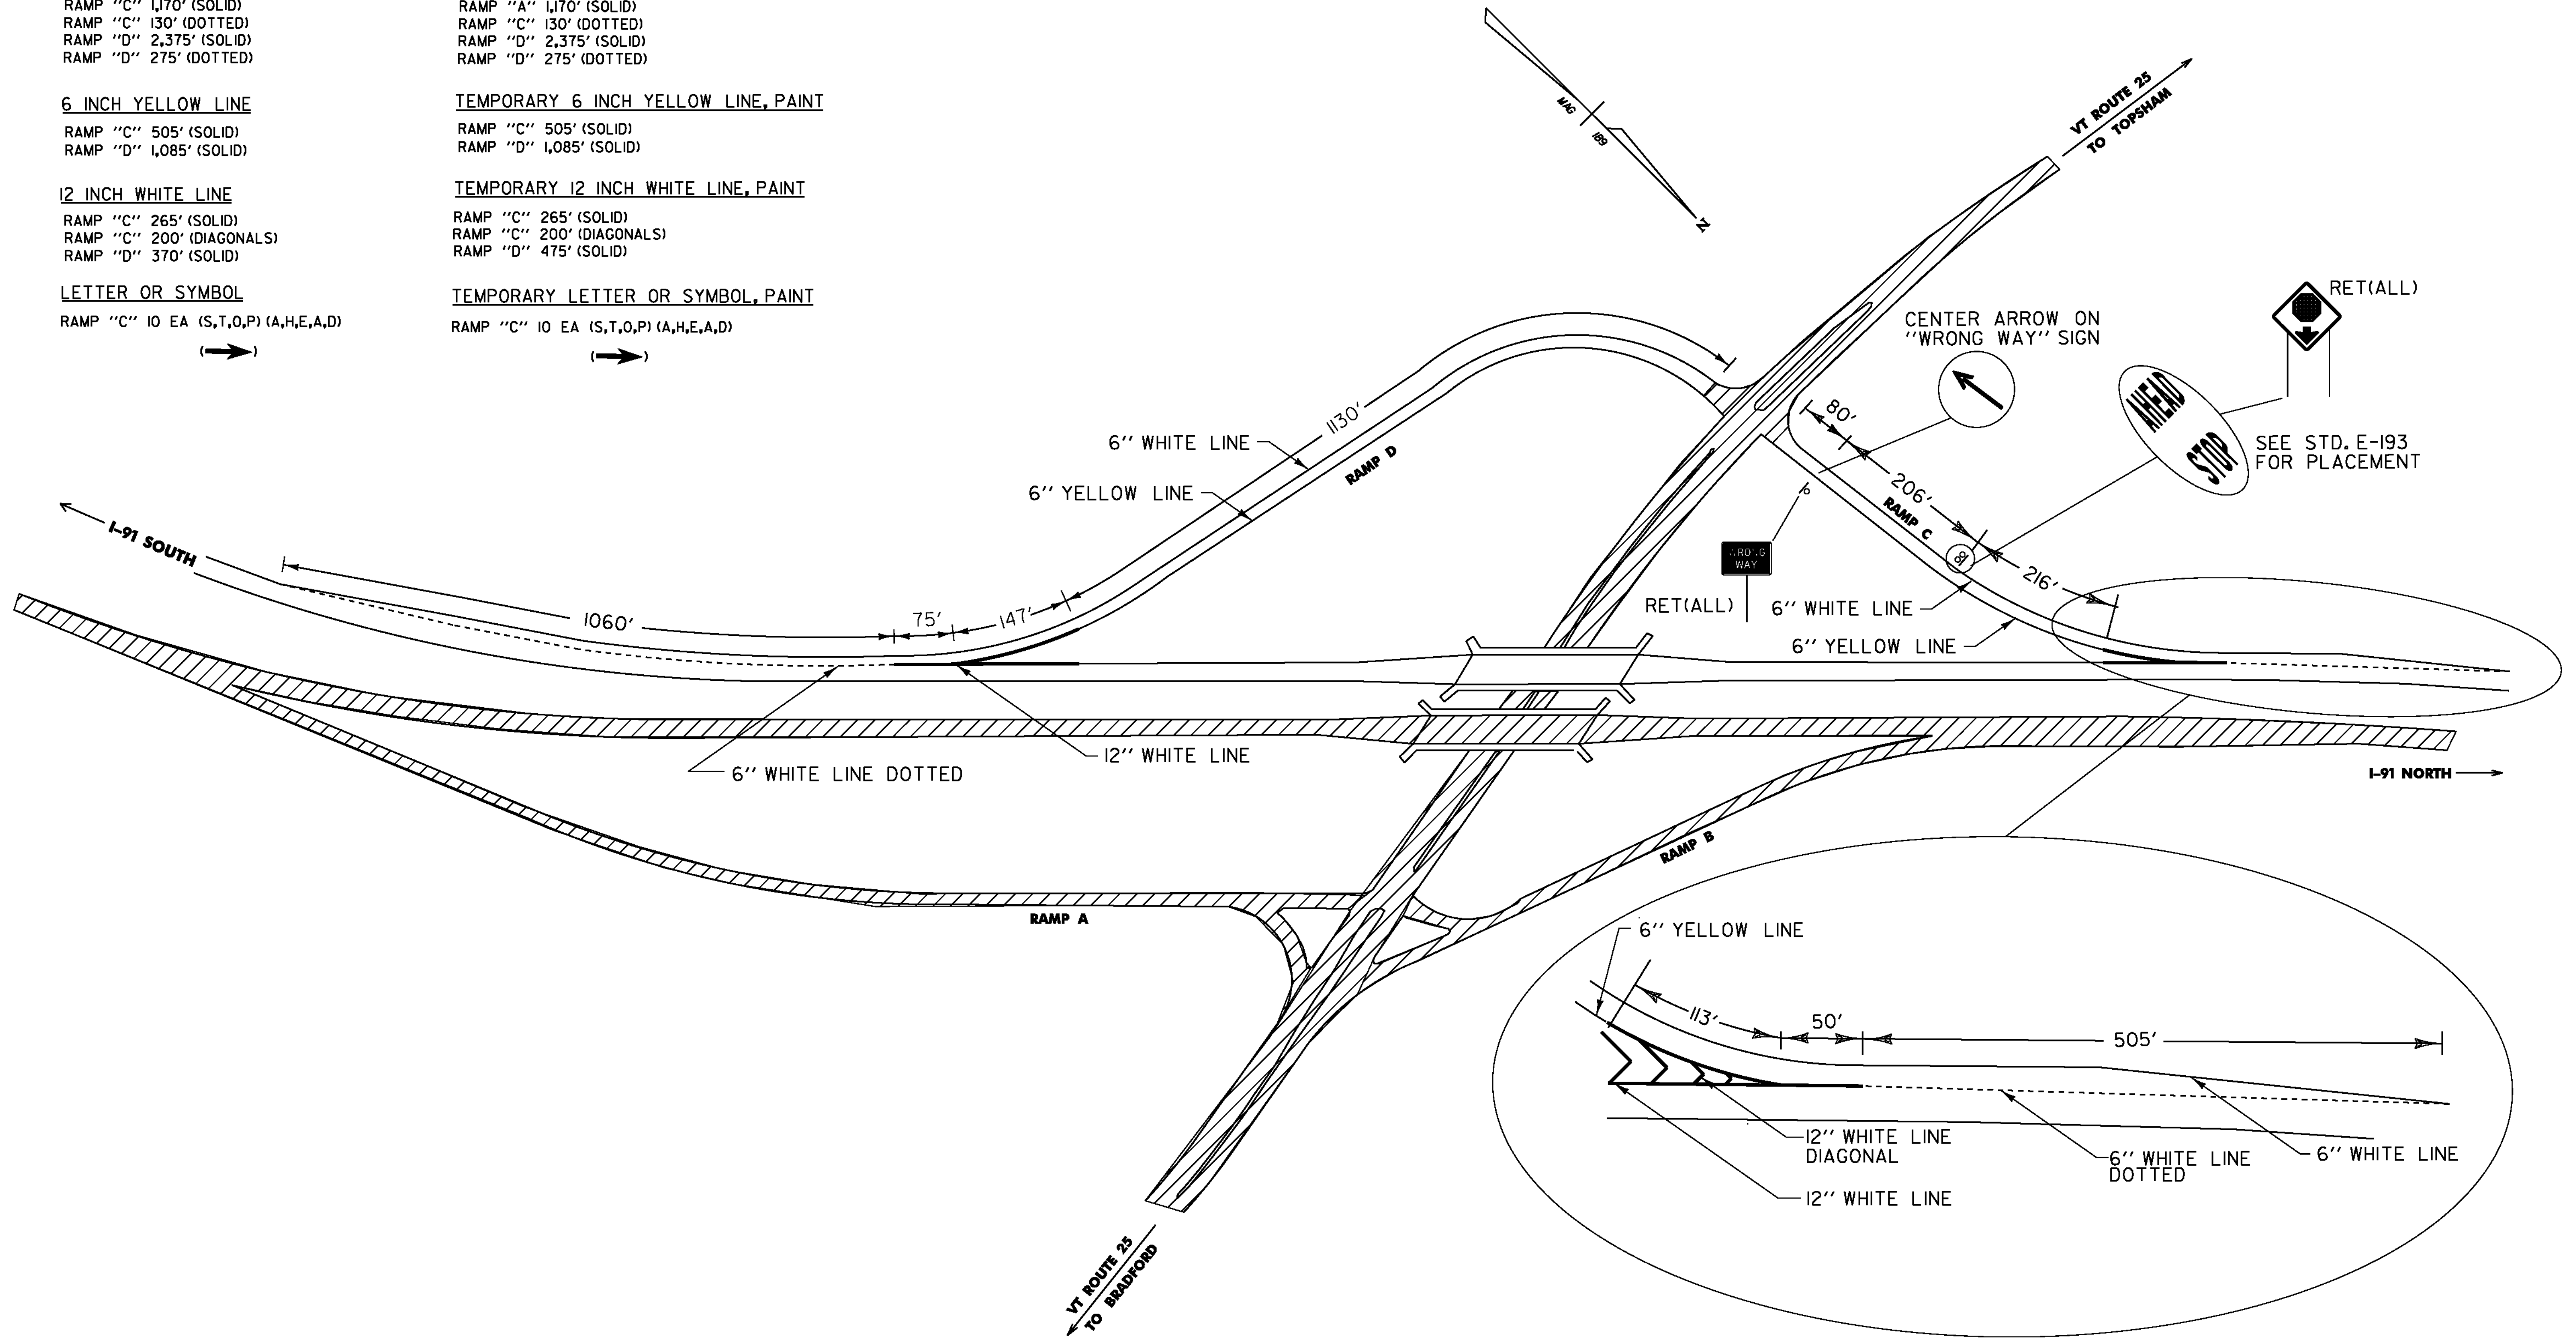

= NO WORK

NOT TO SCALE


**EXIT 16
 PAVEMENT MARKING
 SHEET**

DESIGNED BY	LSW	DATE	4-21-10
DRAWN BY	LSW	DATE	14-21-10
DESIGN FILE NO.	/pave/11a030/p11a030.dgn		
PRF FILE	p11a030_12.1	DATE PLOTTED	07-FEB-2012
PROJ. NAME	NORWICH - BRADFORD		
PROJ. NO.	IM SURF (31)		
SHEET	12	OF	19 SHEETS

I-91 Norwich-Bradford IM SURF(31) Pre. Construction

Profiled 6-3-11

Travel Lane Avg. IRI = 51.9, Passing Lane Avg. IRI = 52.4

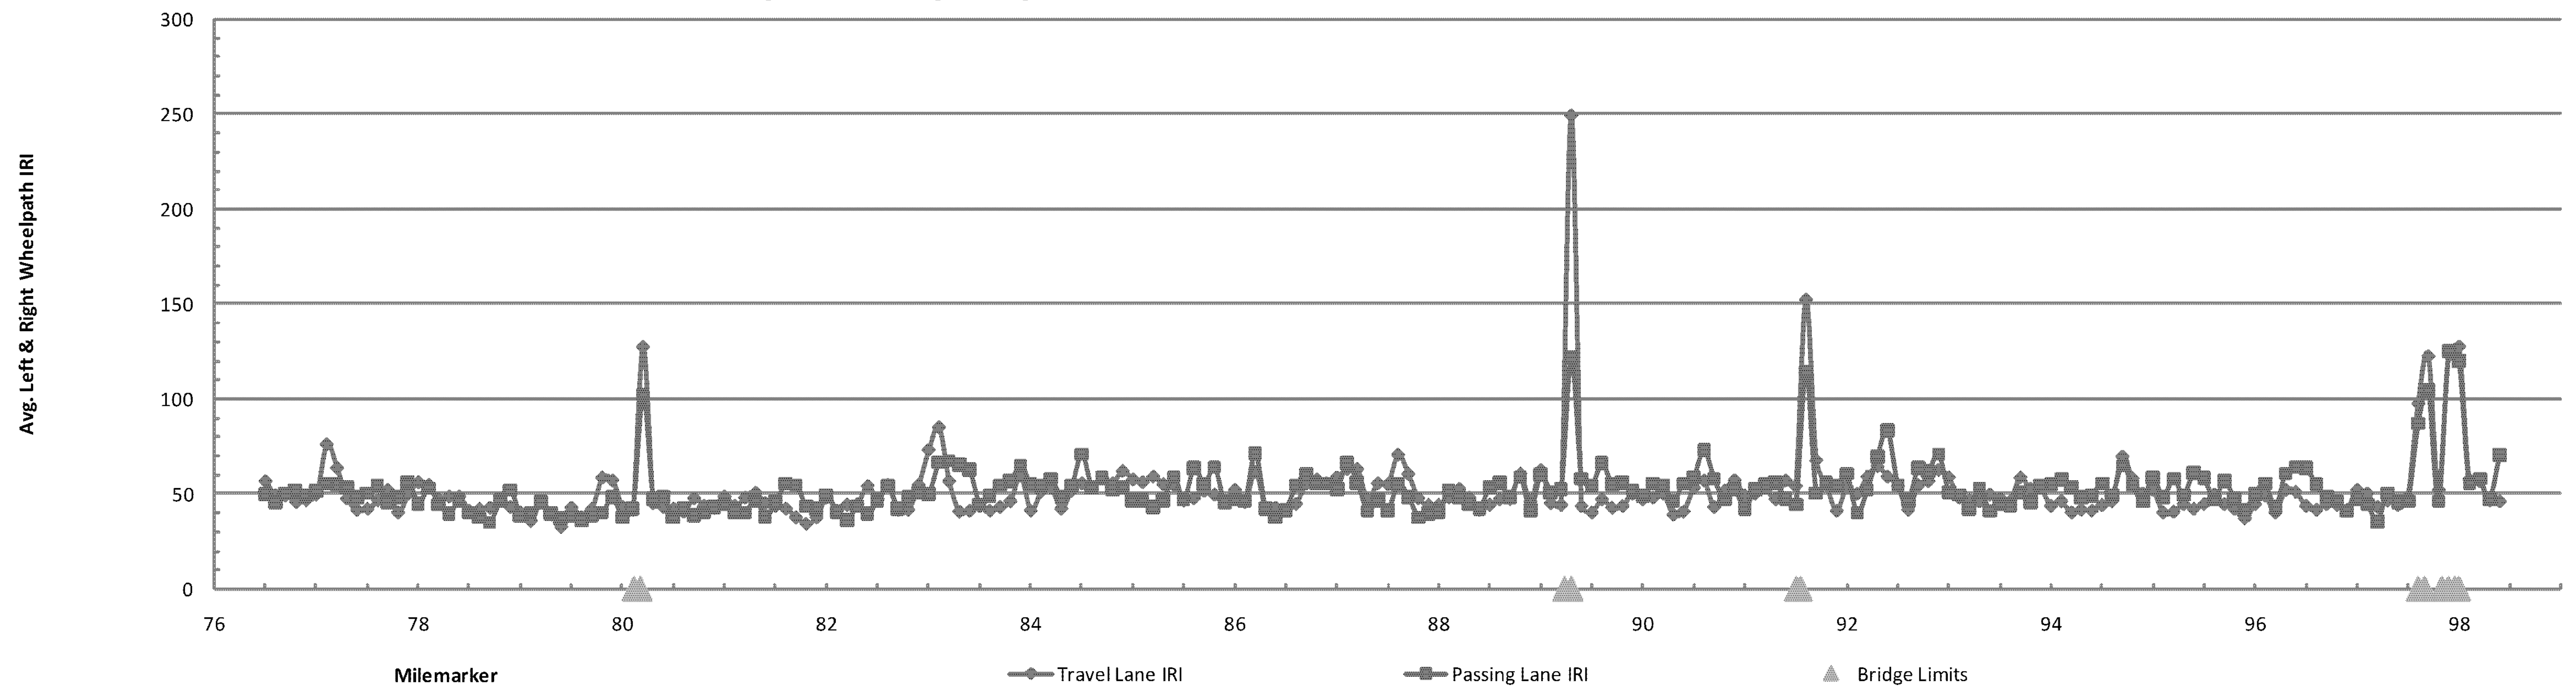

**SOUTHBOUND LANE
FOR INFORMATIONAL PURPOSES ONLY**


**ROUGHNESS
DATA
INFORMATION**

PROJECT NAME: NORWICH - BRADFORD	
PROJECT NUMBER: IM SURF (31)	
FILE NAME: /pave/lla030/plla030.dgn	PLOT DATE: 07-FEB-2012
PROJECT LEADER: MIKE FOWLER	DRAWN BY: WILDER
DESIGNED BY: WILDER	CHECKED BY: PVMT MGMT
IPARM FILE NAME: plla030_13.1	SHEET 13 OF 19

I-91 Norwich-Bradford IM SURF(31) Pre. Construction

Profiled 6-3-11


Travel Lane Avg. Rut = 0.292", Passing Lane Avg. Rut = 0.067"

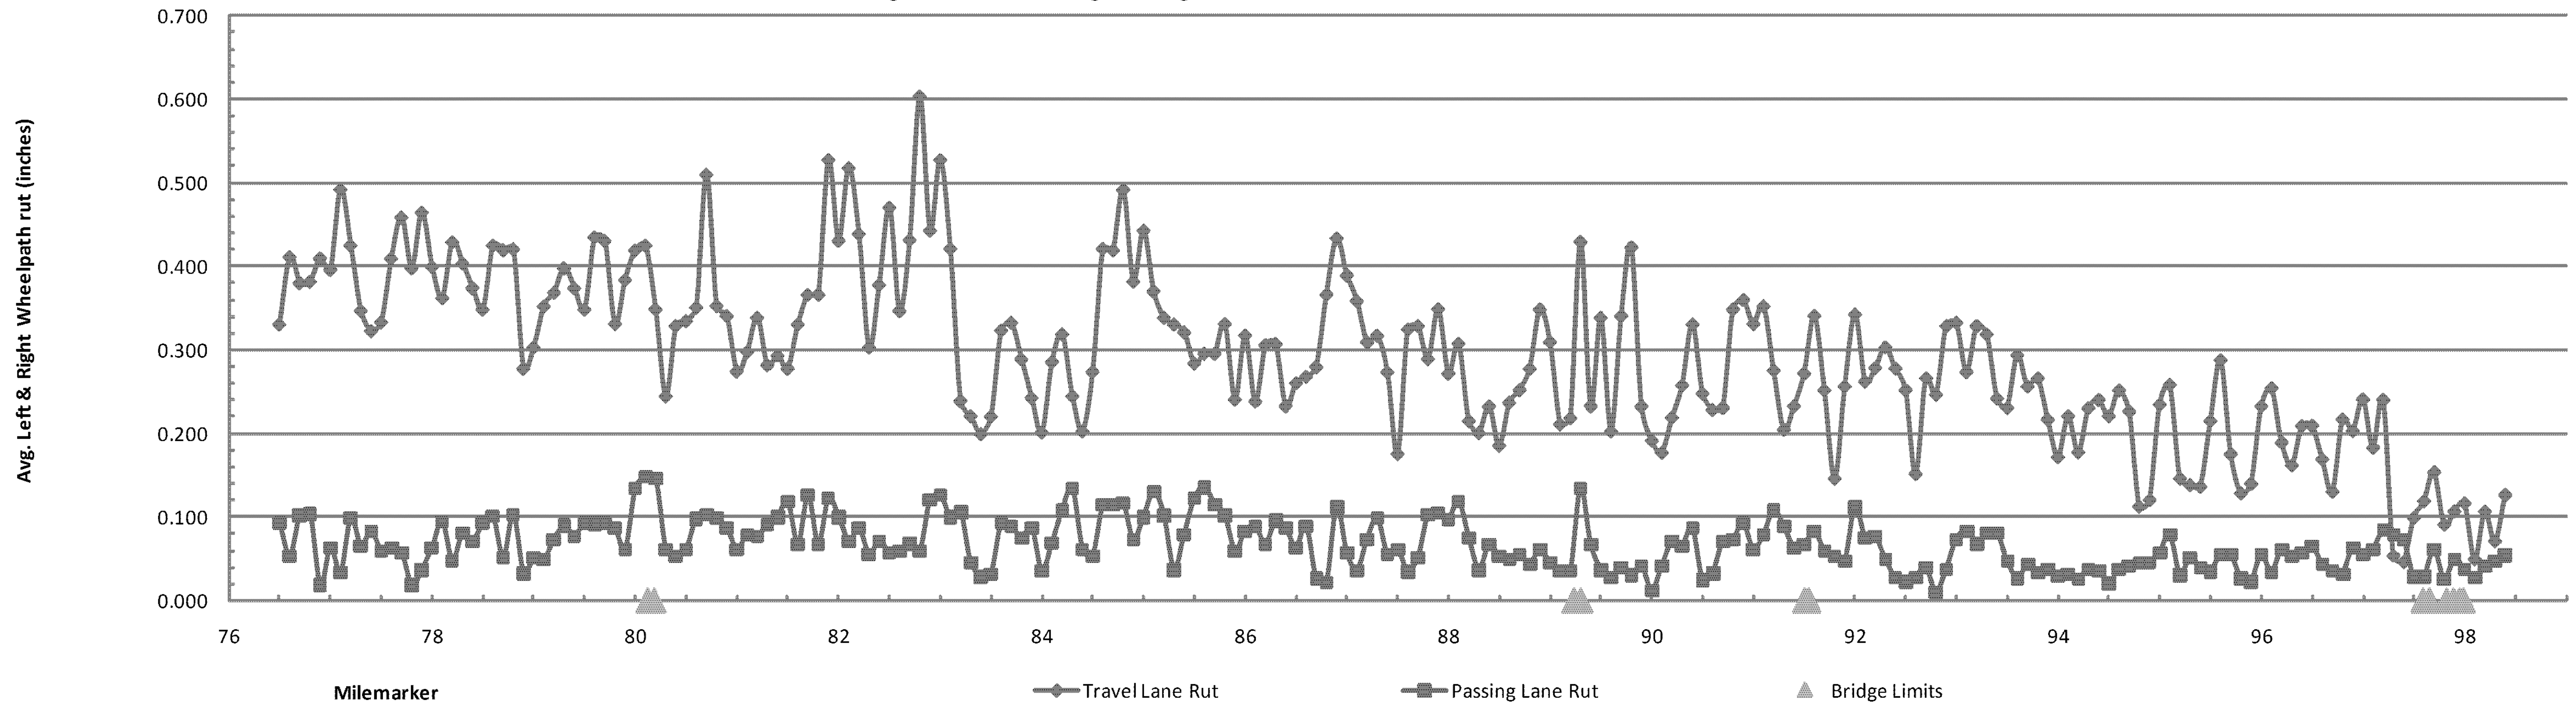

**SOUTHBOUND LANE
FOR INFORMATIONAL PURPOSES ONLY**

**RUTTING DATA
INFORMATION**

PROJECT NAME: NORWICH - BRADFORD	PLOT DATE: 06-FEB-2012
PROJECT NUMBER: IM SURF (31)	DRAWN BY: WILDER
FILE NAME: /pave/lla030/plla030.dgn	CHECKED BY: PVMT MGMT
PROJECT LEADER: MIKE FOWLER	SHEET 14 OF 19
DESIGNED BY: WILDER	
IPARM FILE NAME: plla030_14.1	

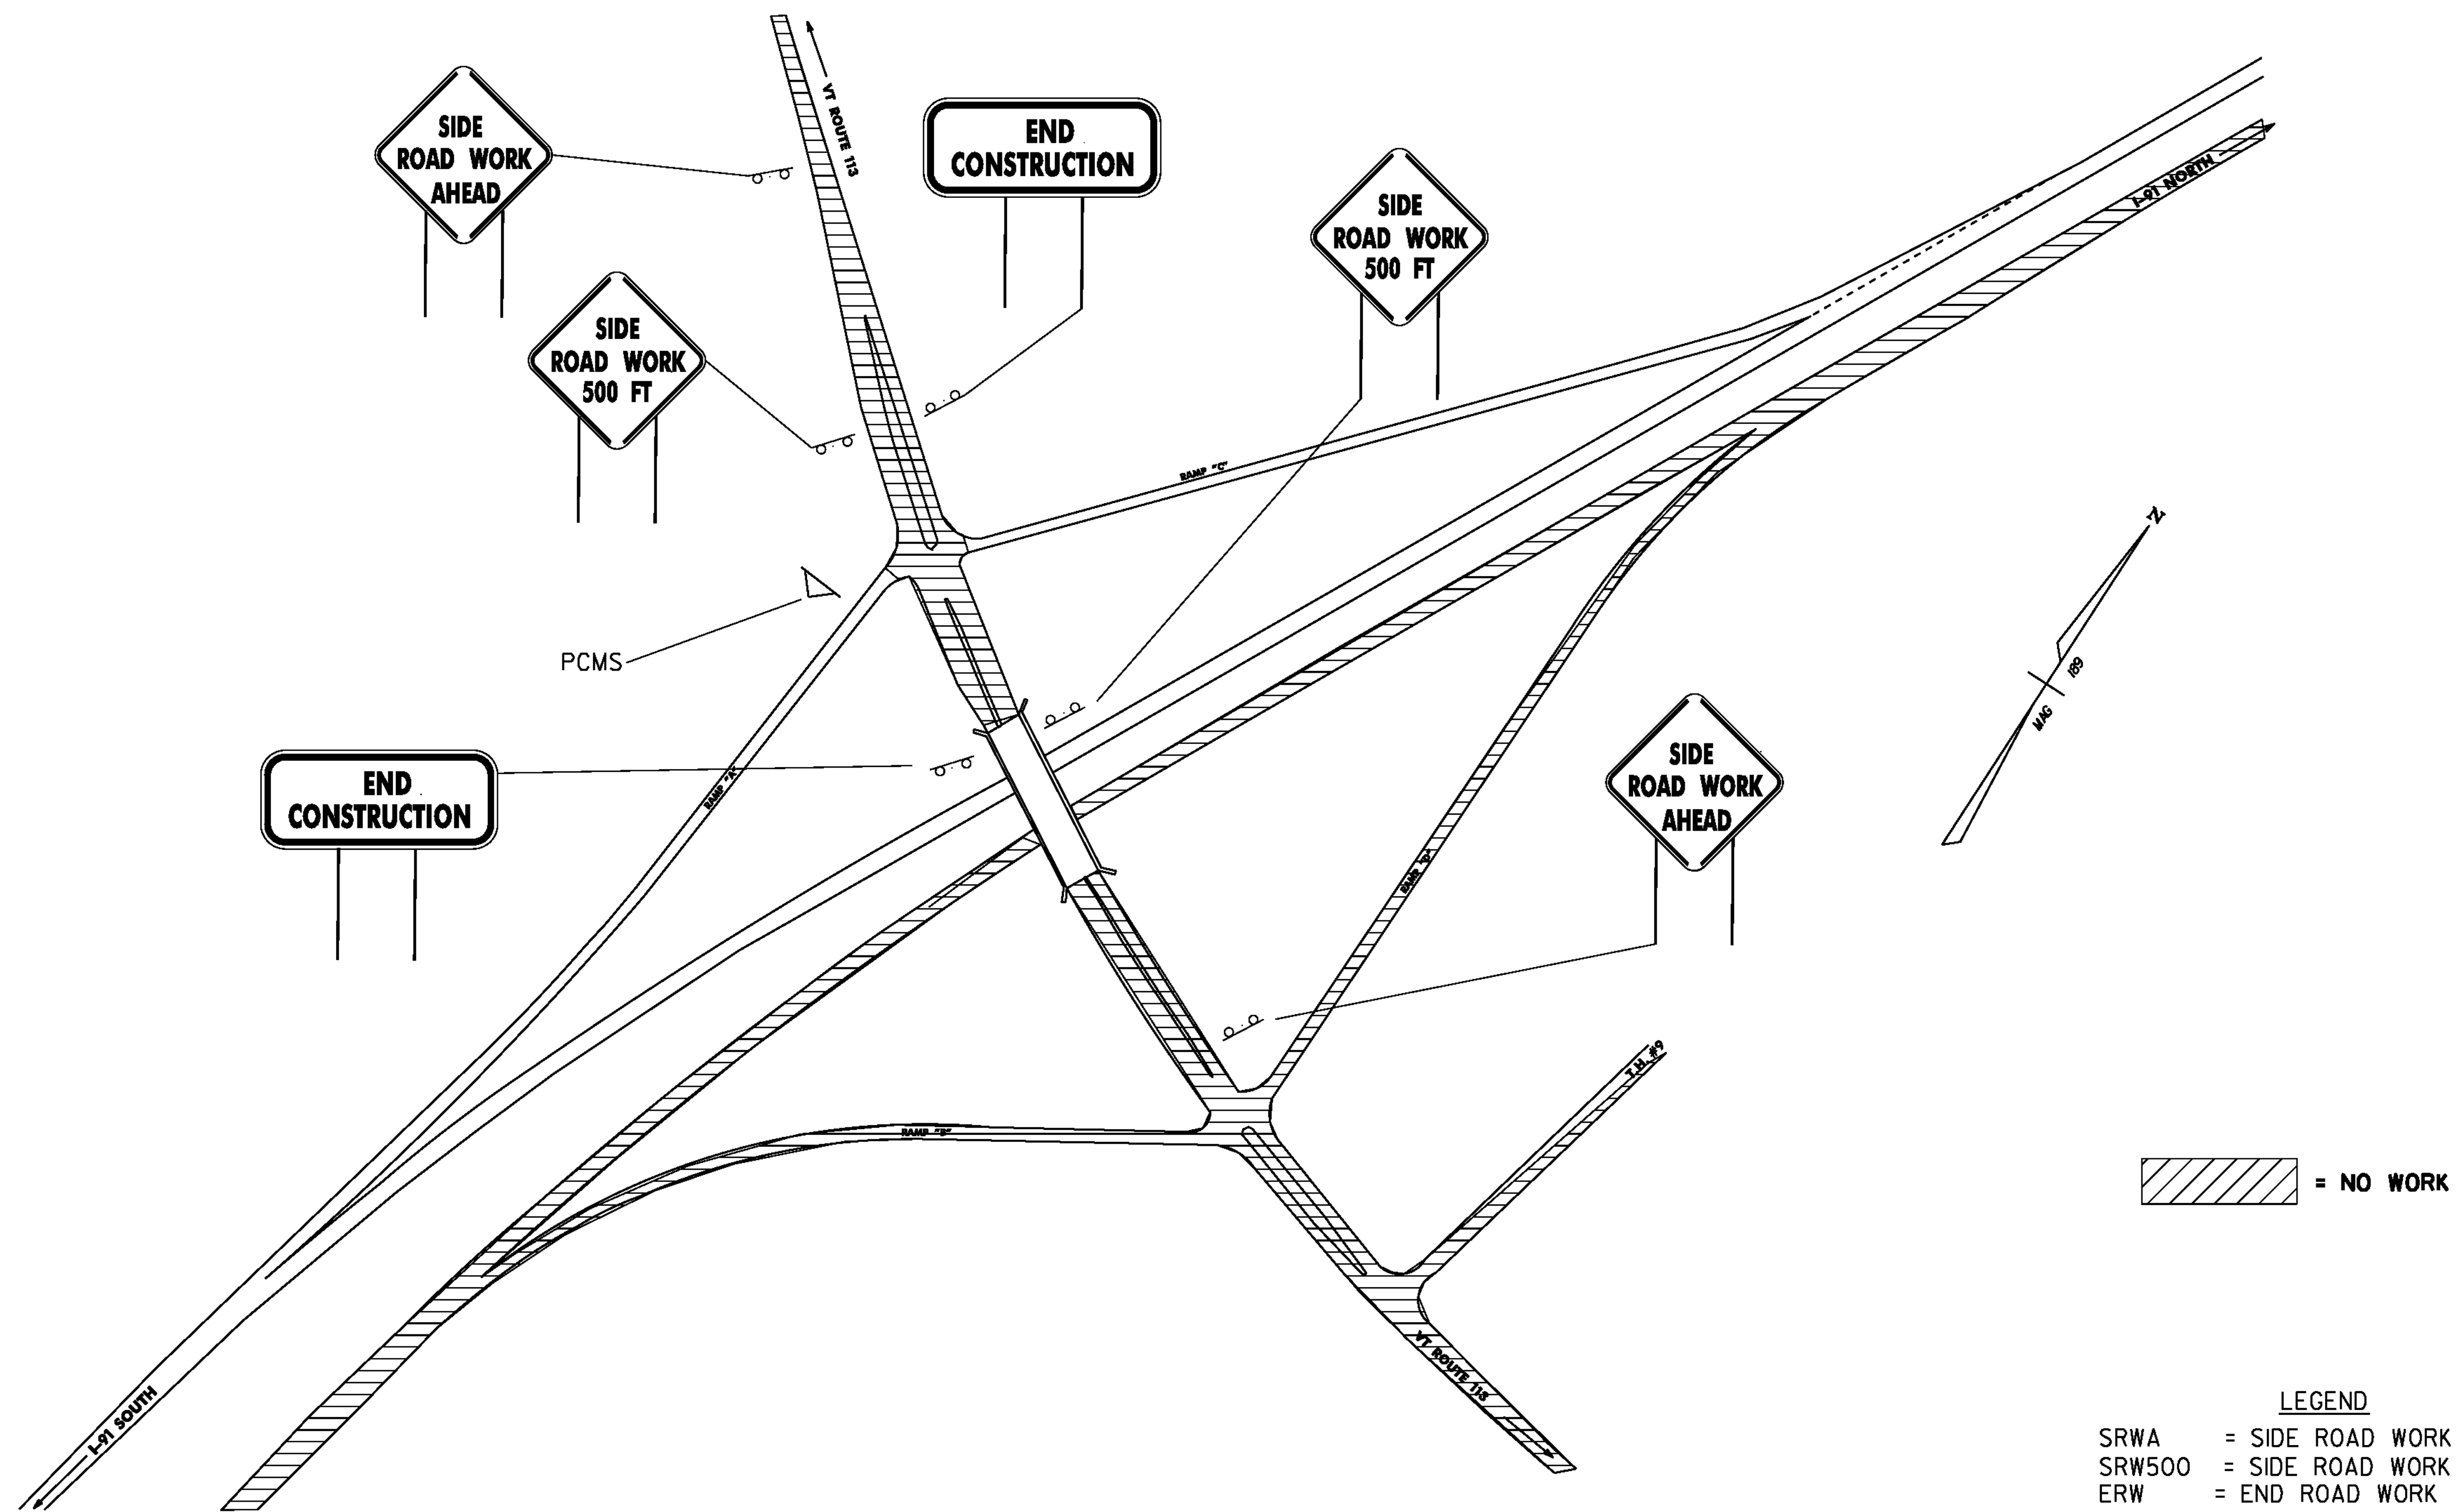

- LEGEND**
- SRWA = SIDE ROAD WORK AHEAD
 - SRW500 = SIDE ROAD WORK 500 FEET
 - ERW = END ROAD WORK
 - △ = PORTABLE CHANGEABLE MESSAGE SIGN
 - [Hatched Box] = NO WORK


LIST OF CONSTRUCTION SIGNS - EXIT 14

LOCATION	SRWA	SRW500	ERW		PCMS
VT. 113	2	2	2		
RAMP "A"					1
TOTALS	2	2	2		1

CONSTRUCTION APPROACH SIGNING EXIT 14


NOT TO SCALE


PROJECT NAME: NORWICH - BRADFORD	PLOT DATE: 07-FEB-2012
PROJECT NUMBER: IM SURF (31)	DRAWN BY: WILDER
FILE NAME: /pave/11a030/p11a030.dgn	CHECKED BY: PVMT MGMT
PROJECT LEADER: MIKE FOWLER	SHEET 15 OF 19
DESIGNED BY: WILDER	
IPARM FILE NAME: p11a030_15.1	

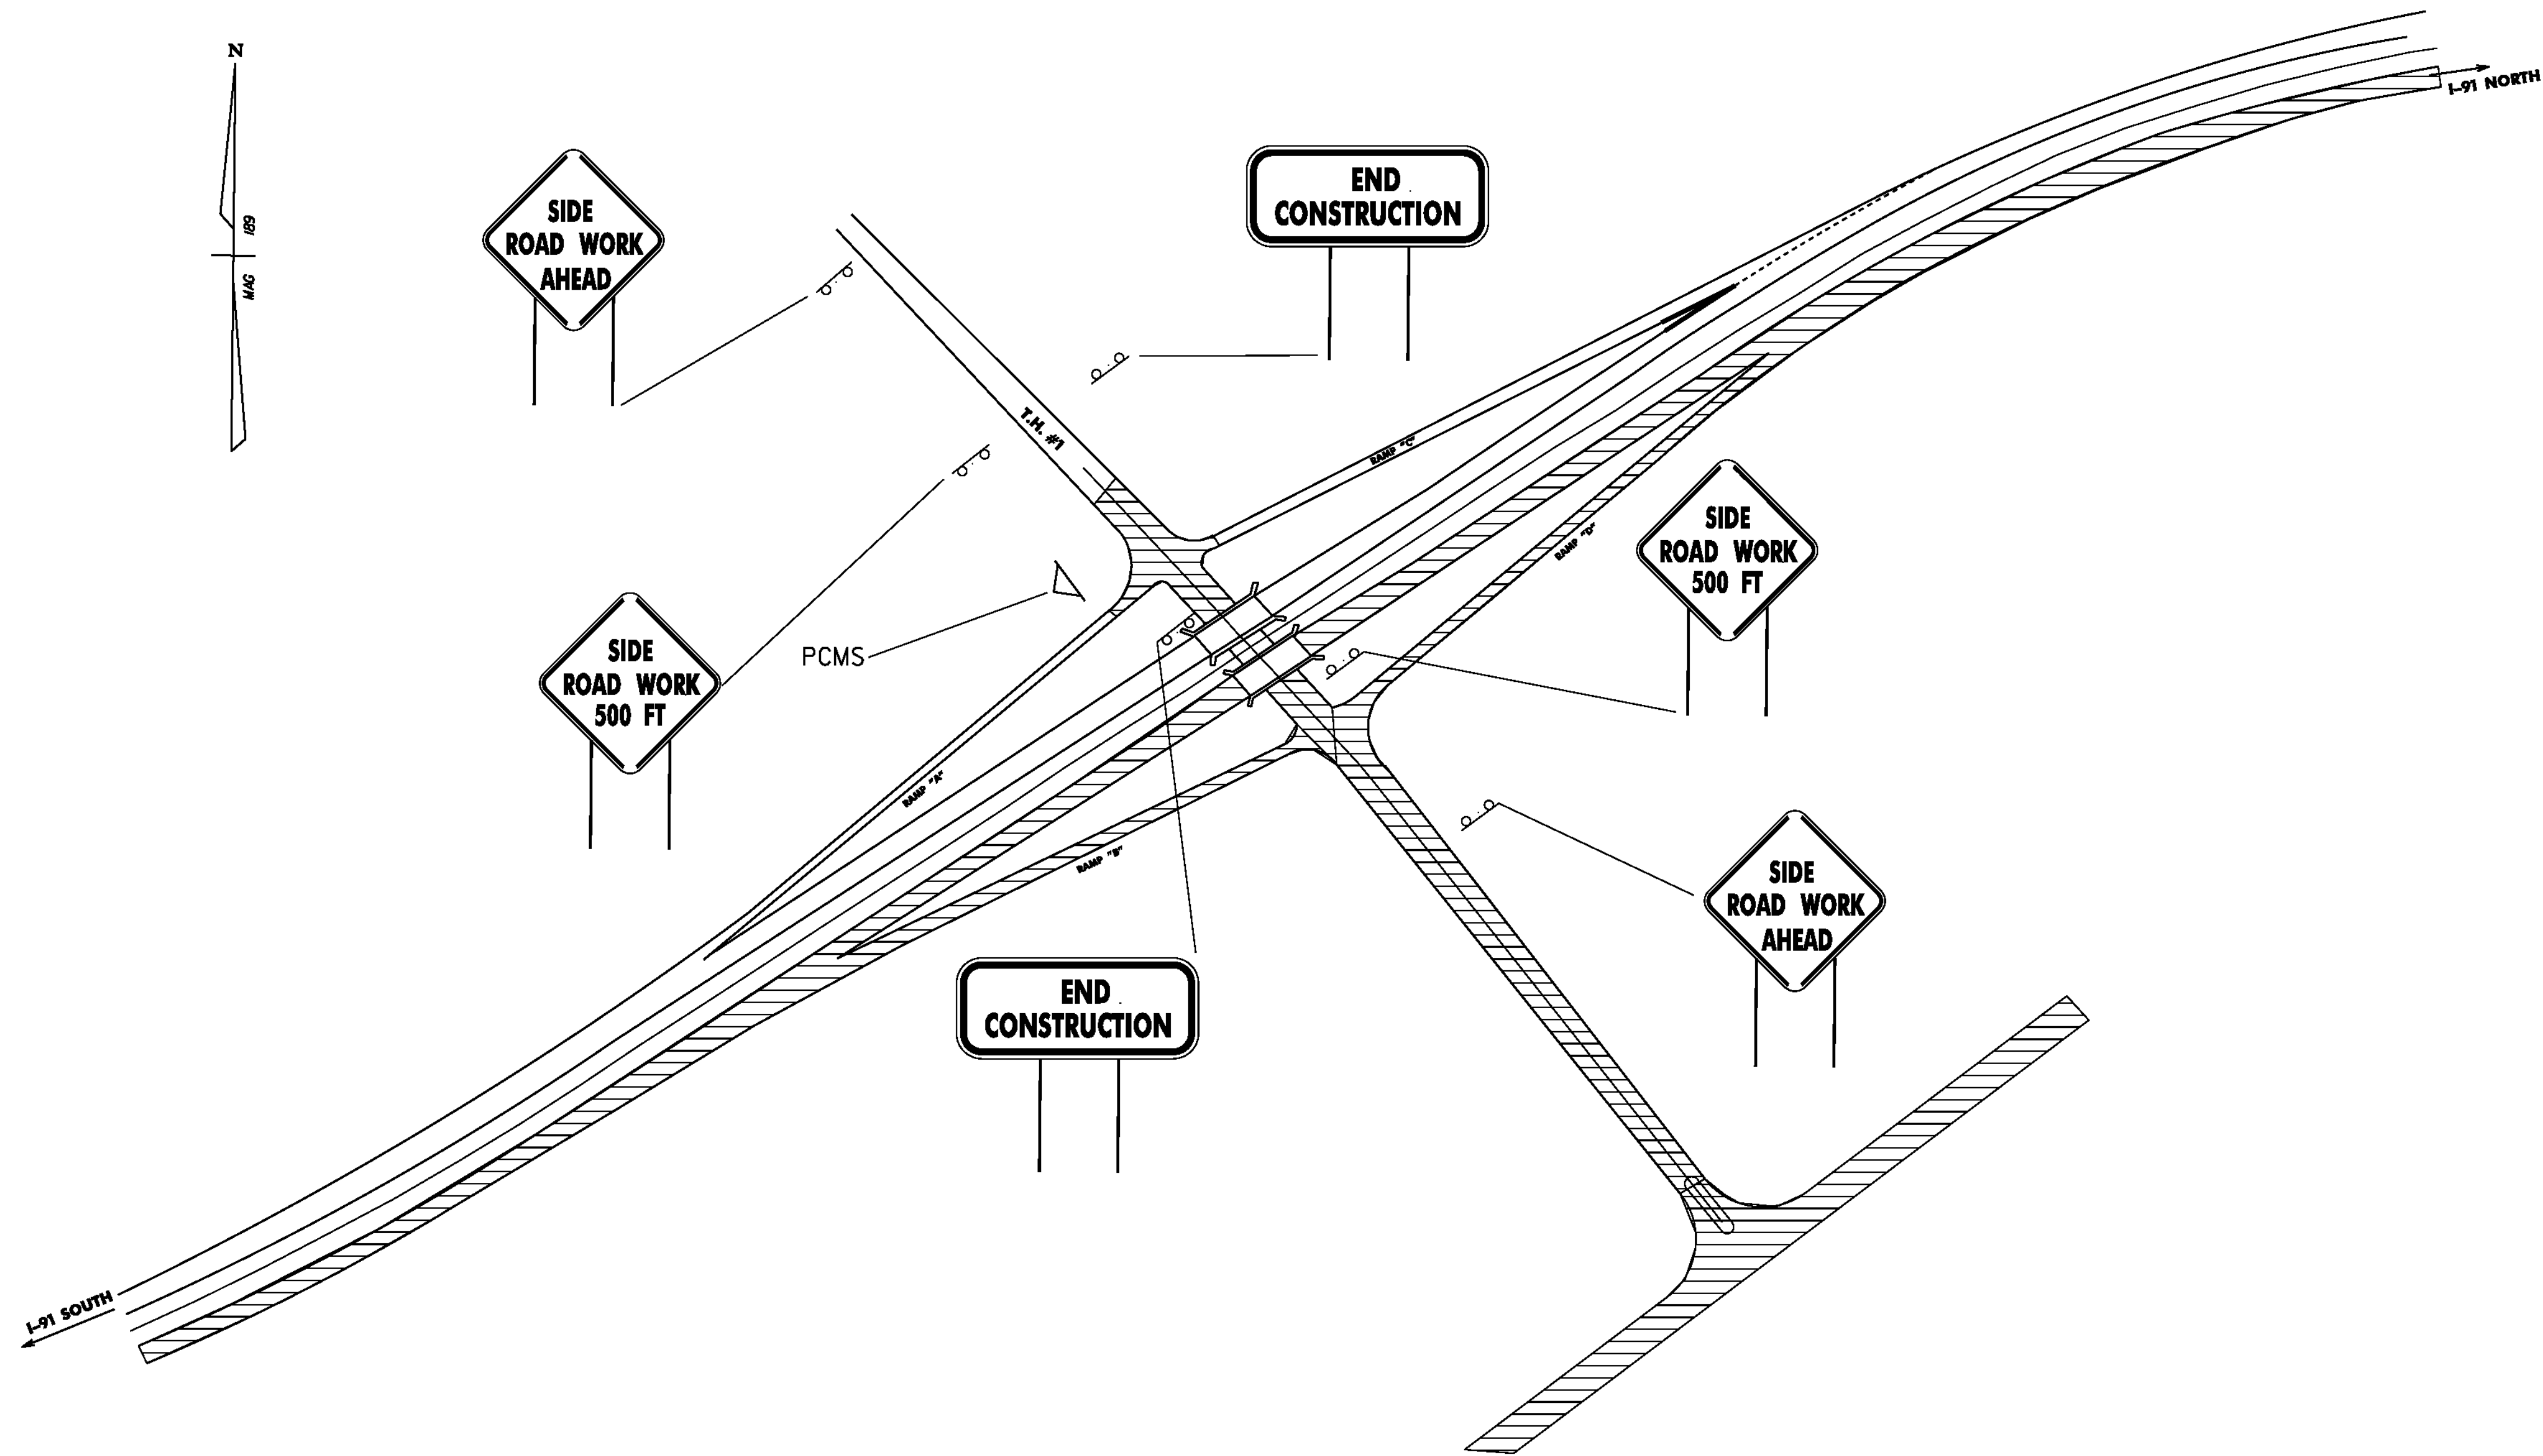

LIST OF CONSTRUCTION SIGNS - EXIT 15

LOCATION	SRWA	SRW500	ERW	PCMS
TH # 1	2	2	2	
RAMP "A"				1
TOTALS	2	2	2	1

 = NO WORK


LEGEND
 SRWA = SIDE ROAD WORK AHEAD
 SRW500 = SIDE ROAD WORK 500 FEET
 ERW = END ROAD WORK
 = PORTABLE CHANGEABLE MESSAGE SIGN

NOT TO SCALE

**CONSTRUCTION APPROACH
SIGNING
EXIT 15**

PROJECT NAME: NORWICH - BRADFORD
 PROJECT NUMBER: IM SURF (31)

FILE NAME: /pave/11a030/plla030.dgn PLOT DATE: 07-FEB-2012
 PROJECT LEADER: MIKE FOWLER DRAWN BY: WILDER
 DESIGNED BY: WILDER CHECKED BY: PVMT MGMT
 IPARM FILE NAME: plla030.i6.1 SHEET 16 OF 19

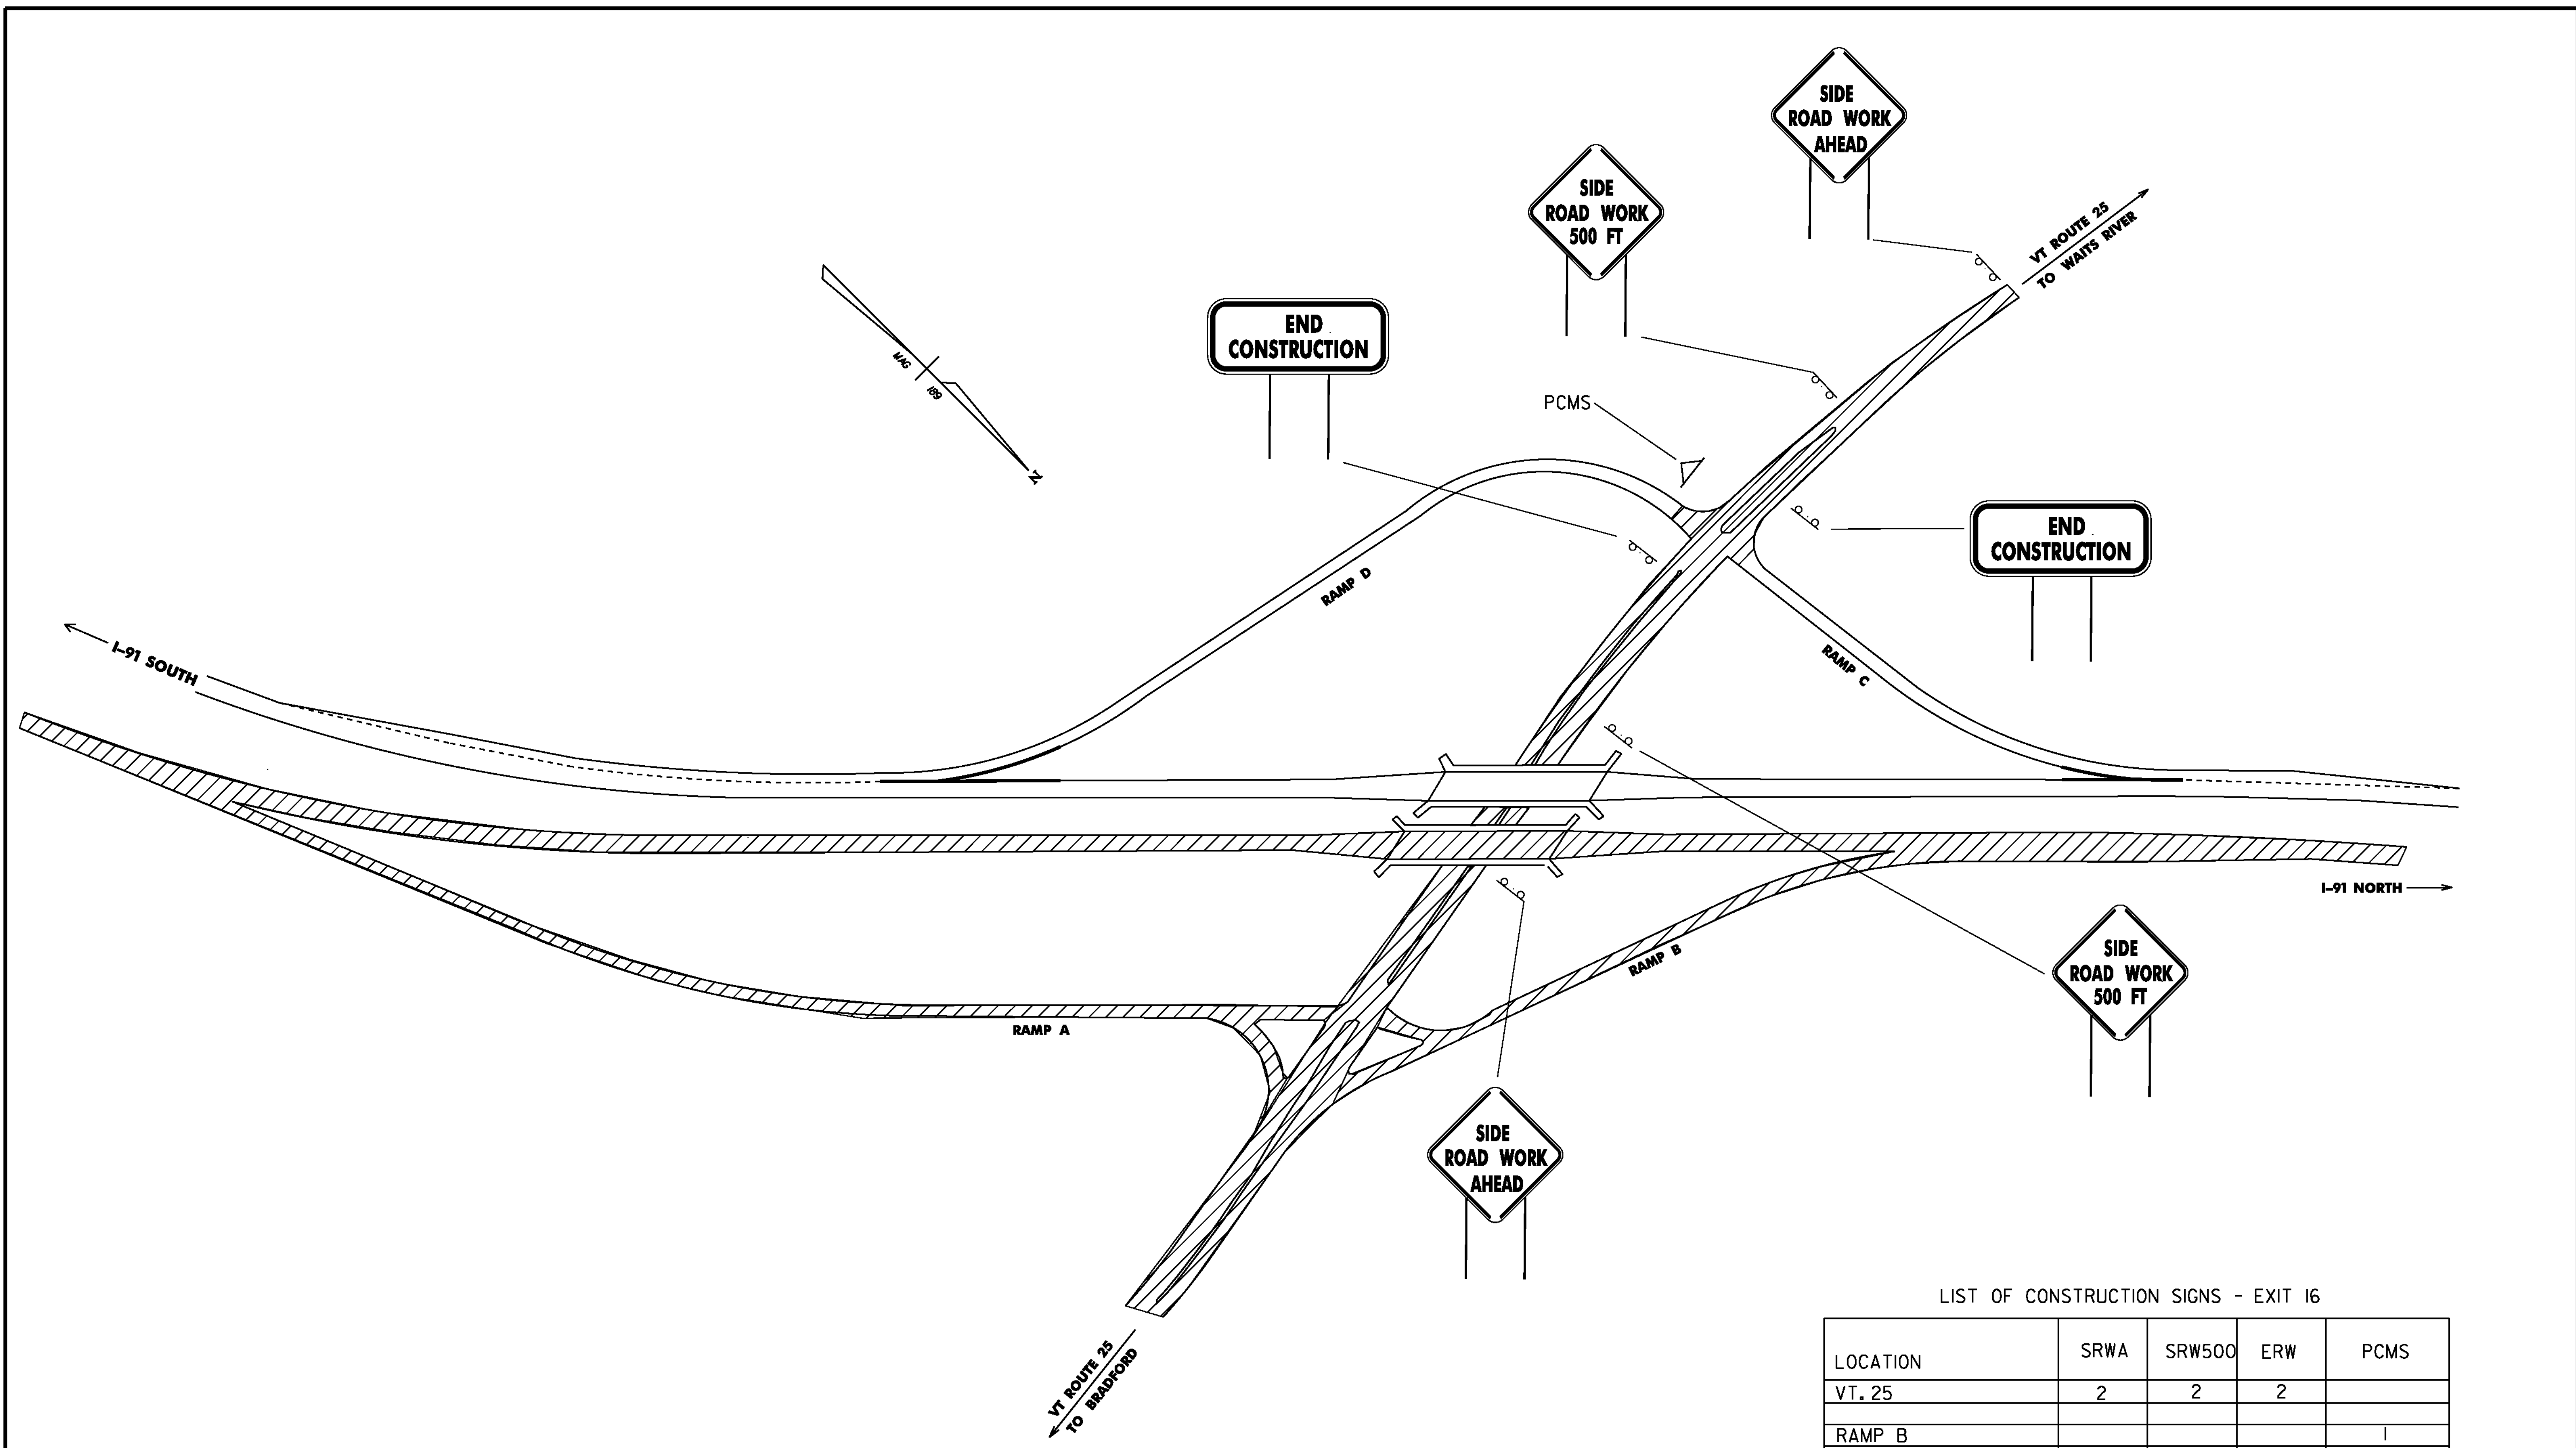

LIST OF CONSTRUCTION SIGNS - EXIT 16

LOCATION	SRWA	SRW500	ERW	PCMS
VT. 25	2	2	2	
RAMP B				1
TOTALS	2	2	2	1

NOT TO SCALE


= NO WORK

LEGEND
 SRWA = SIDE ROAD WORK AHEAD
 SRW500 = SIDE ROAD WORK 500 FEET
 ERW = END ROAD WORK
 = PORTABLE CHANGEABLE MESSAGE SIGN

**CONSTRUCTION APPROACH
SIGNING
EXIT 16**

PROJECT NAME: NORWICH - BRADFORD
 PROJECT NUMBER: IM SURF (31)
 FILE NAME: /pave/11a030/p11a030.dgn PLOT DATE: 07-FEB-2012
 PROJECT LEADER: MIKE FOWLER DRAWN BY: WILDER
 DESIGNED BY: WILDER CHECKED BY: PVMT MGMT
 IPARM FILE NAME: p11a030.i7.1 SHEET 17 OF 19

**BEGIN /END PROJECT
CONSTRUCTION APPROACH SIGNING
I-91 SOUTHBOUND**

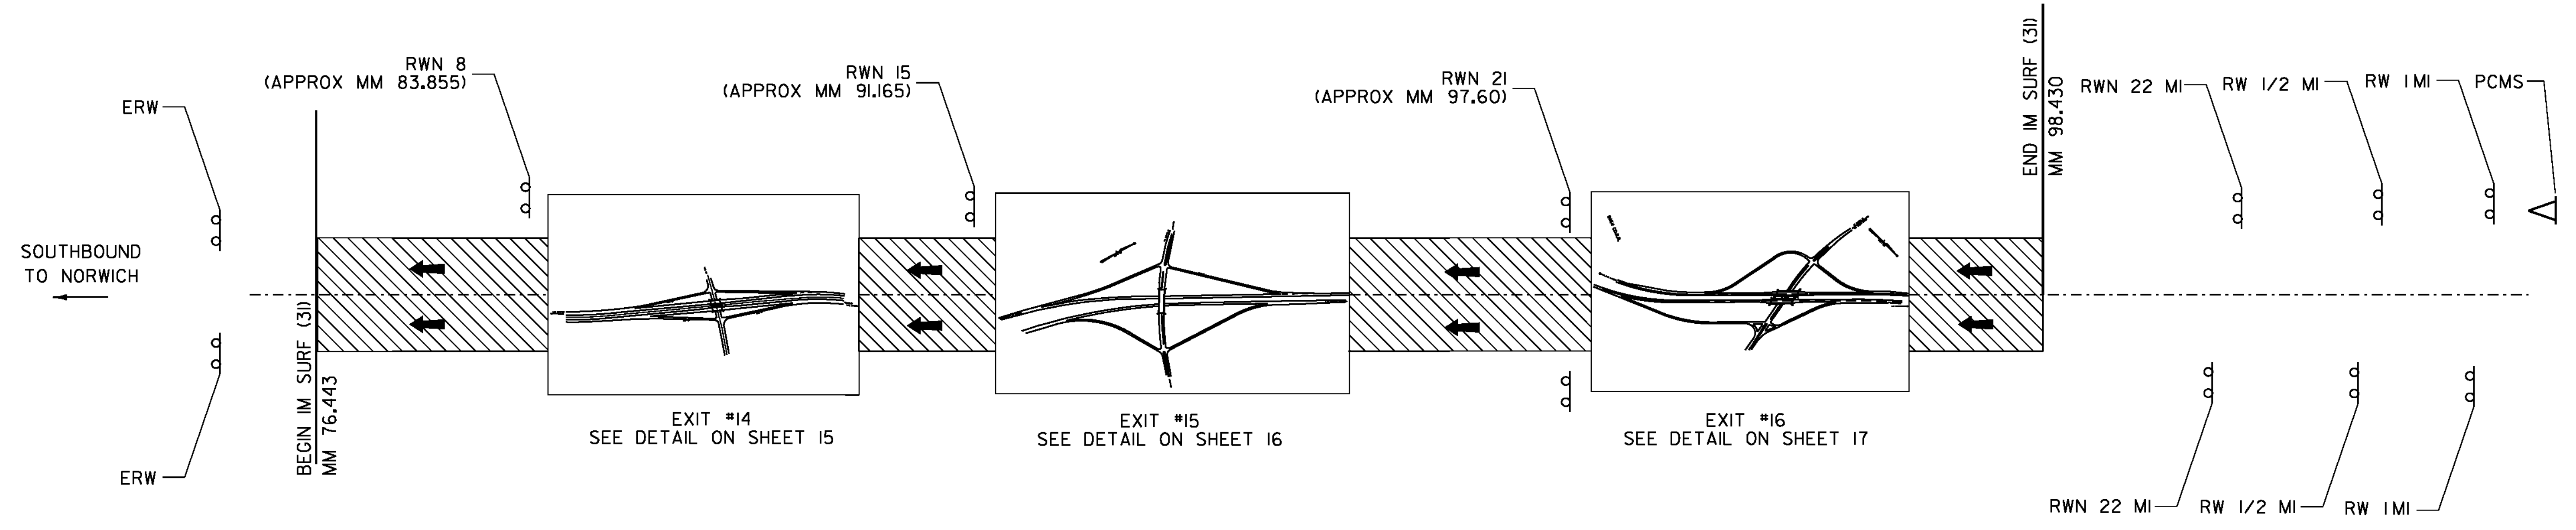

- LEGEND**
- RWN XX MILES = ROAD WORK NEXT XX MILES
 - ERW = END ROAD WORK
 - RW 1MI = ROAD WORK IN 1 MILE
 - RW 1/2 MI = ROAD WORK IN 1/2 MILE
 - △ = PORTABLE CHANGEABLE MESSAGE SIGN
 - ← = DIRECTION OF TRAFFIC FLOW
 - [Hatched Box] = WORK AREA

LIST OF CONSTRUCTION SIGNS - MAINLINE SB

LOCATION	RW 1MI	RW 1/2 MI	RWN 22 MILES	RWN 21 MILES	RWN 15 MILES	RWN 8 MILES	ERW	PCMS
I-91 SOUTHBOUND	2	2	2	1	1	1	2	1
TOTALS	2	2	2	1	1	1	2	1

NOT TO SCALE

CONSTRUCTION APPROACH MAINLINE SIGNING SHEET	PROJECT NAME: NORWICH - BRADFORD	
	PROJECT NUMBER: 1M SURF (3I)	
	FILE NAME: /pave/11a030/plla030.dgn	PLOT DATE: 07-FEB-2012
	PROJECT LEADER: MIKE FOWLER	DRAWN BY: WILDER
DESIGNED BY: WILDER	CHECKED BY: PVMT MGMT	
IPARM FILE NAME: plla030_18.1	SHEET 18	OF 19

NOTES:

1. THE CONTRACTOR SHALL SUBMIT A TRAFFIC CONTROL PLAN TO THE ENGINEER FOR APPROVAL PRIOR TO THE START OF CONSTRUCTION. THE COST OF PREPARING THIS PLAN (AND MAKING CHANGES IF NECESSARY) SHALL BE INCLUDED IN THE LUMP SUM PRICE FOR ITEM 641.10, TRAFFIC CONTROL.
2. THE CONTRACTOR SHALL INCLUDE A CONSTRUCTION SIGN APPROACH PACKAGE FOR EXPECTED LANE CLOSURES AND WORK ZONE SPEED REDUCTIONS IN COMPLIANCE WITH VTRANS STANDARDS E-103, E-106 AND THE LATEST REVISION OF THE 2009 MUTCD. PAYMENT FOR PROVIDING THIS PACKAGE SHALL BE INCIDENTAL TO ITEM 641.10, TRAFFIC CONTROL. WHERE CONFLICTS EXIST, THE MUTCD SHALL GOVERN.
3. THE BID PRICE FOR TRAFFIC CONTROL, ITEM 641.10, SHALL INCLUDE ALL APPROACH AND ON-PROJECT CONSTRUCTION SIGNING, PORTABLE ARROW BOARDS, BARRELS, CONES, BARRICADES, TEMPORARY REGULATORY AND WARNING SIGNS, AND POSTS AS DETAILED IN VTRANS STANDARDS. ALL ADJUSTING, RELOCATING, AND REMOVING OF THESE DEVICES AS DIRECTED BY THE ENGINEER SHALL ALSO BE INCLUDED. THE FOLLOWING ITEMS WILL BE PAID FOR SEPARATELY:
630.10 - UNIFORMED TRAFFIC OFFICERS
630.15 - FLAGGERS
646.622 - TEMPORARY 6 INCH WHITE LINE, PAINT
646.632 - TEMPORARY 6 INCH YELLOW LINE, PAINT
646.662 - TEMPORARY 12 INCH WHITE LINE, PAINT
646.692 - TEMPORARY LETTER OR SYMBOL, PAINT
4. PORTABLE CHANGEABLE MESSAGE SIGNS (PCMS) SHALL BE PROVIDED FOR USE ALONG THIS PROJECT. THE PLACEMENT OF THESE UNITS AS WELL AS THE MESSAGE WILL BE APPROVED BY THE ENGINEER. THESE SIGNS WILL BE PAID FOR UNDER ITEM 641.15, PORTABLE CHANGEABLE MESSAGE SIGN.

FOR THE DURATION OF THE PROJECT, THE CONTRACTOR SHALL POSITION A PCMS PRIOR TO EXIT 16 SOUTHBOUND LANE WARNING MOTORISTS OF EXPECTED ROADWAY CONDITIONS AND REDUCED ROADWAY WIDTHS.

PCMS SHOULD NOT REPLACE ANY OF THE SIGNING DETAILED IN THE MUTCD AND SHOULD NOT BE USED IF STANDARD TRAFFIC CONTROL DEVICES ADEQUATELY PROVIDE THE INFORMATION THE MOTORISTS NEED TO TRAVEL SAFELY.

THE PCMS SHALL CONSIST OF EITHER ONE OR TWO PHASES. TYPICALLY, A PHASE SHALL CONSIST OF UP TO THREE LINES OF EIGHT CHARACTERS PER LINE. THE PCMS SHOULD BE USED AS A SUPPLEMENT AND NOT AS A SUBSTITUTE FOR CONVENTIONAL SIGNS AND PAVEMENT MARKINGS.

THE PCMS SHOULD COMMUNICATE WHAT INFORMATION MOTORISTS NEED TO KNOW. UNNECESSARY INFORMATION SHOULD BE AVOIDED. MESSAGES SHOULD BE UPDATED AND/OR CHANGED PERIODICALLY TO DESCRIBE THE WORK ACTIVITY OCCURRING SO THAT THE PCMS CONTINUES TO COMMAND THE ATTENTION OF MOTORISTS.
5. NO CONSTRUCTION SIGNS SHALL BE INSTALLED AS TO INTERFERE OR OBSTRUCT THE VIEW OF EXISTING TRAFFIC CONTROL DEVICES, STOPPING SIGHT DISTANCE, AND CORNER SIGHT DISTANCE.
6. REFER TO VT. STATE STANDARDS AND THE 2009 MUTCD FOR TEMPORARY TRAFFIC CONTROL SIGN COLORS.
7. DURING CONSTRUCTION IT WILL BE NECESSARY FOR THE CONTRACTOR TO MAINTAIN ONE-LANE TRAFFIC FOR EXTENDED PERIODS OF TIME. IN NO CASE SHALL THE PAVED WIDTH FOR ONE-LANE TRAFFIC, INCLUDING SHOULDERS, BE REDUCED TO LESS THAN 15 FEET IN WIDTH. THIS PAVED WIDTH SHALL REMAIN FREE OF OBSTRUCTIONS AND OBSTACLES AT ALL TIMES.
8. ADDITIONAL RAMP SIGNING MAY BE REQUIRED, AS DIRECTED BY THE ENGINEER.
9. THE DISTANCE SHOWN ON THE "ROAD WORK NEXT XX MILES" (G20-1) SIGN SHALL BE STATED TO THE NEAREST ONE MILE. PLEASE REFER TO PART 6 OF THE 2009 MUTCD SECTION 6F.51.
10. EXISTING SPEED LIMIT SIGNS SHALL BE COMPLETELY COVERED WHEN REDUCED SPEED SIGNS ARE POSTED. KEEP RECORDS WHEN POSTING THE WORK ZONE SPEED LIMIT FOR LEGAL PURPOSES; DOCUMENTING DATES, TIMES, AND LOCATIONS OF SIGNS. WHEN WORK ZONE SPEED LIMIT IS NOT IN USE ALL ASSOCIATED SIGNS SHALL BE COVERED, TURNED OR LAID FLAT SO AS THE MOTORING PUBLIC CANNOT READ THESE SIGNS.
11. PORTABLE OR STATIONARY WORK ZONE SPEED LIMIT SIGNS SHOULD BE SPACED EVERY 1.5 TO 2 MILES WHERE APPLICABLE AS A REMINDER TO THE MOTORIST TRAVELING THROUGH THE WORK ZONE WHAT SPEED THEY SHOULD BE TRAVELING. ALL SPEED LIMIT SIGNS WITHIN THE TEMPORARY SPEED LIMIT ZONE SHALL INCLUDE THE G20-5aP "WORK ZONE" PLAQUE.
12. WHEN REDUCED REGULATORY SPEED LIMIT SIGNS ARE USED, THE RESUMPTION OF THE USUAL SPEED LIMIT SHALL BE INDICATED BY AN APPROPRIATE SPEED LIMIT SIGN AT THE END OF THE WORK ZONE.

TRAFFIC CONTROL NOTE SHEET	PROJECT NAME: NORWICH - BRADFORD	
	PROJECT NUMBER: IM SURF (31)	
	FILE NAME: /pave/lla030/plla030.dgn	PLOT DATE: 06-FEB-2012
PROJECT LEADER: MIKE FOWLER	DRAWN BY: WILDER	
DESIGNED BY: WILDER	CHECKED BY: PVMT MGMT	
IPARM FILE NAME: plla030_19.1	SHEET 19 OF 19	