



ABUT 1 - PLAN
SCALE 1/4" = 1'-0"

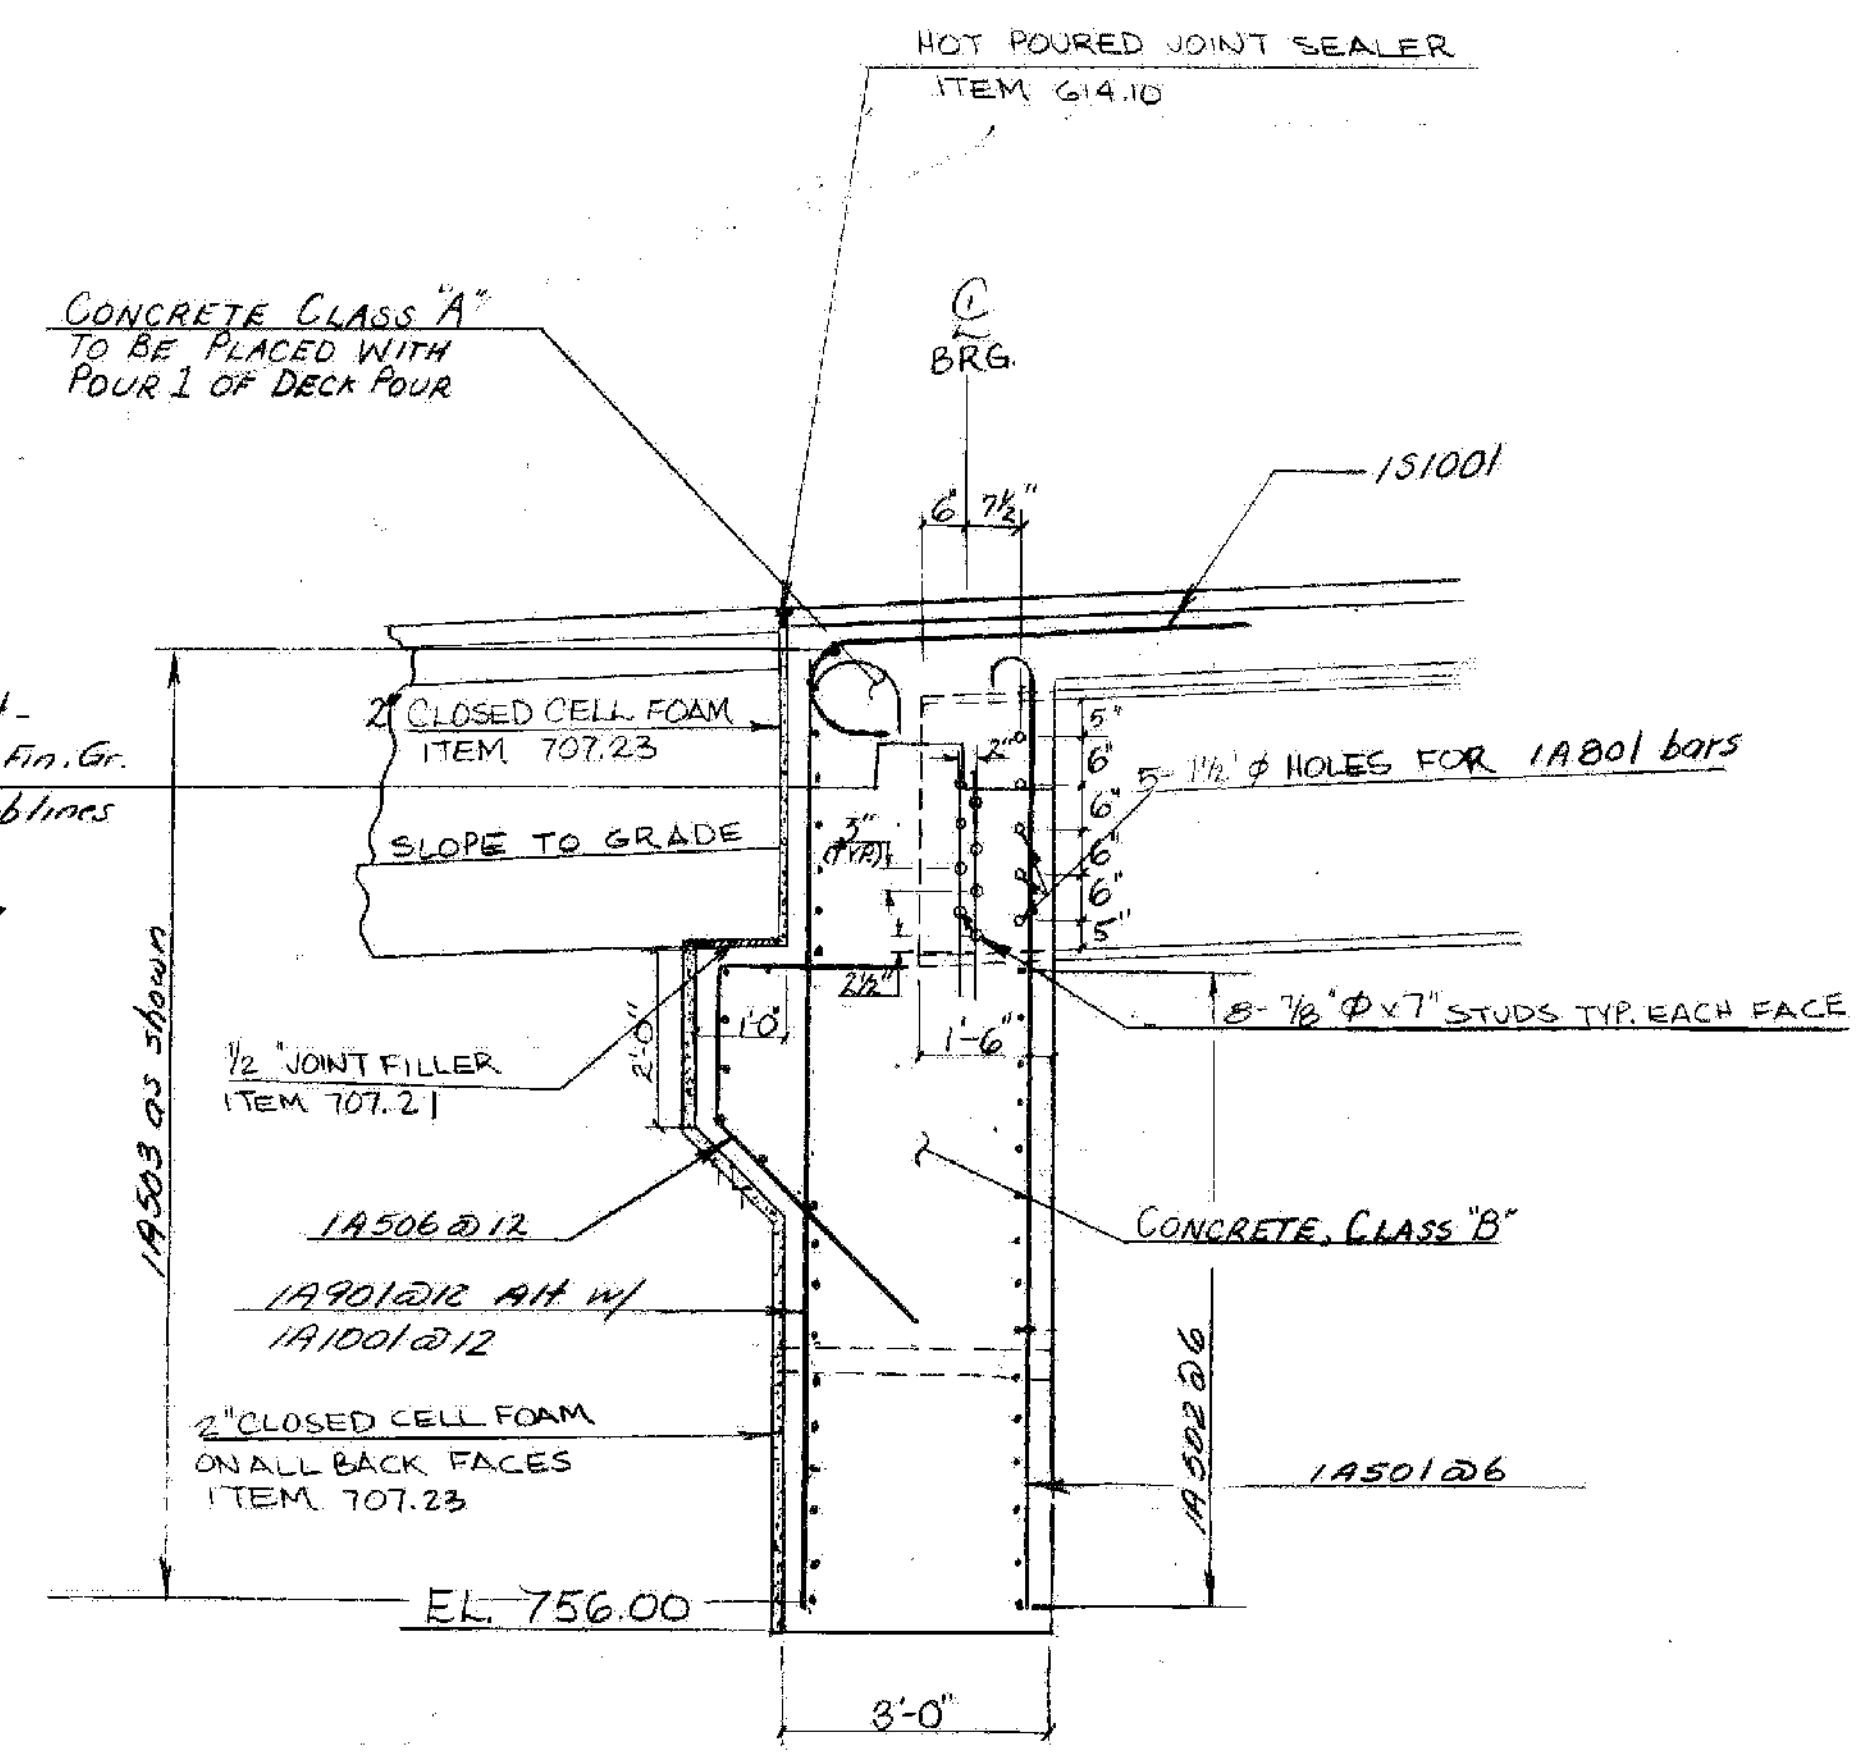

SECTION A-A (DECK SHOWN FOR CLARITY)
SCALE 1/2" = 1'

NOTE: ITEMS CONFORMING TO SPECIFICATIONS 707.21, 707.23 AND 707.30 SHALL BE SUBSIDIARY TO CONCRETE CLASS B.

I-93 BRIDGES 1N&S
WATERFORD
IM MEMB(31)
SHEET 16 OF 48
FOR REFERENCE ONLY

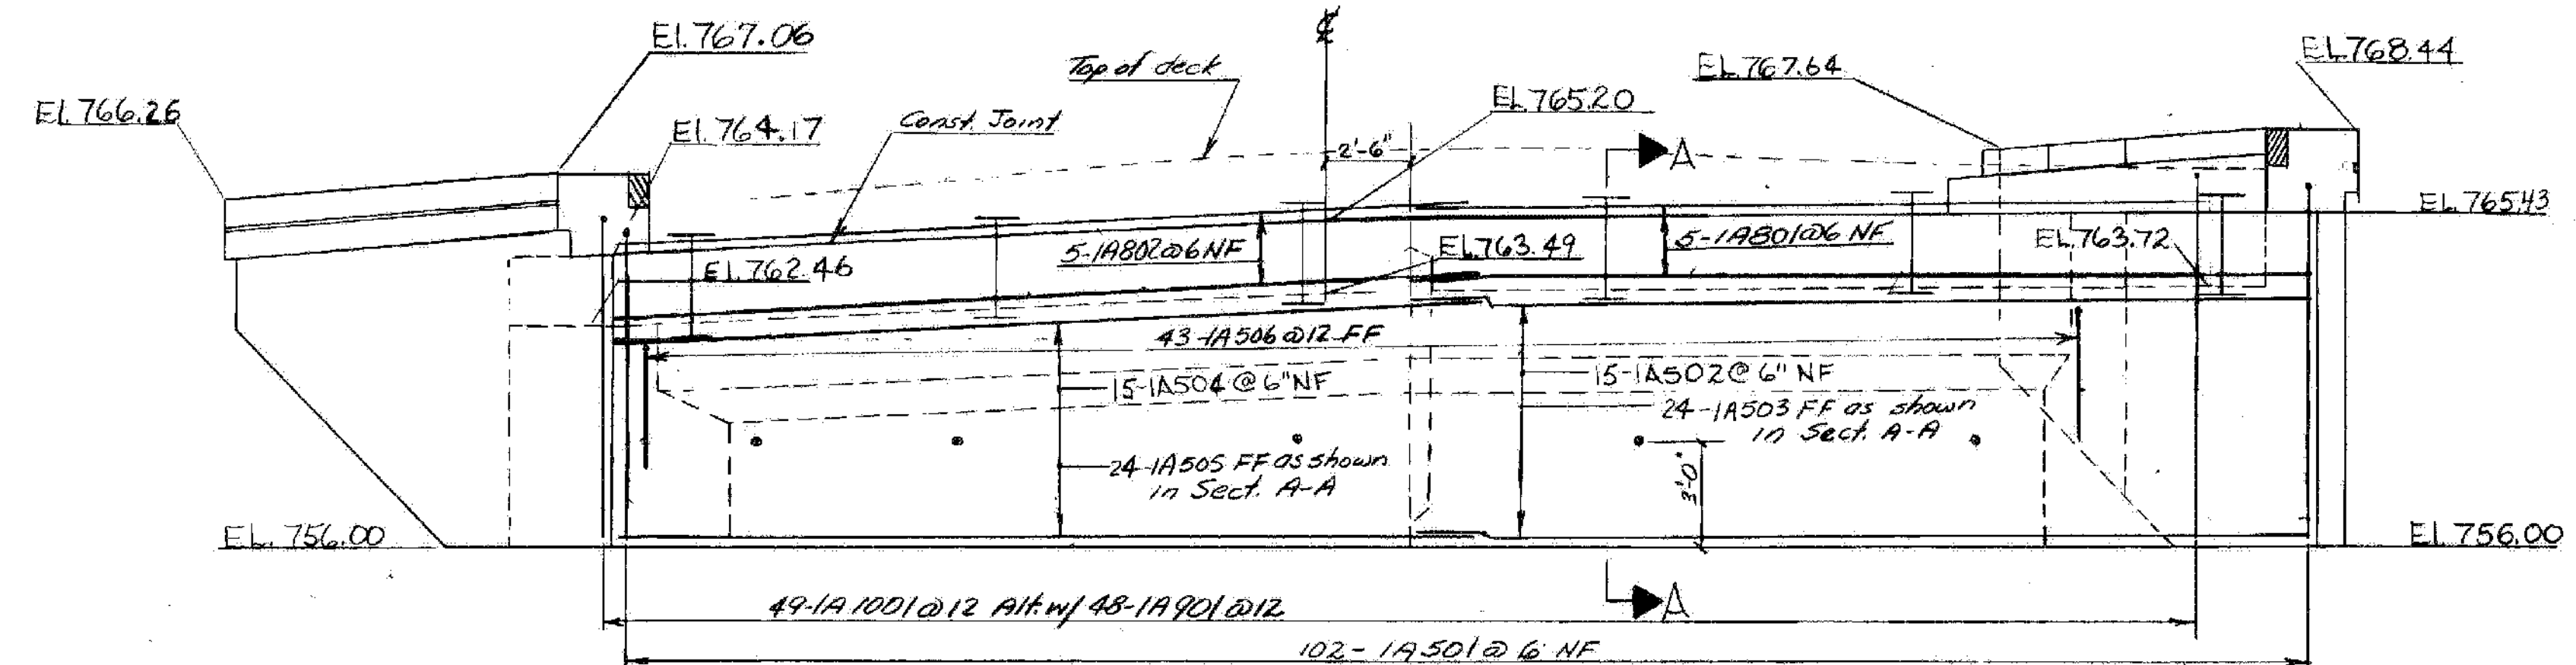

ABUT 1 - ELEV. SECTION B-B
SCALE 1/4" = 1'-0"

FF FAR FACE
NF NEAR FACE

STATE OF VERMONT	
AGENCY OF TRANSPORTATION	
TOWN OF WATERFORD	Bridge No. 1 SB
HIGHWAY NO. I 93	Log Sta.
I 93 NB. & SB Over VT. Rte. 18	
S.B. ABUTMENT DETAILS	
Designed by G. SPILAK	Drawn by M. HEALD
Checked by R. Elwood date 6-13-80	Bridge Design Supervisor R. HAUPT date 6-80
PROJECT CONTRACT I	PROJECT NO. I 93 - 1(3)
WATERFORD	Bridge Sheet No. BR 11.
Sheet 141 of 489	178 of 290