


SCALE: 1"=10'-0"

NEW HIGHWAY SECTION - BRIDGE APPROACHES

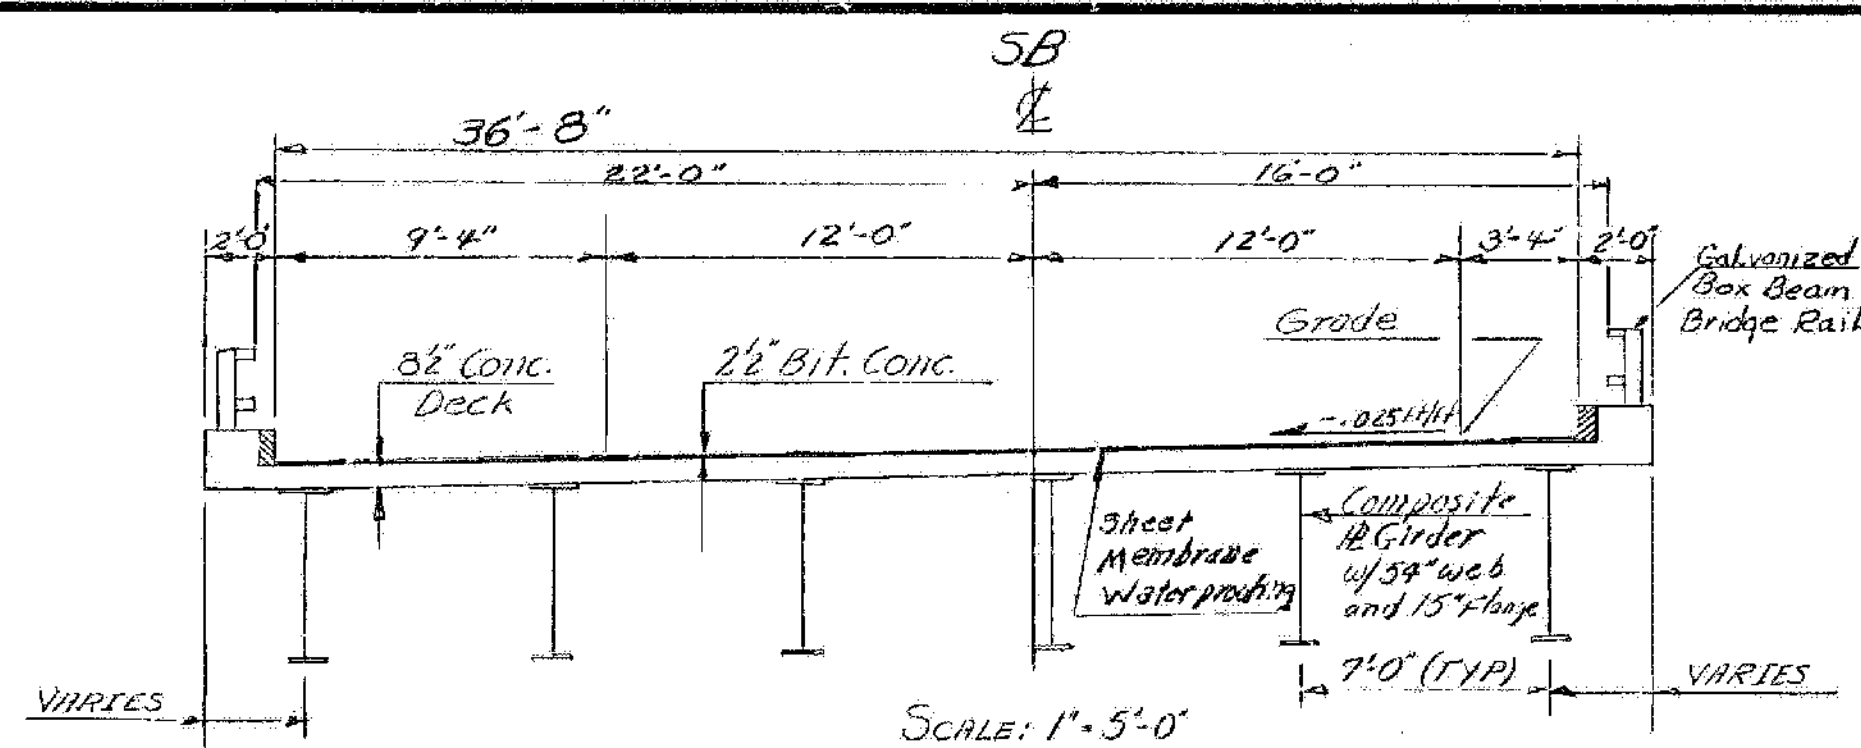

SCALE: 1"=5'-0"

SB BRIDGE TYPICAL SECTION

EXISTING STRUCTURE (None)

- STRUCTURE TYPE _____ OVERALL LENGTH _____ INVENTORY RATING _____
- SPAN LENGTH(S) CENTER TO CENTER OF BEARINGS _____
- CLEAR SPAN LENGTH(S) NORMAL TO STREAM _____
- WATERWAY AREA OF FULL OPENING (NORMAL TO STREAM) _____ VERTICAL CLEARANCE ABOVE STREAMBED _____
- WATER SURFACE ELEVATION @ Q 2.33 _____ WATER SURFACE ELEVATION @ Q _____
- WATER SURFACE ELEVATION AT FLOOD OF RECORD _____ YEAR _____ ESTIMATED DISCHARGE _____
- DOES ALL WATER PASS THROUGH EXISTING STRUCTURE? IF NOT, AT WHAT FREQUENCY AND ELEVATION DOES RELIEF OCCUR? _____
- ADDITIONAL WATERWAY AREA PROVIDED BY RELIEF _____
- TYPE OF SUBSTRUCTURE FOUNDATION MATERIAL _____
- DISPOSITION OF STRUCTURE _____

NEW STRUCTURE

STRUCTURE GEOMETRY:

- STRUCTURE TYPE COMPOSITE PLATE GIRDER OVERALL LENGTH SB = 113.08' NB = 113.04'
- SPAN LENGTH(S) CENTER TO CENTER OF BEARINGS SB = 16'-4" NB = 16'-4"
- VERTICAL CLEARANCE ABOVE STREAMBED OR ROAD UNDER NB = 16'-4" SB = 16'-4"
- CLEAR SPAN LENGTH(S) NORMAL TO STREAM N/A
- WATERWAY AREA OF FULL OPENING (NORMAL TO STREAM) N/A
- ARE PROVISIONS TO BE MADE FOR PUBLIC UTILITIES? NO

HYDRAULIC DATA: N/A


- Q 2.33 _____ WATER ELEVATION _____ VELOCITY _____
- Q 10 _____ WATER ELEVATION _____ VELOCITY _____
- Q 25 _____ WATER ELEVATION _____ VELOCITY _____
- Q 50 _____ WATER ELEVATION _____ VELOCITY _____
- Q 100 _____ WATER ELEVATION _____ VELOCITY _____
- DRAINAGE AREA _____ CHARACTER OF TERRAIN _____
- ARE THERE OBJECTIONS TO A PIER IN THE STREAM? _____
- DOES STREAM REACH ITS MAXIMUM HIGH WATER ELEVATION RAPIDLY? _____ IS ORDINARY RISE RAPID? _____
- NATURE OF NATURAL STREAMBED _____
- ESTIMATED SCOUR DEPTH _____ COMMENT ON: DRIFT _____ ICE _____
- WILL ALL WATER PASS THROUGH NEW STRUCTURE? IF NOT, WHAT FREQUENCY AND ELEVATION WILL RELIEF OCCUR? _____
- ADDITIONAL WATERWAY AREA PROVIDED BY RELIEF _____
- VERTICAL CLEARANCE ABOVE Q _____
- ALLOWABLE WATER SURFACE ELEVATION LIMITED BY _____
- IS DESIGN STAGE AFFECTED BY UPSTREAM OR DOWNSTREAM CONDITIONS? IF YES, DESCRIBE _____
- AVERAGE DAILY LOW FLOW _____ DEPTH _____ AVERAGE DAILY HIGH FLOW _____ DEPTH _____
- STREAMBANK OR CHANNEL PROTECTION REQUIRED _____
- DISTANCE TO EXISTING UPSTREAM STRUCTURE _____ SPAN _____ WATERWAY AREA OF FULL OPENING _____
- DISTANCE TO EXISTING DOWNSTREAM STRUCTURE _____ SPAN _____ WATERWAY AREA OF FULL OPENING _____

ALLOWABLE STRESSES:

- DESIGN LIVE LOAD AASHTO H15 25-44
- ALLOWABLE LOAD FOR SPREAD FOOTINGS ON SOIL 2 Tons/FT² ON LEDGE N/A
- ALLOWABLE LOAD FOR PILING N/A TYPE N/A ESTIMATED LENGTH N/A
- ALLOWABLE STRESS FOR STRUCTURAL STEEL ASTM A 588 TENSION 27,000 PSI
- ALLOWABLE STRESS FOR REINFORCING STEEL GRADE 60 TENSION 24,000 PSI COMPRESSION 20,000 PSI
- ALLOWABLE STRESS FOR CONCRETE CLASS A 3,500 PSI CLASS B 3,500 PSI 1,400 PSI 1,400 PSI


TRAFFIC MAINTENANCE:

- IS TRAFFIC TO BE MAINTAINED? N/A IF YES, ON EXISTING STRUCTURE N/A OR ON TEMPORARY BRIDGE N/A
- TEMPORARY BRIDGE REQUIREMENTS: ONE OR TWO WAY N/A TRAFFIC CONTROL SIGNALS REQUIRED N/A MINIMUM CLEAR SPAN N/A MINIMUM CLEAR HEIGHT N/A MINIMUM WATERWAY AREA N/A ARE SIDEWALKS REQUIRED? N/A IF SO, ON WHAT SIDE? N/A

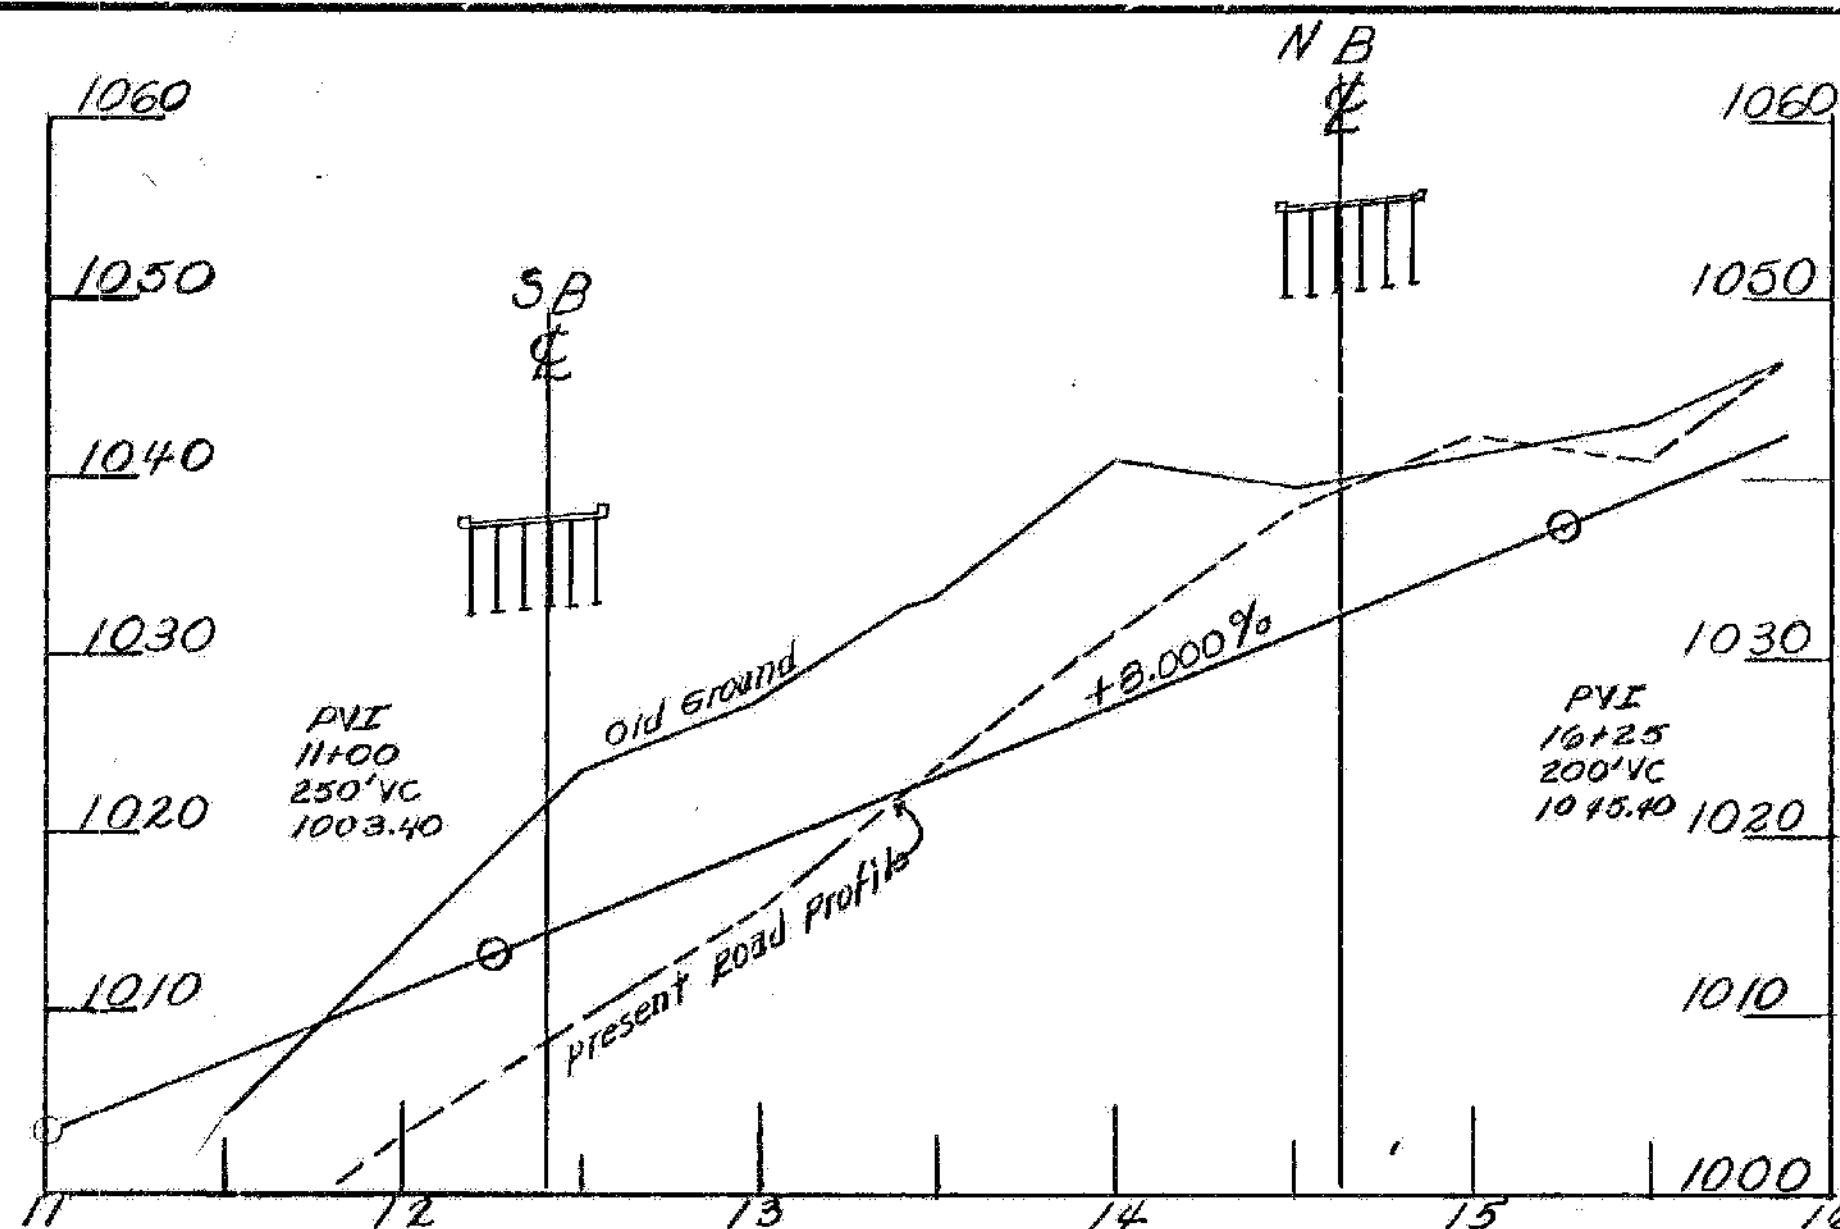


TOWN HIGHWAY #12 - PROFILE

Scale: 1"=50' (hor)
1"=10' (vert)

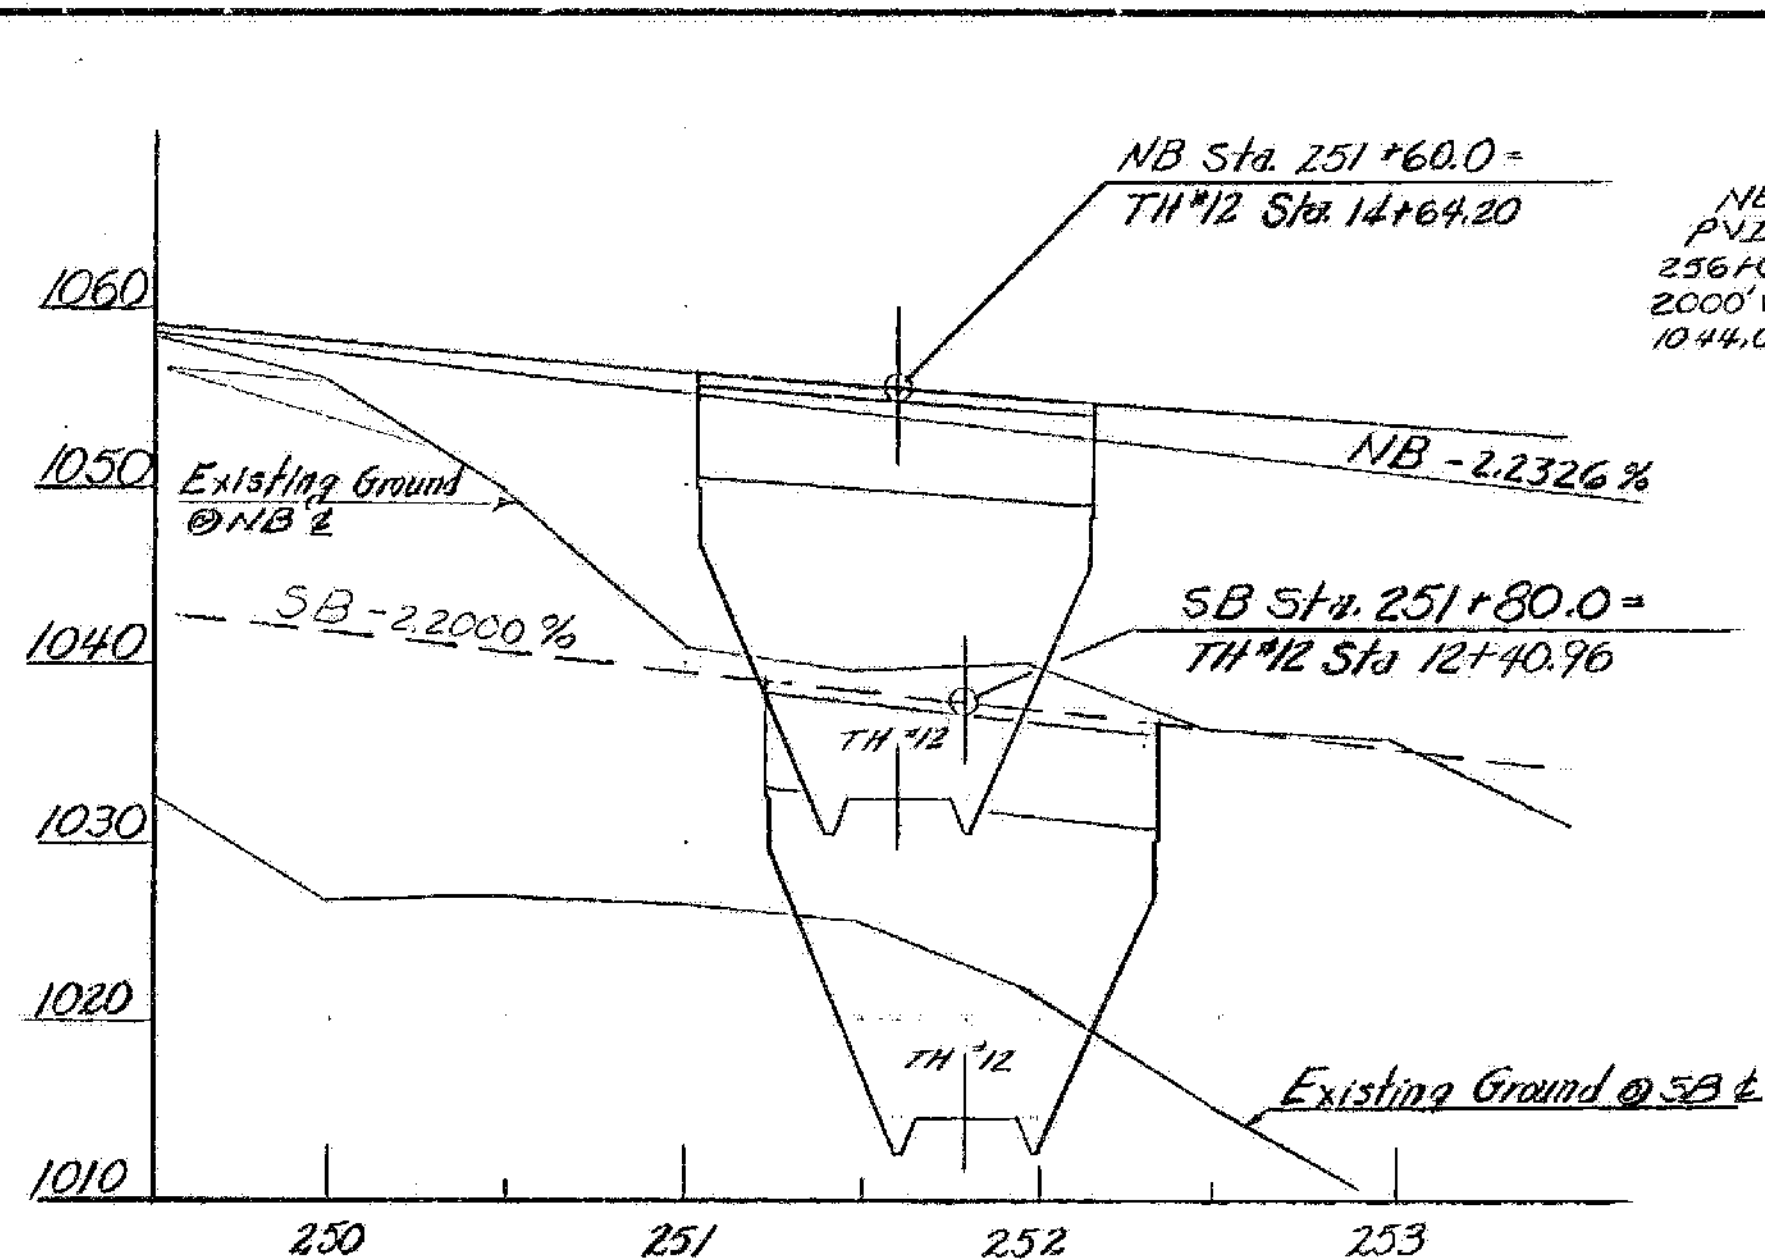

NB & SB PROFILE

Scale: 1"=50' (hor)
1"=10' (vert)

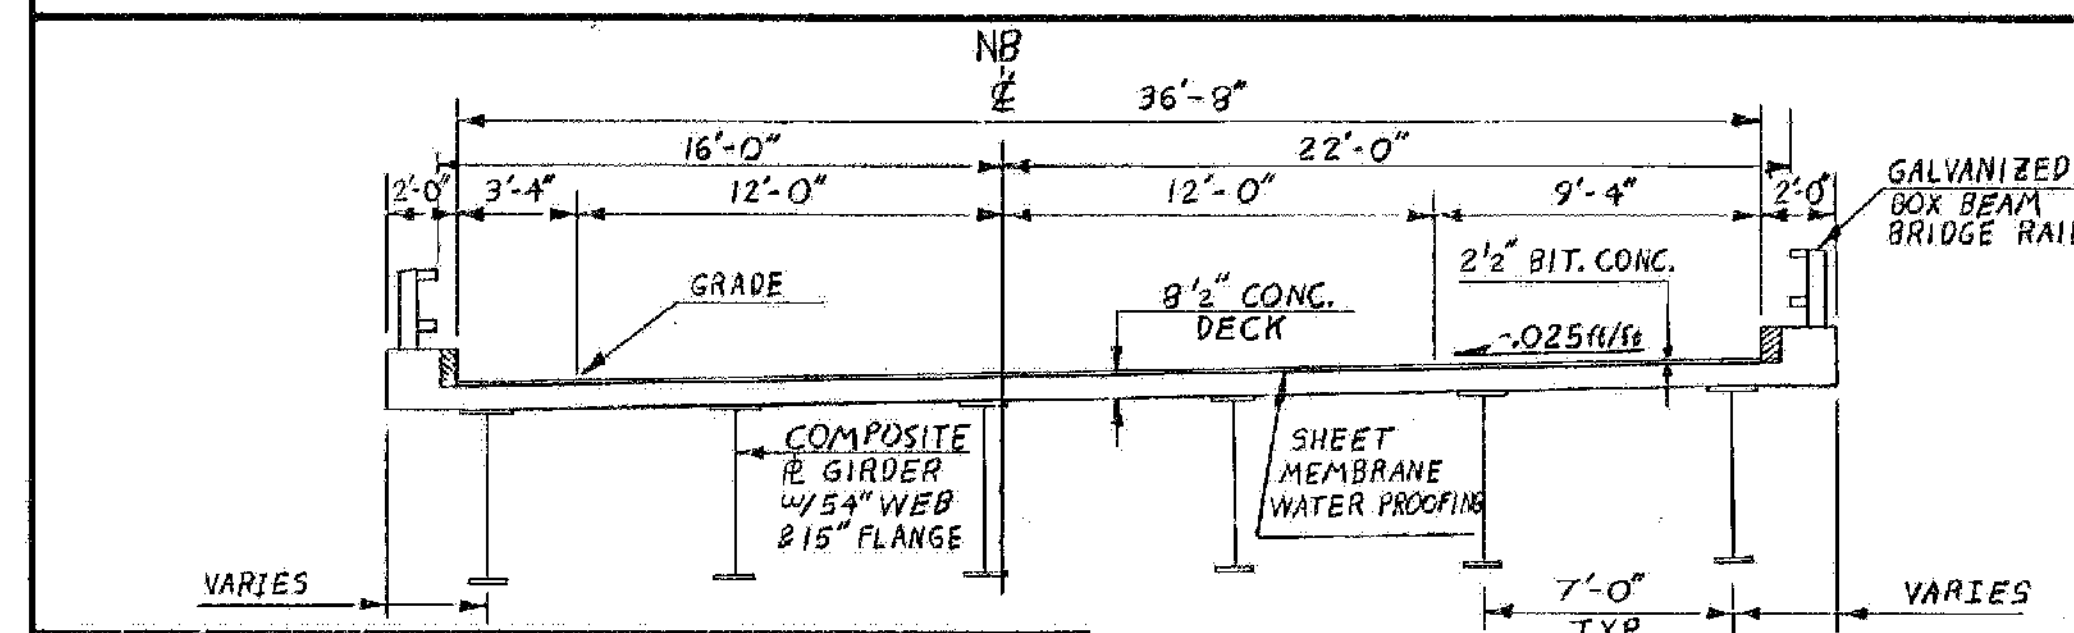

NB BRIDGE TYPICAL SECTION

SCALE: 1"=5'-0"

LOAD RATING (TONS)

STRESS LEVELS	TRUCK						
	H5	H	3S2	6 AXLE	3A STR.	4A STR.	5A SEMI
INVENTORY 0.55 F _y = 27.0	52	47					
POSTED 0.67 F _y = 33.5	74	93			77	78	87
OPERATING 0.75 F _y = 37.5	114	131					

RECOMMENDED FOR APPROVAL

W. M. Smith 1-30-80
STRUCTURES ENGINEER DATE

RECOMMENDED FOR APPROVAL

Chris Jones 1-30-80
CHIEF OF DESIGN DATE

APPROVED BY

S. J. Cone 1-30-80
DIRECTOR OF ENGINEERING & CONSTRUCTION DATE

STATE OF VERMONT
AGENCY OF TRANSPORTATION

TOWN OF WATERFORD
HIGHWAY NO. I 93 NB & SB

REVISIONS

NO.	DESCRIPTION	BY & DATE


1-93 BRIDGES 3N&S
WATERFORD (IM MEMB(31)
SHEET 25 OF 48
FOR REFERENCE ONLY

Bridge No. B5
Log Sta. _____
Surv. Sta. 251+70

I 93 NB & SB OVER TH #12
PRELIMINARY INFORMATION SHEET


Designed by Plumb Drawn by Plumb
Checked by S. Farnsworth Bridge Design Supervisor
G. ROGERS 9/80 date 1-21-80 F. W. Balkum date 1-80

PROJECT WATERFORD PROJECT NO. I 93-1(3) 9/2
Bridge Sheet No. BR500 Sheet 121 of 531

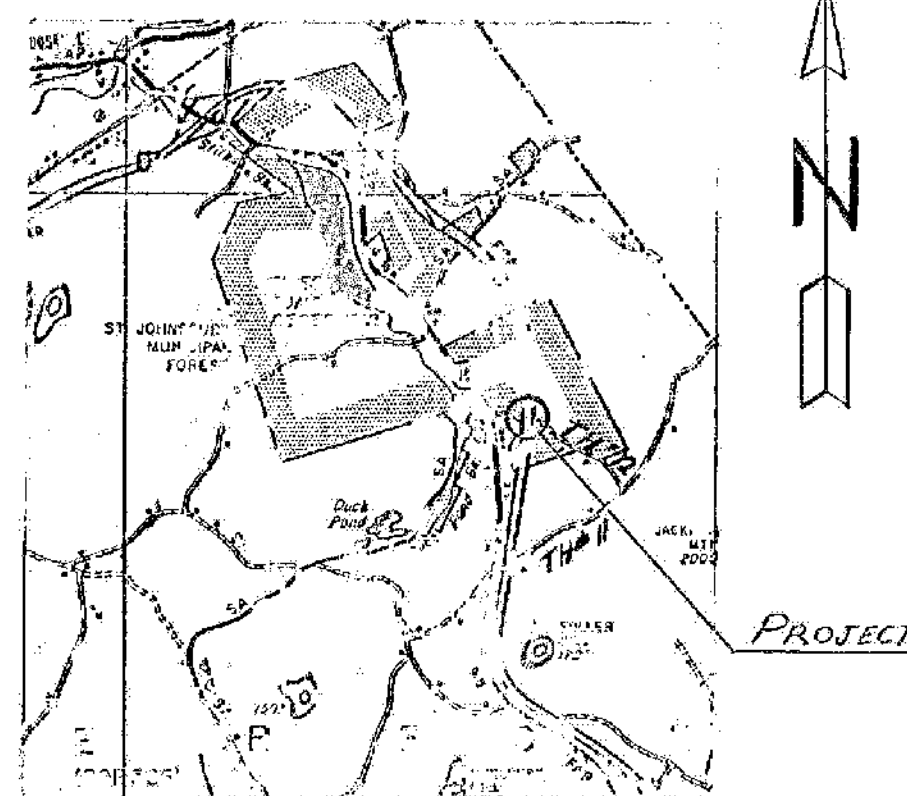

PROJECT LOCATION

Scale: 1"=1 mile

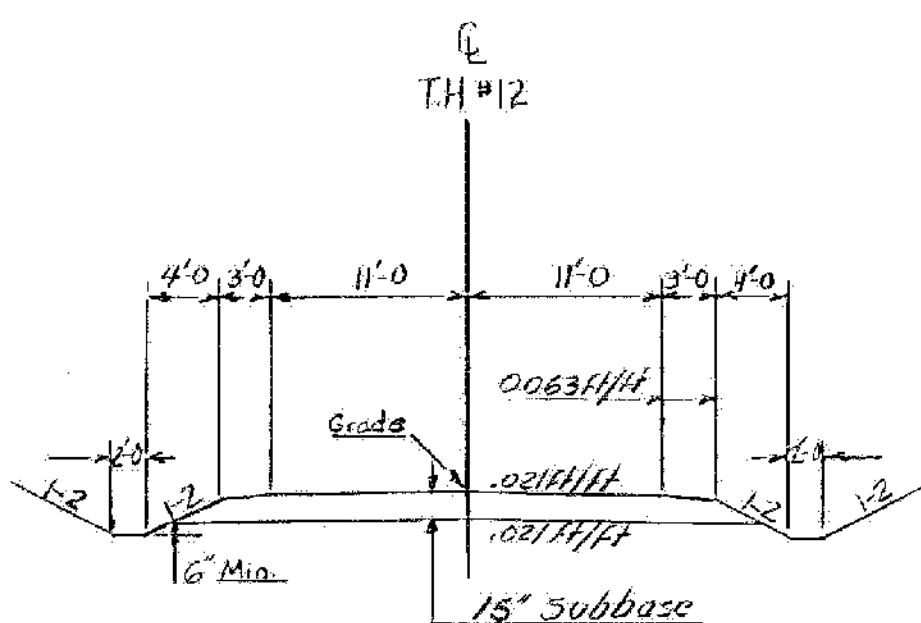

SCALE: 1"=10'-0"

TOWN HIGHWAY SECTION NORMAL

INDEX OF SHEETS ON SHEET BR502
GENERAL NOTES ON SHEET BR503

ALL AB