



PLAN
SCALE: 1" = 10'-0"

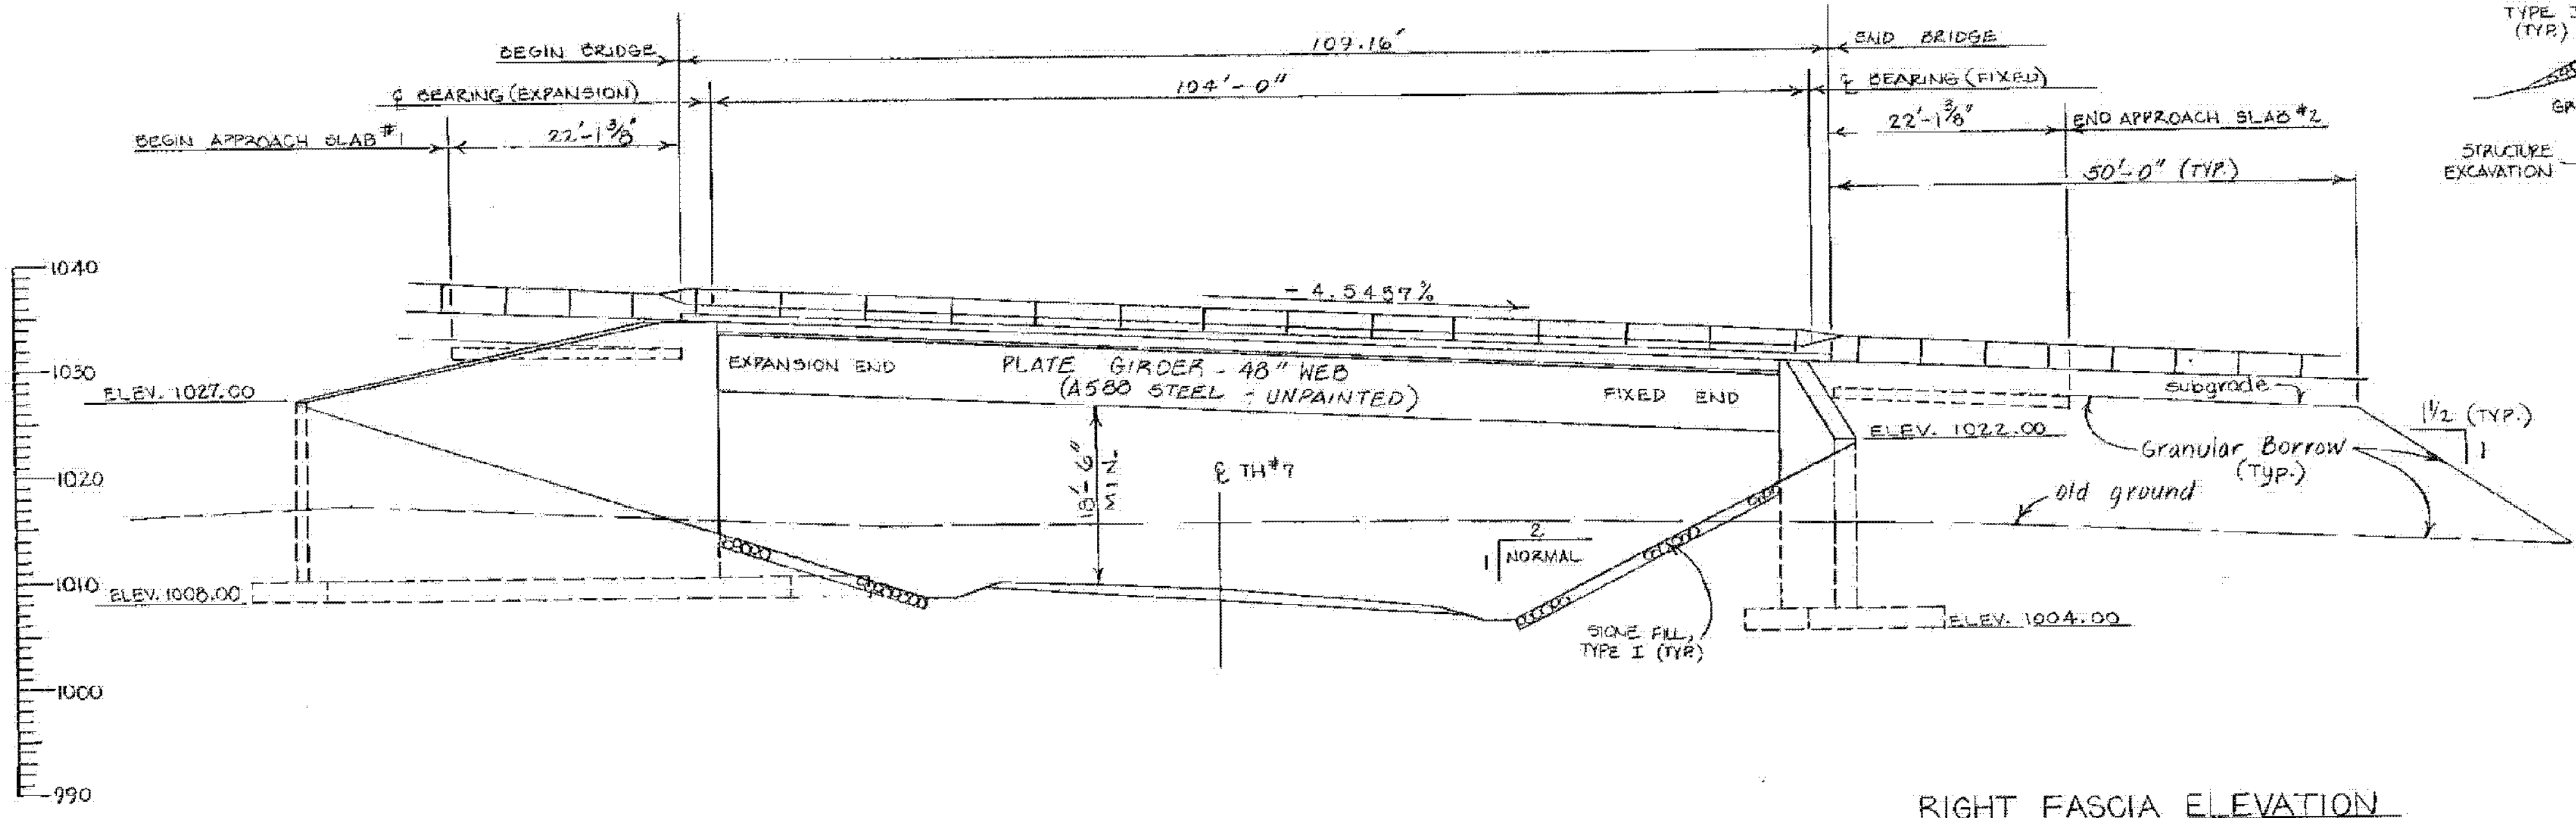

RIGHT FASCIA ELEVATION
SCALE: 1" = 10'-0"

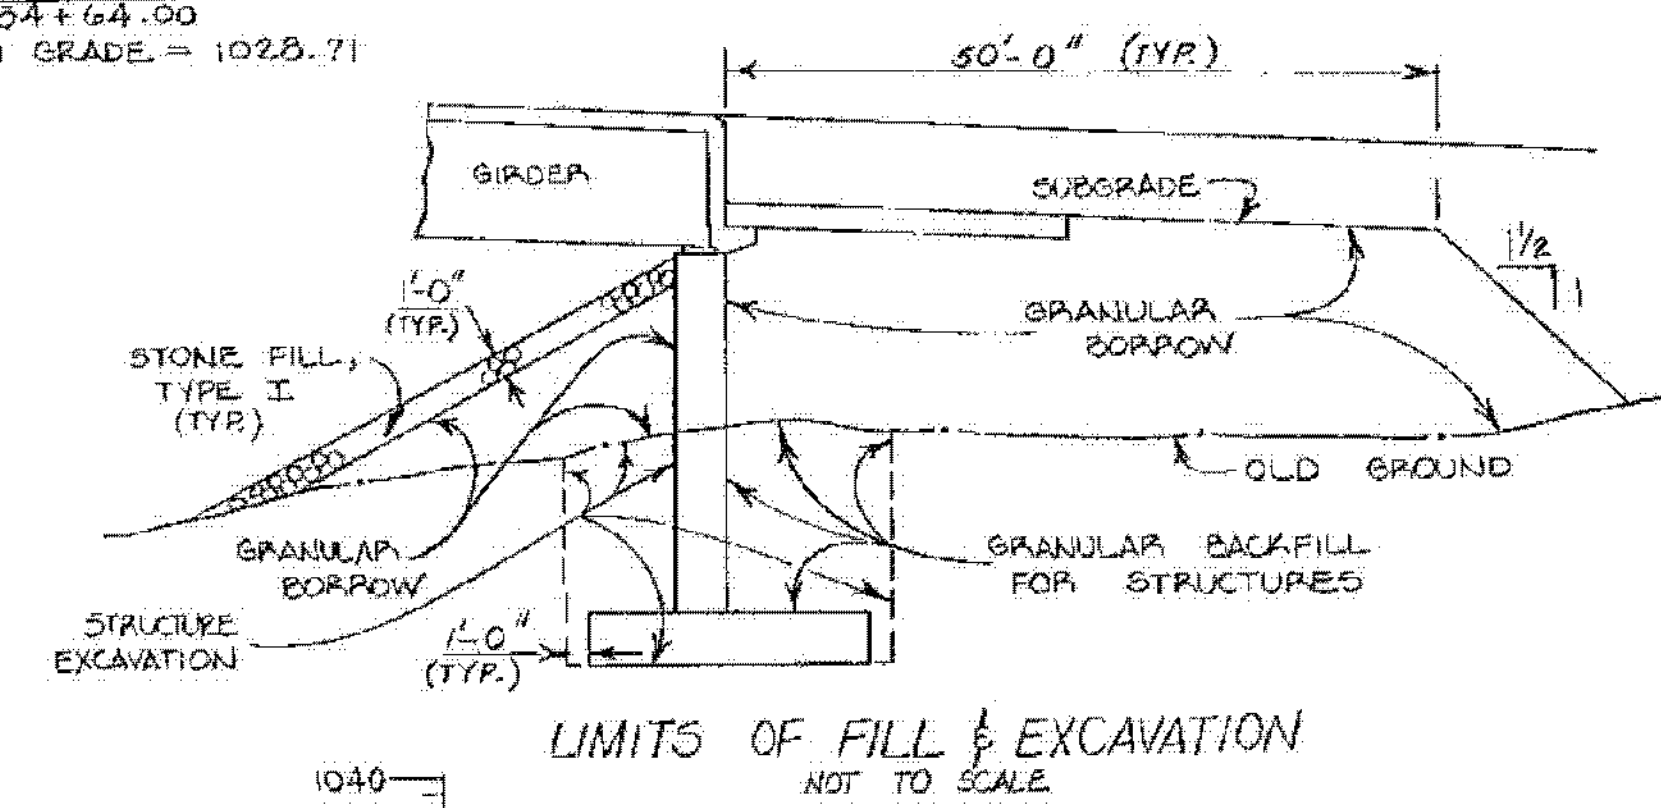

I-93 BRIDGES SN&S
WATERFORD
IM MEMB(31)
SHEET 35 OF 48
FOR REFERENCE ONLY

STATE OF VERMONT	
AGENCY OF TRANSPORTATION	
TOWN OF WATERFORD	Bridge No. 87
HIGHWAY NO. I 93	Log Sta. Surv. Sta. 354+03
I 93 NORTHBOUND OVER TH#7 PLAN & ELEVATION SHEET	
Designed by G. S. ROGERS	Drawn by G. L. DAVIS
Checked by R. W. JENSEN date 1/22/80	Bridge Design Supervisor F.Y. Bolkin date 1/80
PROJECT WATERFORD	PROJECT NO. I93-(3)CONTR.# 2
Bridge Sheet No. 02,702	Sheet 153 of 531

BRIDG-44 (1) 4/81