



INDEX OF SHEETS

SEE SHEET 2

STATE OF VERMONT
AGENCY OF TRANSPORTATION

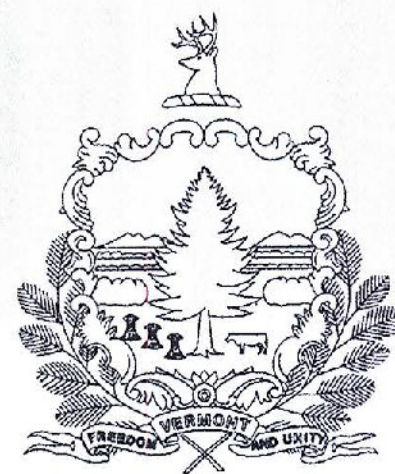

PROPOSED IMPROVEMENT
BRIDGE PROJECT
TOWN OF WATERFORD
COUNTY OF CALEDONIA
PROJECT IM MEMB(31)

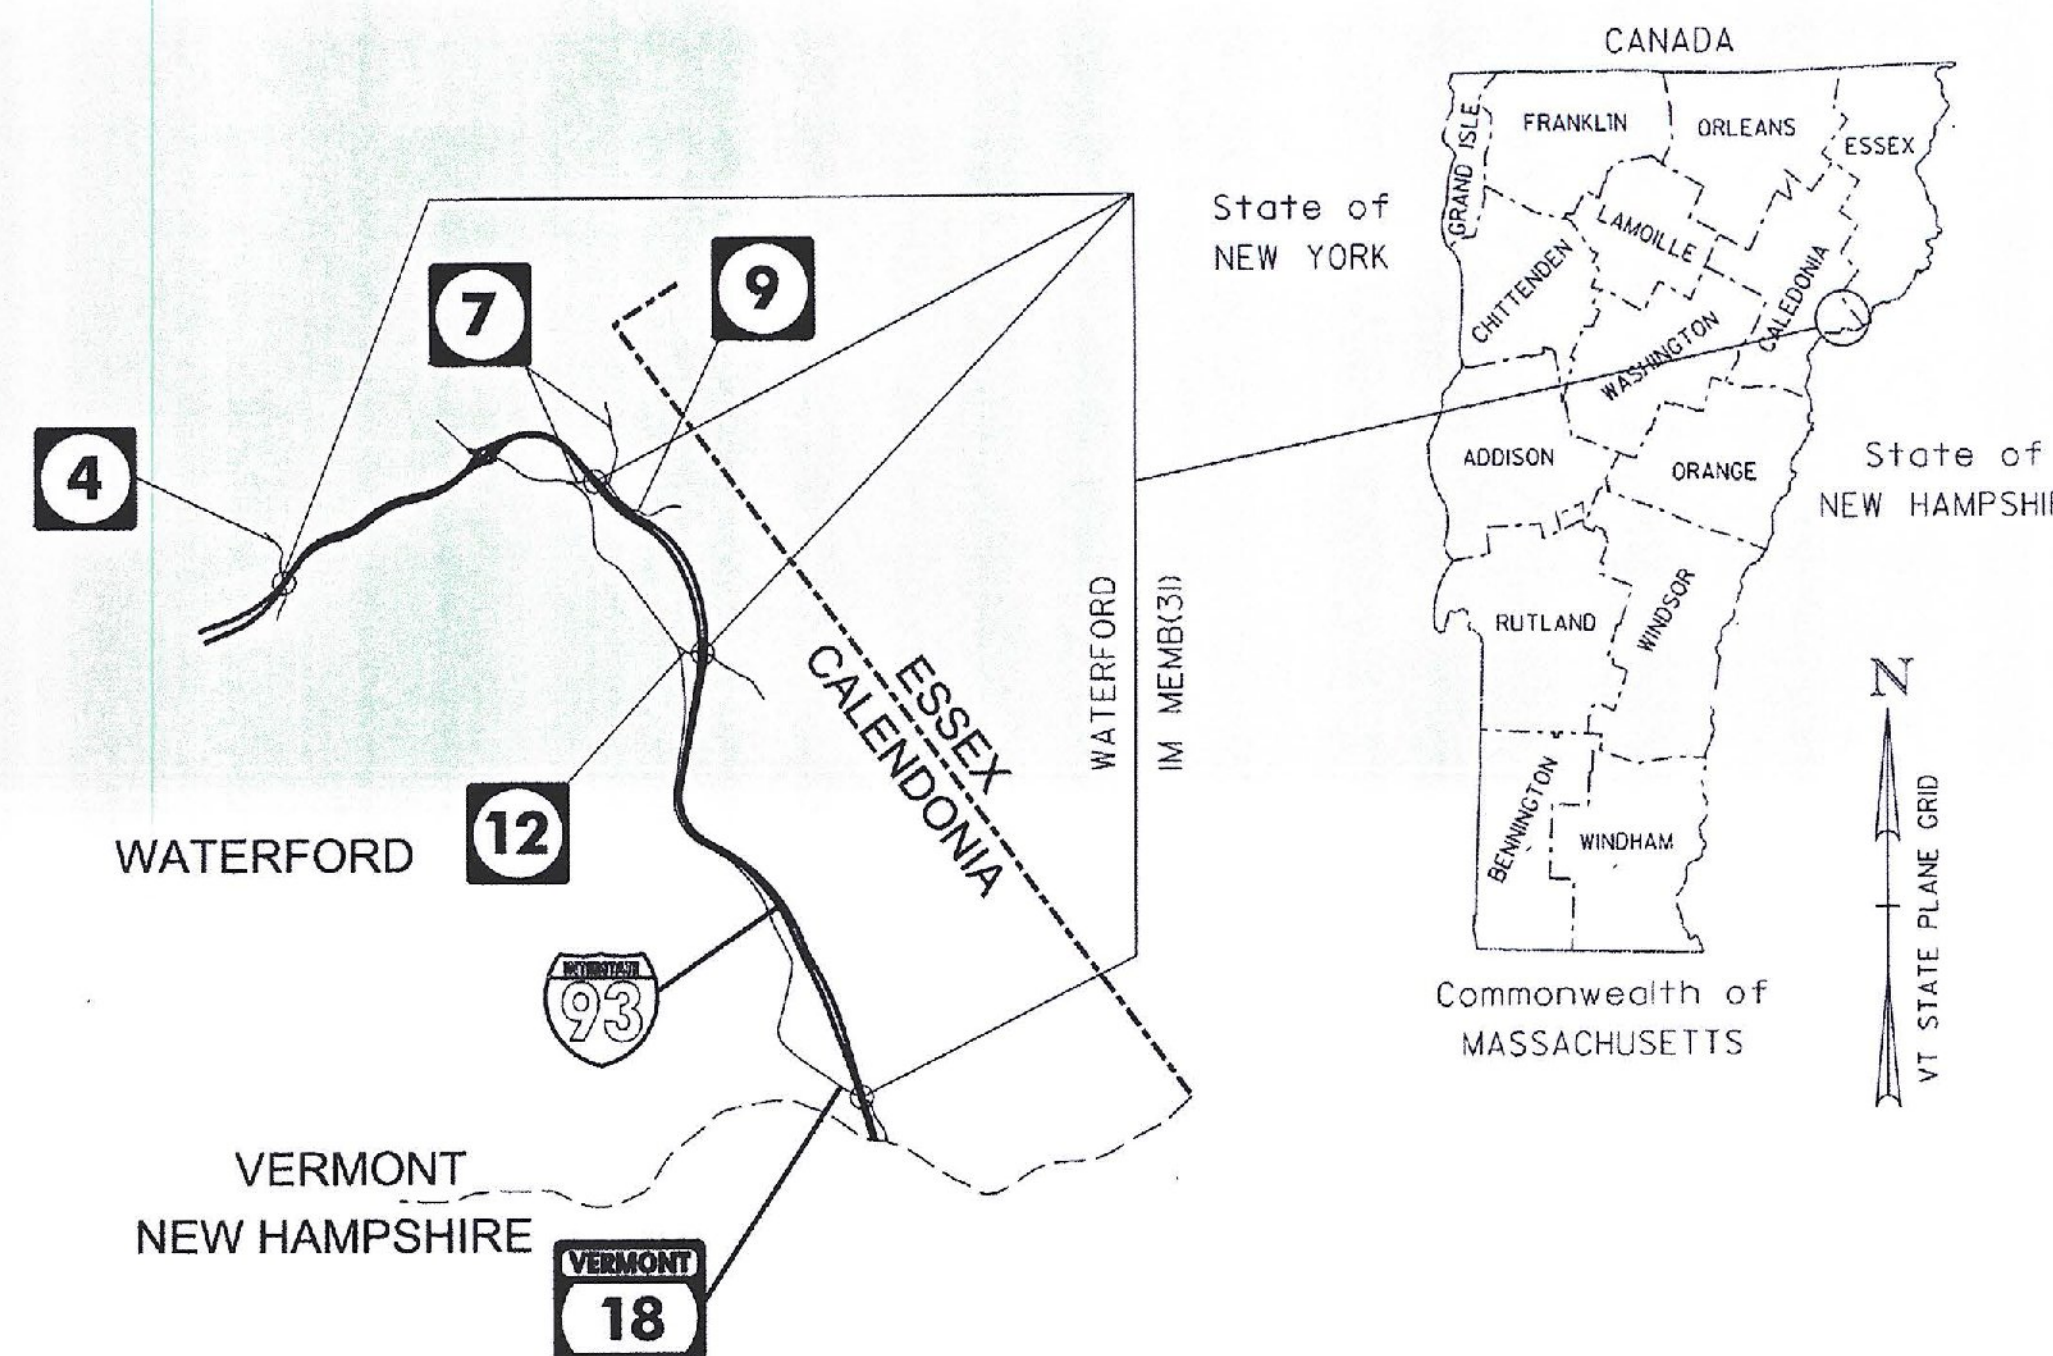

LOCATION MAP
NOT TO SCALE

ROUTE NO.: INTERSTATE I-93
TH NO. 4 (DANIELS FARM ROAD)

BRIDGE NO.: 1N&S, 3N&S, 5N&S, 8

PROJECT LOCATION: BR 1N&S OVER VT 18 (MM 0.367)
BR 3N&S OVER TH NO. 12 (OLD COUNTY ROAD) (MM 4.60)
BR 5N&S OVER TH NO. 7 (WALSH ROAD) (MM 6.385)
BR 8 OVER I-93 (MM 9.53) (T.H. NO. 4 - DANIELS FARM ROAD)

PROJECT DESCRIPTION: THIS PROJECT INVOLVES REMOVING AND REPLACING THE SHEET MEMBRANE WATERPROOFING AND BITUMINOUS CONCRETE PAVEMENT ON THE BRIDGE AND ITS APPROACHES ALONG WITH MINOR RELATED WORK.

LENGTH OF STRUCTURES:	BR 1N	204.88'
	BR 1S	170.91'
	BR 3N	113.04'
	BR 3S	113.08'
	BR 5N	109.16'
	BR 5S	108.96'
	BR 8	306.44'

TOTAL LENGTH OF STRUCTURES: 1126.47'

RECORD PLANS

CONTRACTOR: J.P. SICARD, INC. - BARTON, VT

RESIDENT ENGINEER: JAY STRONG

CONSTRUCTION BEGAN: JULY 5, 2012

CONSTRUCTION COMPLETE: SEPTEMBER 27, 2014

RECORD PLANS BY: JAY STRONG & CRAIG PIERCE

I HEREBY CERTIFY THAT ALL THE CONSTRUCTION REQUIRED BY THIS SET OF DRAWINGS HAS BEEN ACCOMPLISHED AS INDICATED HEREIN.

BY *Jay Strong* RESIDENT ENGINEER

DATE 10/8/2015

NOTE: Any further information concerning final quantities, amounts or other details relative to this project may be found by contacting Vtrans Records Management.



THESE PLANS ARE SUBJECT TO SUCH ENGINEERING CHANGES AS MAY BE REQUIRED BY THE FEDERAL HIGHWAY ADMINISTRATION OR THE DIRECTOR OF PROGRAM DEVELOPMENT.
CONSTRUCTION IS TO BE CARRIED ON IN ACCORDANCE WITH THESE PLANS AND THE STANDARD SPECIFICATIONS FOR CONSTRUCTION DATED 2006, AS APPROVED BY THE FEDERAL HIGHWAY ADMINISTRATION ON JUNE 15, 2006 FOR USE ON THIS PROJECT, INCLUDING ALL SUBSEQUENT REVISIONS AND SUCH REVISED SPECIFICATIONS AND SPECIAL PROVISIONS AS ARE INCORPORATED IN THESE PLANS.

 540 Commercial Street Manchester, NH 03101 (603) 668-9223 • Fax: (603) 668-8802 email: cld@cldeengineering.com • www.cldeengineering.com Maine • New Hampshire • Vermont	DIRECTOR OF PROGRAM DEVELOPMENT
	APPROVED <i>Douglas Bonneau</i> DATE 1/2/12
	PROJECT MANAGER : DOUGLAS BONNEAU
	PROJECT NAME : WATERFORD
	PROJECT NUMBER : IM MEMB(31)
	SHEET 1 OF 48 SHEETS

PLANS PREPARED BY:


QUALITY ASSURANCE PROGRAM: LEVEL I

SURVEYED BY : N/A
SURVEYED DATE : N/A

DATUM
VERTICAL N/A
HORIZONTAL N/A

CONVENTIONAL SYMBOLS

COUNTY LINE	
TOWN LINE	
LIMITS OF ACCESS	
POINT OF ACCESS	
FENCE LINE	
STONE WALL	
TRAVELED WAY	
GUARD RAIL	
RAILROAD	
SURVEY LINE	
CULVERT	
POWER POLE	
TELEPHONE POLE	
TREES	
CONTROL OF ACCESS	
PROPERTY LINE	
R.O.W. TAKING LINE	
SLOPE RIGHTS	
TOP OF CUT	
TOE OF SLOPE	

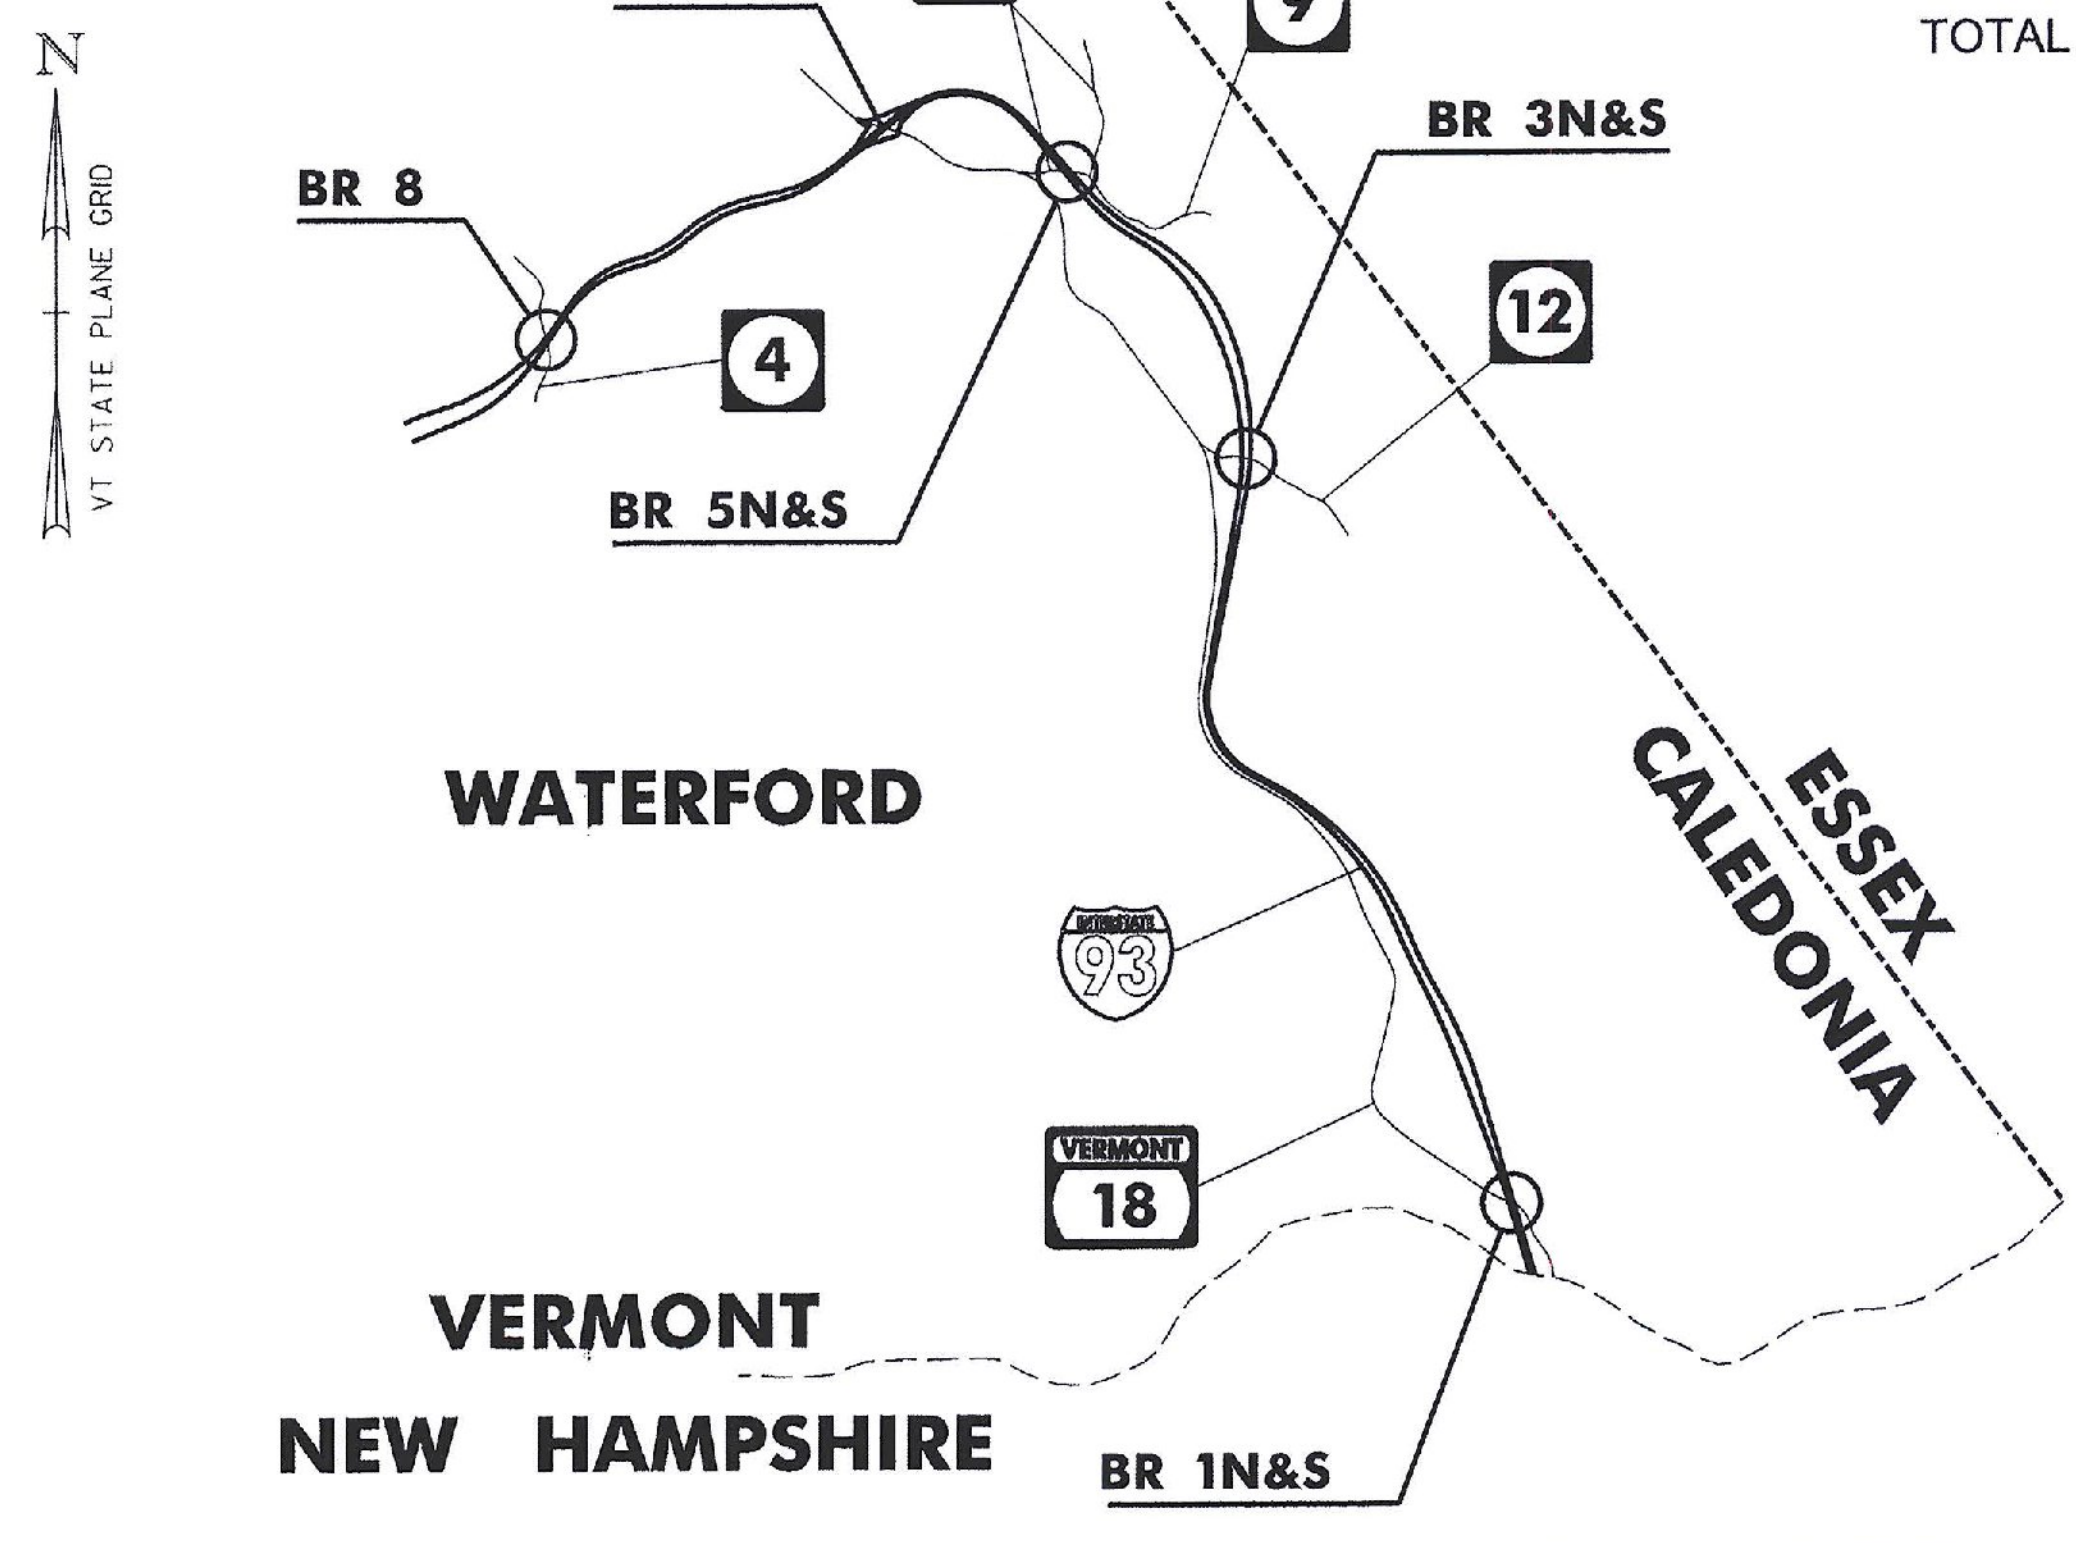

INDEX OF SHEETS

1. TITLE SHEET
2. INDEX OF SHEETS AND PROJECT NOTES
- 3.-4. QUANTITY SHEETS
- 5.-7. TRAFFIC CONTROL SHEETS 1-3
8. BITUMINOUS CONCRETE REMOVAL PLAN
- 9.-10. BITUMINOUS CONCRETE DETAILS SHEETS 1-2
11. PAVEMENT JOINT DETAILS
12. BARRIER RAIL DETAILS
- 12A. VAO T STANDARD SB-R4B-82
- 13.-24. REFERENCE PLANS - BRIDGES IN&S
- 25.-33. REFERENCE PLANS - BRIDGES 3N&S
- 34.-42. REFERENCE PLANS - BRIDGES 5N&S
- 43.-48. REFERENCE PLANS - BRIDGE 8

VAOT STANDARD SHEETS

01/02/04	E-100	CONSTRUCTION APPROACH SIGNS
01/02/04	E-100A	SIDE ROAD CONSTRUCTION APPROACH SIGNS
05/30/03	E-101	CONSTRUCTION SIGN DETAILS
06/30/03	E-102	CONSTRUCTION SIGN DETAILS
05/01/04	E-102A	CONSTRUCTION SIGN DETAILS
03/01/04	E-103	MAINLINE TRAFFIC CONTROL DIVIDED HIGHWAY ONE LANE CLOSED
03/01/04	E-106	TRAFFIC CONTROL MISCELLANEOUS DETAILS
06/30/03	E-107	DELINEATION, BARRICADES AND DETOURS FOR CONSTRUCTION AREAS
06/08/09	E-107A	BREAKAWAY BARRICADE DETAILS
06/08/09	E-108A	CONSTRUCTION ZONE LONGITUDINAL DROP OFFS FOR PAVING
08/08/95	E-110	MAJOR MAINTENANCE OPERATION LANE CLOSURE
08/08/95	E-120	STANDARD SIGN PLACEMENT EXPRESSWAY AND FREEWAY
08/08/95	E-121	STANDARD SIGN PLACEMENT CONVENTIONAL ROAD

PROJECT NOTES

GENERAL

1. ALL MATERIALS AND CONSTRUCTION SHALL CONFORM TO STATE OF VERMONT, AGENCY OF TRANSPORTATION, 2006 STANDARD SPECIFICATIONS FOR CONSTRUCTION, AND ITS LATEST REVISIONS, AND THE AASHTO LRFD BRIDGE DESIGN SPECIFICATIONS, DATED 2010, AND ITS LATEST REVISIONS.
2. ALL WORK AND ANY ASSOCIATED ACTIVITY ON THIS PROJECT SHALL BE PERFORMED WITHIN THE EXISTING RIGHT-OF-WAY LIMITS.
3. ALL COSTS ASSOCIATED WITH PROTECTION OF TRAFFIC DURING REMOVAL OF THE BRIDGE PAVEMENT WILL BE INCIDENTAL TO ITEM 529.10, "REMOVAL OF BRIDGE PAVEMENT".
4. WATER REPELLENT, SILANE SHALL BE APPLIED TO ALL EXPOSED CONCRETE SURFACES EXCEPT THE PIERS AND THE UNDERSIDE OF THE DECK. THIS WORK WILL BE PAID FOR UNDER ITEM 514.10, "WATER REPELLENT, SILANE".
5. FOLLOWING THE COMPLETION OF ALL OTHER CONSTRUCTION ACTIVITIES, ALL FABRIC DRAIN TROUGHS, DOWNSPOUTS AND SCUPPERS WITHIN THE LIMITS OF CONSTRUCTION AS SHOWN ON THE BITUMINOUS CONCRETE REMOVAL PLAN, SHALL BE THOROUGHLY FLUSHED BY THE CONTRACTOR. COST FOR FLUSHING THE FABRIC DRAIN TROUGHS, DOWNSPOUTS AND SCUPPERS WILL BE INCIDENTAL TO ALL OTHER ITEMS IN THE CONTRACT.
6. A 25-FOOT SECTION OF BRIDGE APPROACH RAIL (WOOD POSTS) SHALL BE REMOVED AND REPLACED AT THE NORTHWEST CORNER OF BRIDGE NO. 5N (ADJACENT TO WINGWALL #3). THE REMOVAL AND REPLACEMENT OF THE RAIL SHALL BE PAID FOR UNDER ITEM 900.640, "SPECIAL PROVISION (REMOVE AND REPLACE EXISTING APPROACH RAILING)". SEE STANDARD SB-R4B-82 ON SHEET 12A.

TRAFFIC CONTROL

7. THE TRAFFIC CONTROL PLANS SHOWN ON TRAFFIC CONTROL SHEETS 1, 2, AND 3 ARE SCHEMATICS ONLY AND SHOULD BE USED AS REFERENCES. THE CONTRACTOR SHALL SUBMIT TRAFFIC CONTROL PLANS DEPICTING EACH PHASE OF THE PLANNED WORK. PLANS SHALL BE SUBMITTED IN ACCORDANCE WITH SUBSECTION 105.03 AND SHALL BE STAMPED BY A PROFESSIONAL ENGINEER LICENSED IN AN APPROPRIATE DISCIPLINE IN THE STATE OF VERMONT. PAYMENT FOR PREPARING AND SUBMITTING THE TRAFFIC CONTROL PLAN AND MAKING ANY NECESSARY REVISIONS TO THE PLAN WILL BE INCLUDED IN THE UNIT BID PRICE FOR ITEM 641.10, "TRAFFIC CONTROL". THE CONTRACTOR SHALL ALLOW TWO WEEKS FOR APPROVAL OF THE TRAFFIC CONTROL PLAN. NO WORK SHALL COMMENCE UNTIL THE CONTRACTOR HAS AN APPROVED TRAFFIC CONTROL PLAN.
8. UNLESS COVERED UNDER INDIVIDUAL PAY ITEMS OR NOTED OTHERWISE, ALL COSTS FOR WORK SHOWN ON TRAFFIC CONTROL SHEETS AND FOR TEMPORARY TRAFFIC CONTROL DEVICES INCLUDING RETROREFLECTIVE DRUMS, SIGNS, AND SIGN POSTS WILL BE CONSIDERED TO BE INCLUDED IN THE CONTRACT LUMP SUM PRICE FOR ITEM 641.10, "TRAFFIC CONTROL". THE QUANTITY FOR ITEM 630.15, "FLAGGERS" AS SHOWN ON THE QUANTITY SUMMARY SHEETS WAS ESTIMATED FOR TRAFFIC CONTROL ON ROADS UNDERNEATH THE BRIDGES DURING APPLICATION OF ITEM 514.10, "WATER REPELLENT, SILANE". ANY ADDITIONAL TRAFFIC CONTROL NECESSARY FOR ROADS UNDERNEATH BRIDGES UNDER CONSTRUCTION SHALL BE INCIDENTAL TO ITEM 641.10, "TRAFFIC CONTROL".
9. TRAFFIC WILL BE ALLOWED TO DRIVE ON THE BARE CONCRETE BRIDGE DECK (EXCEPT FOR BRIDGE NO. 8) AFTER THE REMOVAL OF THE BARRIER MEMBRANE, BUT PRIOR TO THE DECK BEING CLEANED AND PREPARED FOR THE NEW SHEET MEMBRANE. ONCE THE CONCRETE BRIDGE DECK IS PREPARED FOR THE NEW SHEET MEMBRANE, NO TRAFFIC WILL BE ALLOWED ON THE NEW MEMBRANE UNTIL THE SECOND LIFT OF BITUMINOUS CONCRETE PAVEMENT IS IN PLACE.
10. TRAFFIC WILL BE ALLOWED TO DRIVE ON THE BARE CONCRETE BRIDGE DECK OF BRIDGE NO. 8 AFTER THE REMOVAL OF THE OVERLAY, BUT PRIOR TO THE DECK BEING CLEANED AND PREPARED FOR THE NEW OVERLAY. ONCE THE CONCRETE BRIDGE DECK IS PREPARED FOR THE NEW OVERLAY, NO TRAFFIC WILL BE ALLOWED ON THE NEW OVERLAY UNTIL IT HAS CURED PER THE MANUFACTURER'S SPECIFICATIONS.

CONCRETE STRUCTURE AND JOINT REPAIR

11. REPAIRS TO DETERIORATED CONCRETE CURBS ON BRIDGE NO. IN&S AT THE WINGWALL JOINTS SHALL BE PAID FOR UNDER ITEM 580.12, "REPAIR OF CONCRETE SUPERSTRUCTURE SURFACE, CLASS III". THE QUANTITY FOR ITEM 580.12 AS SHOWN ON THE QUANTITY SUMMARY SHEETS IS ESTIMATED.
12. REPAIRS SHALL BE MADE TO DETERIORATED AREAS OF THE BEARING SEATS ON BRIDGE NO. 3N, ABUTMENT #2, AND BRIDGE NO. 3S, ABUTMENT #4. ALL REPAIR WORK SHALL BE PAID FOR UNDER ITEM 580.15, "REPAIR OF CONCRETE SUBSTRUCTURE SURFACE, CLASS III". THE QUANTITY FOR ITEM 580.15 AS SHOWN ON THE QUANTITY SUMMARY SHEETS IS ESTIMATED.
13. THE BRIDGE NO. 8 ABUTMENT JOINTS SHALL REMAIN IN-PLACE. CONCRETE REPAIRS TO DETERIORATED AREAS ALONG THE JOINT ARE REQUIRED AND SHALL BE PAID FOR UNDER ITEM 580.12, "REPAIR OF CONCRETE SUPERSTRUCTURE SURFACE, CLASS III". THE QUANTITY FOR ITEM 580.12 AS SHOWN ON THE QUANTITY SUMMARY SHEETS IS ESTIMATED. THE NEOPRENE COMPRESSION SEAL WITHIN EACH JOINT SHALL BE REMOVED AND REPLACED. ALL COSTS FOR REMOVAL OF EXISTING SEALS AND THE FABRICATION AND INSTALLATION OF THE REPLACEMENT SEALS SHALL BE PAID FOR UNDER ITEM 900.640, "SPECIAL PROVISION (REMOVE AND REPLACE COMPRESSION JOINT SEAL)".

PAVEMENT/OVERLAY REMOVAL AND NEW MEMBRANE/OVERLAY

14. THE FINAL ONE HALF INCH OF PAVEMENT (OR THE 3/4" OVERLAY FOR BRIDGE NO. 8) ON THE CONCRETE BRIDGE DECK (AND APPROACH SLABS IF APPLICABLE) SHALL BE REMOVED BY LOADER, GRADER OR EQUIPMENT APPROVED BY THE ENGINEER. COLD PLANING TO REMOVE BRIDGE PAVEMENT WILL BE INCIDENTAL TO ITEM 529.10, "REMOVAL OF BRIDGE PAVEMENT".
15. AFTER THE REMOVAL OF THE EXISTING 216 TAMMS FLEXOLITH OVERLAY ON BRIDGE NO. 8, THE CONCRETE BRIDGE DECK SHALL BE CLEANED IN ACCORDANCE WITH THE SPECIAL PROVISIONS AND TO THE SATISFACTION OF THE ENGINEER. THE REMOVAL OF THE EXISTING 216 TAMMS FLEXOLITH OVERLAY AND CLEANING OF THE CONCRETE DECK WILL BE PAID FOR UNDER ITEM 900.670, "SPECIAL PROVISION (SURFACE PREPARATION FOR OVERLAY)".

PAVEMENT/OVERLAY REMOVAL AND NEW MEMBRANE/OVERLAY (CONT.)

16. DURING BRIDGE (AND APPROACH SLAB IF APPLICABLE) PAVEMENT REMOVAL (OR OVERLAY FOR BRIDGE NO. 8), THE CONTRACTOR SHALL EXERCISE CARE TO INSURE THAT NO DAMAGE OCCURS TO THE EXISTING CONCRETE BRIDGE DECK (AND THE EXISTING APPROACH SLABS IF APPLICABLE). ANY DAMAGE TO THE CONCRETE BRIDGE DECK (OR APPROACH SLABS IF APPLICABLE) SHALL BE REPAIRED AT THE CONTRACTOR'S EXPENSE. REPAIRS SHALL BE MADE IN ACCORDANCE WITH SECTION 580.
17. CARE SHALL BE TAKEN TO PROTECT ANY SCUPPERS OR DROP INLETS AT ALL STAGES OF CONSTRUCTION. ANY DAMAGE TO THESE STRUCTURES SHALL BE REPAIRED TO THE SATISFACTION OF THE ENGINEER AND AT THE CONTRACTOR'S EXPENSE.
18. AFTER THE REMOVAL OF THE BRIDGE PAVEMENT, THE BARRIER MEMBRANE SHALL BE REMOVED AND THE CONCRETE BRIDGE DECK (AND APPROACH SLABS IF APPLICABLE) SHALL BE CLEANED IN ACCORDANCE WITH SUBSECTION 580.04 AND TO THE SATISFACTION OF THE ENGINEER. REMOVAL OF THE BARRIER MEMBRANE AND THE CLEANING OF THE CONCRETE BRIDGE DECK WILL BE PAID FOR UNDER ITEM 580.16, "SURFACE PREPARATION FOR MEMBRANE".
19. ONCE THE BARRIER MEMBRANE IS REMOVED, ANY AREAS ON THE CONCRETE BRIDGE DECK (AND APPROACH SLABS IF APPLICABLE) THAT ARE FOUND TO BE UNSOUND SHALL BE BROUGHT TO THE ATTENTION OF THE ENGINEER. THE METHOD FOR DETERMINING AREAS OF UNSOUND CONCRETE SHALL BE APPROVED BY THE ENGINEER. THE ENGINEER SHALL MAKE A DETERMINATION AS TO HOW TO REPAIR THE DETERIORATED PORTION OF THE CONCRETE BRIDGE DECK (AND APPROACH SLABS IF APPLICABLE) AND THE LIMITS OF THE REPAIR. THE REPAIRS SHALL BE PAID FOR UNDER ITEM 580.10, "REPAIR OF CONCRETE SUPERSTRUCTURE SURFACE, CLASS I", ITEM 580.11, "REPAIR OF CONCRETE SUPERSTRUCTURE SURFACE, CLASS II", OR ITEM 580.12, "REPAIR OF CONCRETE SUPERSTRUCTURE SURFACE, CLASS III". QUANTITIES FOR ITEMS 580.10, 580.11, AND 580.12 AS SHOWN ON THE QUANTITY SUMMARY SHEETS ARE ESTIMATED.
20. ANY REPAIR WORK REQUIRING THE USE OF ITEM 580.20, "RAPID SETTING CONCRETE REPAIR MATERIAL WITH COURSE AGGREGATE" SHALL BE APPROVED BY THE ENGINEER.
21. UPON THE ENGINEER'S APPROVAL OF THE CONCRETE BRIDGE DECK'S CONDITION, AND WITH THE EXCEPTION OF BRIDGE NO. 8, ITEM 519.20, "SHEET MEMBRANE WATERPROOFING, TORCH APPLIED" SHALL BE INSTALLED IN ACCORDANCE WITH SECTION 519. THE CONTRACTOR SHALL NOT INSTALL ITEM 519.20, "SHEET MEMBRANE WATERPROOFING, TORCH APPLIED" WHEN THE DECK CONCRETE AND/OR DECK PATCH AREAS' MOISTURE CONTENT IS ABOVE SECTION 519 SPECIFICATIONS OR MANUFACTURER'S SPECIFICATIONS, WHICHEVER IS LESS. A 3/4" OVERLAY SHALL BE PLACED ON THE CONCRETE BRIDGE DECK FOR BRIDGE NO. 8. PLACEMENT OF THE OVERLAY SHALL BE PAID FOR UNDER ITEM 900.675, "SPECIAL PROVISION (BRIDGE DECK OVERLAY SYSTEM, POLY-CARB FLEXOGRID)".

PAVEMENT

22. FOLLOWING THE INSTALLATION OF THE NEW SHEET MEMBRANE WATERPROOFING ON THE CONCRETE BRIDGE DECK, THE CONCRETE BRIDGE DECK (AND THE AT-GRADE APPROACH SLABS IF APPLICABLE) SHALL BE PAVED CURB TO CURB WITH ITEM 406.27, "MEDIUM DUTY BITUMINOUS CONCRETE PAVEMENT" IN TWO 1/4" LIFTS. THE PAVEMENT SHALL BE TYPE IV FOR BOTH LIFTS, NO EXCEPTIONS.
23. NO PAVEMENT OR SHEET MEMBRANE SHALL BE PLACED ON BRIDGE NO. 8.
24. CARE SHALL BE EXERCISED TO SMOOTHLY TRANSITION THE NEW BRIDGE PAVEMENT INTO THE EXISTING PAVEMENT. ANY COLD PLANING NECESSARY FOR SHAPING BRIDGE APPROACHES SHALL BE PAID FOR UNDER ITEM 210.10, "COLD PLANING, BITUMINOUS PAVEMENT".
25. TESTING FOR PAVEMENT DENSITY WILL REQUIRE CORES OF THE PAVEMENT ON THE BRIDGE. THE COST FOR THIS WORK WILL BE INCIDENTAL TO ITEM 406.27, "MEDIUM DUTY BITUMINOUS CONCRETE PAVEMENT". ANY DAMAGE TO THE NEW SHEET MEMBRANE CAUSED BY CORING THE PAVEMENT SHALL BE REPAIRED TO THE SATISFACTION OF THE ENGINEER AND AT THE CONTRACTOR'S EXPENSE.
26. FOR PG BINDER GRADE SEE SECTION 406 OF THE GENERAL SPECIAL PROVISIONS AND SPECIAL PROVISIONS.
27. EMULSIFIED ASPHALT SHALL BE APPLIED AT A RATE OF 0.08 GAL/SY TO ALL COLD PLANED SURFACES AND AT A RATE OF 0.03 TO 0.04 GAL/SY BETWEEN PAVEMENT LIFTS. PAYMENT SHALL BE UNDER ITEM 404.65, "EMULSIFIED ASPHALT".
28. THE CONTRACTOR SHALL INSTALL TEMPORARY PAVEMENT MARKINGS ON ALL PAVED SURFACES THAT WILL NOT HAVE THE PERMANENT MARKINGS APPLIED WITHIN 14 CALENDAR DAYS OF THE FINAL PAVING OPERATIONS AS DIRECTED BY THE ENGINEER.

PROJECT NAME: WATERFORD
PROJECT NUMBER: IM MEMB(31)


FILE NAME: s1a296notes.dgn PLOT DATE: 3/19/2012
PROJECT LEADER: JPB DRAWN BY: MWS
DESIGNED BY: SRB CHECKED BY: JF
INDEX OF SHEETS AND PROJECT NOTES SHEET 2 OF 48

QUANTITY SHEET 1


SUMMARY OF ESTIMATED QUANTITIES										TOTALS		DESCRIPTIONS				DETAILED SUMMARY OF QUANTITIES		
ROADWAY	BRIDGE NO. 1N	BRIDGE NO. 3N	BRIDGE NO. 5N	BRIDGE NO. 8	FULL C.E. ITEMS	BRIDGE NO. 1S	BRIDGE NO. 3S	BRIDGE NO. 5S		GRAND TOTAL	FINAL	UNIT	ITEMS	ITEM NUMBER	ROUND	QUANTITIES	UNIT	ITEMS
1										1		CY	TRENCH EXCAVATION OF EARTH, EXPLORATORY (N.A.B.I.)	204.22				
	815	815	815			815	815	815		4890		SY	COLD PLANING, BITUMINOUS PAVEMENT	210.10				
	15.8	12.2	12.1			14.5	12.2	12.1		78.9		CWT	EMULSIFIED ASPHALT	404.65				
	290	237	235			270	237	235		1504		TON	MEDIUM DUTY BITUMINOUS CONCRETE PAVEMENT	406.27				
	1	1	1			1	1	1		6		LU	MAT DENSITY PAY ADJUSTMENT (N.A.B.I.)	406.29				
1										1		LU	PRICE ADJUSTMENT, ASPHALT CEMENT (N.A.B.I.)	406.50				
	17	14	28	26		16	14	24		139		GAL	WATER REPELLENT, SILANE	514.10				
	106	76	110			96	76	106		570		LF	BRIDGE EXPANSION JOINT, ASPHALTIC PLUG	516.10				
	835	461	445			697	461	444		3343		SY	SHEET MEMBRANE WATERPROOFING, TORCH APPLIED	519.20				
	835	461	445			697	461	444		3343		SY	REMOVAL OF BRIDGE PAVEMENT	529.10				
	42	24	23	50		35	24	23		221		SY	REPAIR OF CONCRETE SUPERSTRUCTURE SURFACE, CLASS I	580.10				
	126	70	67	150		105	70	67		655		SY	REPAIR OF CONCRETE SUPERSTRUCTURE SURFACE, CLASS II	580.11				
	21	3	3	14		21	3	3		68		CY	REPAIR OF CONCRETE SUPERSTRUCTURE SURFACE, CLASS III	580.12				
		3					3			6		CY	REPAIR OF CONCRETE SUBSTRUCTURE SURFACE, CLASS III	580.15				
	7513	4145	4003			6267	4147	3996		30071		SF	SURFACE PREPARATION FOR MEMBRANE	580.16				
	10	10	10	10		10	10	10		70		CF	RAPID SETTING CONCRETE REPAIR MATERIAL WITH COARSE AGGREGATE	580.20				
	5	5	5			5	5	5		30		HR	ALL PURPOSE EXCAVATOR RENTAL, TYPE I	608.25				
	5	5	5			5	5	5		30		HR	TRUCK RENTAL	608.37				
	346	191	185	414		289	191	184		1800		HR	TRUCK-MOUNTED ATTENUATOR	608.45				
	1	1	1	2		1	1	1		8		EACH	ENERGY ABSORPTION ATTENUATOR	621.56				
	733	641	637	160		699	641	637		4148		LF	TEMPORARY TRAFFIC BARRIER	621.90				
	707	615	611	160		673	615	611		3992		LF	REMOVE AND RESET TEMPORARY TRAFFIC BARRIER	621.95				
	692	382	369	207		578	383	368		2979		HR	UNIFORMED TRAFFIC OFFICERS	630.10				
	150	150	150	300		150	150	150		1200		HR	FLAGGERS	630.15				
						1				1		LS	FIELD OFFICE, ENGINEERS	631.10				
						1				1		LS	TESTING EQUIPMENT, CONCRETE	631.16				
						1				1		LS	TESTING EQUIPMENT, BITUMINOUS	631.17				
						3000				3000		DL	FIELD OFFICE TELEPHONE (N.A.B.I.)	631.26				
1										1		LS	MOBILIZATION/DEMOBILIZATION	635.11				
	1									1		LS	TRAFFIC CONTROL (I-93 - BRIDGE NO. 1N)	641.10				
						1				1		LS	TRAFFIC CONTROL (I-93 - BRIDGE NO. 1S)	641.10				
		1								1		LS	TRAFFIC CONTROL (I-93 - BRIDGE NO. 3N)	641.10				
							1			1		LS	TRAFFIC CONTROL (I-93 - BRIDGE NO. 3S)	641.10				
			1							1		LS	TRAFFIC CONTROL (I-93 - BRIDGE NO. 5N)	641.10				
								1		1		LS	TRAFFIC CONTROL (I-93 - BRIDGE NO. 5S)	641.10				
				1						1		LS	TRAFFIC CONTROL (T.H. 4 OVER I-93 - BRIDGE NO. 8)	641.10				
	1	1	1			1	1	1		6		EACH	PORTABLE CHANGEABLE MESSAGE SIGN	641.15				
	1	1	1			1	1	1		6		EACH	PORTABLE ARROW BOARD	641.16				
	507	392	387			464	392	387		2529		LF	6 INCH WHITE LINE	646.214				
	405	314	310	1013		371	314	309		3036		LF	6 INCH YELLOW LINE	646.215				

QUANTITY SHEET 2

SUMMARY OF ESTIMATED QUANTITIES										TOTALS		DESCRIPTIONS				DETAILED SUMMARY OF QUANTITIES		
ROADWAY	BRIDGE NO. 1N	BRIDGE NO. 3N	BRIDGE NO. 5N	BRIDGE NO. 8	FULL C.E. ITEMS	BRIDGE NO. 1S	BRIDGE NO. 3S	BRIDGE NO. 5S		GRAND TOTAL	FINAL	UNT	ITEMS	ITEM NUMBER	ROUND	QUANTITIES	UNIT	ITEMS
	3467	3283	3275			3399	3283	3275		19982		LF	TEMPORARY 6 INCH WHITE LINE, TYPE II TAPE	646.621				
	3467	3283	3275			3399	3283	3275		19982		LF	TEMPORARY 6 INCH YELLOW LINE, TYPE II TAPE	646.631				
				48						48		LF	TEMPORARY 24 INCH STOP BAR, TYPE II TAPE	646.681				
	174	165	164			170	165	164		1002		EACH	RAISED PAVEMENT MARKERS, TYPE II	646.75				
	1321	1275	1273	600		1304	1275	1273		8321		SF	PAVEMENT MARKING MASK	646.86				
1										1		LU	PRICE ADJUSTMENT, FUEL (N.A.B.I.)	690.50				
				1						1		EACH	SPECIAL PROVISION (TEMPORARY TRAFFIC SIGNAL SYSTEM, PORTABLE)	900.620				
	17	10	9			14	10	9		69		GAL	SPECIAL PROVISION (REPOINTING GRANITE CURB)	900.625				
				76						76		LF	SPECIAL PROVISION (REMOVE AND REPLACE COMPRESSION JOINT SEAL)	900.640				
		25	25							25		LF	SPECIAL PROVISION (REMOVE AND REPLACE EXISTING APPROACH RAILING)	900.640				
				8991						8991		SF	SPECIAL PROVISION (SURFACE PREPARATION FOR OVERLAY)	900.670				
				999						999		SY	SPECIAL PROVISION (BRIDGE DECK OVERLAY SYSTEM, POLY-CARB FLEXOGRID)	900.675				

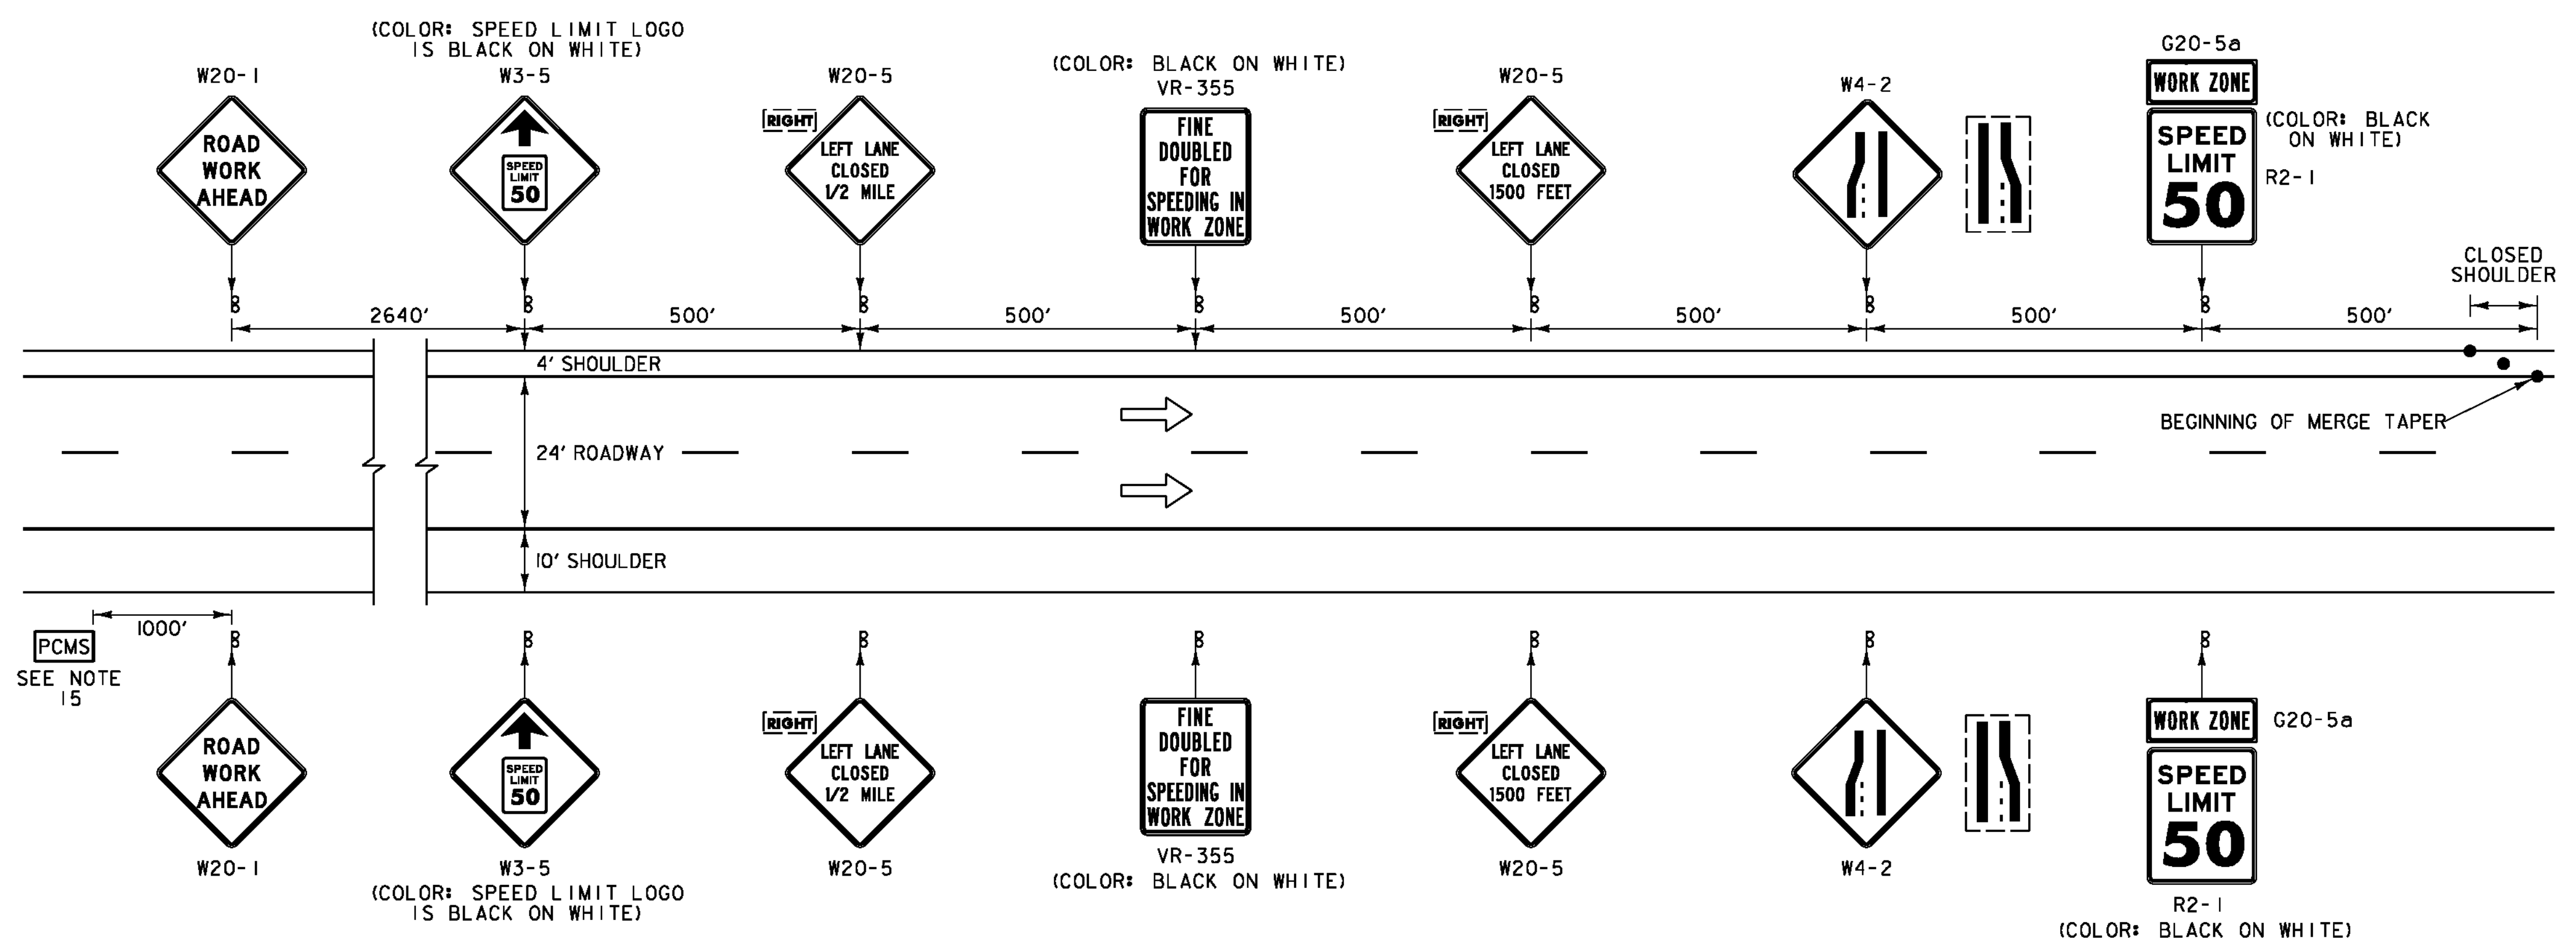

CONSTRUCTION APPROACH SIGNING ON INTERSTATE 93 LEFT LANE CLOSED

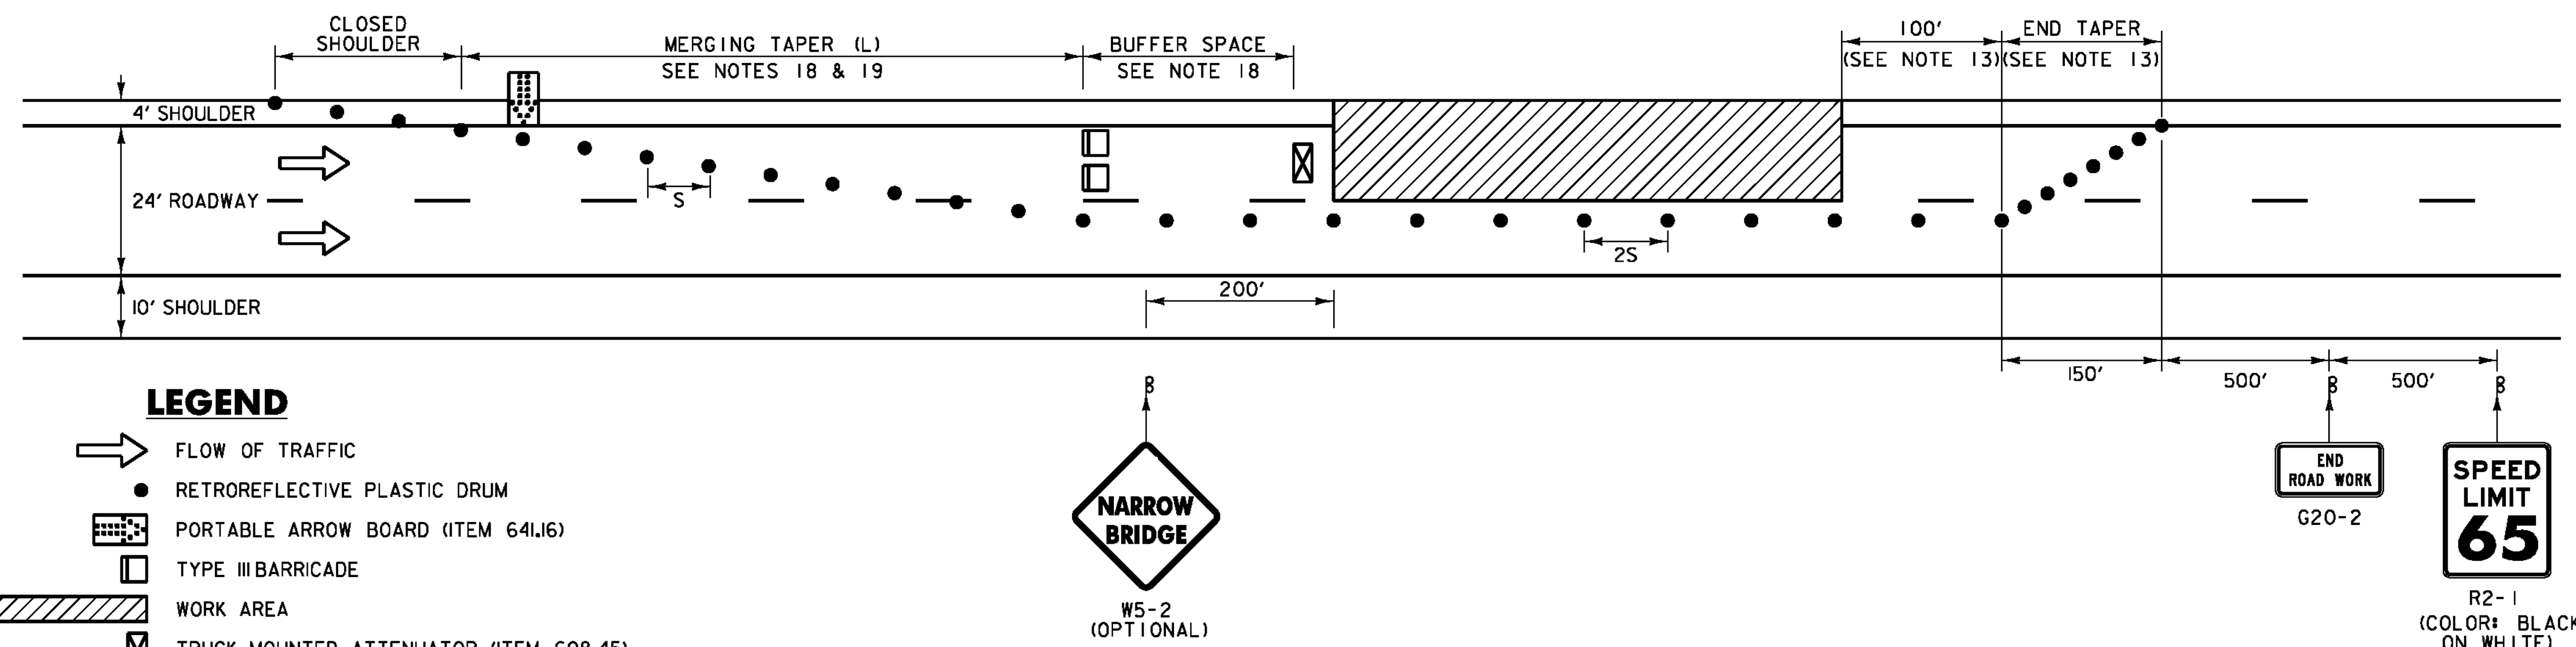

LEGEND

- FLOW OF TRAFFIC
- RETROREFLECTIVE PLASTIC DRUM
- PORTABLE ARROW BOARD (ITEM 641J6)
- TYPE III BARRICADE
- WORK AREA
- TRUCK-MOUNTED ATTENUATOR (ITEM 608.45)
- PORTABLE CHANGEABLE MESSAGE SIGN (ITEM 641J5) (SEE NOTE 15)

TRAFFIC CONTROL ON INTERSTATE 93 LEFT LANE CLOSED

CHANNELIZING DEVICES

TAPER RATES ARE DETERMINED USING THE FOLLOWING EQUATION:
 $L = WS$ FOR POSTED SPEEDS OF 45 MPH OR GREATER
 $L = WS/60$ FOR POSTED SPEEDS OF 40 MPH OR LESS
 L = MINIMUM LENGTH OF TAPER
 W = WIDTH OF OFFSET IN FEET. (TYPICAL)
 S = POSTED SPEED IN MPH


POSTED SPEED (MPH)	TAPER LENGTHS (FT)		TANGENT W=12 FT (L/2)	BARRIER FLARE RATE (MINIMUM)	MINIMUM BUFFER SPACE LENGTH (FT)	MAXIMUM CHANNELIZING DEVICE SPACING (FT)	
	SHOULDER W=10 FT (L/3)	MERGING 12 FT LANE* (L)				TAPER (S)	TANGENT (2S)
≤40	90	320	160	1:9	305	40	80
45	150	540	270	1:9	360	45	90
50	170	600	300	1:11	425	50	100
55	185	660	330	1:13	495	55	110
60	200	720	360	1:13	570	60	120
65	215	780	390	1:13	645	65	130

* SEE NOTE 19.


TRAFFIC CONTROL NOTES:

1. THE LEFT LANE CLOSURE IS SHOWN. THE RIGHT LANE APPROACH SIGNING IS SIMILAR. THE RIGHT LANE CLOSURE IS SHOWN ON TRAFFIC CONTROL SHEET 2.
2. THE EXISTING SPEED LIMIT IS 65 MPH. THE SPEED LIMIT WILL BE REDUCED TO 50 MPH IN THE WORK ZONE FOR THIS PROJECT. ANY EXISTING SPEED LIMIT SIGNS WITHIN THE SPEED REDUCTION AREA SHALL BE COMPLETELY COVERED.
3. CONSTRUCTION SIGNS SHALL BE INSTALLED SO AS NOT TO OBSTRUCT EXISTING SIGNS.
4. ALL SIGNS SHALL BE IN ACCORDANCE WITH THE CURRENT EDITIONS OF THE "MANUAL ON UNIFORM TRAFFIC CONTROL DEVICES" (MUTCD) AND THE "STANDARD HIGHWAY SIGNS AND MARKINGS" BOOK (SHSM) PUBLISHED BY THE FEDERAL HIGHWAY ADMINISTRATION (FHWA).
5. SOLID SUBSTRATE CONSTRUCTION SIGNS SHALL HAVE RETROREFLECTIVE SHEETING EQUAL TO OR EXCEEDING "AMERICAN SOCIETY FOR TESTING AND MATERIALS" (ASTM) TYPE VII, VIII OR IX REQUIREMENTS, UNLESS OTHERWISE NOTED. BLACK AND WHITE REGULATORY SIGNS SHALL BE A MINIMUM OF TYPE III, UNLESS OTHERWISE NOTED.
6. ROLL UP SIGNS SHALL HAVE RETROREFLECTIVE SHEETING EQUAL TO OR EXCEEDING ASTM TYPE VI.
7. CONSTRUCTION SIGNS SHALL BE ERECTED BEFORE THE START OF ANY WORK AND SHALL BE COVERED UNTIL WORK COMMENCES, DURING PERIODS OF INACTIVITY, OR UPON COMPLETION OF THE WORK. EACH SIGN SHALL BE ERECTED IN A NEAT AND WORKMANLIKE MANNER. SIGNS SHALL BE REMOVED UPON COMPLETION OF THE WORK AT THE DISCRETION OF THE ENGINEER.
8. FIXED SIGNS SHALL BE SET SECURELY IN THE GROUND. THE BOTTOM OF A SIGN SHALL BE AT LEAST SEVEN FEET ABOVE THE EDGE OF PAVEMENT. THE NEAREST EDGE OF A SIGN SHALL BE AT LEAST SIX FEET OUTSIDE THE SHOULDER POINT OR FOUR FEET OUTSIDE GUARDRAIL.
9. PORTABLE SIGNS SHALL BE PLACED ON THE EDGE OF ROADWAY AND ONE FOOT MINIMUM ABOVE TRAVELED WAY. ALL VEGETATION THAT INTERFERES WITH VISIBILITY OF THE SIGNS SHALL BE REMOVED AT THE CONTRACTOR'S EXPENSE. WHEN PLACED BEHIND GUARDRAIL, THE BOTTOM OF THE SIGN FACE SHALL BE ABOVE THE TOP OF THE GUARDRAIL.
10. WHERE SIGN INSTALLATIONS ARE NOT PROTECTED BY GUARDRAIL OR OTHER APPROVED TRAFFIC BARRIERS, ALL SIGN STANDS AND POST INSTALLATIONS SHALL BE "NATIONAL COOPERATIVE HIGHWAY RESEARCH PROGRAM" (NCHRP) REPORT 350 COMPLIANT. NO SIGN POSTS SHALL EXTEND OVER THE TOP OF THE SIGN INSTALLED ON SAID POST(S). WHEN ANCHORS ARE INSTALLED, STUB SHALL NOT BE GREATER THAN FOUR INCHES ABOVE EXISTING GROUND.
11. THE CONTRACTOR SHALL HAVE SIGNS FOR CLOSURE OF RIGHT AND LEFT LANES ON PROJECT BEFORE WORK COMMENCES.
12. THE NUMBER OF CHANNELIZING DEVICES, TYPE THREE BARRICADE AND OTHER TRAFFIC CONTROL DEVICES SHOWN ARE FOR ILLUSTRATIVE PURPOSES ONLY. THE ACTUAL NUMBER REQUIRED ARE TO BE DETERMINED BASED ON INDIVIDUAL DETOUR CONDITIONS (TAPERS, SPEED LIMITS, LENGTH OF DETOUR, CURVE, ETC.). WARNING LIGHTS SHALL NOT BE USED ON CHANNELIZING DEVICES.
13. PLACE LAST CHANNELIZING DEVICE 100 FEET BEYOND THE ANTICIPATED WORK ZONE TERMINAL POINT EACH DAY AND THEN START THE END TAPER. THE END TAPER SHALL BE CONSTRUCTED OF 8 ADDITIONAL RETROREFLECTIVE DRUMS SPACED AT 20 FEET MAX. ON CENTER.
14. THE ARROW BOARD SHALL BE PLACED ON THE SHOULDER OF THE ROADWAY, OR, IF PRACTICAL, FURTHER FROM THE TRAVELED LANE AT THE END OF THE SHOULDER TAPER.
15. THE PORTABLE CHANGEABLE MESSAGE SIGNS (PCMS) SHALL BE USED AT THE DISCRETION OF THE ENGINEER. THE PCMS SHALL BE USED IN ACCORDANCE WITH SECTION 6F.60 OF THE MUTCD. THE PCMS SHALL READ "LEFT (OR RIGHT) LANE CLOSED AHEAD, PLEASE MERGE EARLY".
16. TRAVEL LANE SHALL BE A MINIMUM OF 12 FEET WIDE.
17. THE CONTRACTOR SHALL REDUCE TRAFFIC TO ONE LANE DURING WORKING HOURS IN ACCORDANCE WITH THIS SHEET. ALL EQUIPMENT SHALL BE MOVED TO A LOCATION OFF PAVED SHOULDERS AND OUTSIDE THE CLEAR ZONE (MINIMUM 30 FEET) DURING NON-WORK PERIODS AND PROTECTED BY BARRELS OR CONES, UNLESS PROTECTED BY TRAFFIC BARRIER OR GUARDRAIL.
18. AT THE DISCRETION OF THE ENGINEER, MERGING TAPER AND BUFFER SPACE LENGTHS MAY BE EXTENDED BEYOND MINIMUM VALUES, ESPECIALLY IN CLOSE PROXIMITY TO INTERCHANGE RAMP, CURVES, OR OTHER INFLUENCING FACTORS. THIS WORK SHALL BE INCIDENTAL TO ITEM 641J6, "TRAFFIC CONTROL".
19. EXTEND MERGING TAPER TO ACCOUNT FOR REQUIRED LANE SHIFT OFFSET.

PROJECT NAME: WATERFORD
 PROJECT NUMBER: IM MEMB(31)
 FILE NAME: s1a296ts.Ldgn PLOT DATE: 3/19/2012
 PROJECT LEADER: JPB DRAWN BY: MWS
 DESIGNED BY: SRB CHECKED BY: JF
TRAFFIC CONTROL SHEET 1 SHEET 5 OF 48

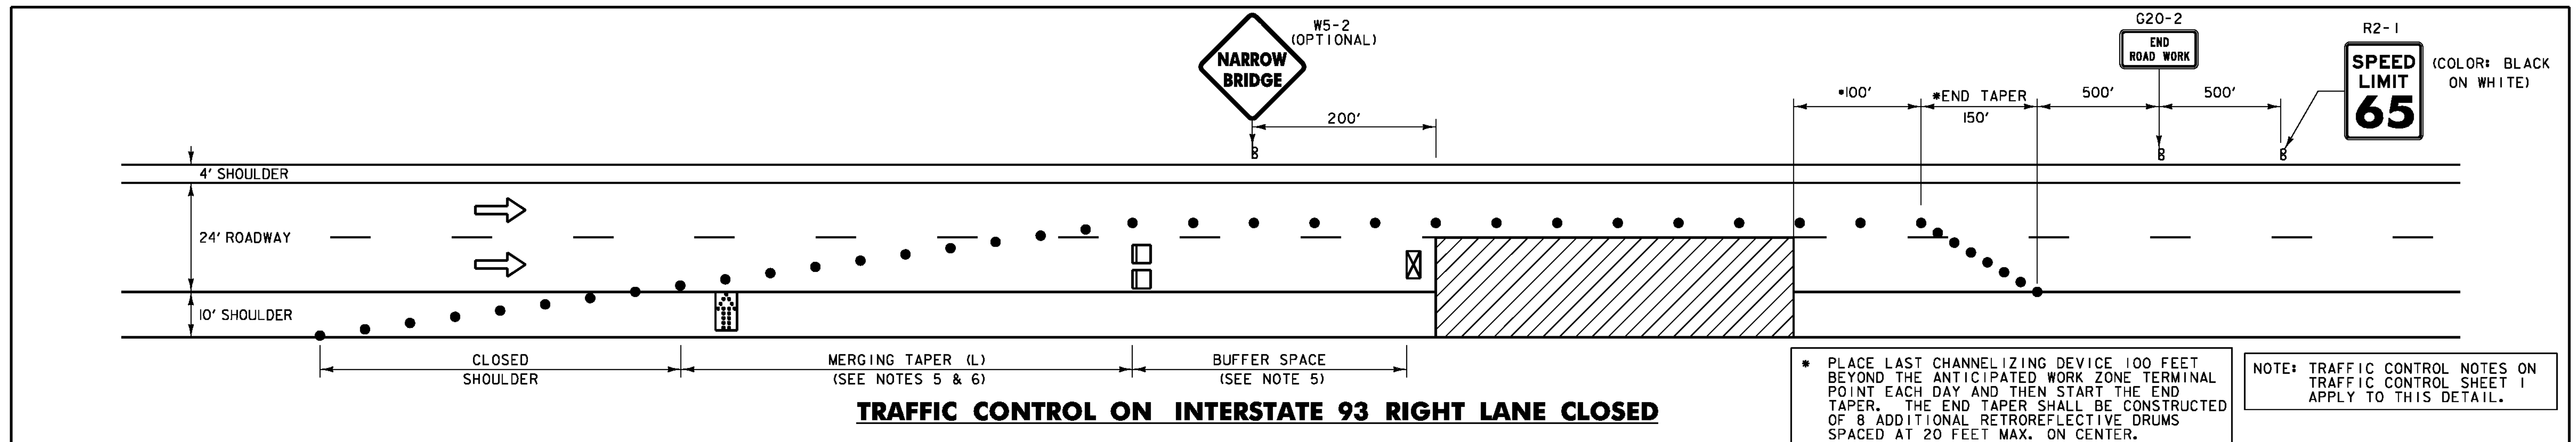


TRAFFIC CONTROL ON INTERSTATE 93 RIGHT LANE CLOSED

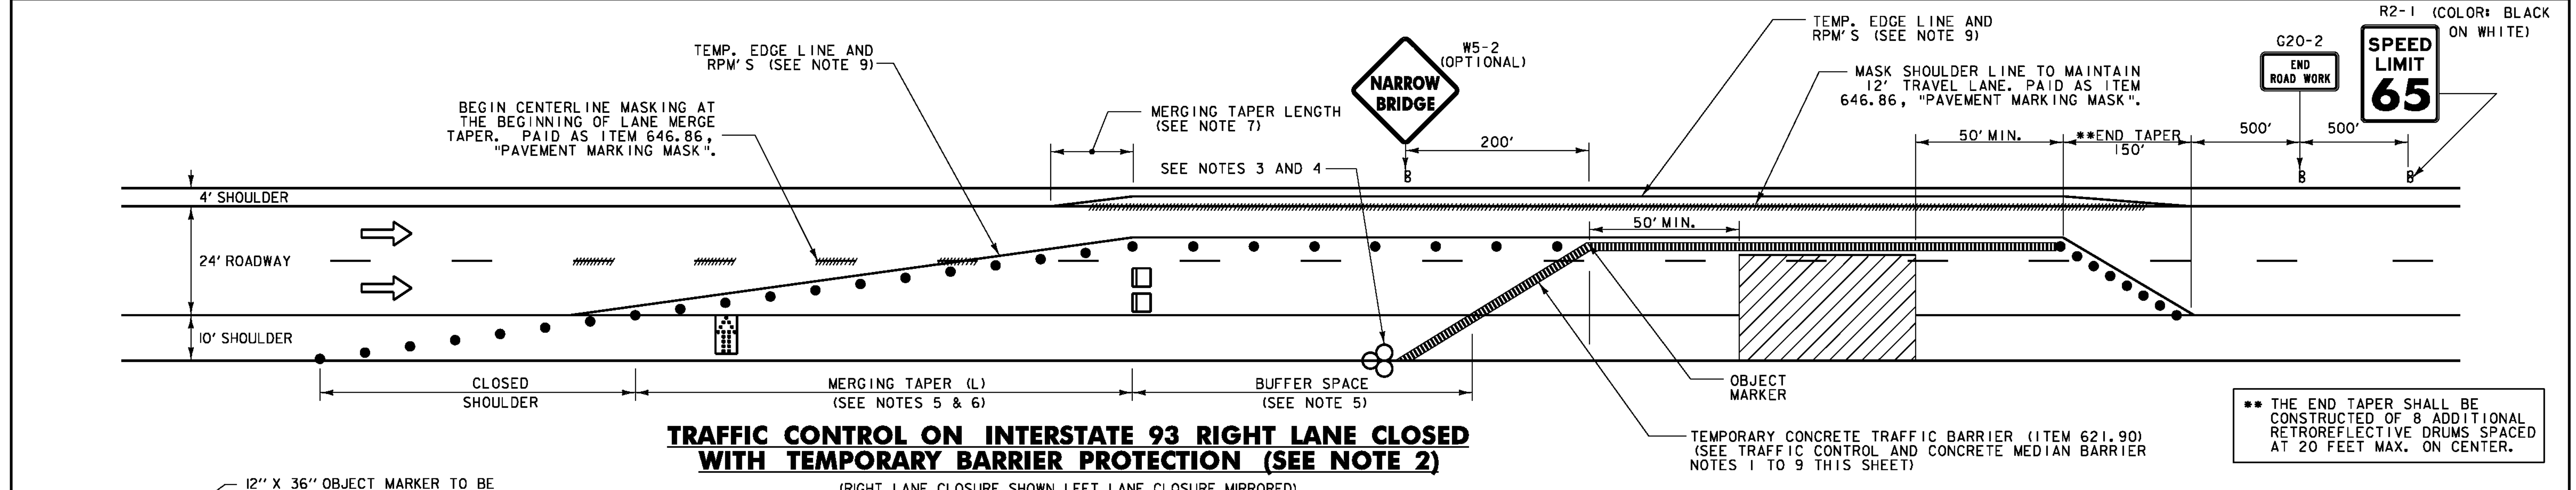

TRAFFIC CONTROL ON INTERSTATE 93 RIGHT LANE CLOSED WITH TEMPORARY BARRIER PROTECTION (SEE NOTE 2)

(RIGHT LANE CLOSURE SHOWN, LEFT LANE CLOSURE MIRRORED)

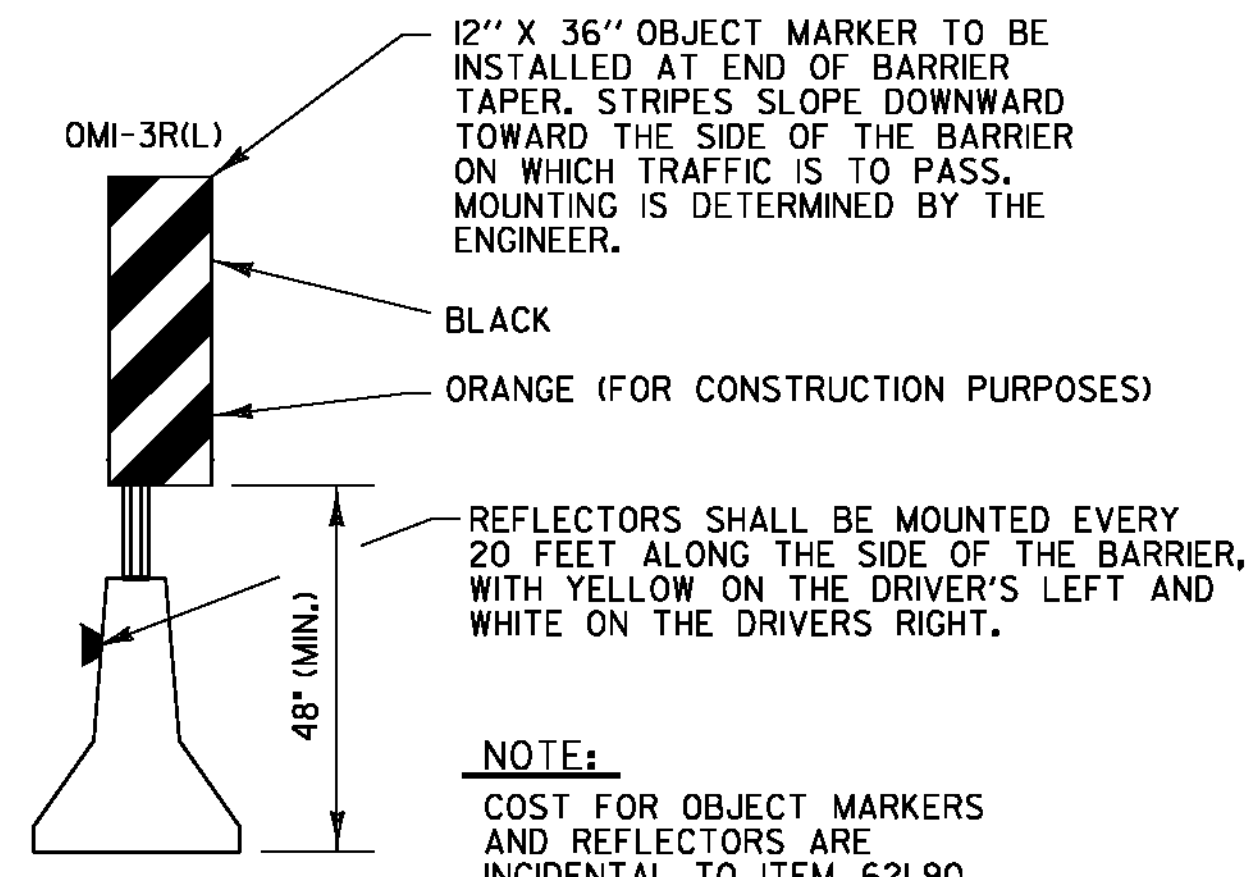

NOTE:
COST FOR OBJECT MARKERS AND REFLECTORS ARE INCIDENTAL TO ITEM 621.90 TEMPORARY TRAFFIC BARRIER.

CHANNELIZING DEVICES

POSTED SPEED (MPH)	TAPER LENGTHS (FT)		TANGENT W=12 FT (L/2)	BARRIER FLARE RATE (MINIMUM)	MINIMUM BUFFER SPACE LENGTH (FT)	MAXIMUM CHANNELIZING DEVICE SPACING (FT)	
	SHOULDER W=10 FT (L/3)	MERGING 12 FT LANE (L)				TAPER (S)	TANGENT (2S)
≤40	90	320	160	1:9	305	40	80
45	150	540	270	1:9	360	45	90
50	170	600	300	1:11	425	50	100
55	185	660	330	1:13	495	55	110
60	200	720	360	1:13	570	60	120
65	215	780	390	1:13	645	65	130

* SEE NOTE 6.

TAPER RATES ARE DETERMINED USING THE FOLLOWING EQUATION:
 $L = WS$ FOR POSTED SPEEDS OF 45 MPH OR GREATER
 $L = WS/60$ FOR POSTED SPEEDS OF 40 MPH OR LESS

L = MINIMUM LENGTH OF TAPER
W = WIDTH OF OFFSET IN FEET. (TYPICAL)
S = POSTED SPEED IN MPH



TRAFFIC CONTROL AND CONCRETE MEDIAN BARRIER NOTES:

- SEE THE TRAFFIC CONTROL NOTES ON THE PREVIOUS SHEET (TRAFFIC CONTROL SHEET 1) FOR ADDITIONAL NOTES AND APPROACH SIGNING FOR THE RIGHT LANE CLOSURE.
- IF THE LANE CLOSURE IS TO LAST LONGER THAN 3 DAYS, THE CONTRACTOR SHALL USE TEMPORARY TRAFFIC BARRIER AS SHOWN ON THIS SHEET AND PAID FOR AS ITEM 621.90, "TEMPORARY TRAFFIC BARRIER". TEMPORARY TRAFFIC BARRIER SHALL BE A CONCRETE MEDIAN BARRIER (CMB) TYPE. STEEL BEAM GUARDRAIL WILL NOT BE ALLOWED FOR USE AS A TEMPORARY TRAFFIC BARRIER. WHEN ONE SIDE OF THE BRIDGE IS COMPLETE, MOVING THE BARRIER TO CLOSE THE OTHER SIDE TO TRAFFIC WILL BE PAID FOR AS ITEM 621.95, "REMOVE AND RESET TEMPORARY TRAFFIC BARRIER".
- THE END OF THE BARRIER FACING APPROACHING TRAFFIC SHALL MEET THE FOLLOWING REQUIREMENTS.
 - WHEN NO GUARDRAIL IS PRESENT, A 30' OFFSET SHALL BE USED FROM THE EDGE OF TRAVELLED WAY. IF A 30' OFFSET IS NOT ATTAINABLE, THEN AN ENERGY ABSORPTION ATTENUATOR SHALL BE LOCATED AT THE END OF THE BARRIER.
 - IF GUARDRAIL IS PRESENT, THEN TEMPORARY CONCRETE TRAFFIC BARRIER SHALL BE CONNECTED TO EXISTING GUARDRAIL (COST INCIDENTAL TO ITEM 621.90, "TEMPORARY TRAFFIC BARRIER") (COSTS FOR DISMANTLING BARRIER CONNECTION AND RESTORING EXISTING BARRIER TO ORIGINAL CONFIGURATION SHALL BE INCIDENTAL TO ITEM 621.90, "TEMPORARY TRAFFIC BARRIER.") SEE BARRIER RAIL DETAILS ON SHEET 12. AN ENERGY ABSORPTION ATTENUATOR SHALL BE LOCATED AT THE END OF THE BARRIER.
- THE QUANTITIES INCLUDE ONE ENERGY ABSORPTION ATTENUATOR PER BRIDGE EXCEPT FOR BRIDGE NO. 8 WHICH SHALL HAVE 2. THE COST FOR THE ATTENUATORS AND TO MOVE ATTENUATORS FOR SHIFTING LANE CLOSURES SHALL BE PAID FOR AS ITEM 621.56, "ENERGY ABSORPTION ATTENUATOR". THE COST FOR ENERGY ABSORPTION ATTENUATORS USED FOR ANY OTHER TRAFFIC CONTROL SETUP SHALL BE INCIDENTAL TO ITEM 641.10, "TRAFFIC CONTROL".
- AT THE DISCRETION OF THE ENGINEER, MERGING TAPER AND BUFFER SPACE LENGTHS MAY BE EXTENDED BEYOND MINIMUM VALUES, ESPECIALLY IN CLOSE PROXIMITY TO INTERCHANGE RAMP, CURVES, OR OTHER INFLUENCING FACTORS. THIS WORK SHALL BE INCIDENTAL TO ITEM 641.10, "TRAFFIC CONTROL".
- EXTEND MERGING TAPER TO ACCOUNT FOR REQUIRED LANE SHIFT OFFSET.
- PROVIDE MERGING TAPER LENGTH AS REQUIRED FOR LANE SHIFT.
- TEMPORARY TAPE EDGELINES SHALL BE APPLIED AND SHALL MAINTAIN A ONE FOOT MINIMUM DISTANCE FROM THE BARRIER WITH TWO FEET BEING DESIRABLE.
- THE RAISED PAVEMENT MARKERS (RPM'S), TYPE II SHALL BE PLACED TO THE OUTSIDE OF THE TEMPORARY TAPE PAVEMENT MARKINGS. THE RPM'S SHALL BE SPACED AT 20 FEET AND SHALL BE PAID FOR UNDER ITEM 646.75, "RAISED PAVEMENT MARKERS, TYPE II".

LEGEND

- FLOW OF TRAFFIC
- RETROREFLECTIVE PLASTIC DRUM
- PORTABLE ARROW BOARD (ITEM 641.16)
- TYPE III BARRICADE
- WORK AREA
- TRUCK-MOUNTED ATTENUATOR (ITEM 608.45)
- PORTABLE CHANGEABLE MESSAGE SIGN (ITEM 641.15) (SEE NOTE 15 ON TRAFFIC CONTROL SHEET 1)
- ENERGY ABSORPTION ATTENUATOR (ITEM 621.56)
- TEMPORARY TRAFFIC BARRIER (ITEM 621.90)

PROJECT NAME: WATERFORD	PLOT DATE: 3/19/2012
PROJECT NUMBER: IM MEMB(31)	DRAWN BY: MWS
FILE NAME: s1a296ts.dgn	CHECKED BY: JF
PROJECT LEADER: JPB	SHEET 6 OF 48
DESIGNED BY: SRB	
TRAFFIC CONTROL SHEET 2	

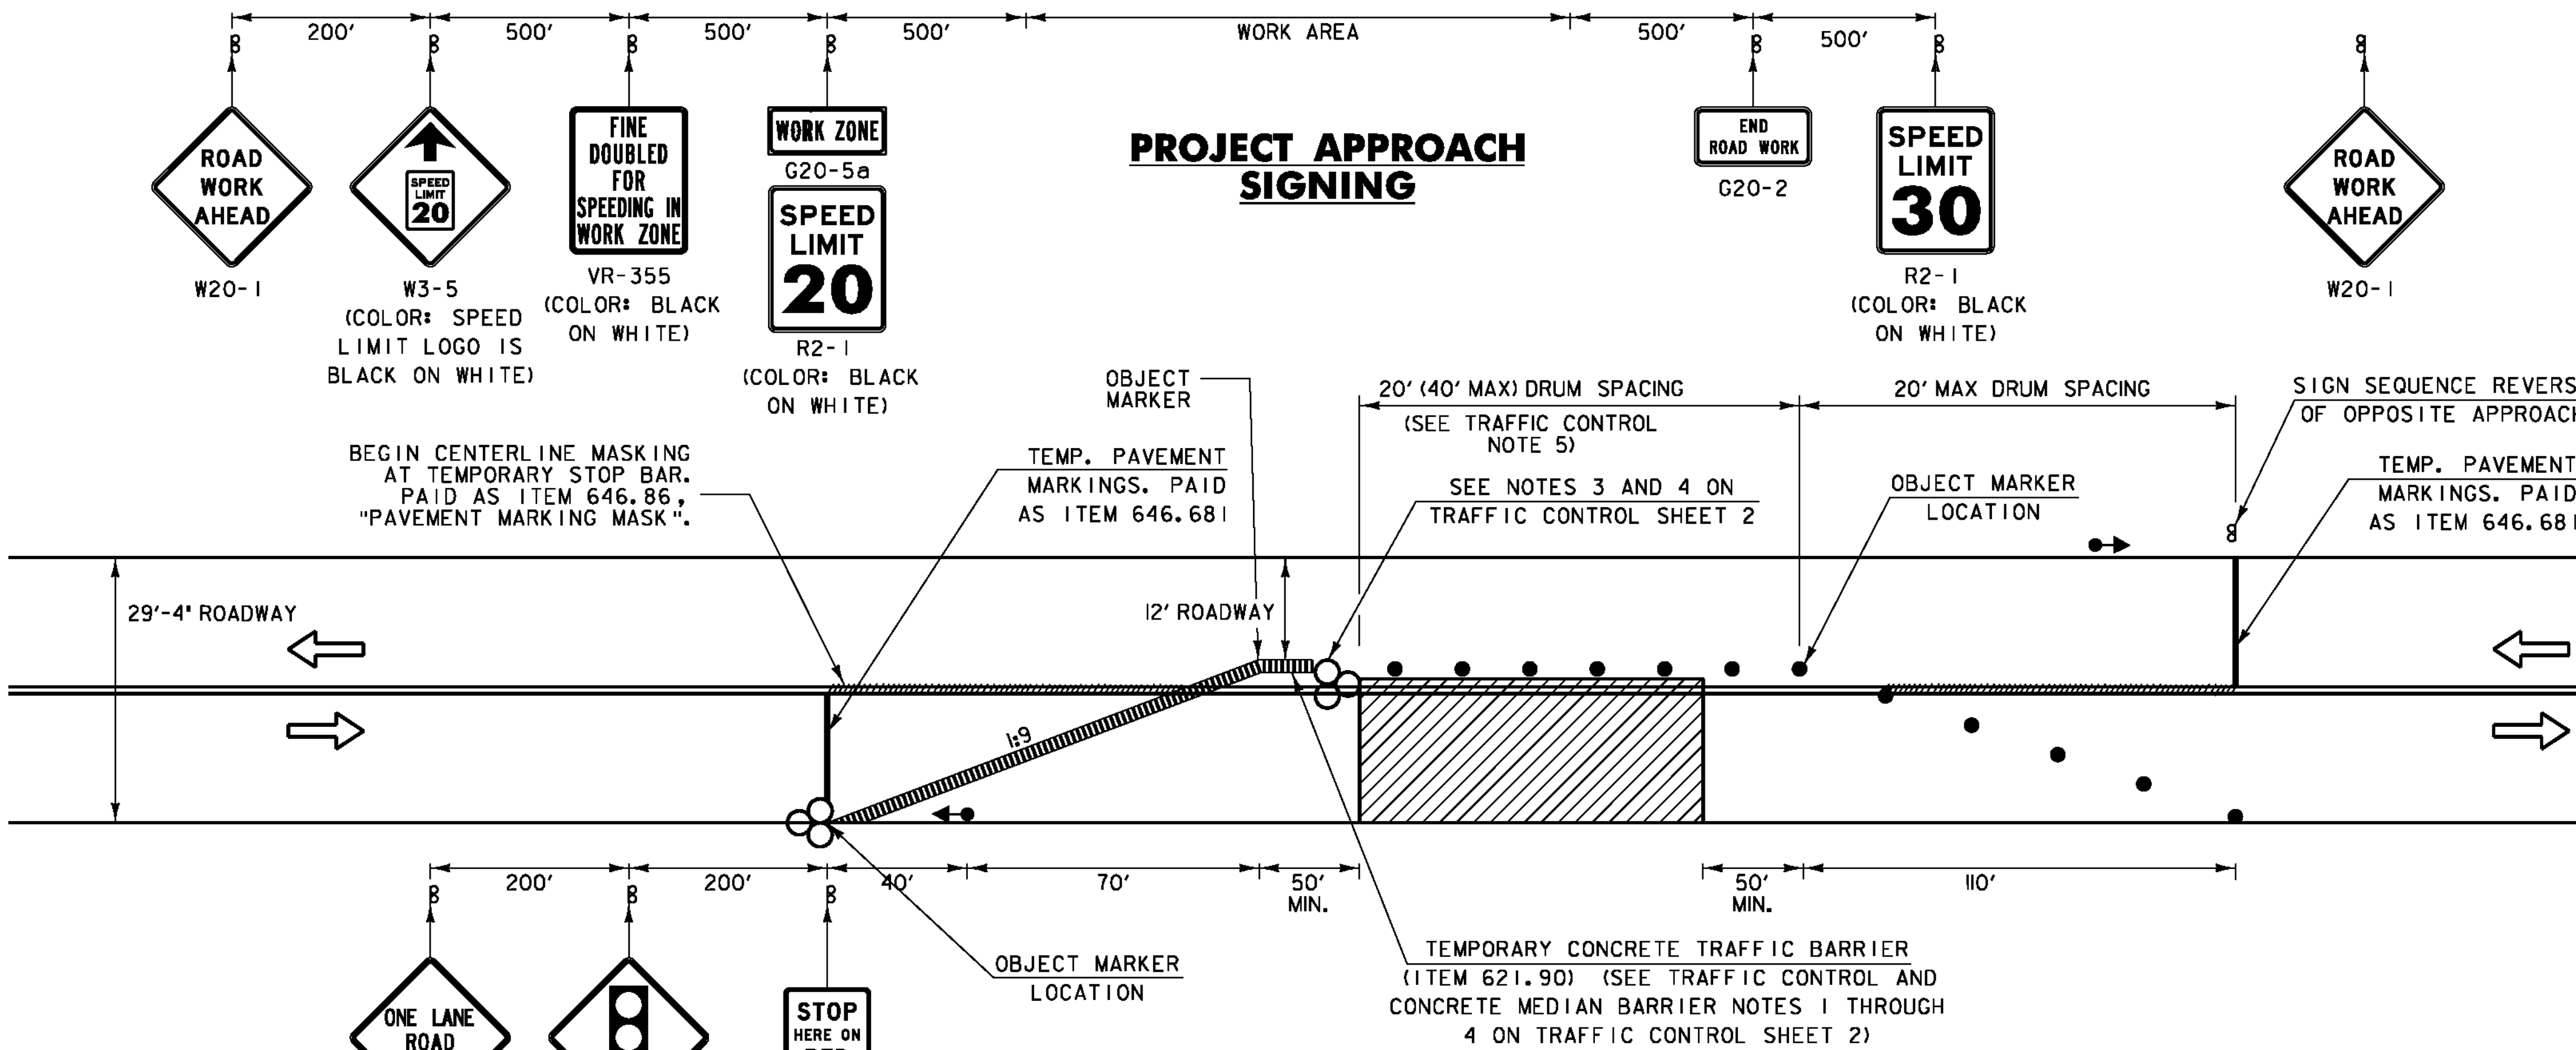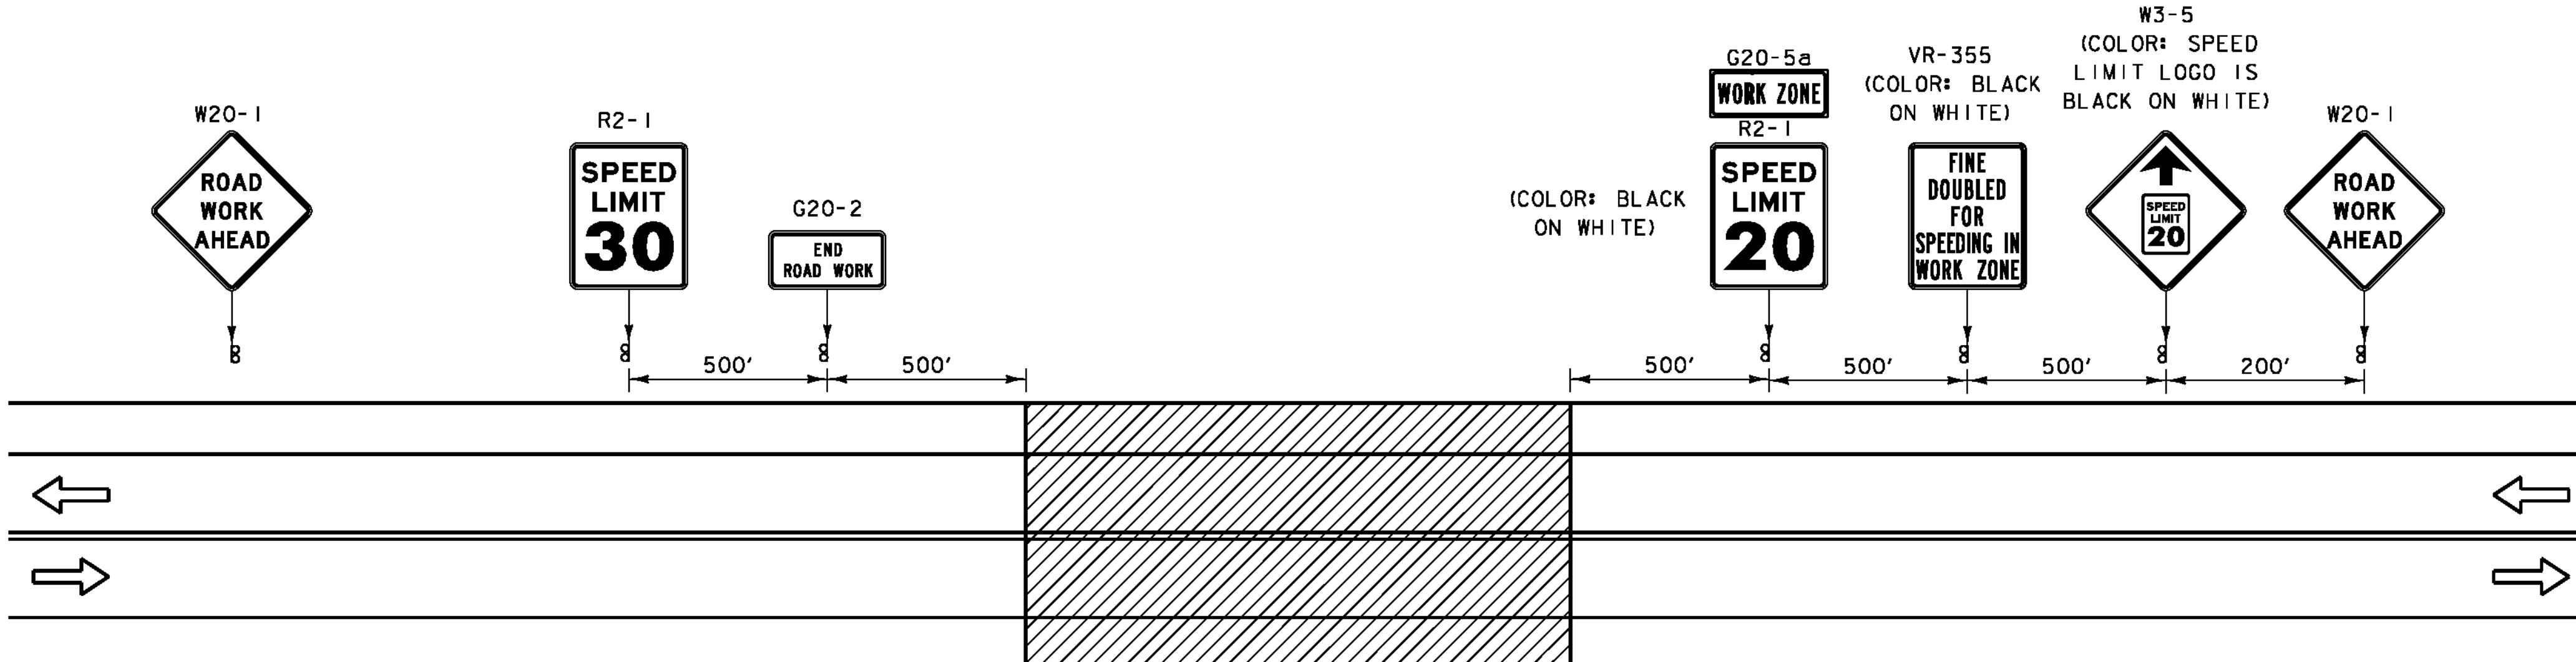

**TRAFFIC CONTROL FOR TH#4 (DANIELS FARM ROAD) WITH
TEMPORARY PORTABLE TRAFFIC CONTROL SIGNALS**

TRAFFIC CONTROL NOTES:

1. THE EXISTING TOWN HIGHWAY 4 SPEED LIMIT IS 30 MPH. THE SPEED LIMIT WILL BE REDUCED TO 20 MPH IN THE WORK ZONE FOR THIS PROJECT. ANY EXISTING SPEED LIMIT SIGNS WITHIN THE SPEED REDUCTION AREA SHALL BE COMPLETELY COVERED.
2. SEE THE TRAFFIC CONTROL NOTES 3 THROUGH 10 AND NOTE 17 ON TRAFFIC CONTROL SHEET 1 FOR ADDITIONAL NOTES.
3. THE CONTRACTOR SHALL HAVE SIGNS FOR CLOSURE OF LANES ON THE PROJECT BEFORE WORK COMMENCES.
4. SEE THE TRAFFIC CONTROL AND CONCRETE MEDIAN BARRIER NOTES 2 THROUGH 7 ON TRAFFIC CONTROL SHEET 2 FOR ADDITIONAL NOTES.
5. DUE TO THE NARROW TRAVELWAY AND SHOULDERS ON BRIDGE NO. 8, CHANNELIZING DEVICES SHALL BE USED IN LIEU OF CONCRETE BARRIER WITHIN THE WORK ZONE.
6. TRAFFIC CONTROL PLANS SUBMITTED BY THE CONTRACTOR PER NOTE 7 ON SHEET 2 SHALL INCLUDE DRIVE ENTRANCE LOCATIONS ADJACENT TO BRIDGE NO. 8. IF A TEMPORARY STOP BAR OCCURS BEYOND A DRIVE ENTRANCE PER THE TRAFFIC CONTROL DETAILS ON THIS SHEET, THE DIMENSIONS SHALL BE REVISED TO ENSURE ALL DRIVE ENTRANCES OCCUR OUTSIDE TEMPORARY STOP BAR LOCATIONS. ACCESS TO DRIVES ON BOTH SIDES OF BRIDGE NO. 8 SHALL BE MAINTAINED AT ALL TIMES.


TEMPORARY PORTABLE SIGNAL NOTES:

1. TEMPORARY TRAFFIC CONTROL (TTC) SIGNALS SHALL BE INSTALLED AND OPERATED IN ACCORDANCE WITH THE PROVISIONS OF PART 4 OF THE MUTCD. TTC SIGNALS SHALL MEET THE PHYSICAL DISPLAY AND OPERATIONAL REQUIREMENTS OF CONVENTIONAL TRAFFIC CONTROL SIGNALS.
2. TTC SIGNAL TIMING SHALL BE ESTABLISHED BY THE CONTRACTOR AND APPROVED BY THE ENGINEER. DURATIONS OF RED CLEARANCE INTERVALS SHALL BE ADEQUATE TO CLEAR THE ONE-LANE SECTION OF CONFLICTING VEHICLES.
3. STOP LINES SHALL BE INSTALLED WITH TTC SIGNALS. EXISTING CONFLICTING PAVEMENT MARKINGS BETWEEN THE ACTIVITY AREA AND THE STOP LINE SHALL BE MASKED. AFTER THE TTC SIGNAL IS REMOVED, THE STOP LINES AND OTHER TEMPORARY PAVEMENT MARKINGS SHALL BE REMOVED AND THE PERMANENT PAVEMENT MARKINGS RESTORED.
4. ADJUSTMENTS IN LOCATION OF THE ADVANCE WARNING SIGNS SHOULD BE MADE AS NEEDED AND AT THE DISCRETION OF THE ENGINEER TO ACCOMMODATE THE HORIZONTAL OR VERTICAL ALIGNMENT OF THE ROADWAY, RECOGNIZING THAT THE DISTANCES SHOWN FOR SIGN SPACINGS ARE MINIMUMS.
5. TTC SIGNALS SHALL BE ASSUMED TO BE LOCATED BEHIND TEMPORARY CONCRETE TRAFFIC BARRIER OR EXISTING GUARDRAIL. ANY FILL REQUIRED FOR ESTABLISHING A LEVEL SURFACE FOR TTC SIGNALS BEHIND THE GUARDRAIL SHALL BE INCIDENTAL TO ITEM 900.620, "SPECIAL PROVISION (TEMPORARY TRAFFIC SIGNAL SYSTEM, PORTABLE)". IF THE CONTRACTOR INSTALLS THE TTC SIGNALS INSIDE THE GUARDRAIL, TWO ENERGY ABSORPTION ATTENUATORS SHALL BE PROVIDED, ONE ON EITHER SIDE OF THE TTC SIGNAL. THE COST OF THE ENERGY ABSORPTION ATTENUATORS SHALL BE INCIDENTAL TO ITEM 900.620, "SPECIAL PROVISION (TEMPORARY TRAFFIC SIGNAL SYSTEM, PORTABLE)".
6. SEE THE SPECIAL PROVISIONS FOR ADDITIONAL INFORMATION AND REQUIREMENTS.

LEGEND

- ➔ FLOW OF TRAFFIC
- RETROREFLECTIVE PLASTIC DRUM
- ▨ WORK AREA
- ⊗ ENERGY ABSORPTION ATTENUATOR (ITEM 621.56)
- ⬮ TEMPORARY PORTABLE TRAFFIC CONTROL SIGNAL (SEE NOTES THIS SHEET)
- ▩ TEMPORARY TRAFFIC BARRIER (ITEM 621.90)


PROJECT NAME: WATERFORD	PLOT DATE: 3/19/2012
PROJECT NUMBER: IM MEMB(31)	DRAWN BY: MWS
FILE NAME: s1a296ts.dgn	CHECKED BY: JF
PROJECT LEADER: JPB	DESIGNED BY: SRB
TRAFFIC CONTROL SHEET 3	
SHEET 7 OF 48	

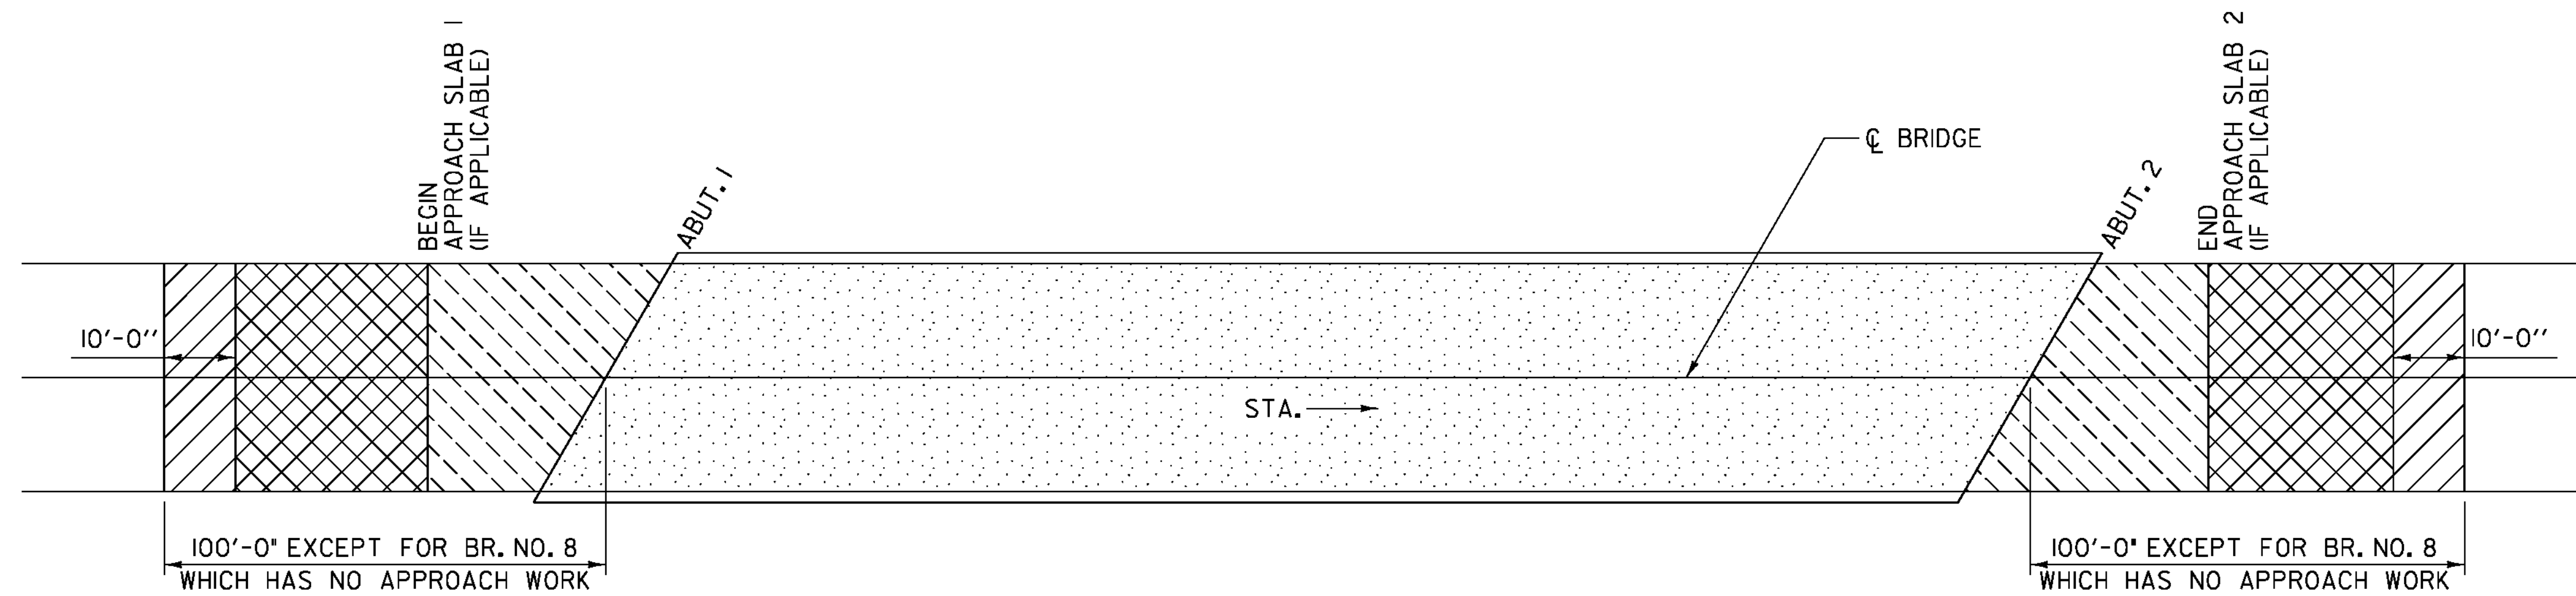

ALL BRIDGES IN THIS PROJECT HAVE EITHER BURIED OR NO APPROACH SLABS. THEREFORE, ALL PAVEMENT REMOVAL BEHIND ABUTMENTS SHALL BE PAID FOR UNDER ITEM 210.10, "COLD PLANING, BITUMINOUS PAVEMENT".

 COLD PLANE - 1/4"

 COLD PLANE - 2 1/2"

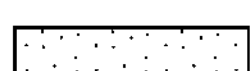 REMOVE BIT. CONC. PAV'T - TO THE TOP OF THE CONCRETE BRIDGE DECK AND REMOVE THE BARRIER MEMBRANE FOR BRIDGE NO. IN&S, 3N&S, AND 5N&S.
REMOVE EXISTING TAMMS FLEXOLITH 216 OVERLAY FOR BRIDGE NO. 8 - TO TOP OF THE CONCRETE BRIDGE DECK.


NOTE:

1. COLD PLANING WILL BE PAID FOR UNDER ITEM 210.10 EXCEPT AS OTHERWISE SPECIFIED IN NOTE 13 ON SHEET 2.
2. REMOVAL OF THE BIT. CONC. PAV'T. WILL BE PAID FOR UNDER ITEM 529.10.
3. REMOVAL OF THE BARRIER MEMBRANE WILL BE PAID FOR UNDER ITEM 580.16.
4. REMOVAL OF THE EXISTING TAMMS FLEXOLITH 216 OVERLAY ON BRIDGE NO. 8 WILL BE PAID FOR UNDER ITEM 900.670, "SPECIAL PROVISION (SURFACE PREPARATION FOR OVERLAY)".
5. IN THE EVENT THAT COLD PLANING OF THE RIGHT ROADWAY SHOULDERS ALONG BRIDGE APPROACHES EXPOSES GRAVEL SUBBASE, THE CONTRACTOR SHALL REMOVE 2" OF GRAVEL SUBBASE, PREPARE THE AREA AS DIRECTED BY THE ENGINEER, AND PROVIDE 2" BASE PAVEMENT, IN ADDITION TO THE 2 1/2" PAVEMENT TO BE PLACED IN TWO EQUAL LIFTS OF TYPE IV MIX IN ALL OTHER LOCATIONS PER TYPICAL APPROACH SECTION ON BITUMINOUS CONCRETE DETAILS SHEET 1. FOR BRIDGES IN&S, 3N&S, AND 5N&S, A TOTAL OF 182 ADDITIONAL TONS HAVE BEEN INCLUDED IN THE ESTIMATED QUANTITY FOR ITEM 406.27 TO ADDRESS THIS WORK. WHERE DIRECTED BY THE ENGINEER, PAYMENT FOR BASE PREPARATION WILL BE PAID FOR UNDER EQUIPMENT RENTAL ITEMS.


BITUMINOUS CONCRETE REMOVAL & REPLACEMENT PLAN

NOT TO SCALE

PROJECT NAME: WATERFORD	
PROJECT NUMBER: IM MEMB(31)	
FILE NAME: s1a296removal.dgn	PLOT DATE: 3/19/2012
PROJECT LEADER: JPB	DRAWN BY: MWS
DESIGNED BY: SRB	CHECKED BY: JF
BITUMINOUS CONCRETE REMOVAL PLAN	SHEET 8 OF 48


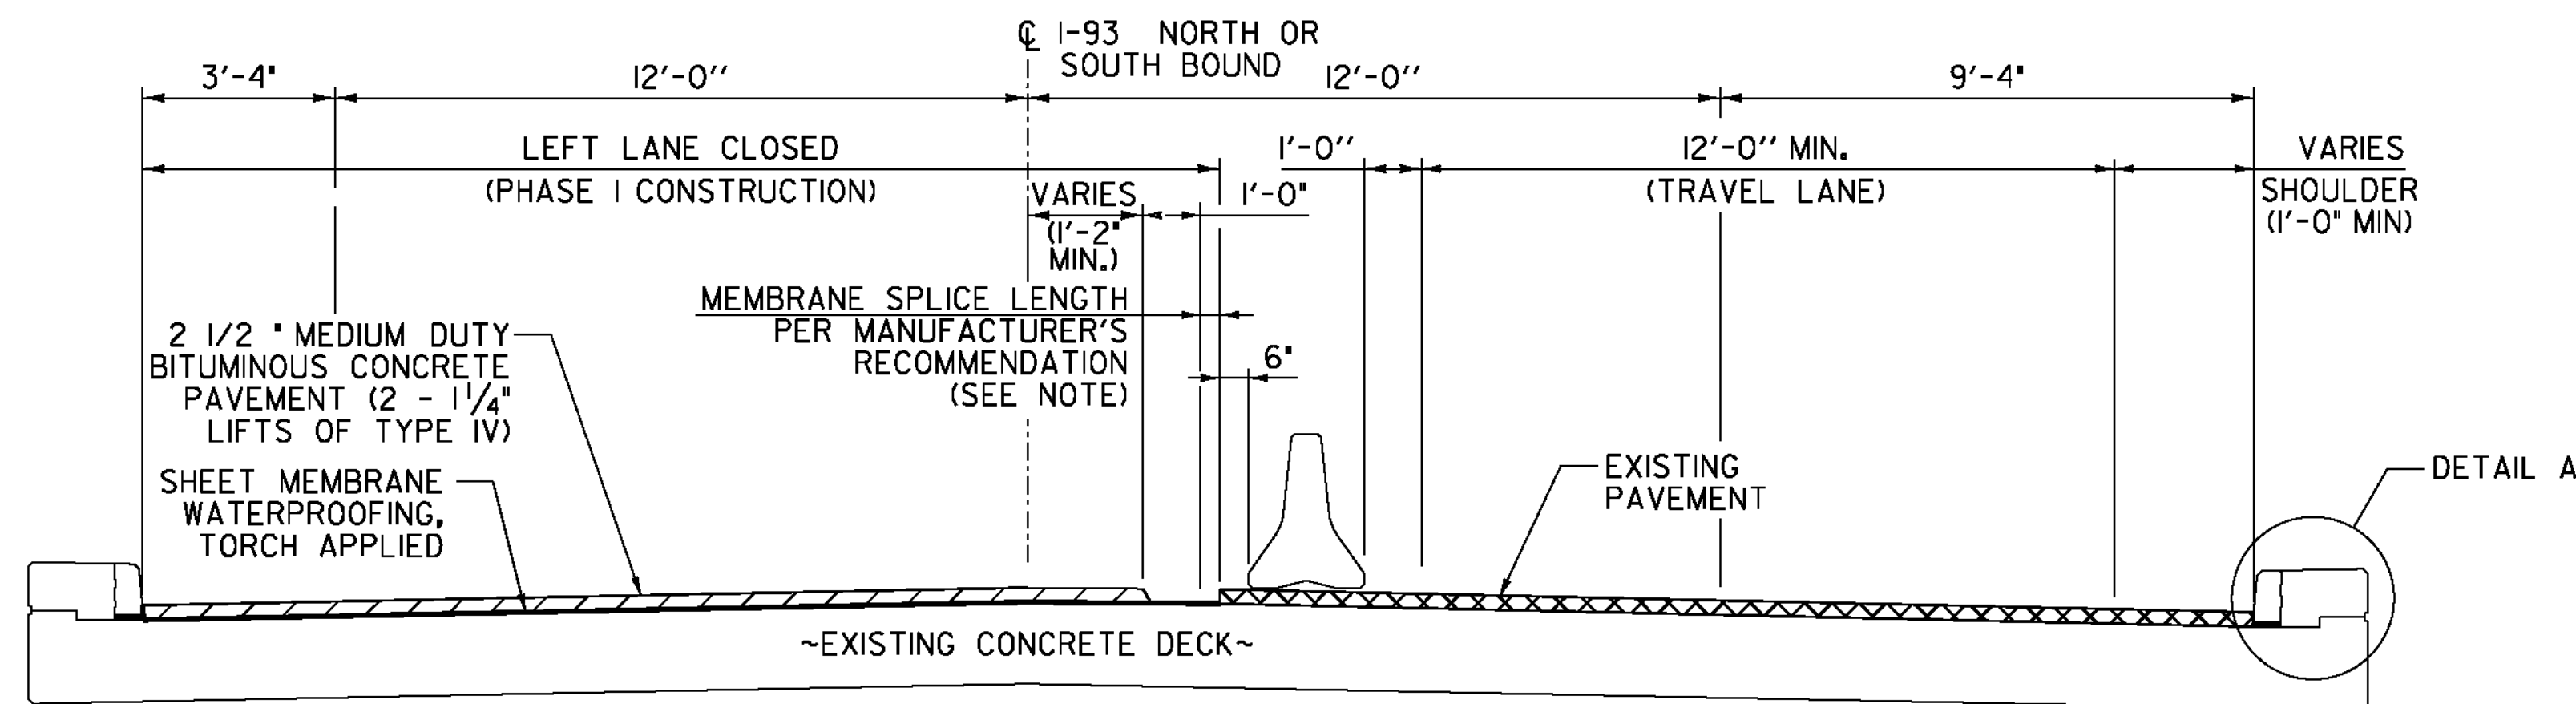


TYPICAL SECTION - PHASE I CONSTRUCTION
(BRIDGES IN&S, 5N&S, AND 3N)
NOT TO SCALE

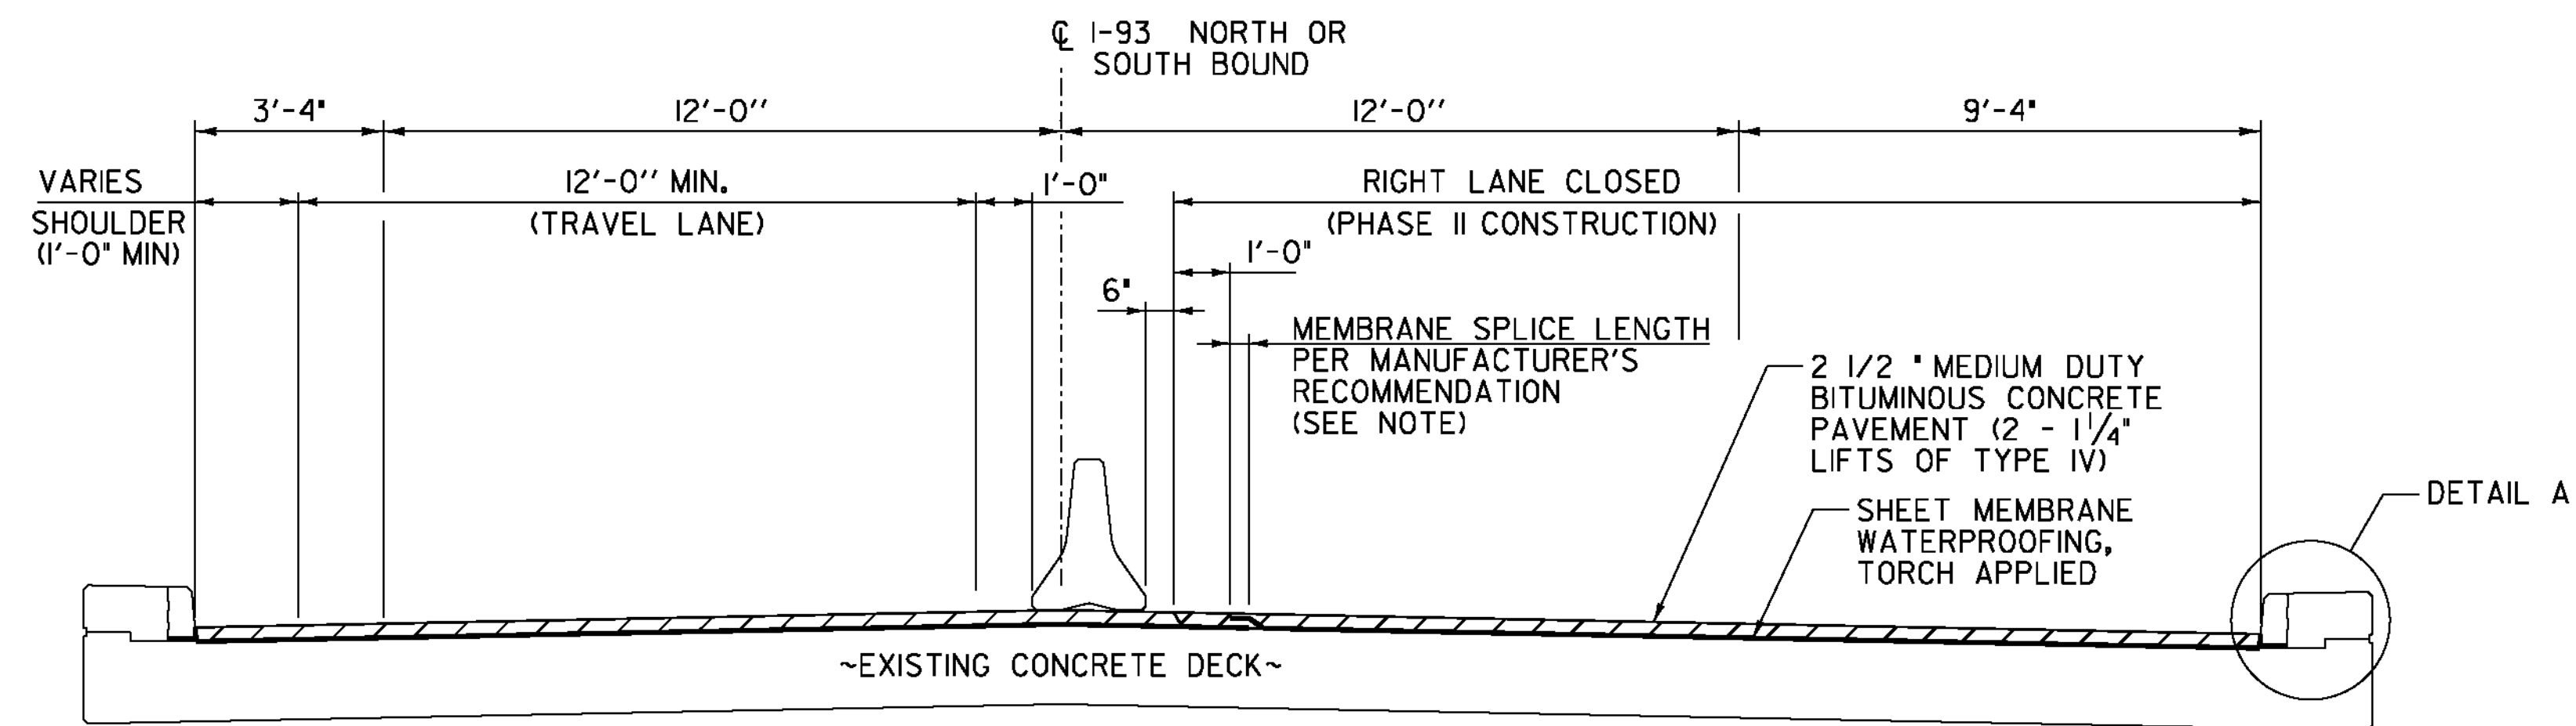

TYPICAL SECTION - PHASE II CONSTRUCTION
(BRIDGES IN&S, 5N&S, AND 3N)
NOT TO SCALE

NOTE: MEMBRANE PLACEMENT FOR BRIDGE NO. 3N IS SIMILAR TO THAT SHOWN IN THE ABOVE SECTIONS EXCEPT THE THE BRIDGE IS SUPERELEVATED WITH THE LEFT SHOULDER AT THE LOW SIDE OF THE CROSS SLOPE. THE CONTRACTOR SHALL BEGIN PLACEMENT OF THE MEMBRANE AT THE LOW SIDE OF THE BRIDGE TO ENSURE THAT THE HIGH SIDE OVERLAPS THE LOW SIDE AT THE MEMBRANE SPLICE.

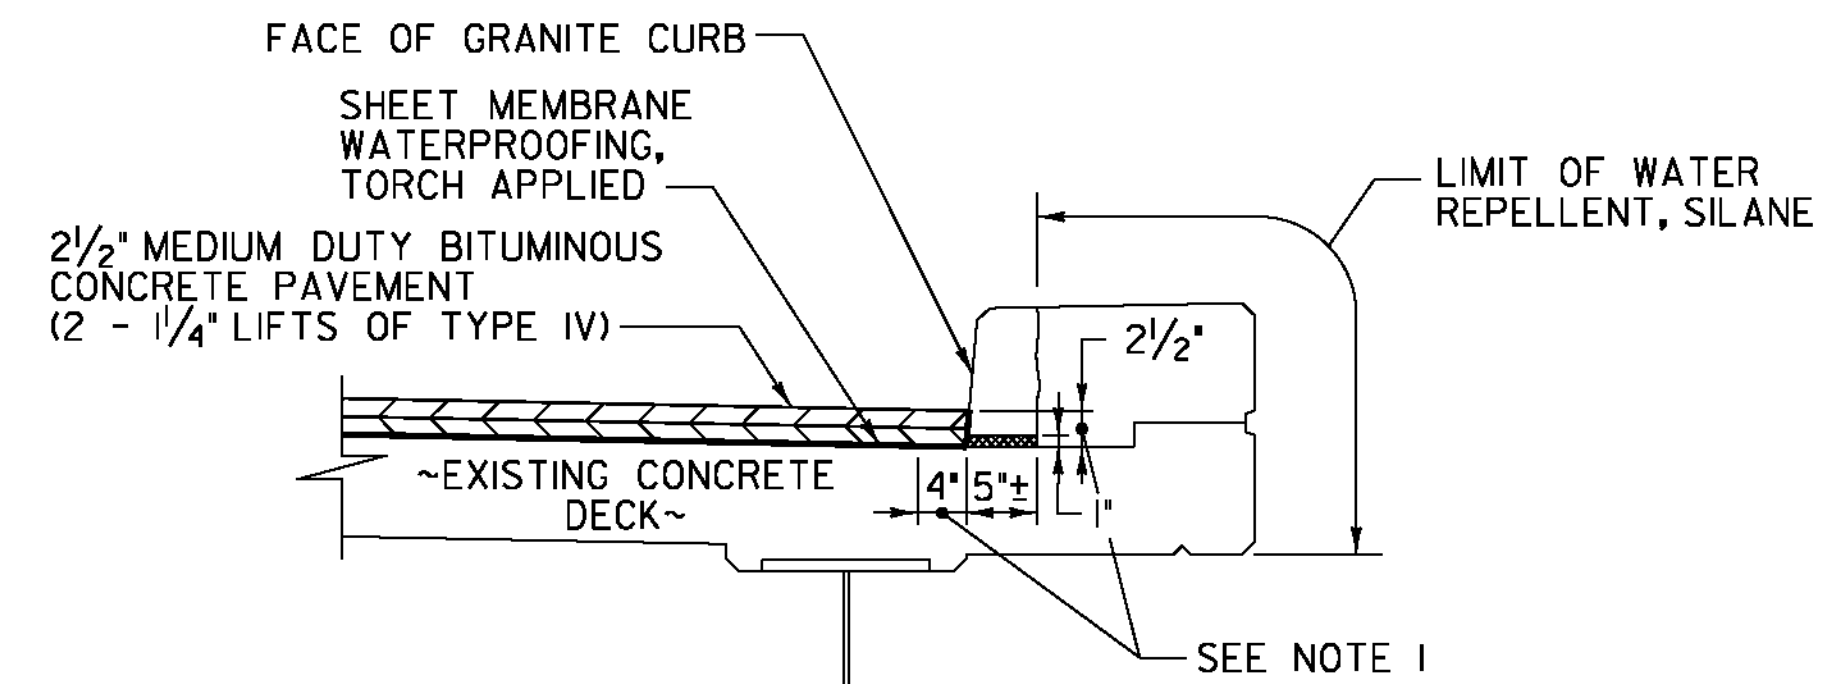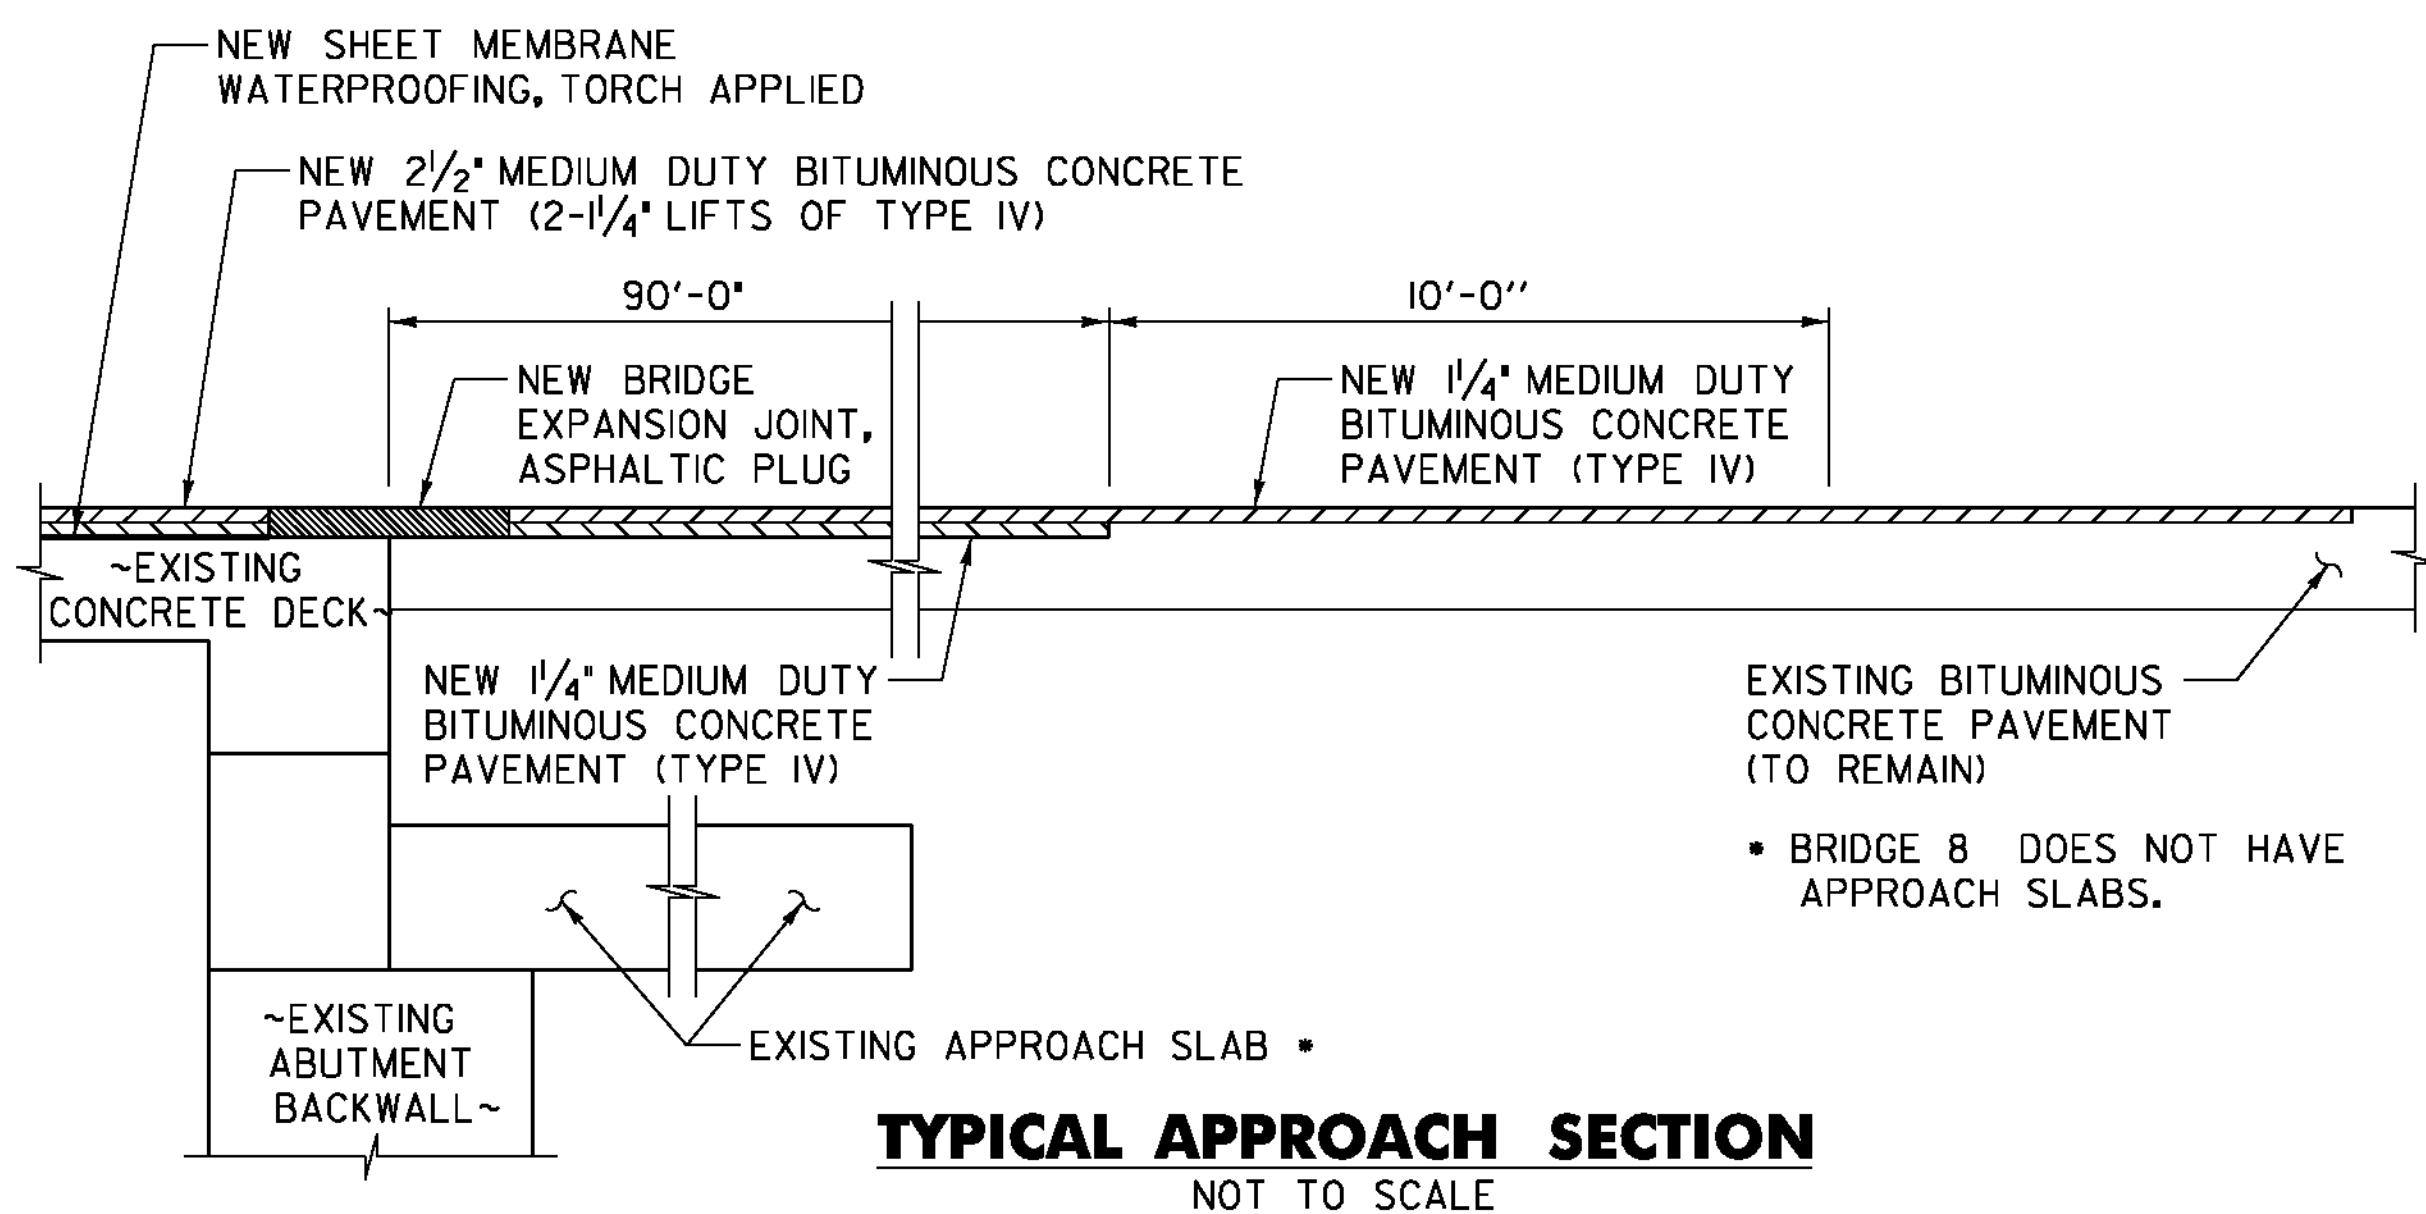

DETAIL A NOTES:

1. INDICATES AREA ALONG DECK AND UP FACE OF CURB FOR PLACEMENT OF TWO COATS OF POLYURETHANE MEMBRANE.
2. POLYURETHANE MEMBRANE AND BLAST CLEANING SHALL BE INCLUDED IN THE UNIT PRICE BID FOR SHEET MEMBRANE WATERPROOFING, TORCH APPLIED.
3. SHEET MEMBRANE WATERPROOFING SHALL EXTEND TO FACE OF CURB AS SHOWN.
4. IN ADDITION TO THE REQUIREMENTS OF SUBSECTION 519.04, BLAST CLEAN 2 1/2" UP THE FACE OF CURB PRIOR TO PLACING THE MEMBRANE.
5. REPOINTING OF THE GRANITE CURB SHALL BE REQUIRED AND PAID FOR UNDER ITEM 900.625, "SPECIAL PROVISION (REPOINTING GRANITE CURB)". THE QUANTITY FOR THIS ITEM AS SHOWN ON THE QUANTITY SHEET IS ESTIMATED.

DETAIL A
(BRIDGES IN&S, 3N&S, AND 5N&S)
NOT TO SCALE

BRIDGE LENGTH AND WIDTH (CURB TO CURB)


BRIDGE NO.	WIDTH (CURB TO CURB) (FEET)	LENGTH (FEET)
IN	36.67	204.88
IS	36.67	170.91
3N	36.67	113.04
3S	36.67	113.08
5N	36.67	109.16
5S	36.67	108.96
8	29.33	306.44

ASPHALTIC PLUG JOINT REPLACEMENT SCHEDULE


BRIDGE NO.	ABUT. 1	PIER 1	PIER 2	ABUT. 2
IN	53 LF	-	-	53 LF
IS	48 LF	-	-	48 LF
3N	38 LF	-	-	38 LF
3S	38 LF	-	-	38 LF
5N	55 LF	-	-	55 LF
5S	53 LF	-	-	53 LF
8	-	-	-	-

PROJECT NAME: WATERFORD
PROJECT NUMBER: IM MEMB(3I)


FILE NAME: s1a296conc_details.dgn PLOT DATE: 3/19/2012
PROJECT LEADER: JPB DRAWN BY: MWS
DESIGNED BY: SRB CHECKED BY: JF
BITUMINOUS CONCRETE DETAILS SHEET 1 SHEET 9 OF 48

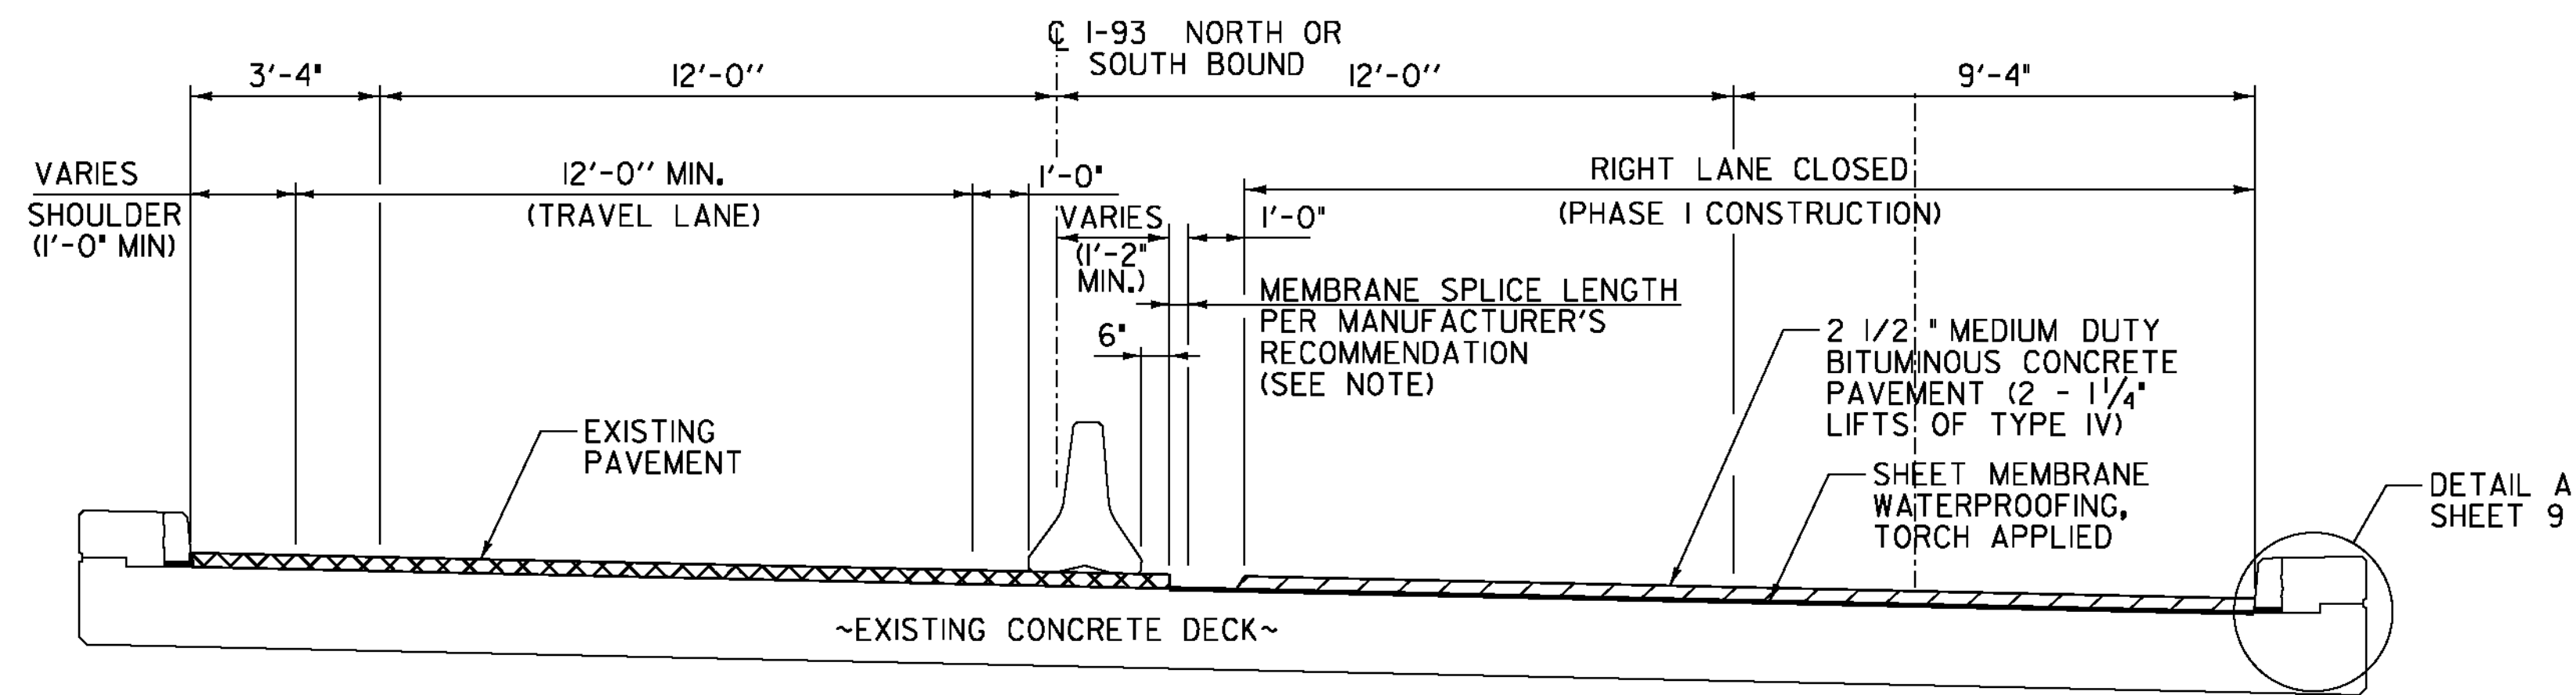


TYPICAL SECTION - PHASE I CONSTRUCTION - BRIDGE NO. 3S
NOT TO SCALE

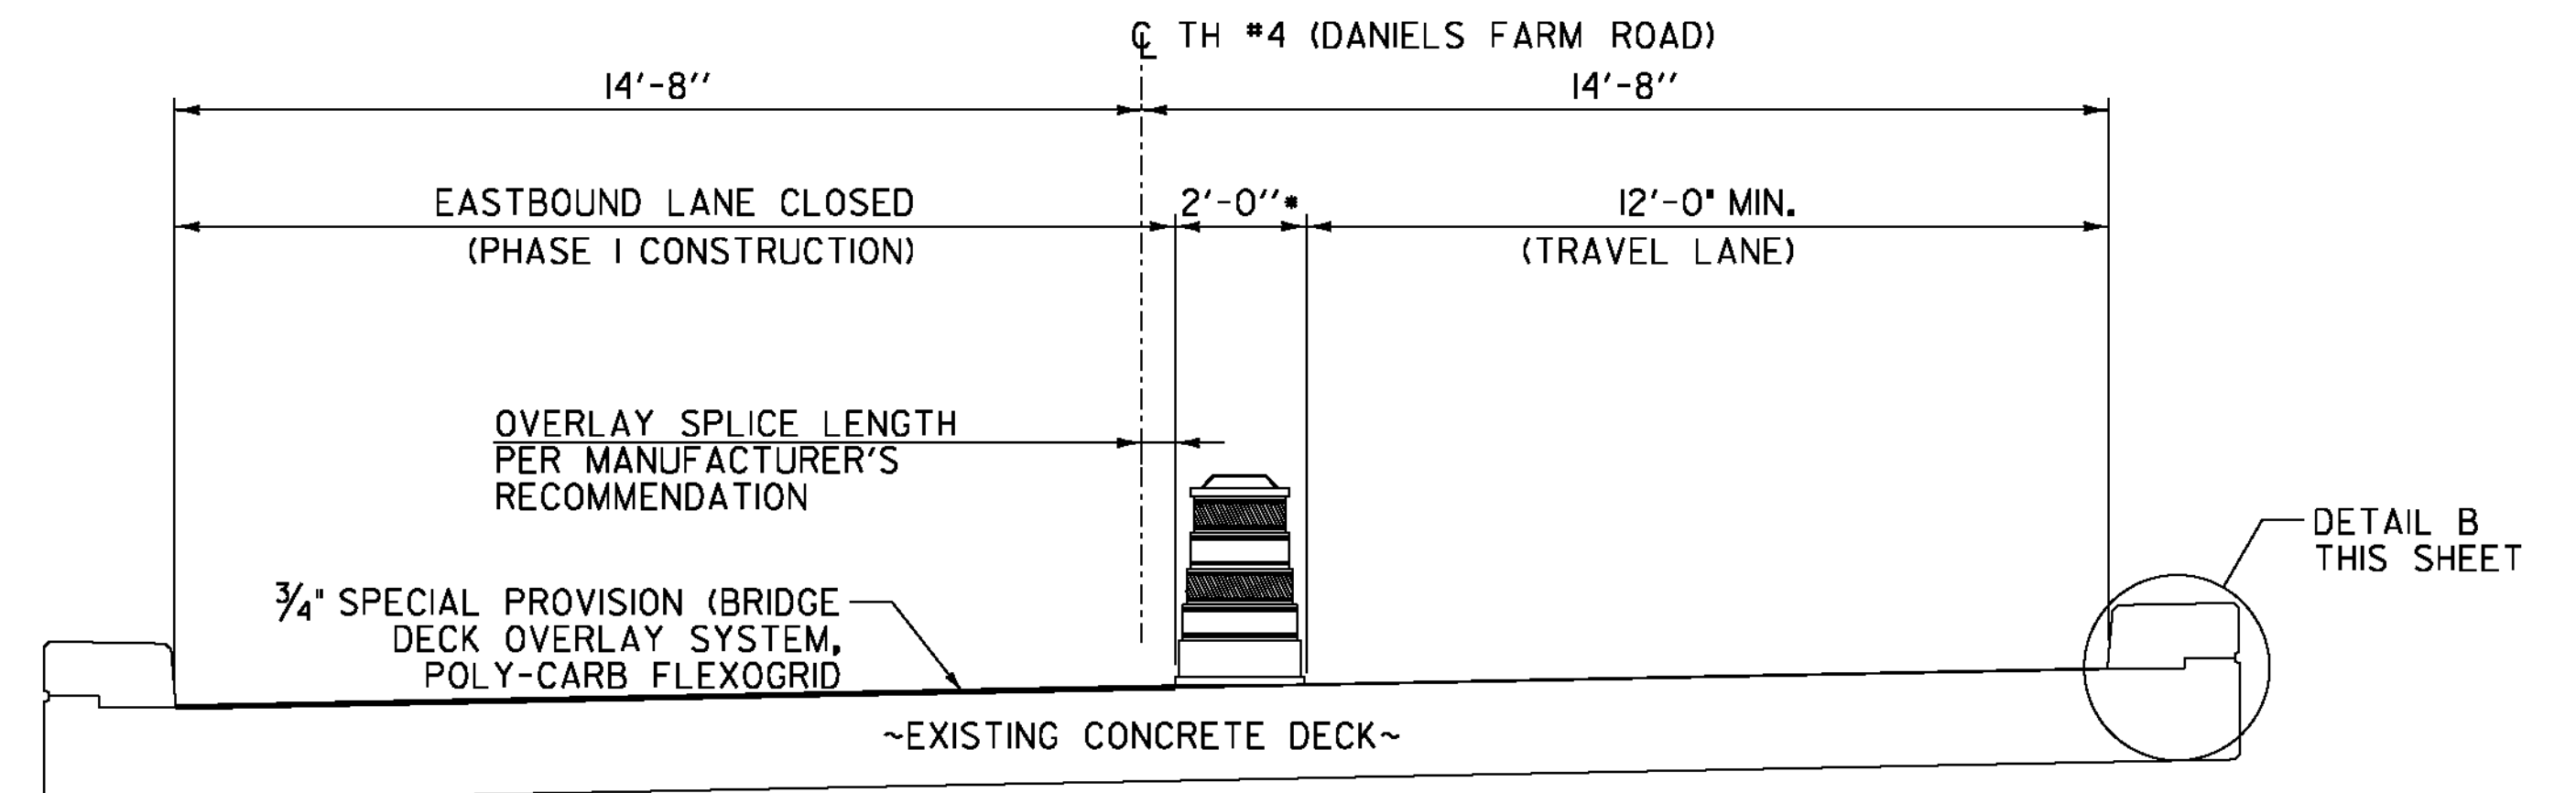

TYPICAL SECTION - PHASE I CONSTRUCTION - BRIDGE NO. 8
NOT TO SCALE

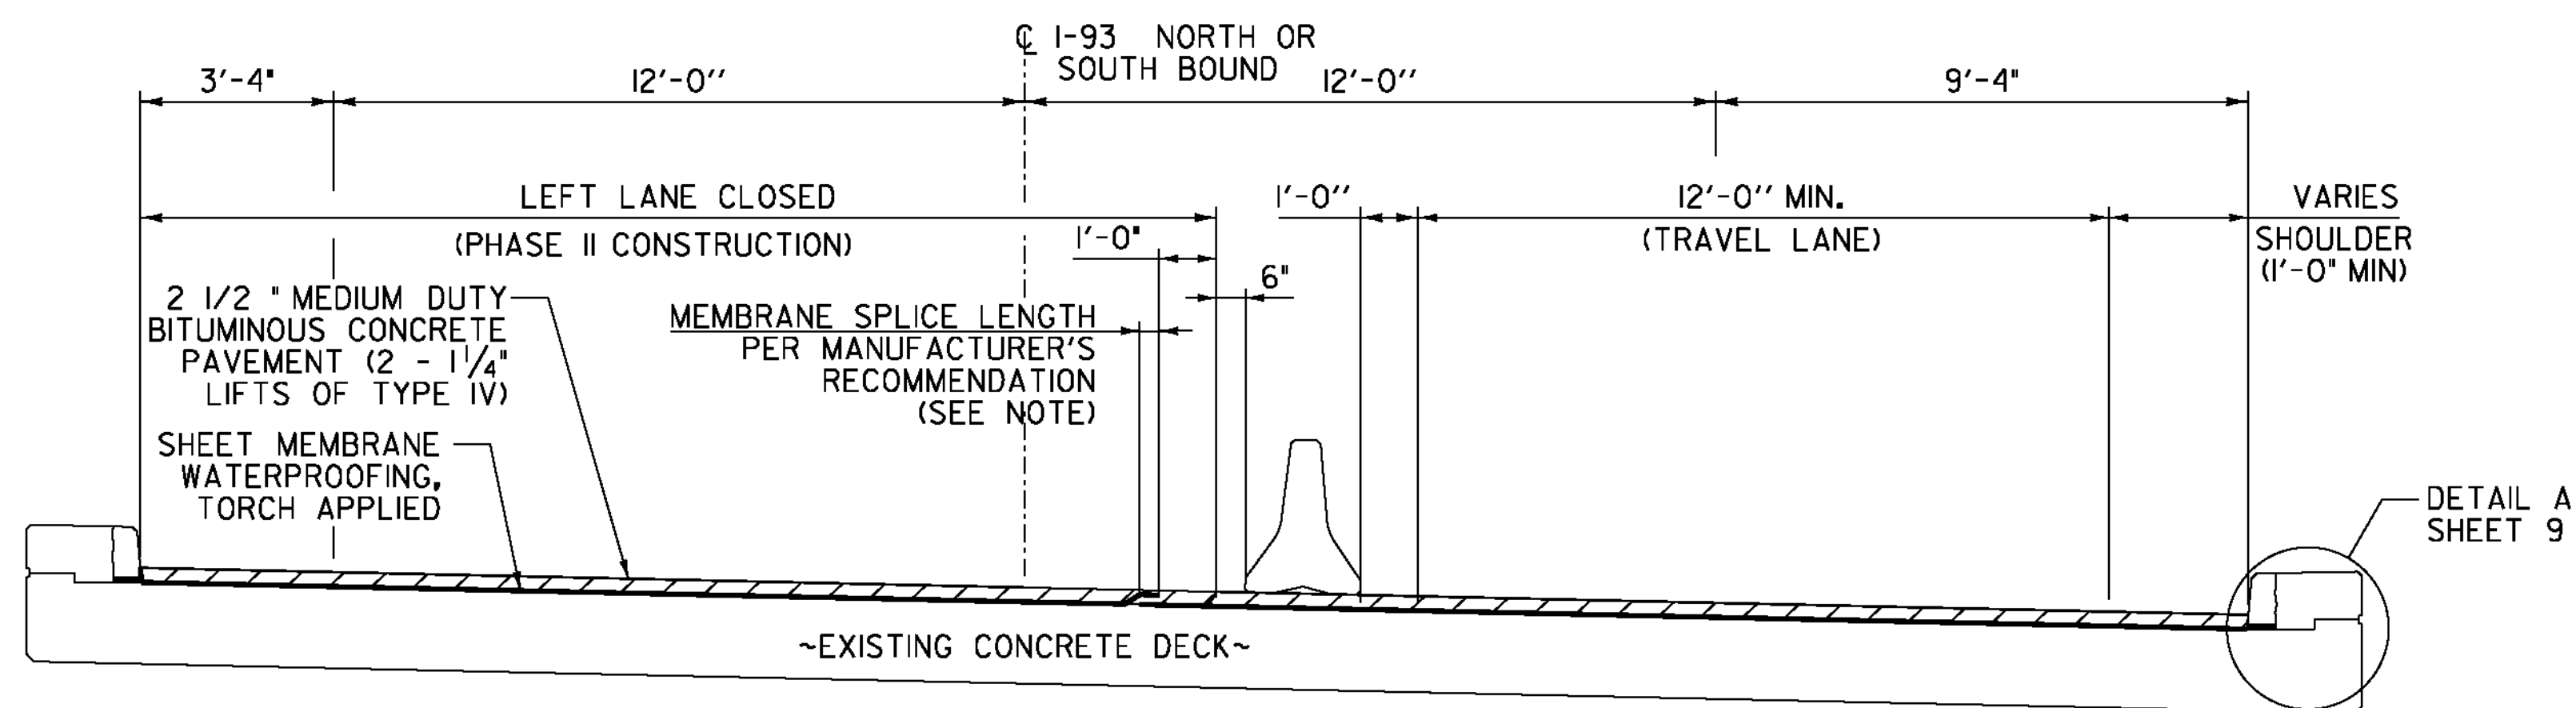


TYPICAL SECTION - PHASE II CONSTRUCTION - BRIDGE NO. 3S
NOT TO SCALE

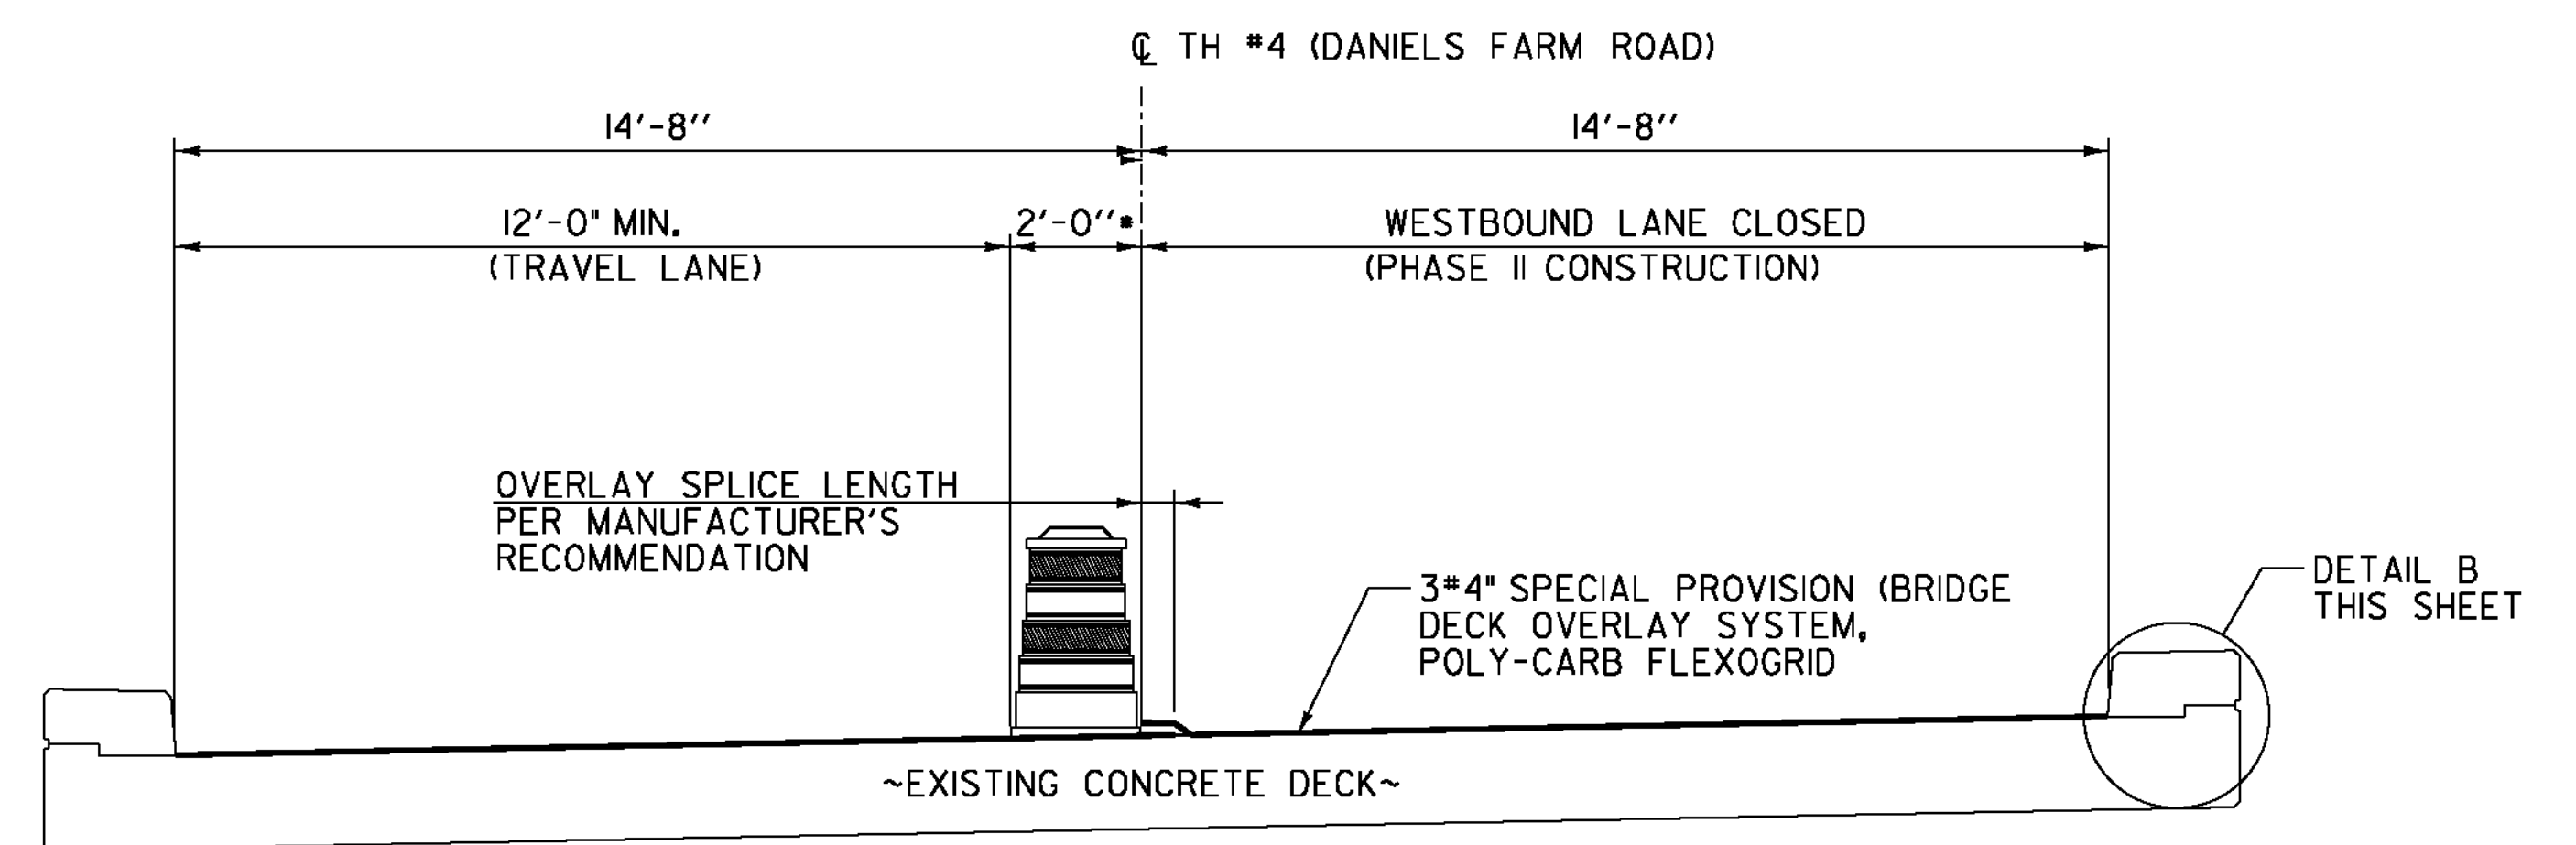

TYPICAL SECTION - PHASE II CONSTRUCTION - BRIDGE NO. 8
NOT TO SCALE


NOTE: PLACEMENT OF THE MEMBRANE SHALL START AT THE LOW SIDE OF THE BRIDGE. THE SPLICE SHALL BE AS SHOWN ABOVE, WITH THE HIGH SIDE OVERLAPPING THE LOW SIDE.

- TEMPORARY BARRELS SHALL BE MOVED AND REPLACED AS NECESSARY TO ACCOMMODATE OVERSIZED VEHICLES AND CONSTRUCTION ACTIVITIES. PAYMENT SHALL BE INCIDENTAL TO ITEM 641.10.

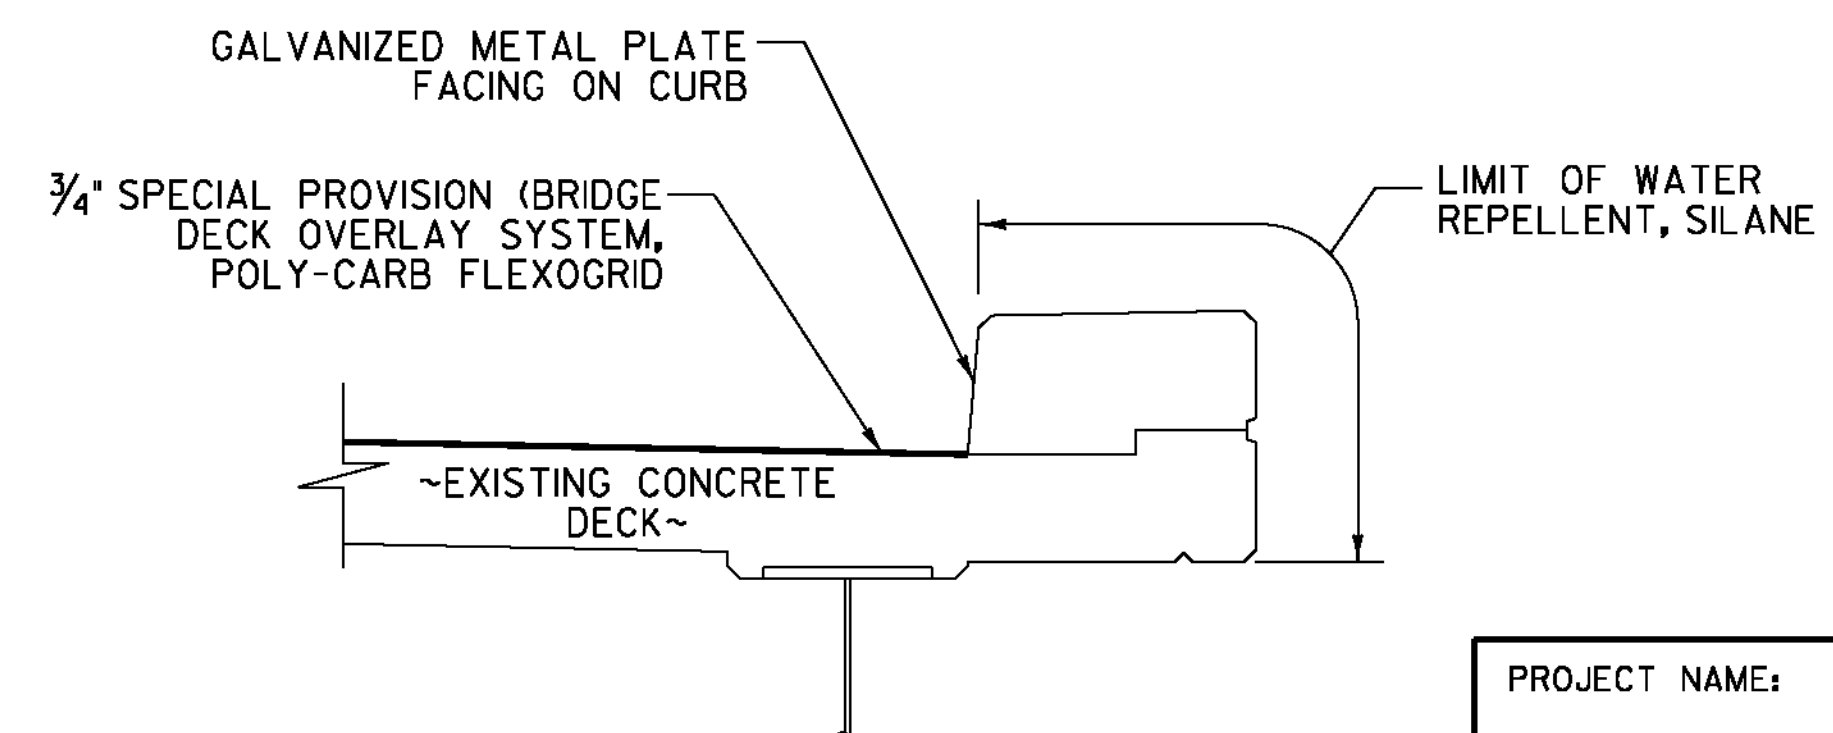


DETAIL B
NOT TO SCALE

PROJECT NAME: WATERFORD	PLOT DATE: 3/19/2012
PROJECT NUMBER: IM MEMB(3I)	DRAWN BY: MWS
FILE NAME: s1a296conc_details.dgn	CHECKED BY: JF
PROJECT LEADER: JPB	
DESIGNED BY: SRB	
BITUMINOUS CONCRETE DETAILS SHEET 2 SHEET 10 OF 48	

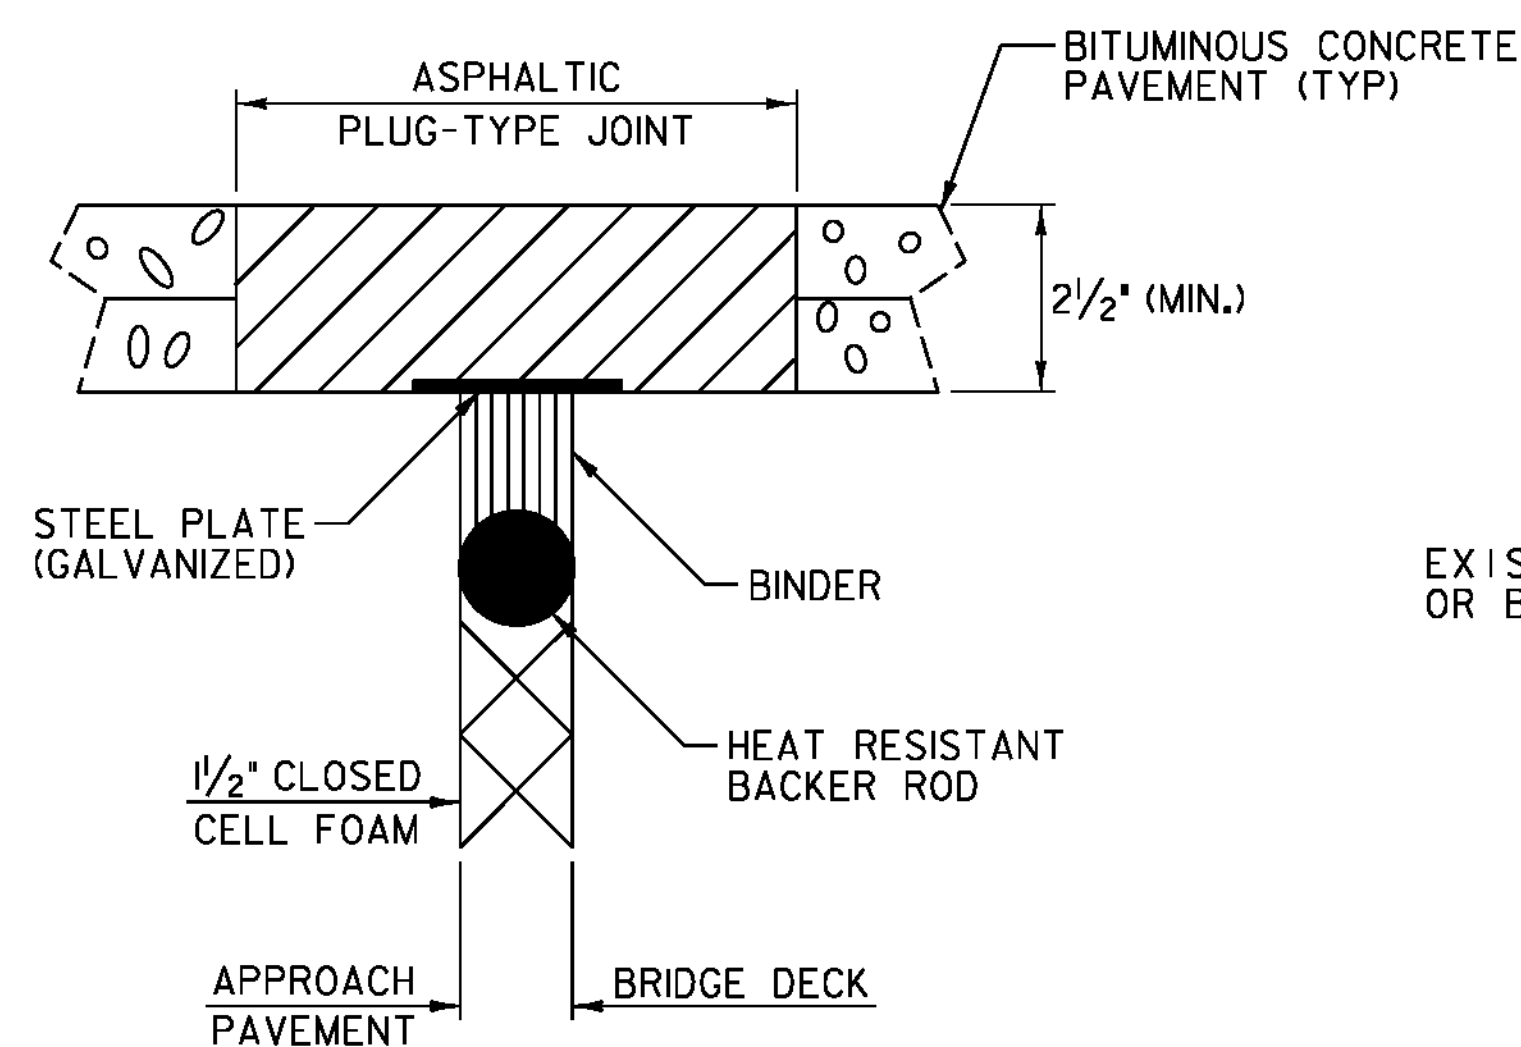


ASPHALTIC PLUG-TYPE JOINT DETAIL
(NOT TO SCALE)

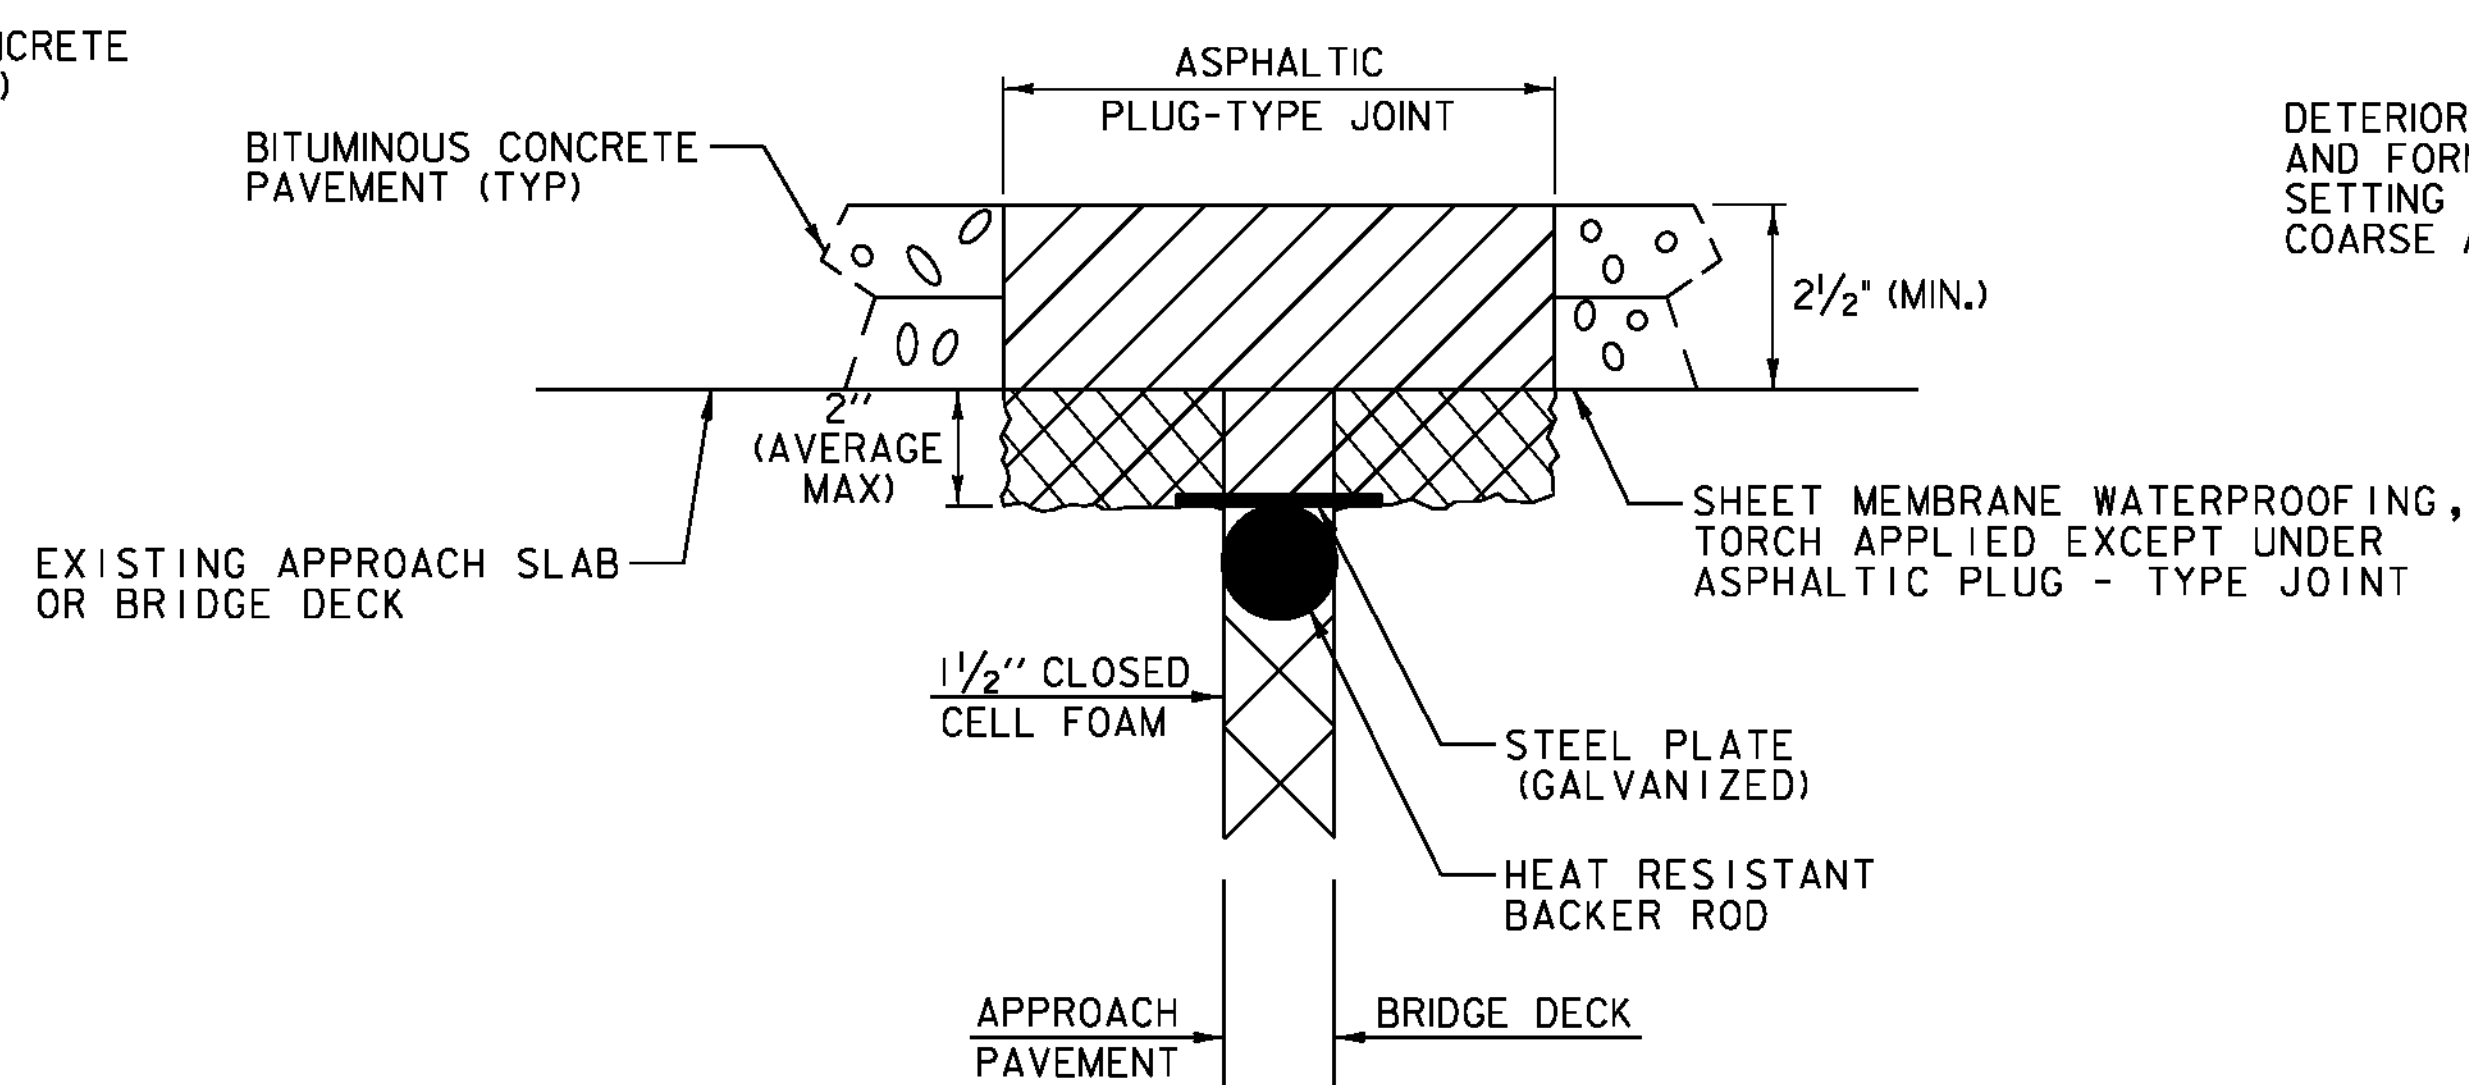

ASPHALTIC PLUG-TYPE JOINT DETAIL
REMOVAL OF UP TO
2" DETERIORATED CONCRETE
(NOT TO SCALE)

DETERIORATED CONCRETE TO BE REMOVED AND FORMED TO EXISTING ELEV. WITH RAPID SETTING CONCRETE REPAIR MATERIAL WITH COARSE AGGREGATE (TYP).(SEE NOTES BELOW)

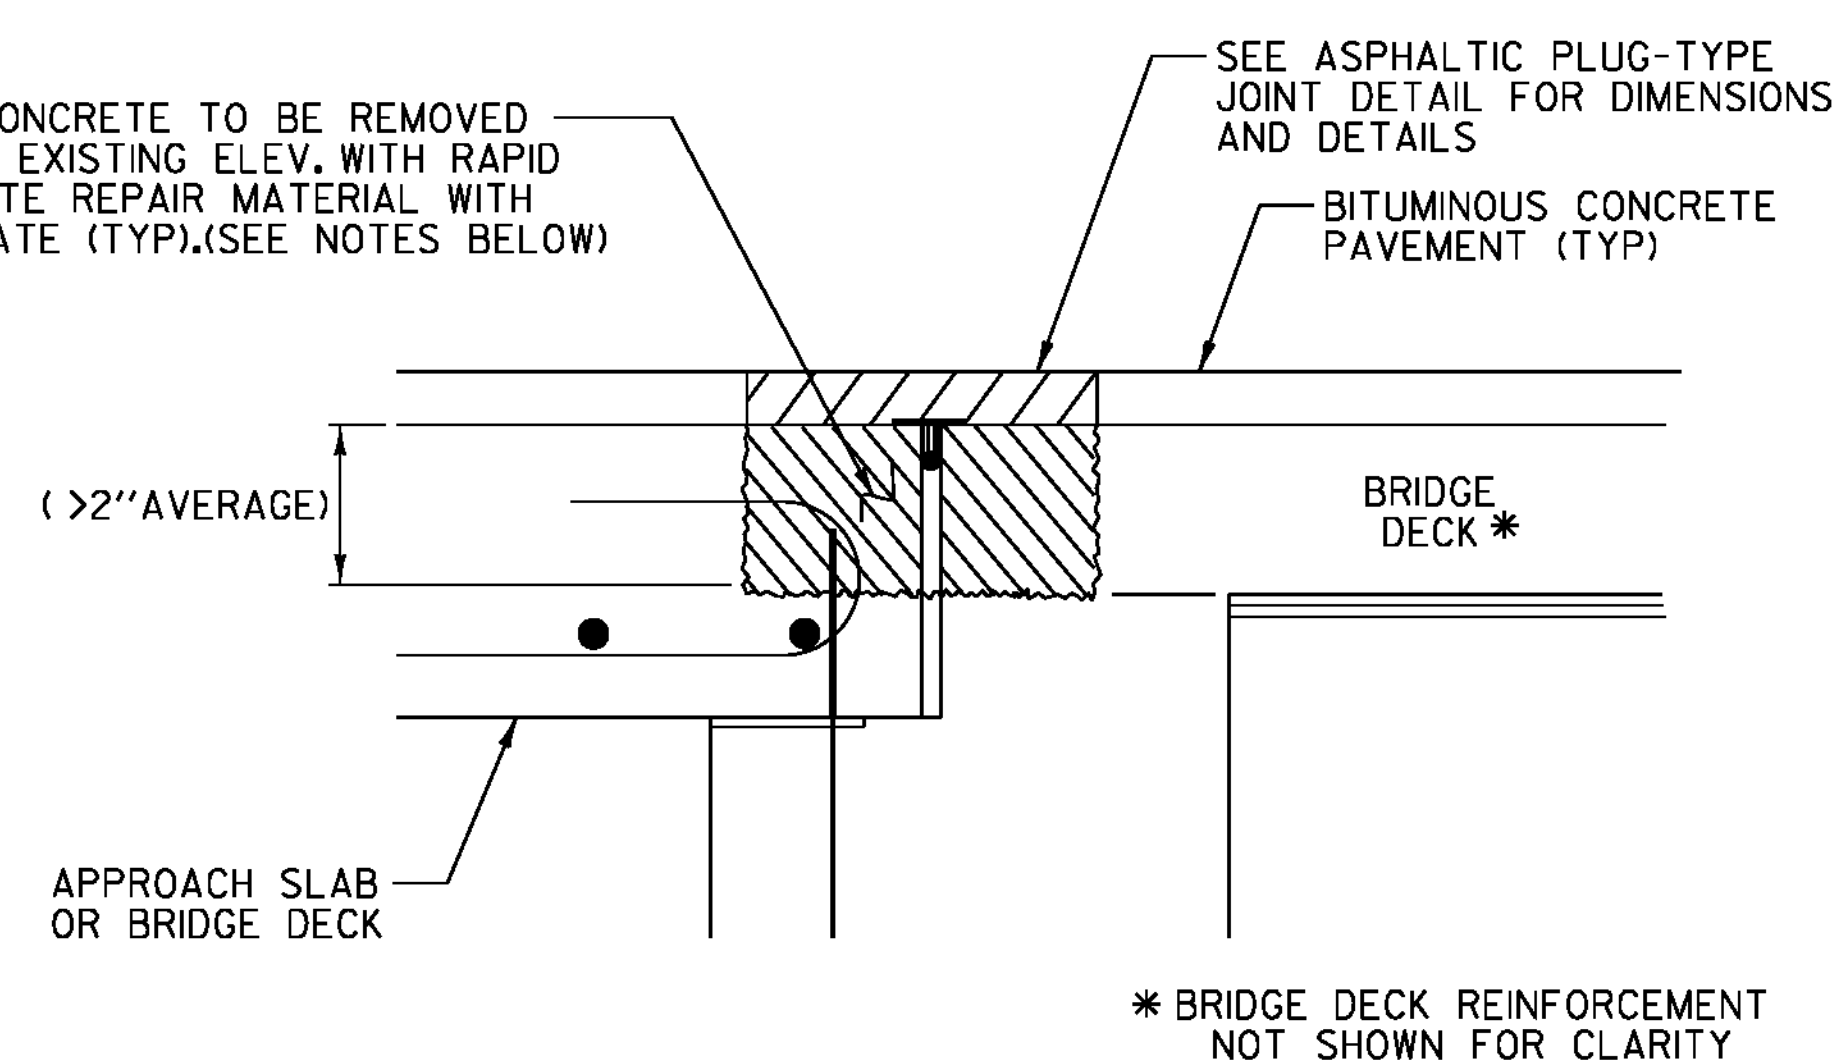

ASPHALTIC PLUG-TYPE JOINT DETAIL
REMOVAL OF >2"
DETERIORATED CONCRETE
(NOT TO SCALE)

NOTES:

1. THE JOINT SHALL BE LOCATED CENTRALLY OVER THE DECK EXPANSION GAP OR FIXED JOINT MARKED OUT TO THE MANUFACTURER'S RECOMMENDED WIDTH.
2. THE JOINT SHALL BE EXCAVATED AS SHOWN ON THE PLANS BY USE OF SAWS AND PNEUMATIC HAMMER OR A HAMMER AND CHISEL.
3. THE JOINT AREA SHALL BE BLAST CLEANED OF DEBRIS AND ASPHALT. THE JOINT AREA SHALL BE THOROUGHLY DRIED USING HOT COMPRESSED AIR PRIOR TO APPLYING BINDER MATERIAL.
4. SPALLED AND DEFECTIVE CONCRETE SHALL BE REPAIRED WITH AN APPROVED MATERIAL AS AGREED UPON BY THE ENGINEER.
5. PROPERLY SIZED HEAT RESISTANT BACKER ROD SHALL BE PLACED IN THE MOVEMENT GAP ALLOWING FOR 1 INCH +/- OF BINDER ABOVE THE ROD.
6. THE BINDER MATERIAL SHALL BE HEATED AND PLACED AS RECOMMENDED BY THE MANUFACTURER.
7. PLACE 1/4 INCH THICK BY 8 INCH WIDE SECTIONS OF STEEL PLATE OVER THE CENTER OF THE MOVEMENT GAP. SECURE PLATES FROM MOVING BY INSERTING LOCATING PINS THROUGH THE PRESTAMPED HOLES INTO BACKER ROD AND COVER WITH HOT BINDER.
 - A. THE STEEL PLATES MAY BE OMITTED WHERE THE APPROACH SLAB IS COVERED WITH A STONE BASE OR BITUMINOUS PAVEMENT AND VERTICAL MOVEMENT OF THE PLATES MIGHT OCCUR.
 - B. FOR ALL EXPANSION LENGTHS OVER 100 FEET, THE CONTRACTOR SHALL BE REQUIRED TO USE STEEL PLATE. ADJACENT SURFACES SHALL BE GROUND DOWN TO ENSURE FULL CONTACT WITH THE STEEL PLATE.
8. THE BINDER MATERIAL AND AGGREGATE SHALL BE HEATED AND MIXED AS RECOMMENDED BY THE MANUFACTURER.
9. THE INSTALLATION OF MATERIAL, COMPACTION, AND TOPCOATING SHALL BE AS RECOMMENDED BY THE MANUFACTURER.
10. IMMEDIATELY AFTER TOPCOATING, AN ANTI-SKID MATERIAL SHALL BE CAST OVER THE JOINT TO REDUCE THE RISK OF TRACKING.
11. JOINT SHALL BE PROTECTED FROM TRAFFIC UNTIL THE MATERIAL HAS COOLED TO 125°F ±.

WEATHER LIMITATIONS

BINDER MATERIAL SHALL BE APPLIED ONLY WHEN THE FOLLOWING CONDITIONS PREVAIL:

- A. THE AMBIENT AIR TEMPERATURE IS AT LEAST 50°F AND RISING.
- B. THE ROAD SURFACE IS SUFFICIENTLY DRY.
- C. WEATHER CONDITIONS OR OTHER CONDITIONS ARE FAVORABLE AND ARE EXPECTED TO REMAIN SO FOR THE PERFORMANCE OF SATISFACTORY WORK.


NOTES:

1. UPON ENCOUNTERING UP TO 2" AVERAGE OF DETERIORATED CONCRETE, THE CONTRACTOR SHALL REMOVE THE DETERIORATED MATERIAL AND REPLACE IT WITH THE ASPHALTIC PLUG JOINT MATERIAL AS DIRECTED BY THE ENGINEER.
2. REMOVAL OF THE DETERIORATED CONCRETE WILL NOT BE PAID SEPARATELY BUT WILL BE CONSIDERED INCIDENTAL TO THE UNIT BID PRICE FOR ITEM 516.10. THE ADDITIONAL PLUG JOINT MATERIAL BELOW THE DESIGN DEPTH REQUIRED TO REPLACE THE DETERIORATED CONCRETE WILL BE CONSIDERED INCIDENTAL TO THE UNIT BID PRICE FOR THE ITEM 516.10.
3. THE STEEL PLATE IN THE ASPHALTIC PLUG JOINT MAY BE OMITTED ONLY IF THE REPAIRED SURFACE IS SO IRREGULAR IT WILL CAUSE VERTICAL MOVEMENT AND IT IS DIRECTED BY THE ENGINEER.


NOTES:

1. UPON ENCOUNTERING GREATER THAN 2" AVERAGE OF DETERIORATED CONCRETE, THE CONTRACTOR SHALL REMOVE THE DETERIORATED MATERIAL AND REPLACE IT WITH RAPID SETTING CONCRETE REPAIR MATERIAL WITH COARSE AGGREGATE.
2. REMOVAL OF THE DETERIORATED CONCRETE WILL BE INCLUDED IN THE UNIT BID PRICE FOR ITEM 580.20 "RAPID SETTING CONCRETE REPAIR MATERIAL WITH COARSE AGGREGATE".
3. THE STEEL PLATE IN THE ASPHALTIC PLUG JOINT MAY BE OMITTED ONLY IF THE REPAIRED SURFACE IS SO IRREGULAR IT WILL CAUSE VERTICAL MOVEMENT AND IT IS DIRECTED BY THE ENGINEER.


PROJECT NAME: WATERFORD	PLOT DATE: 3/19/2012
PROJECT NUMBER: IM MEMB(31)	DRAWN BY: MWS
FILE NAME: s1a296jnt_detail.dgn	CHECKED BY: JF
PROJECT LEADER: JPB	SHEET II OF 48
DESIGNED BY: SRB	
PAVEMENT JOINT DETAILS	

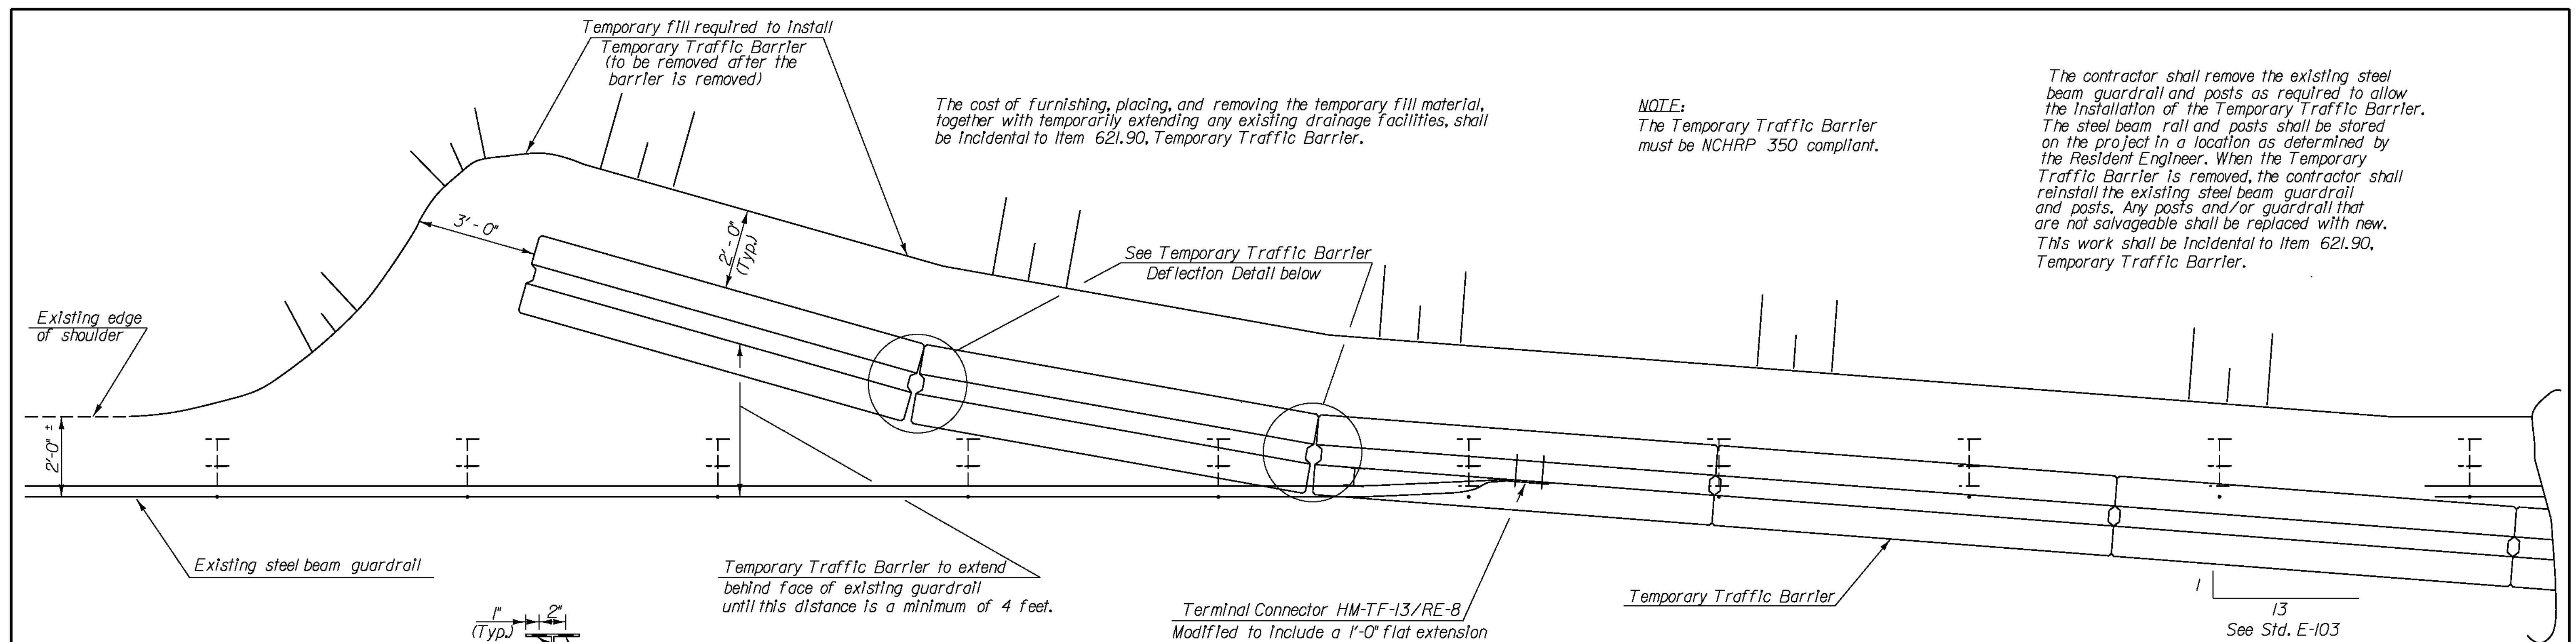


PLAN VIEW SHOWING POSITIVE CONNECTION BETWEEN TEMPORARY TRAFFIC BARRIER AND EXISTING GUARDRAIL

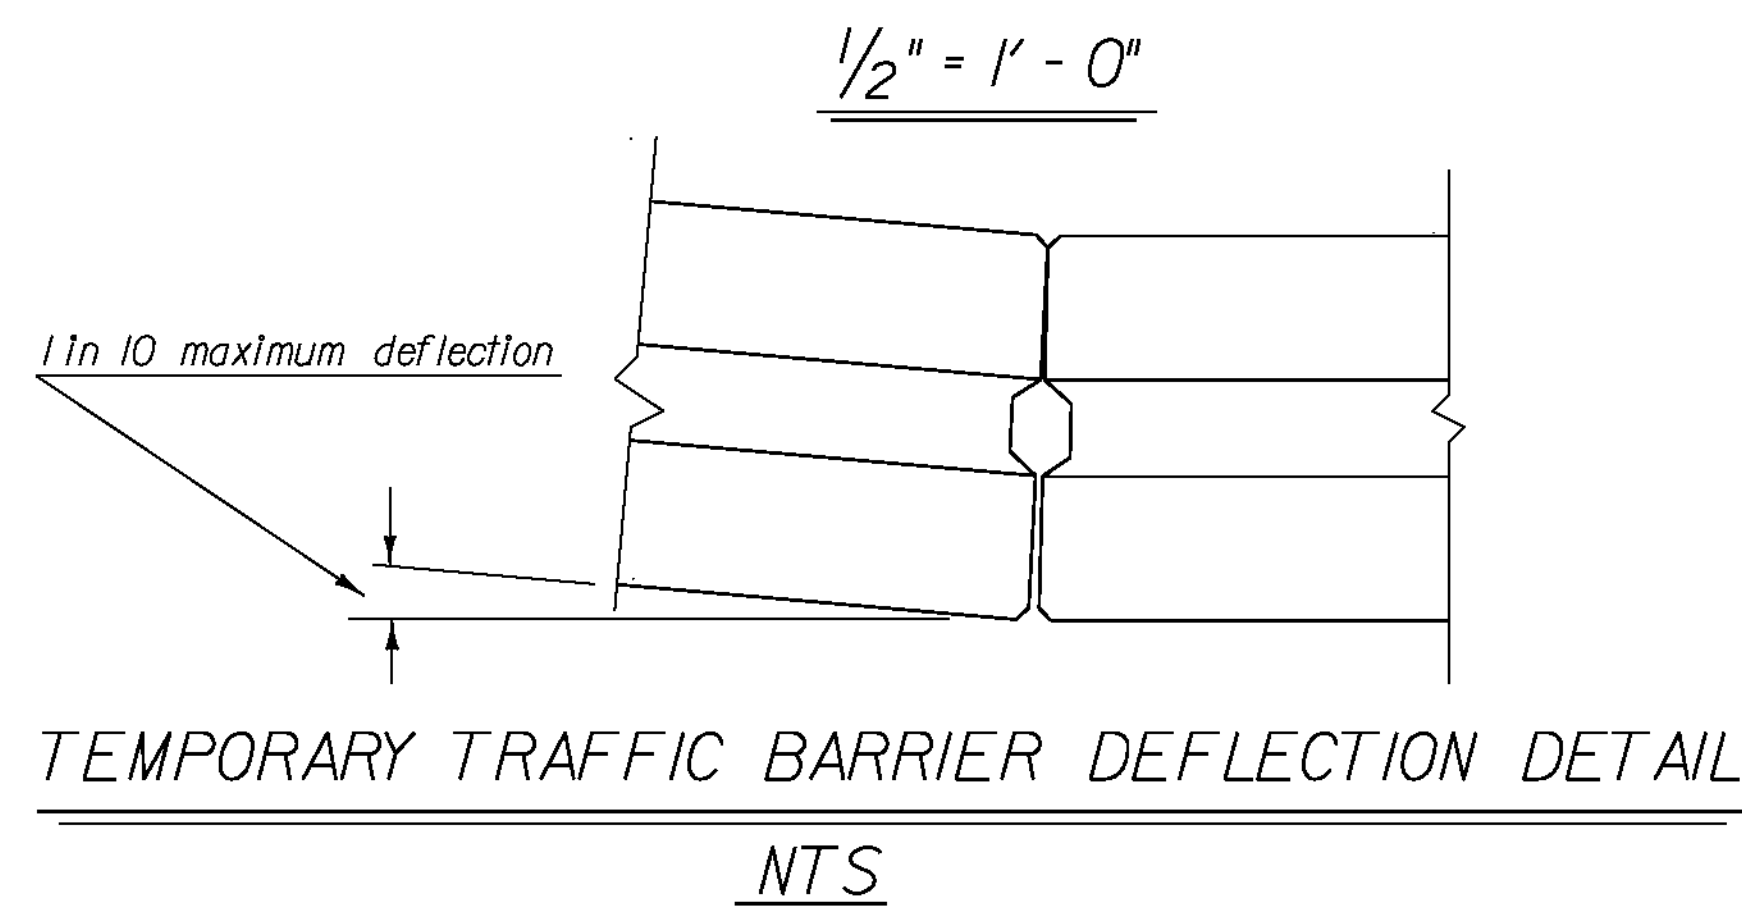


TEMPORARY TRAFFIC BARRIER DEFLECTION DETAIL

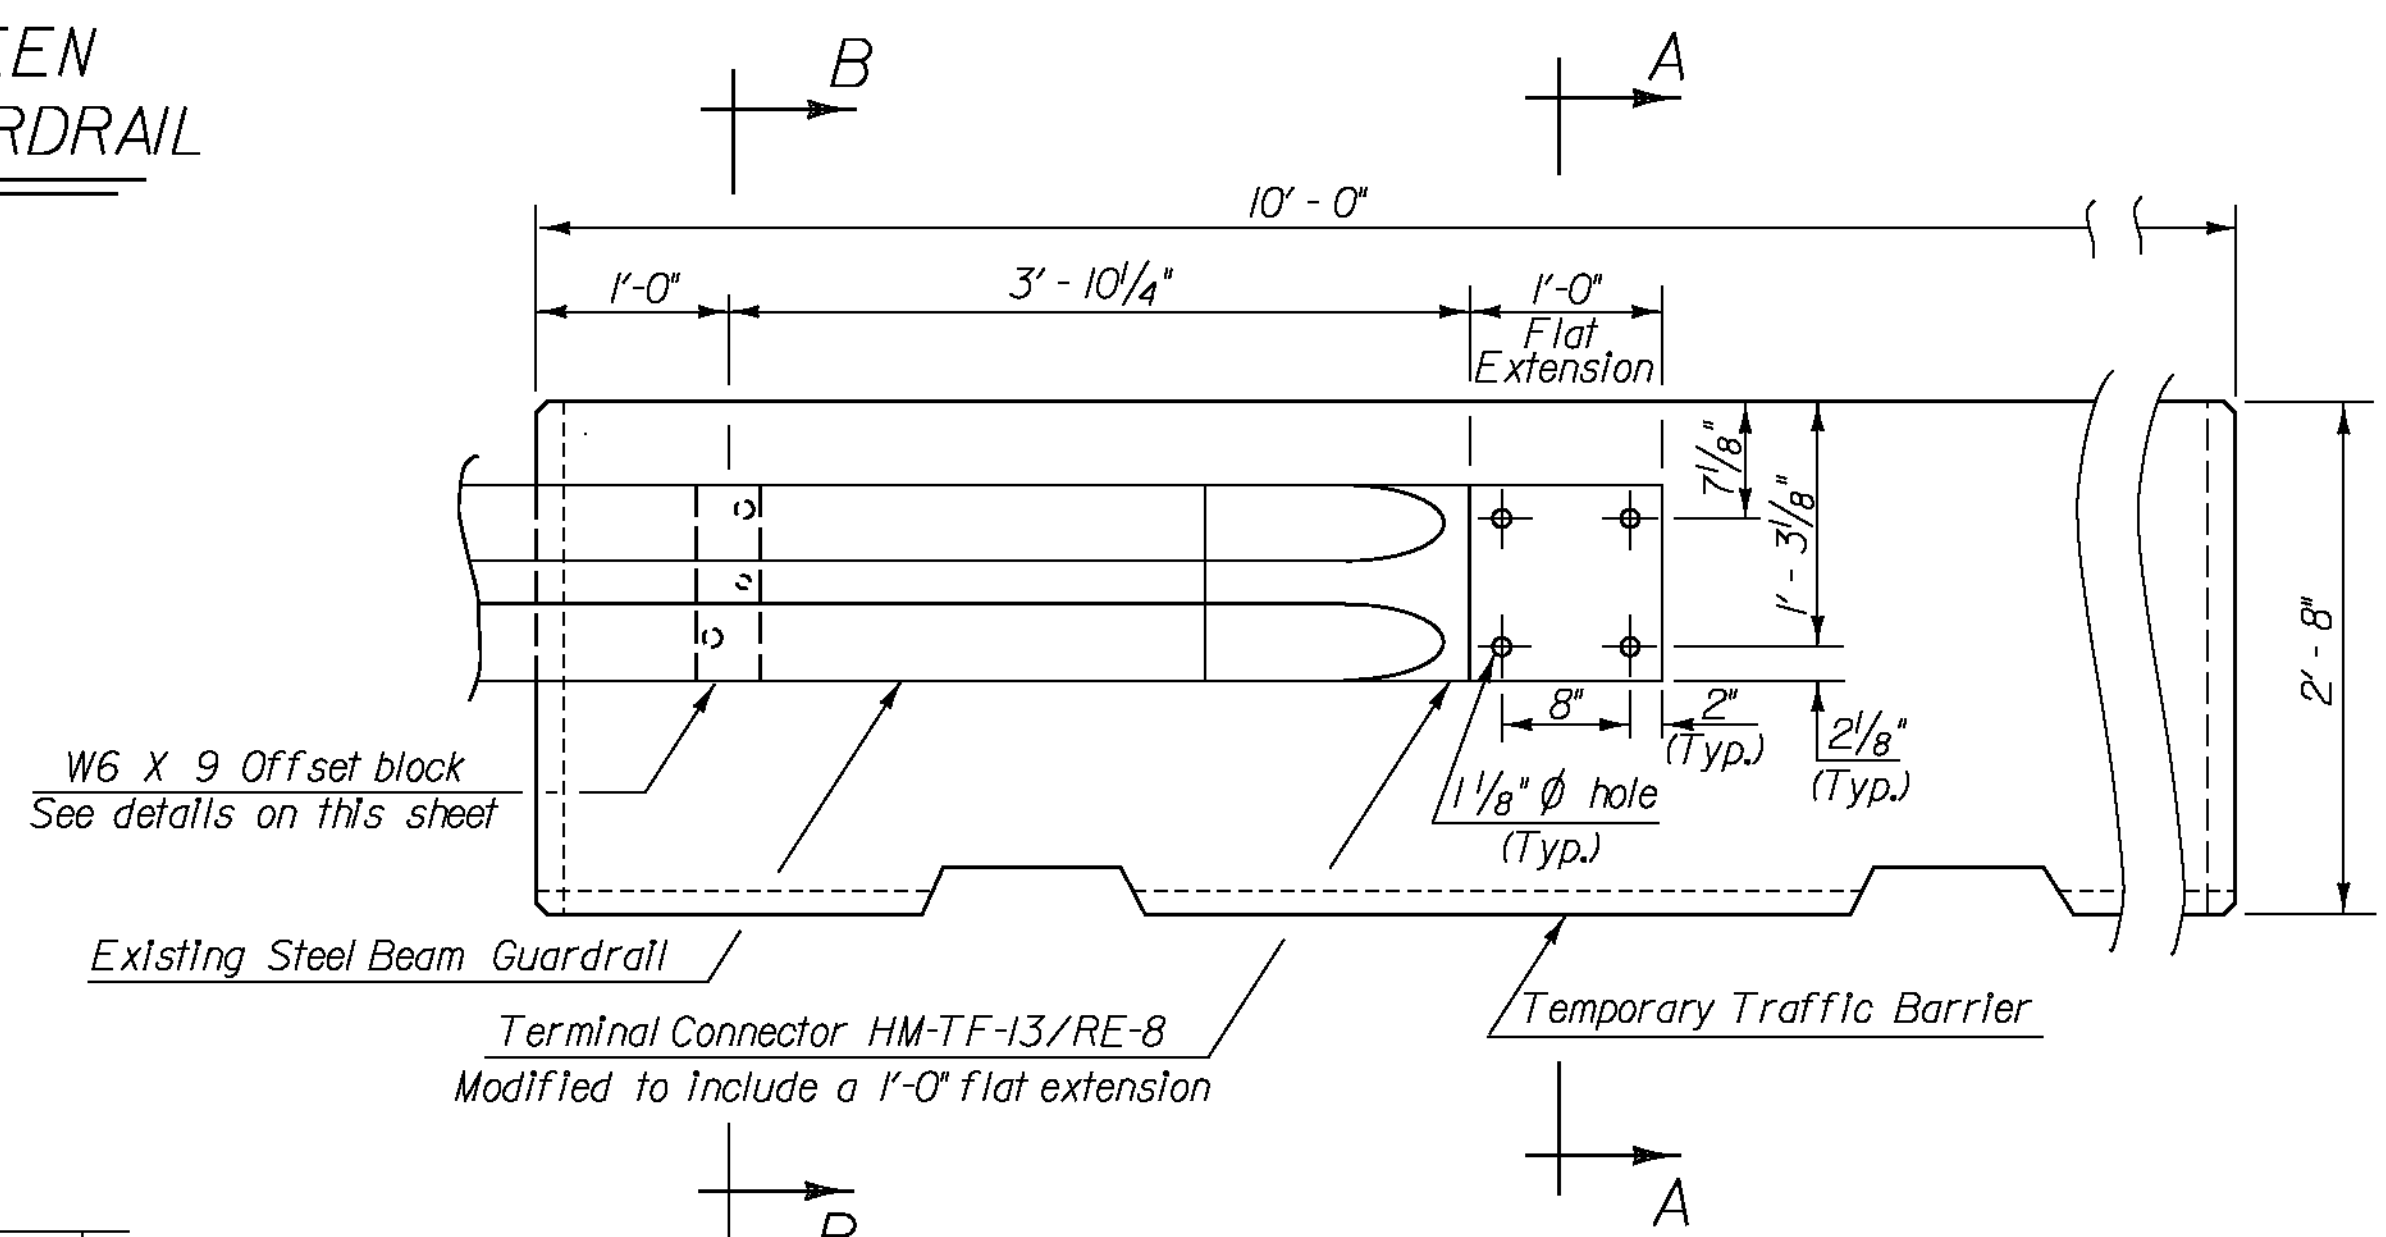


ELEVATION VIEW SHOWING POSITIVE CONNECTION BETWEEN TEMPORARY TRAFFIC BARRIER AND EXISTING GUARDRAIL

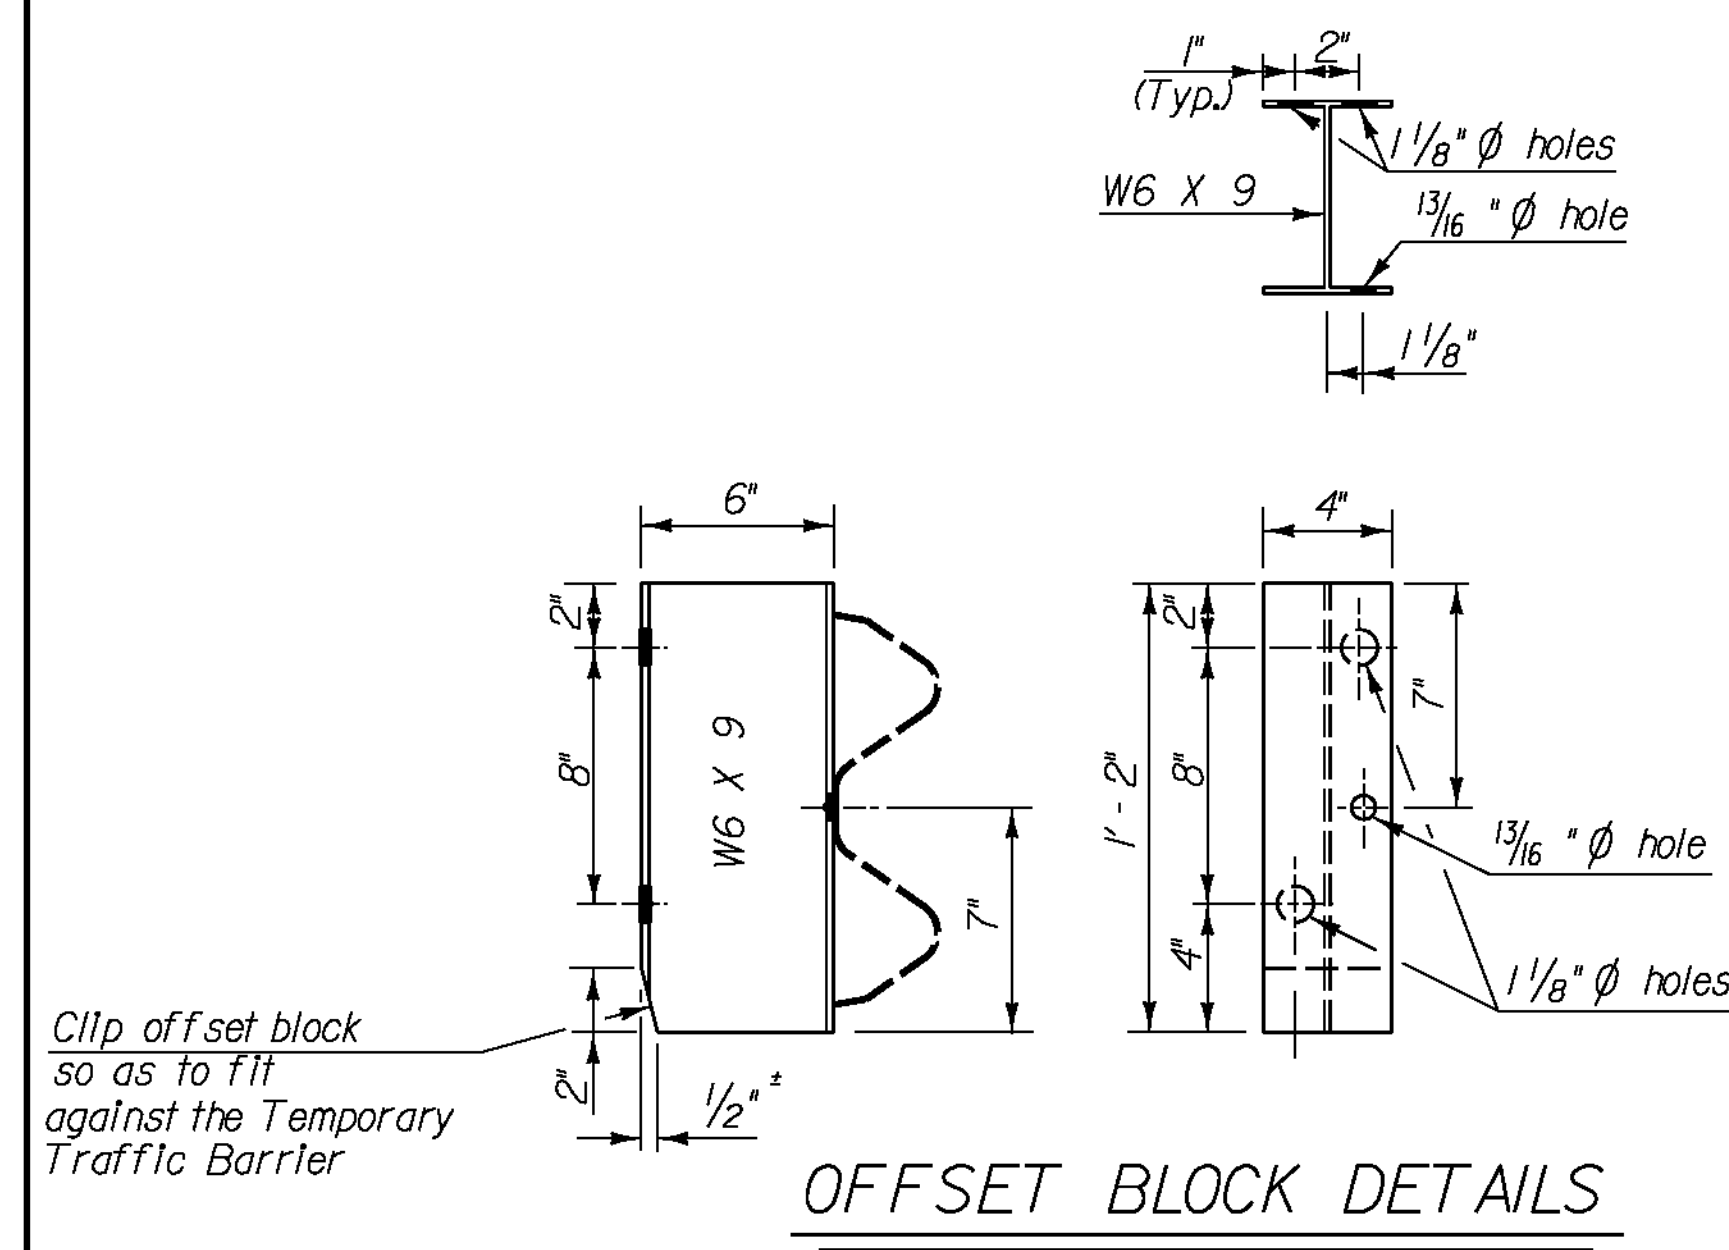


OFFSET BLOCK DETAILS

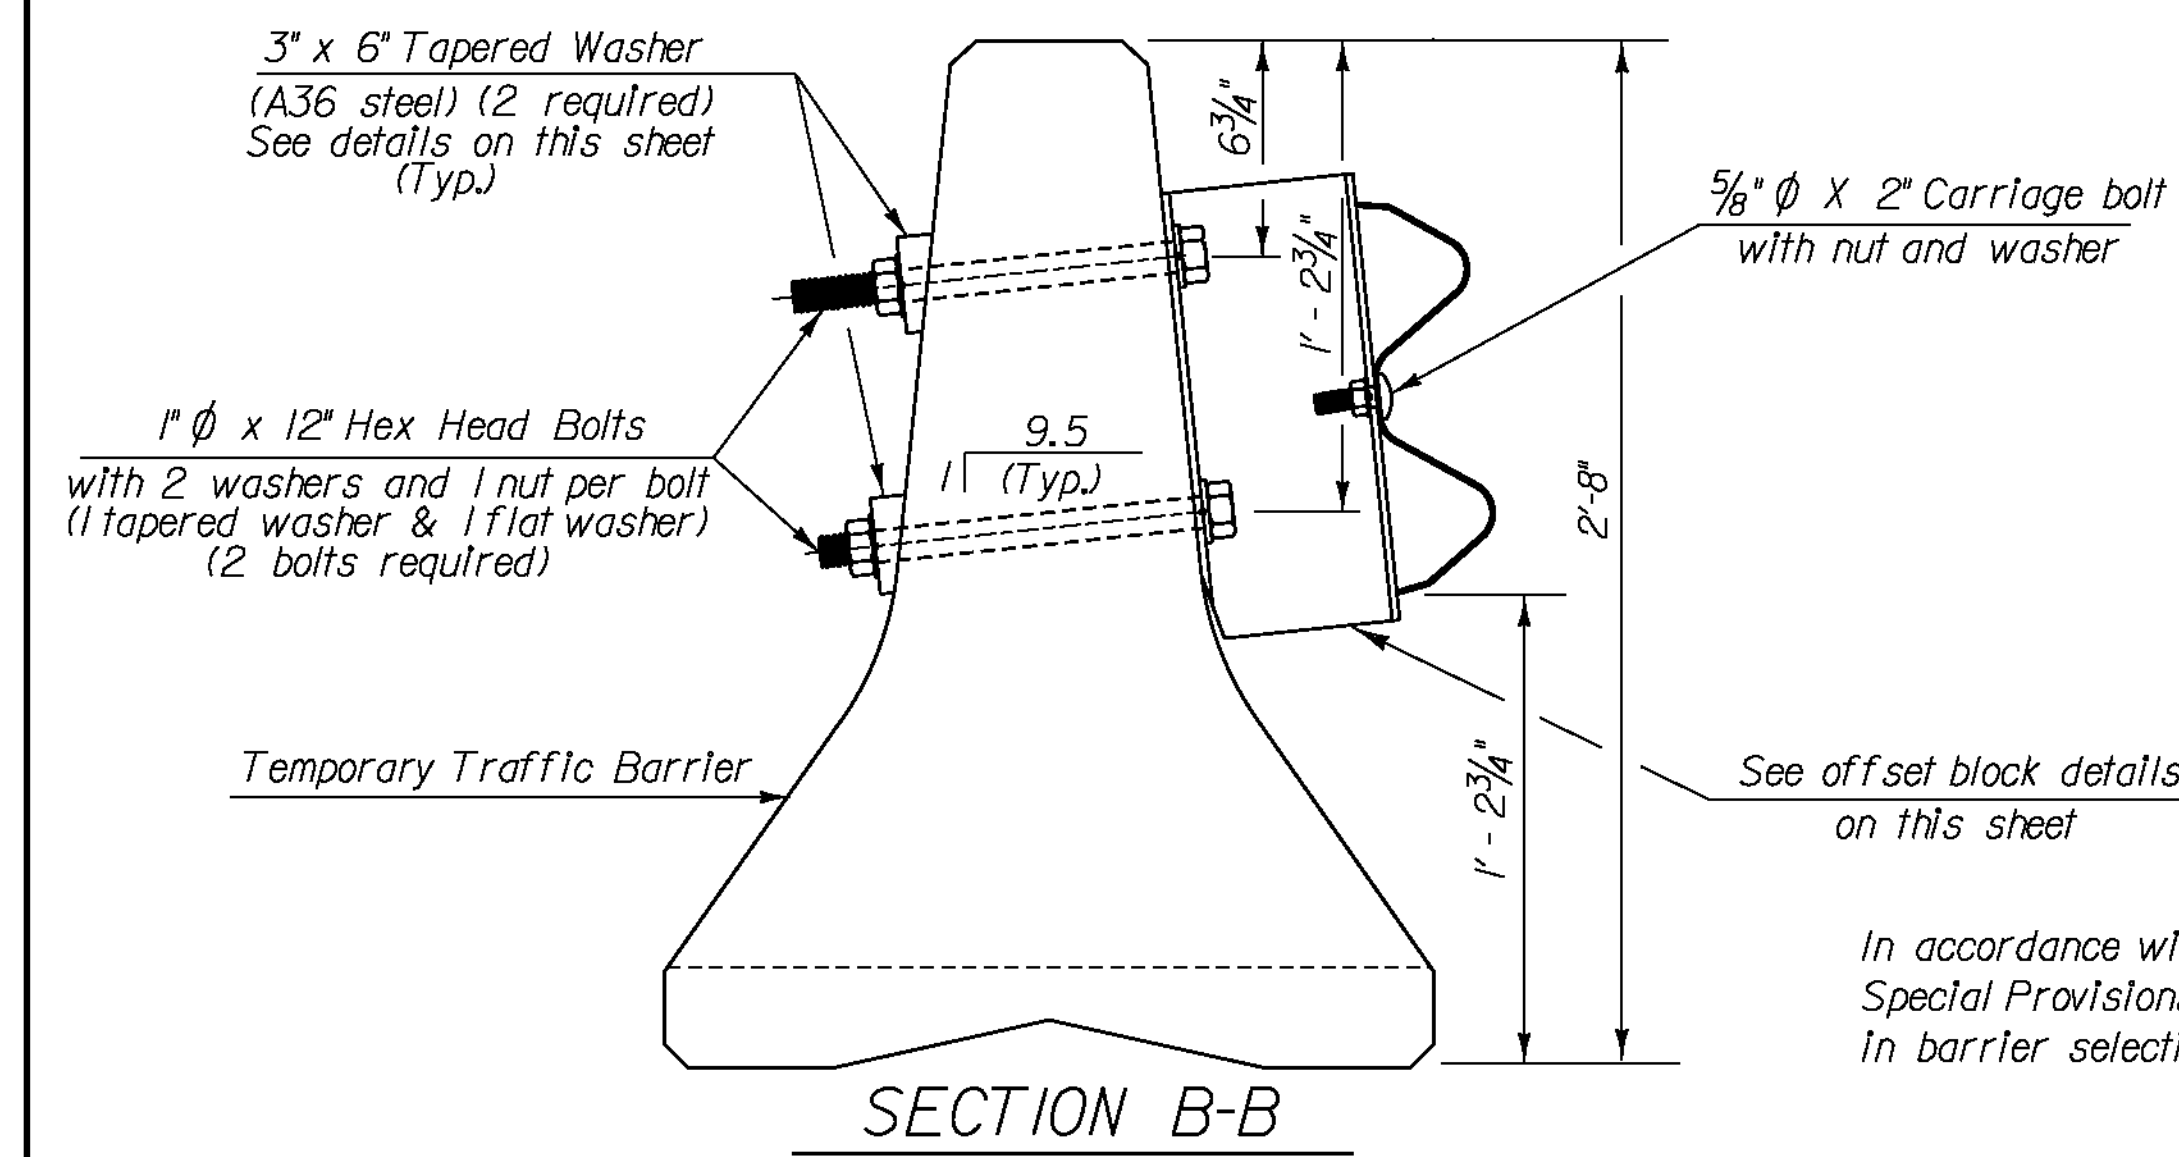

SECTION B-B


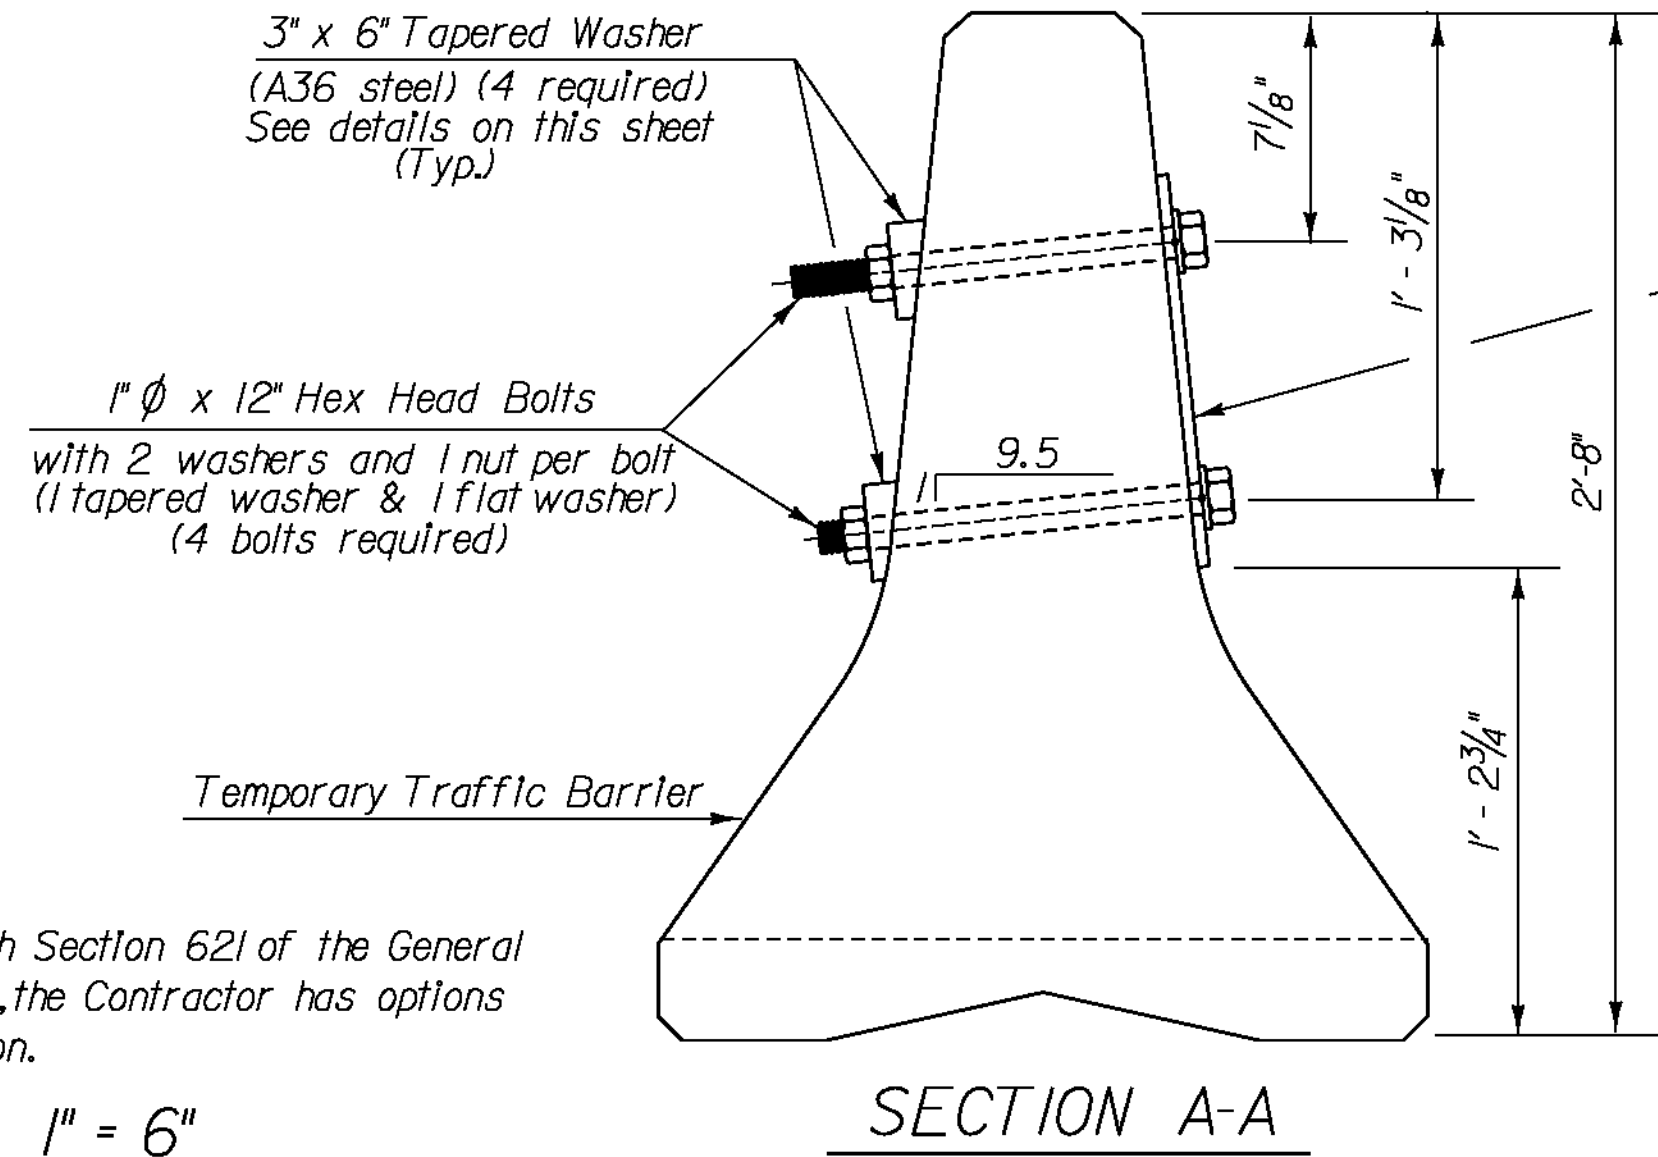


SECTION A-A


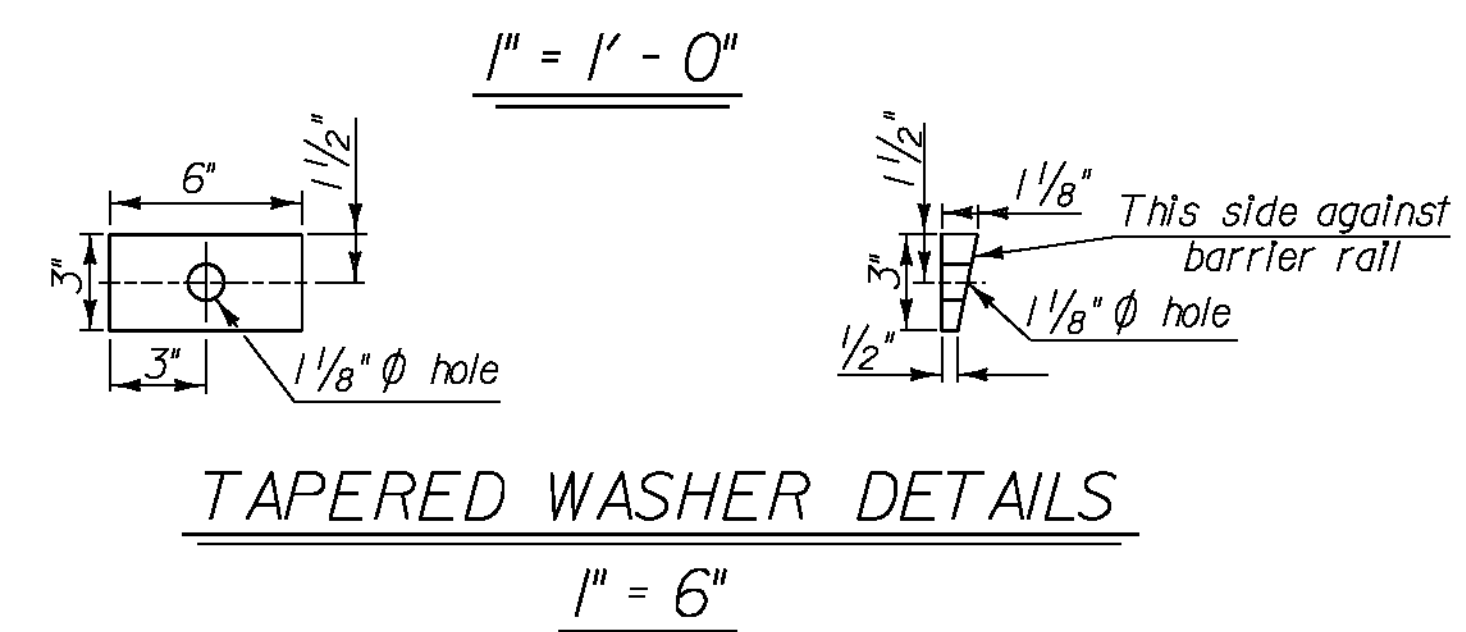


TAPERED WASHER DETAILS

PROJECT NAME: WATERFORD	PLOT DATE: 3/19/2012
PROJECT NUMBER: IM MEMB(31)	DRAWN BY: VTRANS
FILE NAME: s1a296r.dgn	CHECKED BY: VTRANS
PROJECT LEADER: JPB	SHEET 12 OF 48
DESIGNED BY: VTRANS	
BARRIER RAIL DETAILS	

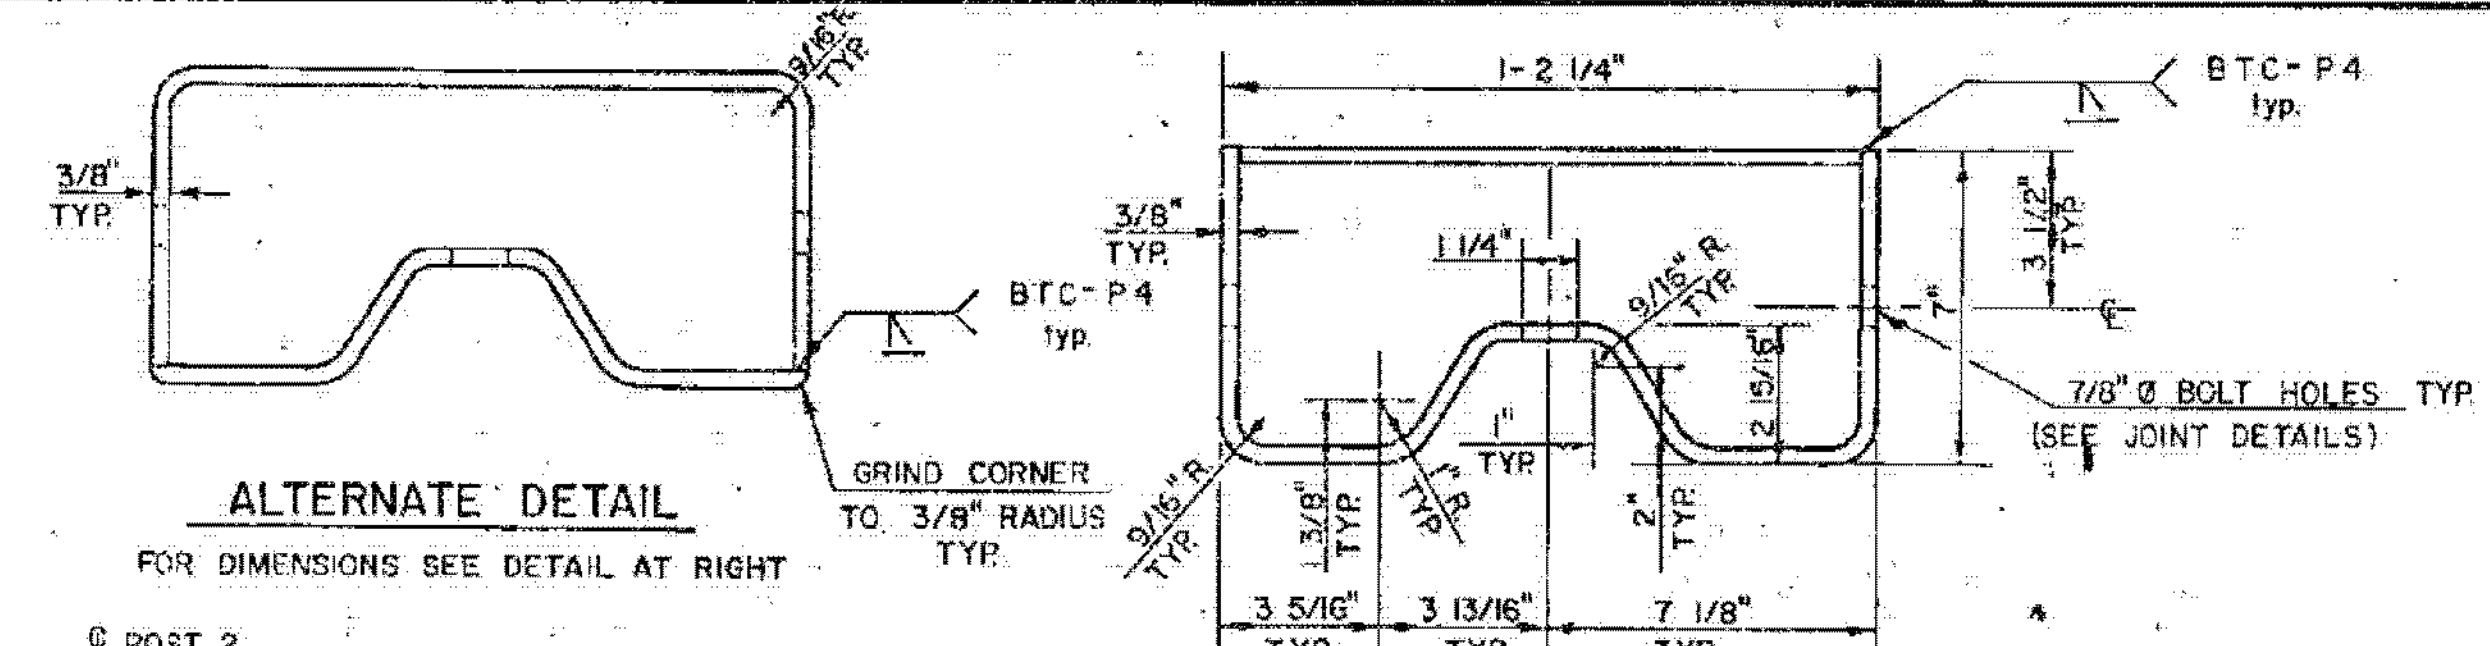
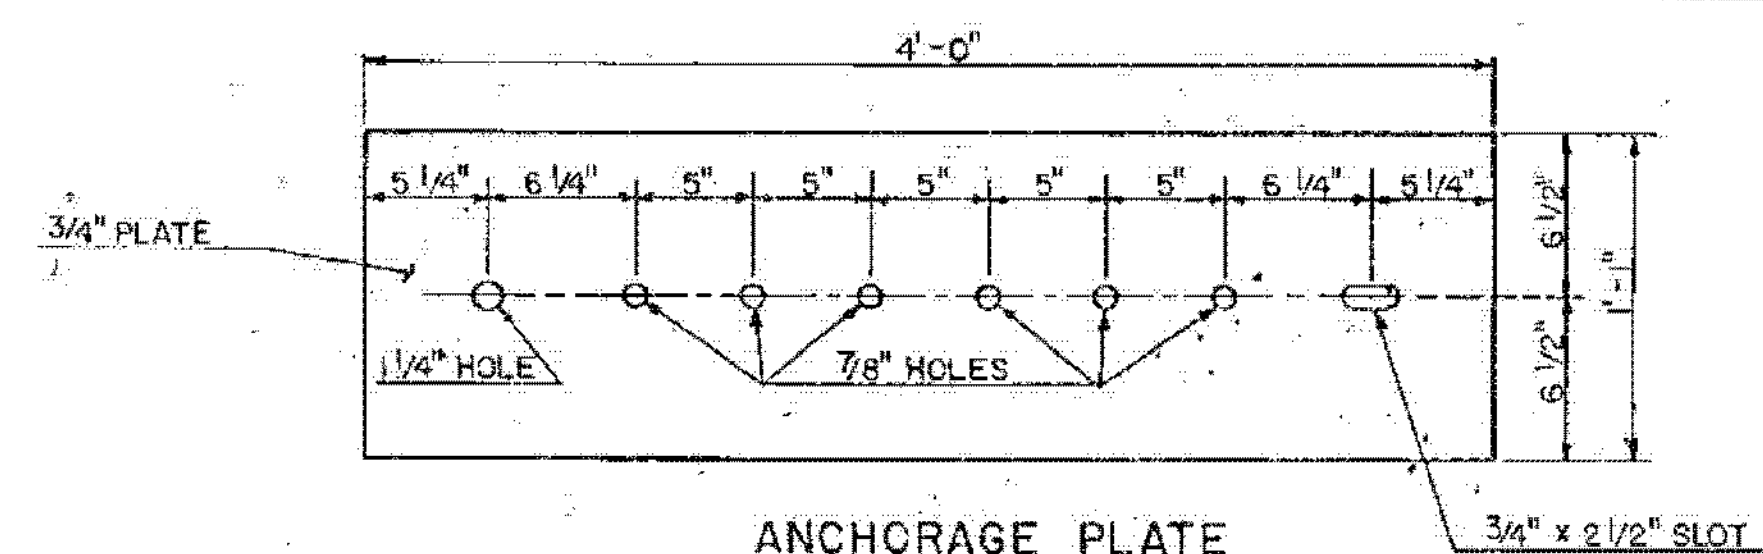


- NOTES**
1. REFER TO STANDARD G-1 FOR DETAILS OF APPROACH GUARD RAIL.
 2. APPROACH RAIL SPLICES SHALL LAP IN DIRECTION OF TRAFFIC FLOW.
 3. ANCHORAGE CONNECTOR AND ANCHORAGE PLATE SHALL BE ASTM A36 STEEL GALVANIZED TO ASTM A123 AFTER FABRICATION.
 4. REFER TO STANDARD SB-R4A-B2 FOR NOTES AND DETAILS OF BRIDGE RAILING.
 5. GUARD RAIL APPROACH SECTION-TYPE I & II SHALL INCLUDE ANCHORAGE PLATE, ANCHORAGE CONNECTOR, RAIL, POSTS, BLOCKS, AND ATTACHMENT HARDWARE.
 6. APPROACH RAILING SHALL BE HEAVY DUTY STEEL BEAM FOR 50'-0" FROM THE C. OF POST 1 FOR TYPE I AND 12'-6" FROM THE C. OF POST 1 FOR TYPE II.
 7. ALLOWABLE DIMENSIONAL TOLERANCE FOR BENT SECTIONS IS ±1/16 OF AN INCH.

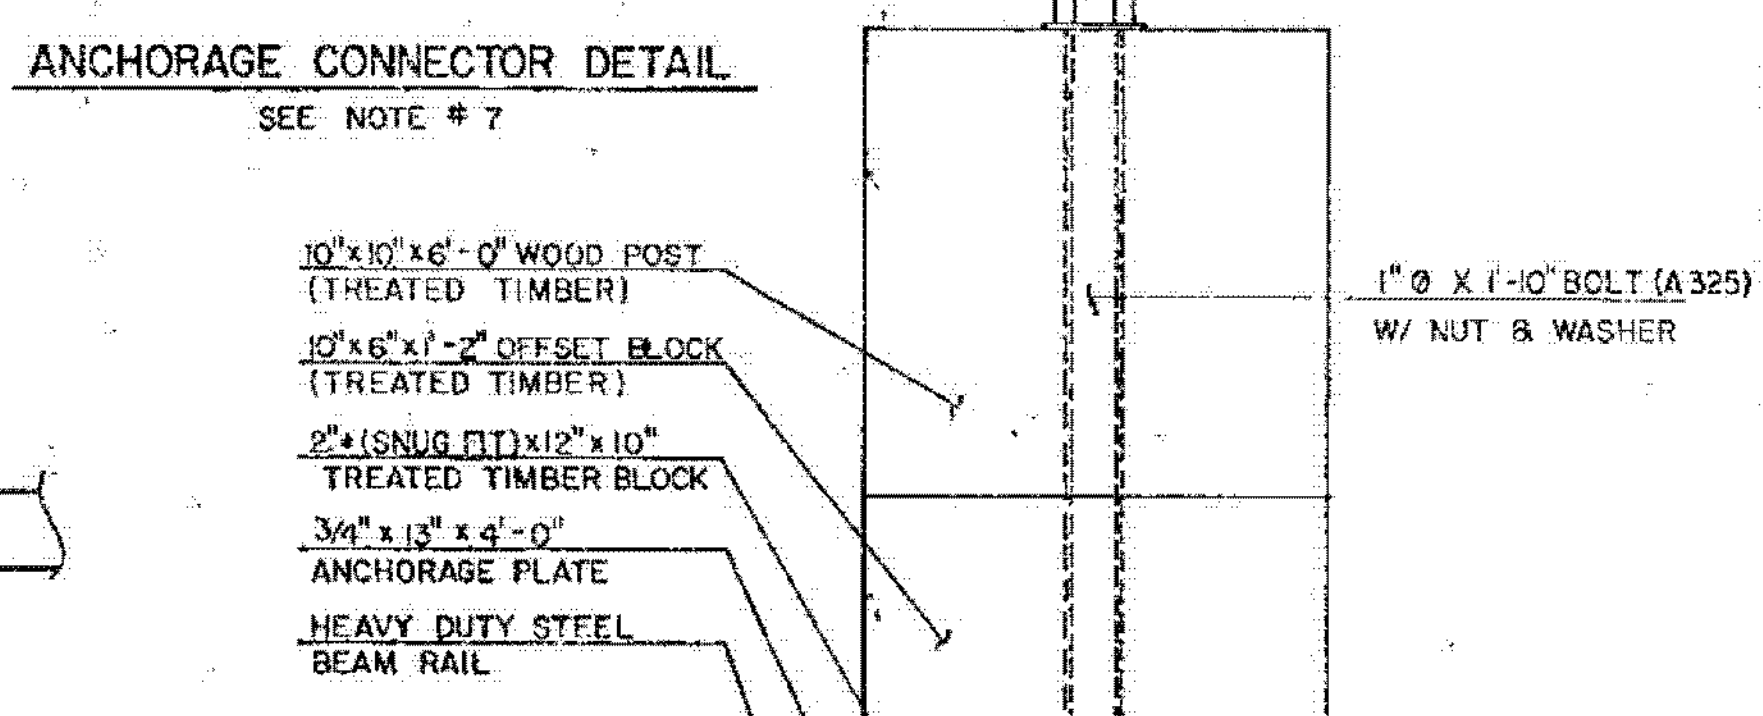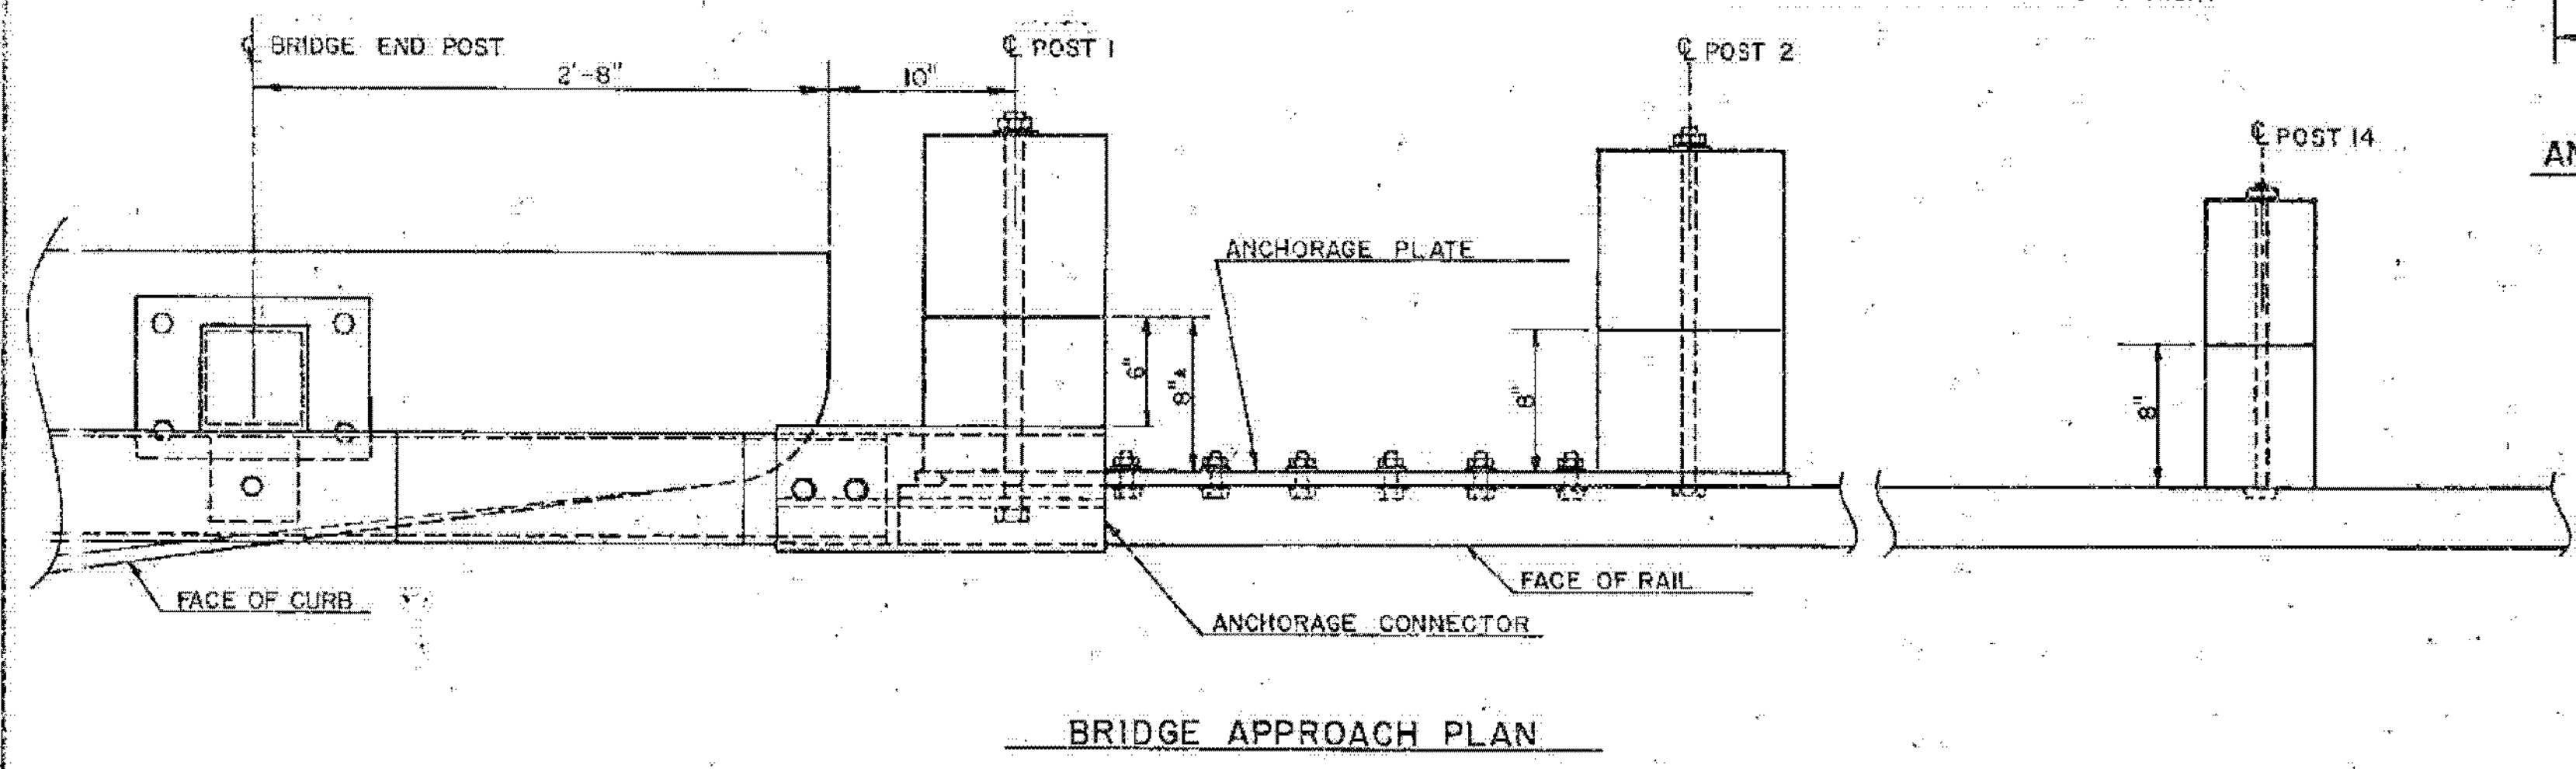

GUARD RAIL APPROACH SECTION TYPE I

POST NO.	POST SIZE	OFFSET BLOCK	SPACING
END POST			
1	10" x 10"	10" x 6"	3'-6"
2	10" x 10"	10" x 6"	3'-1 1/2"
3	10" x 10"	10" x 6"	3'-1 1/2"
4	10" x 10"	10" x 6"	3'-1 1/2"
5	8" x 8"	8" x 6"	3'-1 1/2"
6	8" x 8"	8" x 6"	3'-1 1/2"
7	8" x 8"	8" x 6"	3'-1 1/2"
8	8" x 8"	8" x 6"	3'-1 1/2"
9	6" x 8"	6" x 6"	3'-1 1/2"
10	6" x 8"	6" x 6"	4'-2"
11	6" x 8"	6" x 6"	4'-2"
12	6" x 8"	6" x 6"	4'-2"
13	6" x 8"	6" x 6"	6'-3"
14	6" x 8" (TYP)	6" x 6" (TYP)	6'-3" (TYP)

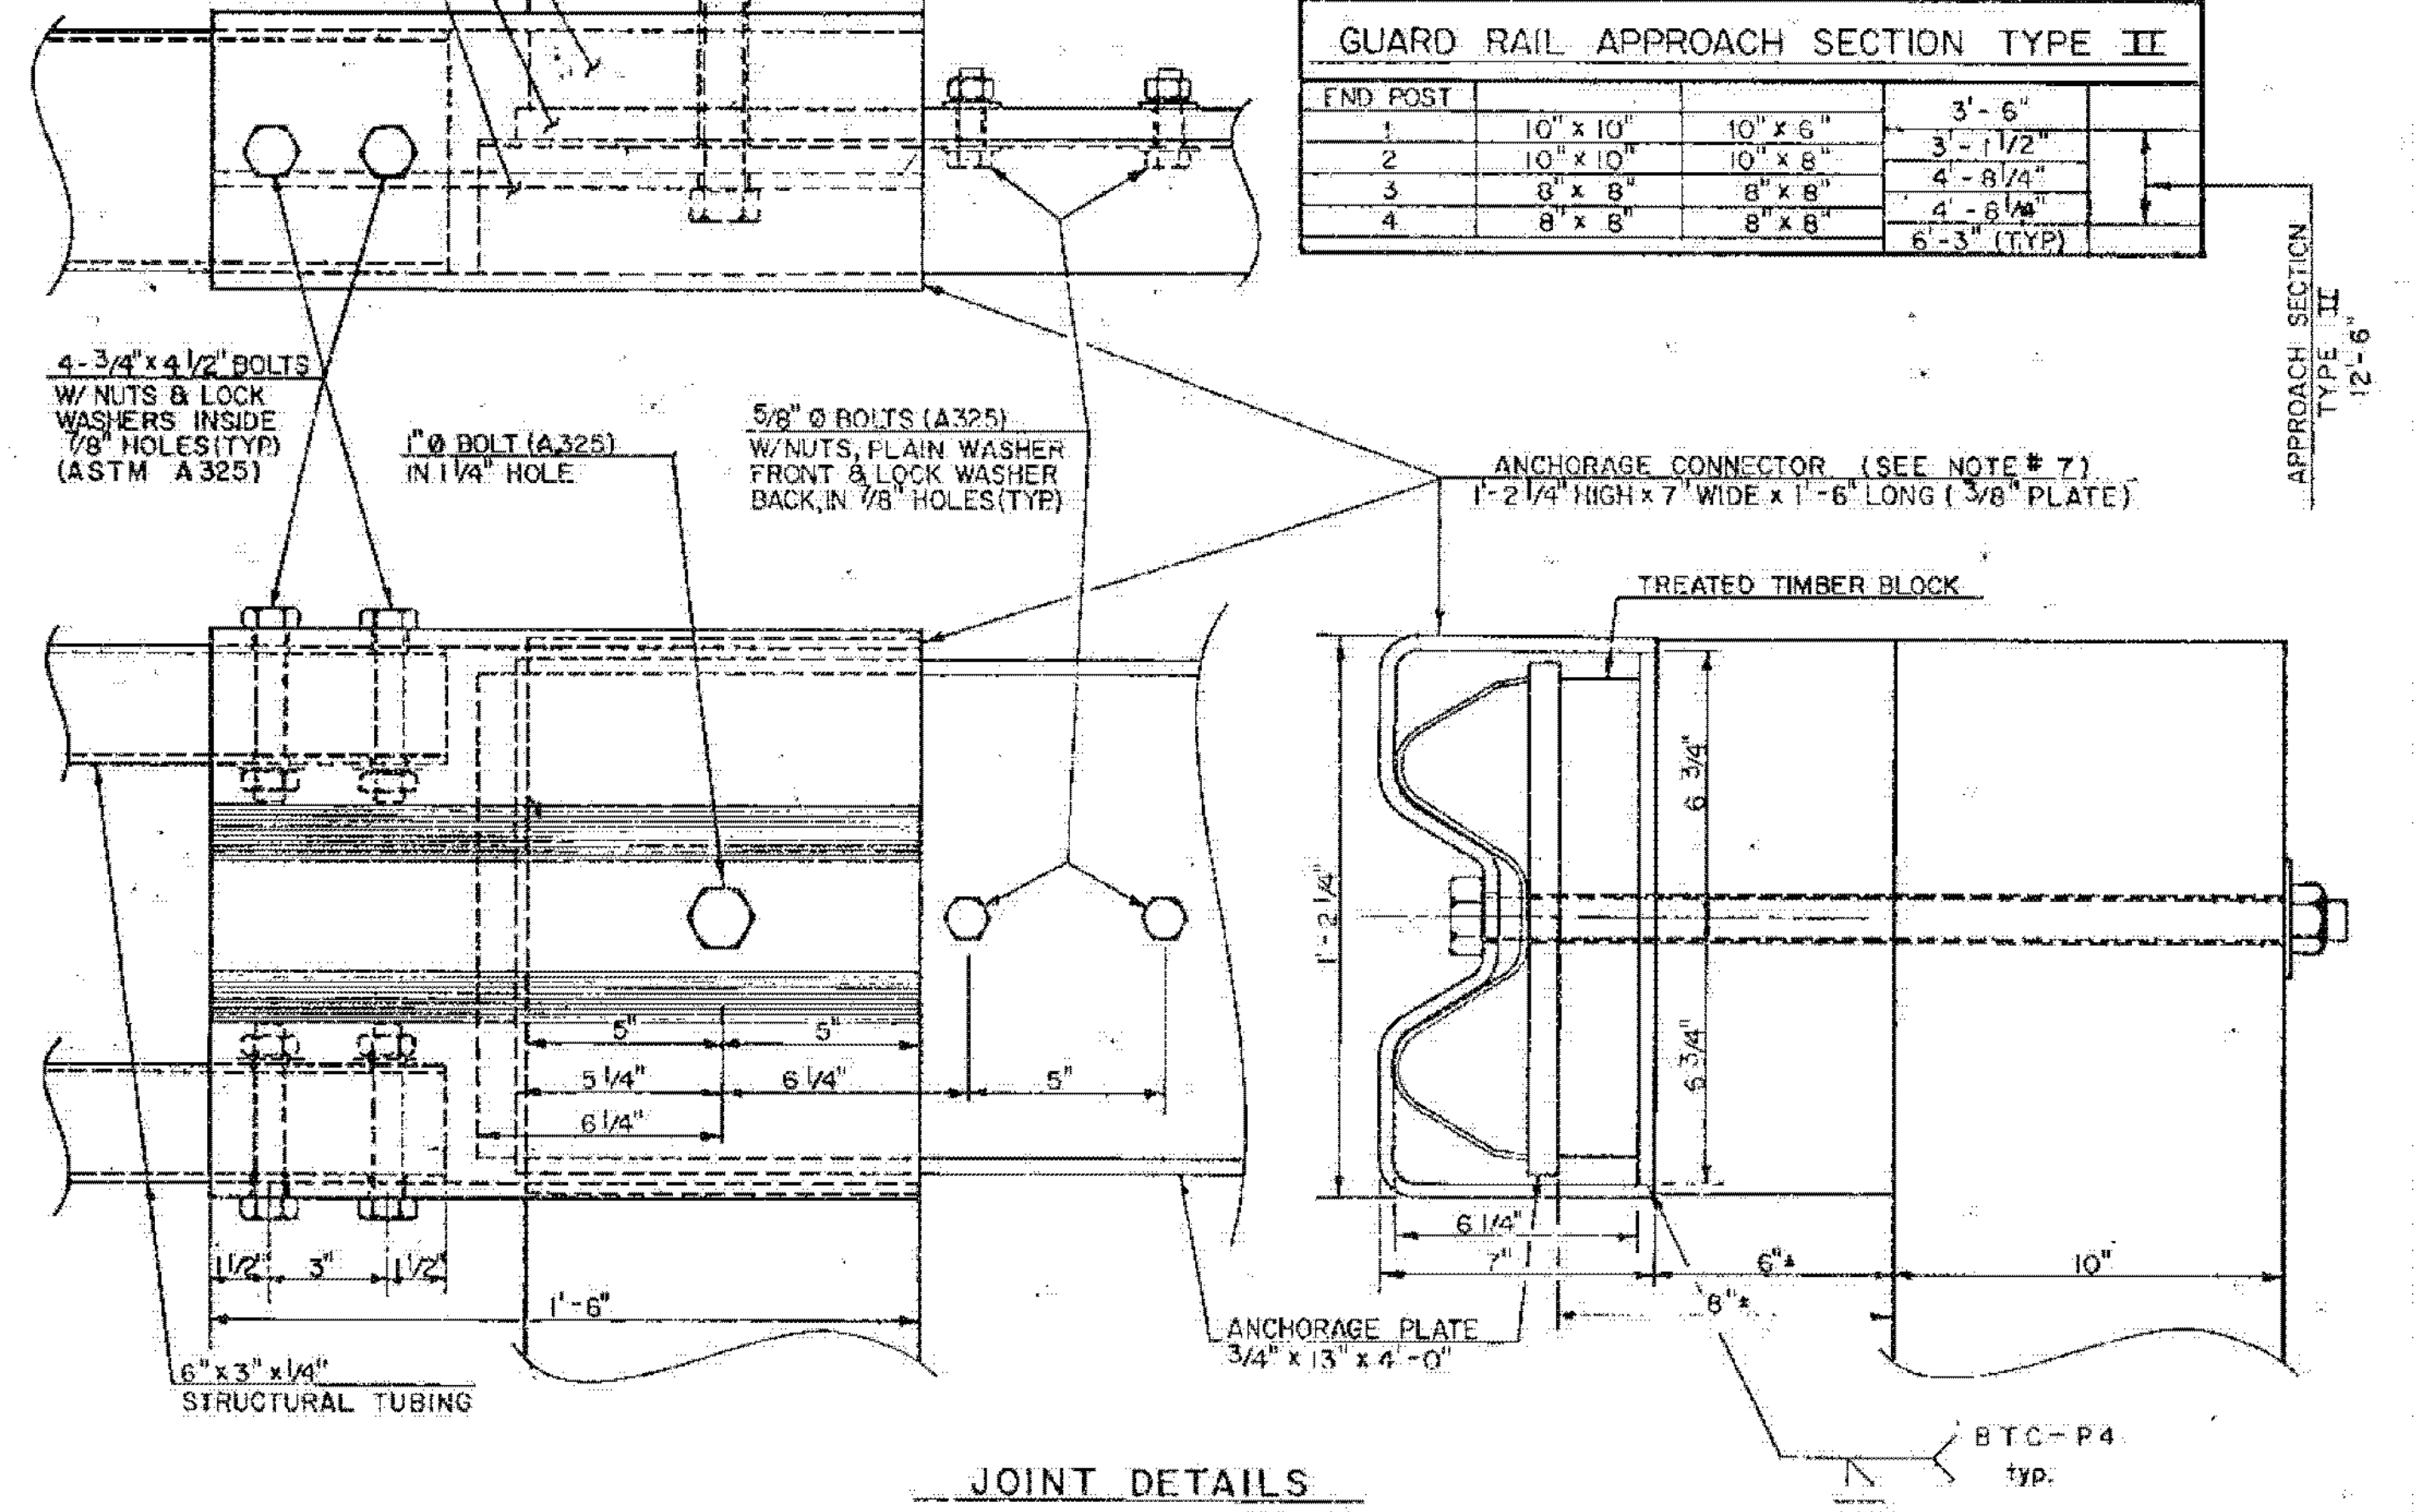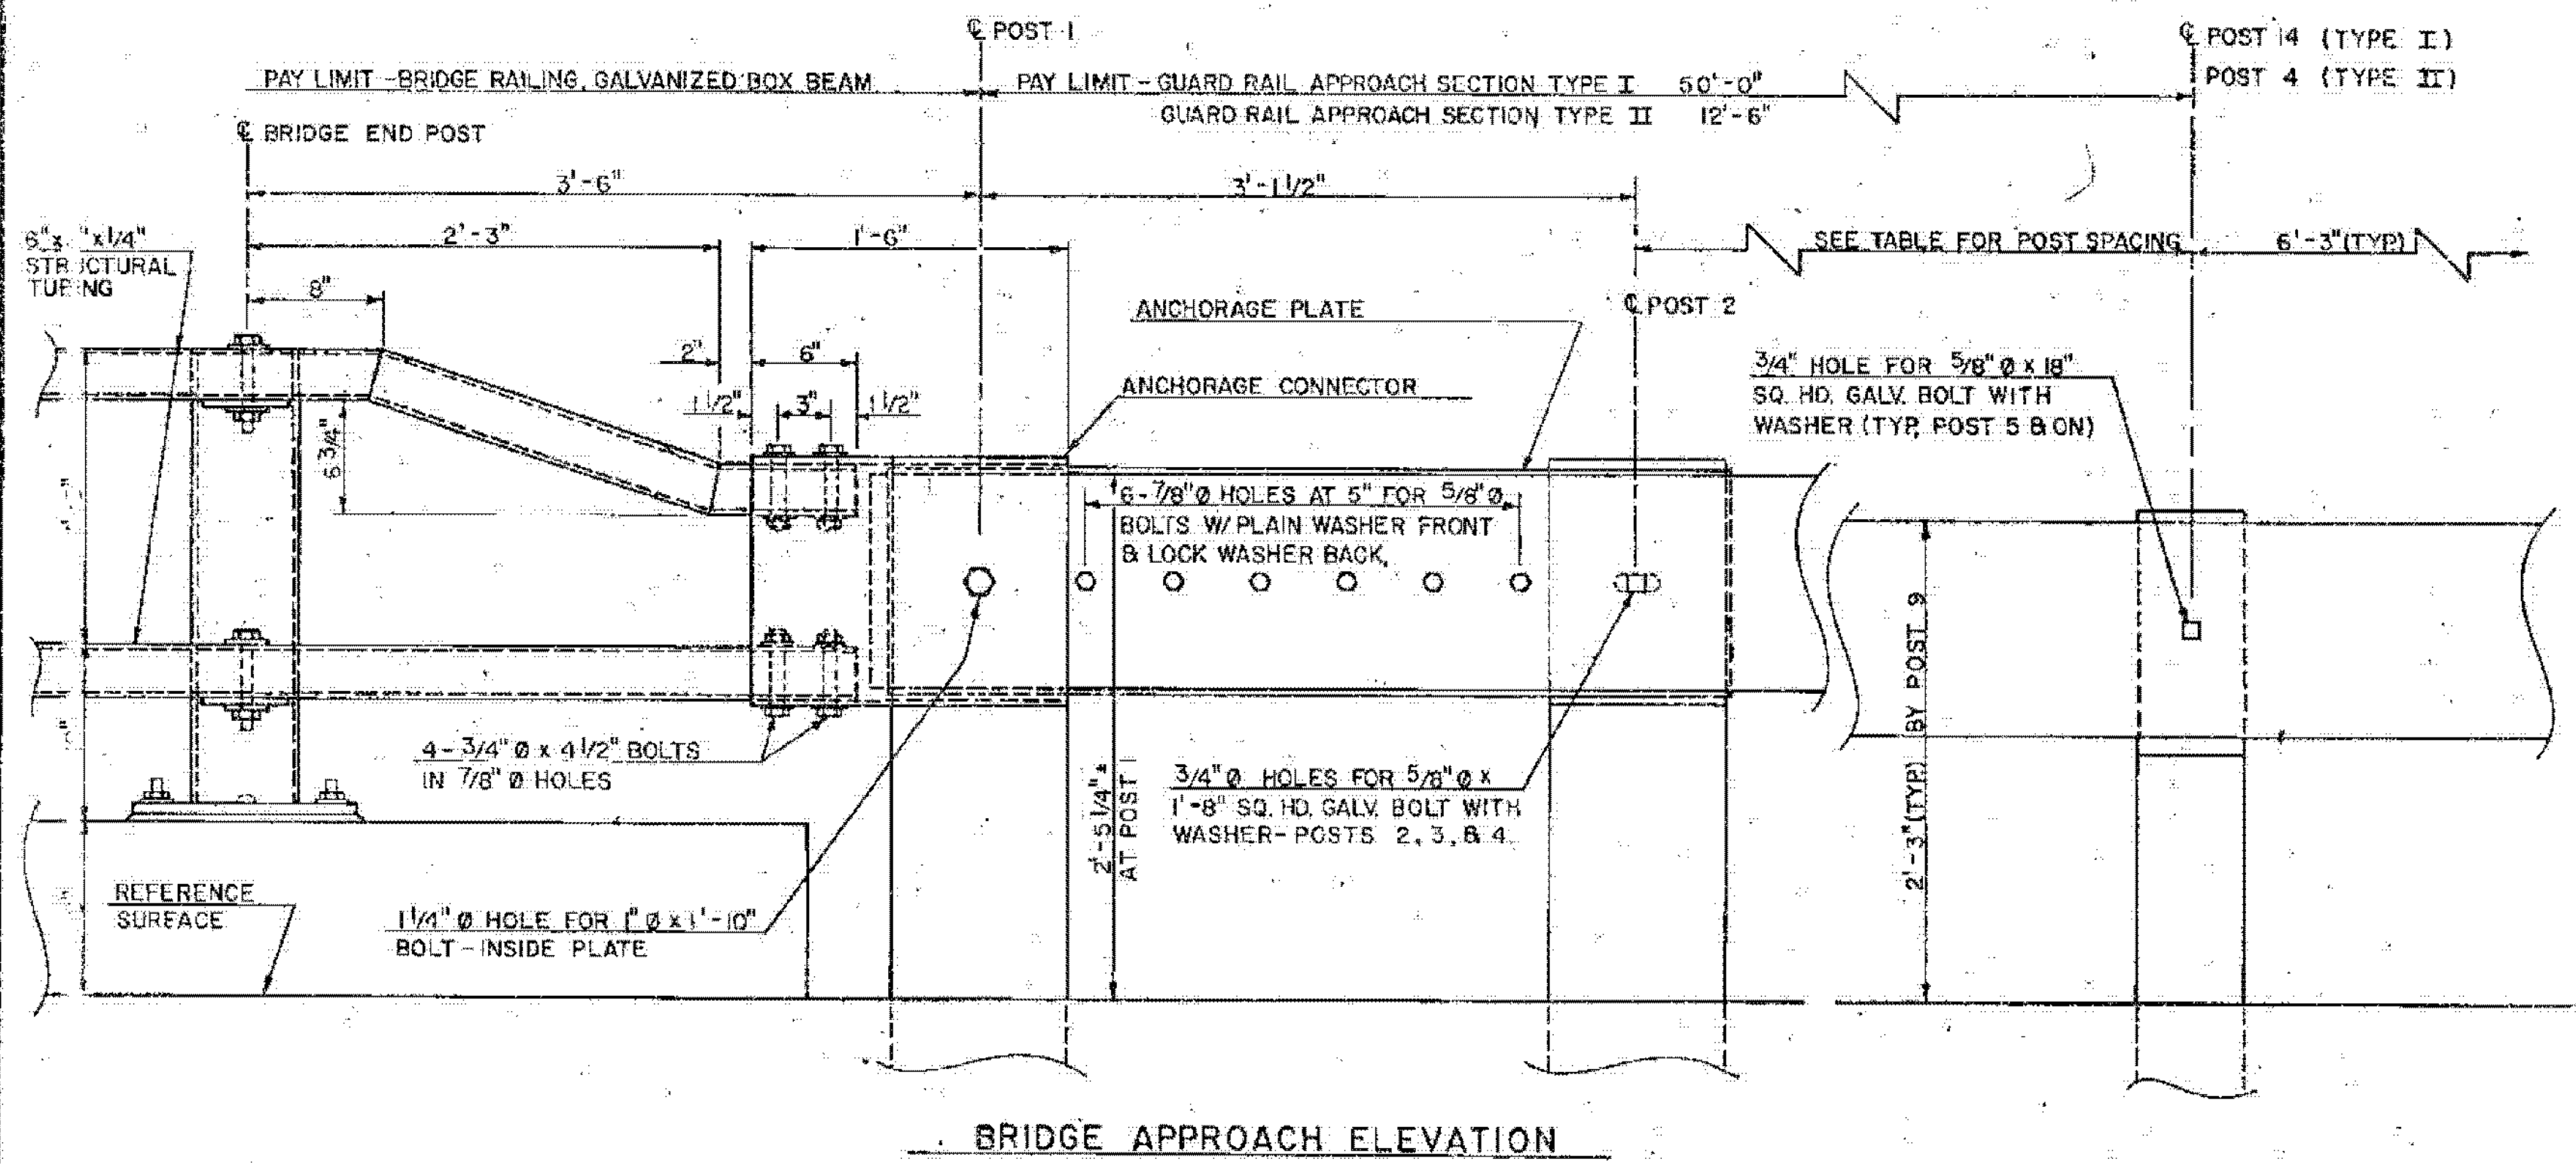

GUARD RAIL APPROACH SECTION TYPE II

END POST	POST SIZE	OFFSET BLOCK	SPACING
1	10" x 10"	10" x 6"	3'-6"
2	10" x 10"	10" x 6"	3'-1 1/2"
3	8" x 8"	8" x 6"	4'-6 1/4"
4	8" x 8"	8" x 6"	6'-3" (TYP)

REVISIONS AND CORRECTIONS

1. ADDED TYPE II APPROACH DETAILS, AND RE-USED ANCHORAGE CONNECTOR DETAILS. R. HAAPT 9/7/83
2. ADDED DIMENSION TO POST NO. 1. R.S.H. 12-13-84
3. CHANGED WELD DESIGNATION FOR ANCHORAGE CONNECTOR. K.B.M. 3-30-88.

APPROVED:

DECEMBER 28, 1981
DATE


Arthur J. Goss
CHIEF OF DESIGN

W.M. Smith
STRUCTURES ENGINEER



S.J. Gane
DIRECTOR OF ENGINEERING AND CONSTRUCTION

APPROVED FOR THIS PROJECT AND FOR DESIGN, FABRICATION AND FINAL APPROVAL TELEPHONE

GUARD RAIL APPROACH SECTION-TYPE I & TYPE II

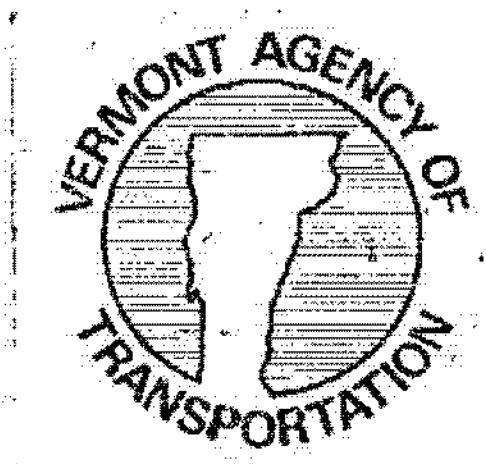

STANDARD SB-R4B-82

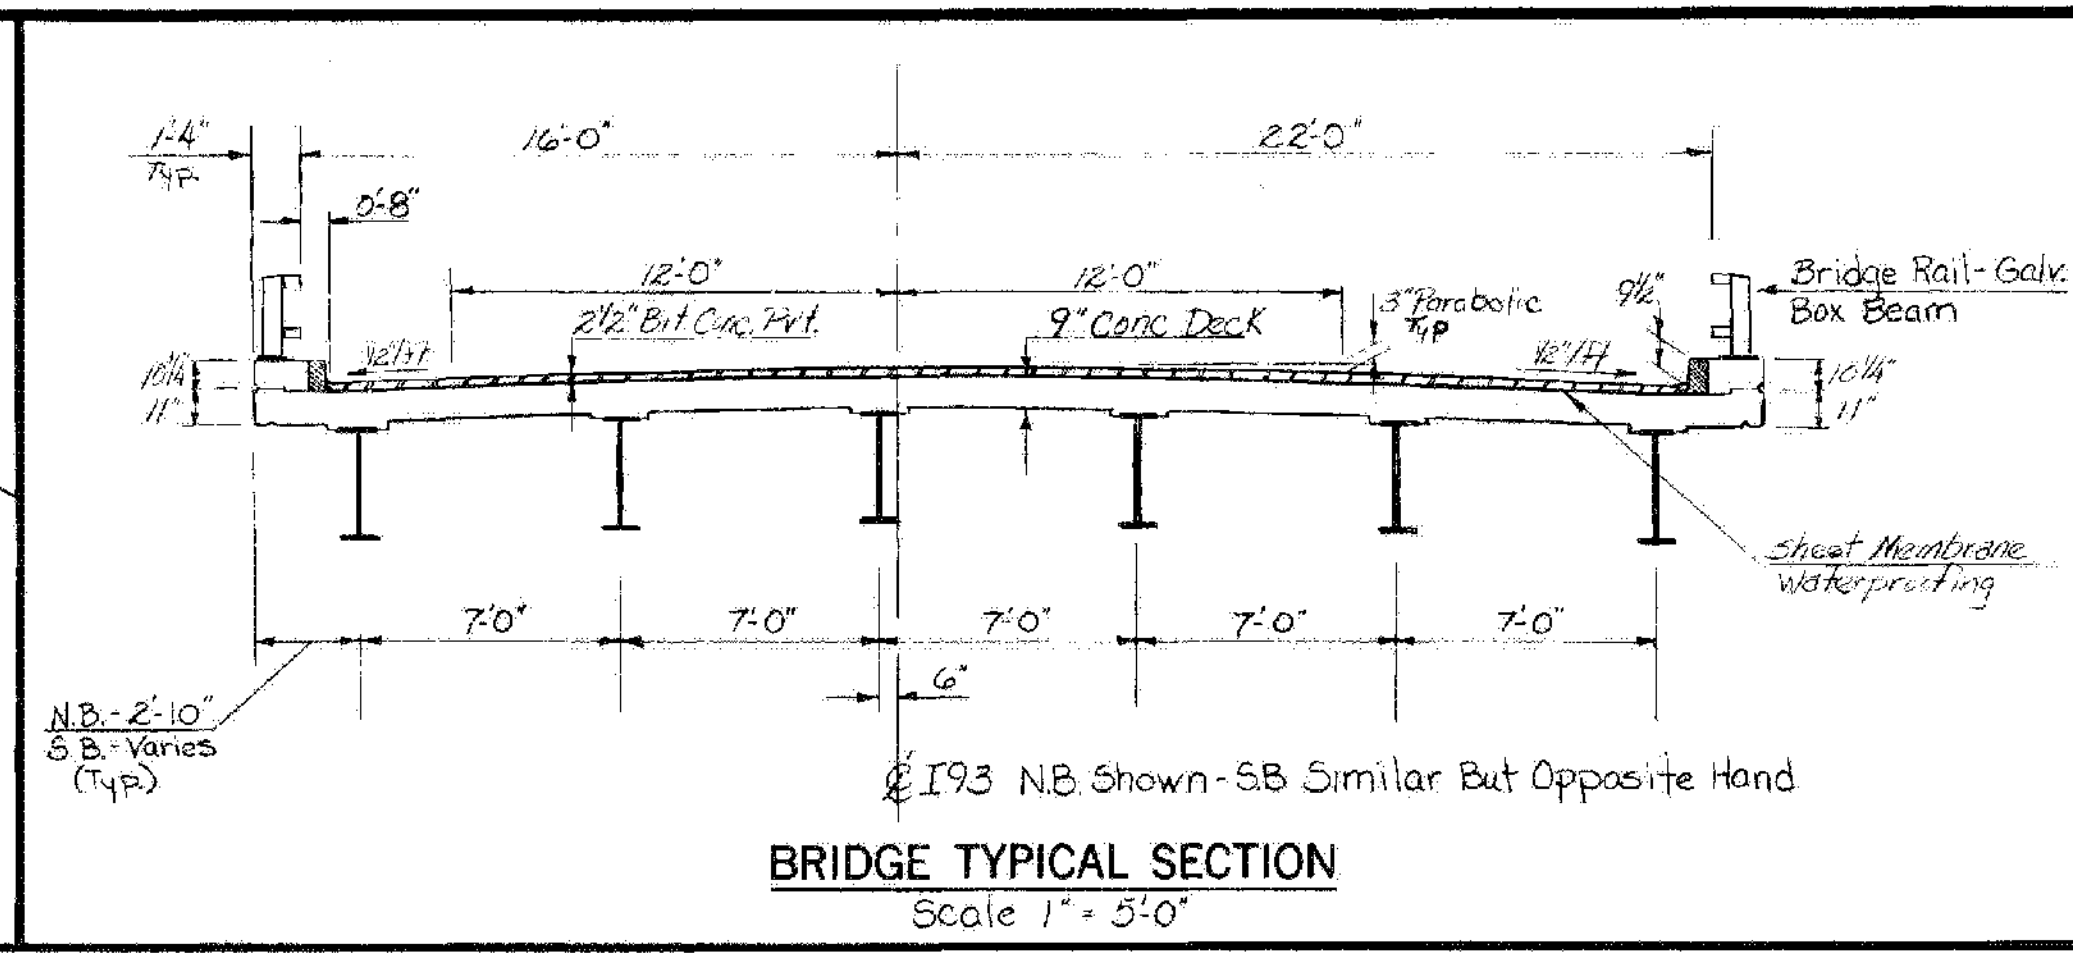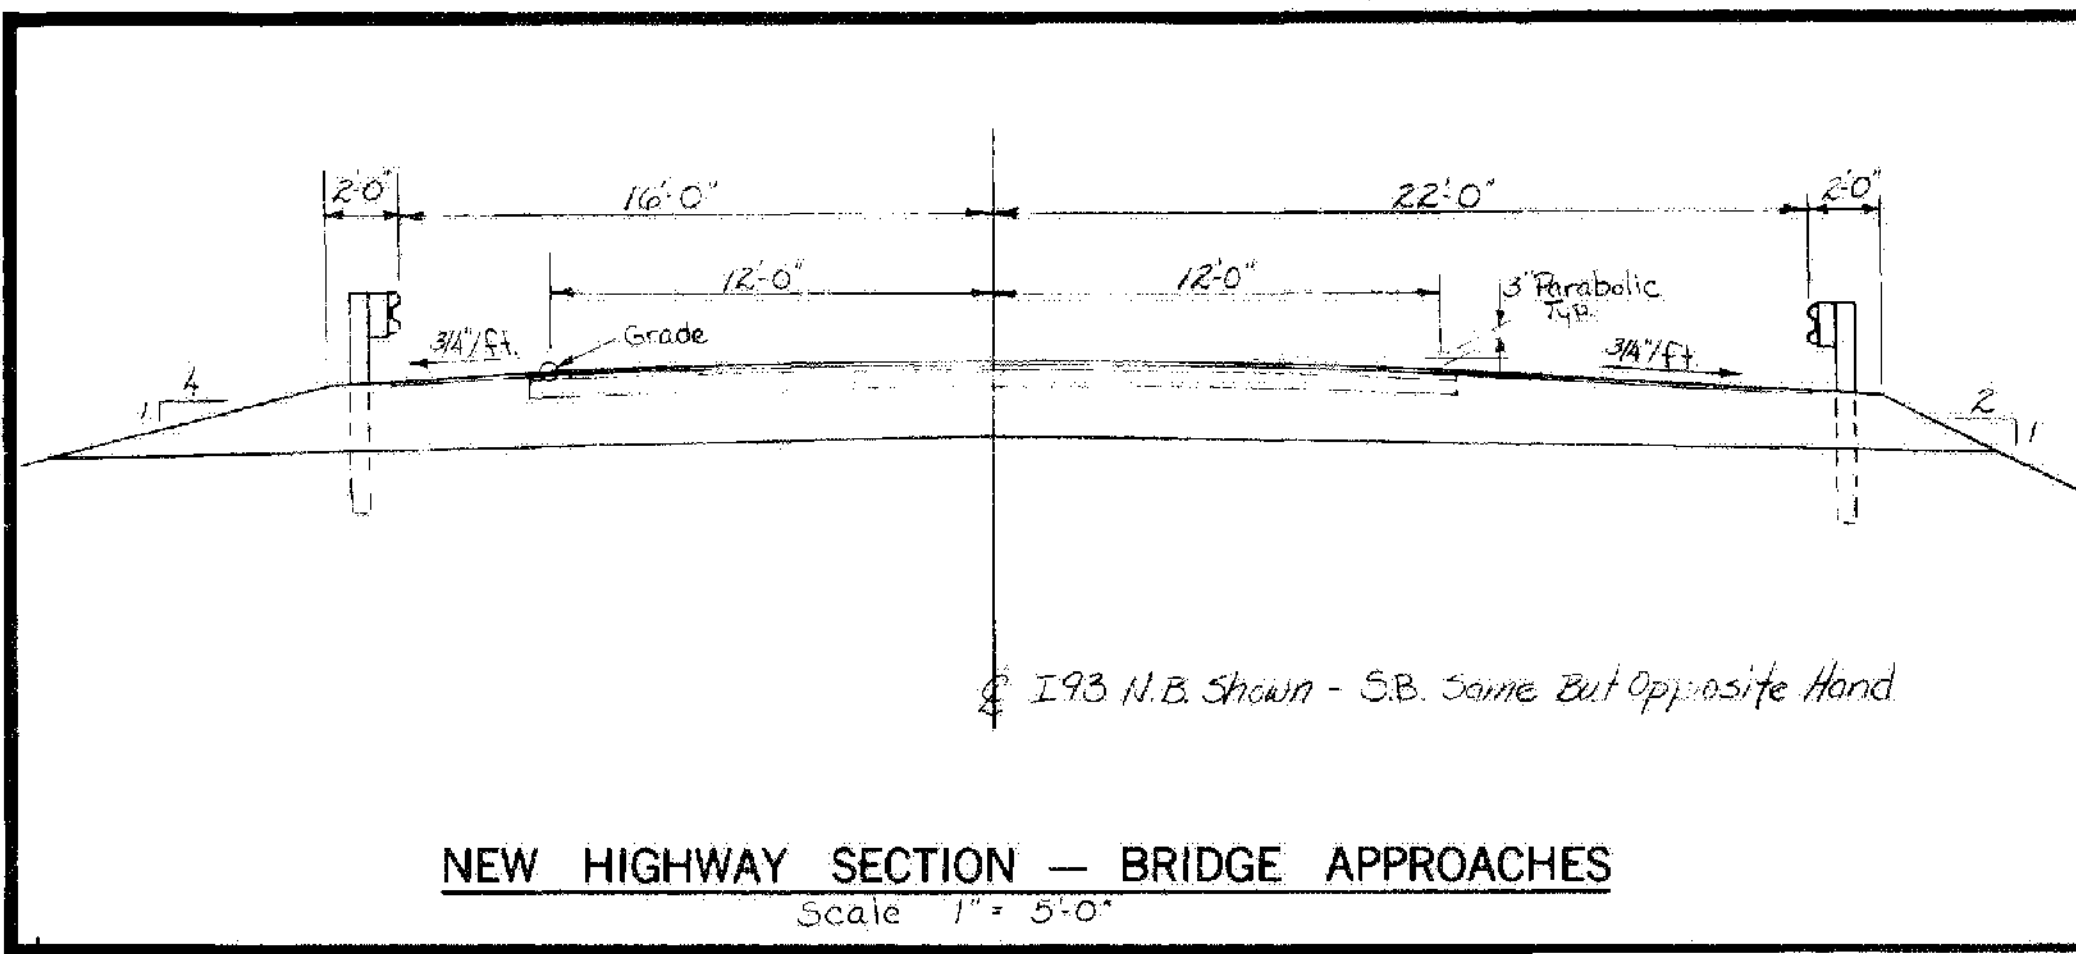


EXISTING STRUCTURE	
1. STRUCTURE TYPE	OVERALL LENGTH
2. SPAN LENGTH(S) CENTER TO CENTER OF BEARINGS	INVENTORY RATING
3. CLEAR SPAN LENGTH(S) NORMAL TO STREAM	VERTICAL CLEARANCE ABOVE STREAMBED
4. WATERWAY AREA OF FULL OPENING (NORMAL TO STREAM)	WATER SURFACE ELEVATION @ Q
5. WATER SURFACE ELEVATION @ Q 2.33	YEAR ESTIMATED DISCHARGE
6. WATER SURFACE ELEVATION AT FLOOR OF RECORD	IF NOT, AT WHAT FREQUENCY AND ELEVATION DOES RELIEF OCCUR?
7. DOES ALL WATER PASS THROUGH EXISTING STRUCTURE?	ADDITIONAL WATERWAY AREA PROVIDED BY RELIEF
8. TYPE OF SUBSTRUCTURE FOUNDATION MATERIAL	
9. DISPOSITION OF STRUCTURE	

NEW STRUCTURE	
STRUCTURE GEOMETRY:	OVERALL LENGTH
1. STRUCTURE TYPE	204' 11" NB, 170' 11" SB
2. SPAN LENGTH(S) CENTER TO CENTER OF BEARINGS	202' NB, 167' SB
3. VERTICAL CLEARANCE ABOVE STREAMBED OR ROAD UNDER	14'-3" MIN. NB, 16'-6" MIN. SB
4. CLEAR SPAN LENGTH(S) NORMAL TO STREAM	N.A.
5. WATERWAY AREA OF FULL OPENING (NORMAL TO STREAM)	N.A.
6. ARE PROVISIONS TO BE MADE FOR PUBLIC UTILITIES?	NO

HYDRAULIC DATA:		
1. Q 2.33	WATER ELEVATION	VELOCITY
Q 10	WATER ELEVATION	VELOCITY
Q 25	WATER ELEVATION	VELOCITY
Q 50	WATER ELEVATION	VELOCITY
Q 100	WATER ELEVATION	VELOCITY
2. DRAINAGE AREA	CHARACTER OF TERRAIN	
3. ARE THERE OBJECTIONS TO A PIER IN THE STREAM?	IS ORDINARY RISE RAPID?	
4. DOES STREAM REACH ITS MAXIMUM HIGH WATER ELEVATION RAPIDLY?		
5. NATURE OF NATURAL STREAMBED	COMMENT ON: DRIFT	ICE
6. ESTIMATED SCOUR DEPTH		
7. WILL ALL WATER PASS THROUGH NEW STRUCTURE?	IF NOT, WHAT FREQUENCY AND ELEVATION WILL RELIEF OCCUR?	
8. ADDITIONAL WATERWAY AREA PROVIDED BY RELIEF		
9. VERTICAL CLEARANCE ABOVE Q	LIMITED BY	
10. ALLOWABLE WATER SURFACE ELEVATION	IF YES, DESCRIBE	DEPTH
11. IS DESIGN STAGE AFFECTED BY UPSTREAM OR DOWNSTREAM CONDITIONS?	AVERAGE DAILY HIGH FLOW	DEPTH
12. STREAMBANK OR CHANNEL PROTECTION REQUIRED		
13. DISTANCE TO EXISTING UPSTREAM STRUCTURE	SPAN	WATERWAY AREA OF FULL OPENING
14. DISTANCE TO EXISTING DOWNSTREAM STRUCTURE	SPAN	WATERWAY AREA OF FULL OPENING

ALLOWABLE STRESSES:		
1. DESIGN LIVE LOAD AASHTO	HS25	
2. ALLOWABLE LOAD FOR SPREAD FOOTINGS ON SOIL	4 KSF	ON LEDGE N.A.
3. ALLOWABLE LOAD FOR PILING	N.A.	ESTIMATED LENGTH
4. ALLOWABLE STRESS FOR STRUCTURAL STEEL ASTM A 36	TENSION 27000 PSI	
5. ALLOWABLE STRESS FOR REINFORCING STEEL GRADE 60	TENSION 24000 PSI	COMPRESSION 20000 PSI
6. ALLOWABLE STRESS FOR CONCRETE CLASS A 1 1/2	3500	1400 PSI
	CLASS B 1 1/2	3200 PSI

TRAFFIC MAINTENANCE:		
1. IS TRAFFIC TO BE MAINTAINED?	IF YES, ON EXISTING STRUCTURE	OR ON TEMPORARY BRIDGE
2. TEMPORARY BRIDGE REQUIREMENTS:	ONE OR TWO WAY	TRAFFIC CONTROL SIGNALS REQUIRED
MINIMUM CLEAR SPAN	MINIMUM CLEAR HEIGHT	MINIMUM WATERWAY AREA
ARE SIDEWALKS REQUIRED?	IF SO, ON WHAT SIDE?	



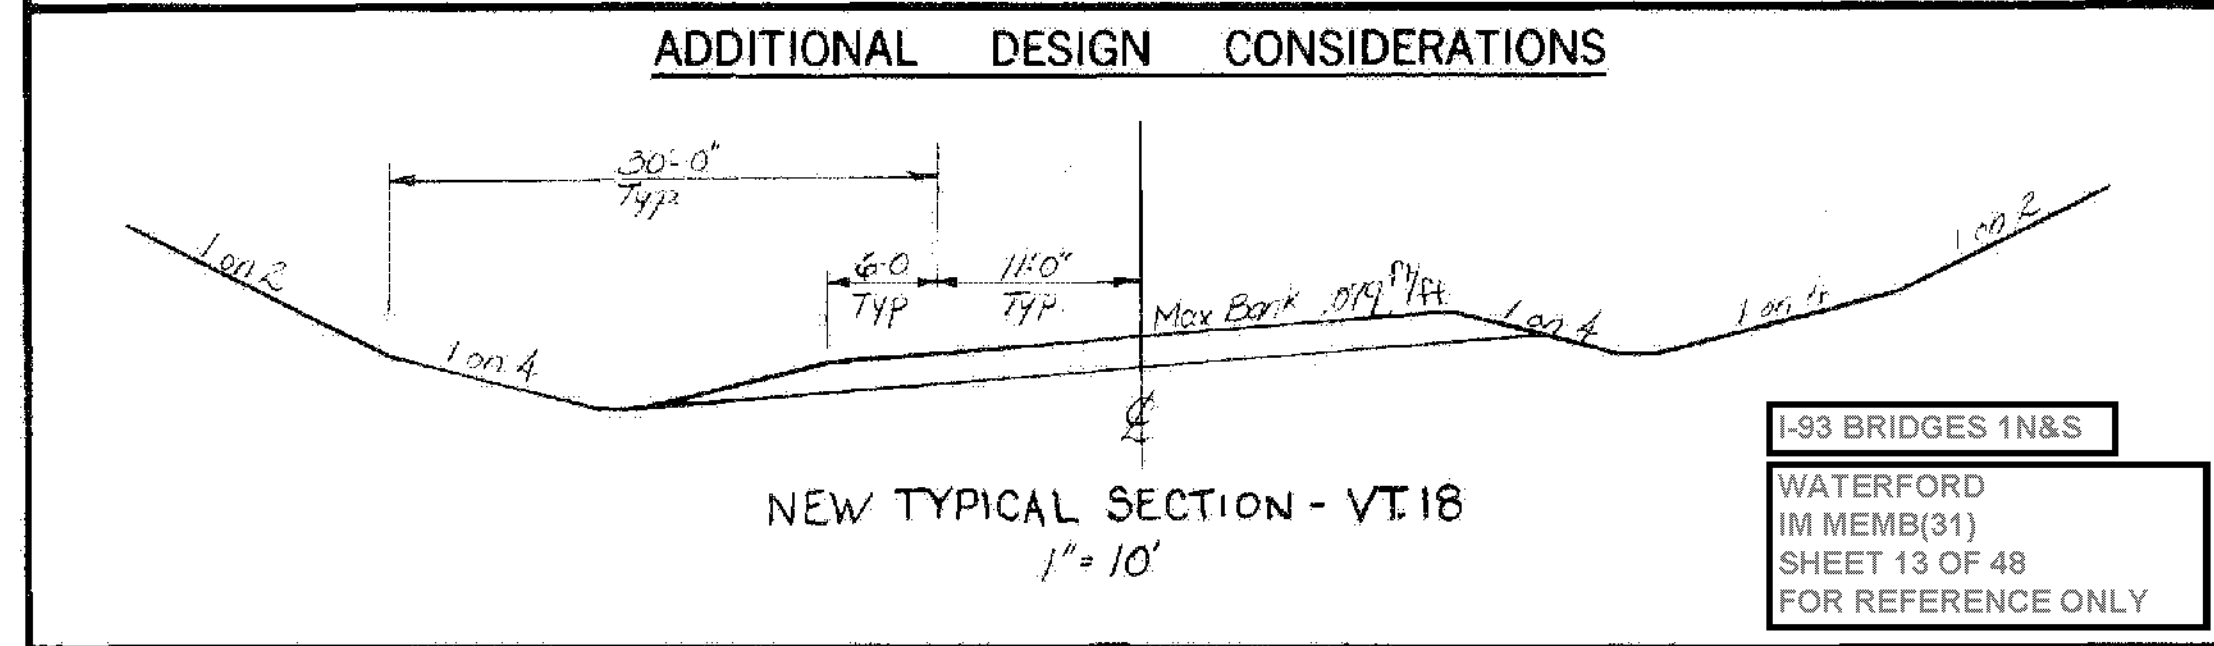


NORTHBOUND LOAD RATING (TONS)					SOUTHBOUND LOAD RATING (TONS)										
TRUCK					TRUCK										
STRESS LEVELS	H	HS	3S2	6 AXLE	3A. STR.	4A. STR.	3A. SEMI	STRESS LEVELS	H	HS	3S2	6 AXLE	3A. STR.	4A. STR.	3A. SEMI
INVENTORY								INVENTORY							
0.55 Fy =								0.55 Fy =							
POSTED								POSTED							
0.67 Fy =								0.67 Fy =							
OPERATING								OPERATING							
0.75 Fy =								0.75 Fy =							

RECOMMENDED FOR APPROVAL	<i>W.M. Smith</i>	1-30-80	DATE
RECOMMENDED FOR APPROVAL	<i>Arthur J. Goss</i>	1-30-80	DATE
APPROVED BY	<i>S. J. Gagne</i>	1-30-80	DATE
	DIRECTOR OF ENGINEERING & CONSTRUCTION		


REVISIONS		BY & DATE	
NO.	DESCRIPTION		
STATE OF VERMONT AGENCY OF TRANSPORTATION TOWN OF WATERFORD HIGHWAY NO. I 93 Bridge No. 1 NB & SB Log Sta. 28+00 Surv. Sta. 28+00 I 93 N.B. & S.B. OVER VT. RTE. 18 PRELIMINARY INFORMATION Designed by G. Spilak Drawn by R. Whitcomb Checked by AWE Bridge Design Supervisor R. S. HART PROJECT CONTRACT # 1 WATERFORD PROJECT NO. I 93-1(3) Bridge Sheet No. BR 100 Sheet 130 of 489			

INDEX OF SHEETS	
BR 100	PRELIMINARY INFORMATION
BR 101	PLAN
BR 102	NORTH BOUND & SOUTH BOUND QUANTITY SHEET.
BR 103	TYPICAL BRIDGE SECTIONS
BR 104	RAIL PLAN, GENERAL NOTES
BR 105	BORING LOGS
BR 106	BORING LOGS
BR 107	N.B. FRAMING PLAN
BR 108	TYPICAL FRAME LEG & BEARING DETAILS
BR 109	S.B. FRAMING PLAN
BR 110	DEFLECTION & CAMBER DIAGRAMS
BR 111	ABUTMENT #1
BR 112	WINGWALLS #1 & 2
BR 113	ABUTMENT #2
BR 114	WINGWALLS #3 & 4
BR 115	ABUTMENT #3
BR 116	WINGWALLS #5 & 6
BR 117	ABUTMENT #4
BR 118	WINGWALLS #7 & 8
BR 119	PIER #1 PLAN
BR 120	PIER #1 & #3 DETAILS
BR 121	PIER #2 PLAN
BR 122	PIER #2 & #4 DETAILS
BR 123	PIER #3 PLAN
BR 124	PIER #4 PLAN
BR 125	DECK REINFORCING
BR 126	APPROACH SLABS
BR 127	ABUTMENT BEARING DEVICES
BR 128	BRIDGE APPROACH RAIL
BR 129	REINFORCING SCHEDULE - ABUT #1 & 2 W.W. 1, 2, 3, & 4
BR 130	REINFORCING SCHEDULE - ABUT #3 & 4 W.W. 5, 6, 7, & 8
BR 131	REINFORCING SCHEDULE - PIERS 1, 2, 3, & 4, DECK SLABS & APPROACH SLABS.
ROADWAY CROSS SECTIONS	

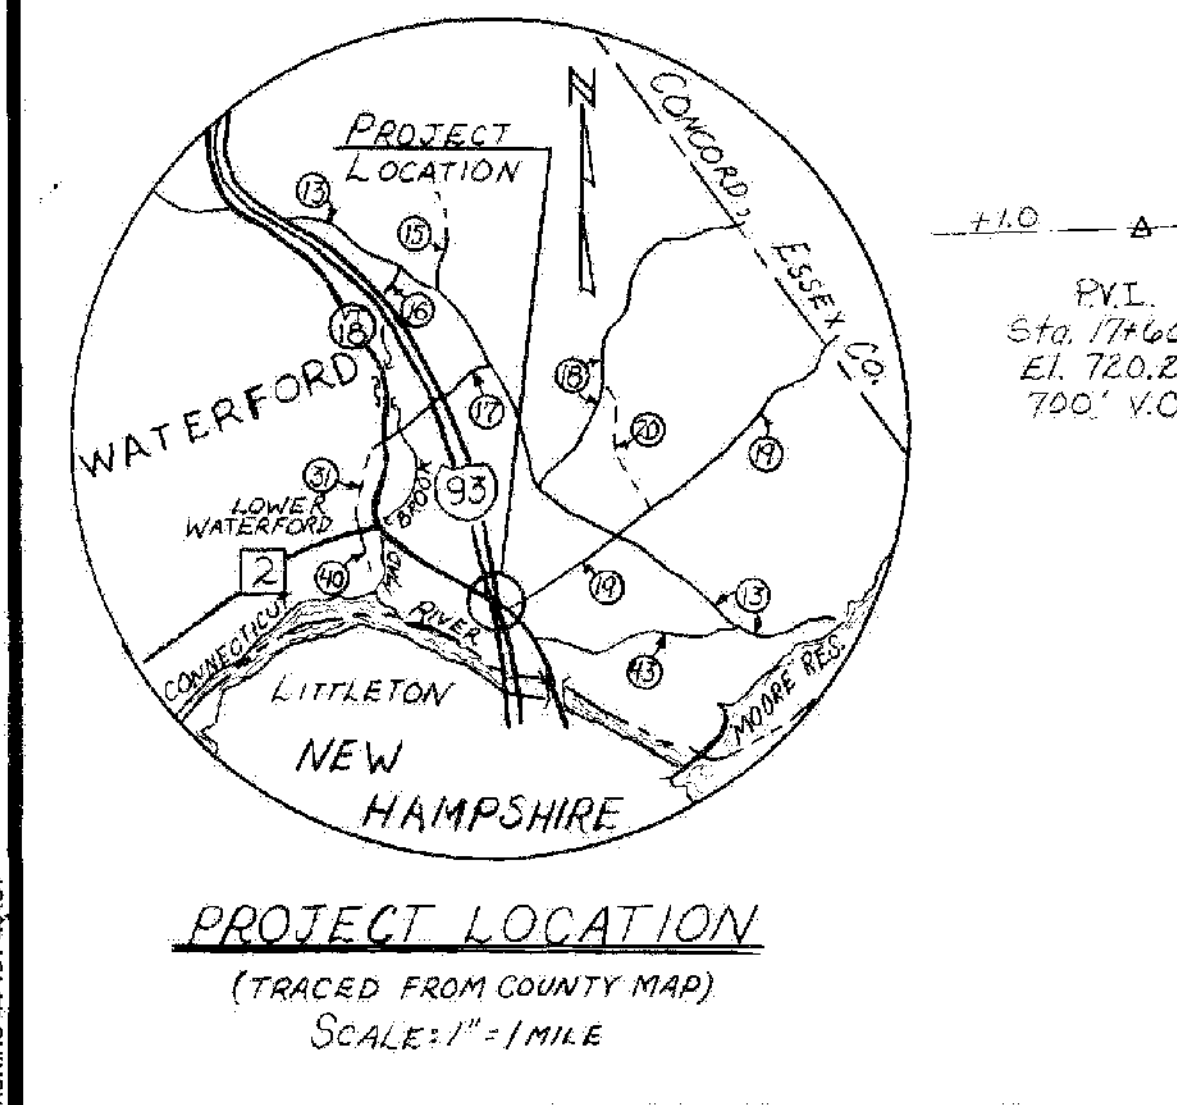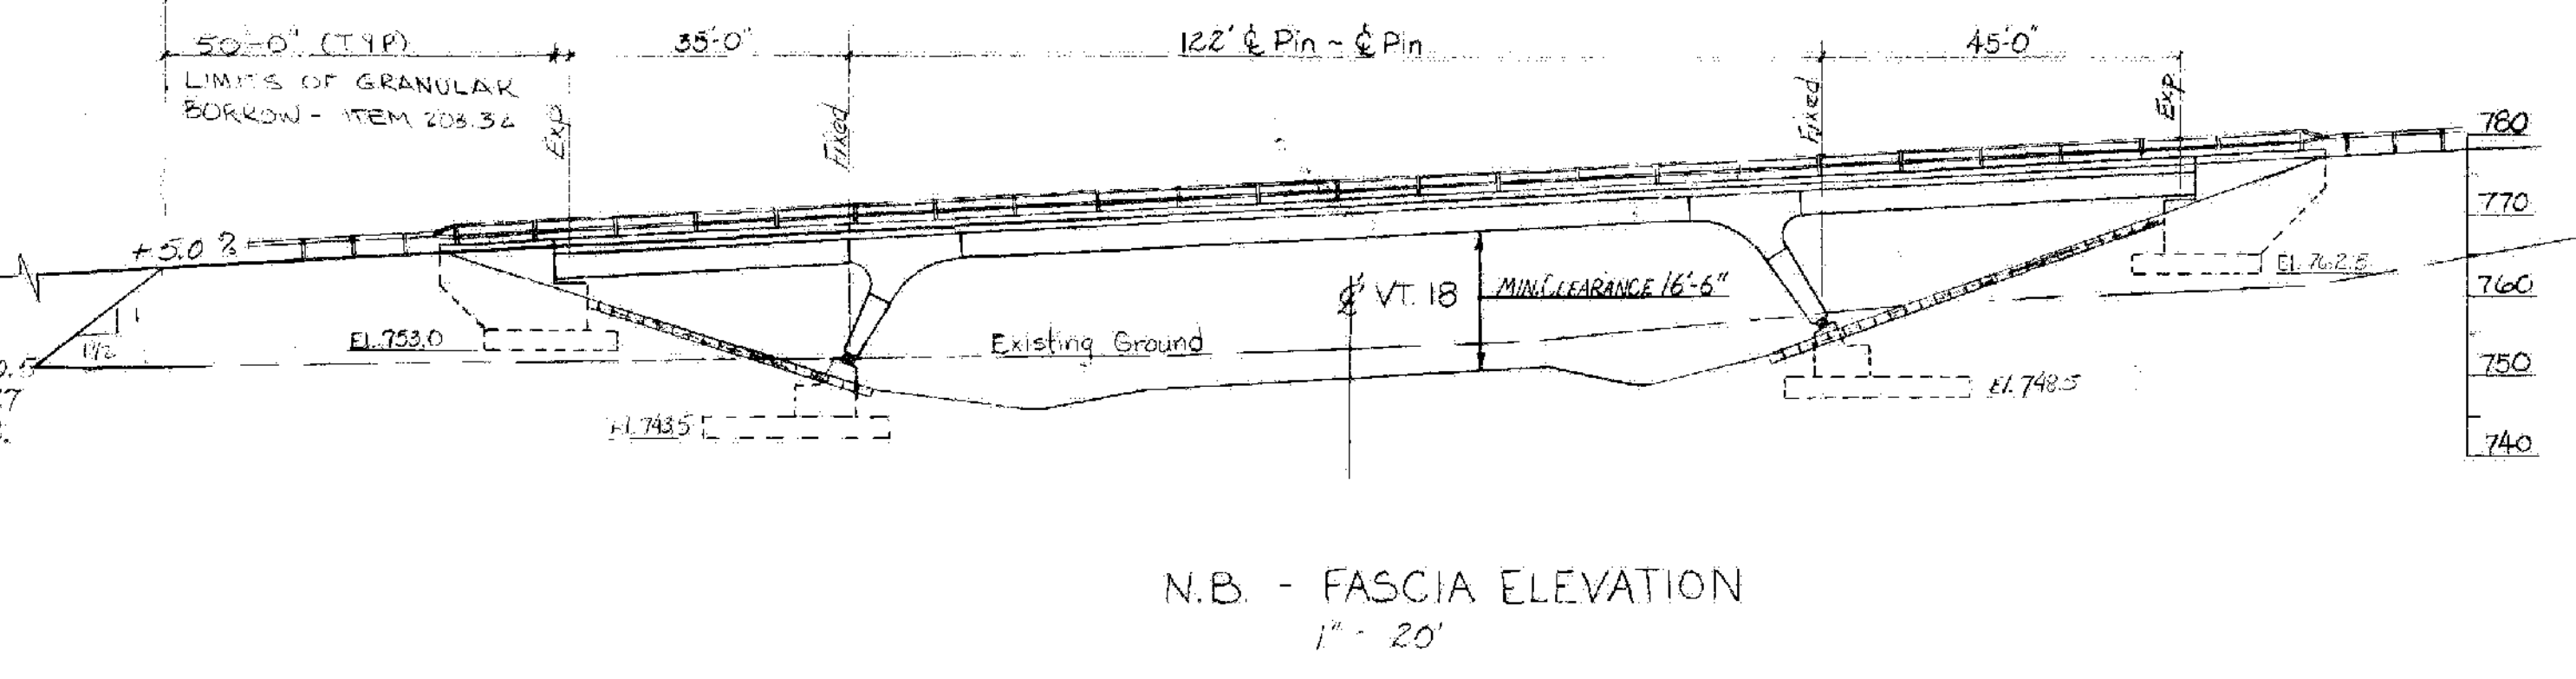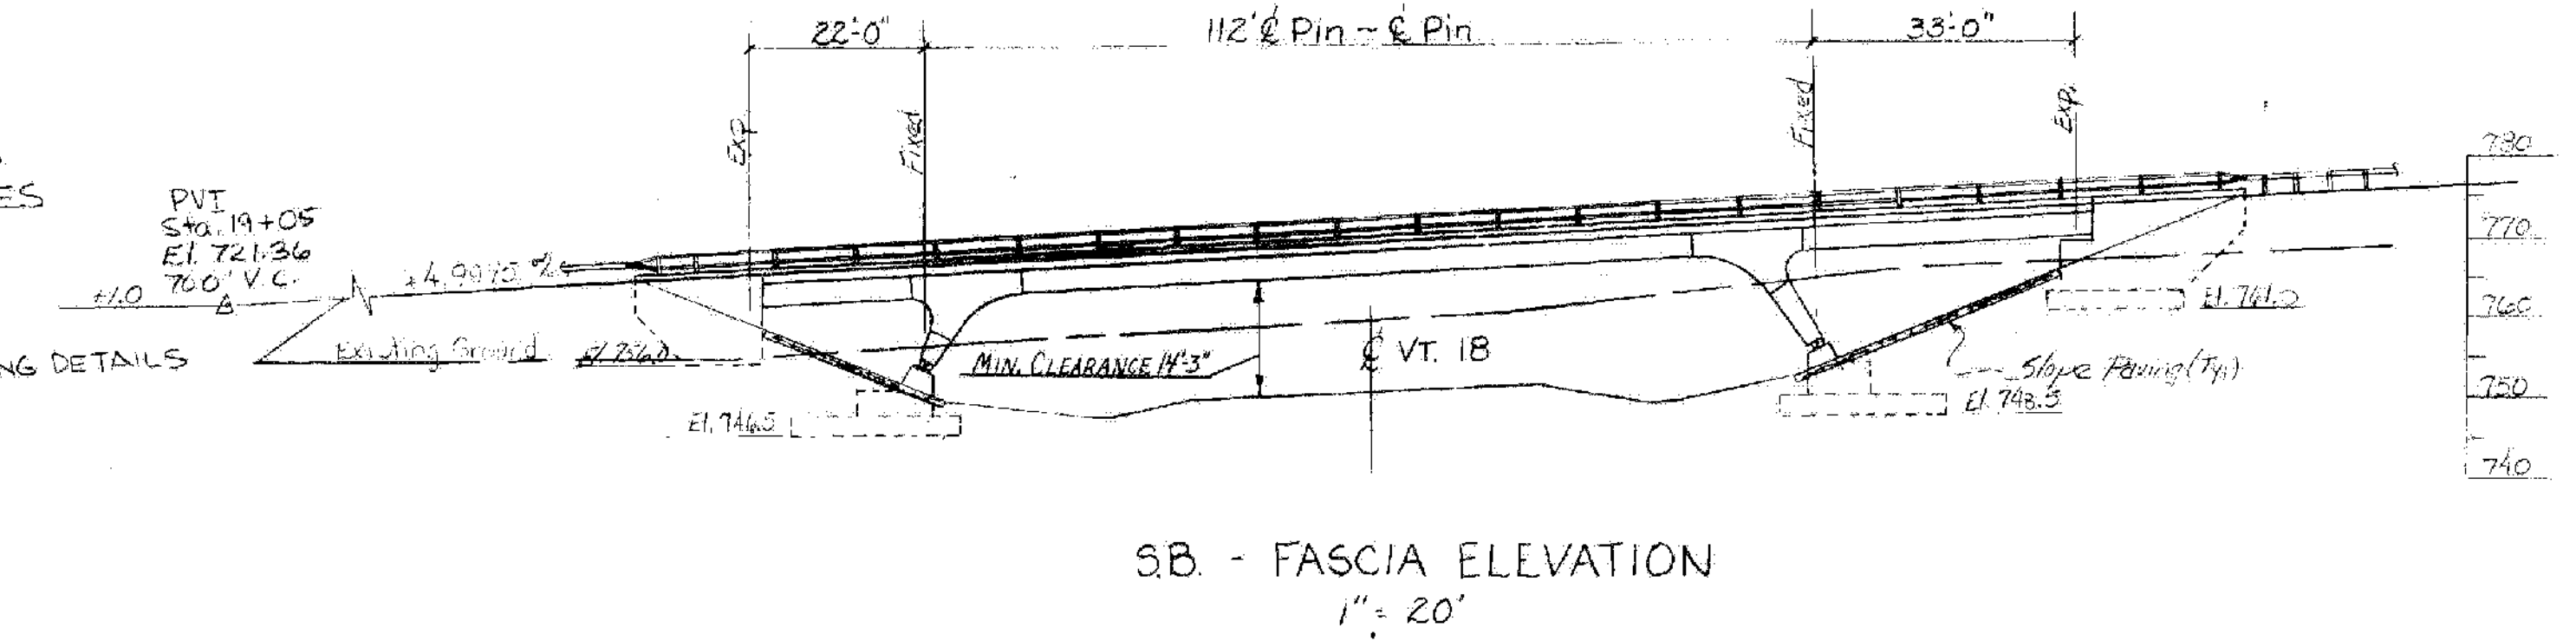

SB. CURVE
 Δ 4°18'01" Lt
 D 22918.32
 R 860.46
 T 1720.11
 L 16.16
 Do Not Bank



VT. RTE. 18
 Δ 52°19'30" Lt
 D 7'30"
 R 7163.95
 T 373.29
 L 697.67
 E 87.20
 Max. Bank 0.0797 ft.

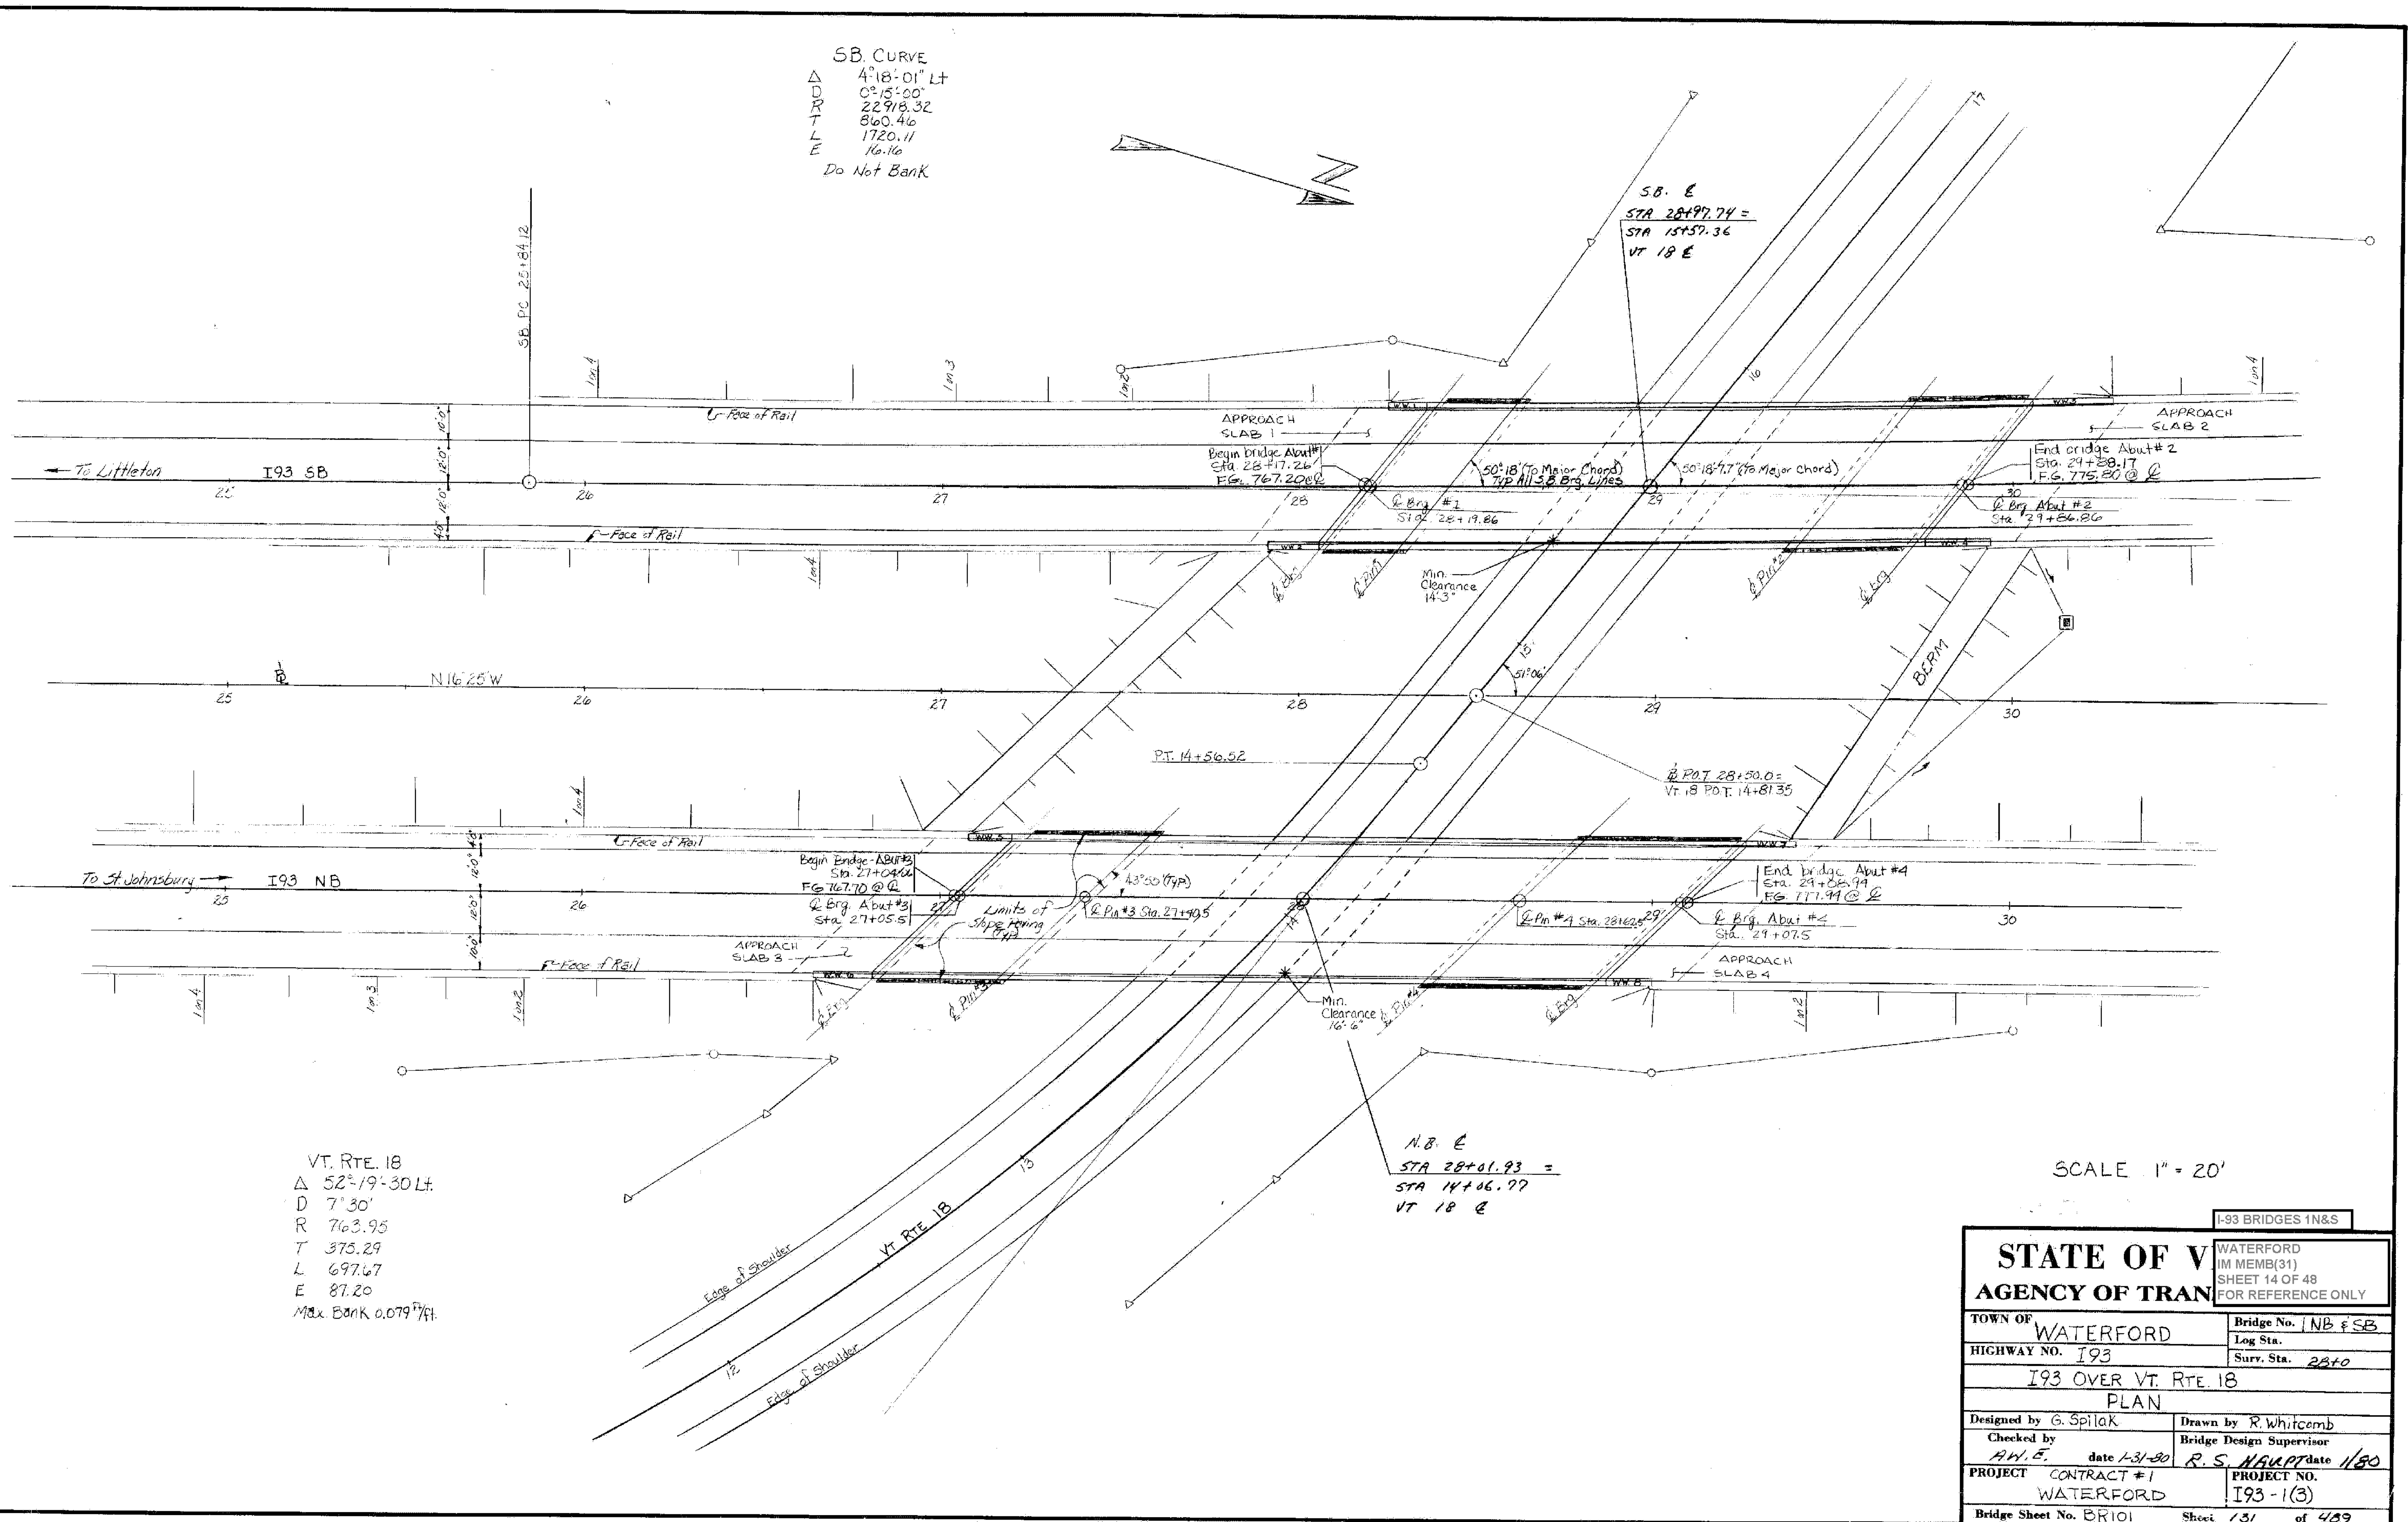

SCALE 1" = 20'

STATE OF VERMONT		WATERFORD IM MEMB(31) SHEET 14 OF 48 FOR REFERENCE ONLY	
AGENCY OF TRANSPORTATION		I-93 BRIDGES IN&S	
TOWN OF	WATERFORD	Bridge No.	INB & SB
HIGHWAY NO.	I93	Log Sta.	
		Surr. Sta.	28+0
I93 OVER VT. RTE. 18			
PLAN			
Designed by	G. Spilak	Drawn by	R. Whitcomb
Checked by	AW/E	Bridge Design Supervisor	R. S. HUBERT
PROJECT	CONTRACT #1	PROJECT NO.	I93-1(3)
WATERFORD		PROJECT NO.	I93-1(3)
Bridge Sheet No.	BR101	Sheet	131 of 489


BR-6

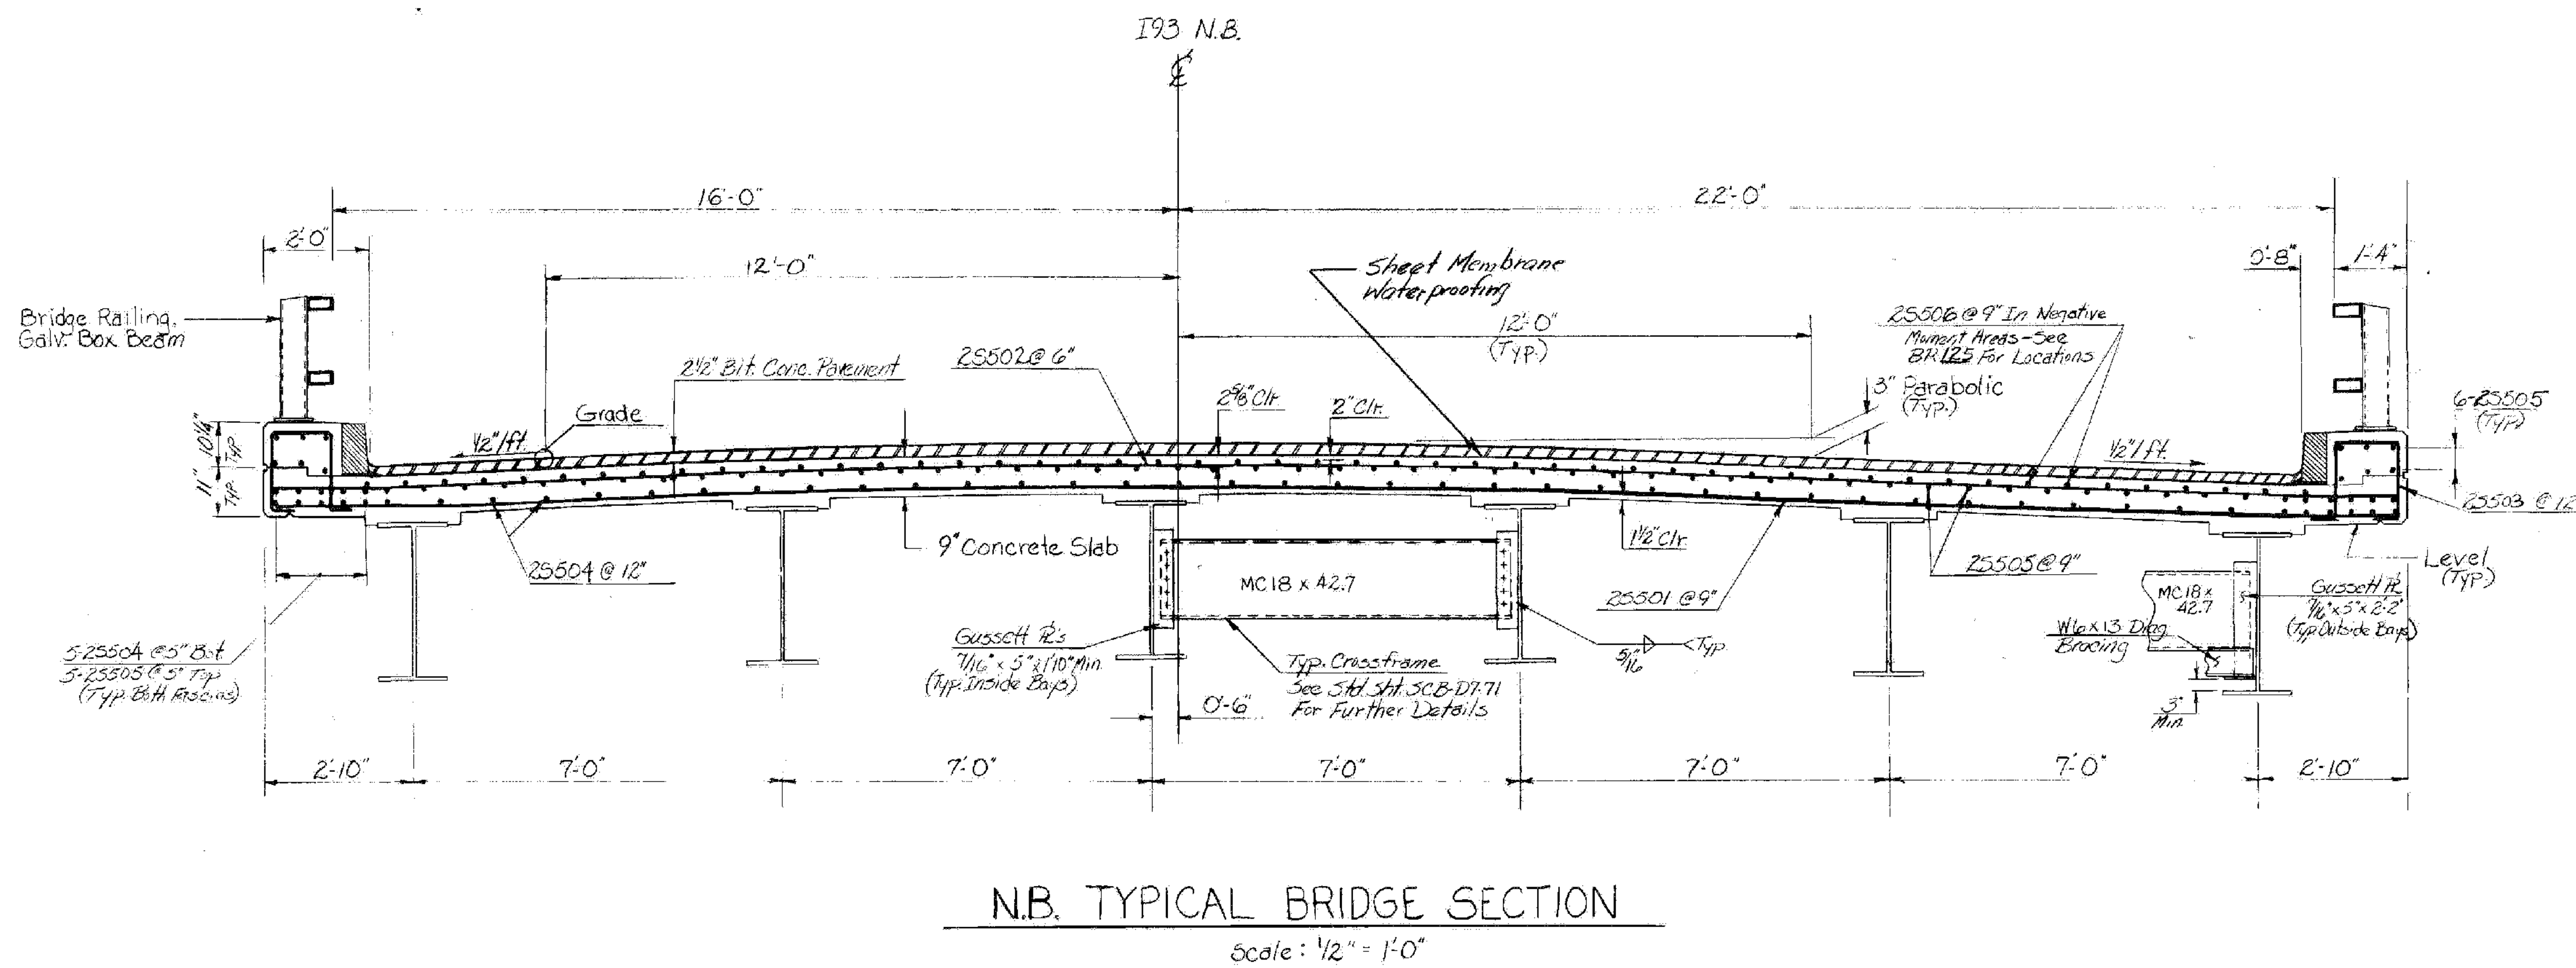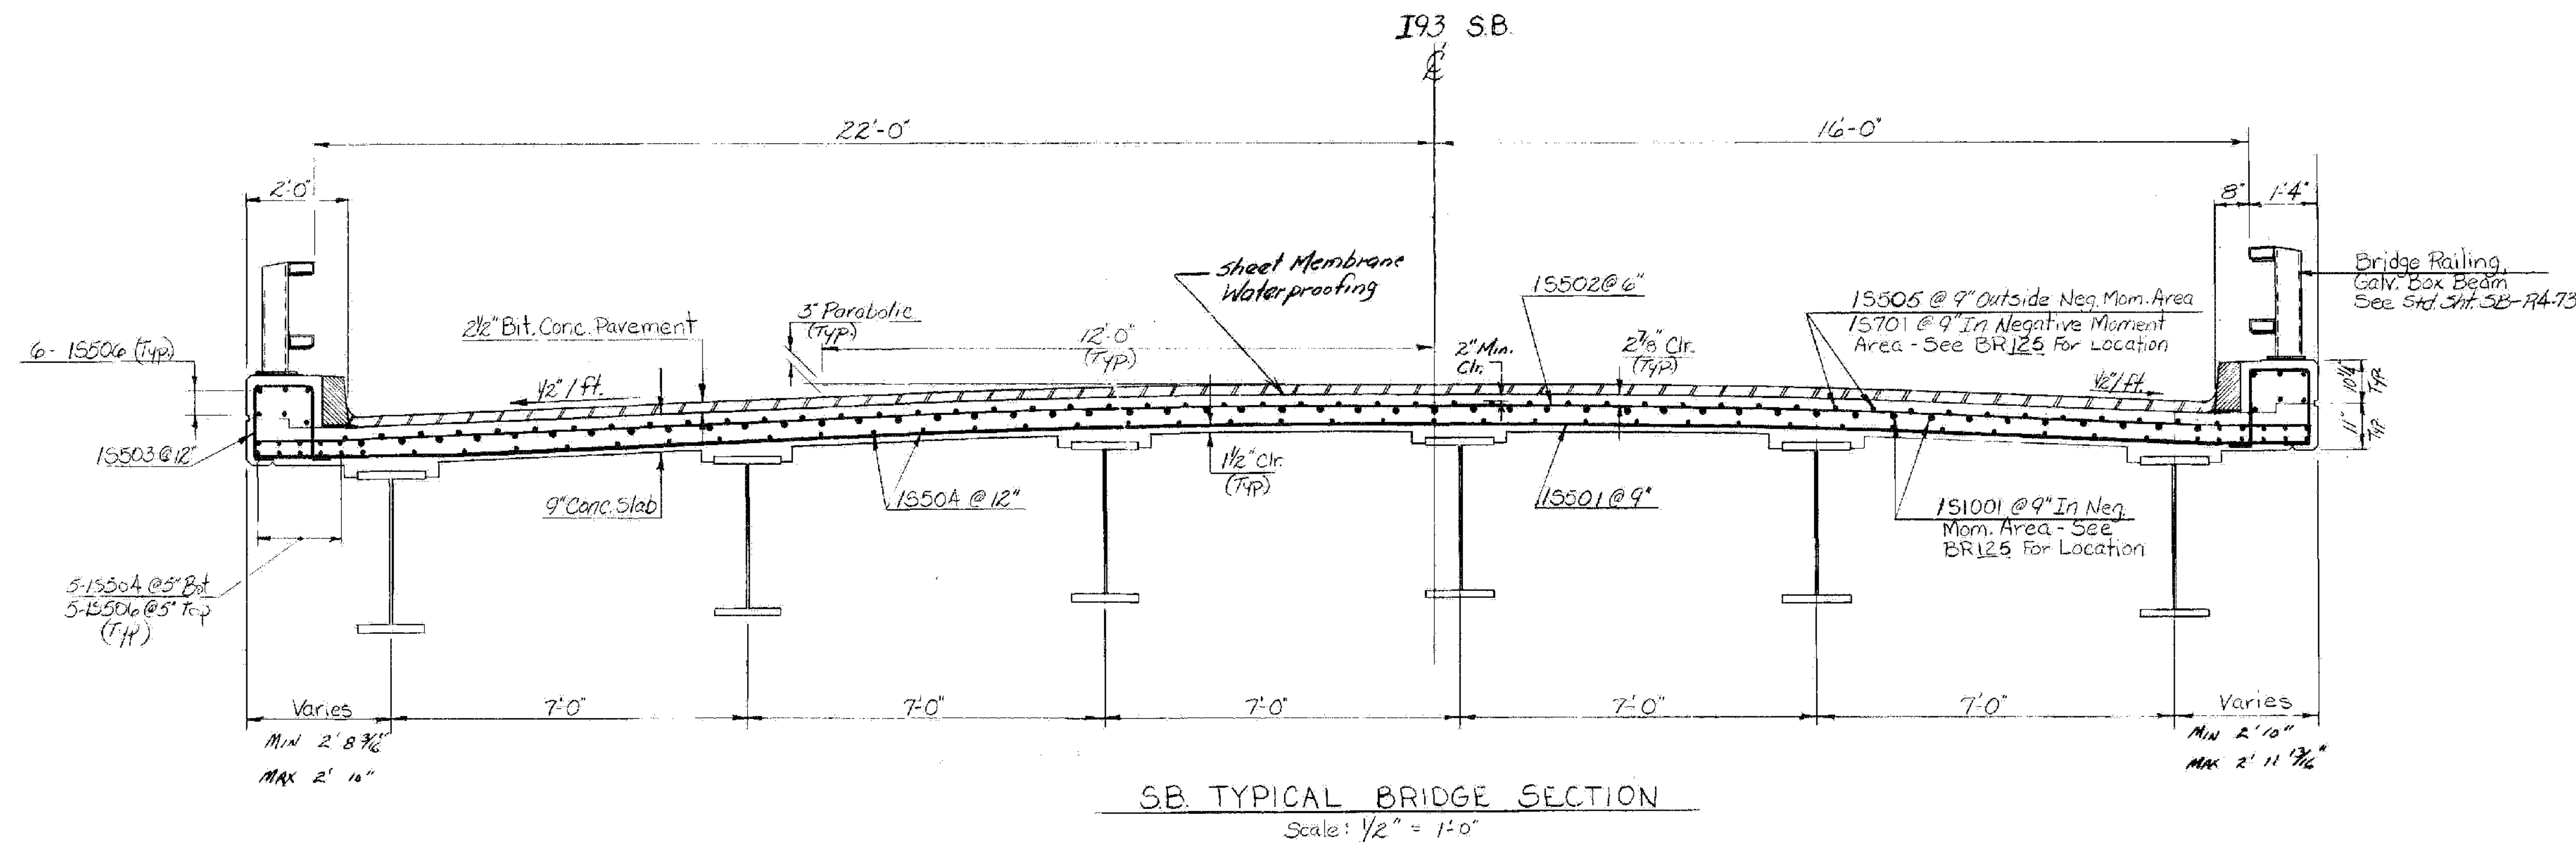


I-93 BRIDGES 1N&S
WATERFORD
IM MEMB(31)
SHEET 15 OF 48
FOR REFERENCE ONLY

STATE OF VERMONT	
AGENCY OF TRANSPORTATION	
TOWN OF WATERFORD	Bridge No. 1NB & SB
HIGHWAY NO. I93	Log Sta. Surv. Sta. 28+0
I93 N.B. & S.B. Over VT. Rte. 18	
TYPICAL BRIDGE SECTIONS	
Designed by G. SPILAK	Drawn by R. WHITCOMB
Checked by A. Elwood date 6-19-80	Bridge Design Supervisor R. S. MAUPT date 4/80
PROJECT WATERFORD - CONTRACT 1	PROJECT NO. I93-1(3)
Bridge Sheet No. BR 103	Sheet 133 of 489

BRUNING 44 (31) 40 (51)

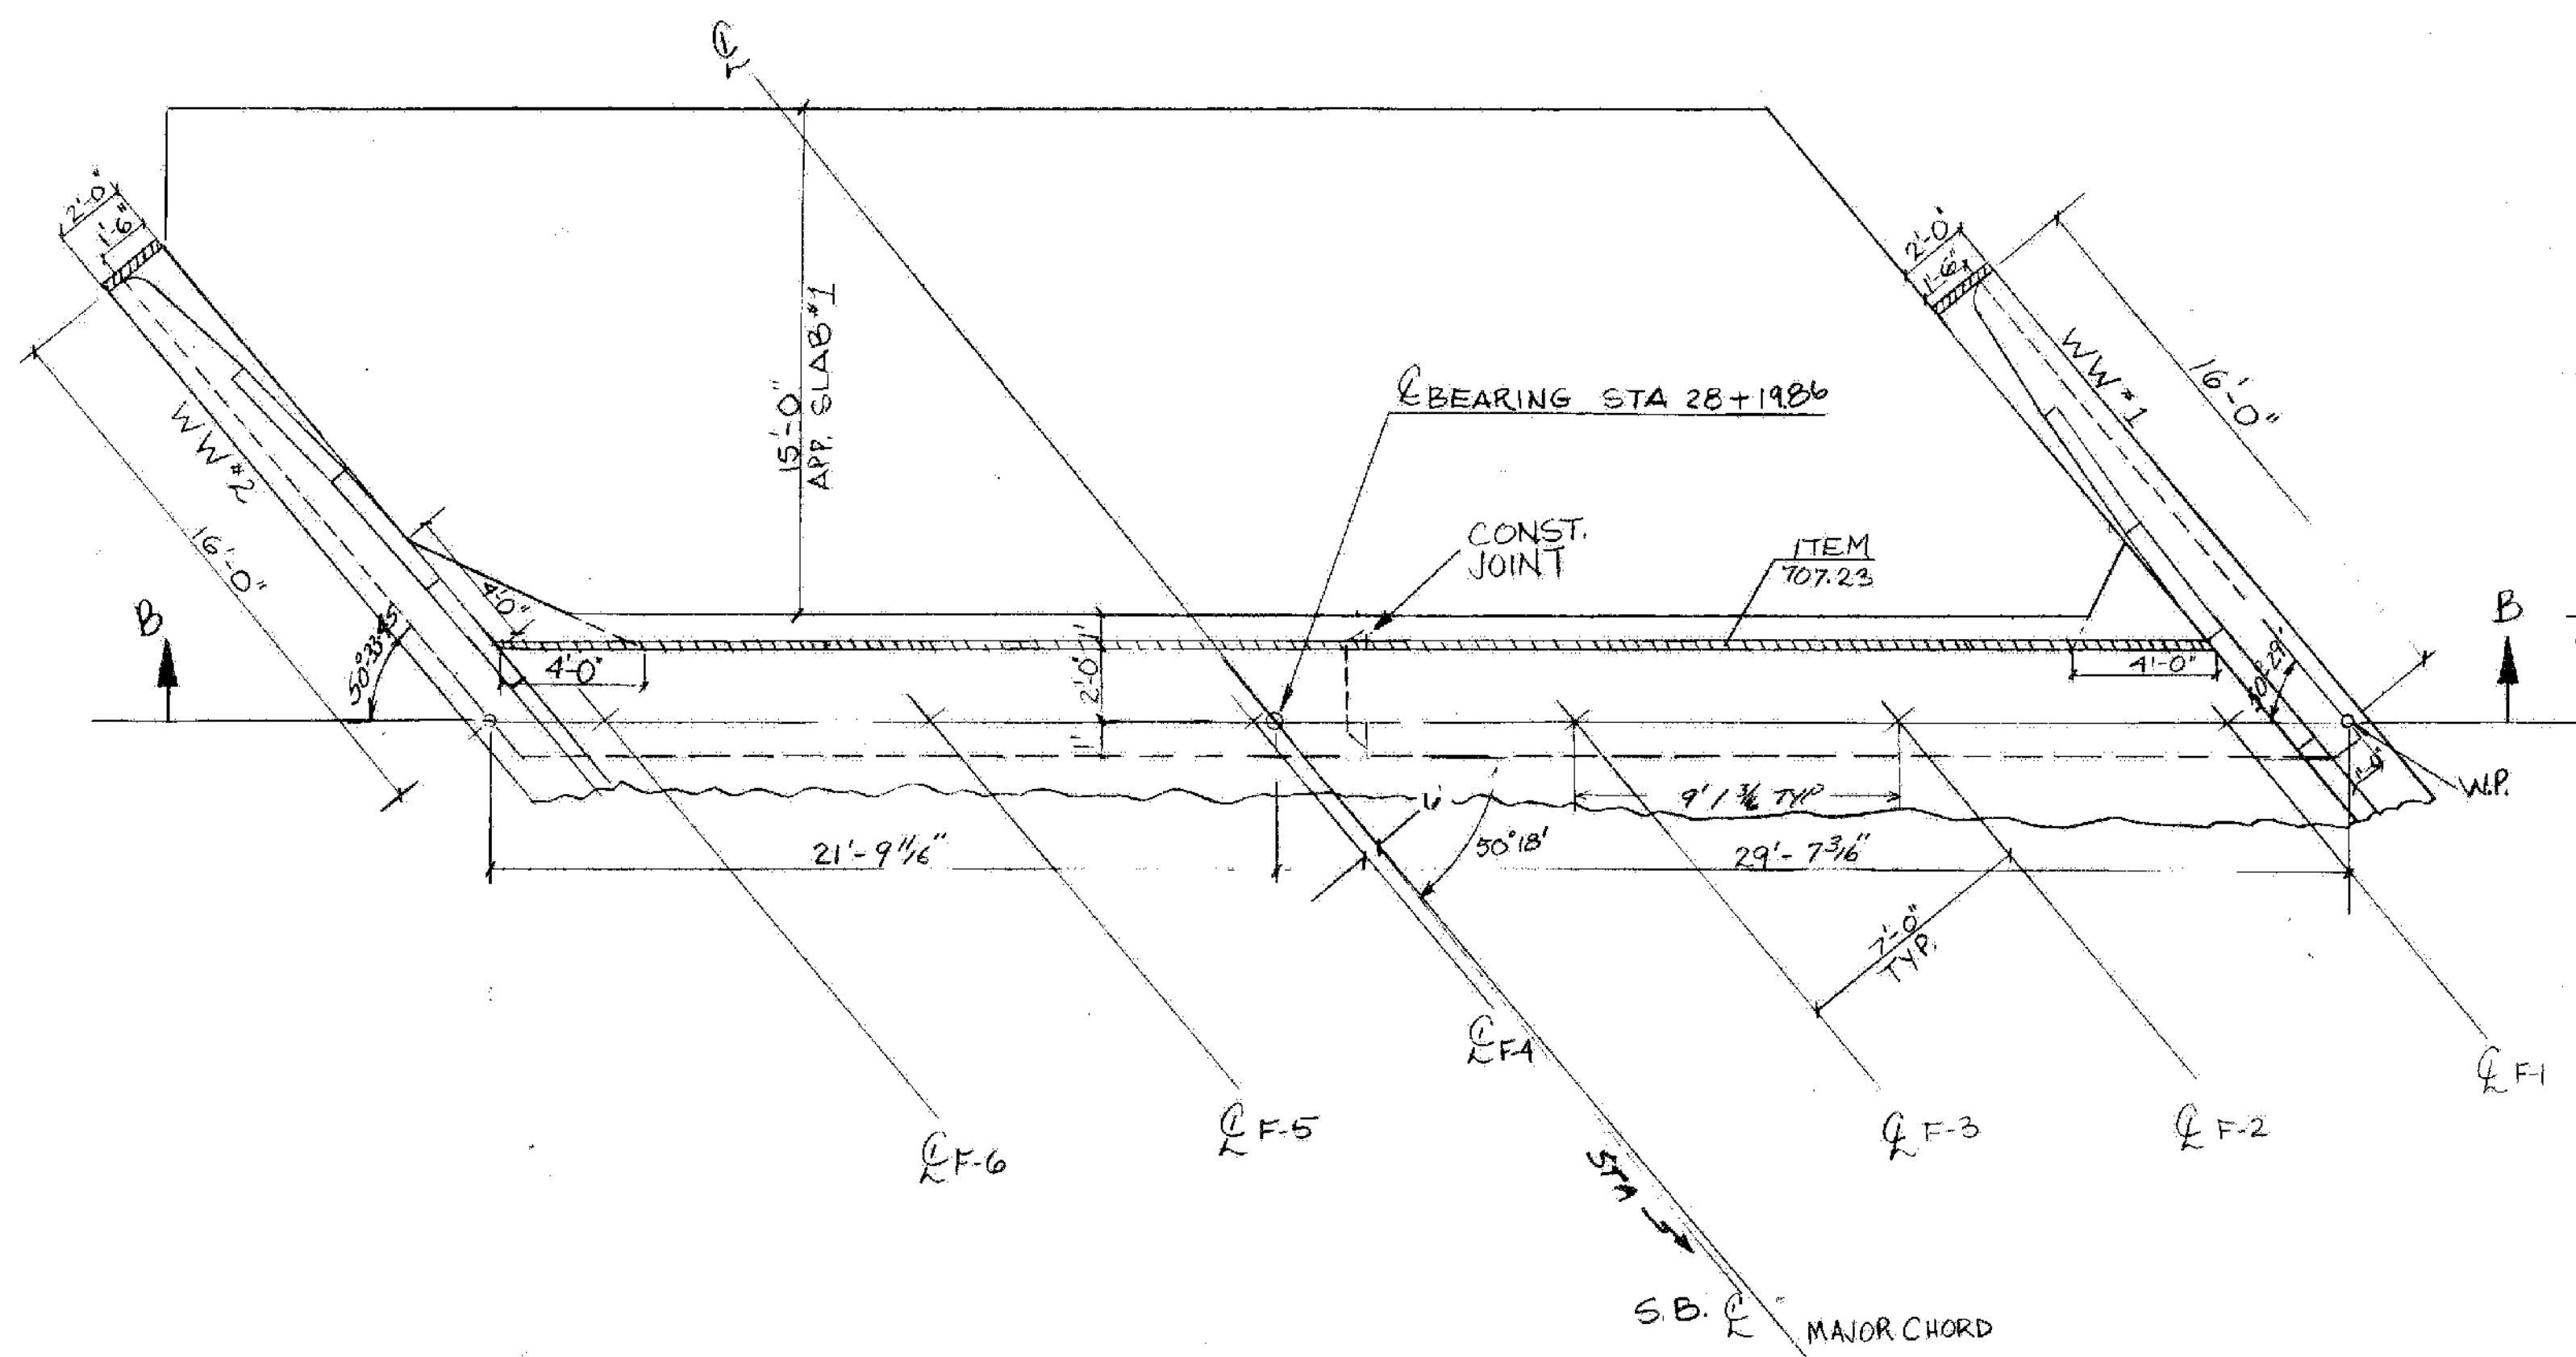


ABUT 1 - PLAN
SCALE 1/4" = 1'-0"

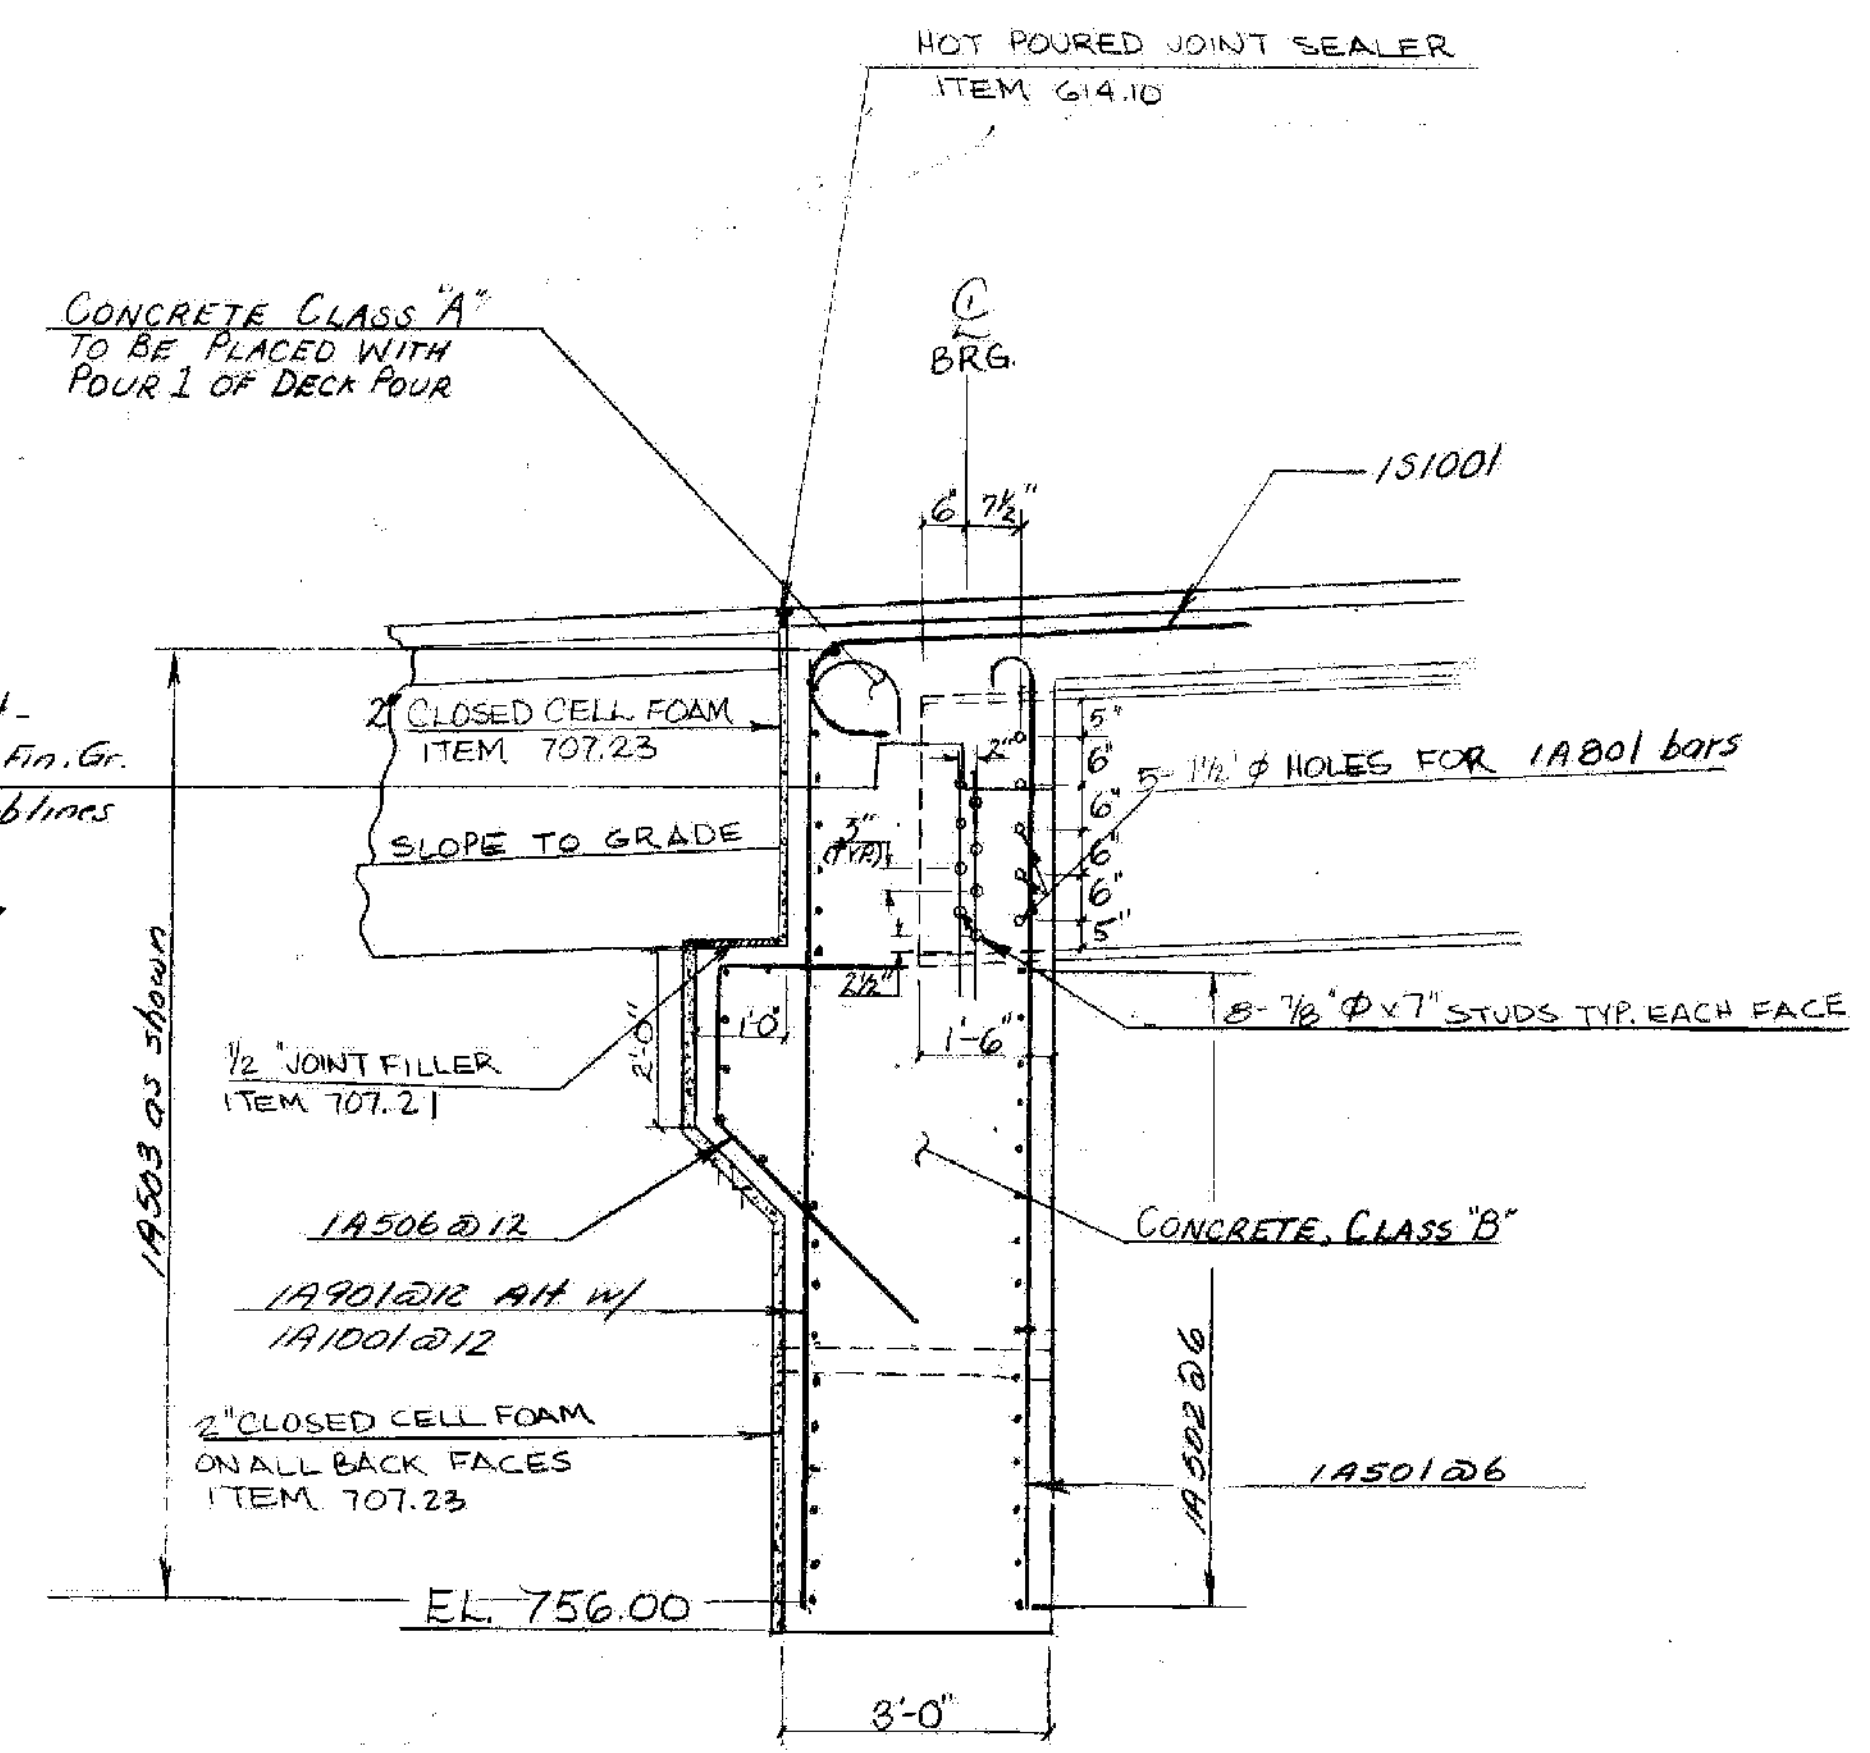

SECTION A-A (DECK SHOWN FOR CLARITY)
SCALE 1/2" = 1'

NOTE: ITEMS CONFORMING TO SPECIFICATIONS 707.21, 707.23 AND 707.30 SHALL BE SUBSIDIARY TO CONCRETE CLASS B.





1993 BRIDGES 1N&S
WATERFORD
IM MEMB(31)
SHEET 16 OF 48
FOR REFERENCE ONLY

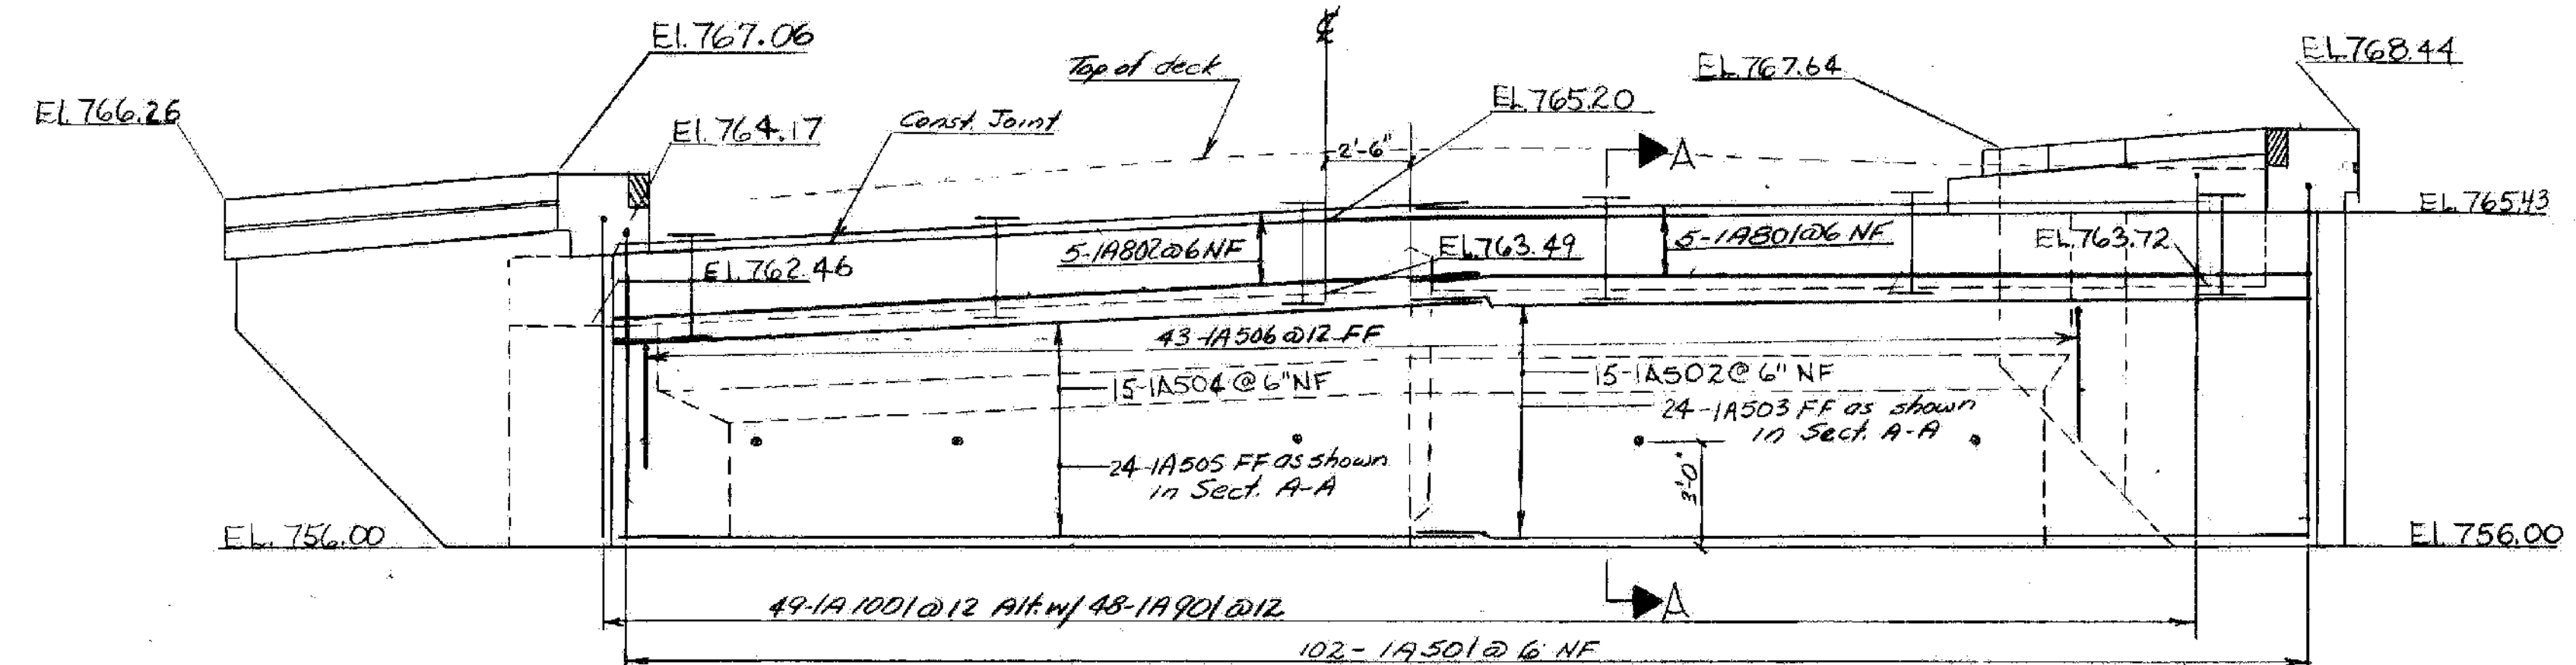

ABUT 1 - ELEV. SECTION B-B
SCALE 1/4" = 1'-0"

FF FAR FACE
NF NEAR FACE

STATE OF VERMONT	
AGENCY OF TRANSPORTATION	
TOWN OF WATERFORD	Bridge No. 1 SB
HIGHWAY NO. I 93	Log Sta.
I 93 NB. & SB Over VT. Rte. 18	Surv. Sta. 28+00
S.B. ABUTMENT DETAILS	
Designed by G. SPILAK	Drawn by M. HEALD
Checked by R. Elwood date 6-13-80	Bridge Design Supervisor R. HAUPT date 6-80
PROJECT CONTRACT I	PROJECT NO. I 93 - 1(3)
WATERFORD	Bridge Sheet No. BR 11.
Sheet 141 of 489	178 of 290

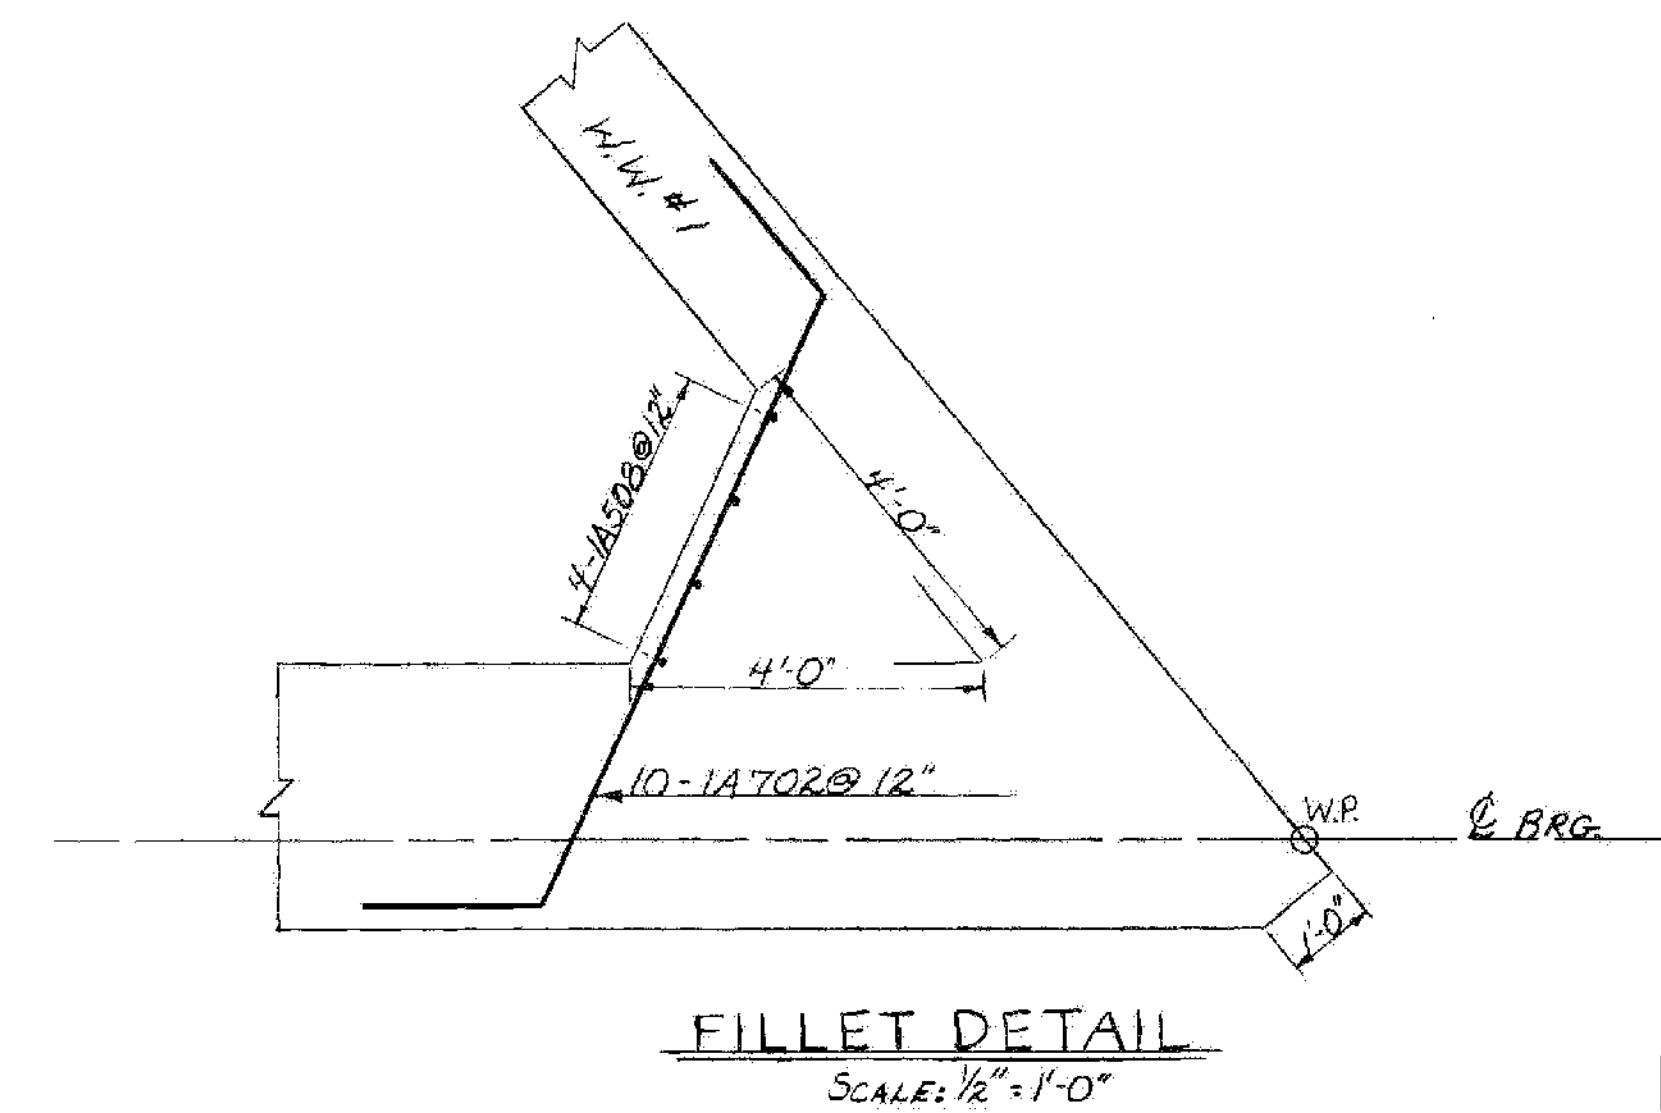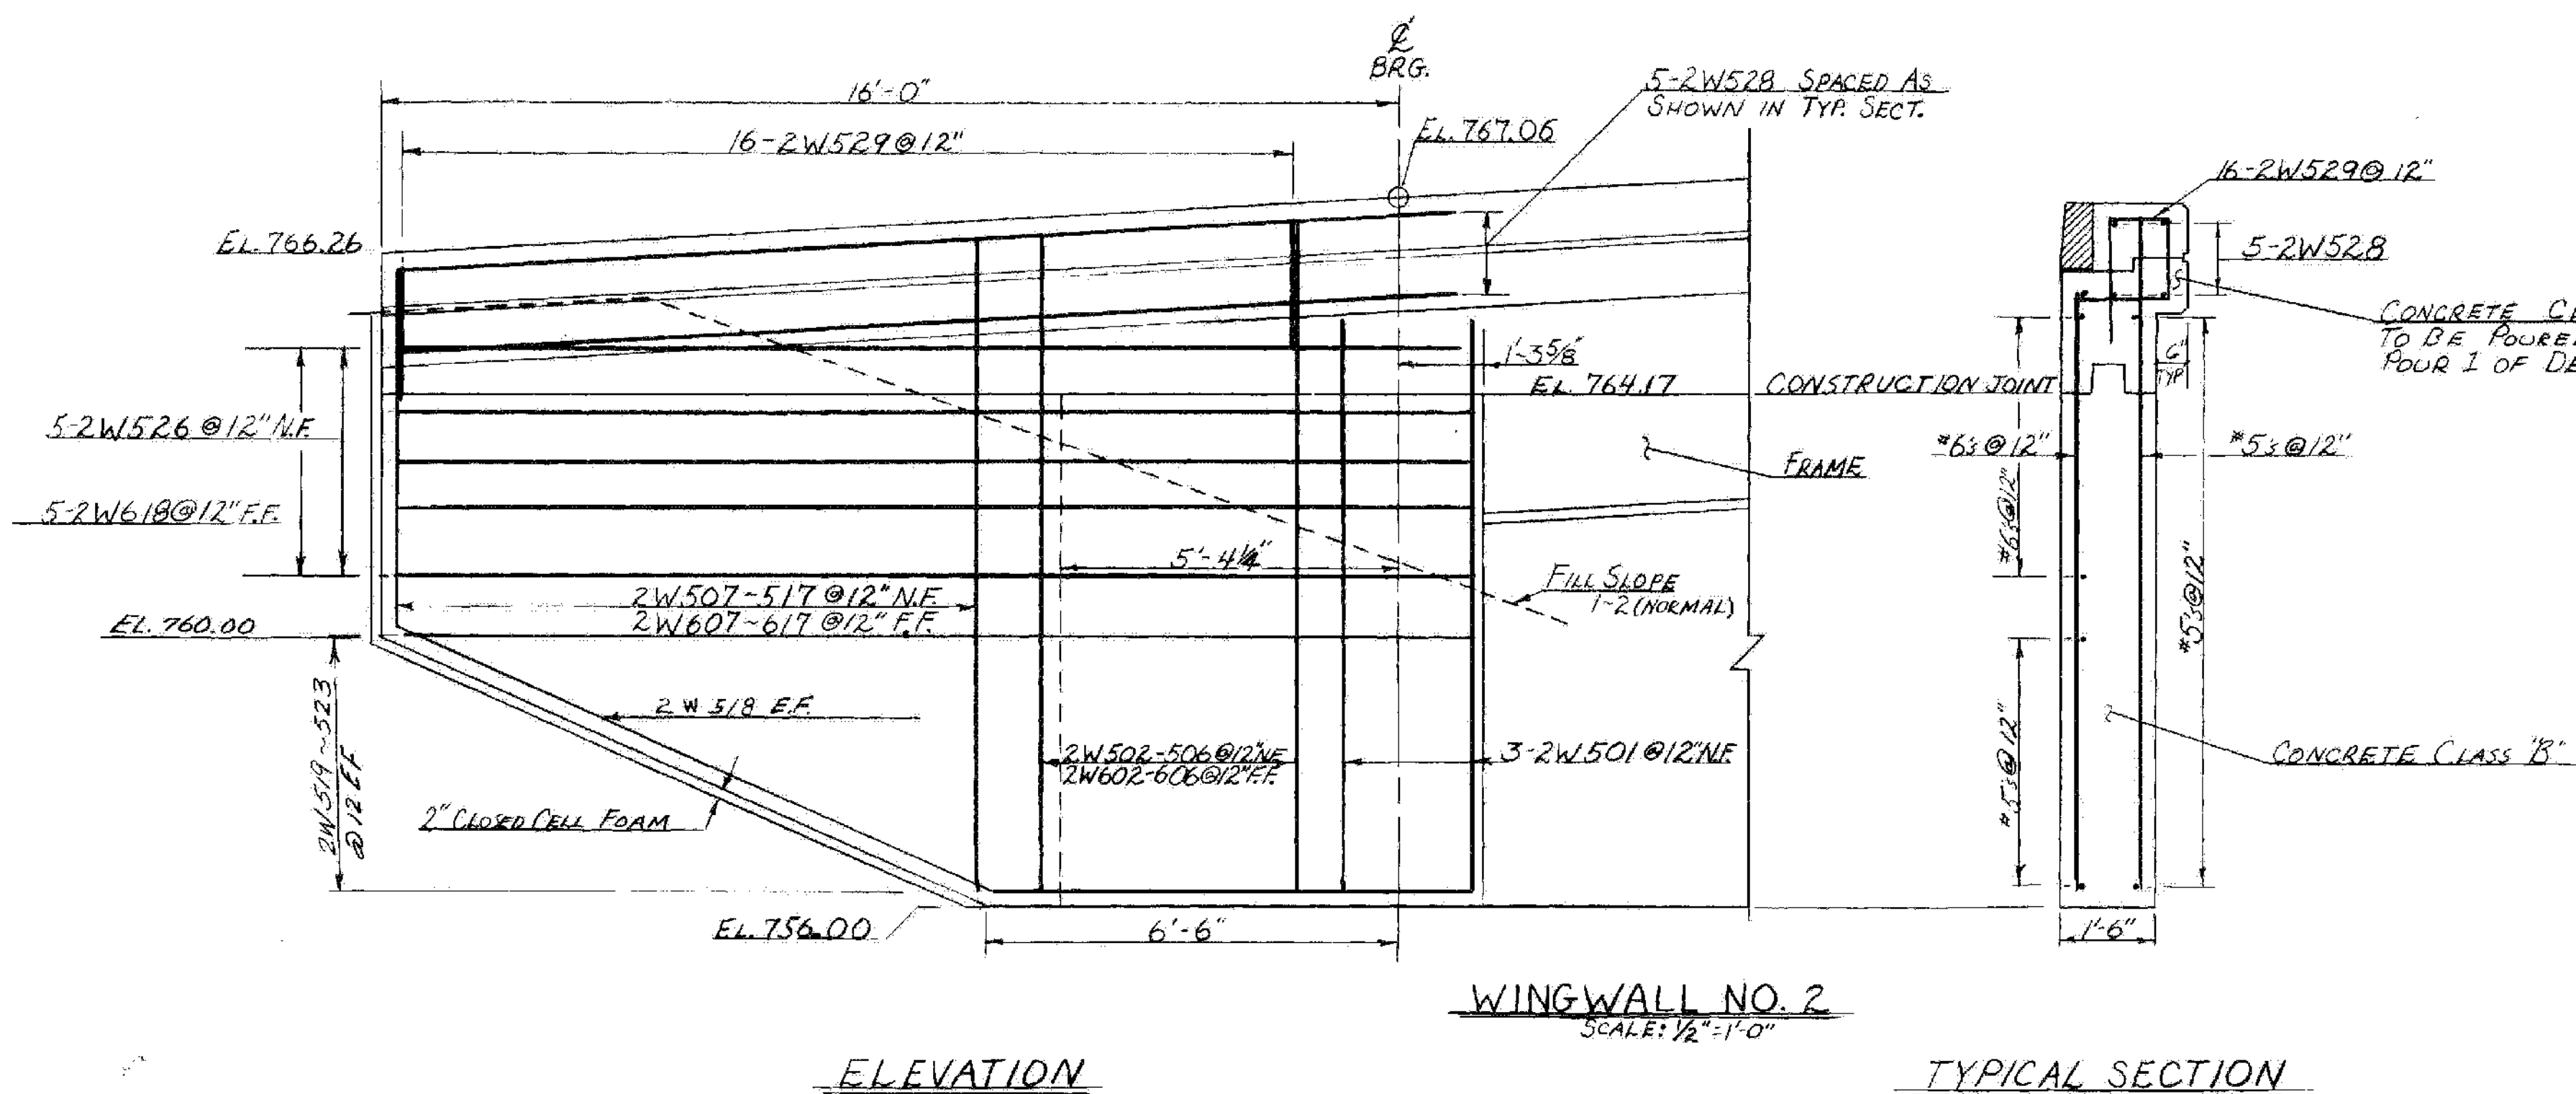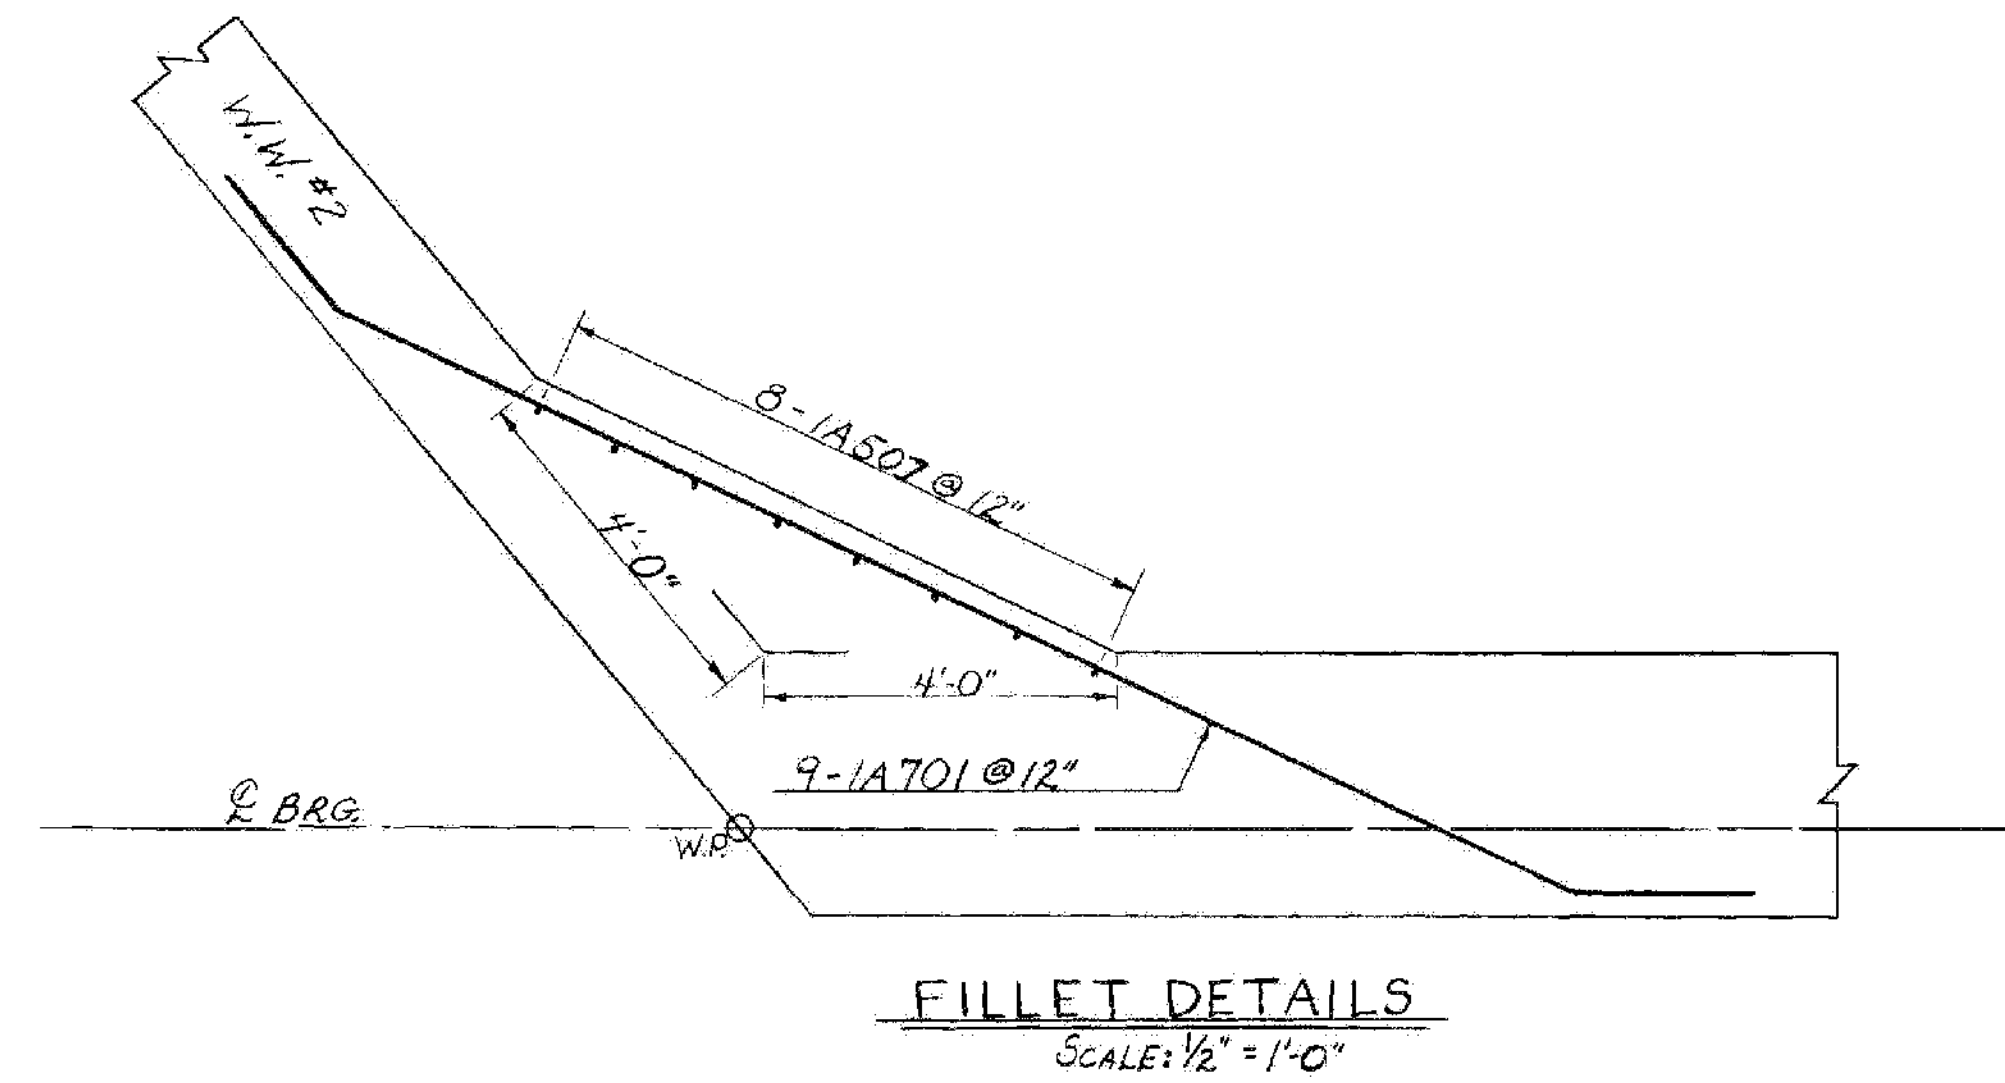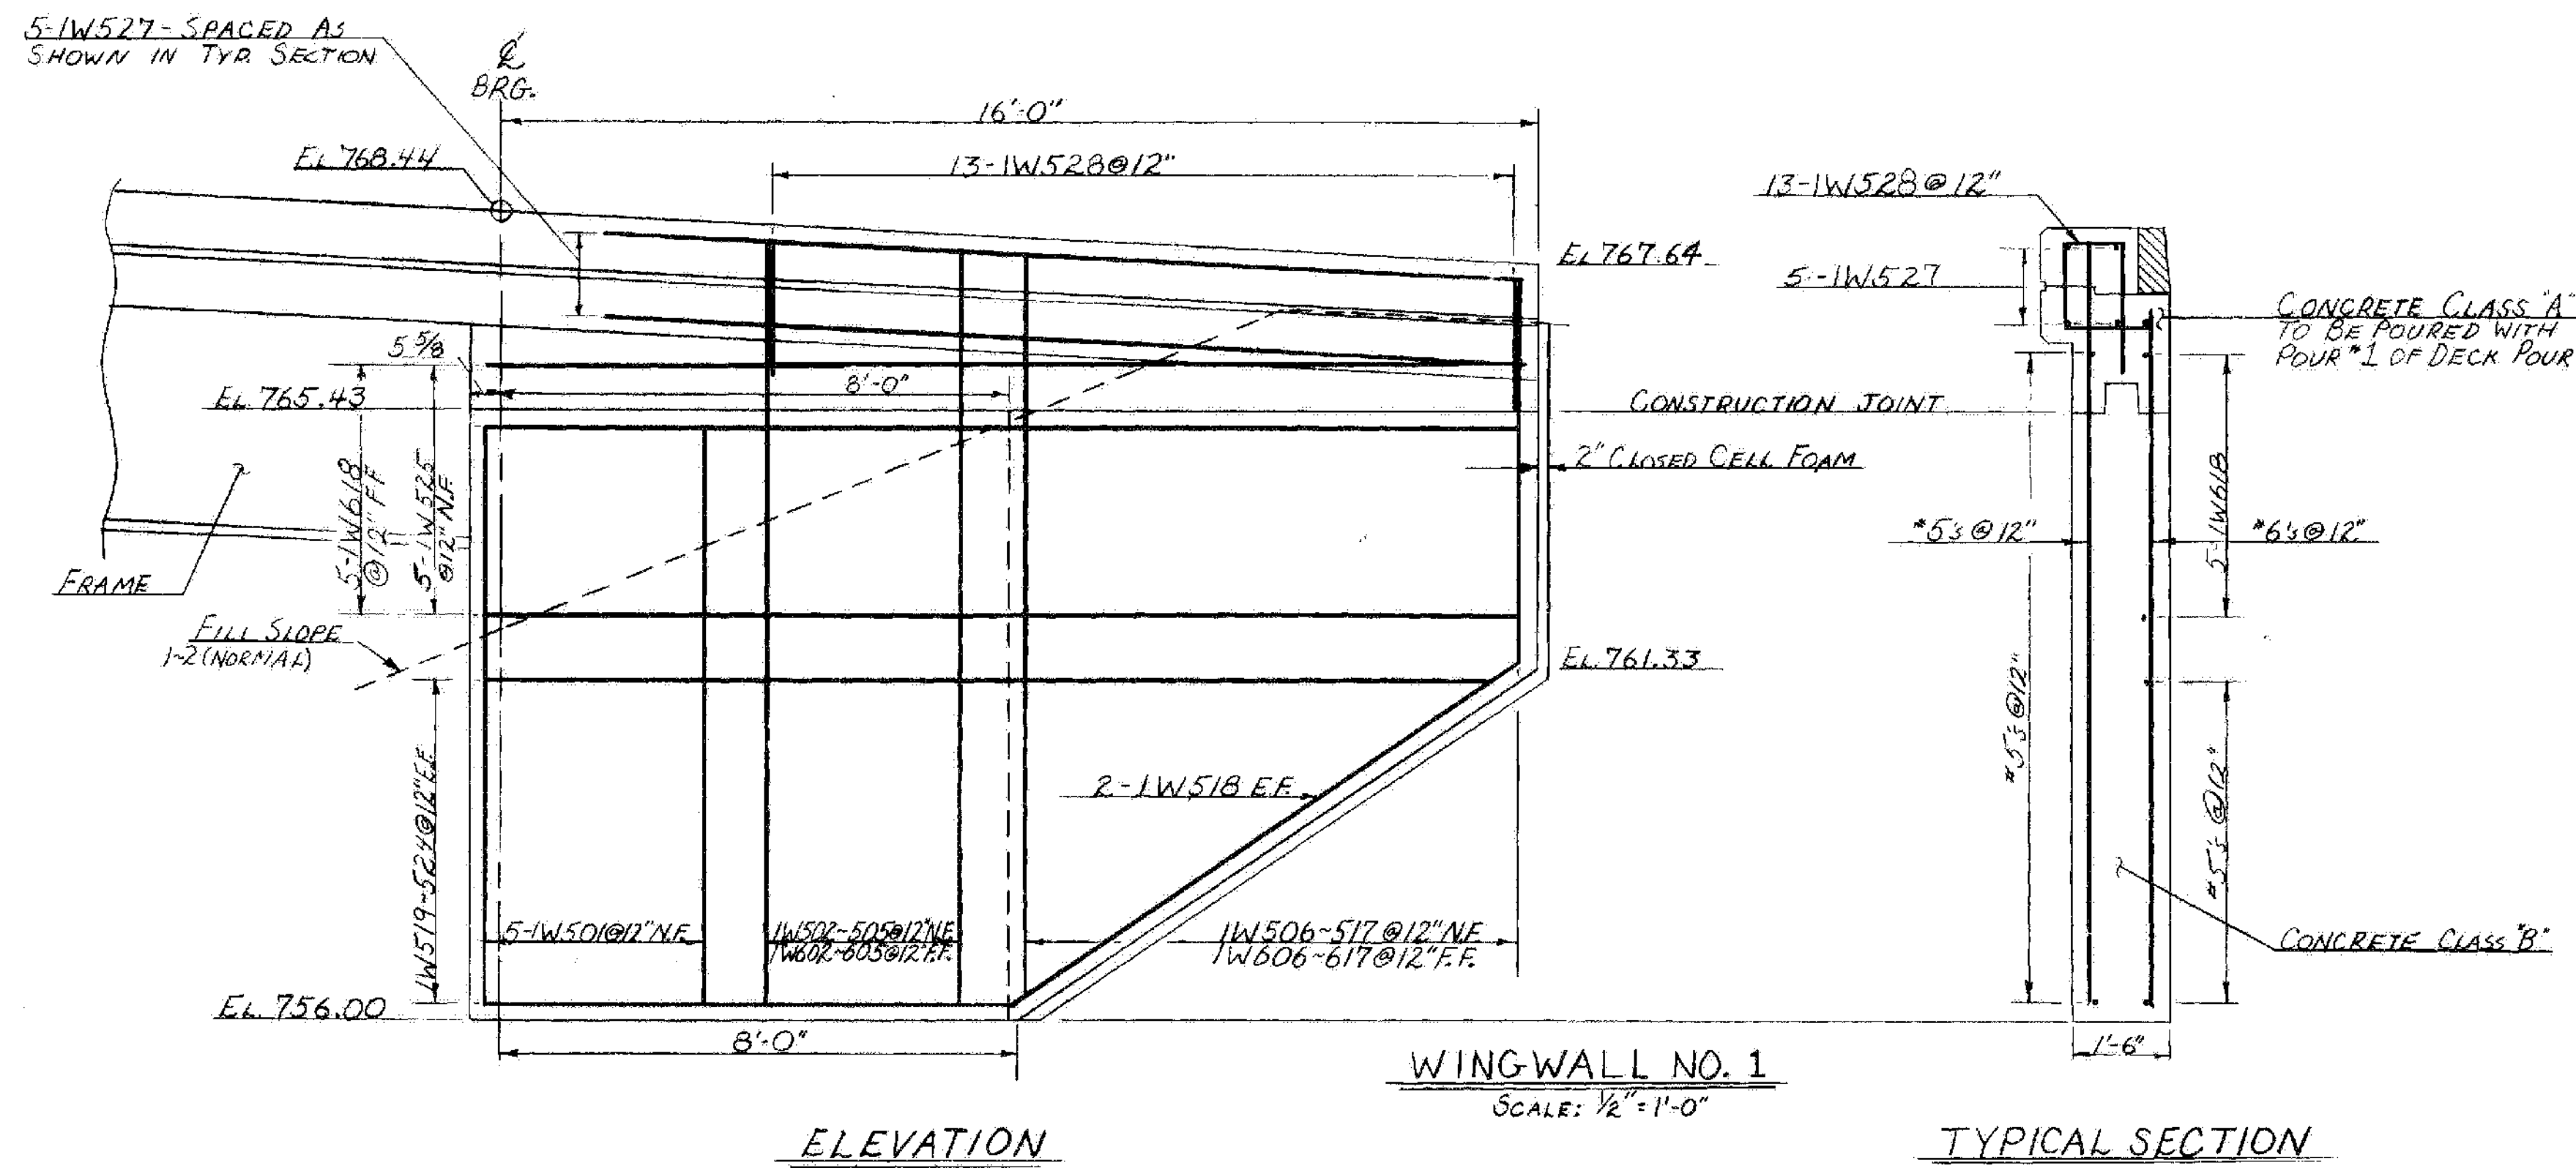


I-93 BRIDGES 1N&S


WATERFORD
IM MEMB(31)
SHEET 17 OF 48
FOR REFERENCE ONLY

STATE OF VERMONT AGENCY OF TRANSPORTATION	
TOWN OF WATERFORD	Bridge No. 1 SB
HIGHWAY NO. I 93	Log Sta. 28+0
I 93 NB. & SB. OVER VT. 18	
S.B. WINGWALLS NO. 1+2 DETAILS	
Designed by G. SPILAK	Drawn by S. BASCOM
Checked by A. Elwood date 6-14-80	Bridge Design Supervisor R.S. HAUPT date 6-80
PROJECT CONTRACT 1 WATERFORD	PROJECT NO. I 93-1(3)
Bridge Sheet No. BR 112	Sheet 142 of 489


N.F. - NEAR FACE
F.F. - FAR FACE
E.F. - EACH FACE

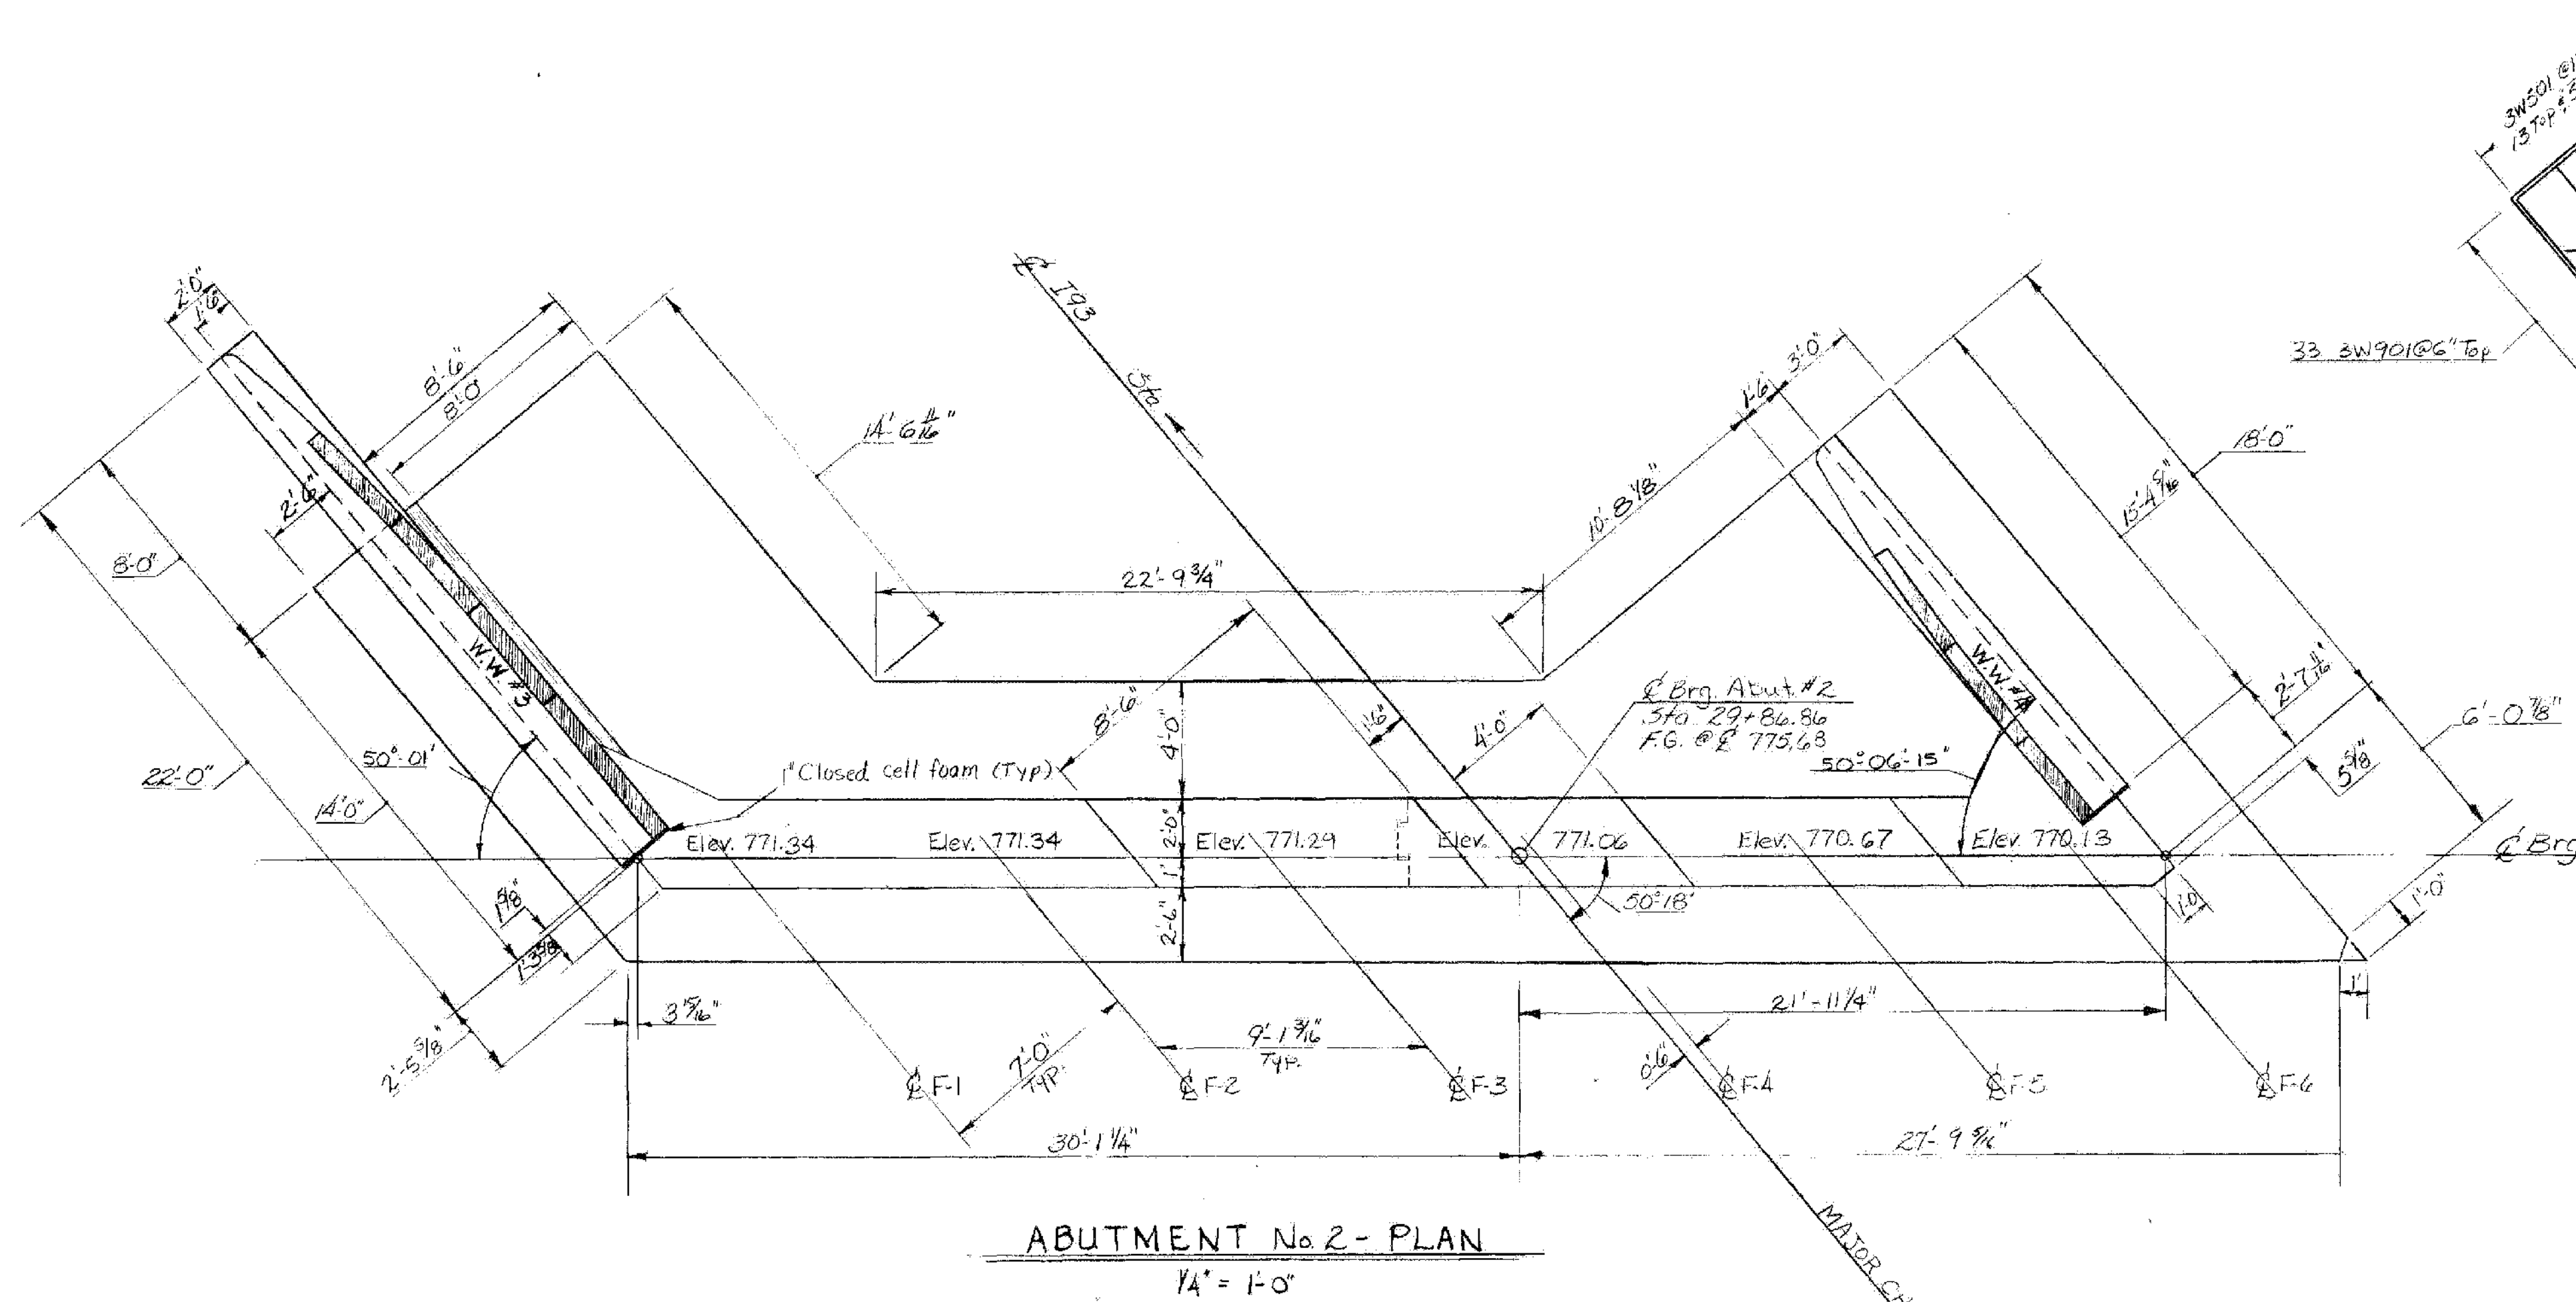


ABUTMENT No 2 - PLAN
1/4" = 1'-0"

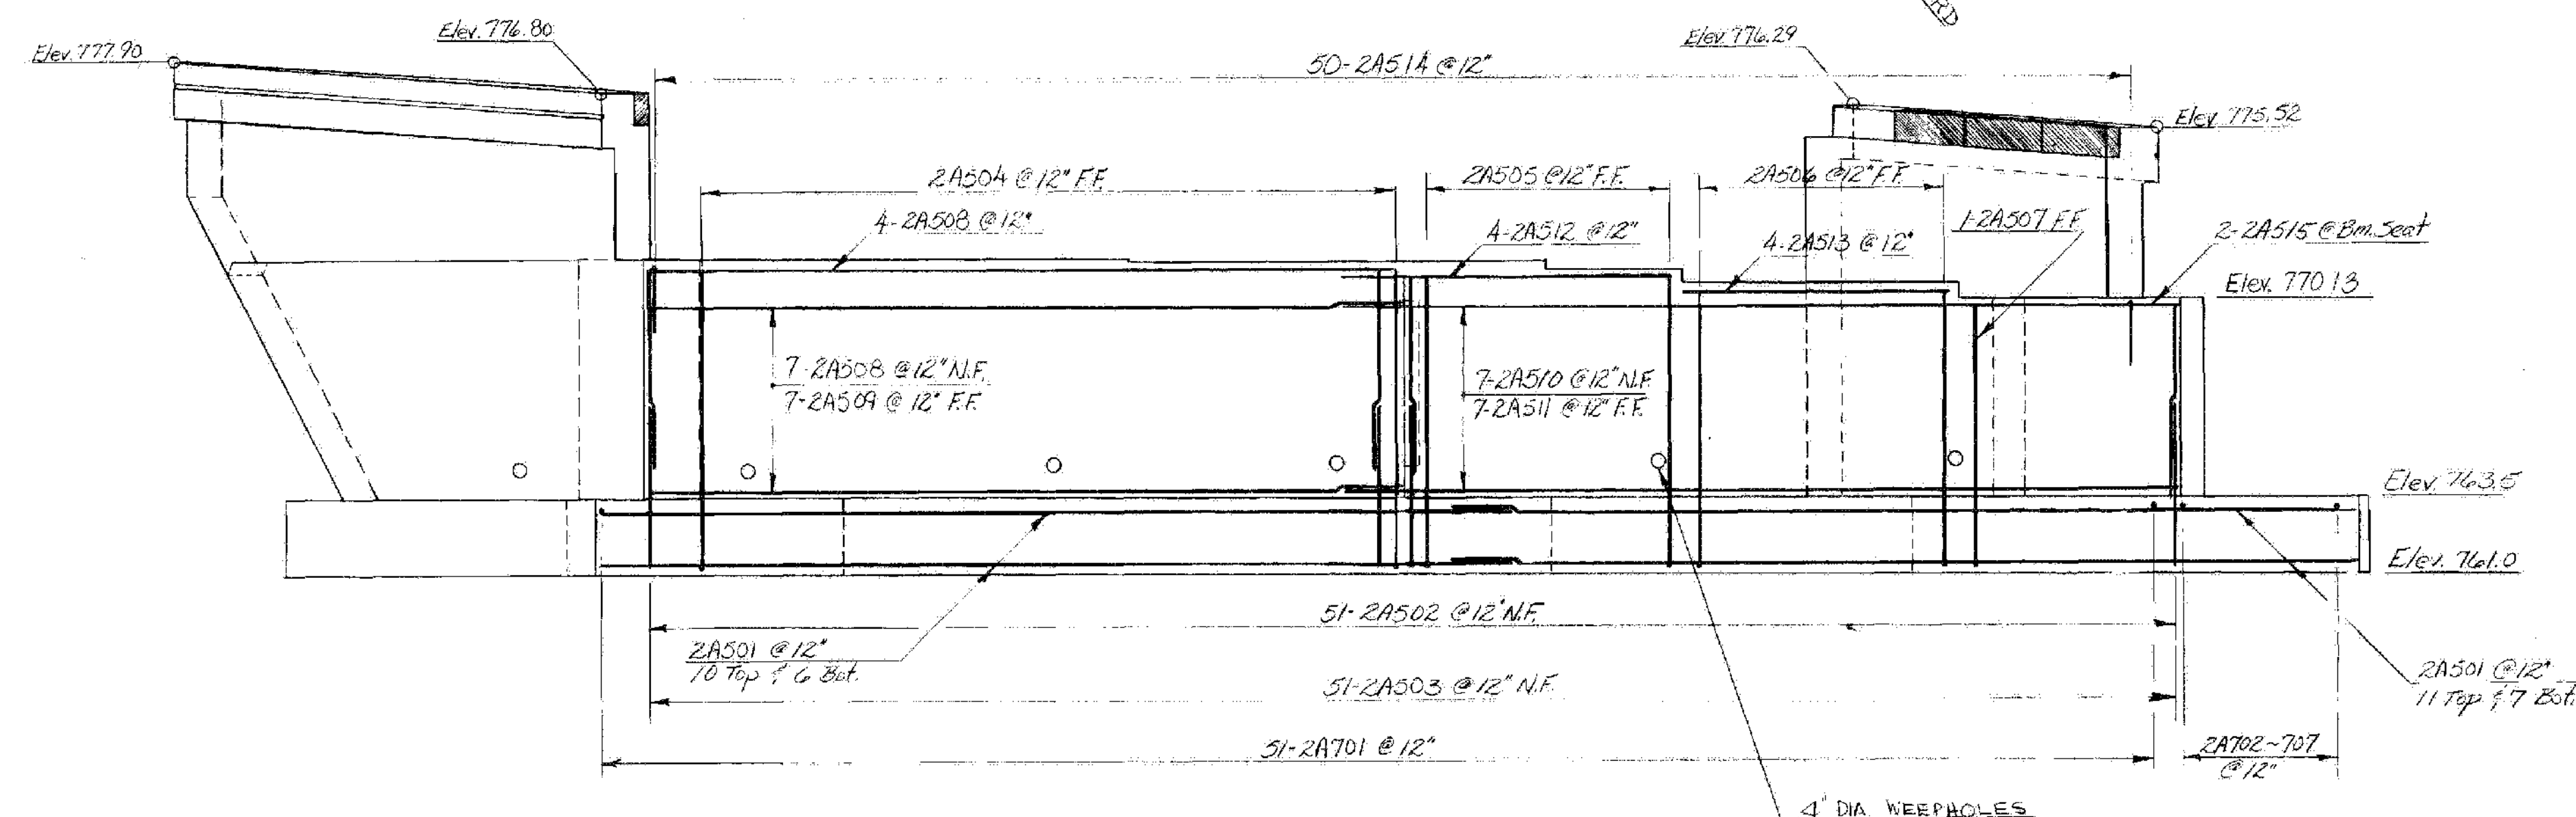

ABUTMENT No 2 - ELEV.
1/4" = 1'-0"

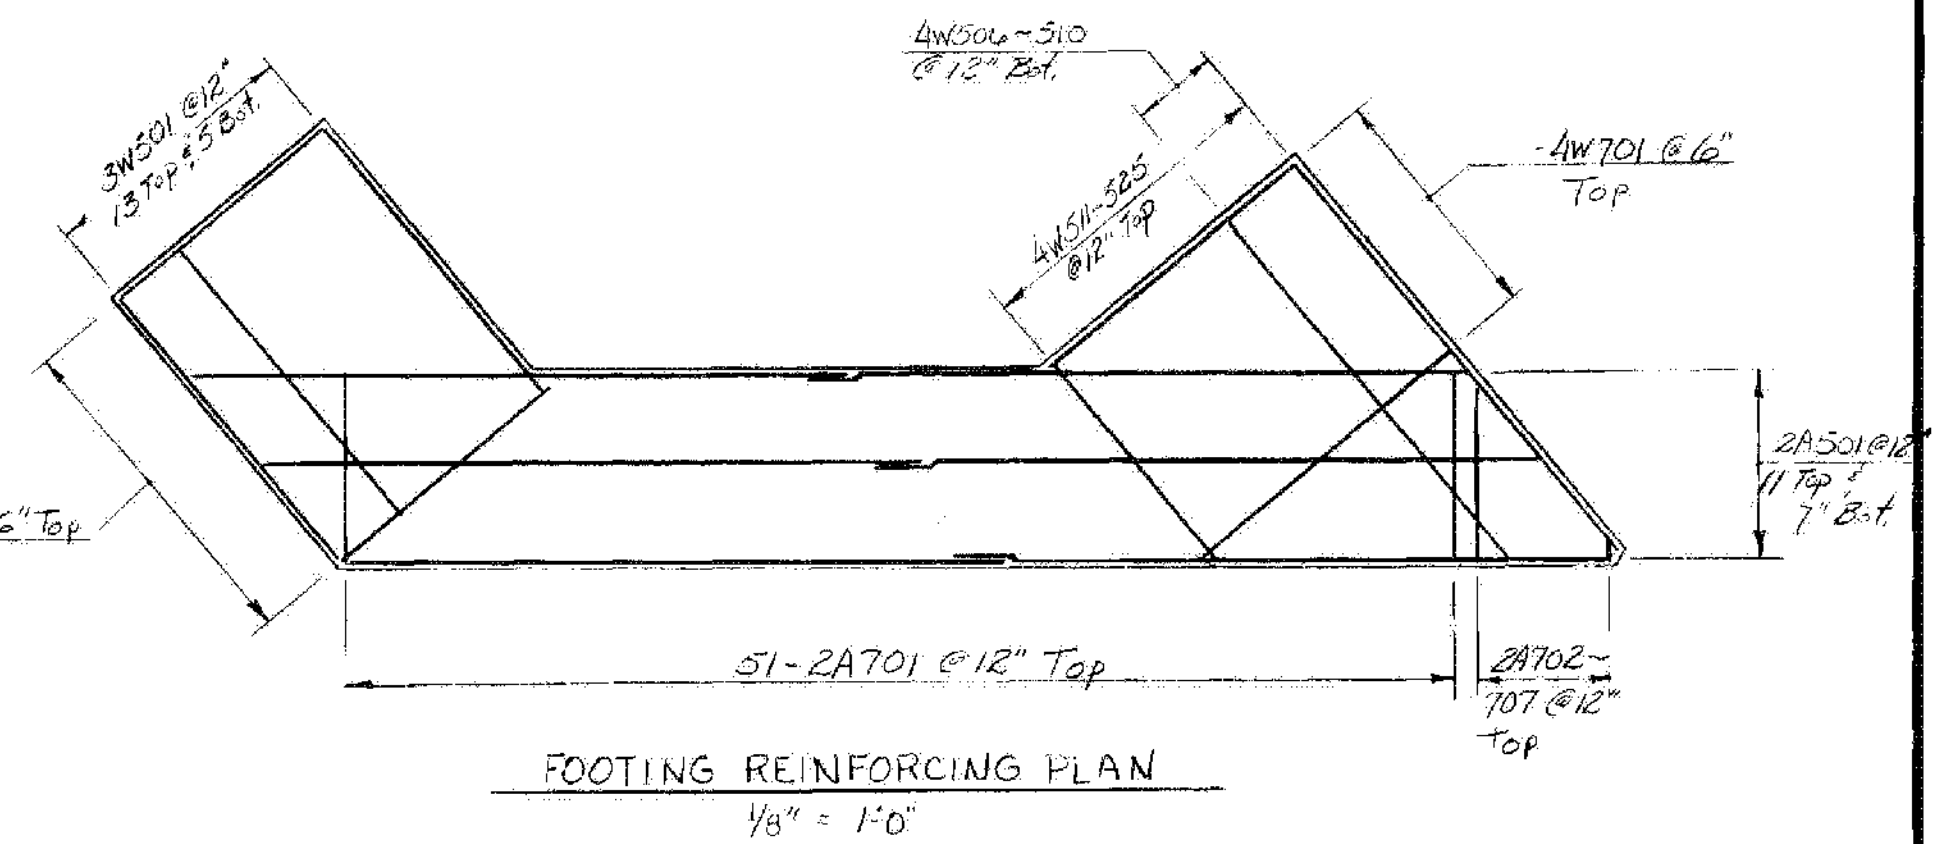


FOOTING REINFORCING PLAN
1/8" = 1'-0"

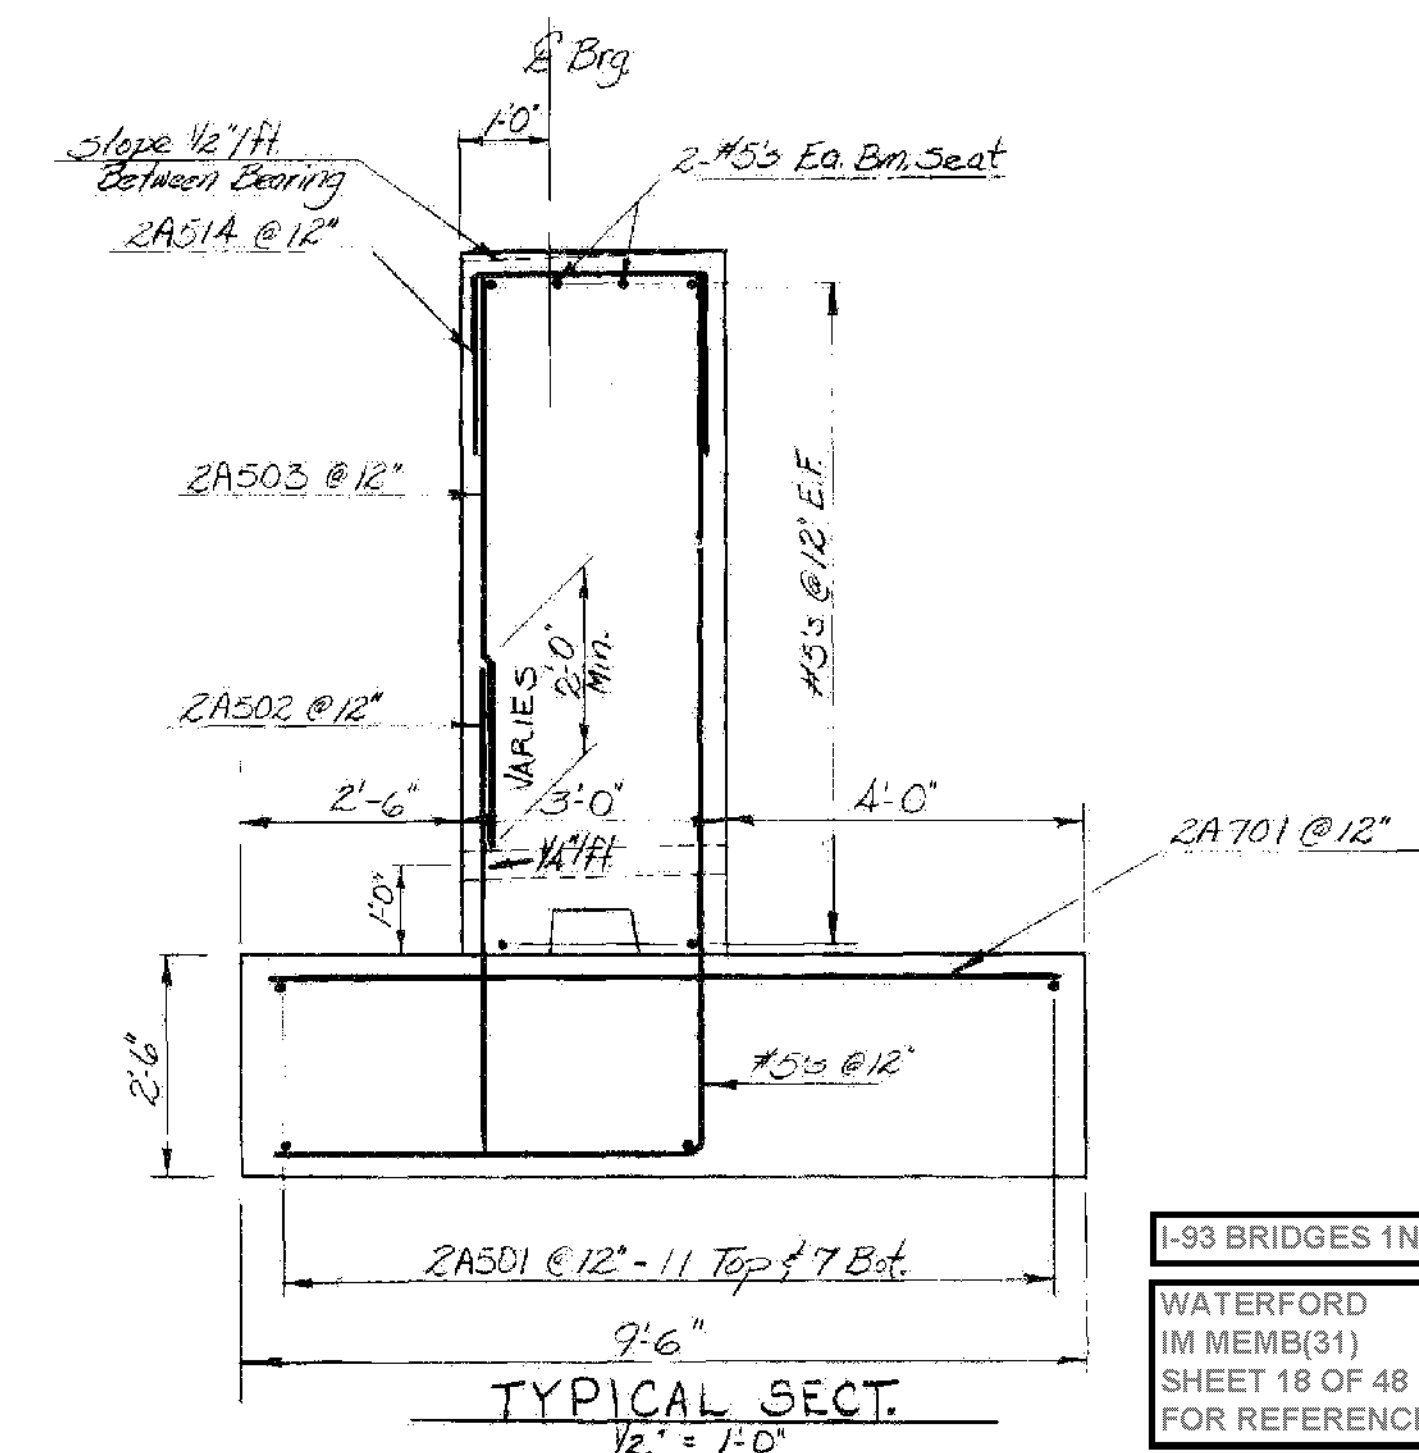


TYPICAL SECT.
1/2" = 1'-0"

I-93 BRIDGES 1N&S
WATERFORD
IM MEMB(31)
SHEET 18 OF 48
FOR REFERENCE ONLY


STATE OF VERMONT	
AGENCY OF TRANSPORTATION	
TOWN OF WATERFORD	Bridge No. 1 SB
HIGHWAY NO. I93	Log Sta.
I93 NB & SB Over Vt. Rte 18	Surv. Sta. 28+0
S.B. ABUTMENT 2 DETAILS	
Designed by G. Spilak	Drawn by R. Whitcomb
Checked by A. Elwood date 6-80	Bridge Design Supervisor R.S. WAUPT date 6-80
PROJECT CONTRACT I	PROJECT NO.
WATERFORD	I93-1(3)
Bridge Sheet No. BR 113	Sheet 143 of 489

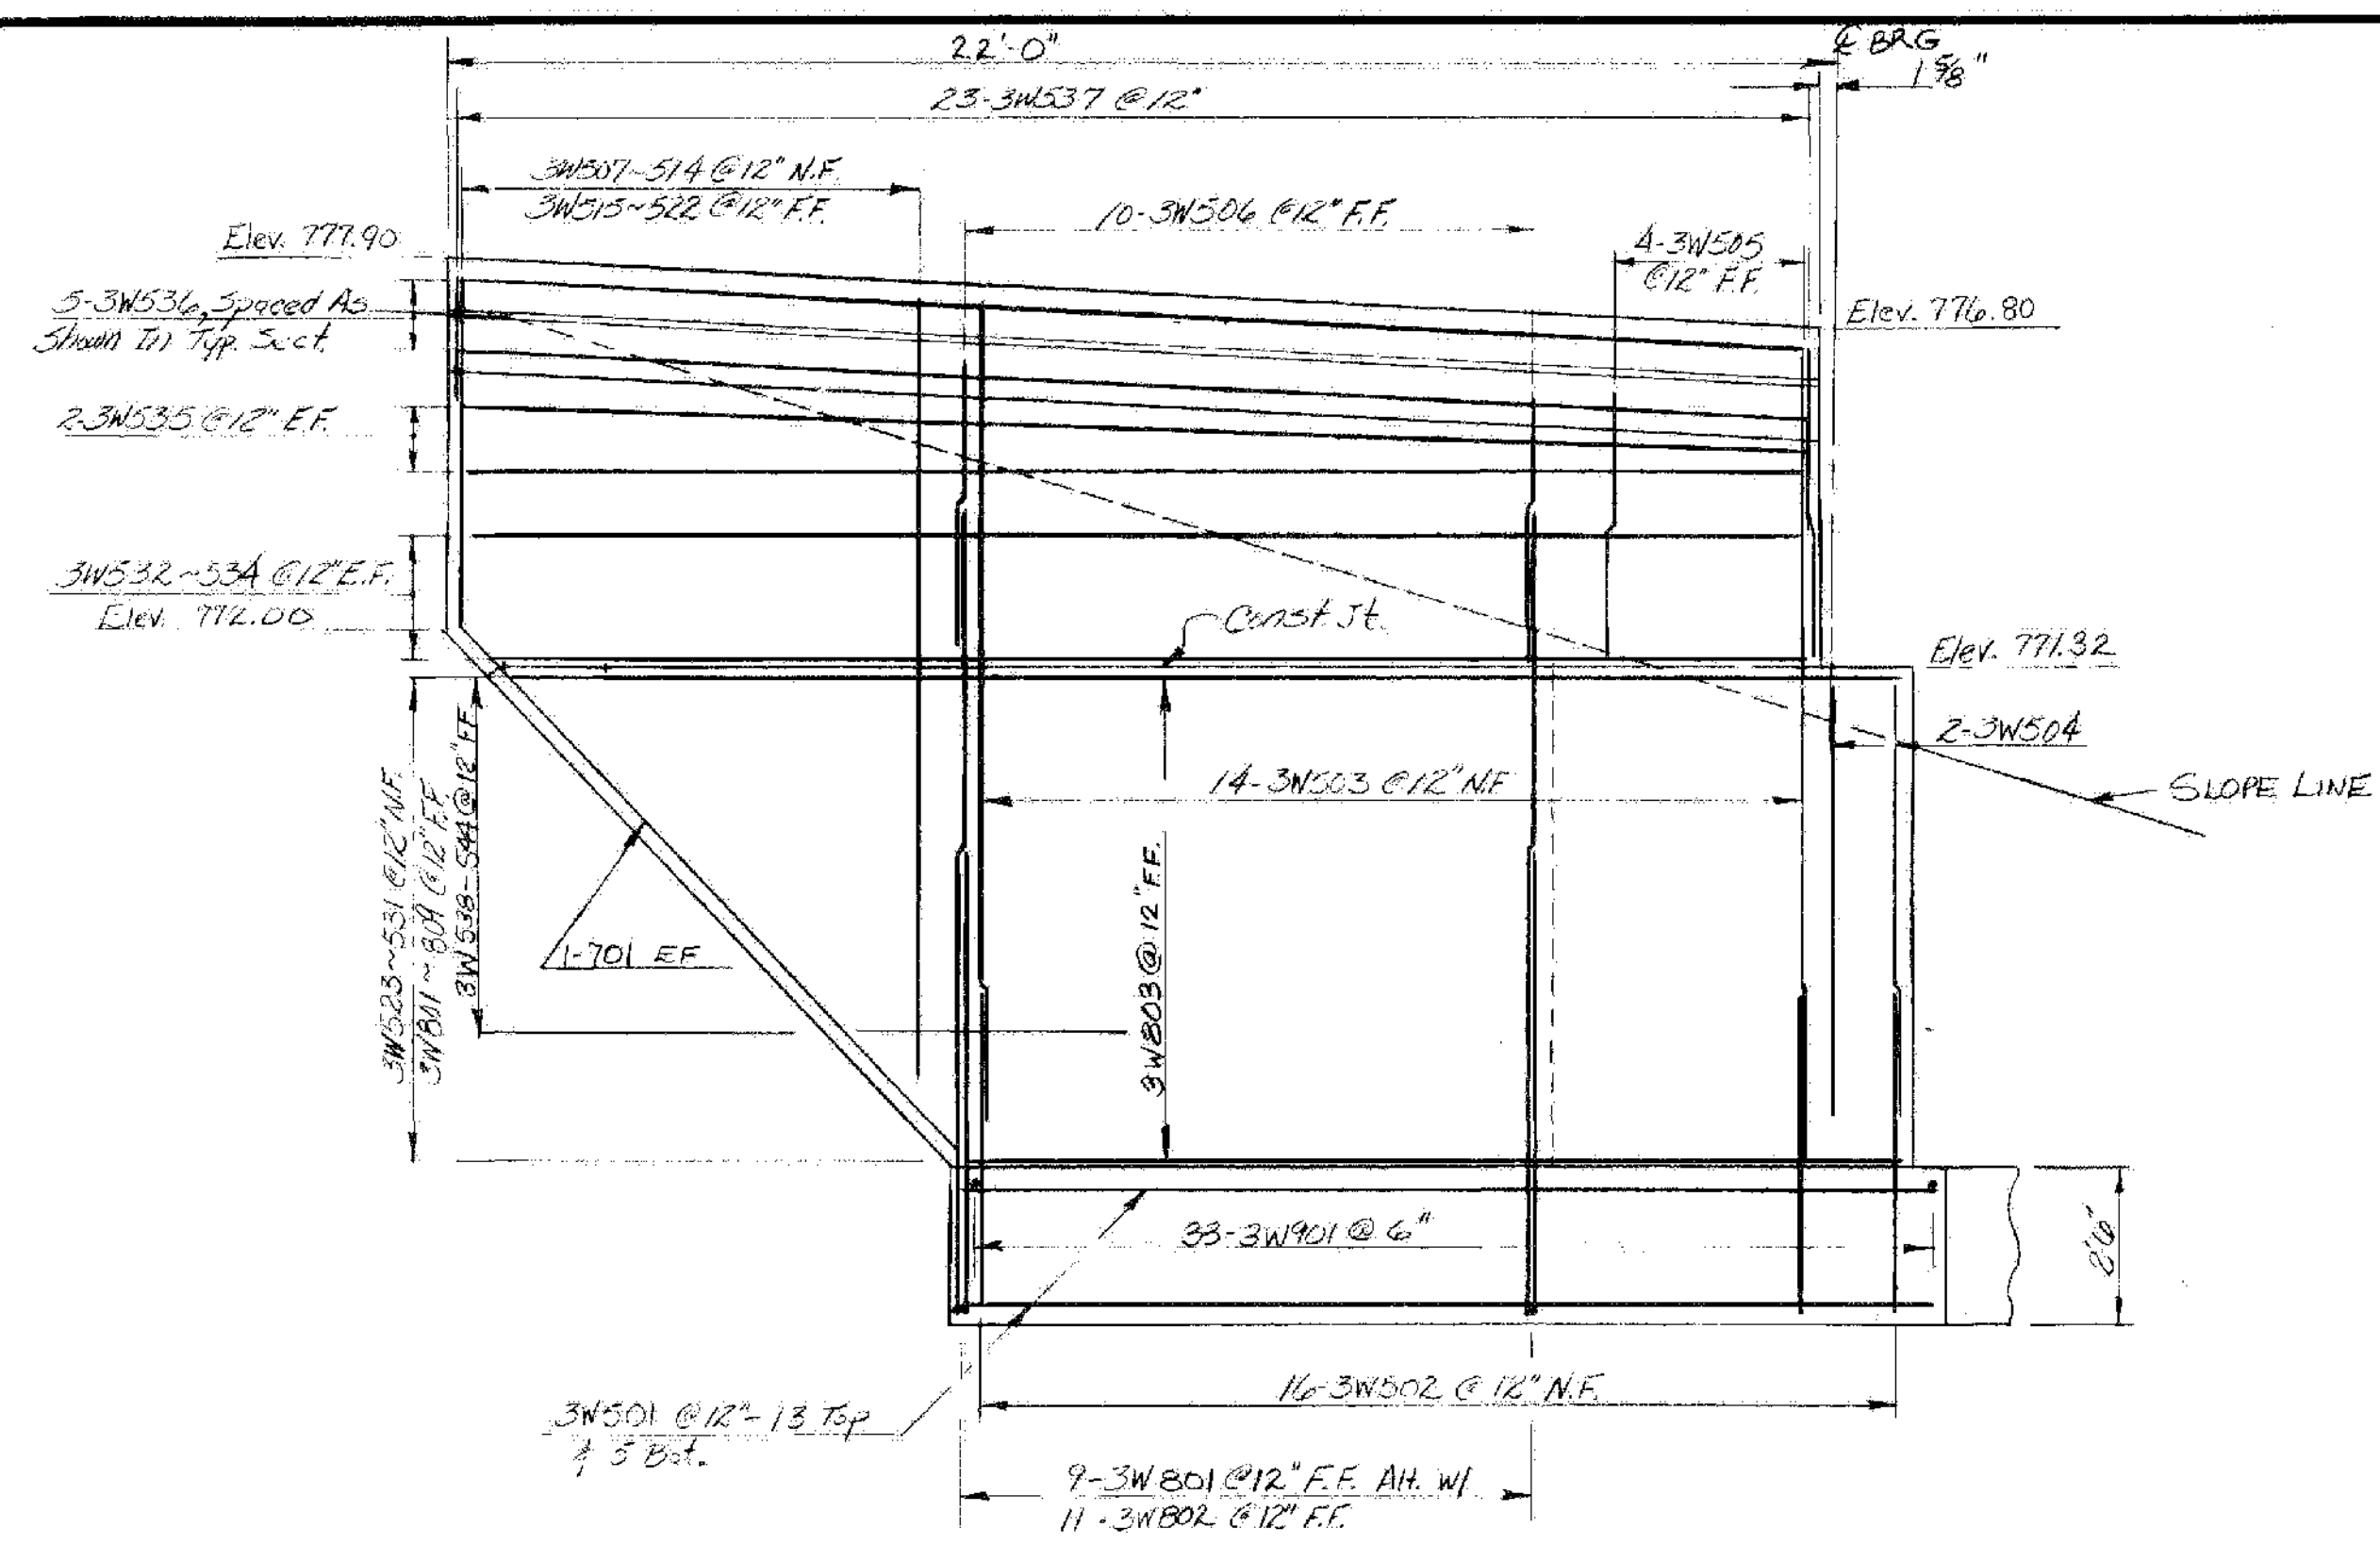


ELEVATION
WINGWALL No. 3
 3/8" = 1'-0"

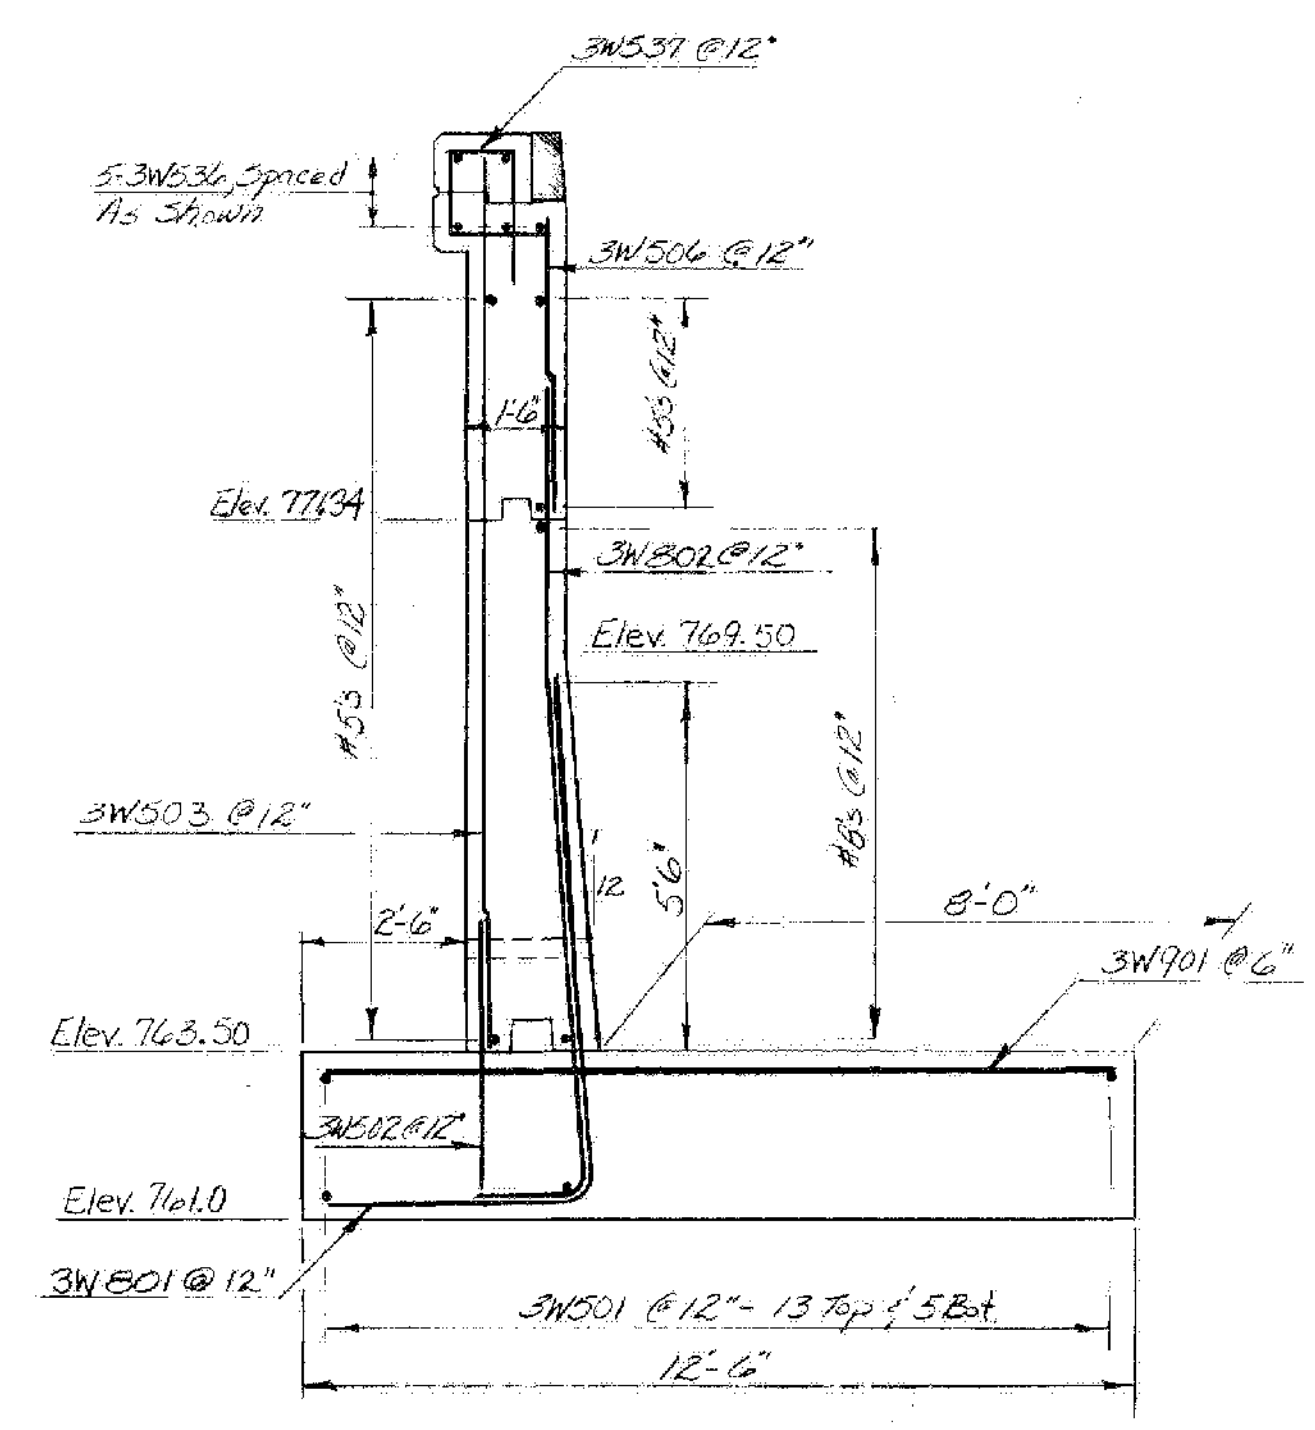


TYPICAL SECTION

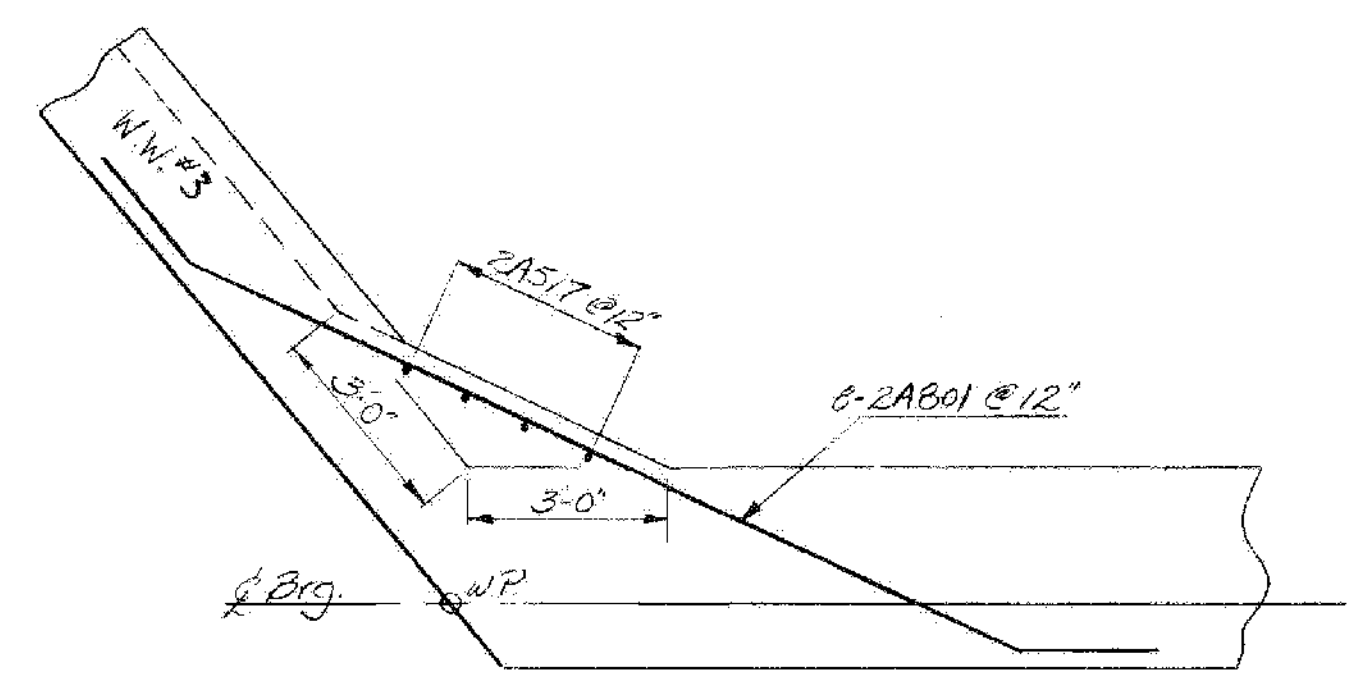


FILLET DETAIL
 3/8" = 1'-0"

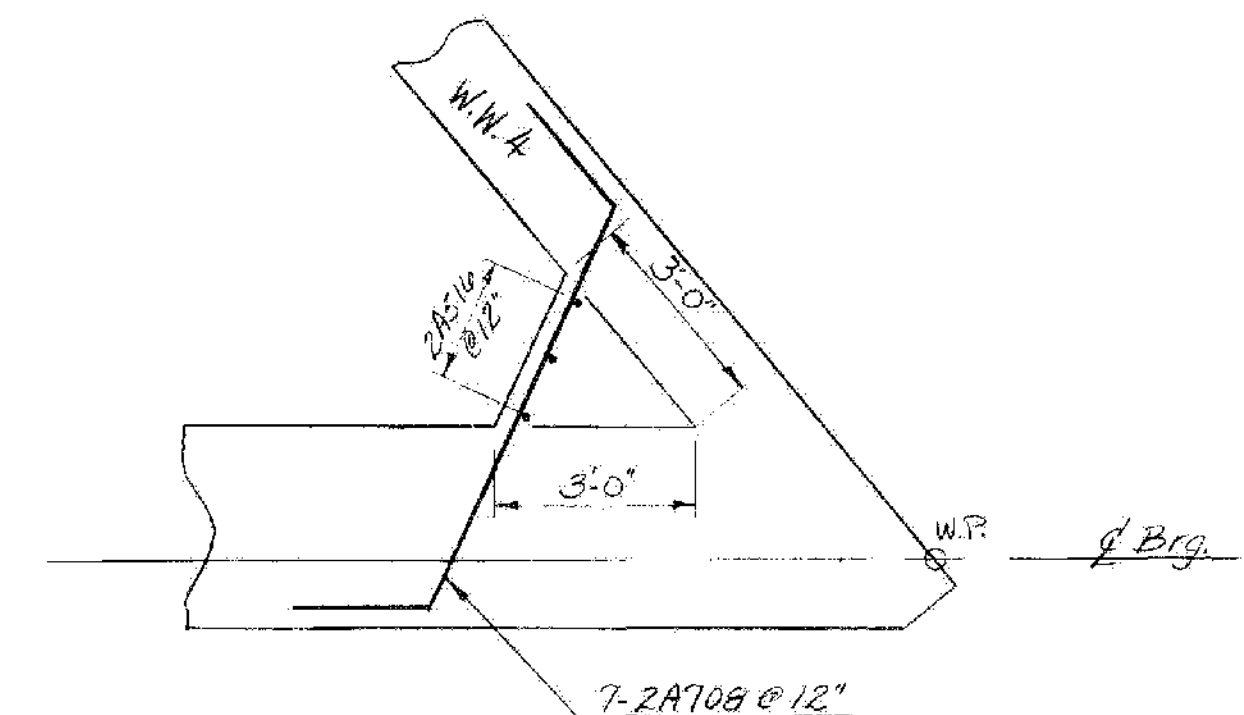

FILLET DETAIL
 3/8" = 1'-0"

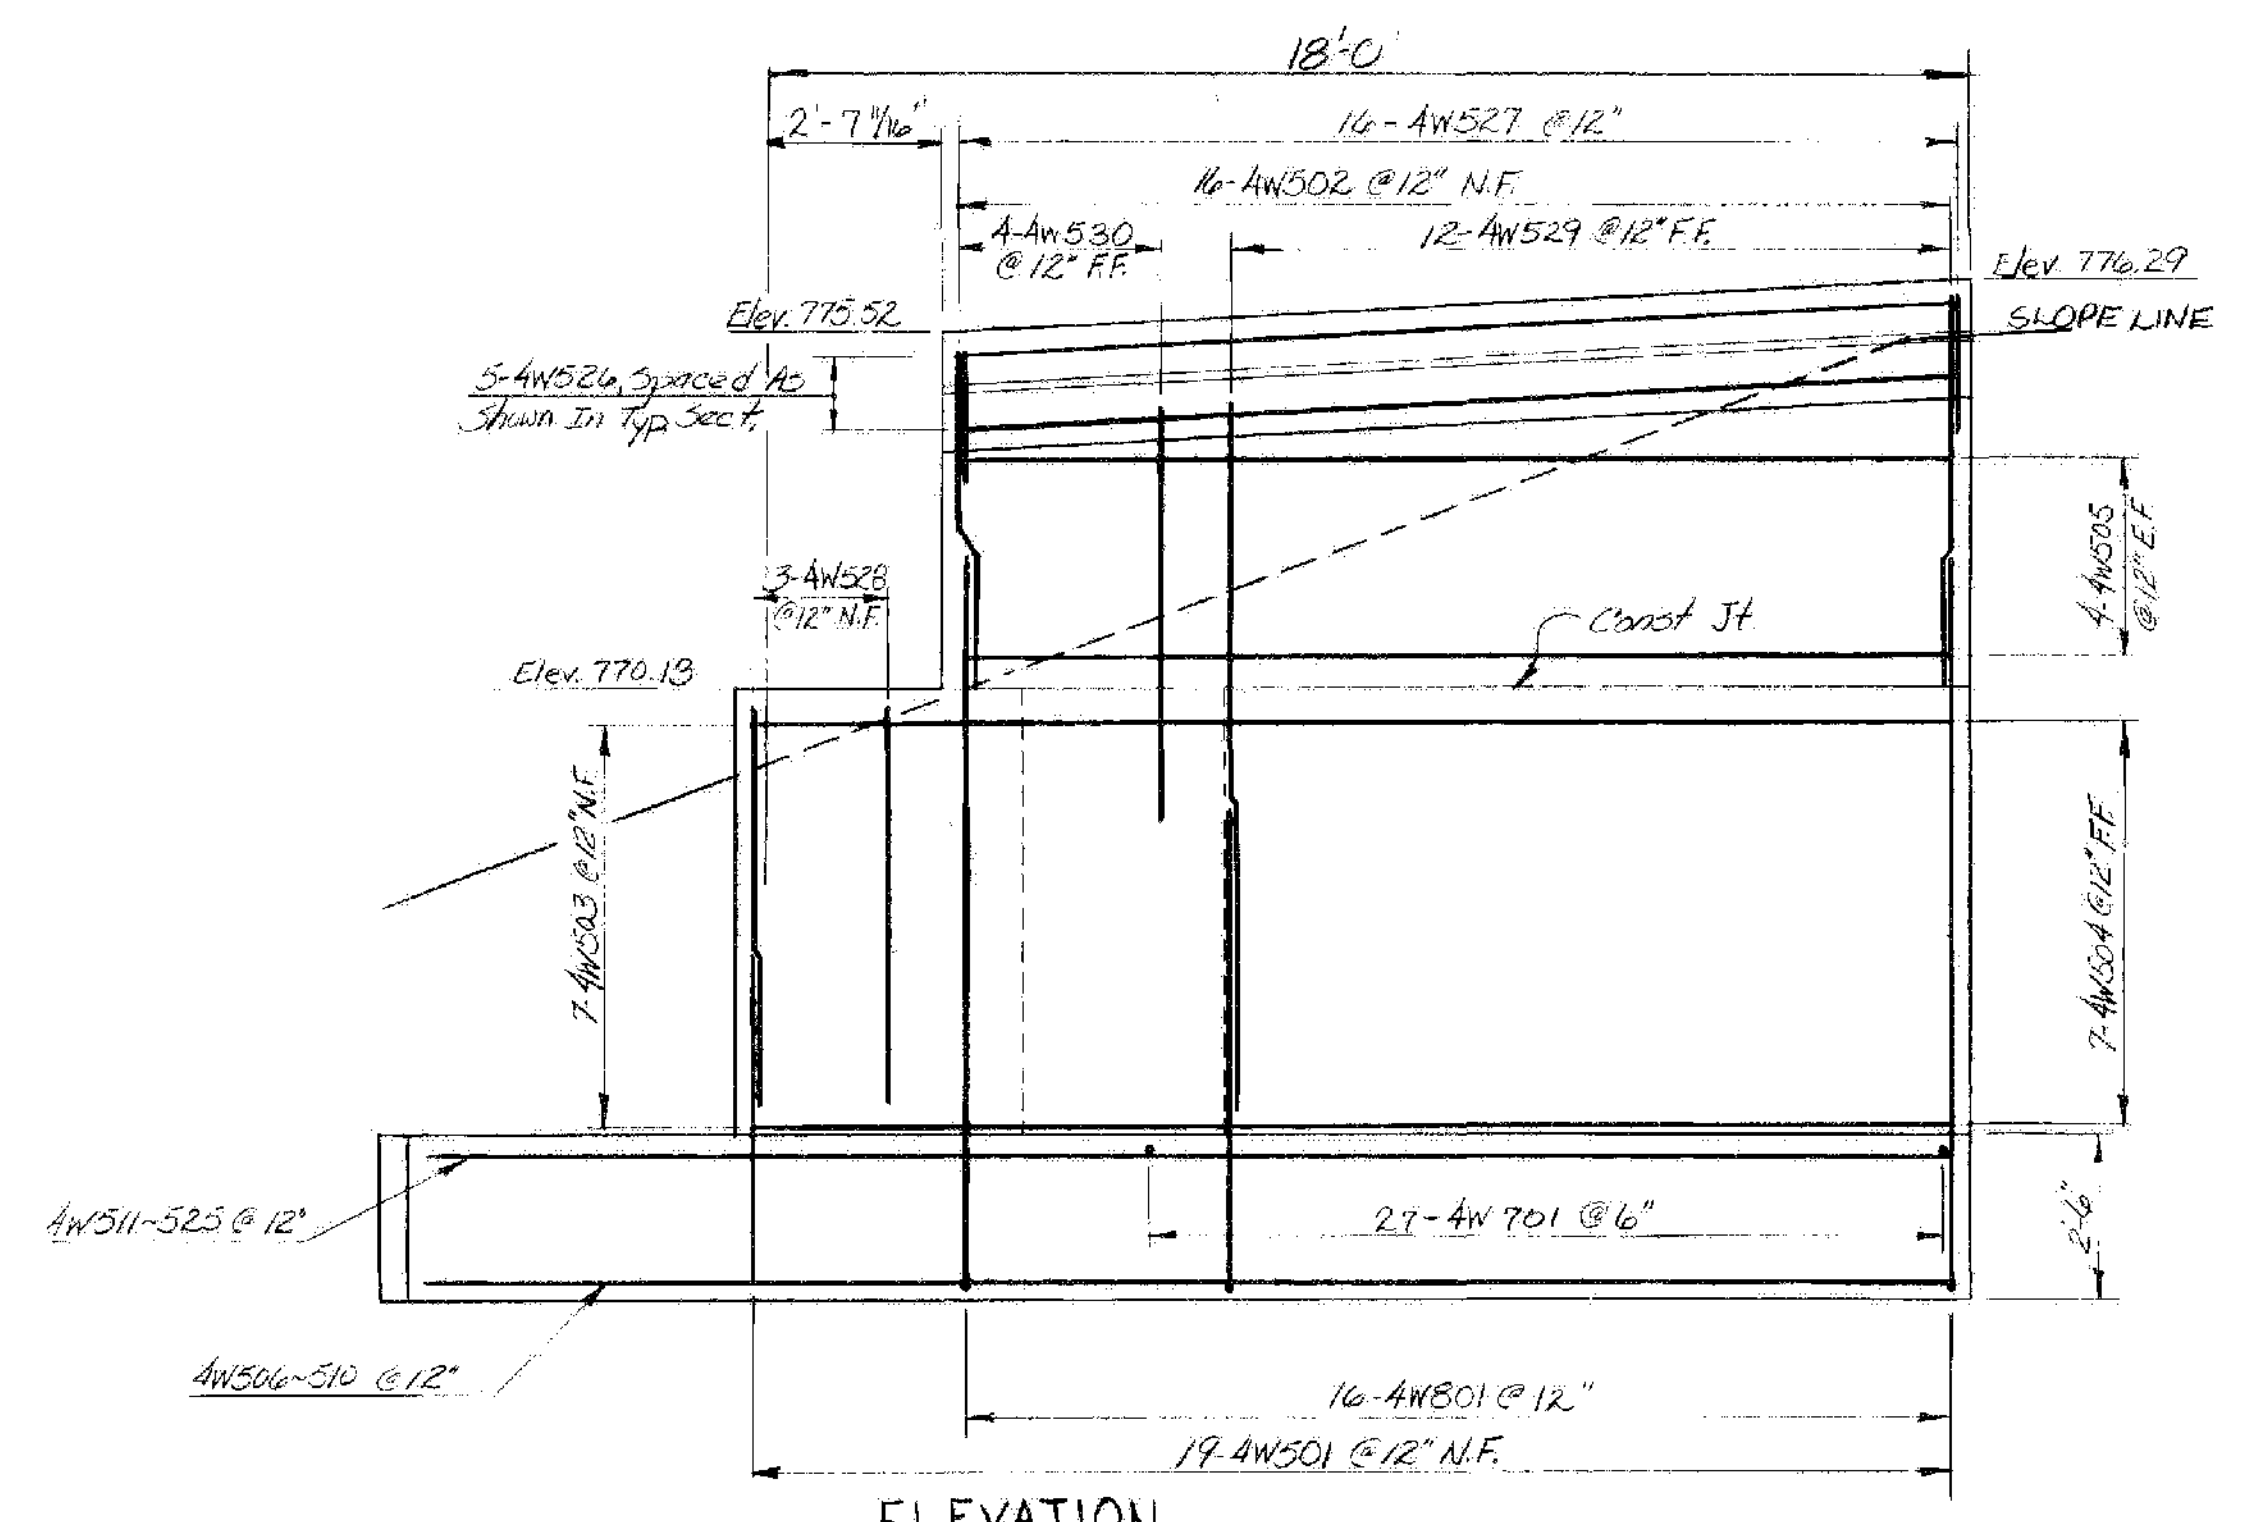


ELEVATION
WINGWALL No. 4
 3/8" = 1'-0"

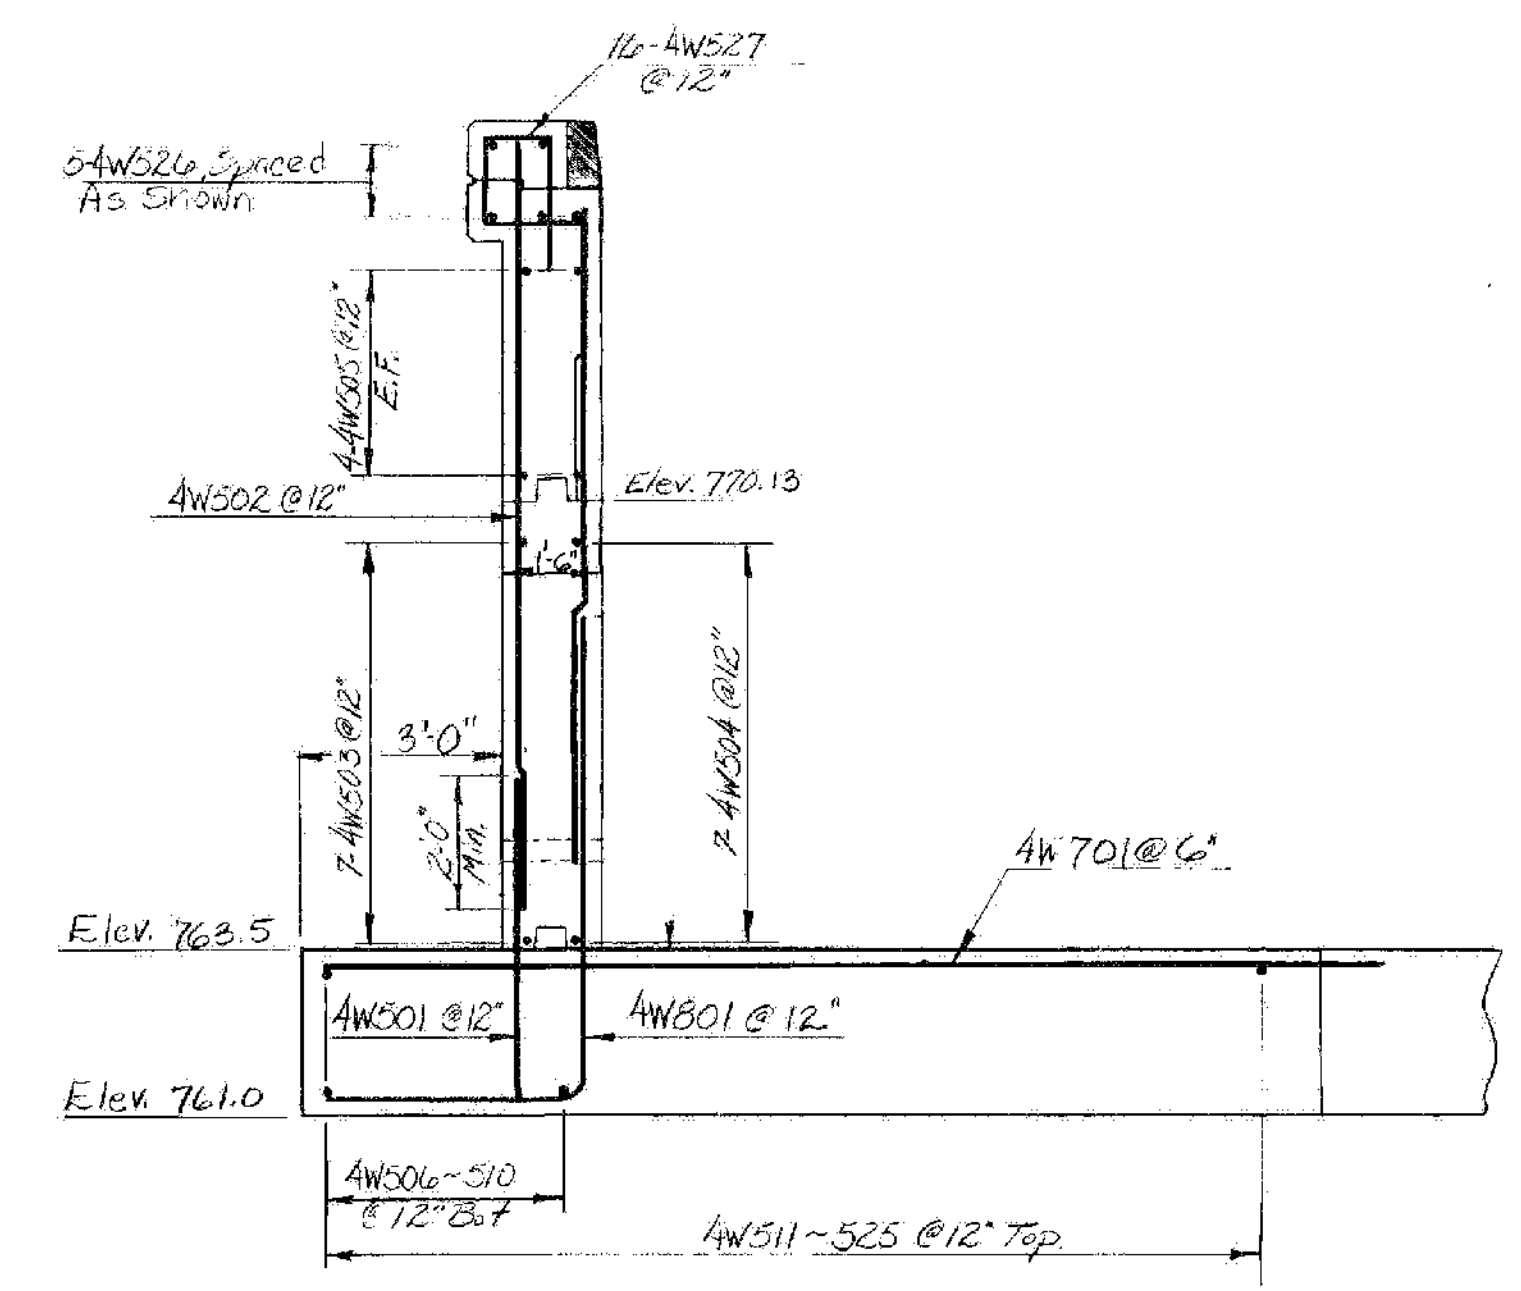

TYPICAL SECTION


I-93 BRIDGES 1N&S
 WATERFORD
 IM MEMB(31)
 SHEET 19 OF 48
 FOR REFERENCE ONLY

STATE OF VERMONT	
AGENCY OF TRANSPORTATION	
TOWN OF WATERFORD	Bridge No. 1 SB
HIGHWAY NO. I93	Log Sta. Surv. Sta. 28+0
I93 N.B. # SB Over Vt. Rte. 18	
S.B. WINGWALLS No 3 & 4 DETAILS	
Designed by G. Spilak	Drawn by R. Whitcomb
Checked by A. Elwood date 6-80	Bridge Design Supervisor R.S. HAUPT date 6-80
PROJECT CONTRACT I WATERFORD	PROJECT NO. I93-1(3)
Bridge Sheet No. BR14	Sheet 144 of 489

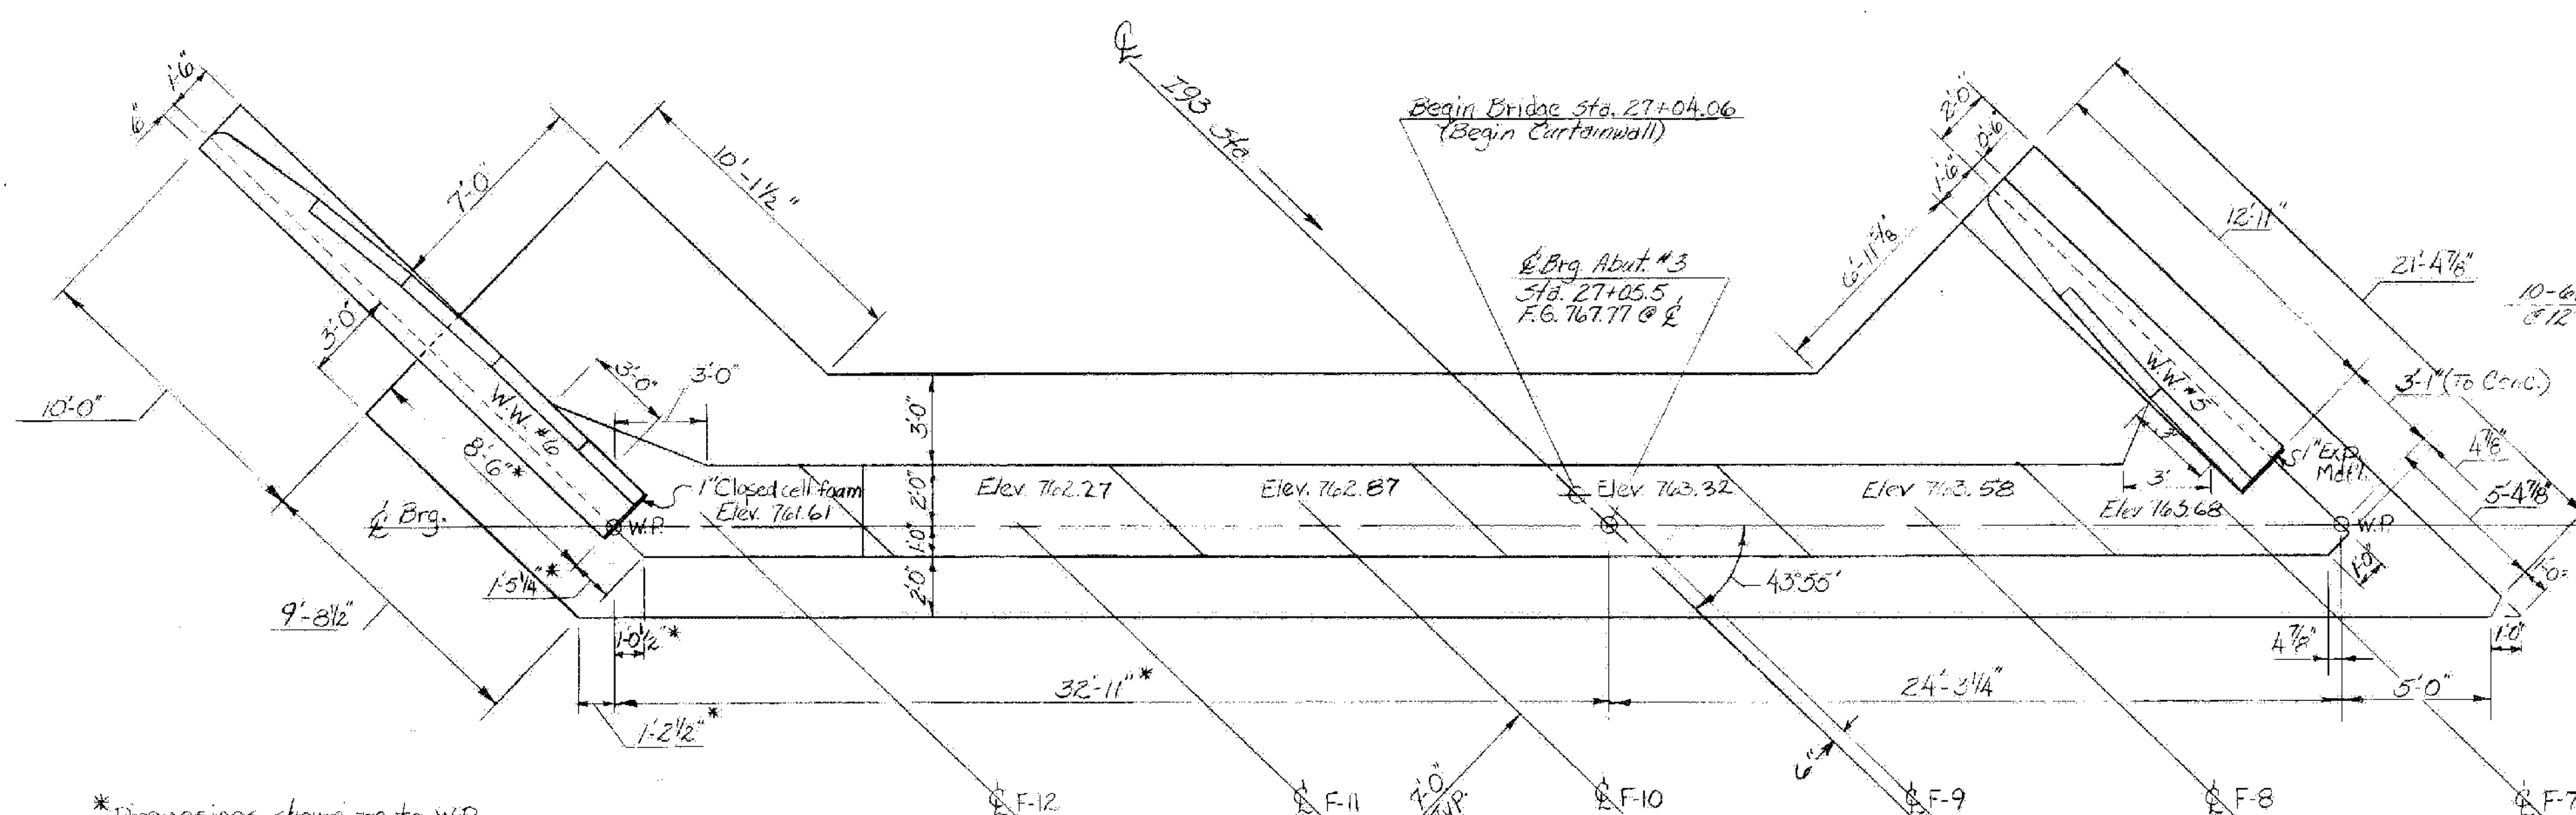


* Dimensions shown are to W.P. Dimension to wingwall (conc) from corner of abut. is 1'-4 7/8"


ABUT. 3 - PLAN
Scale: 1/4" = 1'-0"

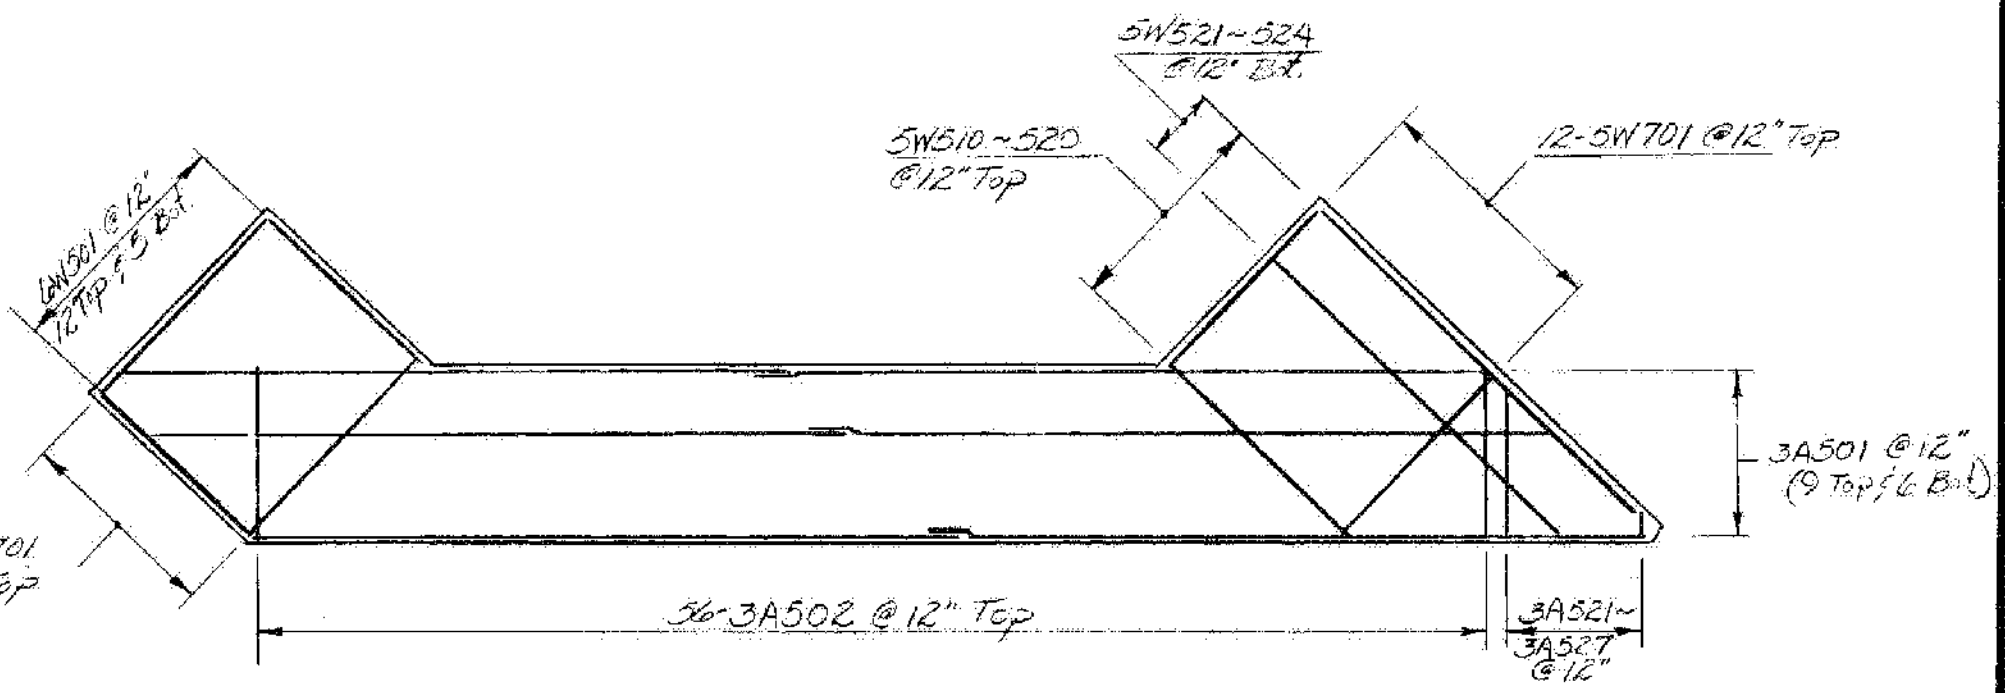

FOOTING REINFORCING PLAN
Scale 1/8" = 1'-0"

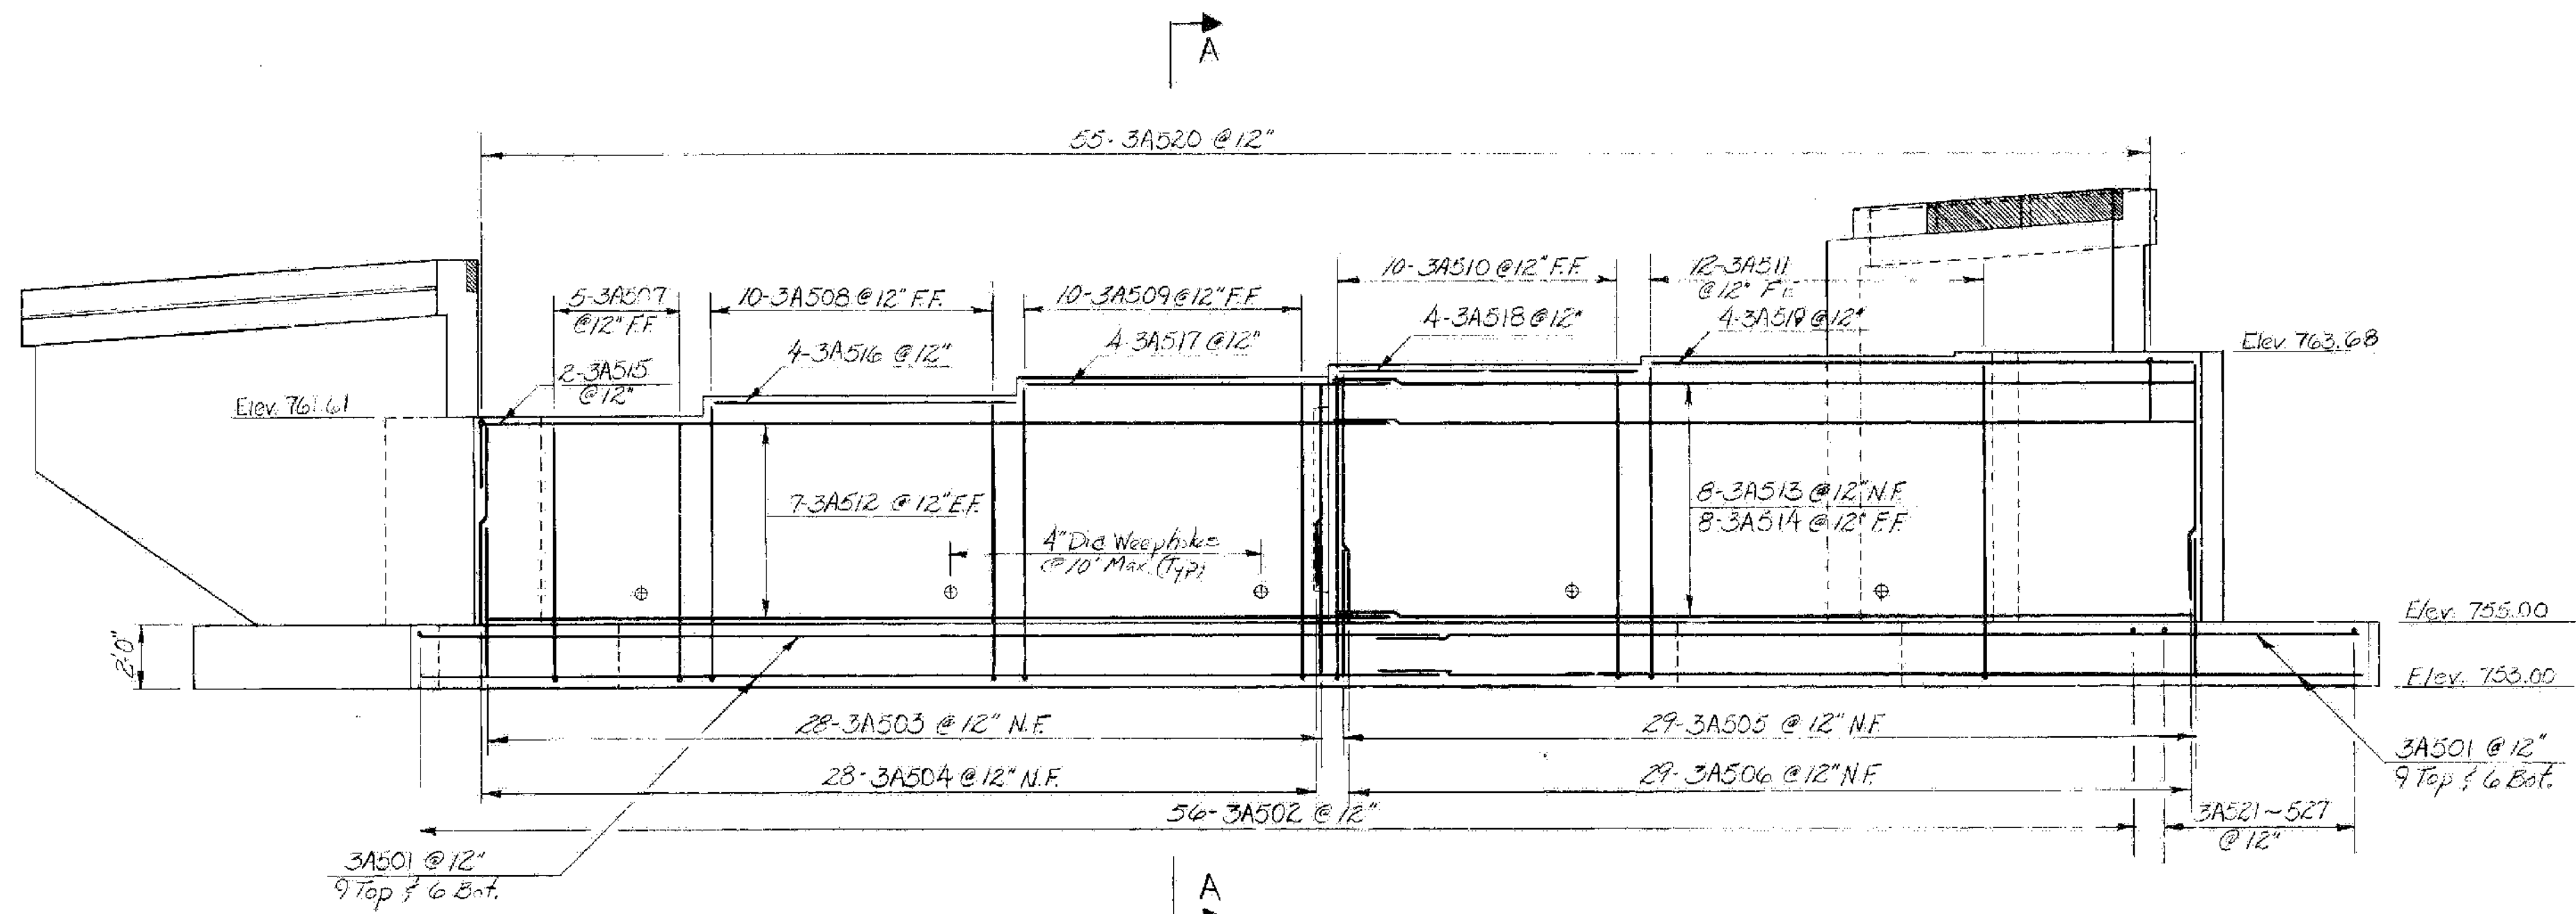


ABUT. 3 - ELEV.
Scale: 1/4" = 1'-0"

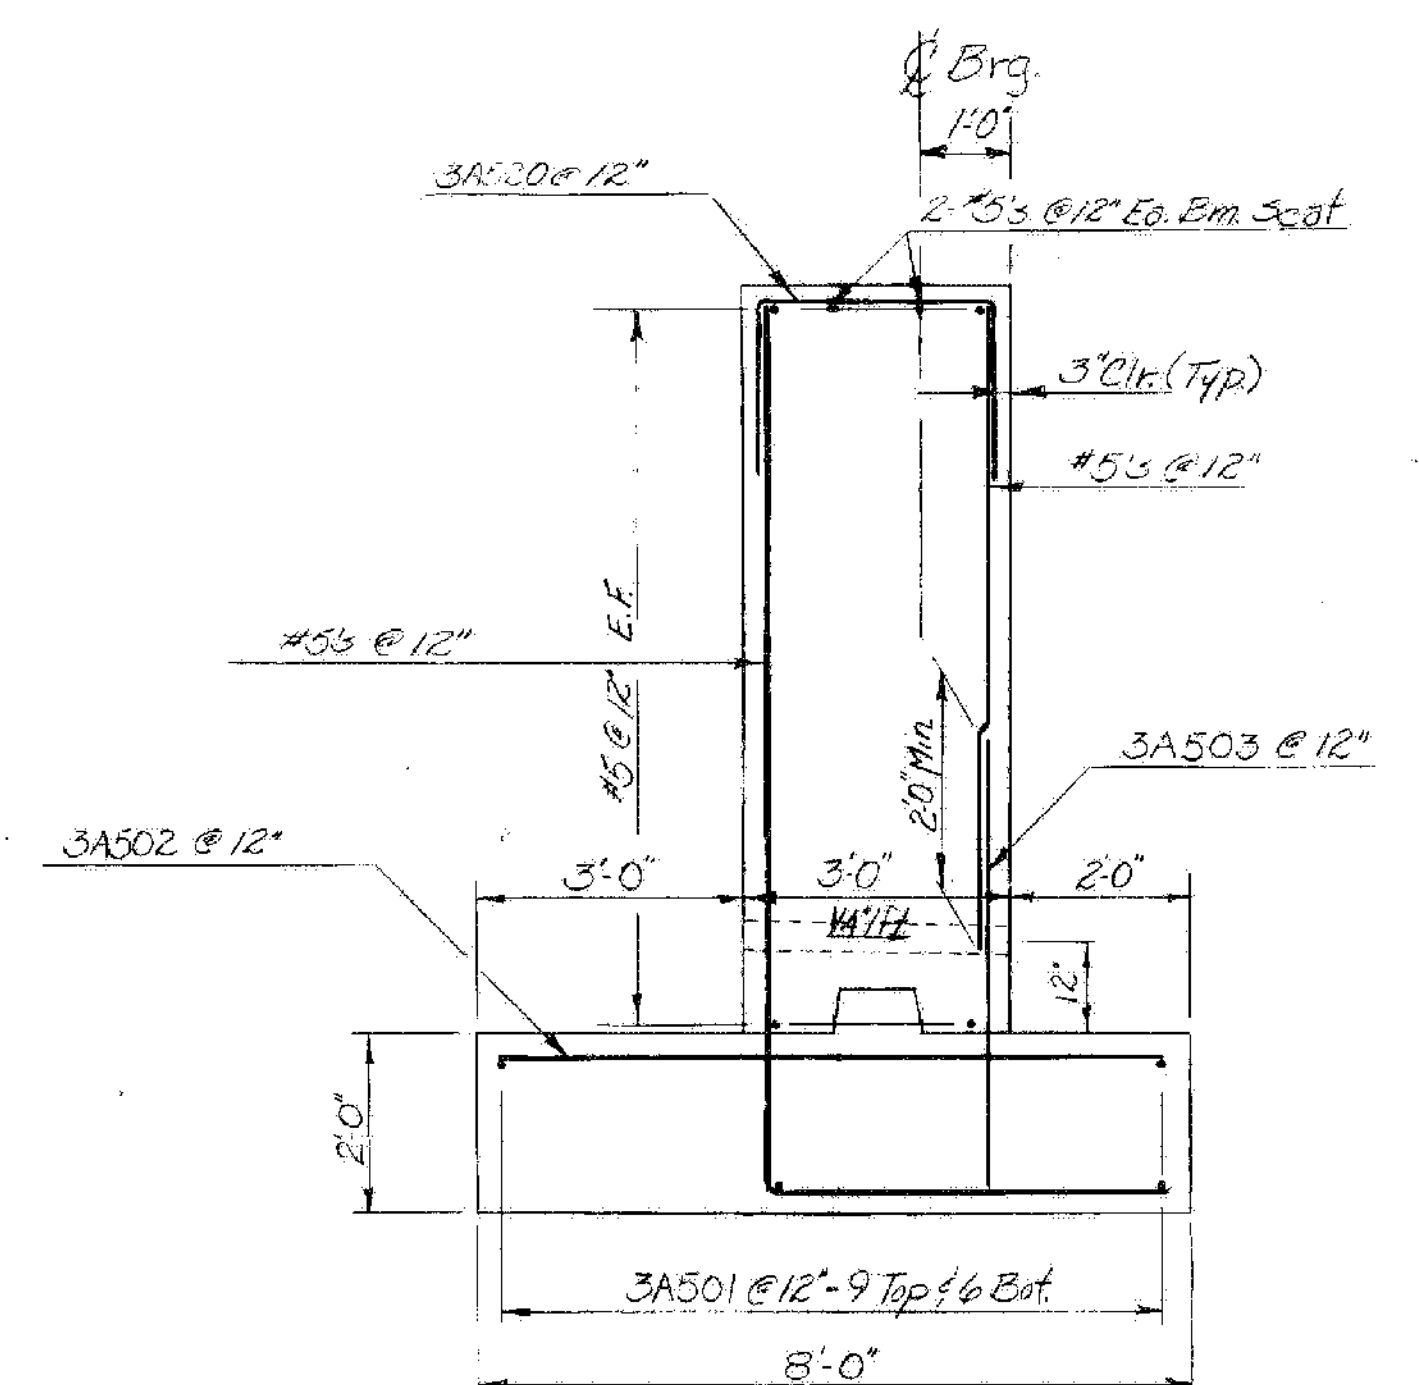


SECT. A-A
Scale 1/2" = 1'-0"

Note:
N.F = Near Face
F.F = Far Face
E.F = Each Face


STATE OF VERMONT		I-93 BRIDGES 1N&S	
AGENCY OF TRANSPORTATION		WATERFORD IM MEMB(31) SHEET 20 OF 48 FOR REFERENCE ONLY	
TOWN OF	WATERFORD	Bridge No.	1 NB
HIGHWAY NO.	I93	Log Sta.	
		Surv. Sta.	28+0
I93 N.B. / S.B. Over Vt. Rte. 18			
N.B. ABUT. 3 DETAILS			
Designed by	A. Elwood	Drawn by	R. Whitcomb
Checked by	G.V.S.	Bridge Design Supervisor	R.S. HAUPT
	date 5-22-80	date	6-80
PROJECT	CONTRACT I WATERFORD	PROJECT NO.	I93-1(3)
Bridge Sheet No.	BR 116	Sheet	145 of 489

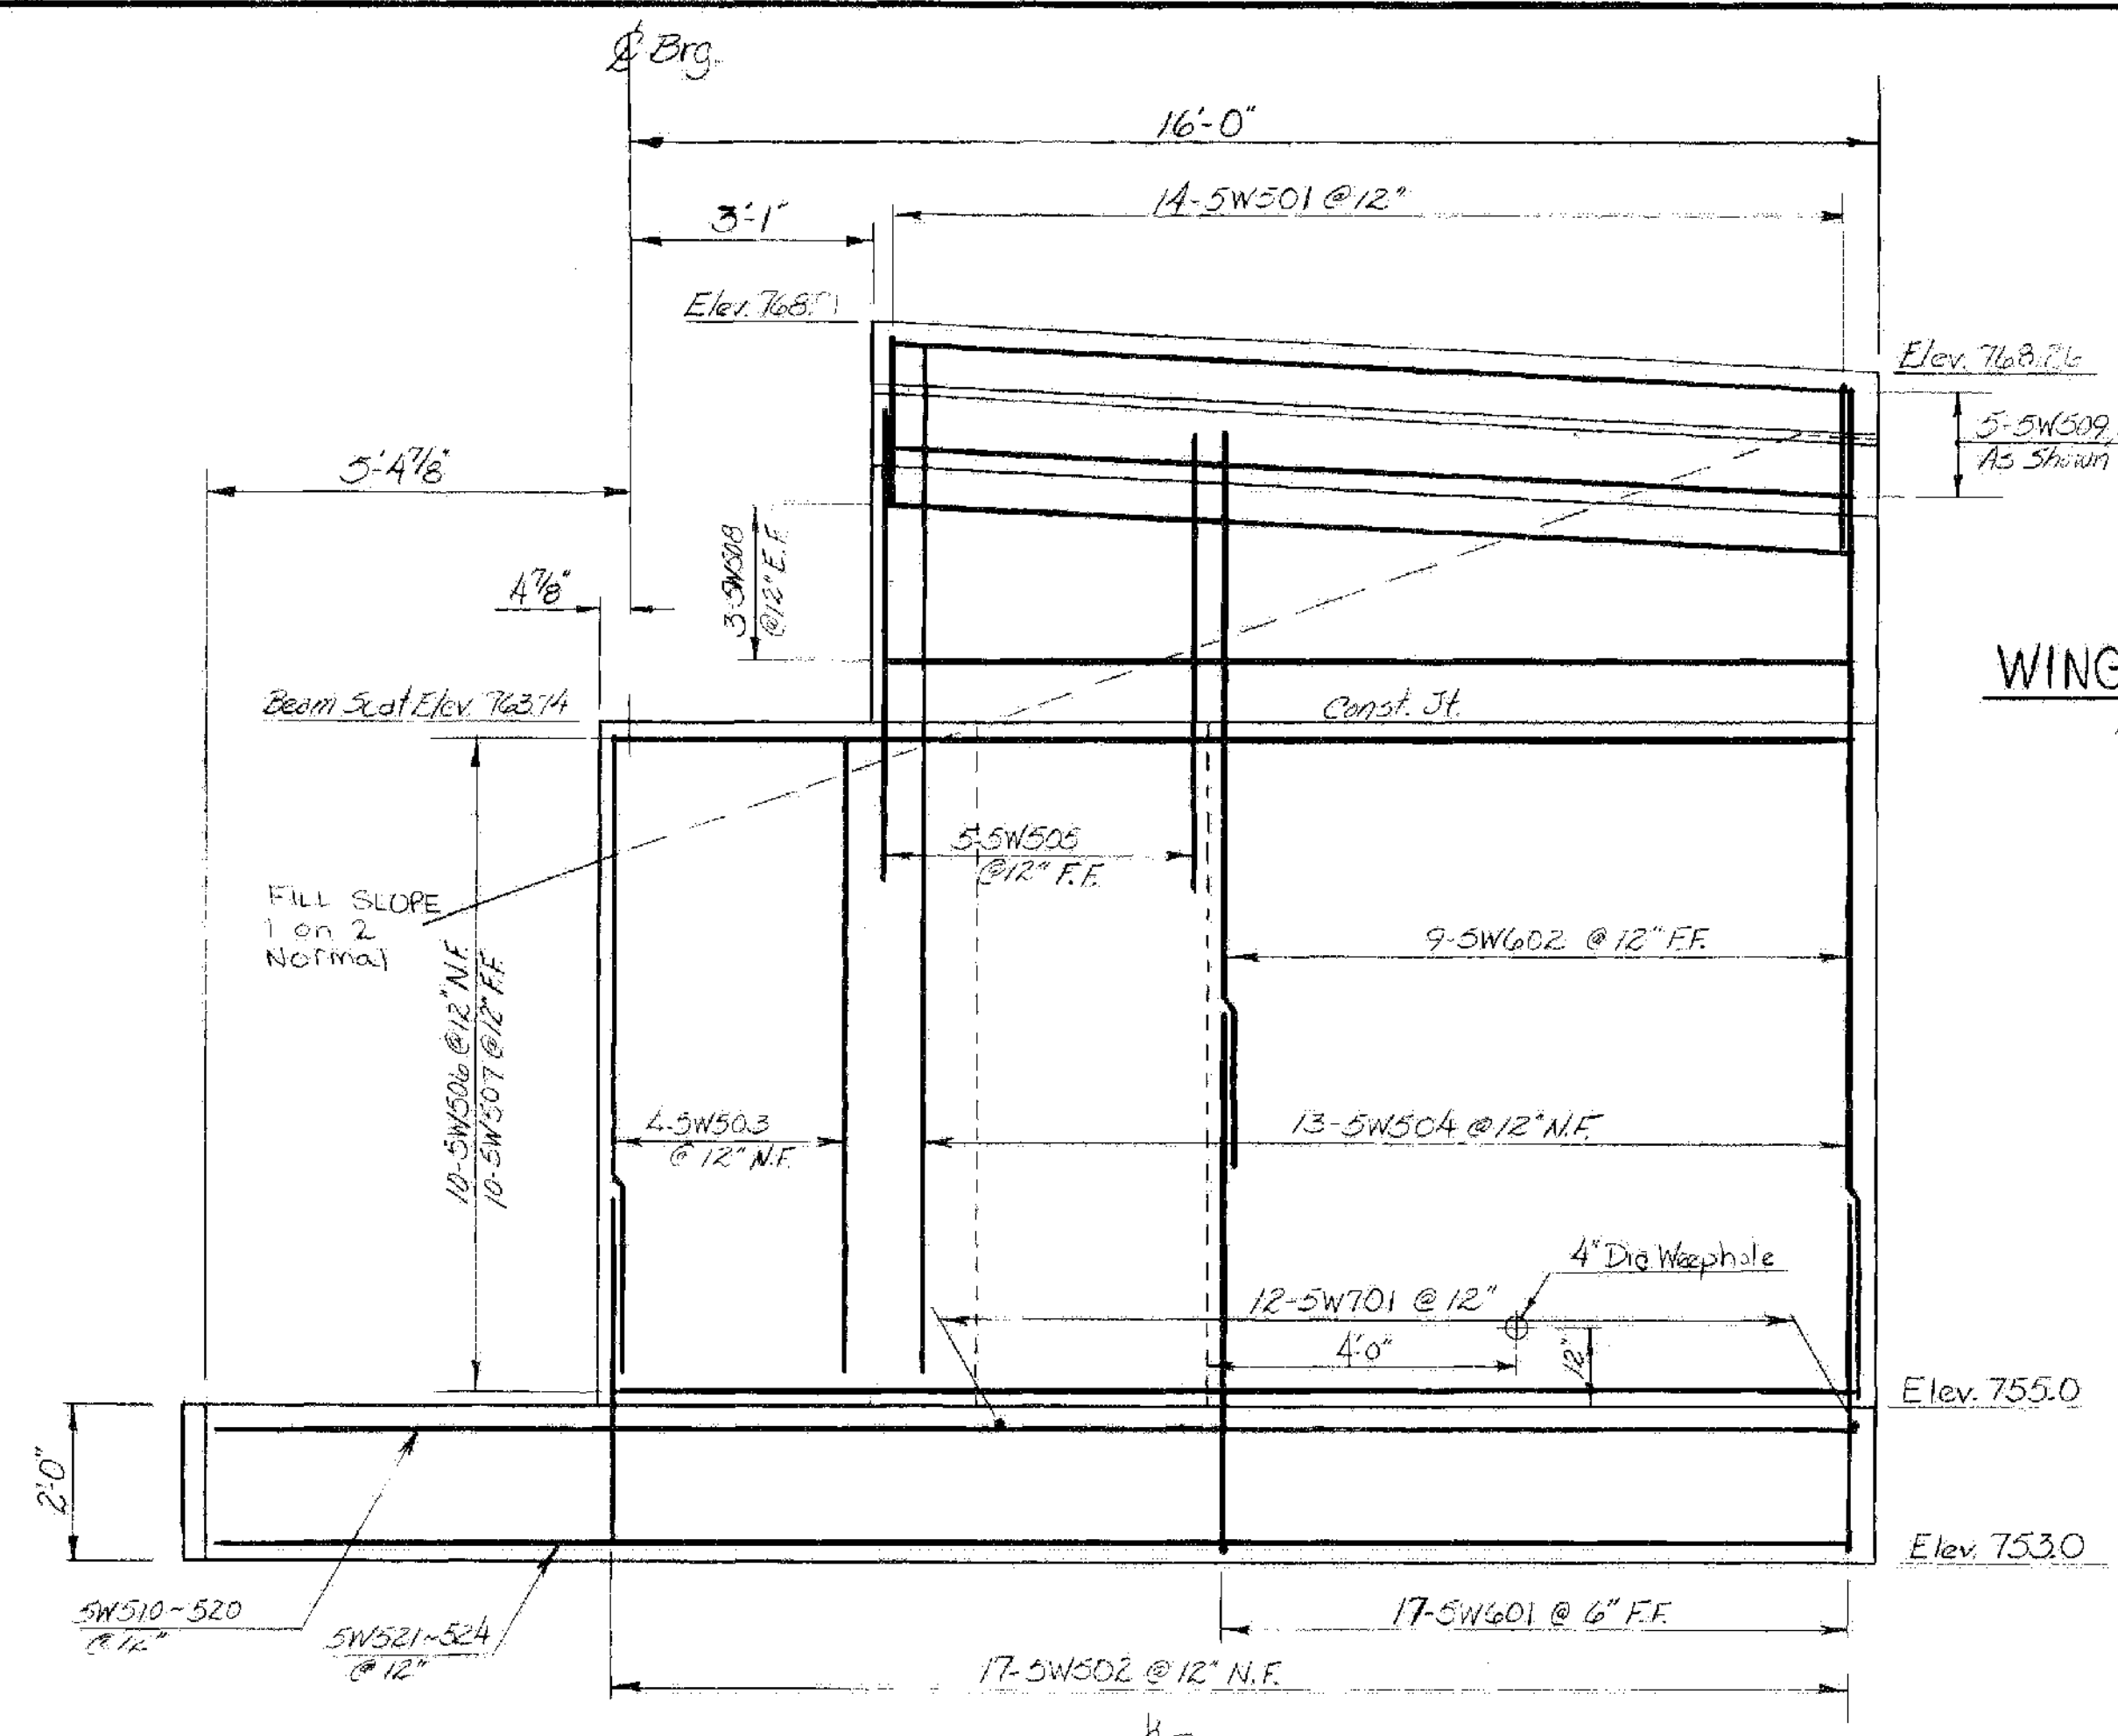


WINGWALL No. 5
1/2" = 1'-0"

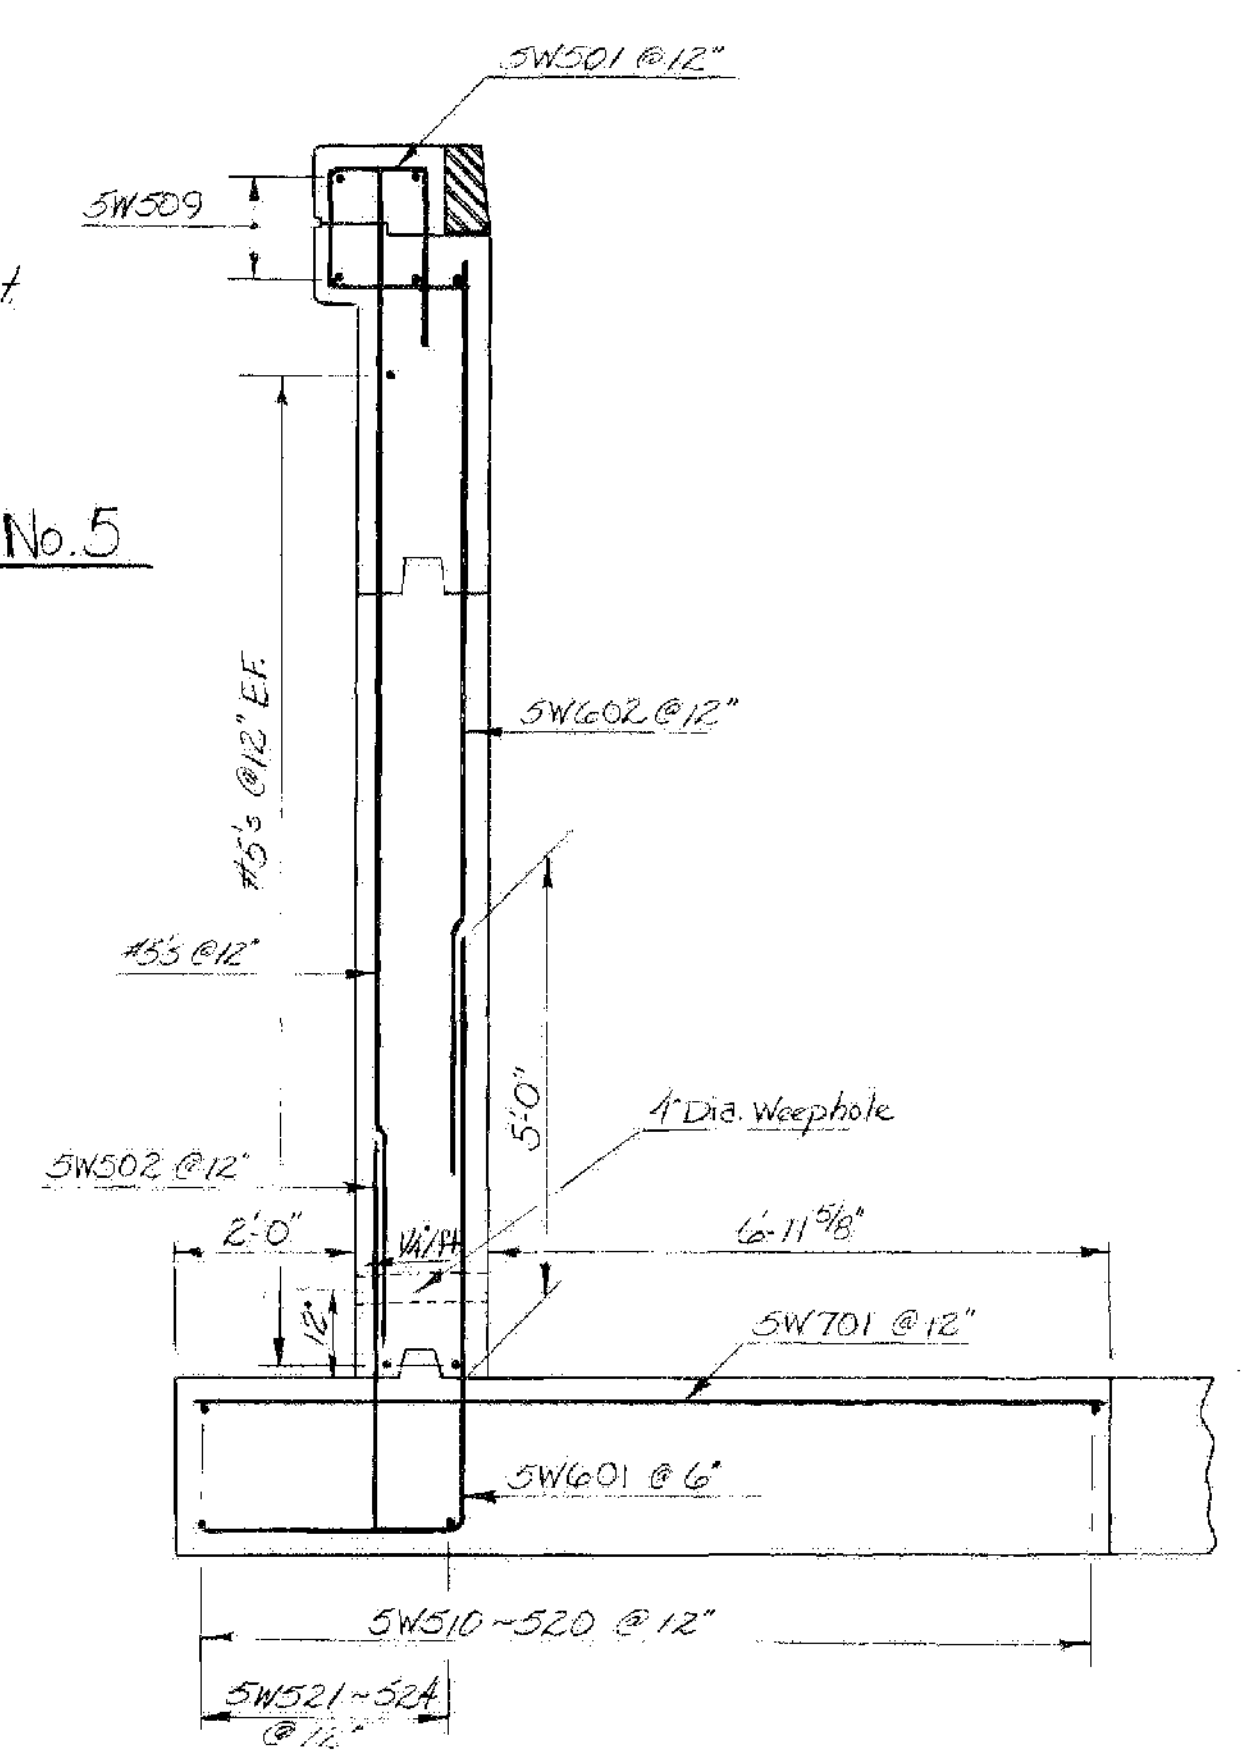


TYPICAL SECTION

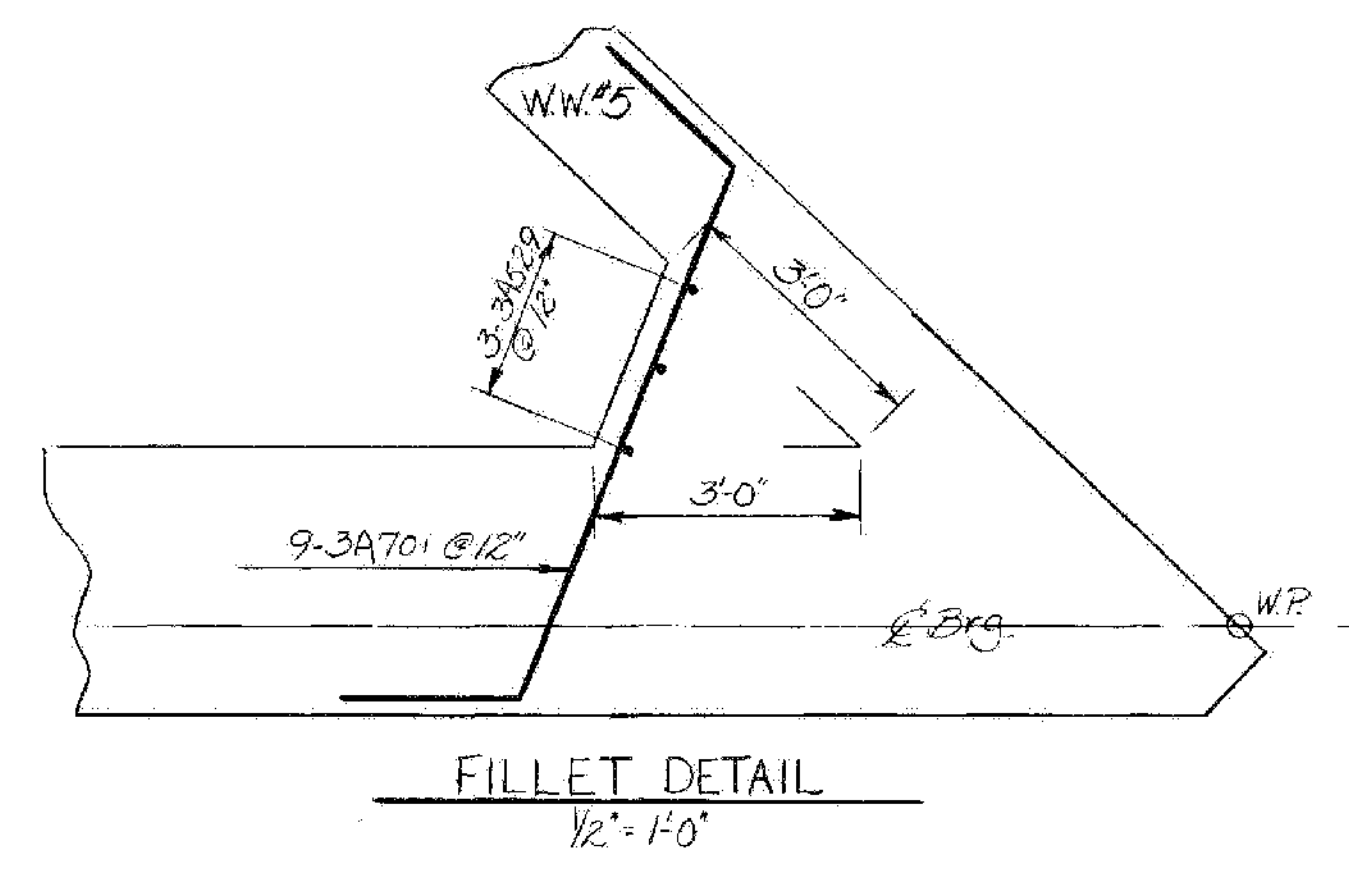


FILLET DETAIL
1/2" = 1'-0"

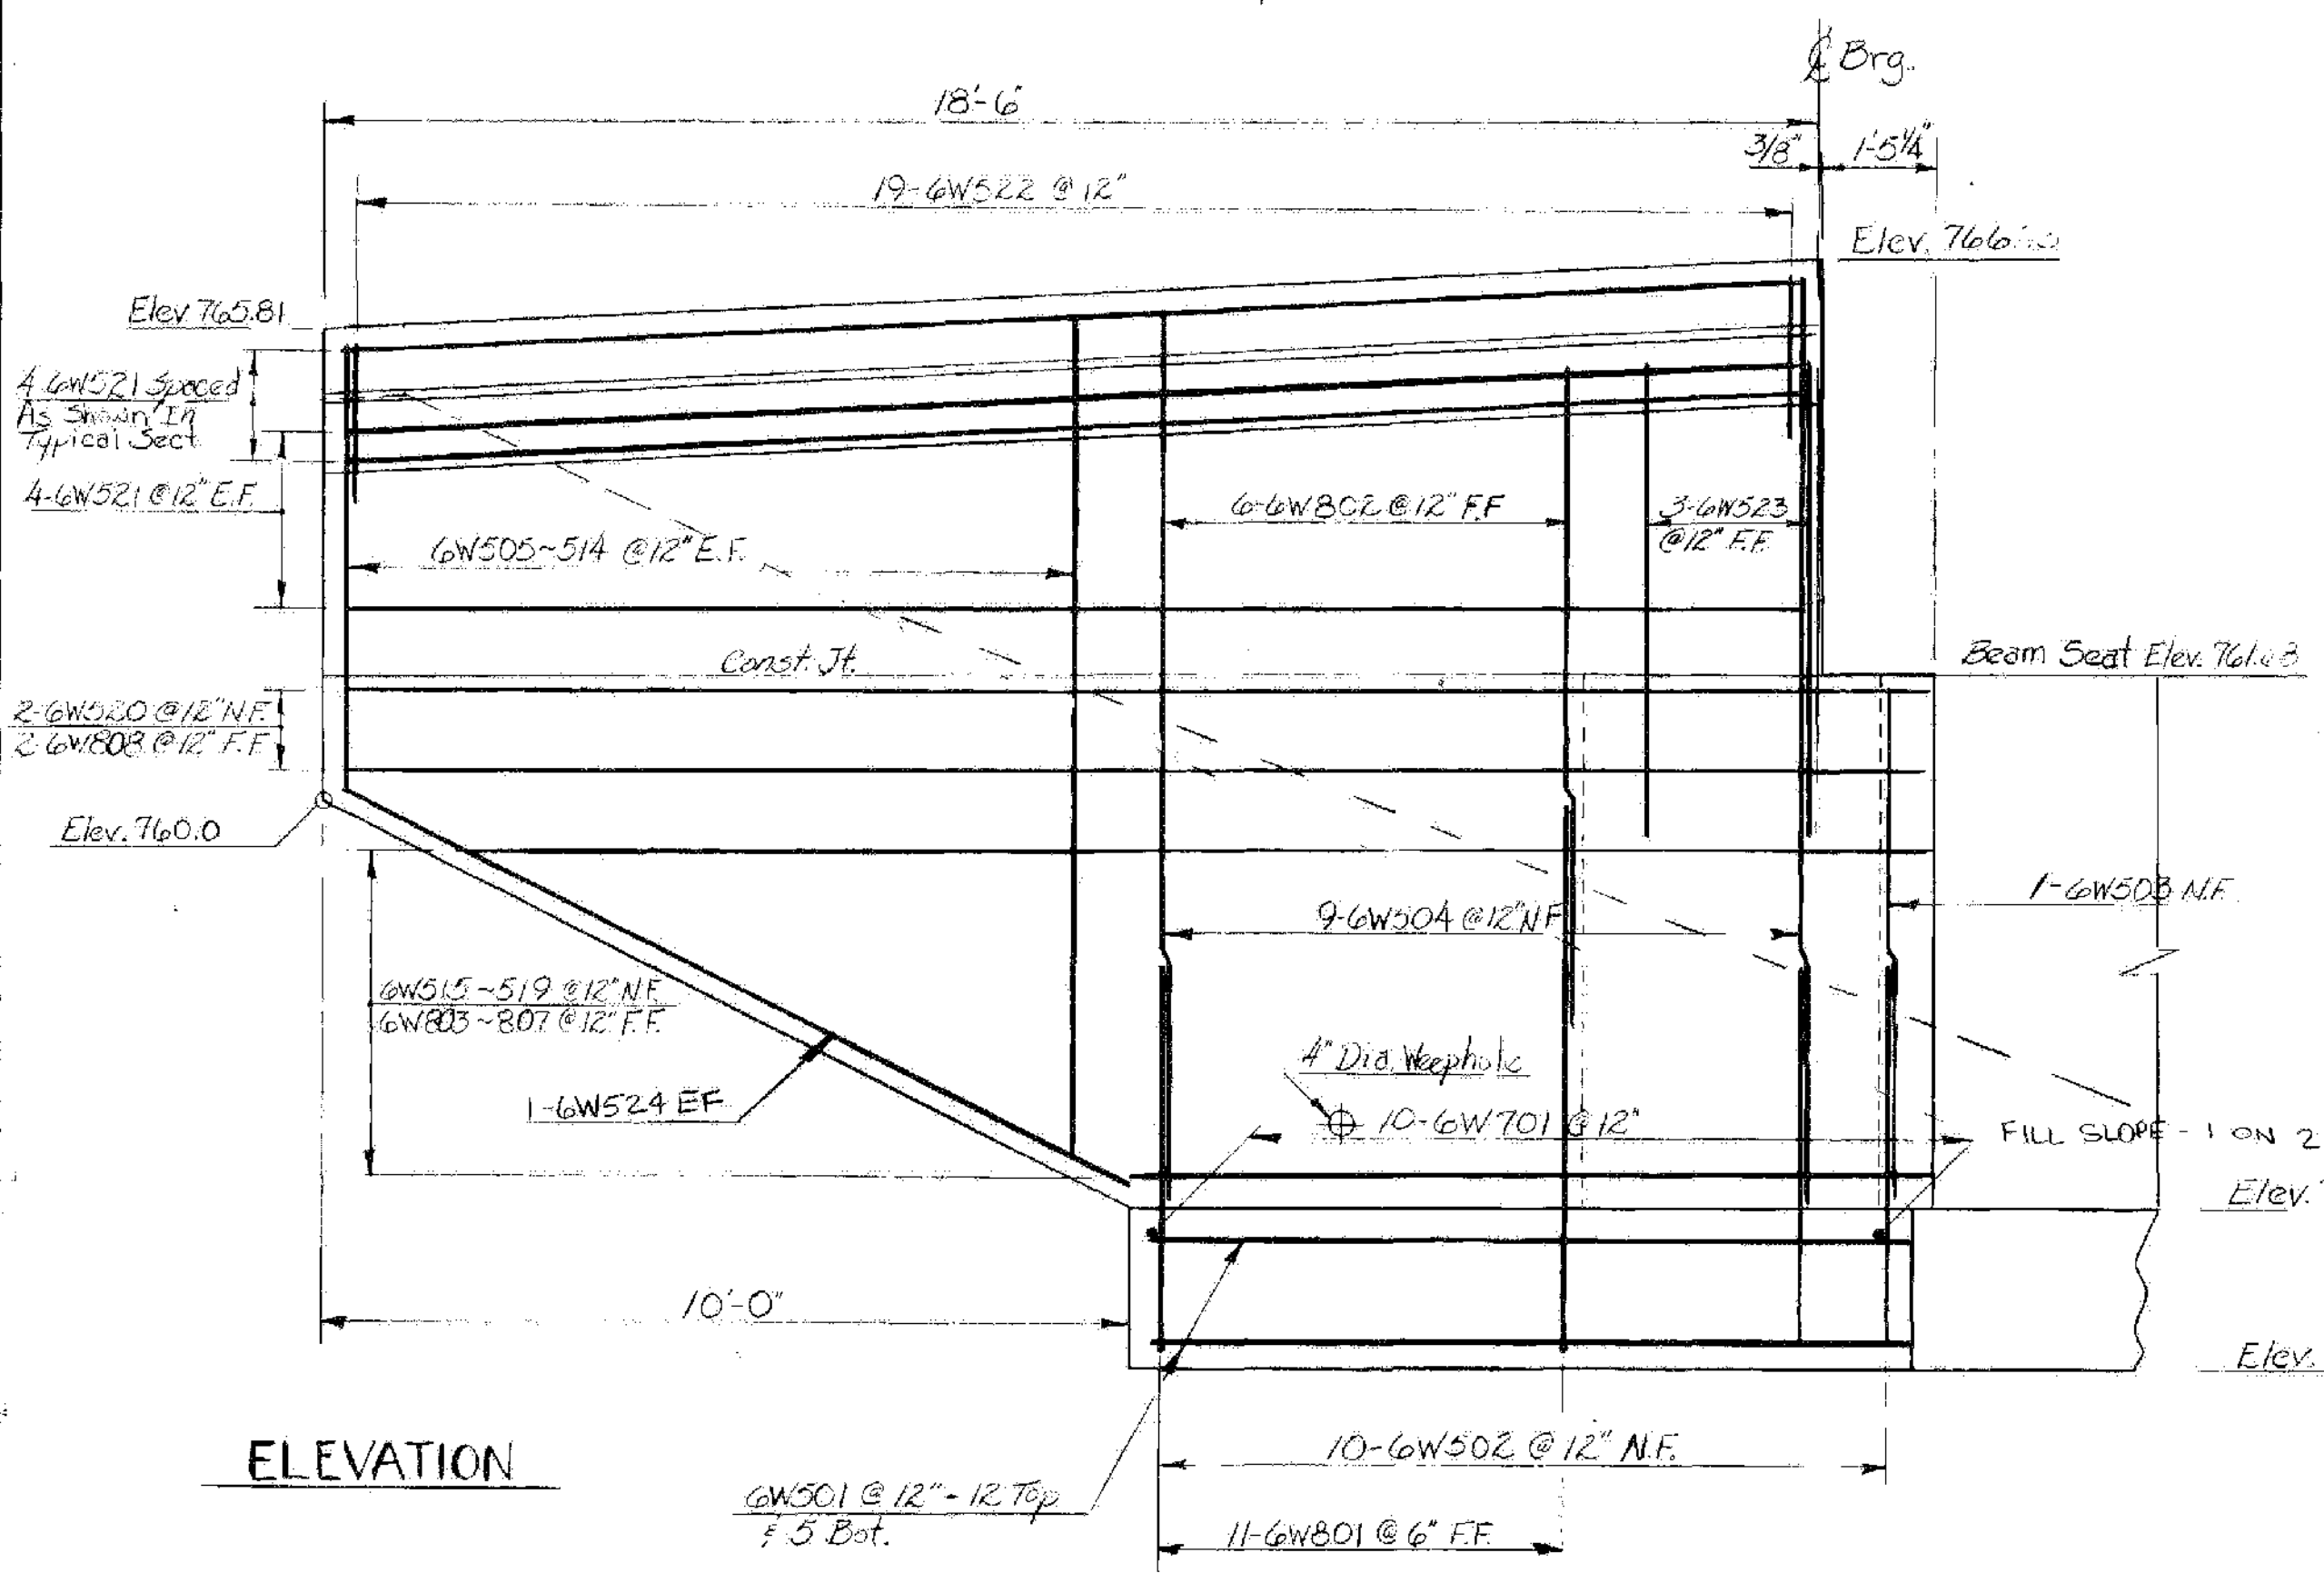

WINGWALL No. 6
1/2" = 1'-0"

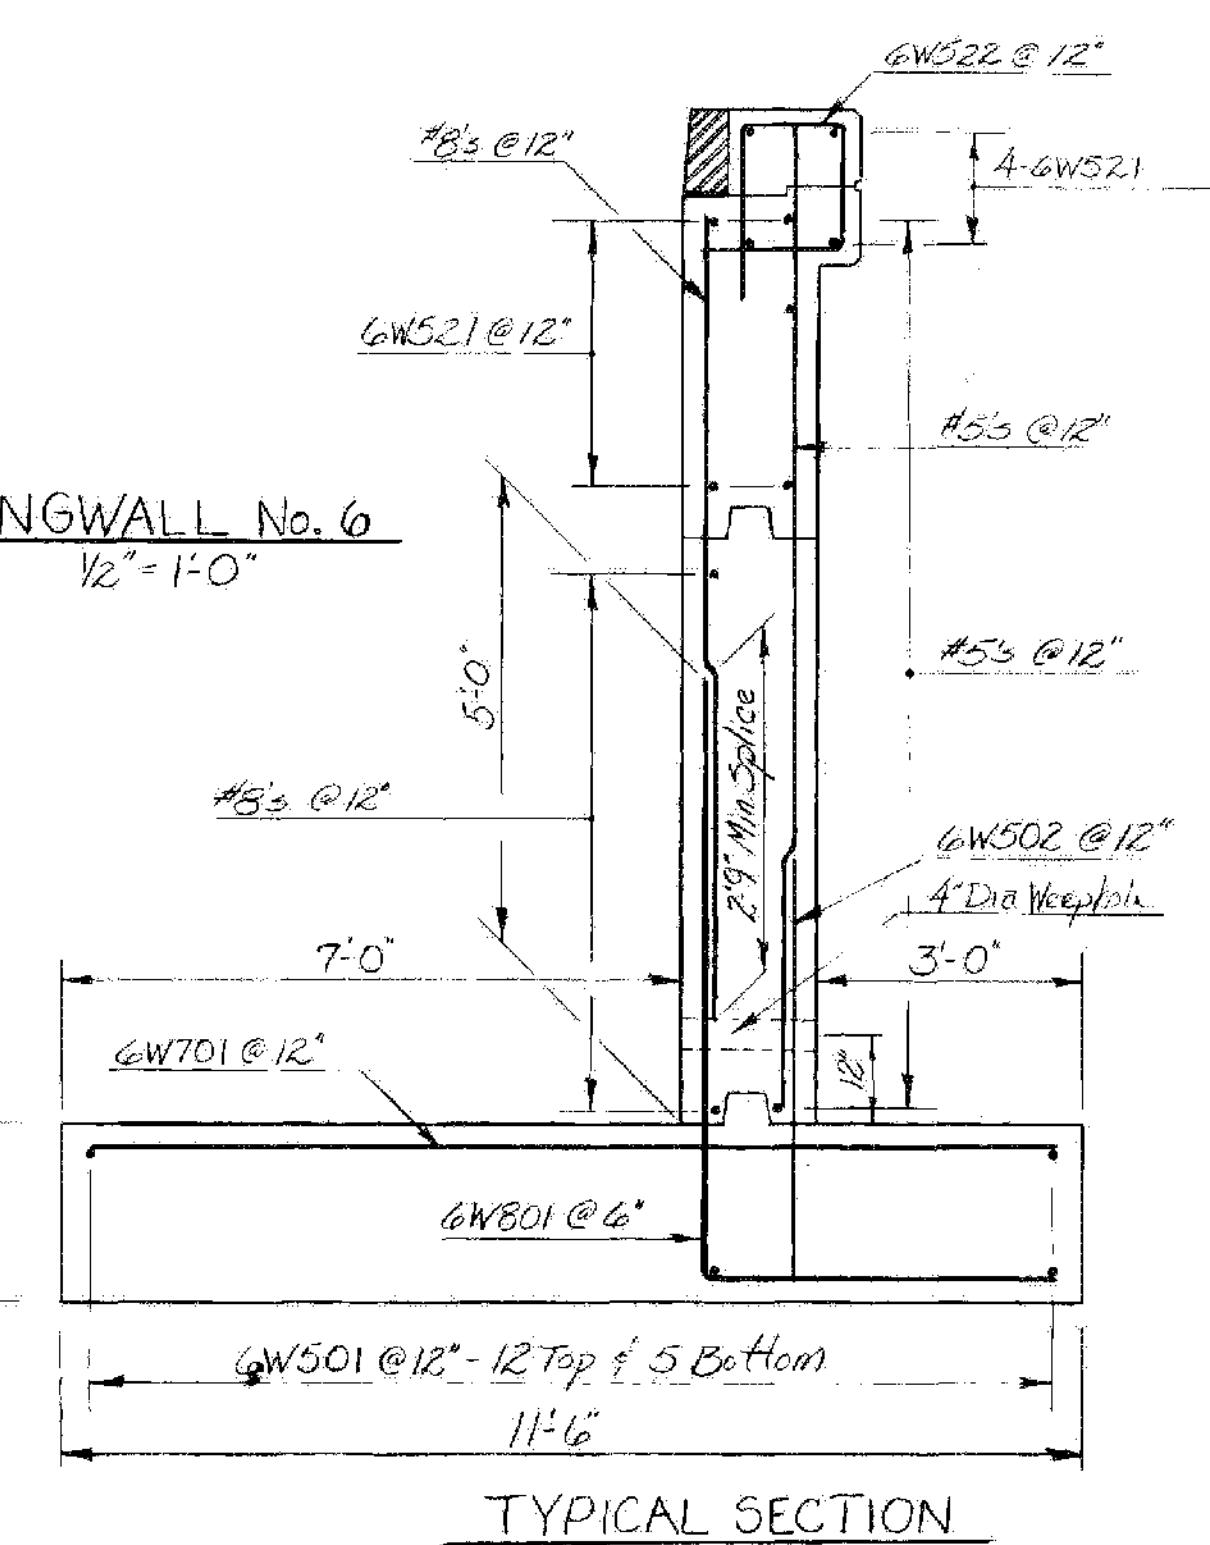


TYPICAL SECTION

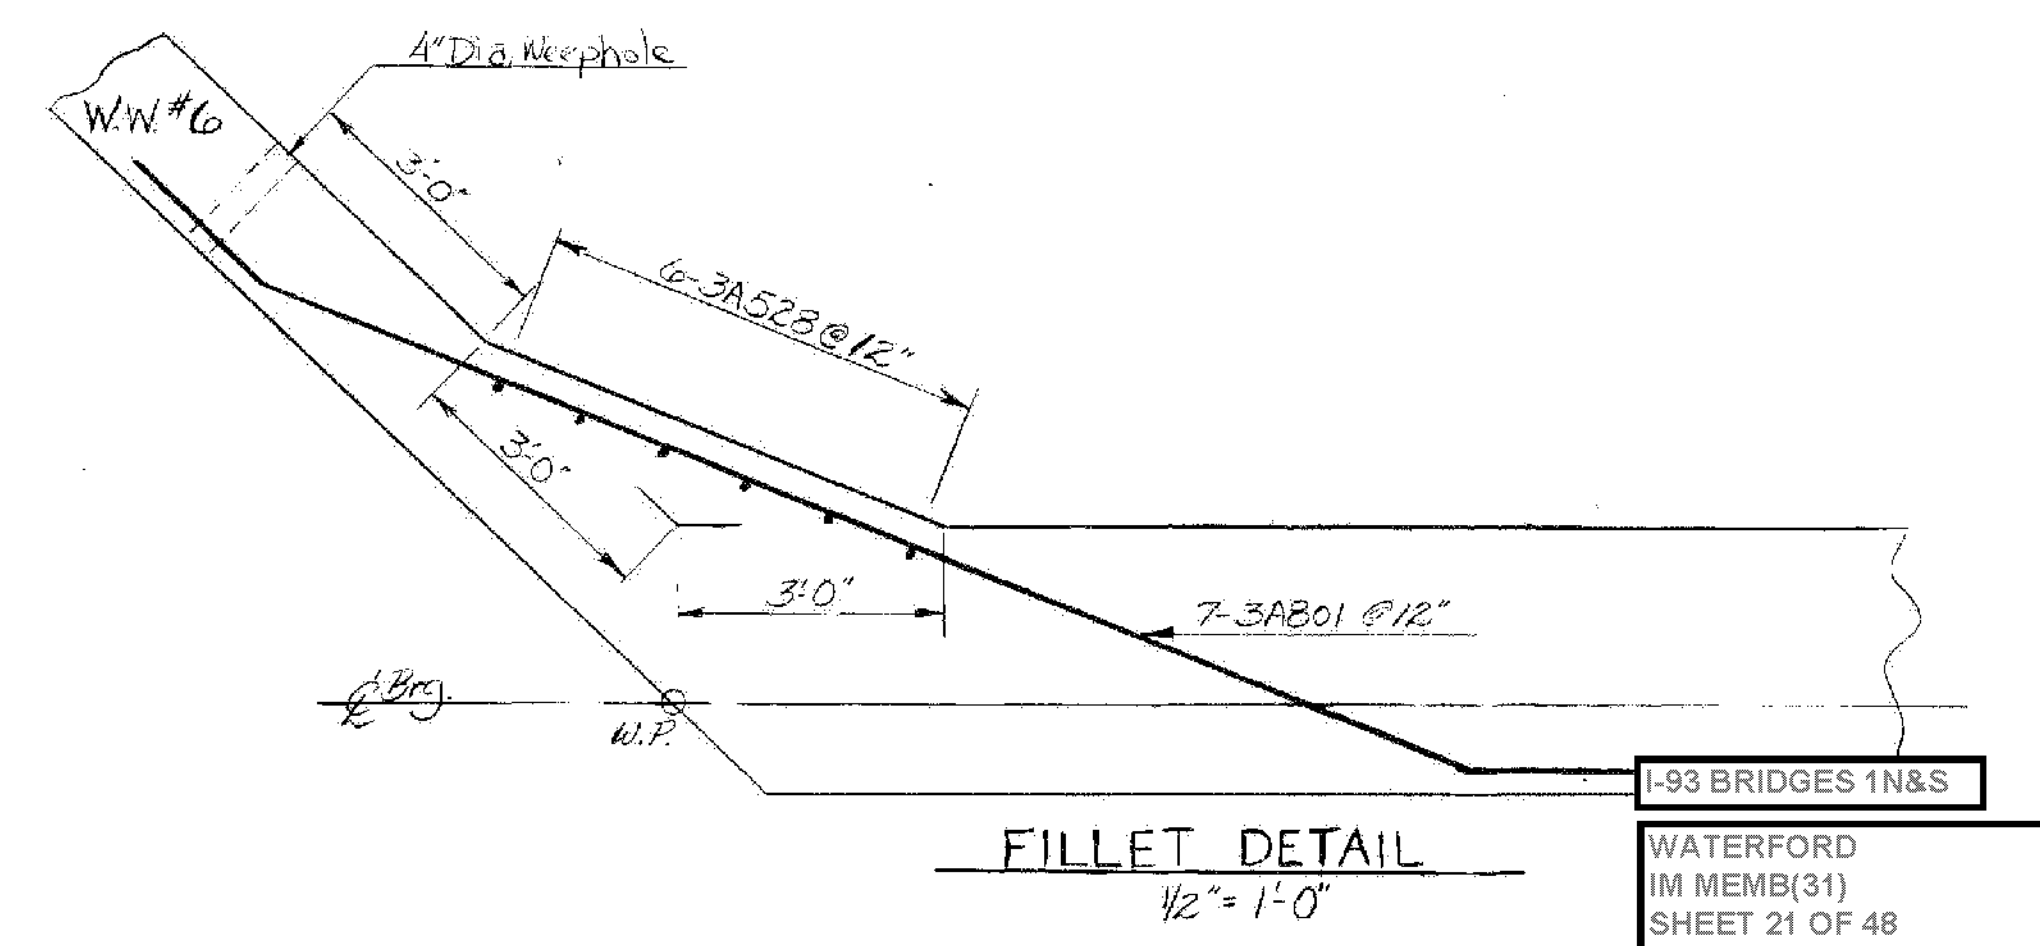


FILLET DETAIL
1/2" = 1'-0"

STATE OF VERMONT AGENCY OF TRANSPORTATION	
TOWN OF WATERFORD	Bridge No. 1 NB
HIGHWAY NO. I93	Log Sta. 2870
I93 N.B. #5.B. Over Vt. Rte. 18 N.B. WINGWALL No. 5 & 6 DETAILS	
Designed by A. Elwood	Drawn by K. Whitcomb
Checked by GVS date 5-23-80	Bridge Design Supervisor: R.S. HAUPT date 6-80
PROJECT CONTRACT 1 WATERFORD	PROJECT NO. I93-1(3)
Bridge Sheet No. BR116	Sheet 146 of 487


NOTE: N.F. = Near Face
F.F. = Far Face
E.F. = Each Face

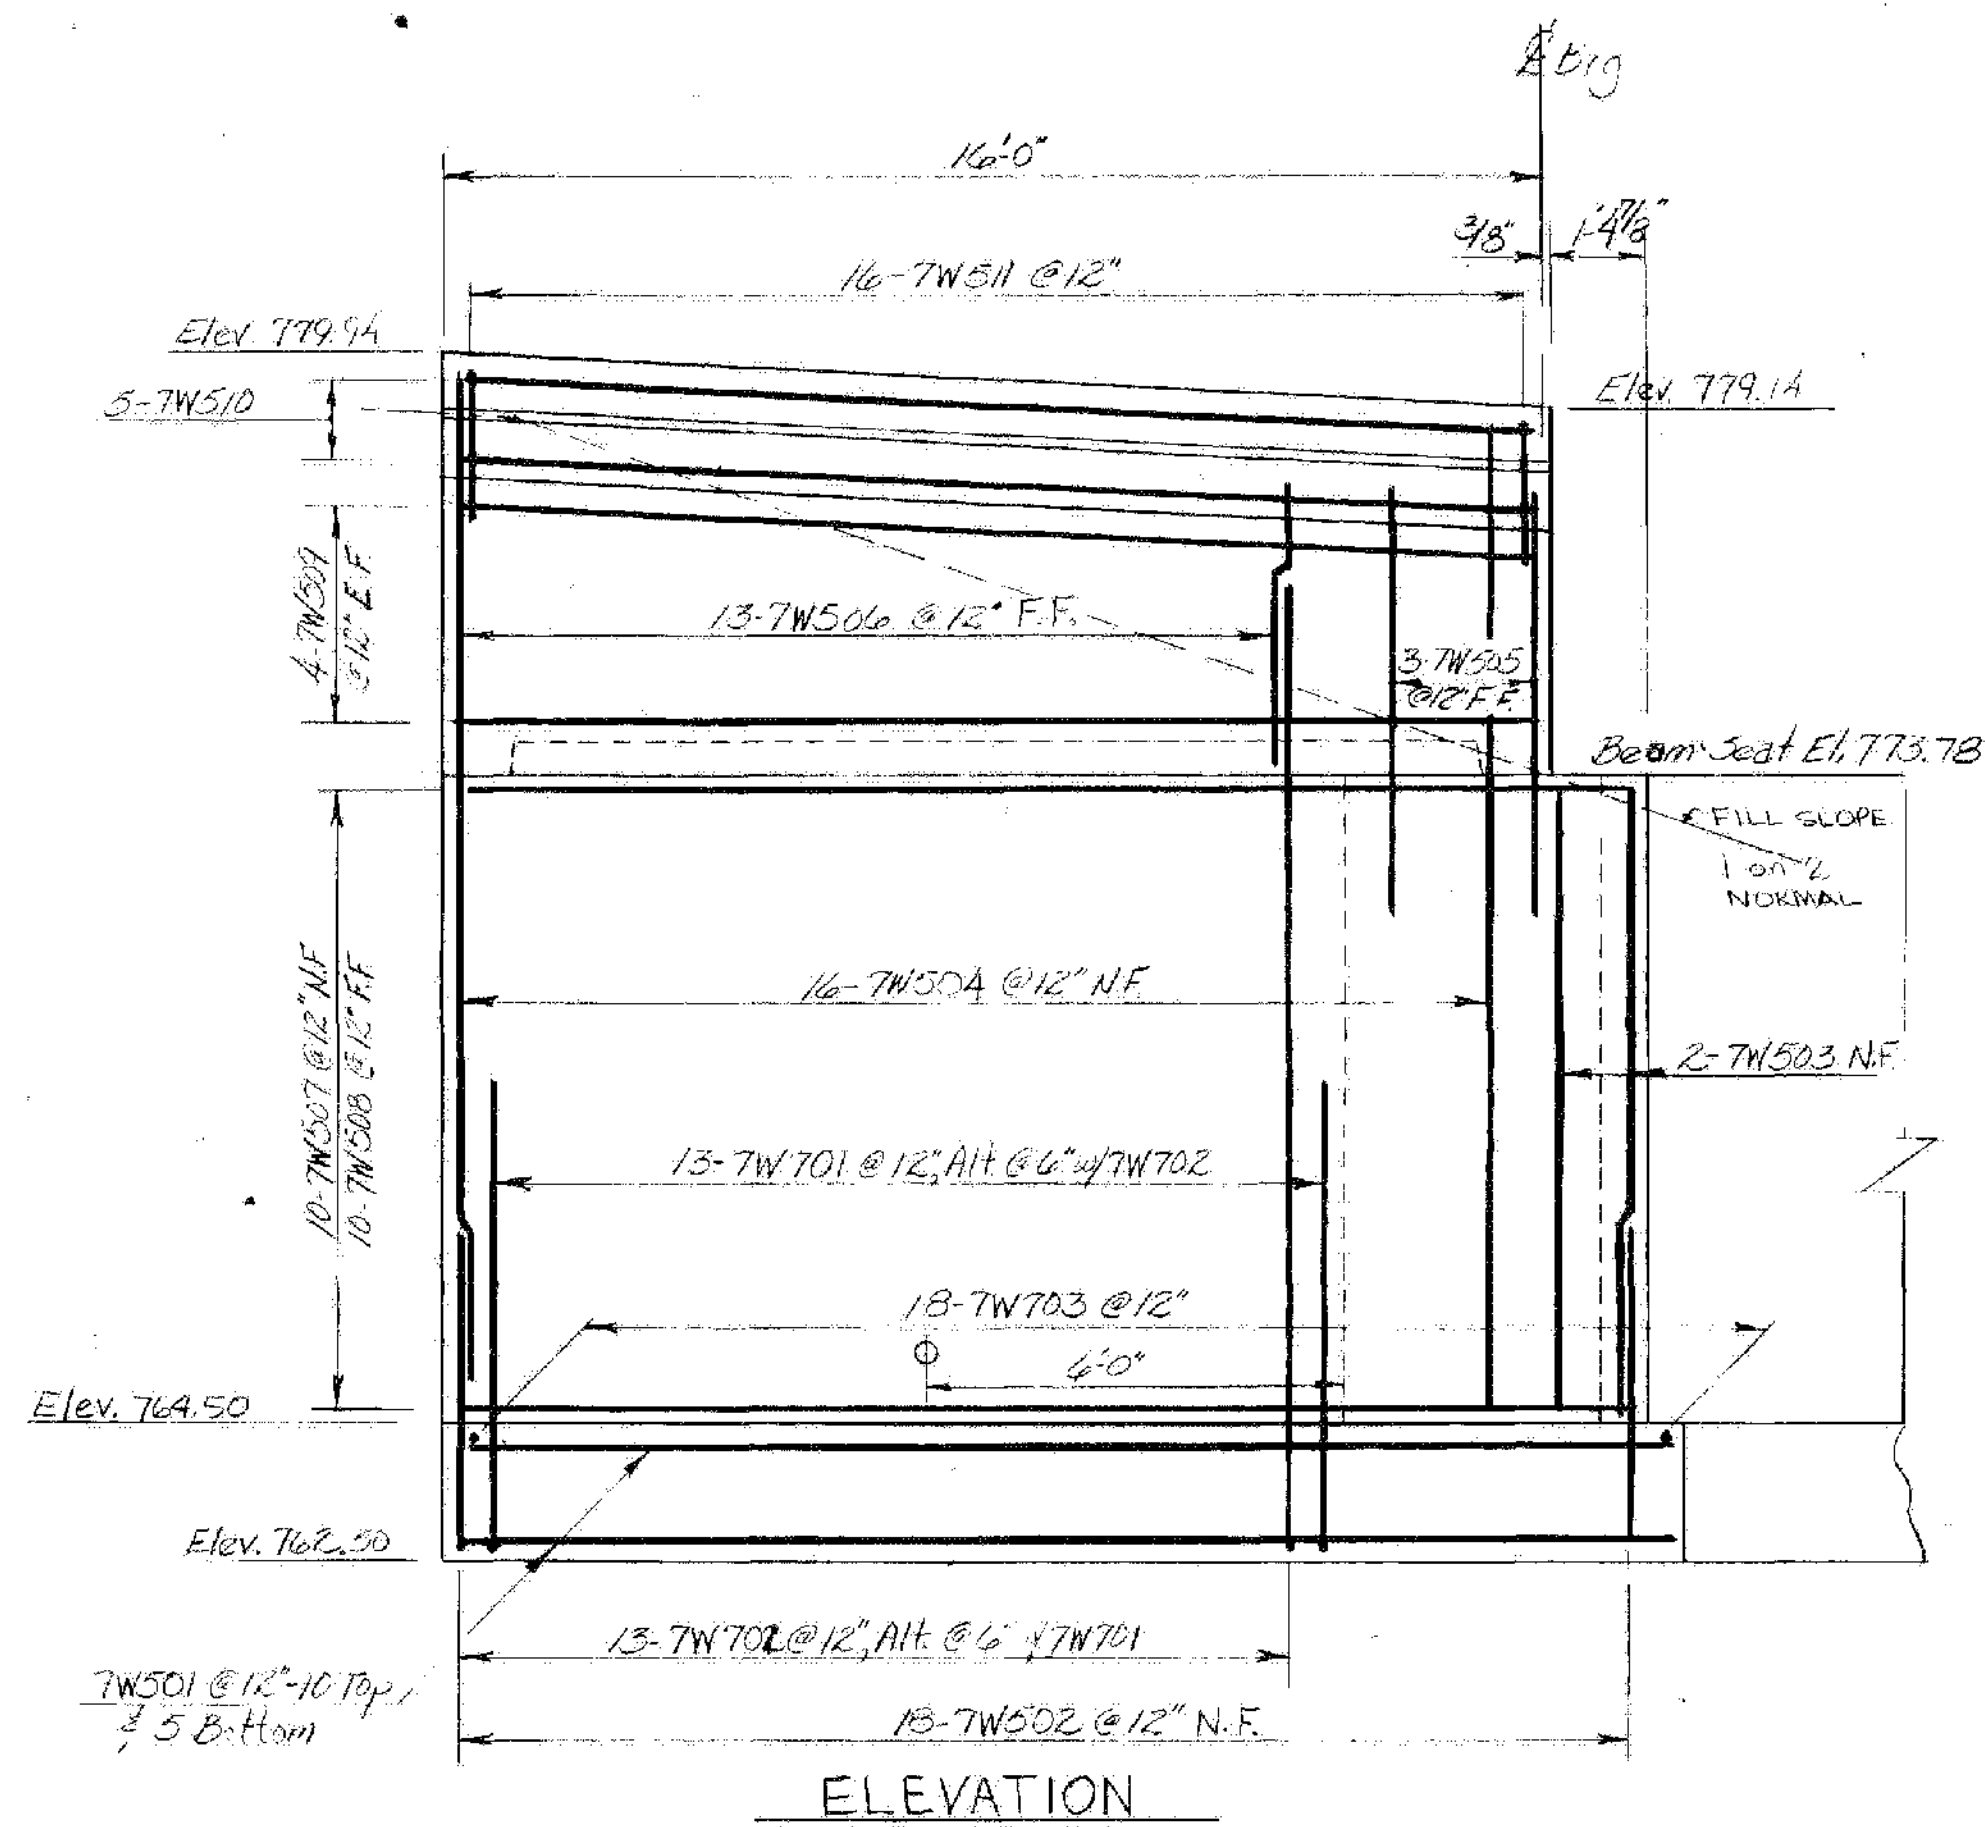

ELEVATION

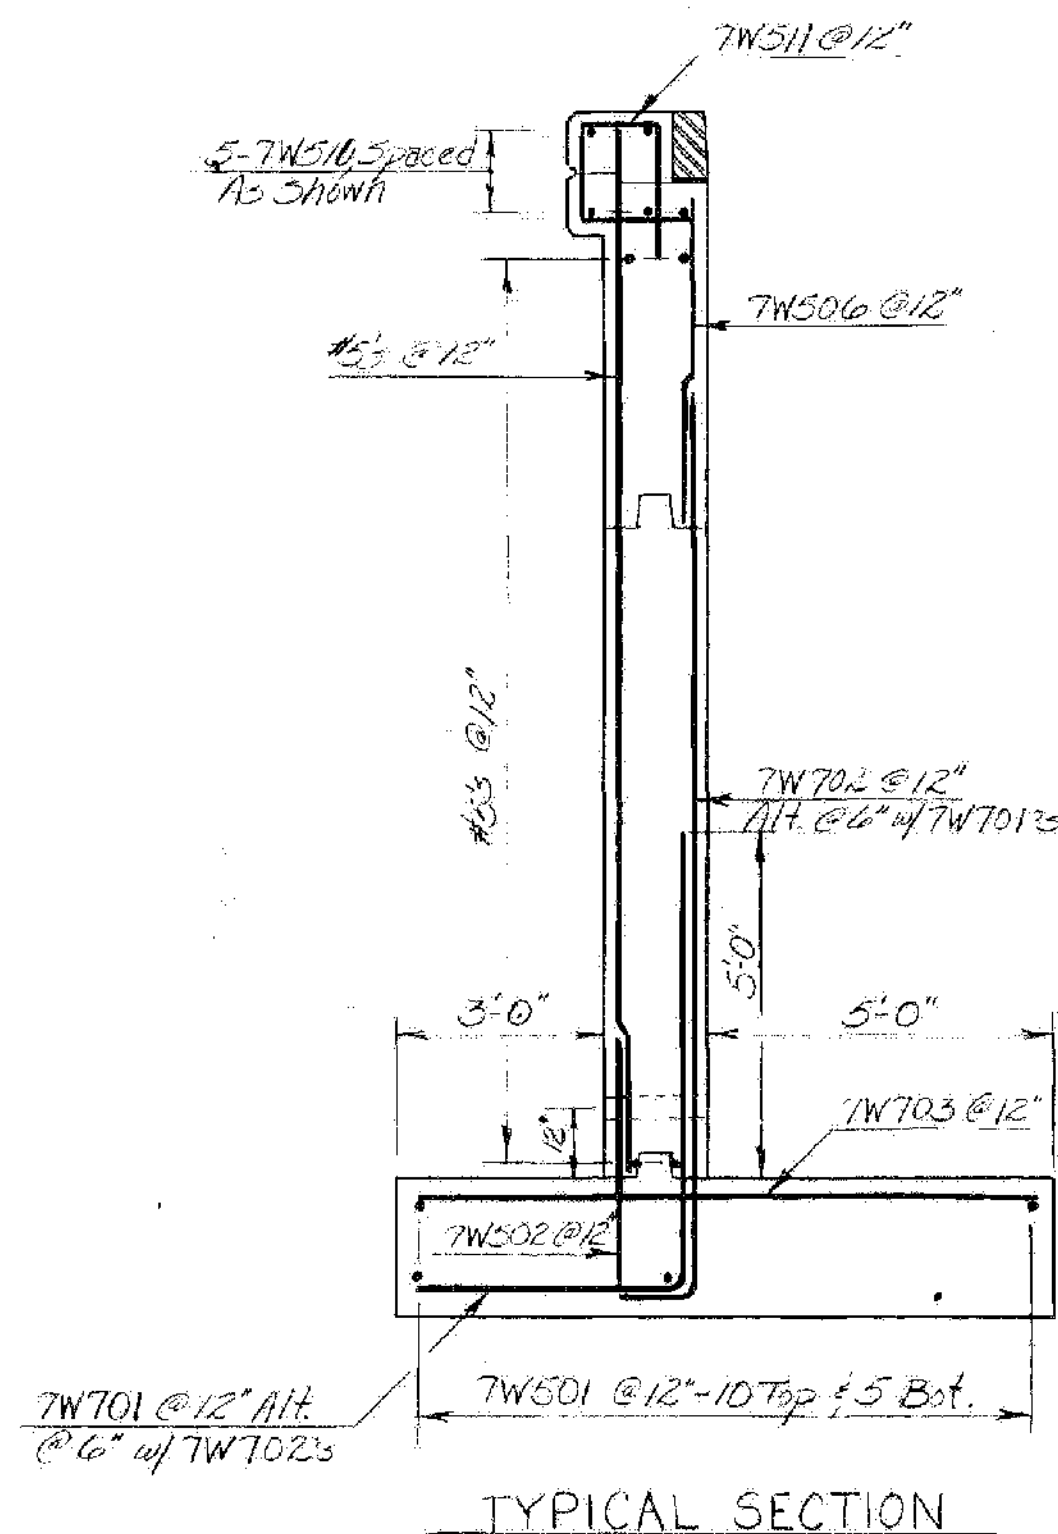


TYPICAL SECTION

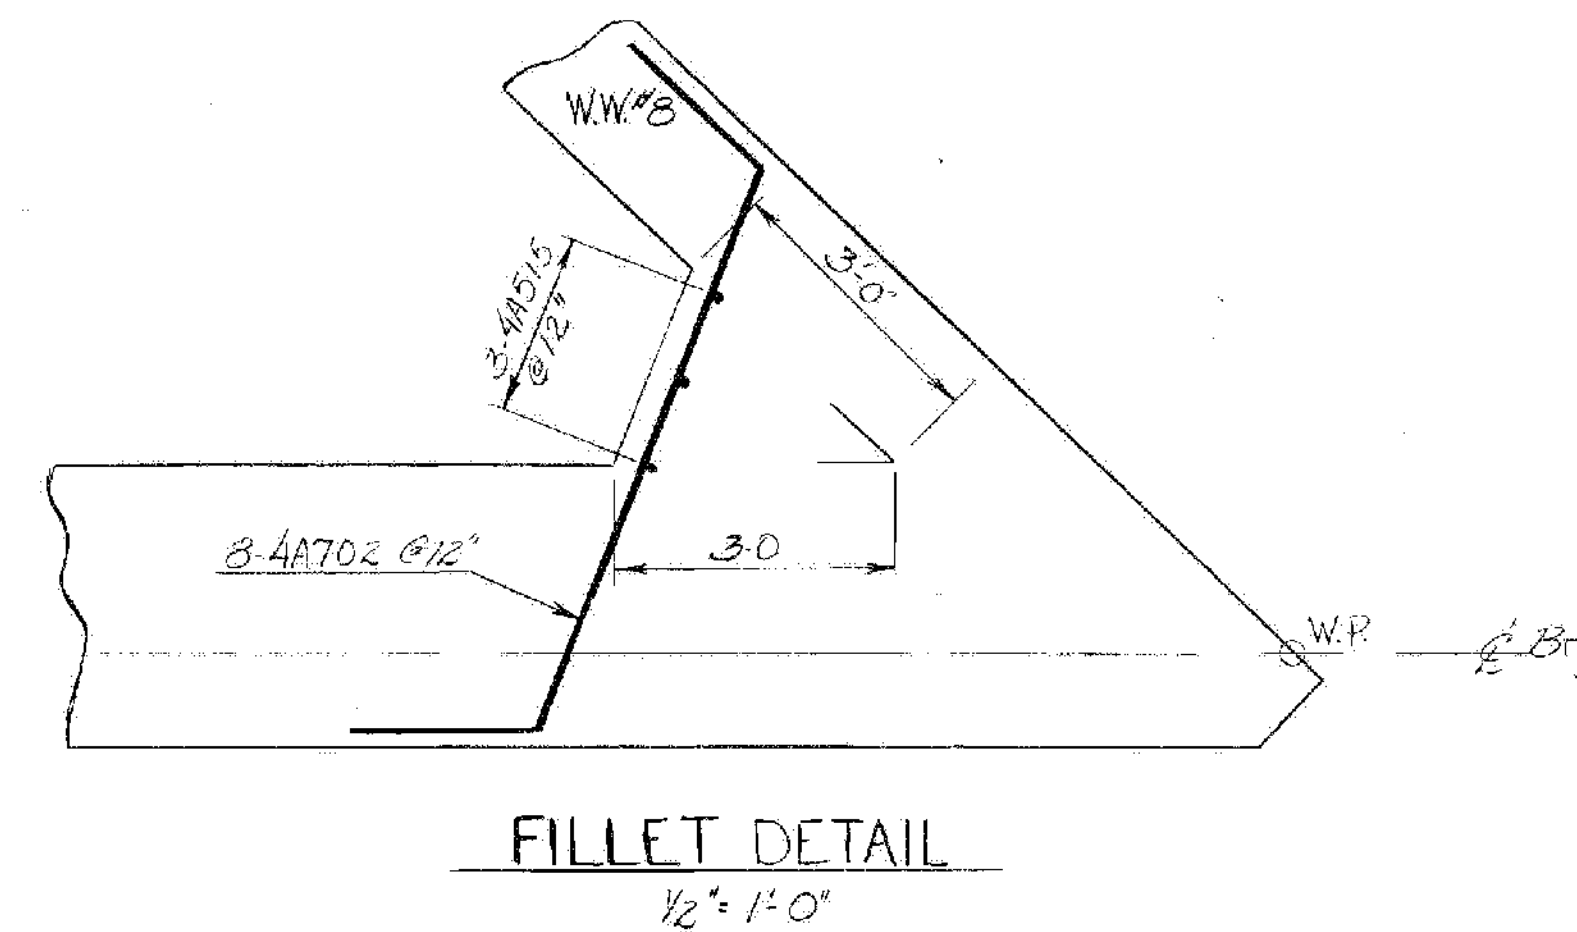


WINGWALL No. 7


3/8" = 1'-0"

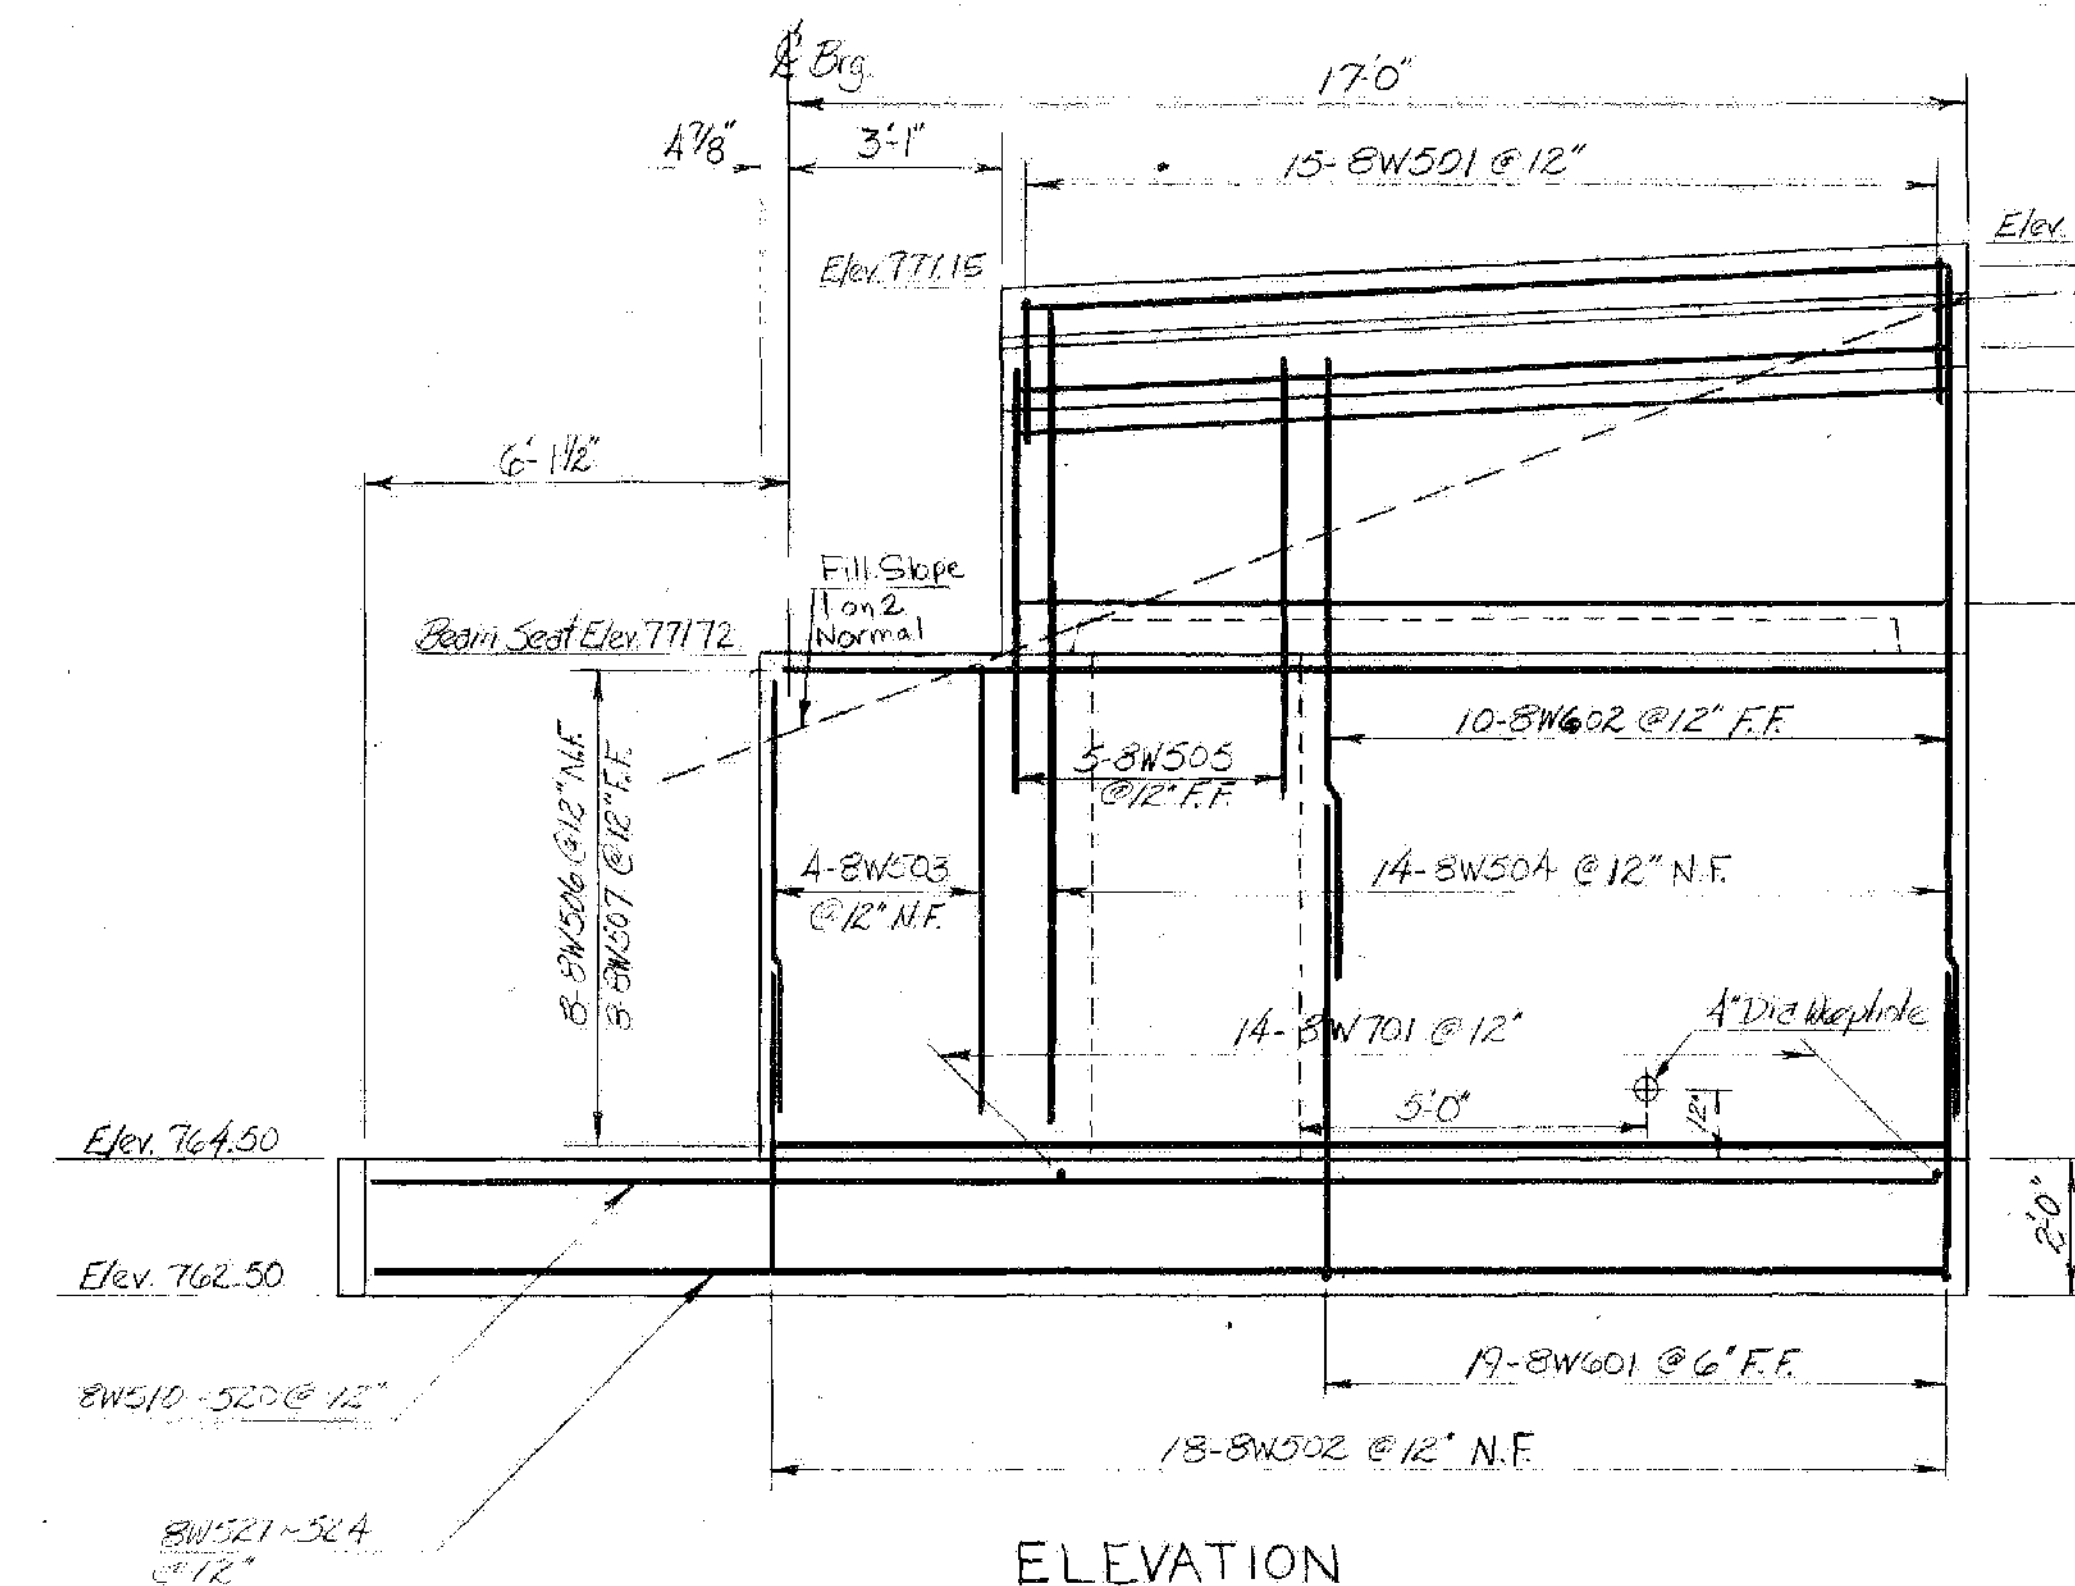

ELEVATION

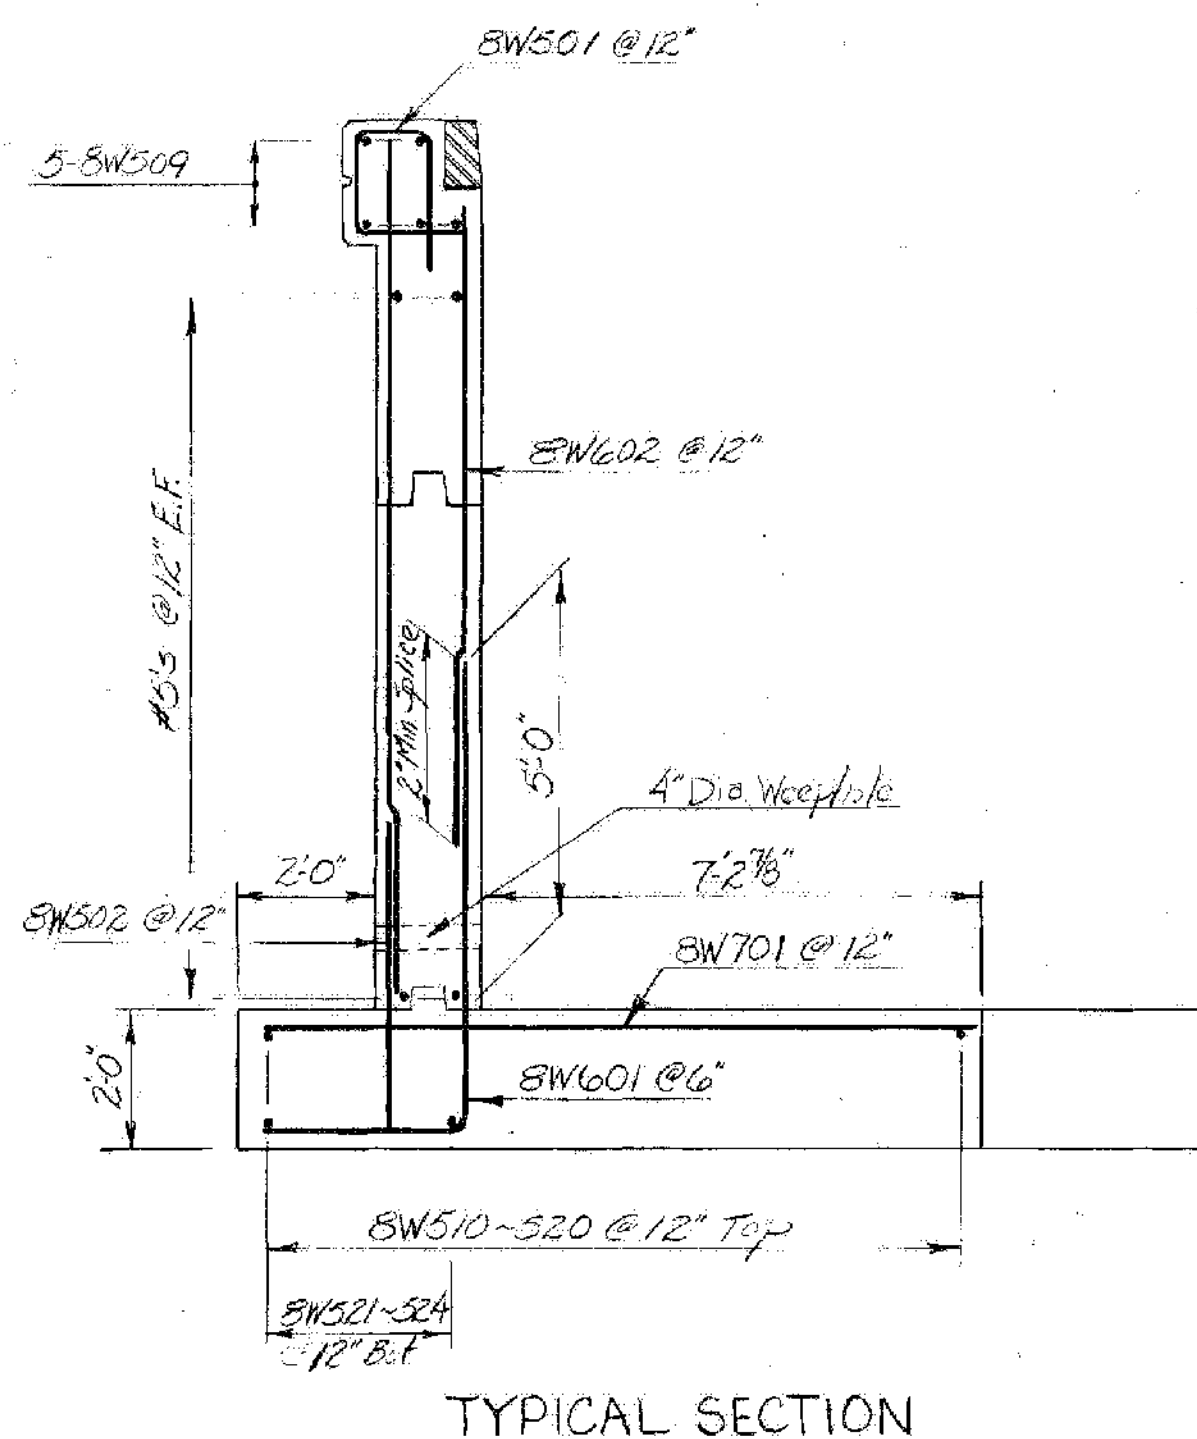

TYPICAL SECTION

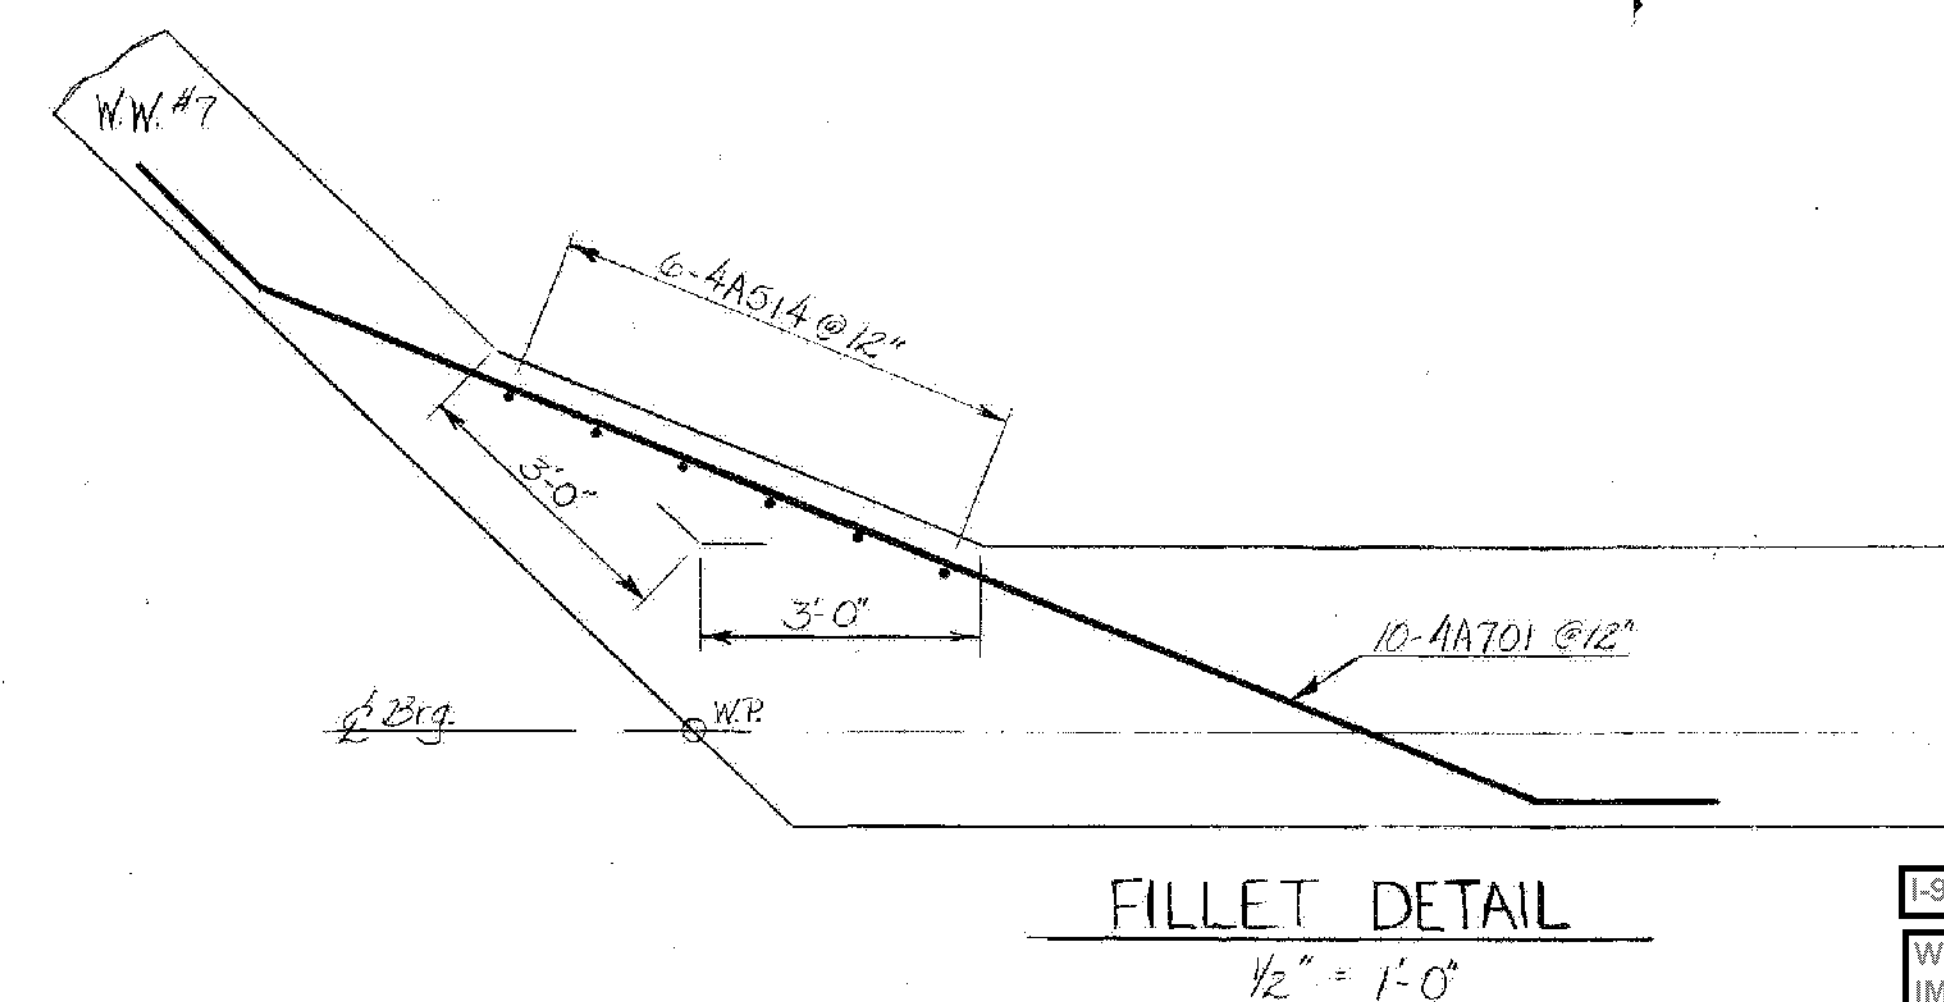

WINGWALL No. 8


3/8" = 1'-0"

NOTE: N.F. = Near Face
F.F. = Far Face
E.F. = Each Face


I-93 BRIDGES 1N&S
WATERFORD
III MEMB(31)
SHEET 23 OF 48
FOR REFERENCE ONLY

**STATE OF VERMONT
AGENCY OF TRANSPORTATION**


TOWN OF WATERFORD	Bridge No. 1 NB
HIGHWAY NO. I-93	Log Sta. F8+0
I-93 NB & S.B. Over Vt Rte. 18	
N.B. WINGWALL No. 7 & 8 DETAILS	
Designed by A Elwood	Drawn by R Whitecomb
Checked by GVS	Bridge Design Supervisor R.S. HAUPT
date 5-20-80	date 6-80
PROJECT CONTRACT 1 WATERFORD	PROJECT NO. I93-1(1)
Bridge Sheet No. BR118	Sheet 148 of 489

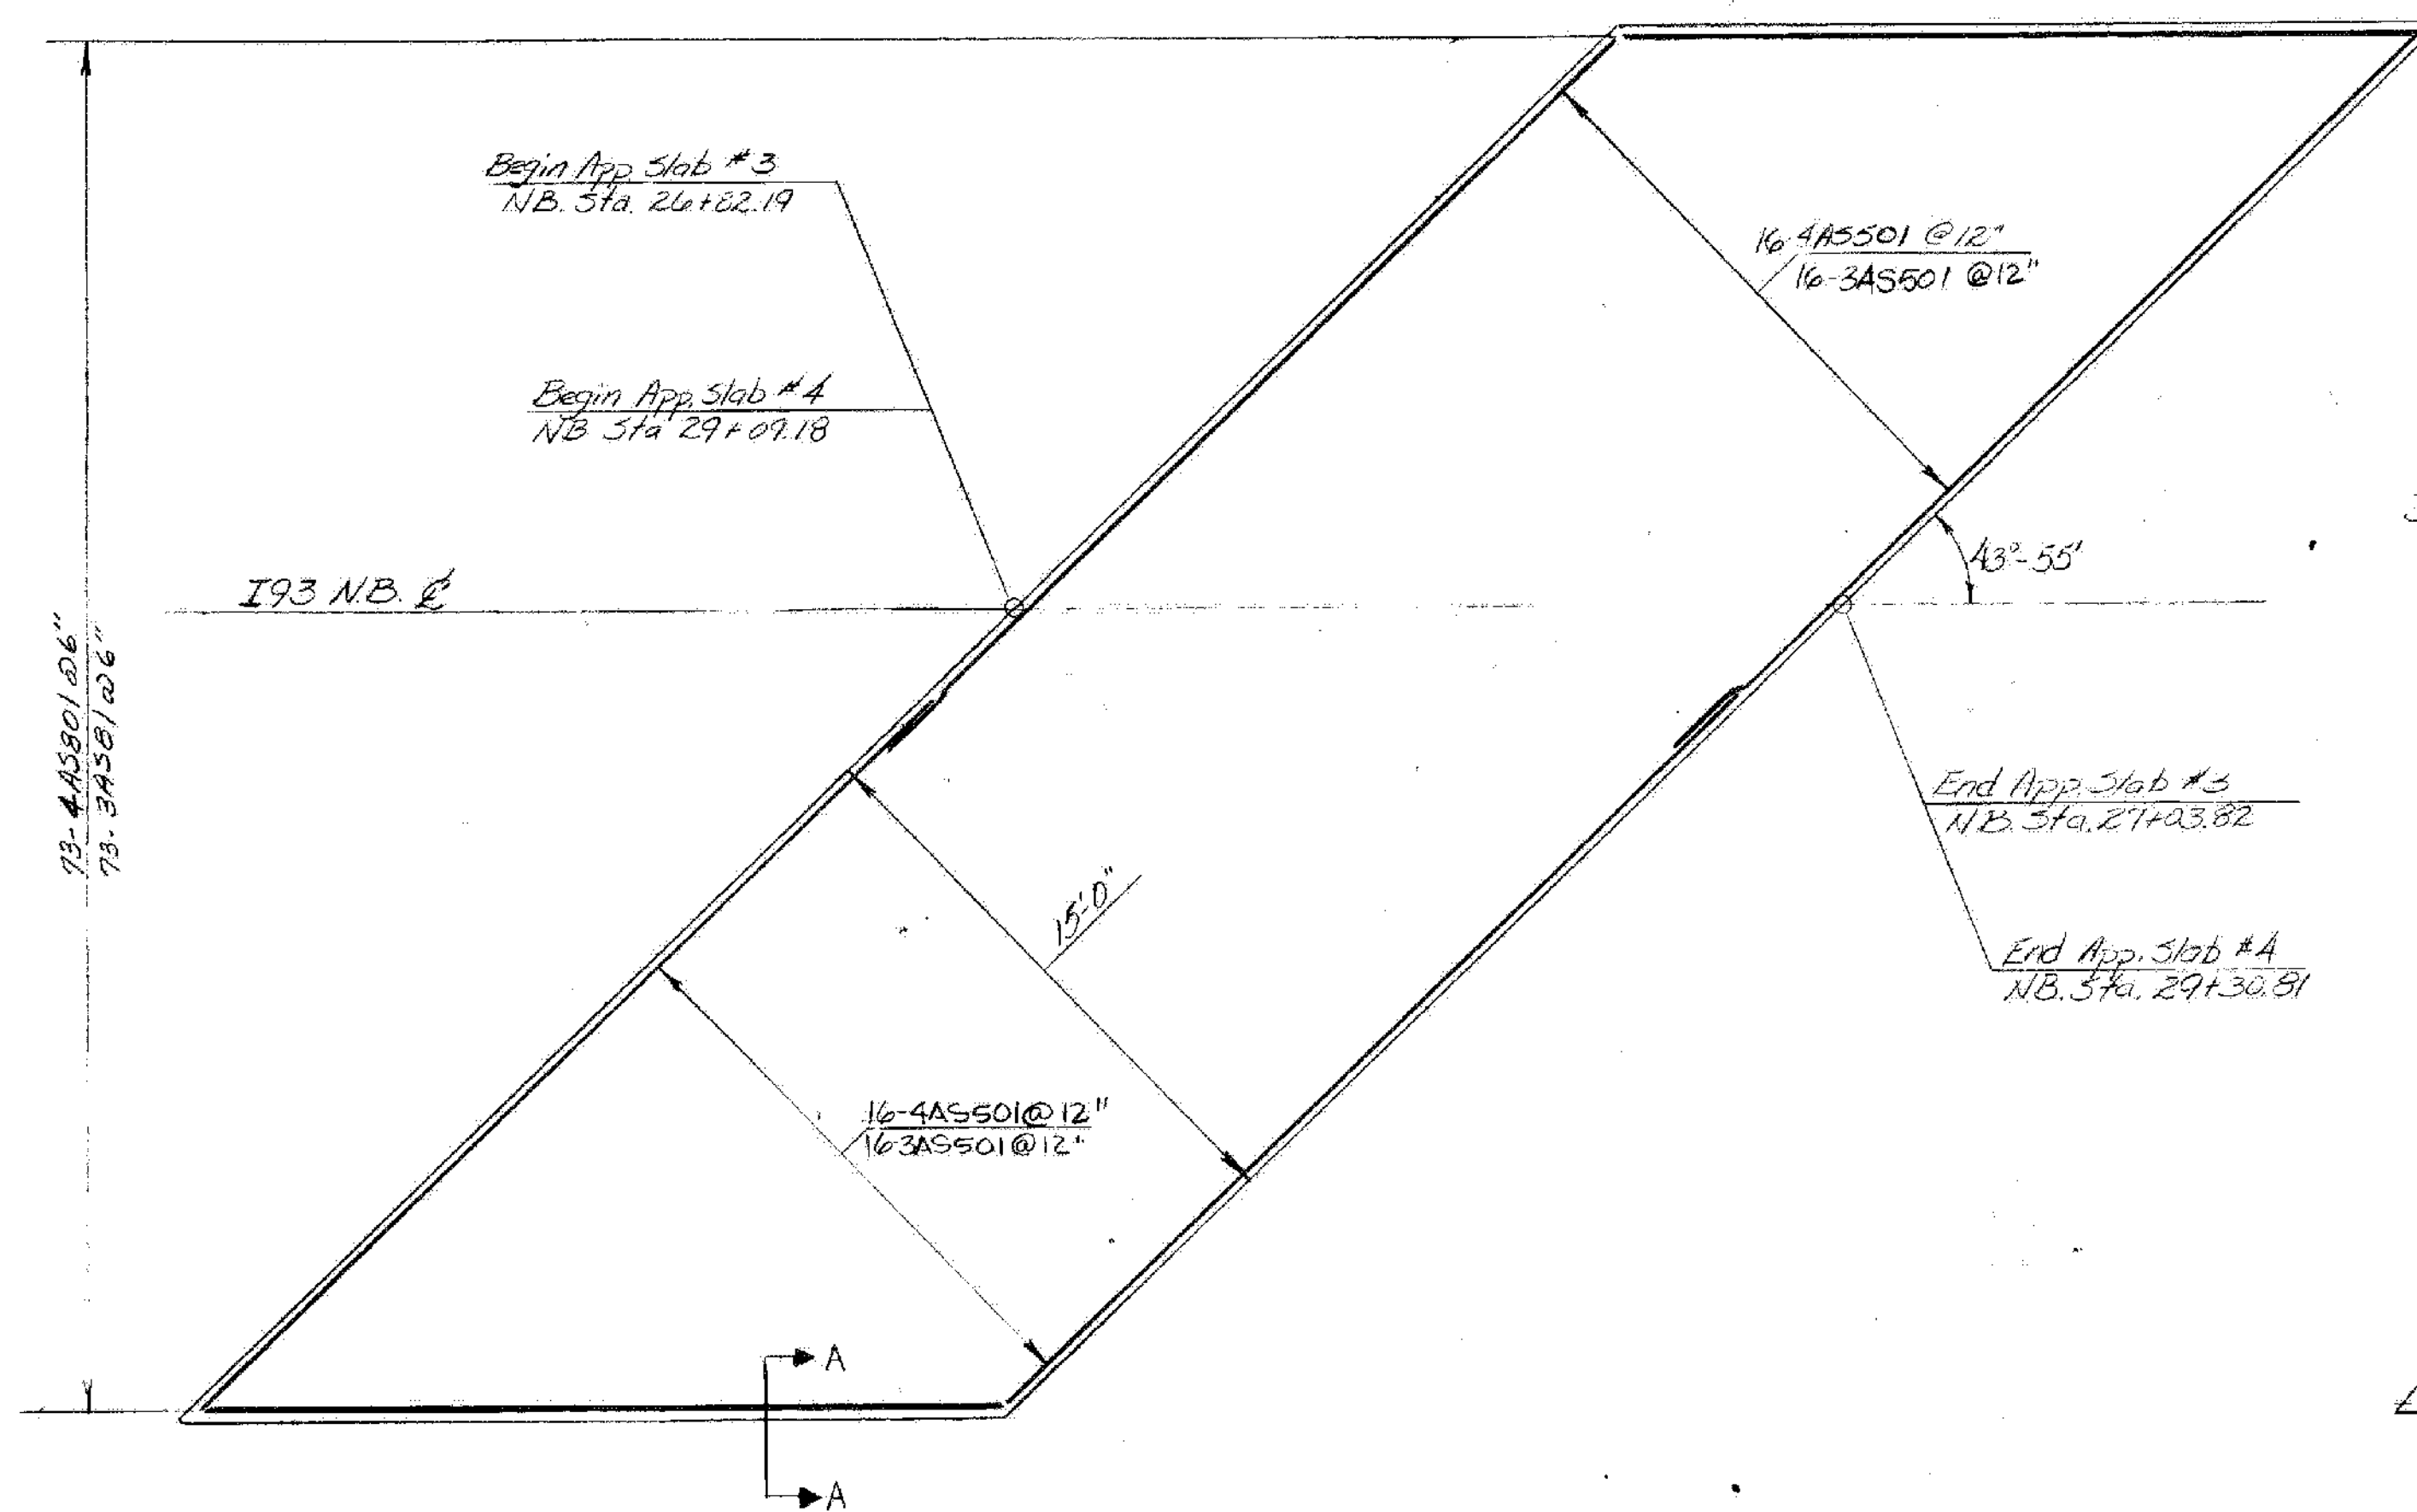


N.B. APPROACH SLABS PLAN
1/4" = 1'-0"

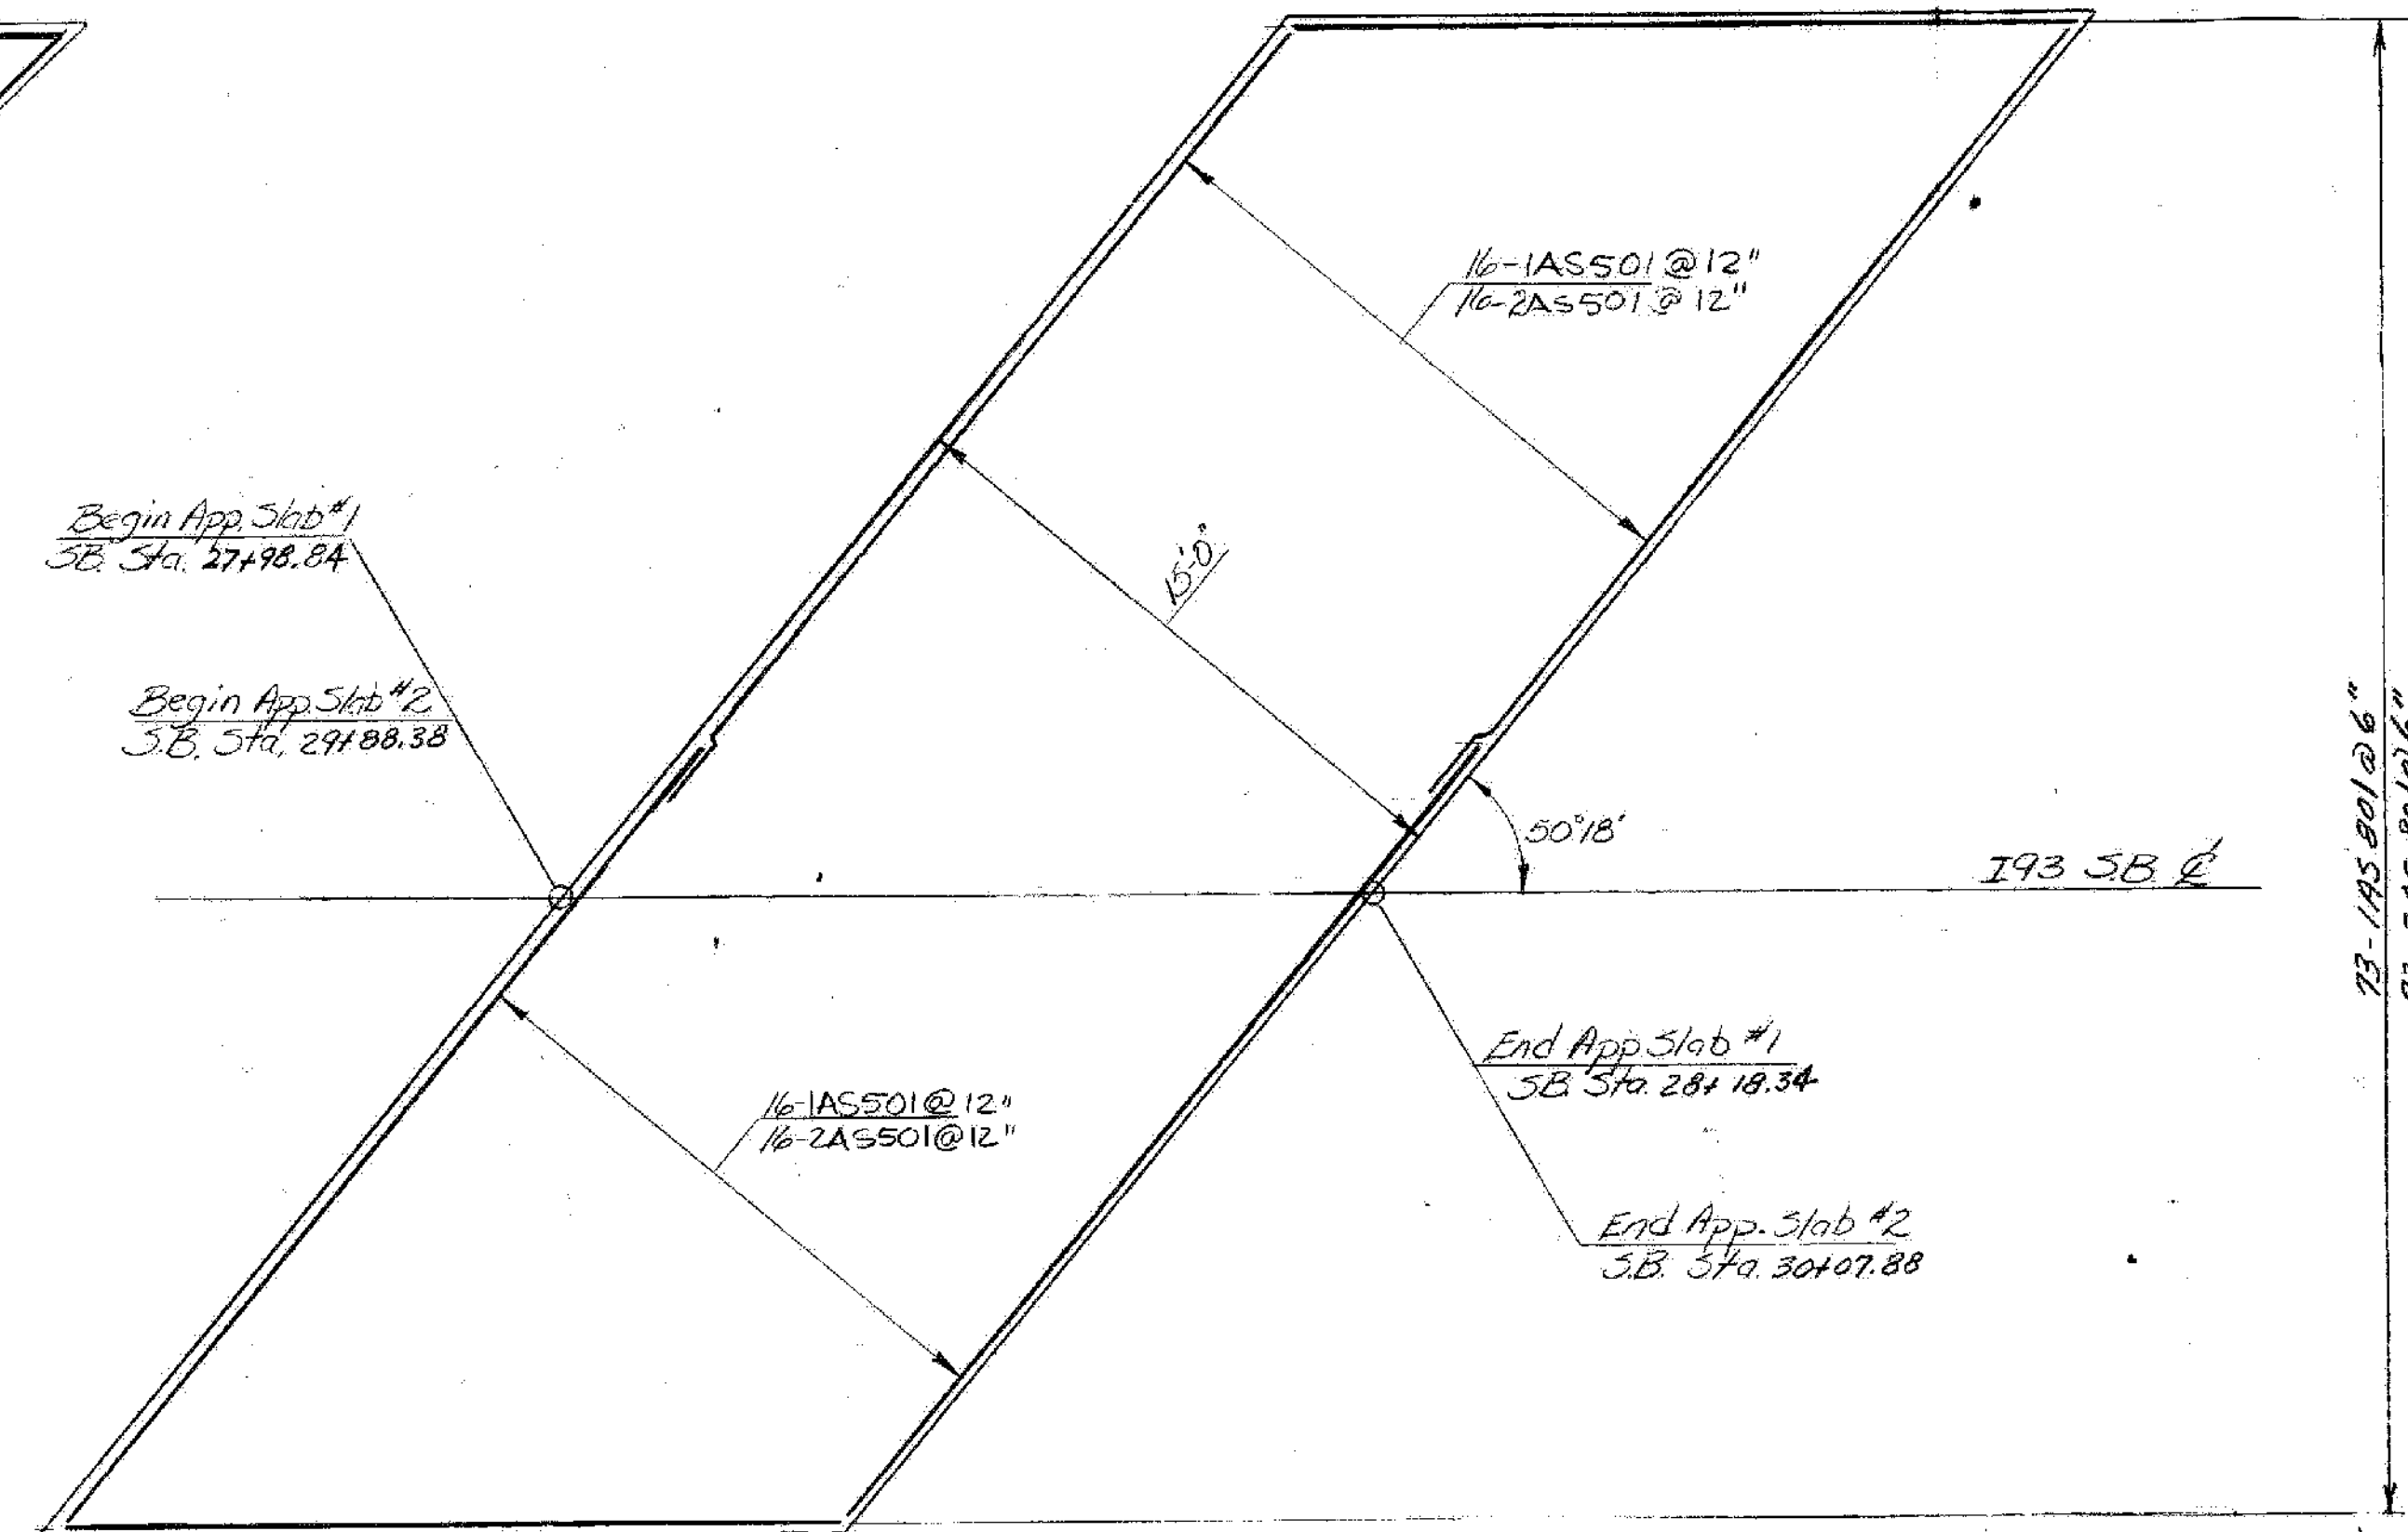

S.B. APPROACH SLABS PLAN
1/4" = 1'-0"

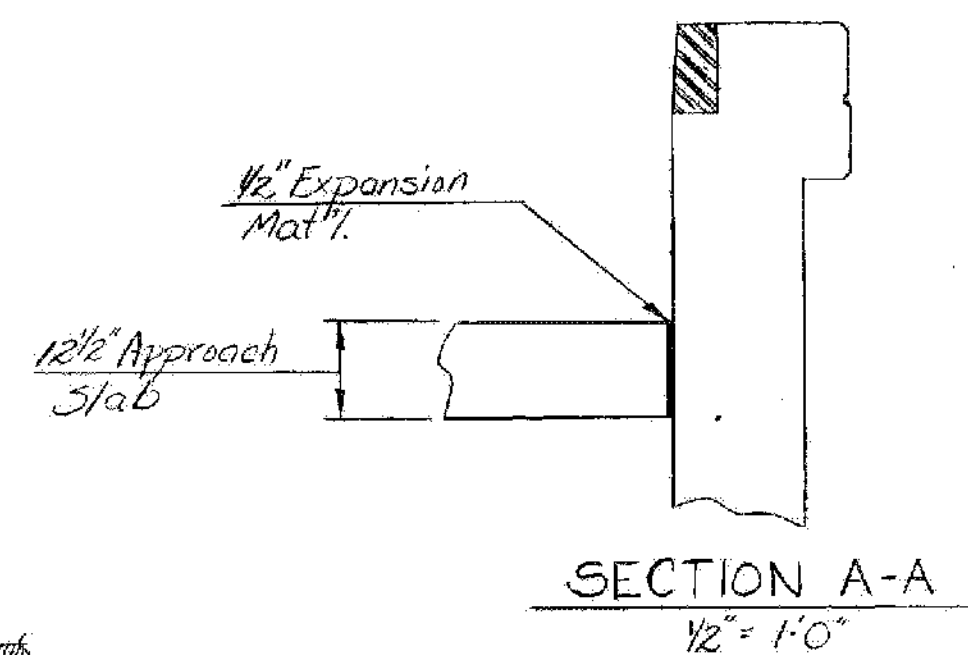

SECTION A-A
1/2" = 1'-0"

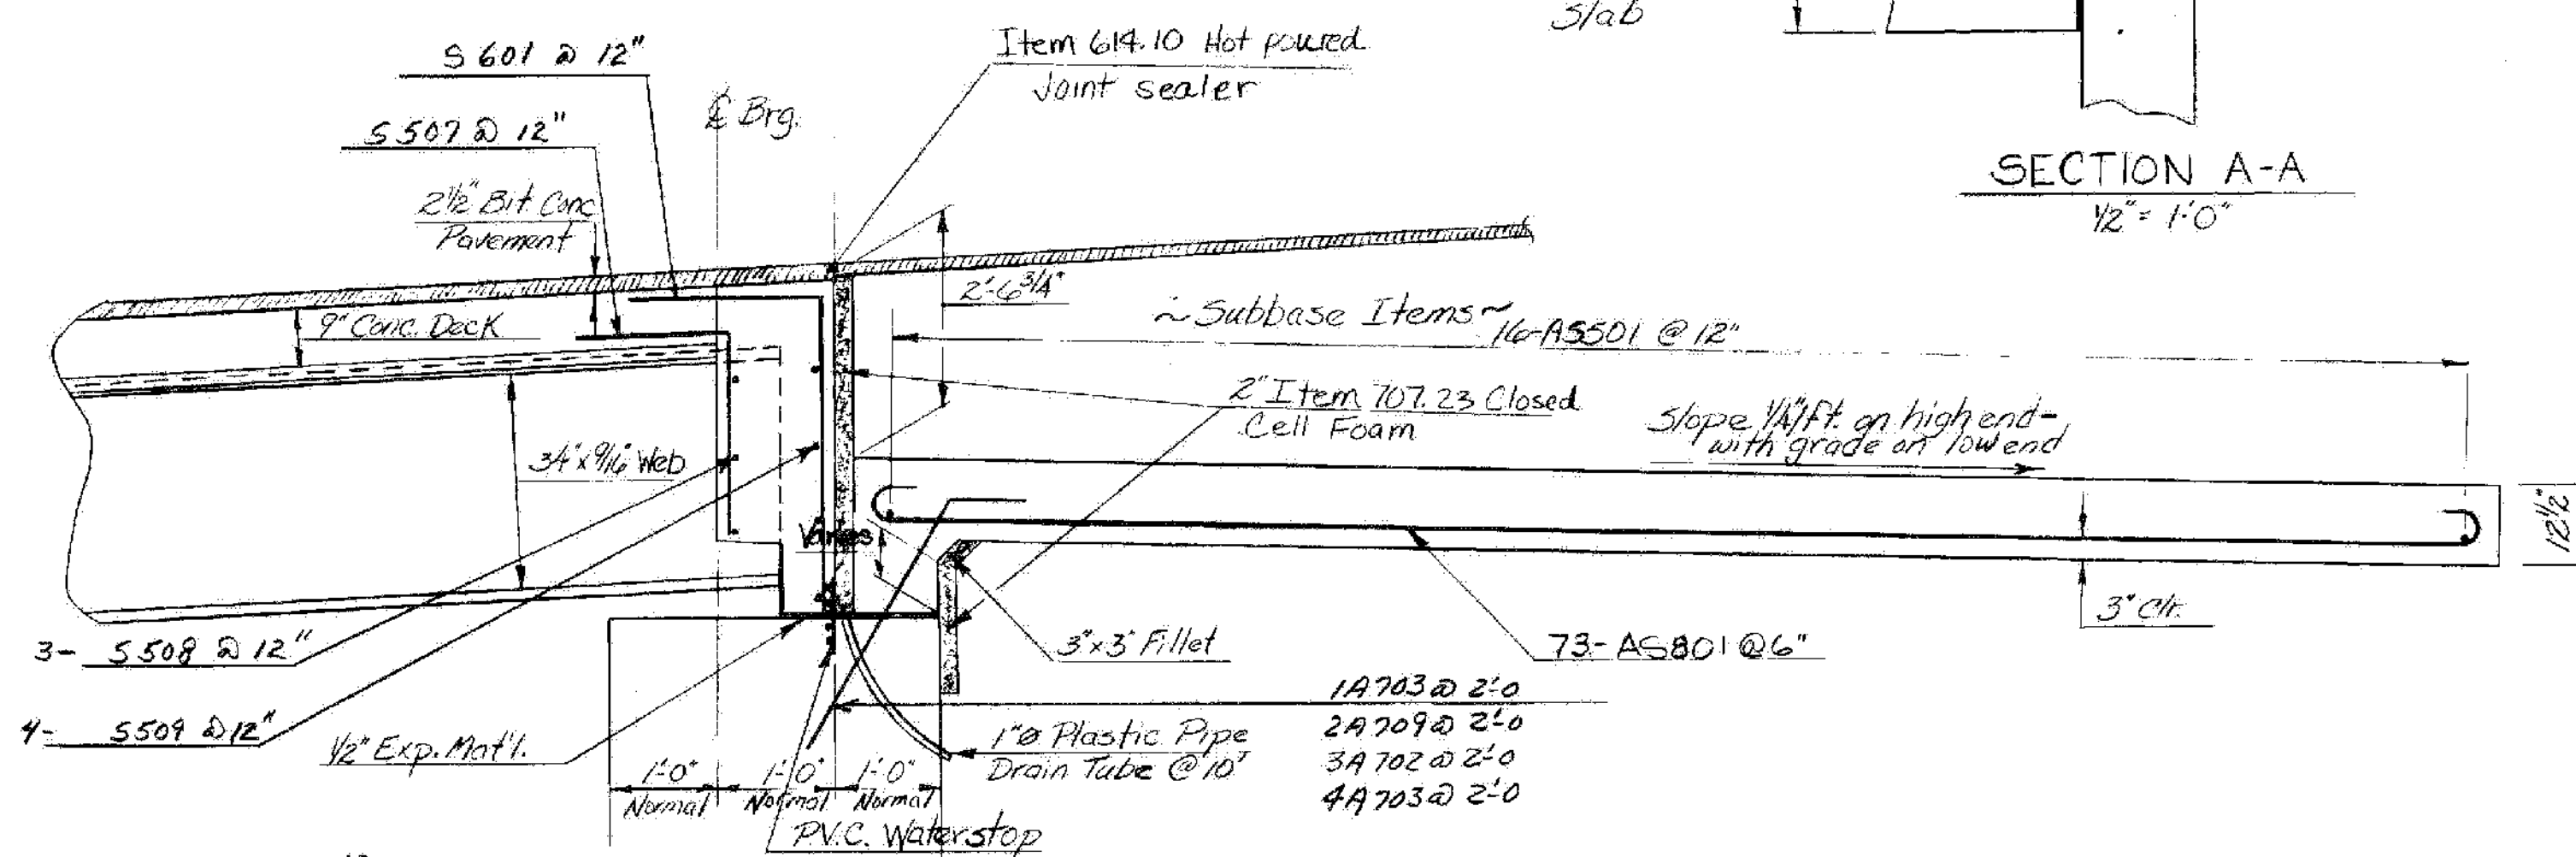

APPROACH SLAB SECTION FOR ABUTMENT 2, 3, & 4
1/2" = 1'-0"


FIELD CUT 5507, 5508, AND 5601 AS REQUIRED.

SEE BR III. FOR ABUTMENT 1 APPROACH SLAB

I-93 BRIDGES 1N&S
WATERFORD
IM MEMB(31)
SHEET 24 OF 48
FOR REFERENCE ONLY


**STATE OF VERMONT
AGENCY OF TRANSPORTATION**

TOWN OF WATERFORD	Bridge No. 1 NB & SB
HIGHWAY NO. I93	Log Sta.
I93 NB & SB Over Vt. Rte. 18	Surv. Sta. 23+0
N.B. & S.B. Approach Slab Details	
Designed by G. Spilak	Drawn by R. Whitcomb
Checked by A. Elwood date 6-18-80	Bridge Design Supervisor R.S. Haupt date 6-80
PROJECT CONTRACT 1	PROJECT NO. I93-1(3)
WATERFORD	
Bridge Sheet No. BR 120	Sheet 156 of 179

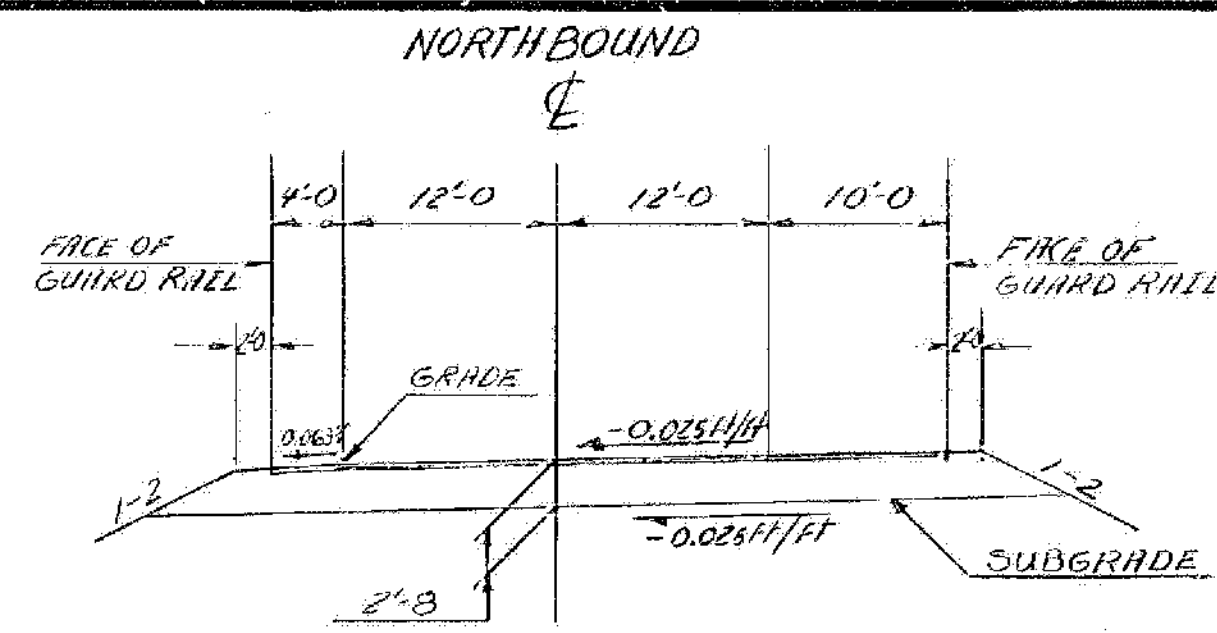

NEW HIGHWAY SECTION - BRIDGE APPROACHES

SCALE: 1"=10'-0"

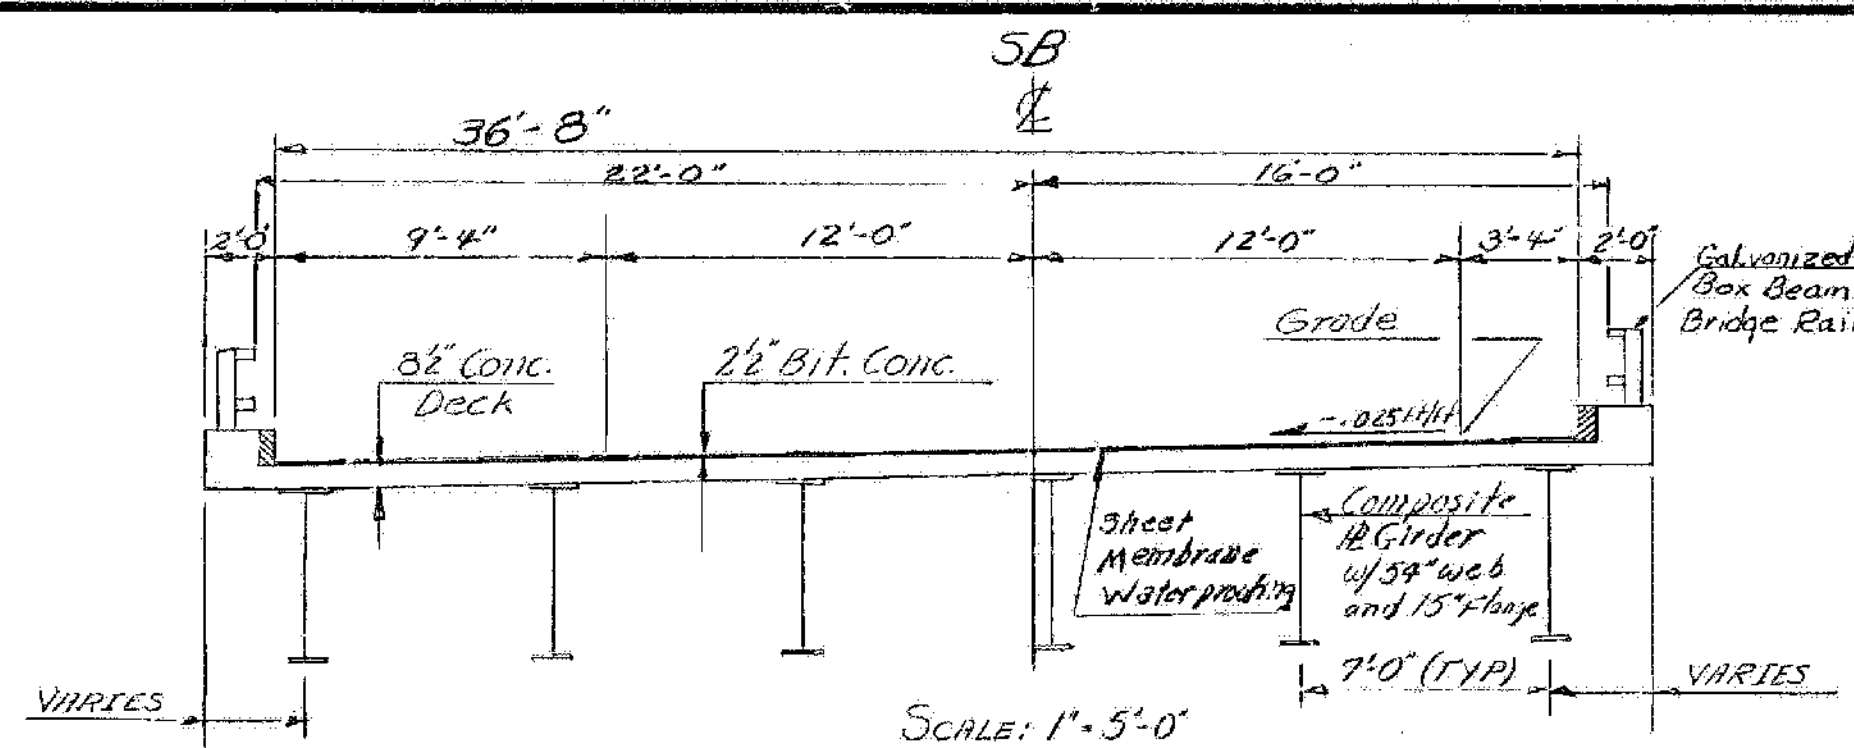

SB BRIDGE TYPICAL SECTION

SCALE: 1"=5'-0"

EXISTING STRUCTURE (None)

- STRUCTURE TYPE _____ OVERALL LENGTH _____ INVENTORY RATING _____
- SPAN LENGTH(S) CENTER TO CENTER OF BEARINGS _____
- CLEAR SPAN LENGTH(S) NORMAL TO STREAM _____
- WATERWAY AREA OF FULL OPENING (NORMAL TO STREAM) _____ VERTICAL CLEARANCE ABOVE STREAMBED _____
- WATER SURFACE ELEVATION @ Q 2.33 _____ WATER SURFACE ELEVATION @ Q _____
- WATER SURFACE ELEVATION AT FLOOD OF RECORD _____ YEAR _____ ESTIMATED DISCHARGE _____
- DOES ALL WATER PASS THROUGH EXISTING STRUCTURE? IF NOT, AT WHAT FREQUENCY AND ELEVATION DOES RELIEF OCCUR? _____
- ADDITIONAL WATERWAY AREA PROVIDED BY RELIEF _____
- TYPE OF SUBSTRUCTURE FOUNDATION MATERIAL _____
- DISPOSITION OF STRUCTURE _____


NEW STRUCTURE

- STRUCTURE GEOMETRY:
- STRUCTURE TYPE COMPOSITE PLATE GIRDER OVERALL LENGTH SB = 113.08' NB = 113.04'
 - SPAN LENGTH(S) CENTER TO CENTER OF BEARINGS SB = 11.00' NB = 11.00'
 - VERTICAL CLEARANCE ABOVE STREAMBED OR ROAD UNDER NB = 16'-4" SB = 16'-5"
 - CLEAR SPAN LENGTH(S) NORMAL TO STREAM N/A
 - WATERWAY AREA OF FULL OPENING (NORMAL TO STREAM) N/A
 - ARE PROVISIONS TO BE MADE FOR PUBLIC UTILITIES? NO

- HYDRAULIC DATA: N/A
- Q 2.33 _____ WATER ELEVATION _____ VELOCITY _____
 - Q 10 _____ WATER ELEVATION _____ VELOCITY _____
 - Q 25 _____ WATER ELEVATION _____ VELOCITY _____
 - Q 50 _____ WATER ELEVATION _____ VELOCITY _____
 - Q 100 _____ WATER ELEVATION _____ VELOCITY _____
 - DRAINAGE AREA _____ CHARACTER OF TERRAIN _____
 - ARE THERE OBJECTIONS TO A PIER IN THE STREAM? _____
 - DOES STREAM REACH ITS MAXIMUM HIGH WATER ELEVATION RAPIDLY? IS ORDINARY RISE RAPID? _____
 - NATURE OF NATURAL STREAMBED _____
 - ESTIMATED SCOUR DEPTH _____ COMMENT ON: DRIFT _____ ICE _____
 - WILL ALL WATER PASS THROUGH NEW STRUCTURE? IF NOT, WHAT FREQUENCY AND ELEVATION WILL RELIEF OCCUR? _____
 - ADDITIONAL WATERWAY AREA PROVIDED BY RELIEF _____
 - VERTICAL CLEARANCE ABOVE Q _____ LIMITED BY _____
 - ALLOWABLE WATER SURFACE ELEVATION _____
 - IS DESIGN STAGE AFFECTED BY UPSTREAM OR DOWNSTREAM CONDITIONS? IF YES, DESCRIBE _____
 - AVERAGE DAILY LOW FLOW _____ DEPTH _____ AVERAGE DAILY HIGH FLOW _____ DEPTH _____
 - STREAMBANK OR CHANNEL PROTECTION REQUIRED _____
 - DISTANCE TO EXISTING UPSTREAM STRUCTURE _____ SPAN _____ WATERWAY AREA OF FULL OPENING _____
 - DISTANCE TO EXISTING DOWNSTREAM STRUCTURE _____ SPAN _____ WATERWAY AREA OF FULL OPENING _____


- ALLOWABLE STRESSES:
- DESIGN LIVE LOAD AASHTO H15 25-44
 - ALLOWABLE LOAD FOR SPREAD FOOTINGS ON SOIL 2 Tons/FT² ON LEDGE N/A
 - ALLOWABLE LOAD FOR PILING N/A TYPE N/A ESTIMATED LENGTH N/A
 - ALLOWABLE STRESS FOR STRUCTURAL STEEL ASTM A 588 TENSION 27,000 PSI
 - ALLOWABLE STRESS FOR REINFORCING STEEL GRADE 60 TENSION 24,000 PSI COMPRESSION 20,000 PSI
 - ALLOWABLE STRESS FOR CONCRETE CLASS A 3,500 PSI CLASS B 3,500 PSI 1,400 PSI 1,400 PSI

- TRAFFIC MAINTENANCE:
- IS TRAFFIC TO BE MAINTAINED? N/A IF YES, ON EXISTING STRUCTURE N/A OR ON TEMPORARY BRIDGE N/A
 - TEMPORARY BRIDGE REQUIREMENTS: ONE OR TWO WAY N/A TRAFFIC CONTROL SIGNALS REQUIRED N/A MINIMUM CLEAR SPAN N/A MINIMUM CLEAR HEIGHT N/A MINIMUM WATERWAY AREA N/A ARE SIDEWALKS REQUIRED? N/A IF SO, ON WHAT SIDE? N/A

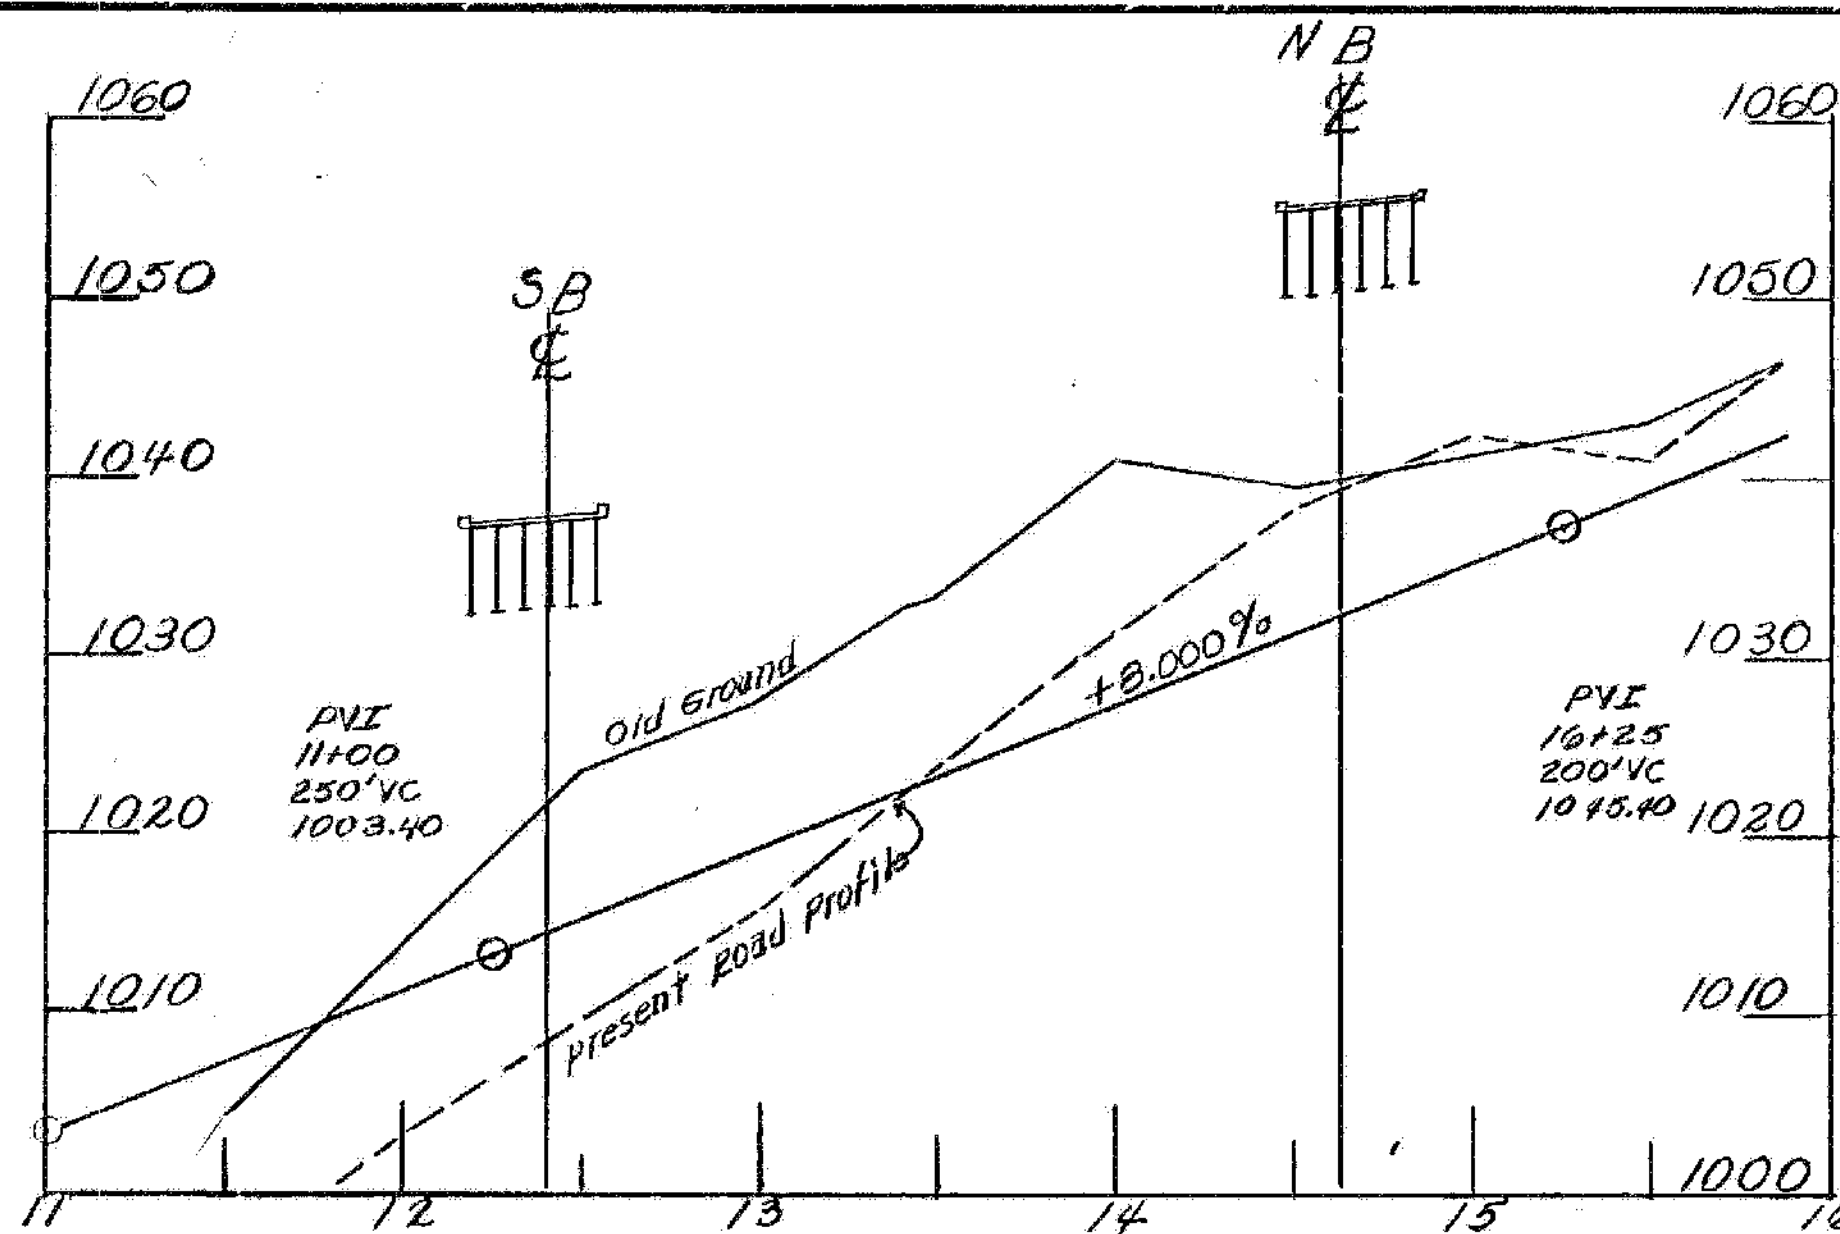


TOWN HIGHWAY #12 - PROFILE

Scale: 1"=50' (hor)
1"=10' (vert)

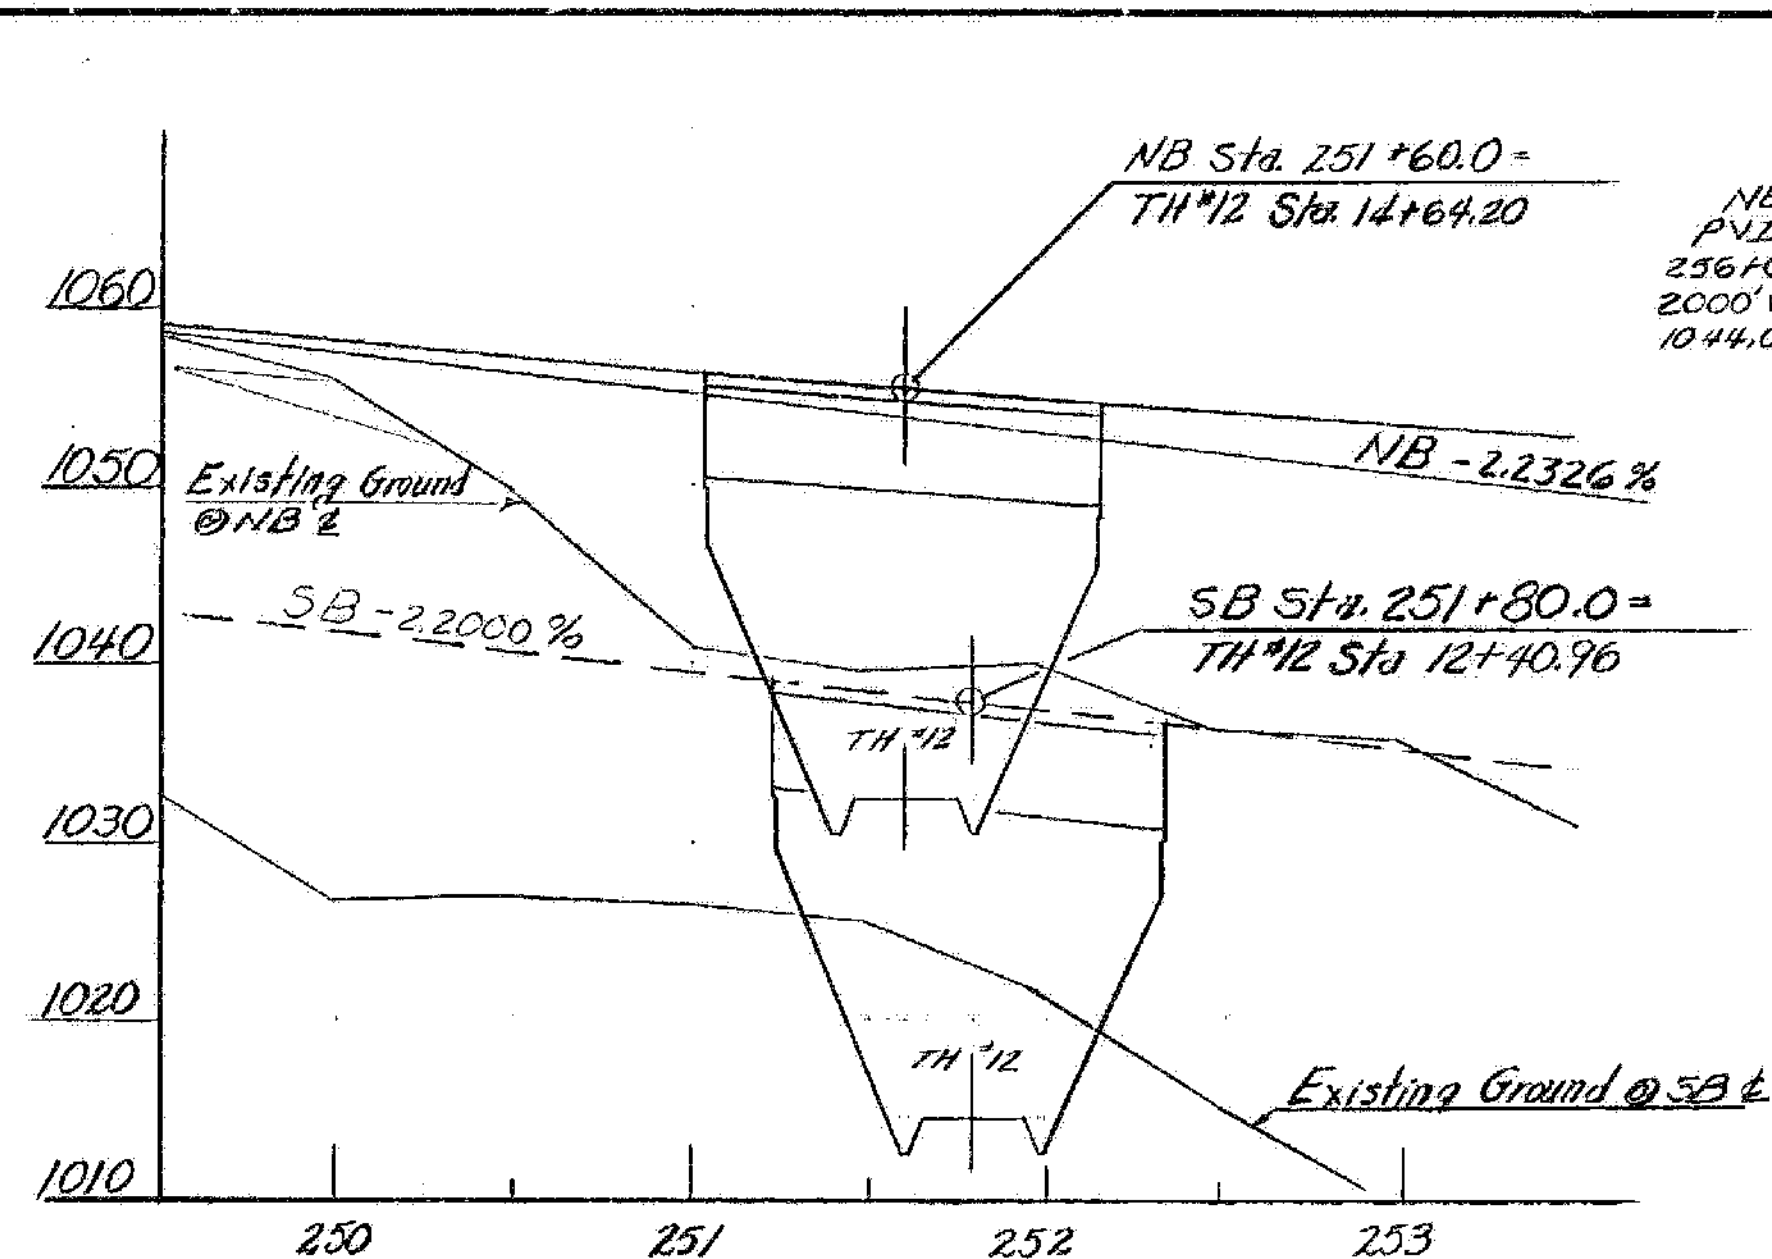

NB & SB PROFILE

Scale: 1"=50' (hor)
1"=10' (vert)

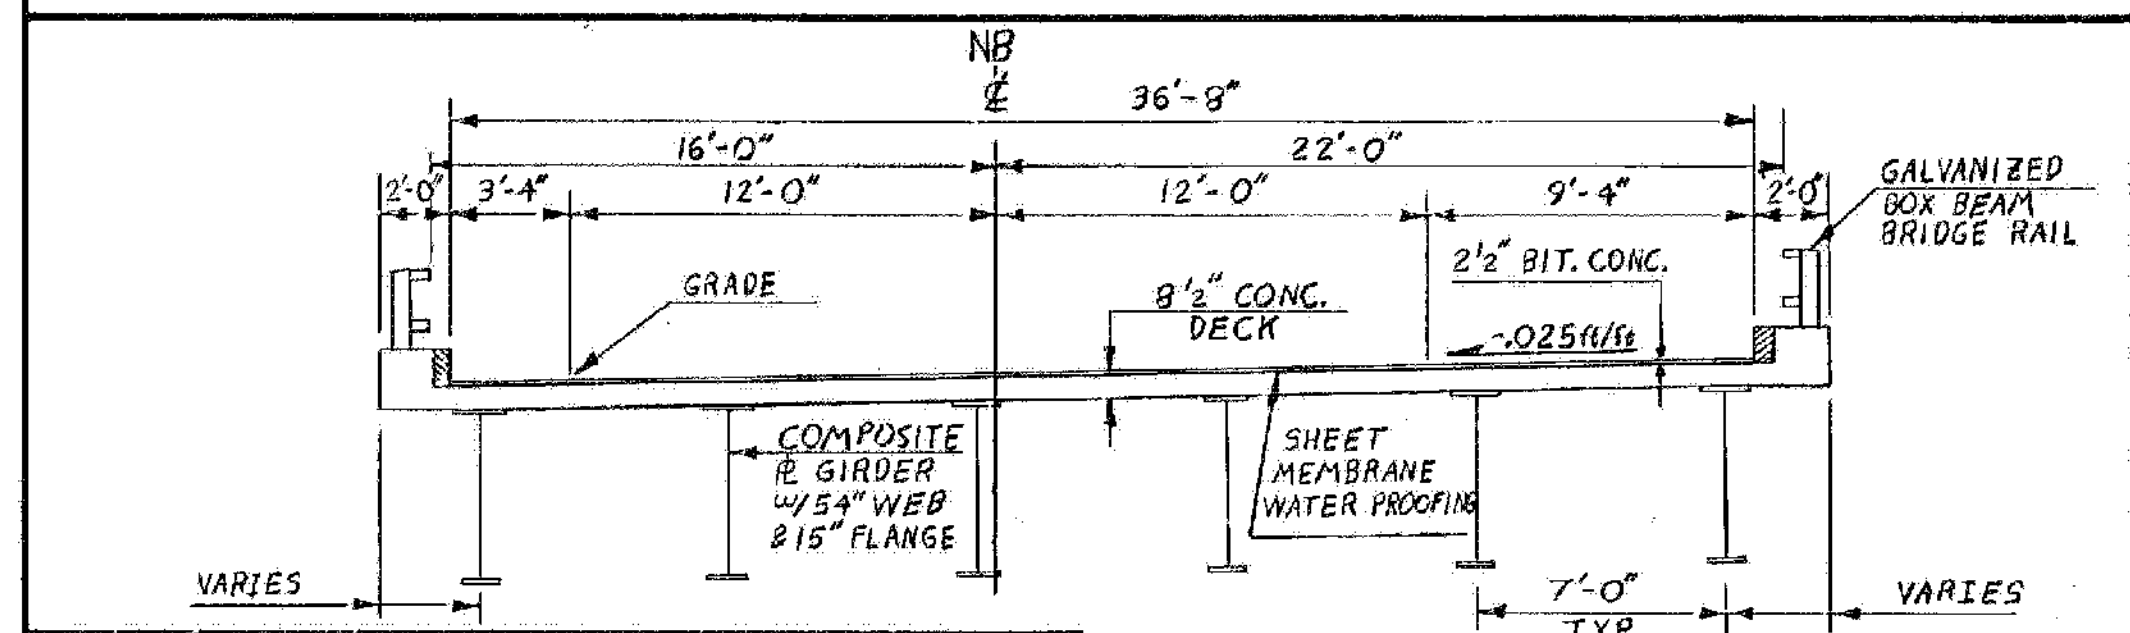

NB BRIDGE TYPICAL SECTION

SCALE: 1"=5'-0"

STRESS LEVELS	TRUCK						
	H5	H	3S2	6 AXLE	3A STR.	4A STR.	5A SEMI
INVENTORY	52	47					
0.55 F _y = 27.0							
POSTED	74	93			77	78	87
0.67 F _y = 33.5							
OPERATING	114	131					
0.75 F _y = 37.5							

RECOMMENDED FOR APPROVAL W. M. Smith 1-30-80 DATE
STRUCTURES ENGINEER
RECOMMENDED FOR APPROVAL Chris Lane 1-30-80 DATE
CHIEF OF DESIGN
APPROVED BY S. J. Cone 1-30-80 DATE
DIRECTOR OF ENGINEERING & CONSTRUCTION


STATE OF VERMONT AGENCY OF TRANSPORTATION
WATERFORD (IM MEMB(31))
SHEET 25 OF 48
FOR REFERENCE ONLY

TOWN OF WATERFORD
Log Sta. _____
HIGHWAY NO. I 93 NB & SB
Surv. Sta. 251+70

I 93 NB & SB OVER TH #12
PRELIMINARY INFORMATION SHEET

Designed by Plumb Drawn by Plumb
Checked by S. Farnsworth Bridge Design Supervisor
G. ROGERS 9/80 date 1-21-80 F. W. Balkum date 1-80


PROJECT WATERFORD PROJECT NO. I 93-1(3) 9/2
Bridge Sheet No. BR500 Sheet 121 of 531

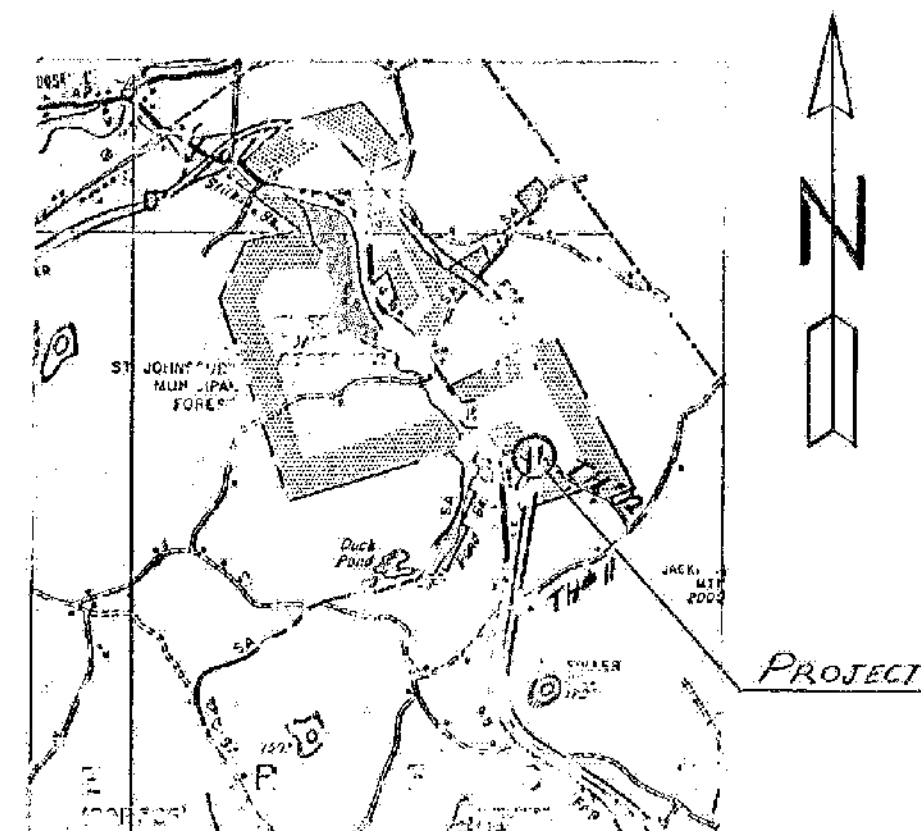

PROJECT LOCATION

Scale: 1"=1 mile


INDEX OF SHEETS ON SHEET BR502
GENERAL NOTES ON SHEET BR503

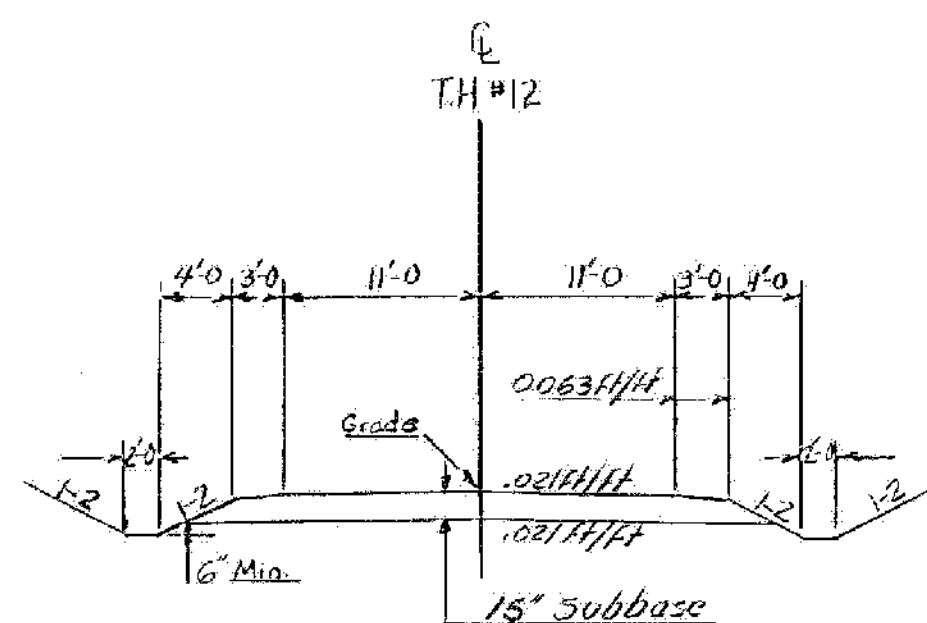


TOWN HIGHWAY SECTION NORMAL

SCALE: 1"=10'-0"

ALL AB

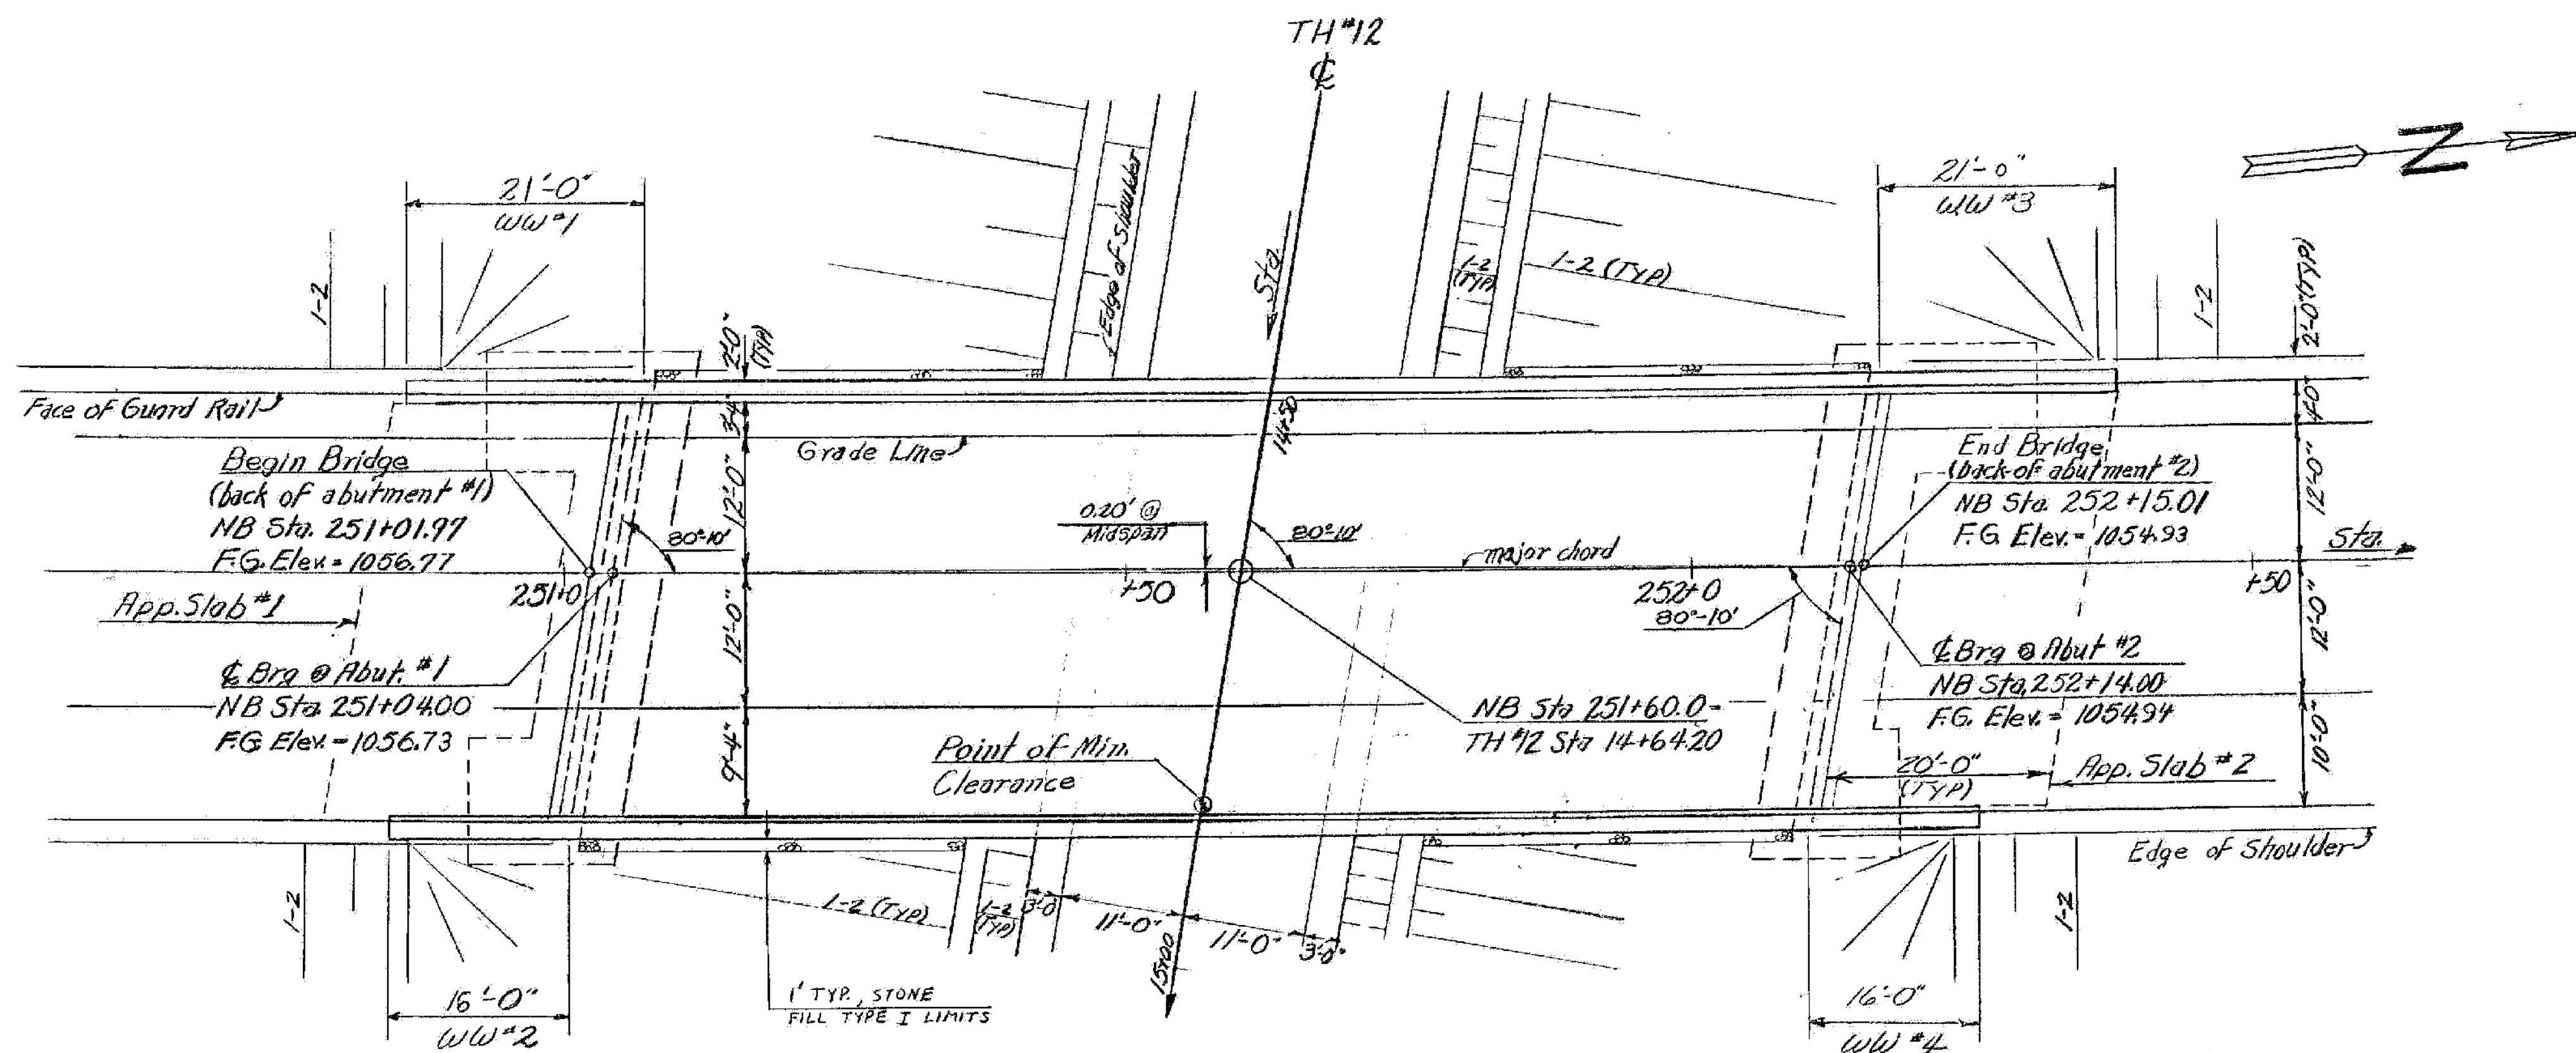

PLAN
Scale: 1"=10'

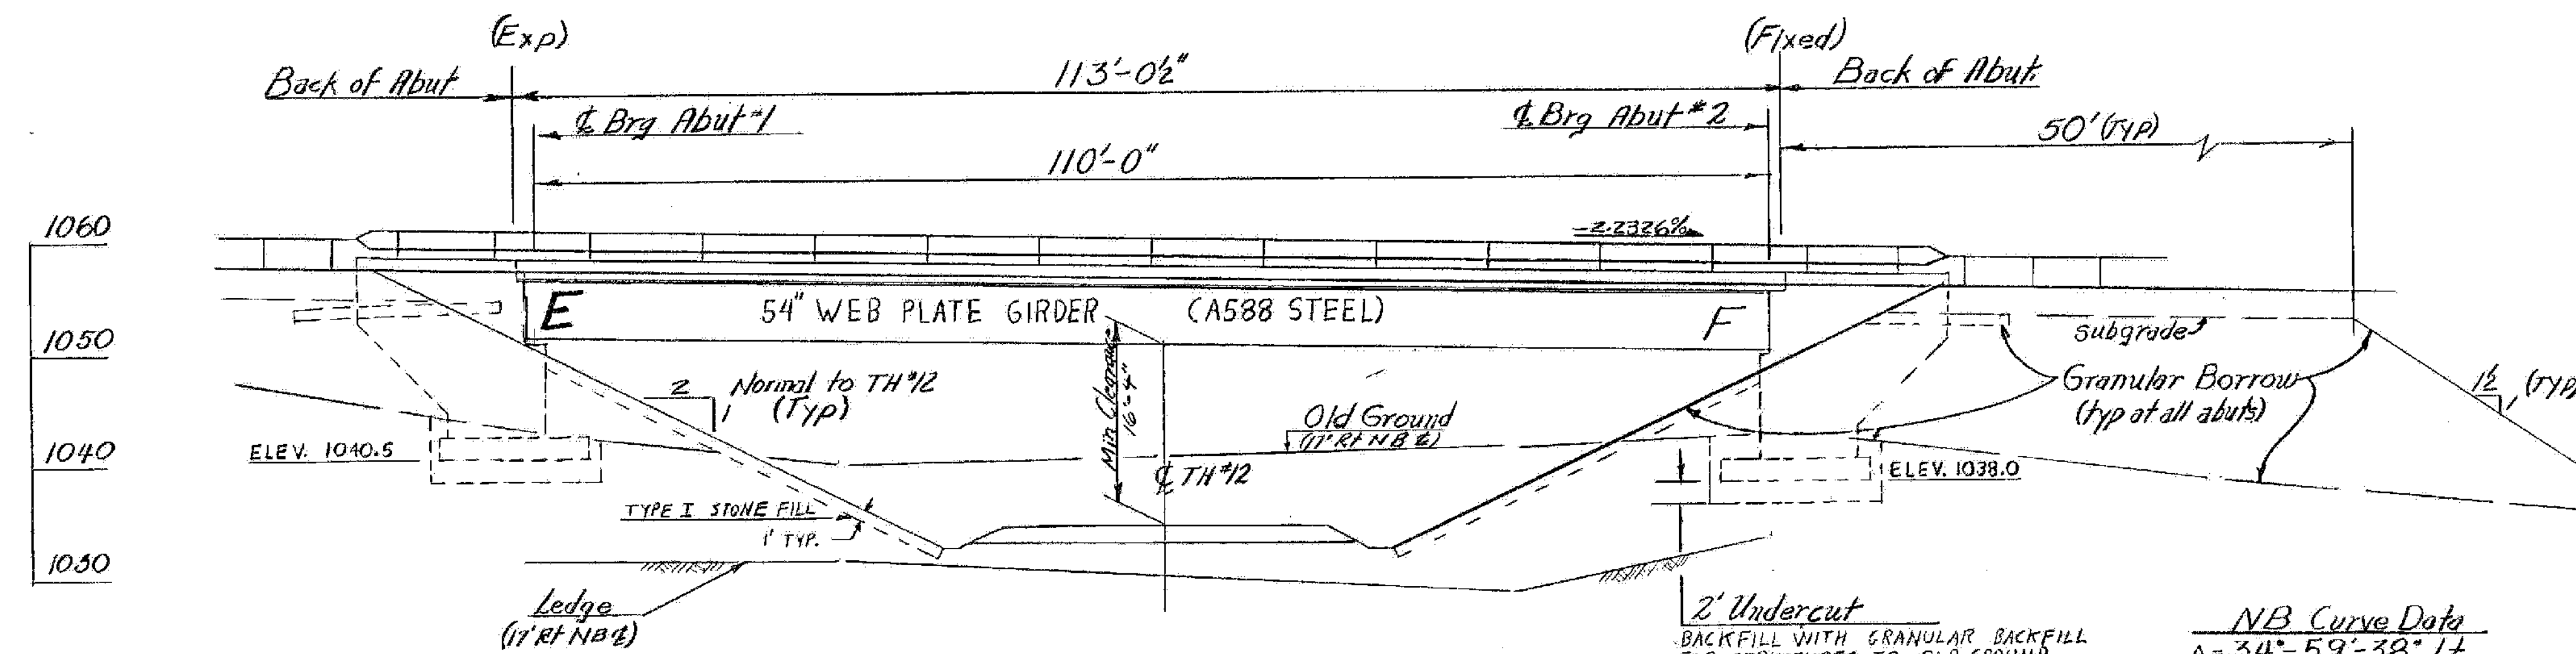

ELEVATION (along rt. Fascia)
Scale: 1"=10'

NB Curve Data
 $\Delta = 34^\circ - 59' - 38''$ LT
 $D = 0^\circ - 45'$
 $R = 7639.44$
 $T = 2408.26$
 $L = 4665.85$
 $E = 393.00$
 $Bnh. = 0.025 \%$

PVI
 Sta. NB 256+00
 Elev. = 1044.00
 L.C. = 2000 FT.
 $E_1 = 5.34 \%$
 $k = 933$ FT.
 $G_1 = -2.2326 \%$
 $G_2 = -0.0909 \%$

INDEX OF SHEETS

BR 500	PRELIMINARY INFORMATION SHEET
BR 501	BRIDGE QUANTITY SHEET
BR 502	NORTHBOUND PLAN & ELEVATION SHEET
BR 503	SOUTHBOUND PLAN & ELEVATION SHEET
BR 504	BORING LOGS
BR 505	TYPICAL SECTION & DECK REINFORCING STEEL
BR 506	FRAMING PLAN, GIRDER ELEVATION, & CROSS FRAMES
BR 507	BEARING DETAILS
BR 508	BRIDGE APPROACH & ILL DETAILS, STEEL BEAM TO BOX BEAM
BR 509	APPROACH SLAB DETAILS AND ABUTMENT BACKFILL & EXCAVATION TYP.
BR 510	ABUTMENT #1 & WINGWALL #2 DETAILS
BR 511	ABUTMENT #2 & WINGWALL #3 DETAILS
BR 512	ABUTMENTS #1 & 2 FOOTINGS, AND WINGWALLS #1 & 4 DETAILS
BR 513	ABUTMENT #3 & WINGWALL #6 DETAILS
BR 514	ABUTMENT #4 & WINGWALL #7 DETAILS
BR 515	ABUTMENTS #5 & 4 FOOTINGS, AND WINGWALLS #5 & 8 DETAILS
BR 516-519	REINFORCING STEEL SCHEDULE

STANDARD DRAWINGS

STD. DWG.	SCB-D1-75	APRIL 3, 1978 (R)
STD. DWG.	SCB-D4-76	JAN. 8, 1976 (R)
STD. DWG.	SCB-D6-73	JAN. 3, 1977 (R)
STD. DWG.	SCB-D7-71 (DETAIL C)	DEC. 15, 1976 (R)
STD. DWG.	SCB-D8-71	JUNE 1, 1977 (R)
STD. DWG.	SCB-D9-71	JAN. 27, 1975 (R)
STD. DWG.	SB-R4-73	NOV. 21, 1979 (R)


REFERENCE SHEETS

193, NB & SB	PLAN STA. 255+0 - 267+0	(2 SHEETS)
193, NB & SB	PROFILE STA. 255+0 - 267+0	(2 SHEETS)
TH #12	RELOCATION PLAN & PROFILE STA. 7+0 - 20+0	(1 SHEET)
193, NB X-SECTIONS	STA. 250+50 - 252+50	(1 SHEET)
193, SB X-SECTIONS	STA. 249+00 - 254+00	(1 SHEET)
TH #12	RELOCATION X-SECTIONS STA. 11+50 - 15+50	(2 SHEETS)

I-93 BRIDGES 3N&S
 WATERFORD
 IM MEMB(31)
 SHEET 26 OF 48
 FOR REFERENCE ONLY

STATE OF VERMONT
AGENCY OF TRANSPORTATION


TOWN OF	WATERFORD	Bridge No.	B5
HIGHWAY NO.	I 93 NB	Log Sta.	
		Surr. Sta.	251+70
I 93 NORTHBOUND OVER TH #12			
PLAN AND ELEVATION SHEET			
Designed by	Plumb	Drawn by	Plumb
Checked by	S. Farnsworth	Bridge Design Supervisor	
	4/80 date 1-80	F.W. Bolken	date 1-80
PROJECT	WATERFORD	PROJECT NO.	I 93-1(3) 1/2
Bridge Sheet No.	BR502	Sheet	123 of 531

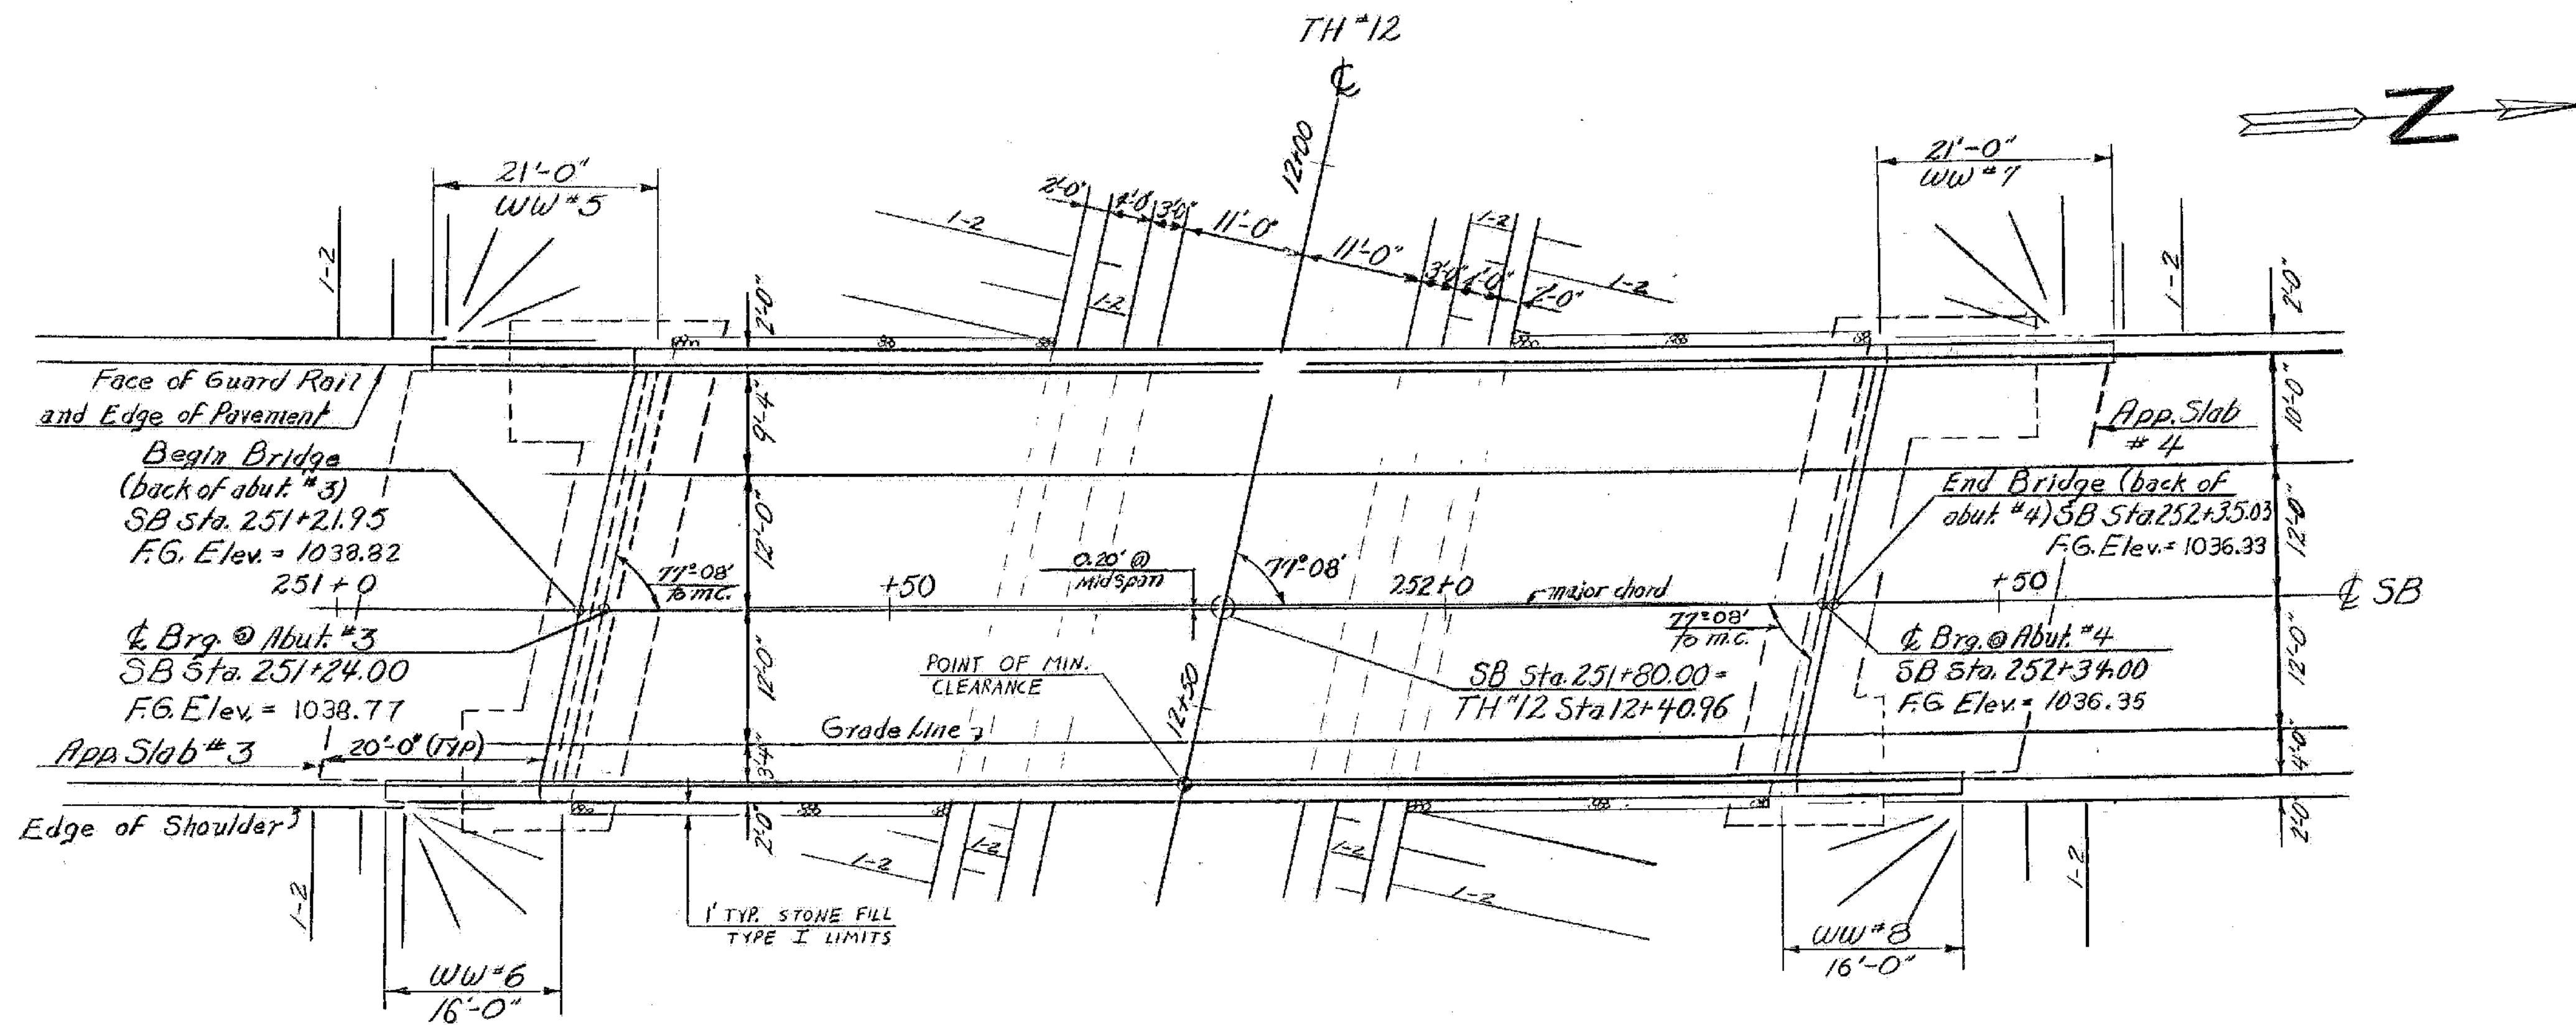

PLAN
Scale: 1"=10'

GENERAL NOTES

1. THE GENERAL NOTE PERTAINING TO SPECIFICATIONS, MATERIALS, AND CONSTRUCTION IS SHOWN ON STD. DWG. SCB-01-75. OTHER GENERAL NOTES ON THE STANDARD, NOT OTHERWISE SHOWN OR MODIFIED ON THESE PLANS, ARE NOTES 1, 2, 3, 4, 5, 6, 7, 8, 9, 10, 11, 13, 14, & 16.
2. FLEMING BRACKETS OR SIMILAR FALSEWORK SHALL BE SPACED AT A MAXIMUM OF FOUR (4) FEET.
3. WATER REPELLENT SHALL BE APPLIED TO ALL EXPOSED AREAS OF THE ABUTMENTS AND HINGALLS, CURBS, FASCIA, AND THE CURB SOFFIT BACK TO THE DRIP NOTCH.
4. ALL WEEP PIPES SHALL BE PLACED ON THE LOW CURB SIDE ONLY; AND BETWEEN THE ABUTMENT AND EDGE OF TH 12 SHOULDER. THEY SHOULD NOT BE PLACED MORE THAN TEN (10) FEET APART OR WITHIN TWO (2) HORIZONTAL FEET OF ABUTMENT OR CROSS FRAMES.
5. THE PREFORMED JOINT FILLER, VINYLFOAM, SHALL BE SEMI-RIGID GRADE, AND SHALL MEET THE REQUIREMENTS OF SUB-SECTION 707.23. PAYMENT SHALL BE INCLUDED IN THE UNIT BID PRICE FOR CONCRETE, CLASS A.
6. THE PVC WATER STOP SHALL BE AS SPECIFIED IN SUBSECTION 707.30. THE COST OF THE WATER STOP SHALL BE INCLUDED IN THE UNIT PRICE BID FOR CONCRETE, CLASS A.
7. FOR CURB JOINT DETAILS, SEE STANDARD SCB-D4-76, DETAIL B.
8. FOR TREATMENT OF THE CURB AREA BETWEEN THE DECK AND HINGALLS, SEE STANDARD SHEET SCB-D9-71, AND NOTE THE FOLLOWING CHANGES:
OMIT WATERSTOP AND INCREASE 1/2" EXPANSION MATERIAL, PREFORMED JOINT FILLER, CORK, TO 1".

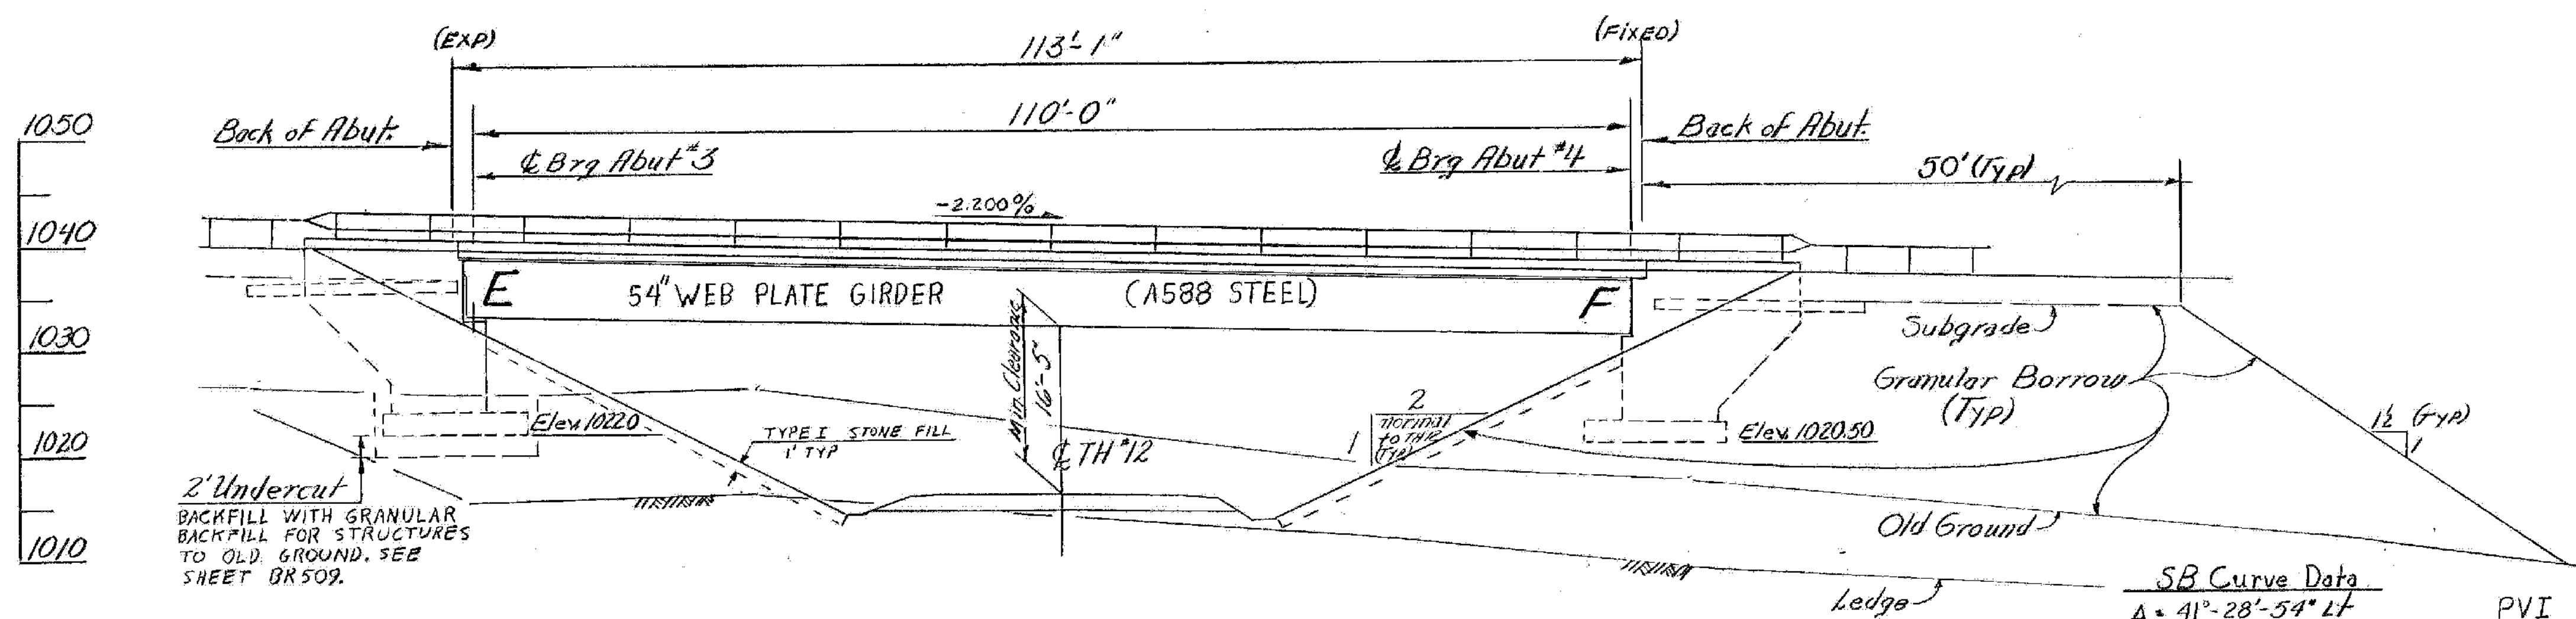







ELEVATION (along r.t. Fascia)
Scale: 1"=10'

SB Curve Data
 $\Delta = 41^\circ-28'-54''$ LT
 $D = 0^\circ-45'$
 $R = 7639.44$
 $T = 2892.93$
 $L = 5530.89$
 $E = 529.41$
 $Bnk = 0.025'$





PVI
 SB STA. 264+00.00
 ELEV. = 1011.00
 LC = 1800'
 E = 8.15
 $G_1 = -2.2000\%$
 $G_2 = +1.4223\%$

I-93 BRIDGES 3N&S
 WATERFORD
 IM MEMB(31)
 SHEET 27 OF 48
 FOR REFERENCE ONLY

STATE OF VERMONT	
AGENCY OF TRANSPORTATION	
TOWN OF WATERFORD	Bridge No. B5
HIGHWAY NO. I 93	Log Sta.
	Surv. Sta. 251+70
I93 SOUTHBOUND over TH #12	
PLAN and ELEVATION SHEET	
Designed by Plumb	Drawn by Plumb
Checked by S. Farnsworth	Bridge Design Supervisor
G. ROGERS 1/30 date 1-80	F.W. Balkum date 1-80
PROJECT WATERFORD	PROJECT NO. I93-1(3) 1/2
Bridge Sheet No. BR 503	Sheet 124 of 531

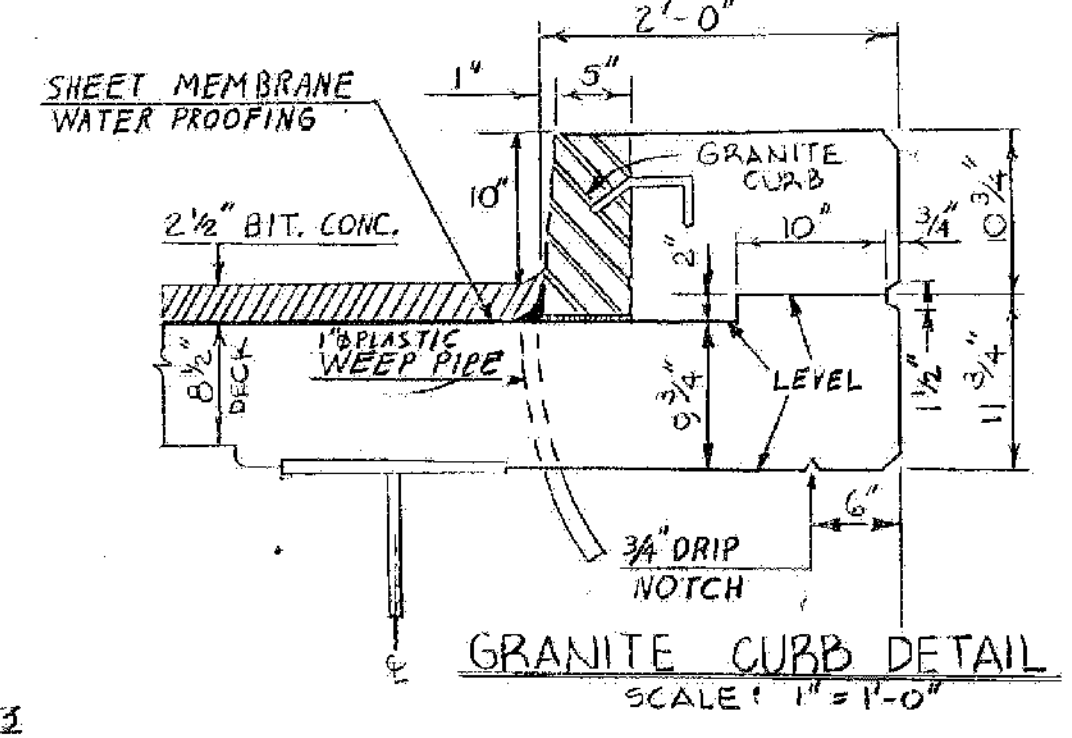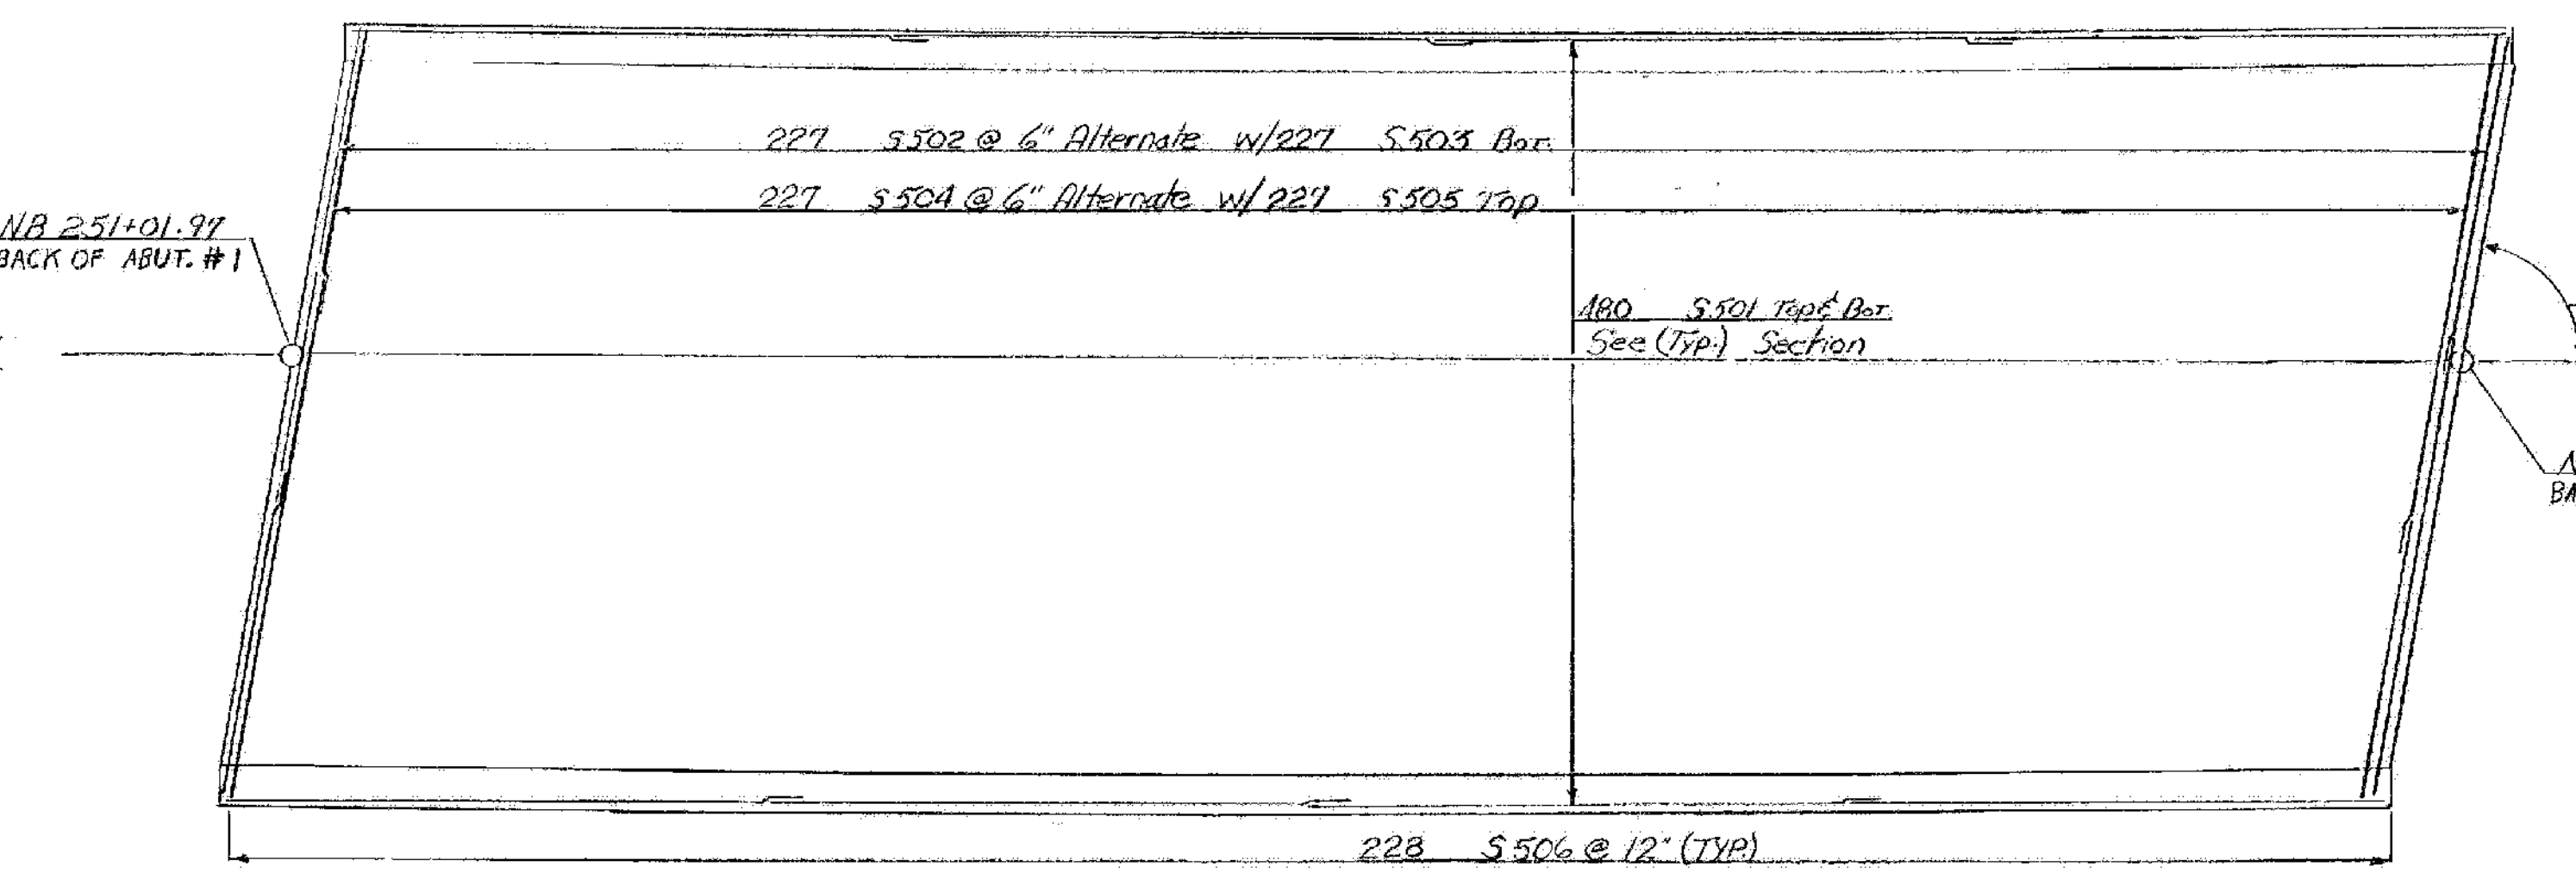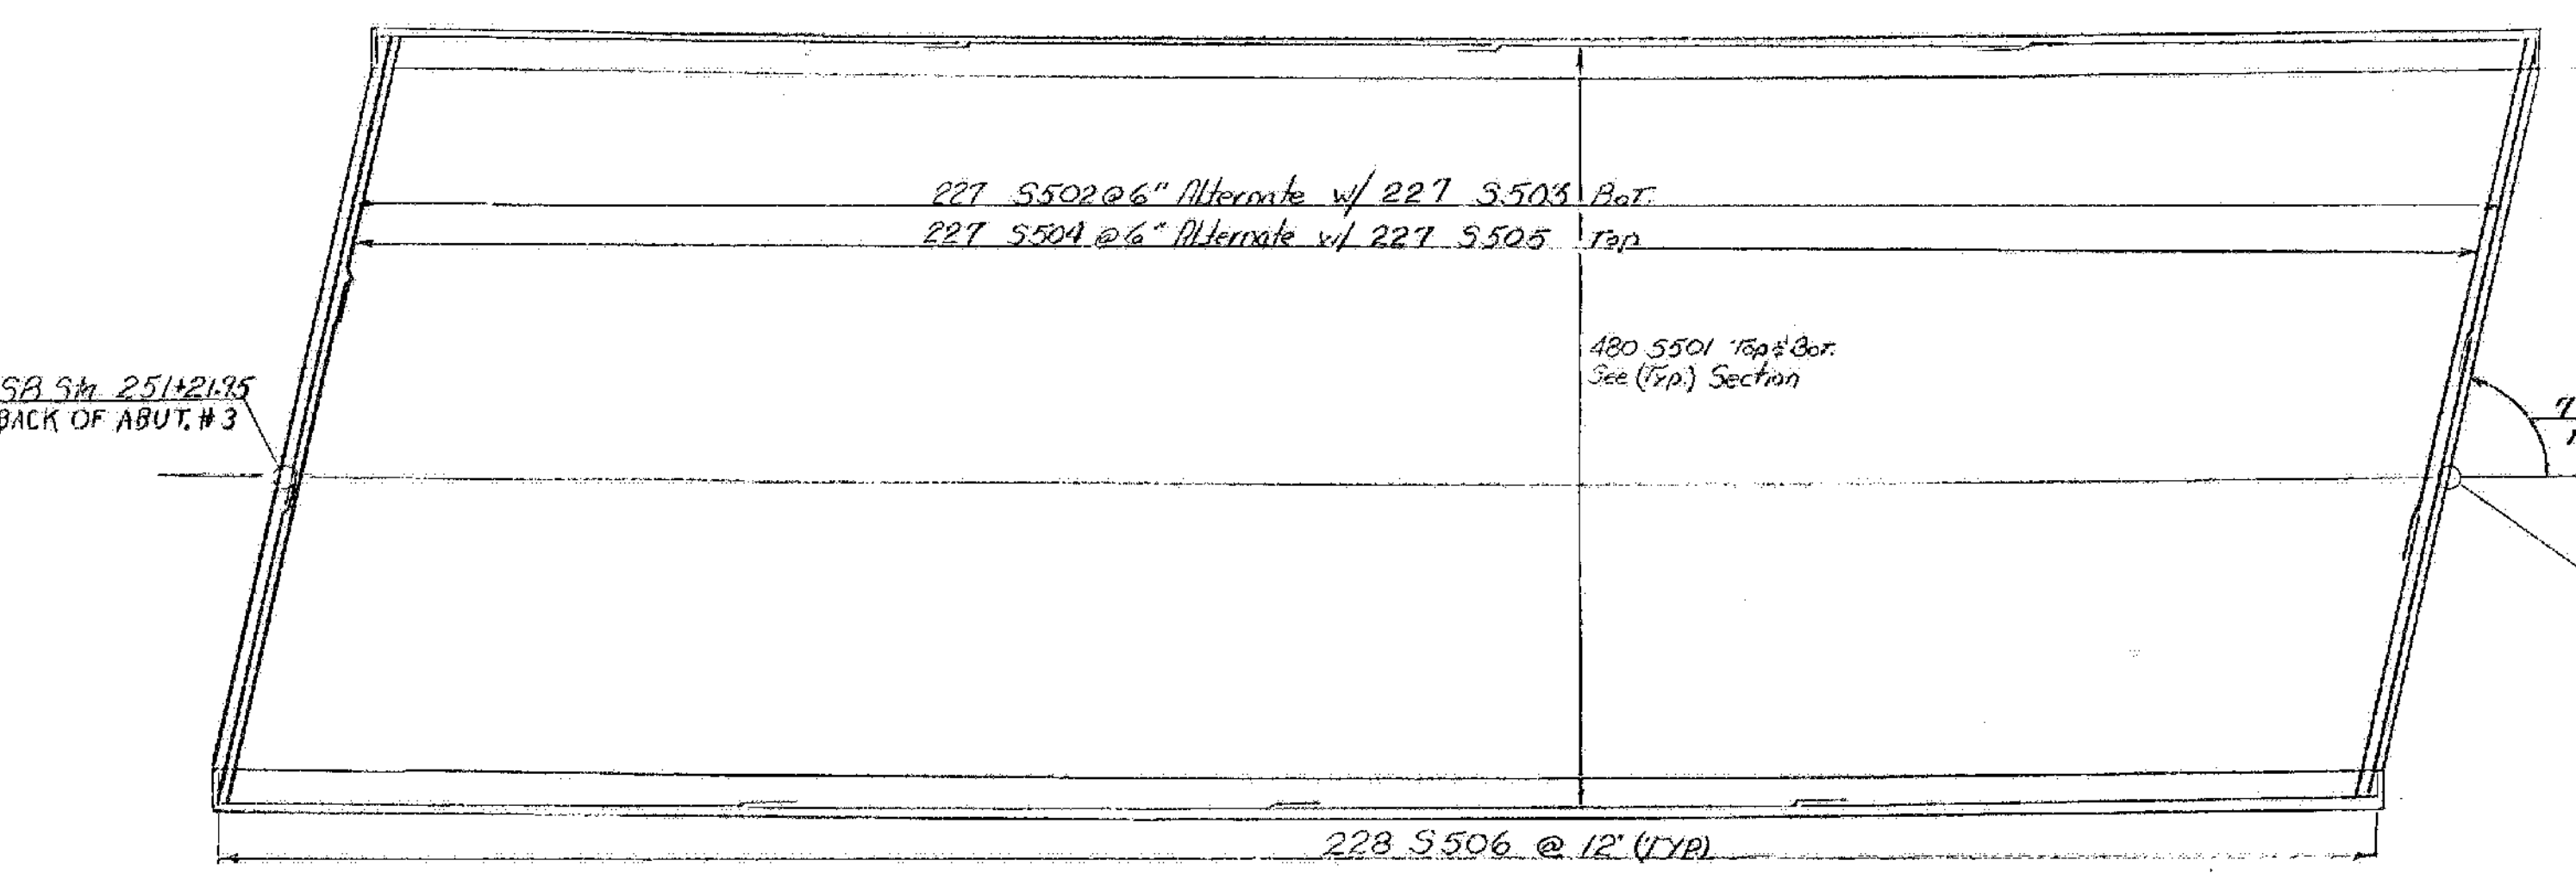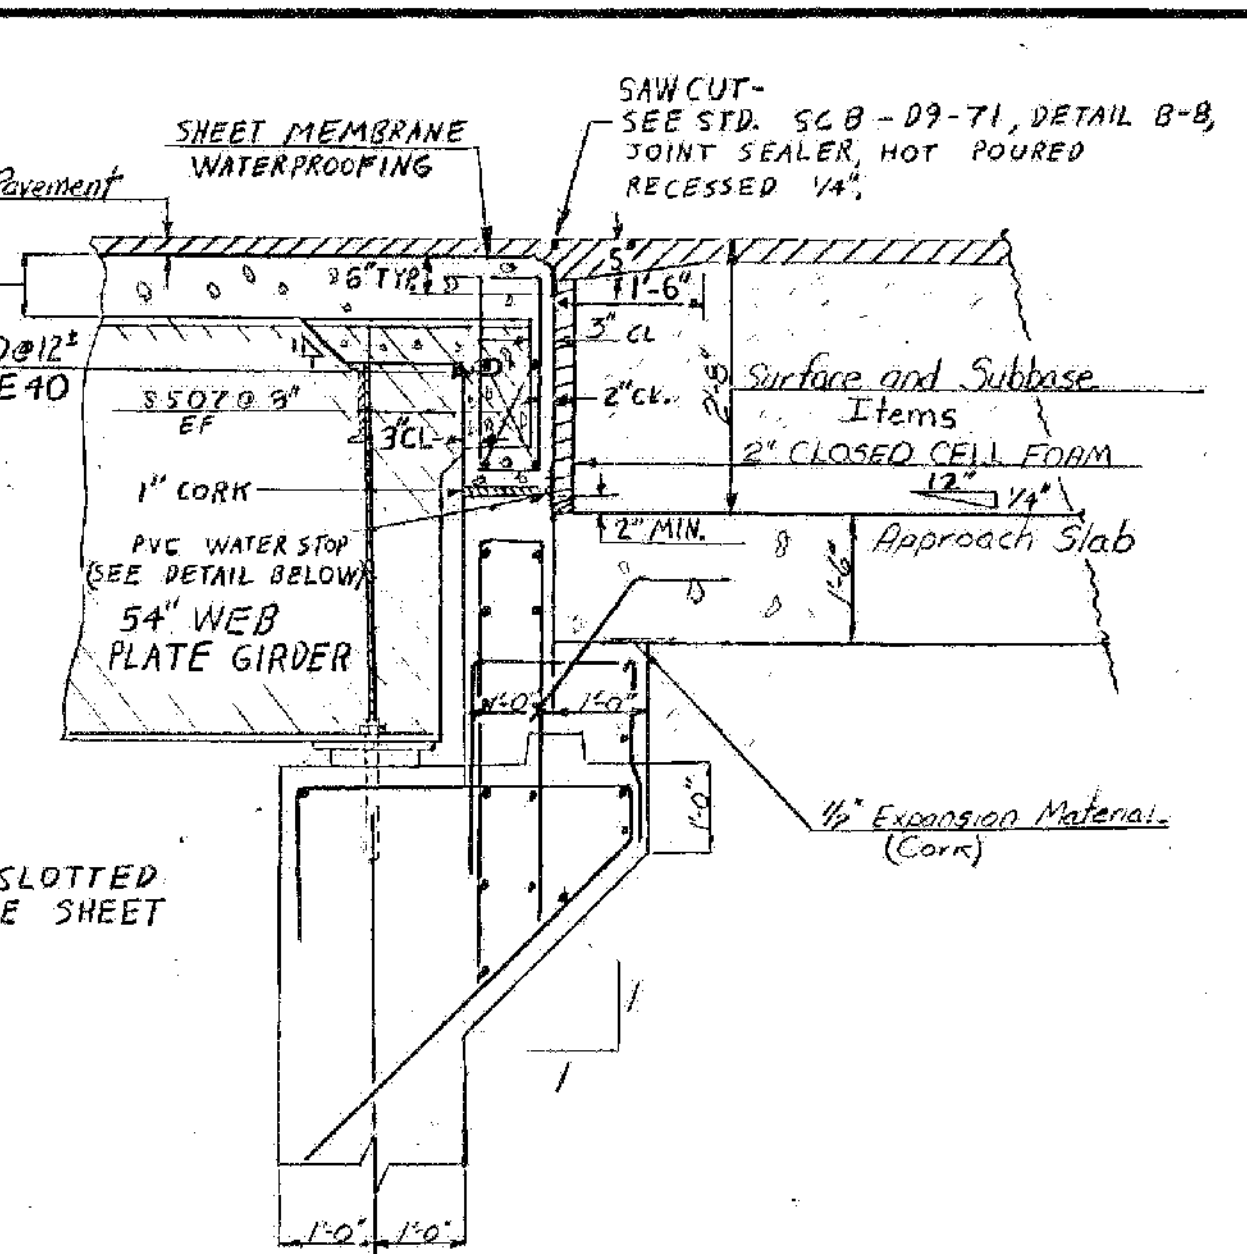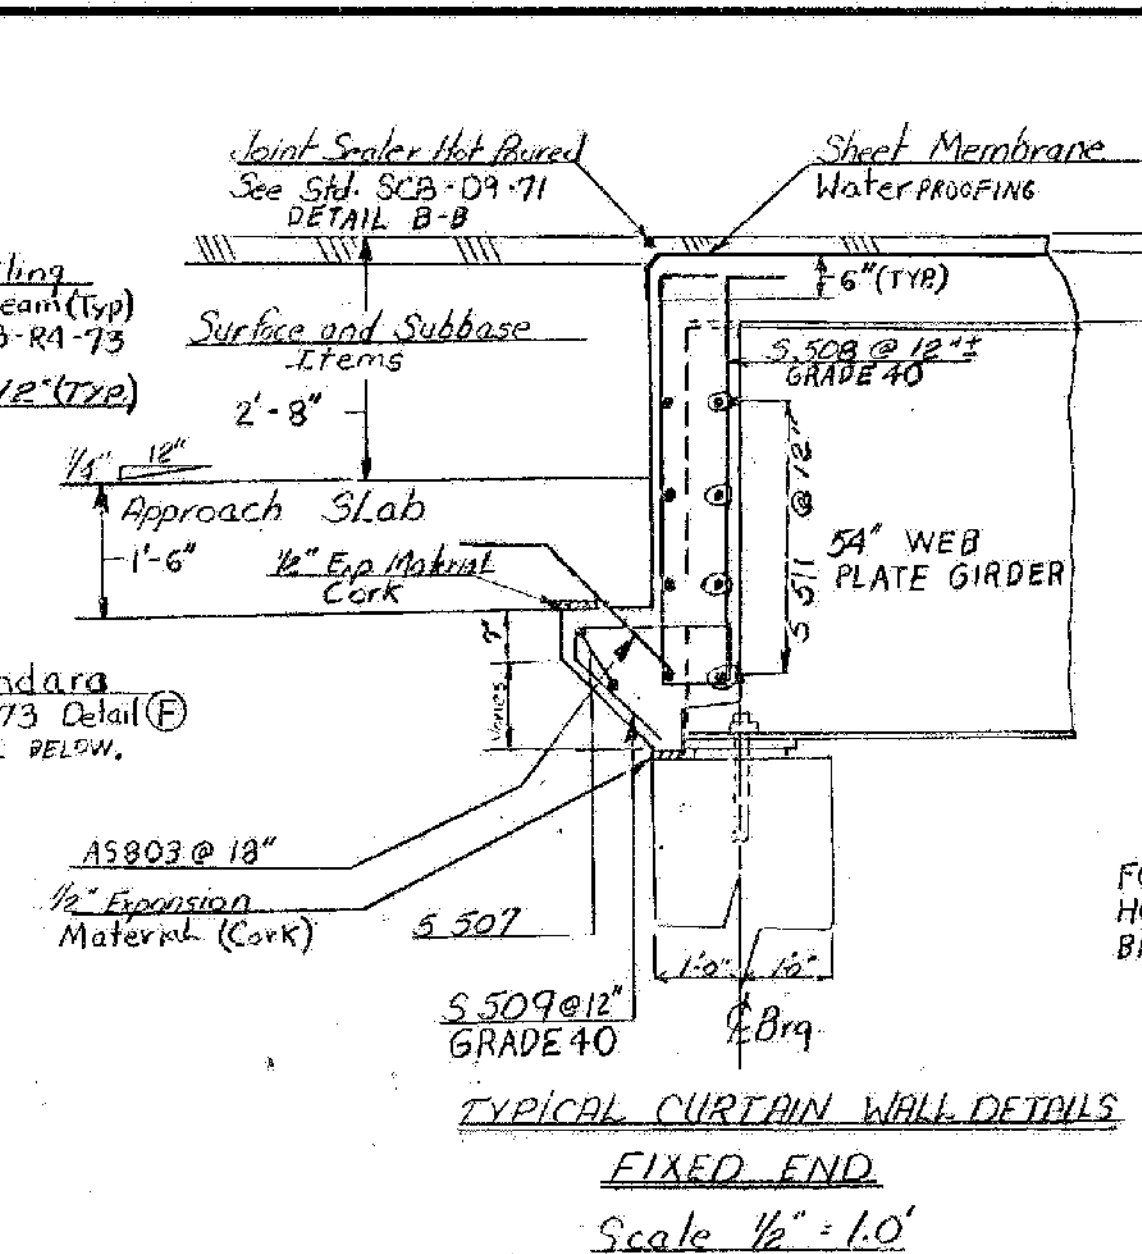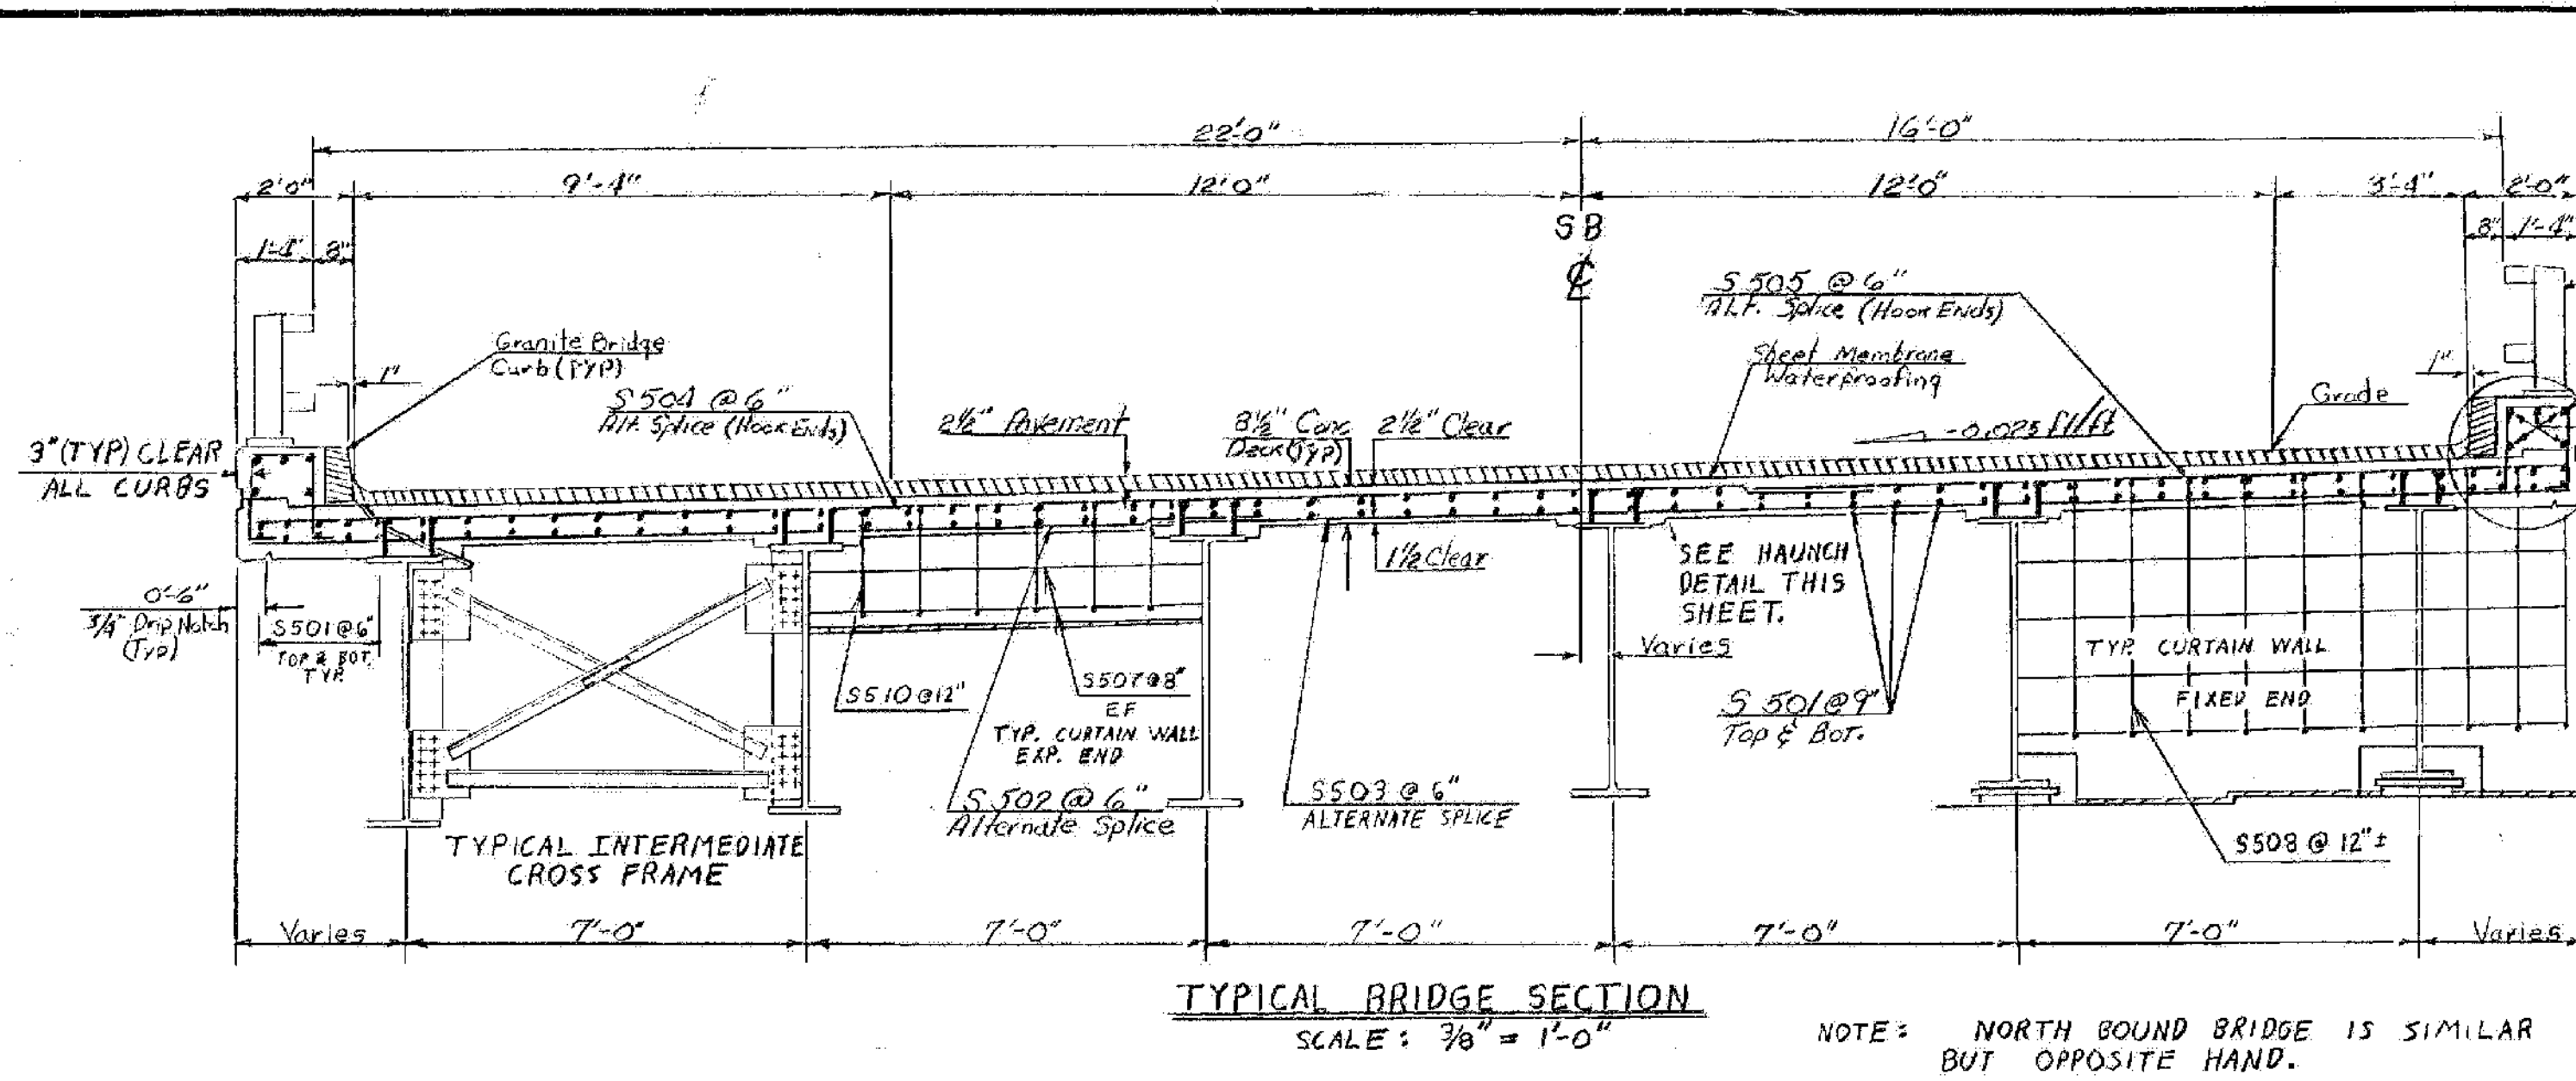


FOR ADDITIONAL CURB DETAILS SEE SCB-D6-73 DETAIL (D), SCB-D4-76 DETAIL (D), & GENERAL NOTES 4 & 8.

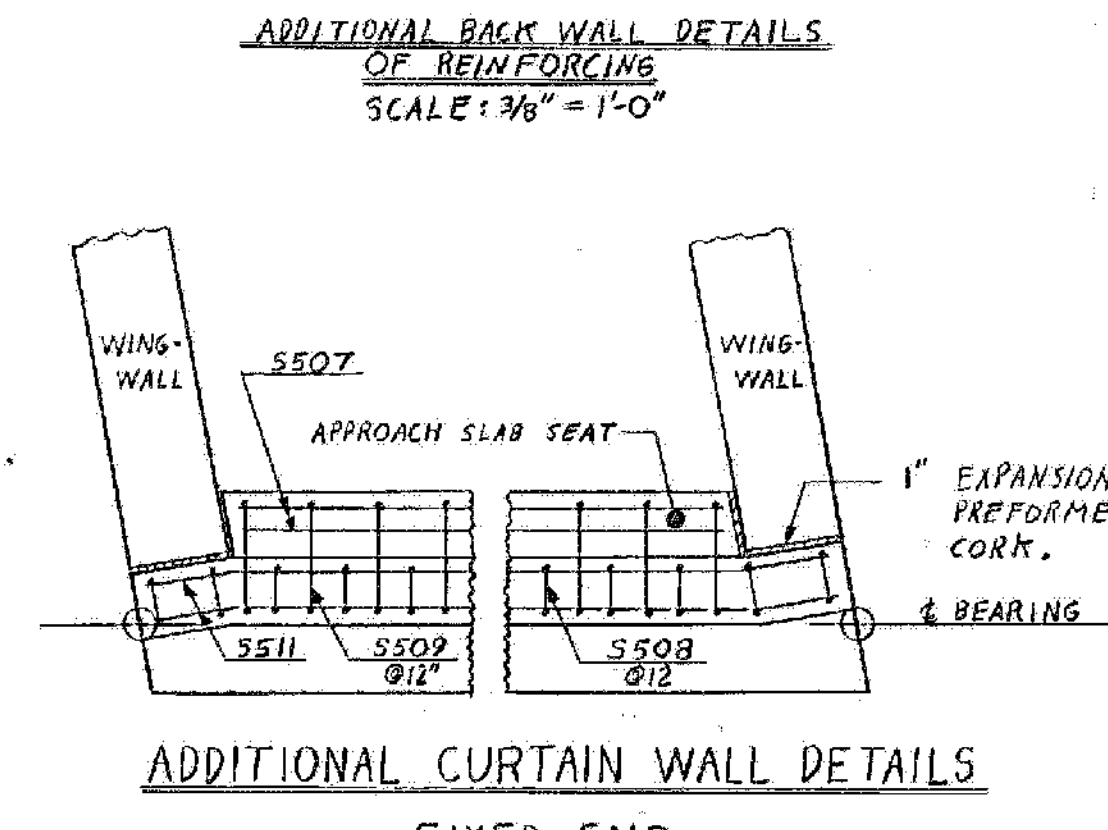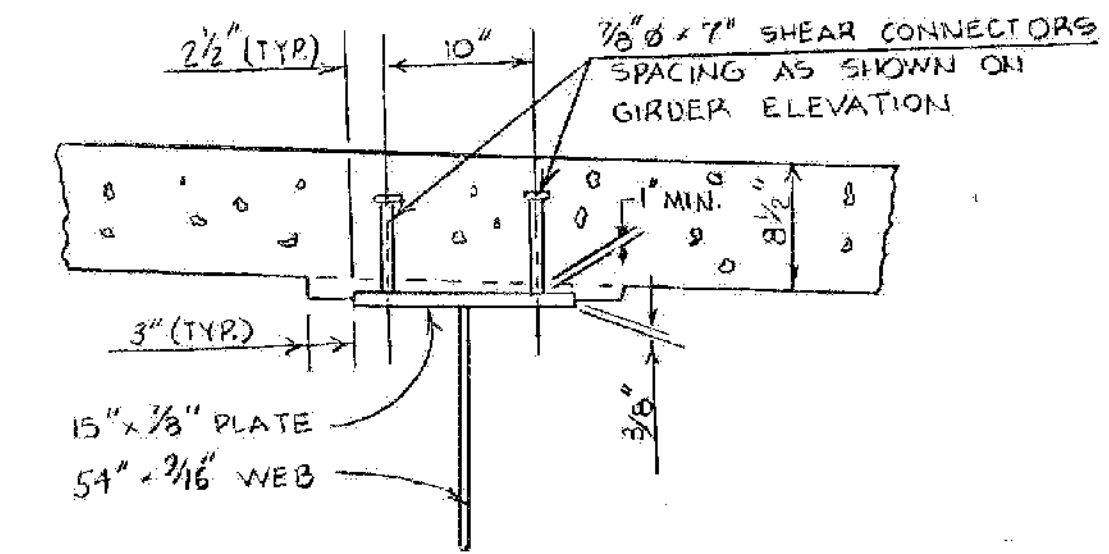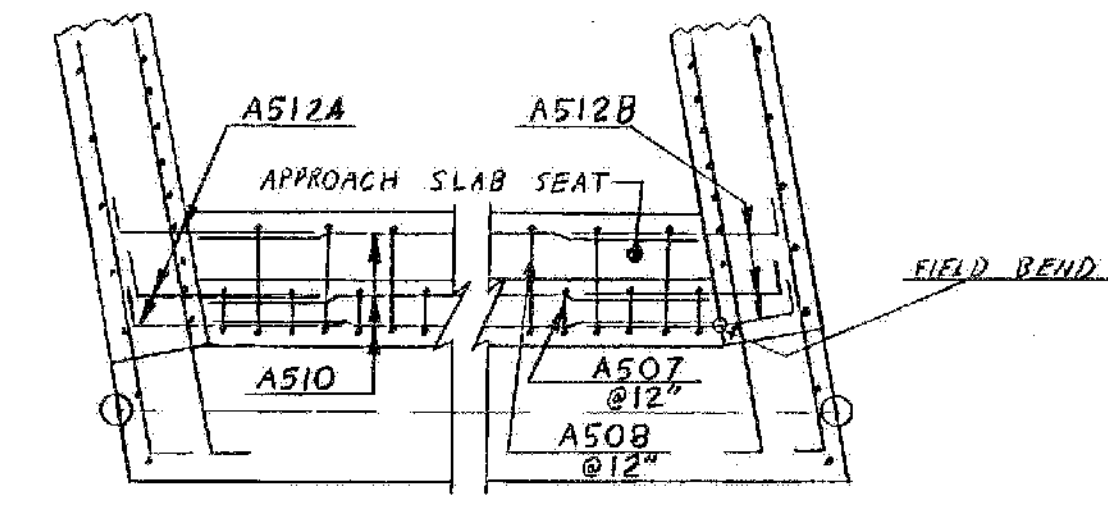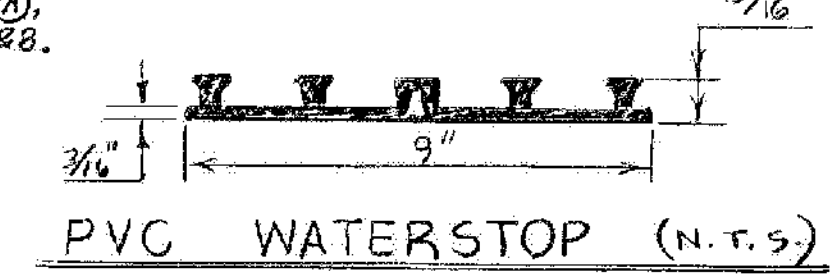

1-93 BRIDGES 3N&S
WATERFORD
IM MEMB(31)
SHEET 28 OF 48
FOR REFERENCE ONLY

STATE OF VERMONT	
AGENCY OF TRANSPORTATION	
TOWN OF WATERFORD	Bridge No. B5
HIGHWAY NO. I93	Log Sta. 251+70
I 93 NB & SB over TH #12	
TYPICAL SECTION & DECK REINFORCING STEEL	
Designed by Chery Rogers	Drawn by R. JENSEN & S. FARNSWORTH
Checked by G. ROGERS	Bridge Design Supervisor
date 6/80	F.Y. Boikum date 7/80
PROJECT WATERFORD	PROJECT NO. I93-1(3) 1/2
Bridge Sheet No. BR 505	Sheet 126 of 531


135 of 290

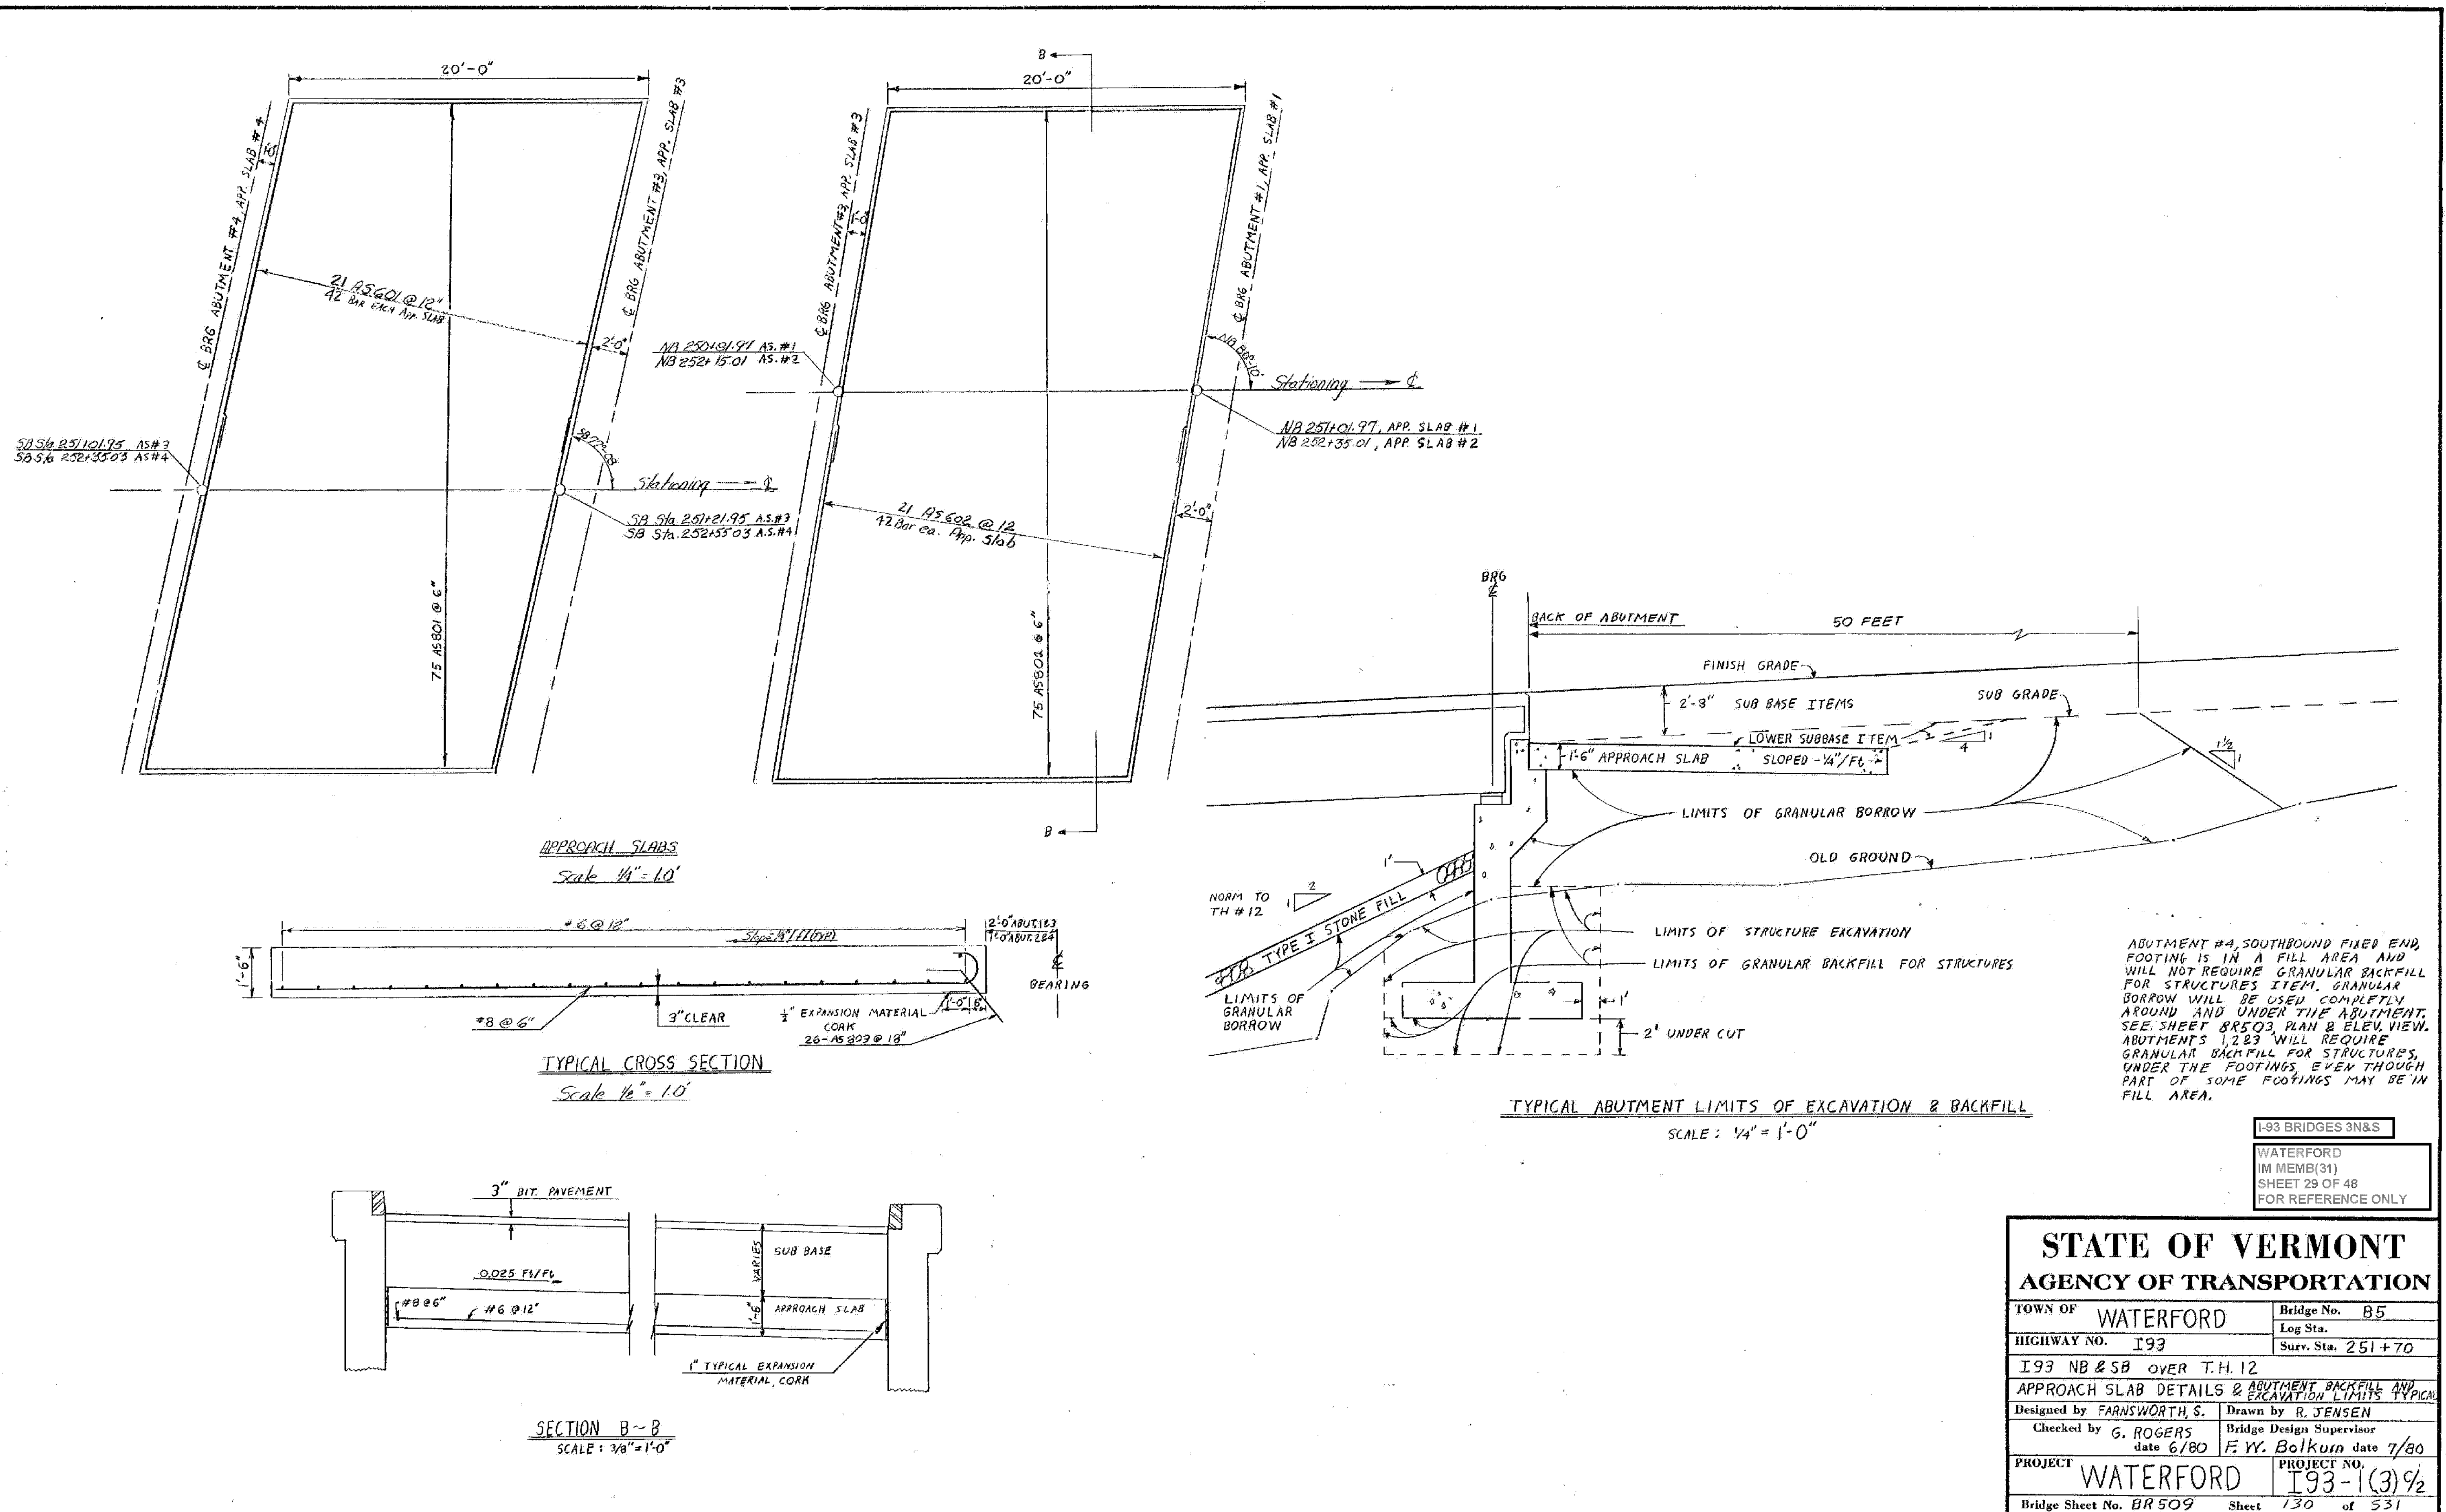


ABUTMENT #4, SOUTHBOUND FIRED END, FOOTING IS IN A FILL AREA AND WILL NOT REQUIRE GRANULAR BACKFILL FOR STRUCTURES ITEM. GRANULAR BORROW WILL BE USED COMPLETELY AROUND AND UNDER THE ABUTMENT. SEE SHEET BR503, PLAN & ELEV. VIEW. ABUTMENTS 1,2,3 WILL REQUIRE GRANULAR BACKFILL FOR STRUCTURES, UNDER THE FOOTINGS, EVEN THOUGH PART OF SOME FOOTINGS MAY BE IN FILL AREA.

I-93 BRIDGES 3N&S
 WATERFORD
 IM MEMB(31)
 SHEET 29 OF 48
 FOR REFERENCE ONLY


STATE OF VERMONT	
AGENCY OF TRANSPORTATION	
TOWN OF WATERFORD	Bridge No. B5
HIGHWAY NO. I93	Log Sta.
I93 NB & SB OVER T.H. 12	Surv. Sta. 251+70
APPROACH SLAB DETAILS & ABUTMENT BACKFILL AND EXCAVATION LIMITS TYPICAL	
Designed by FARNSWORTH, S.	Drawn by R. JENSEN
Checked by G. ROGERS date 6/80	Bridge Design Supervisor F. W. Bolcum date 7/80
PROJECT WATERFORD	PROJECT NO. I93-1(3)½
Bridge Sheet No. BR 509	Sheet 130 of 531

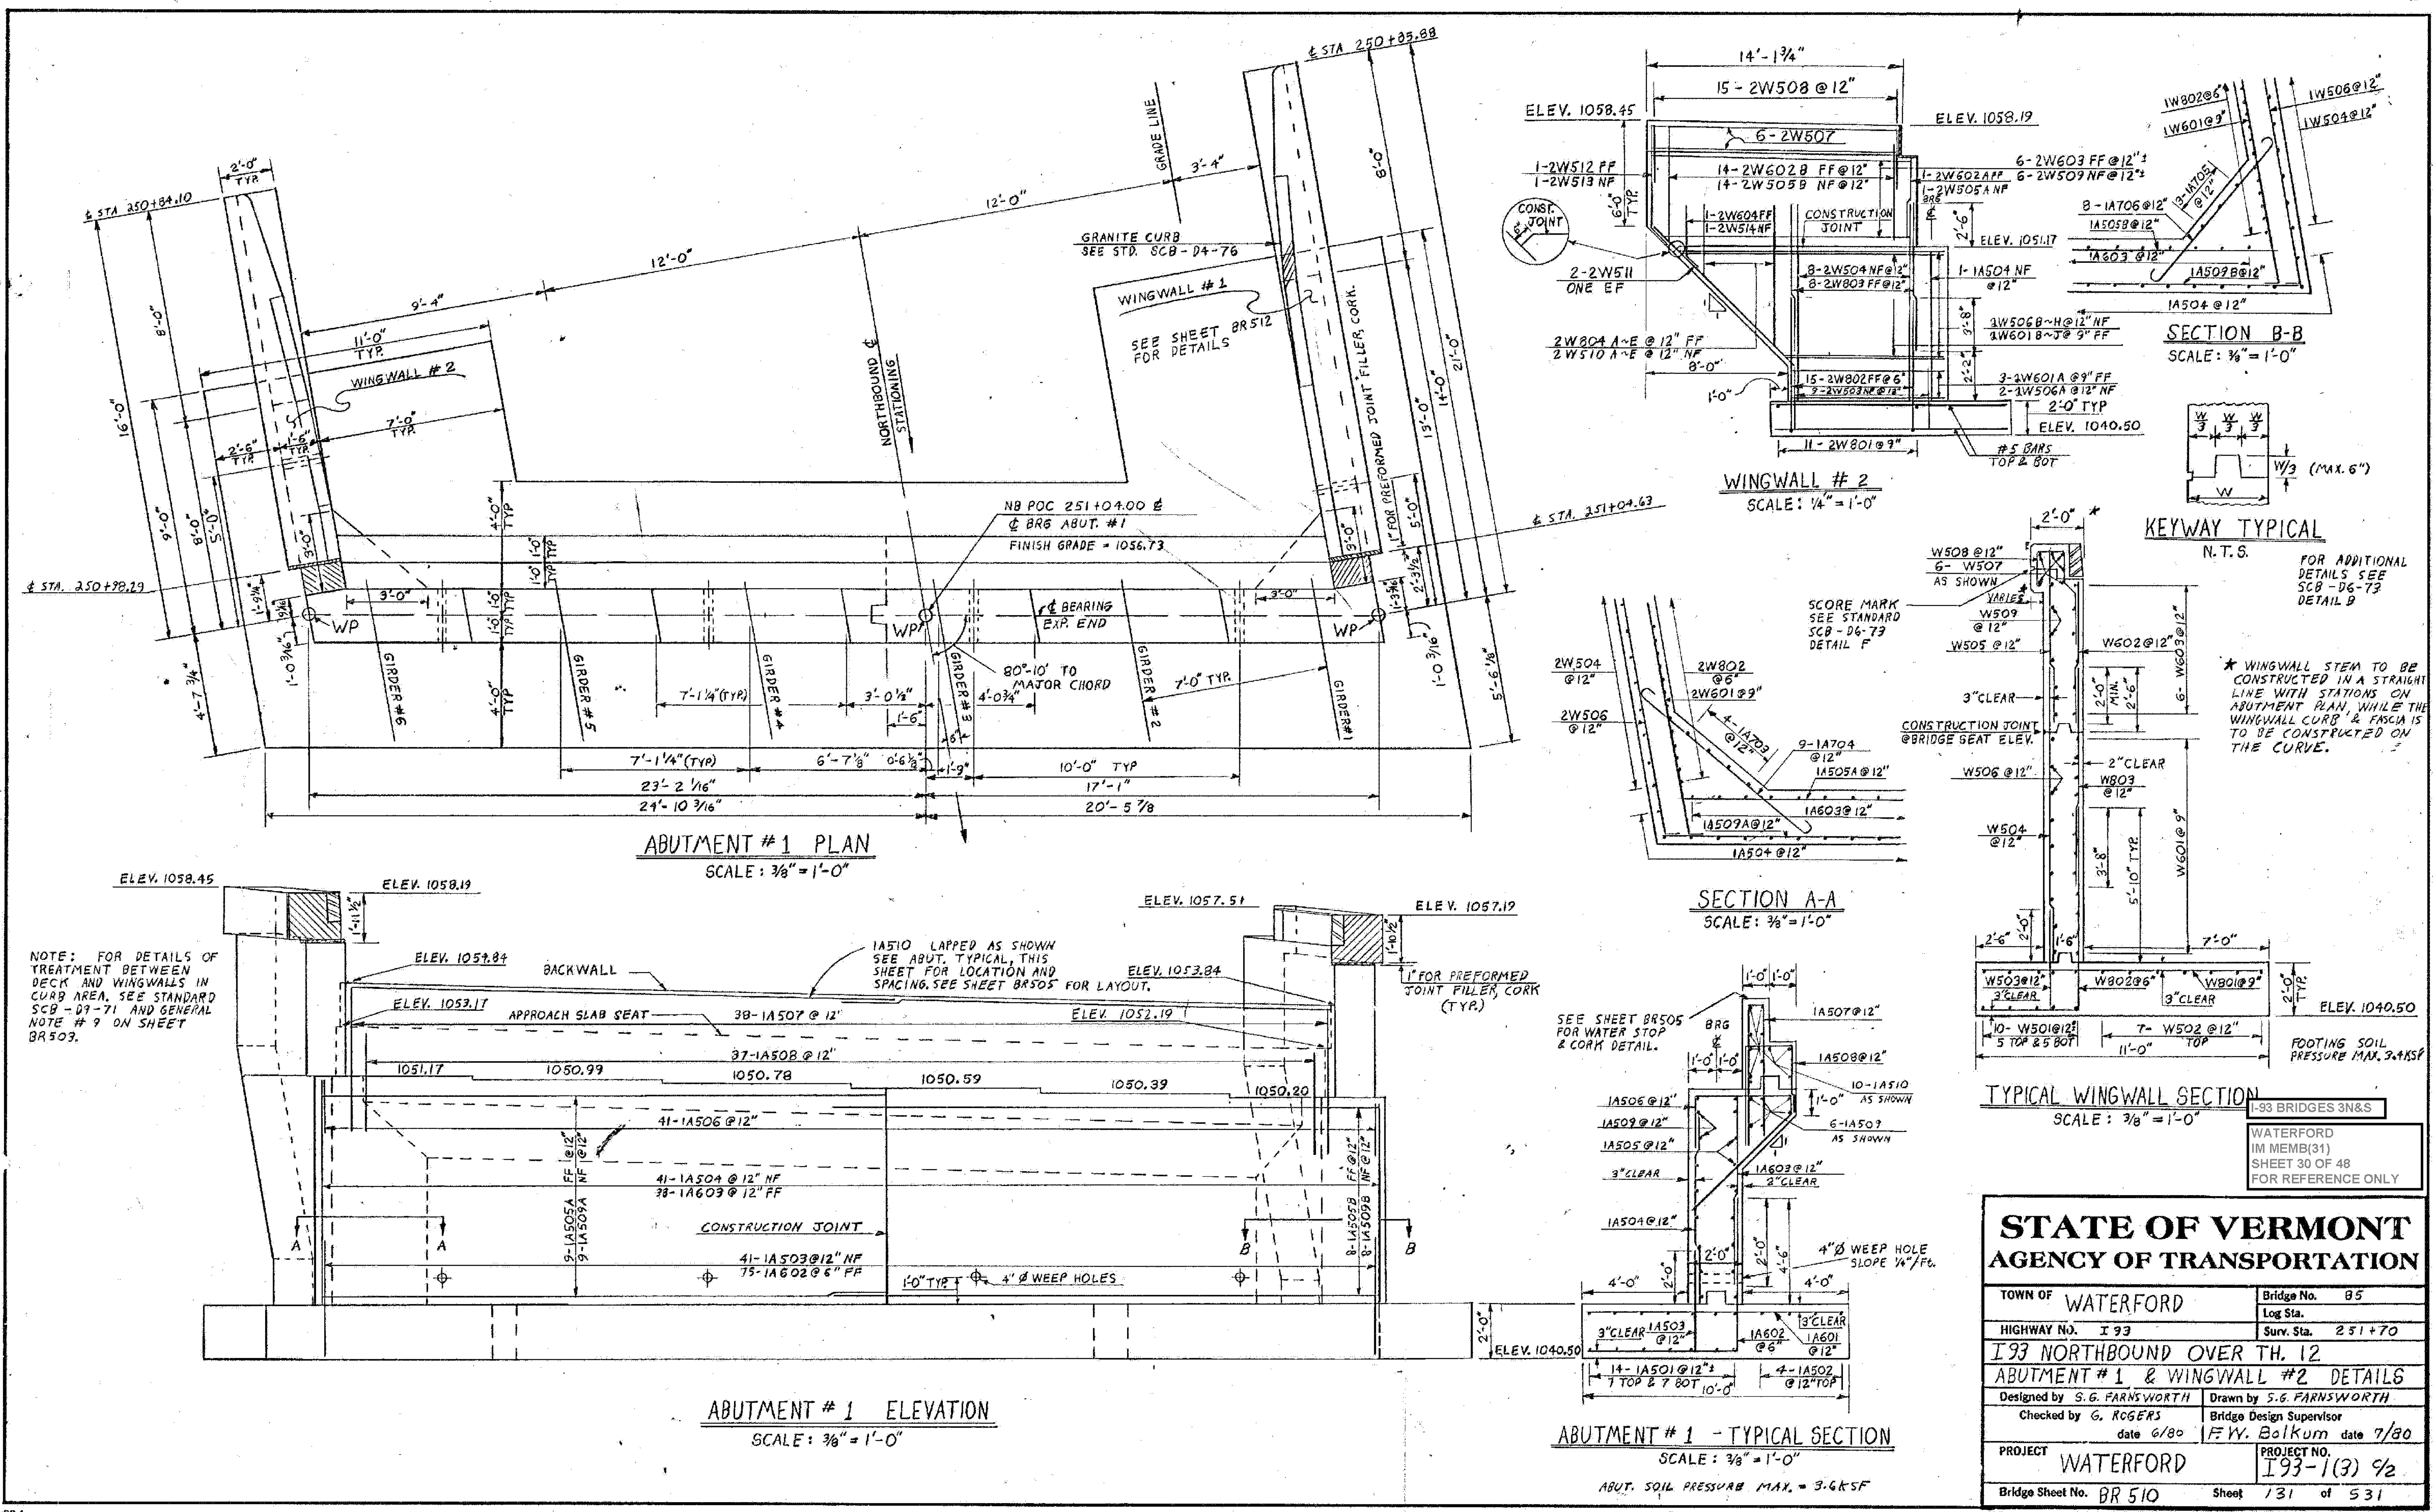

STATE OF VERMONT	
AGENCY OF TRANSPORTATION	
TOWN OF WATERFORD	Bridge No. 85
HIGHWAY NO. I 93	Log Sta.
I 93 NORTHBOUND OVER TH. 12	
ABUTMENT #1 & WINGWALL #2 DETAILS	
Designed by S.G. FARNSWORTH	Drawn by S.G. FARNSWORTH
Checked by G. ROGERS	Bridge Design Supervisor
date 6/80	FW. Balkum date 7/80
PROJECT WATERFORD	PROJECT NO. I 93-1(3) 92
Bridge Sheet No. BR 510	Sheet 131 of 531

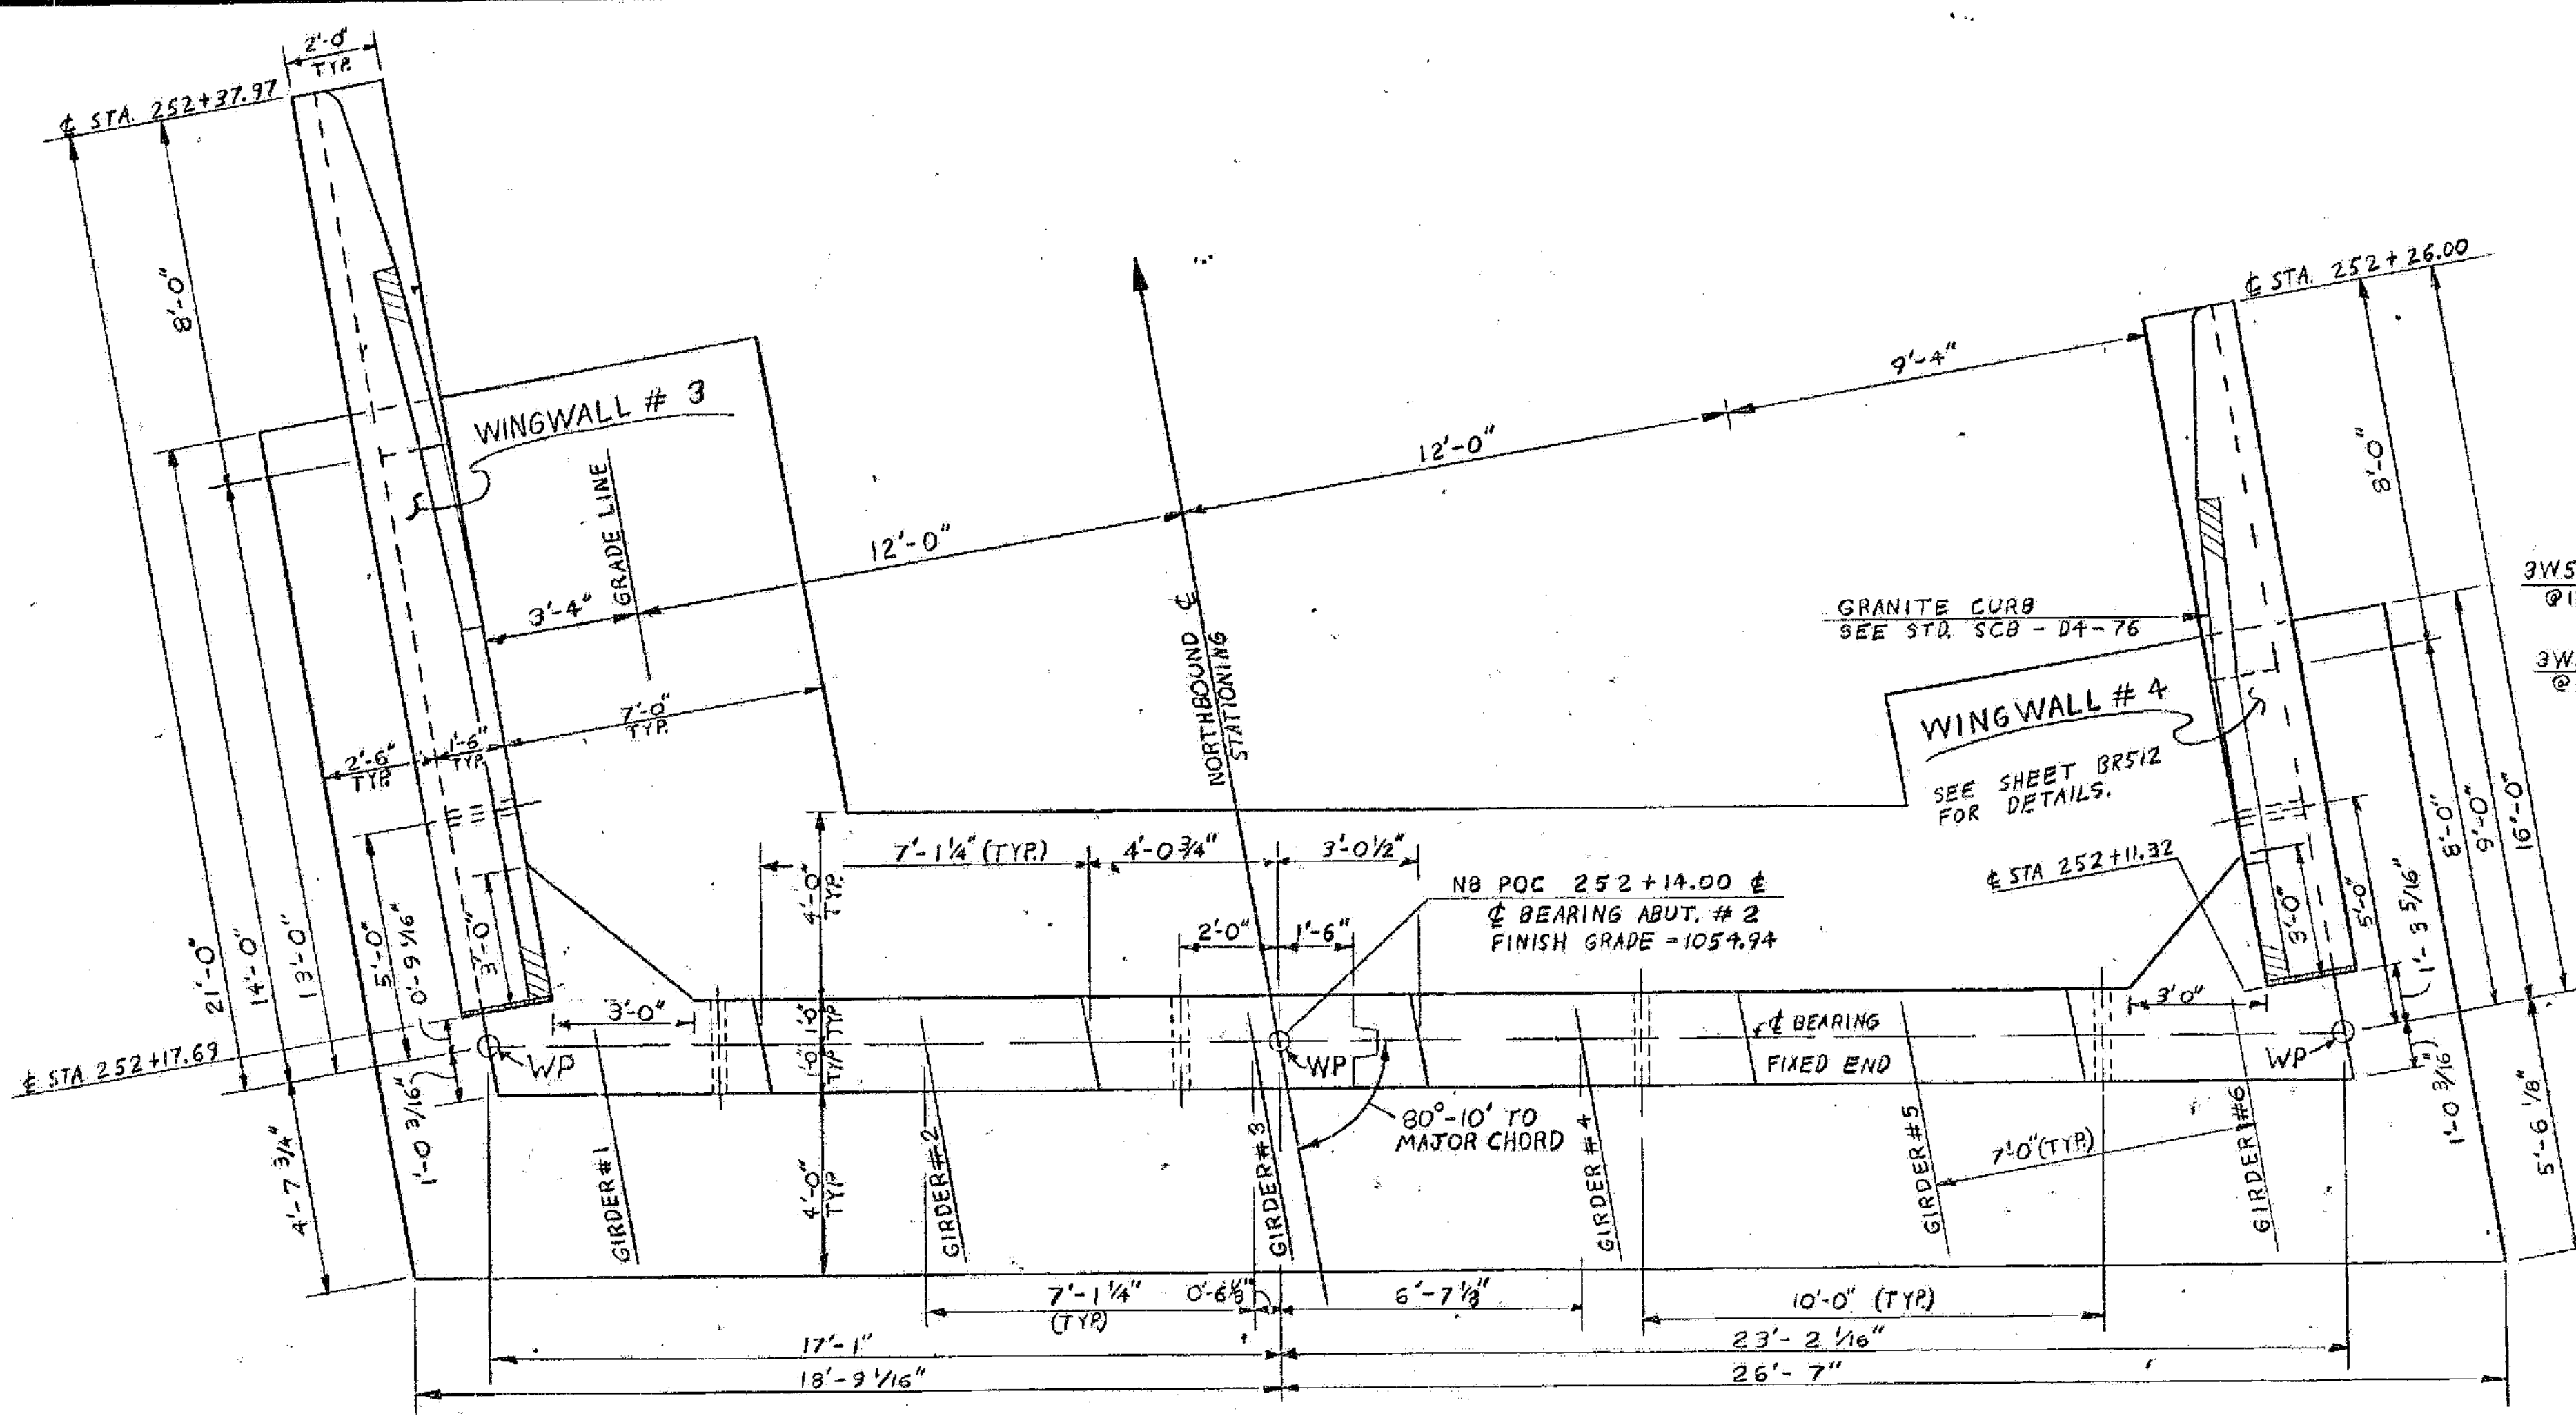


ABUTMENT # 2 PLAN
SCALE: 3/8" = 1'-0"

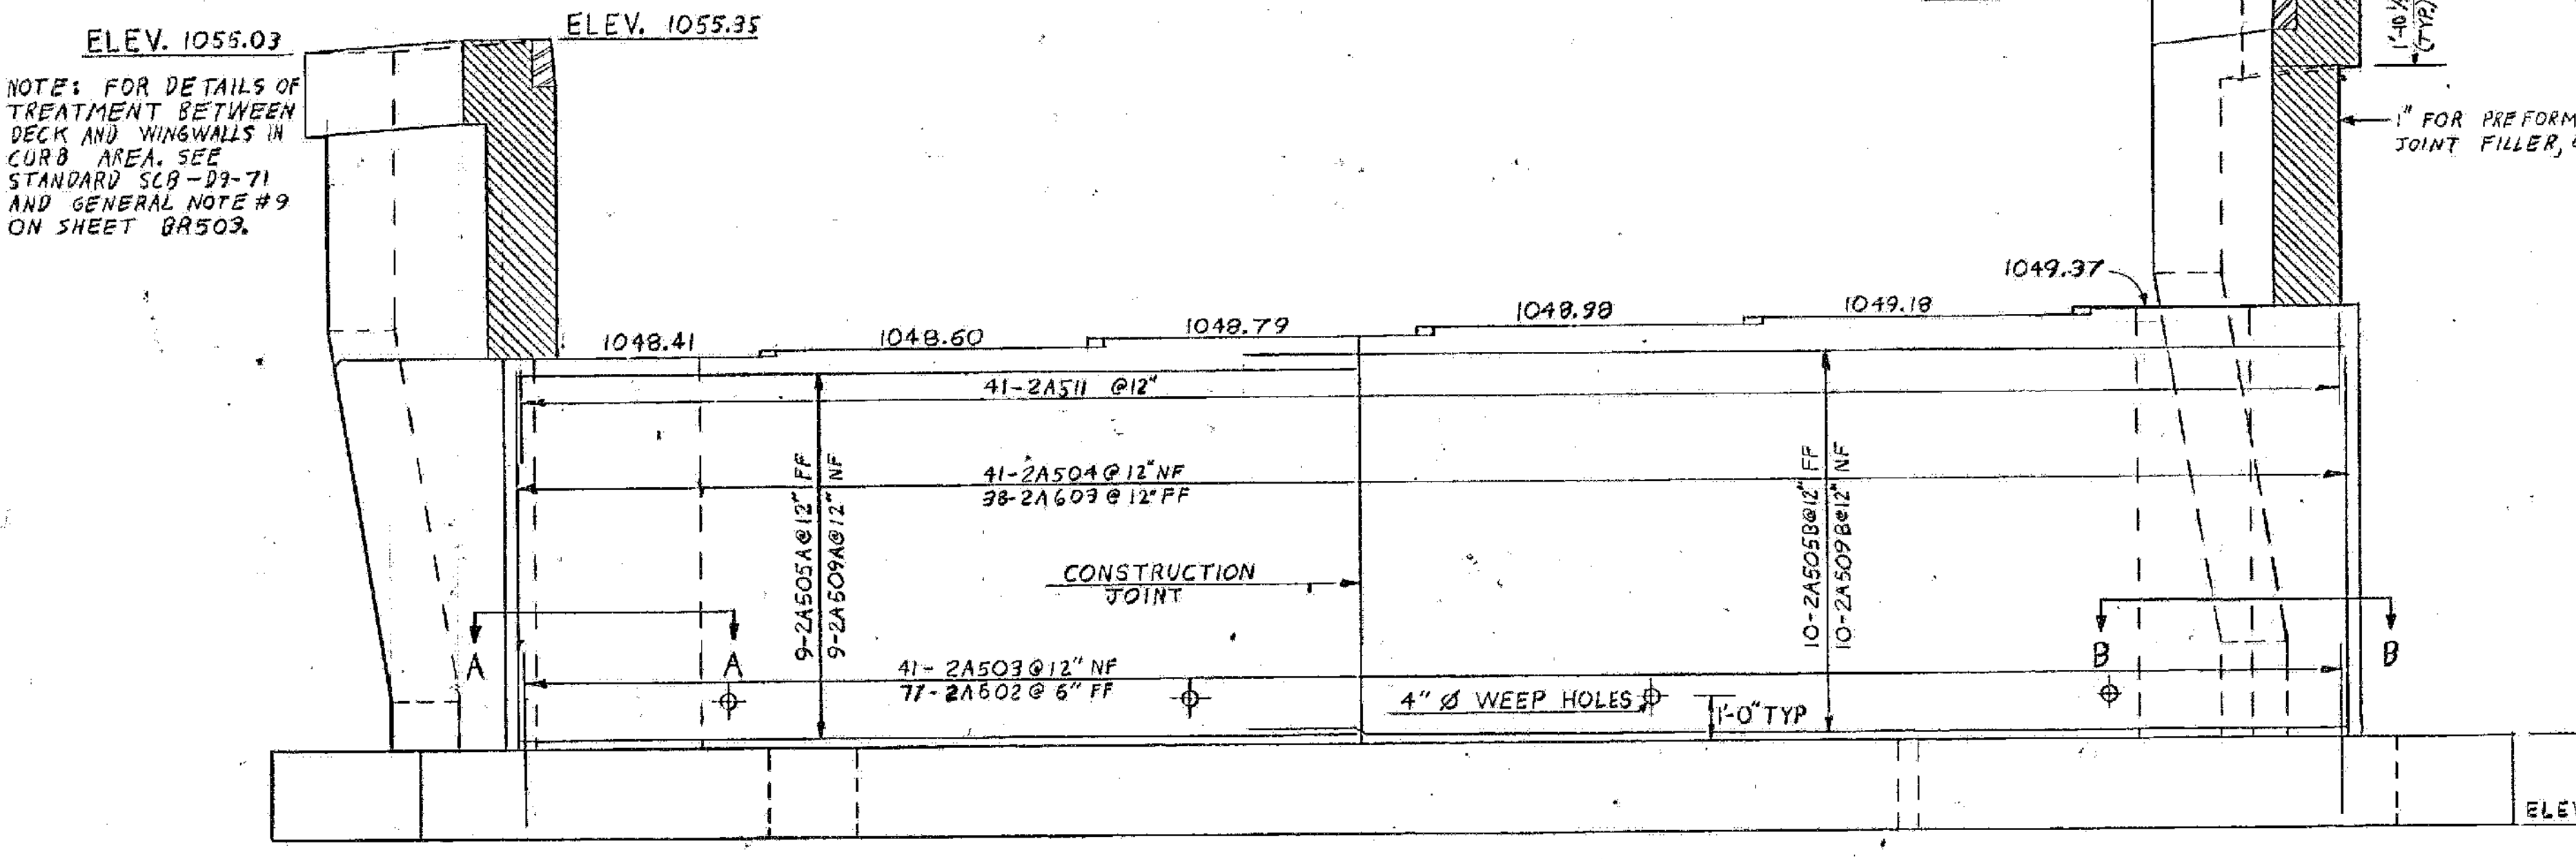


ABUTMENT # 2 ELEVATION
SCALE: 3/8" = 1'-0"


NOTE: FOR DETAILS OF TREATMENT BETWEEN DECK AND WINGWALLS IN CURB AREA, SEE STANDARD SCB-D9-71 AND GENERAL NOTE #9 ON SHEET BR503.

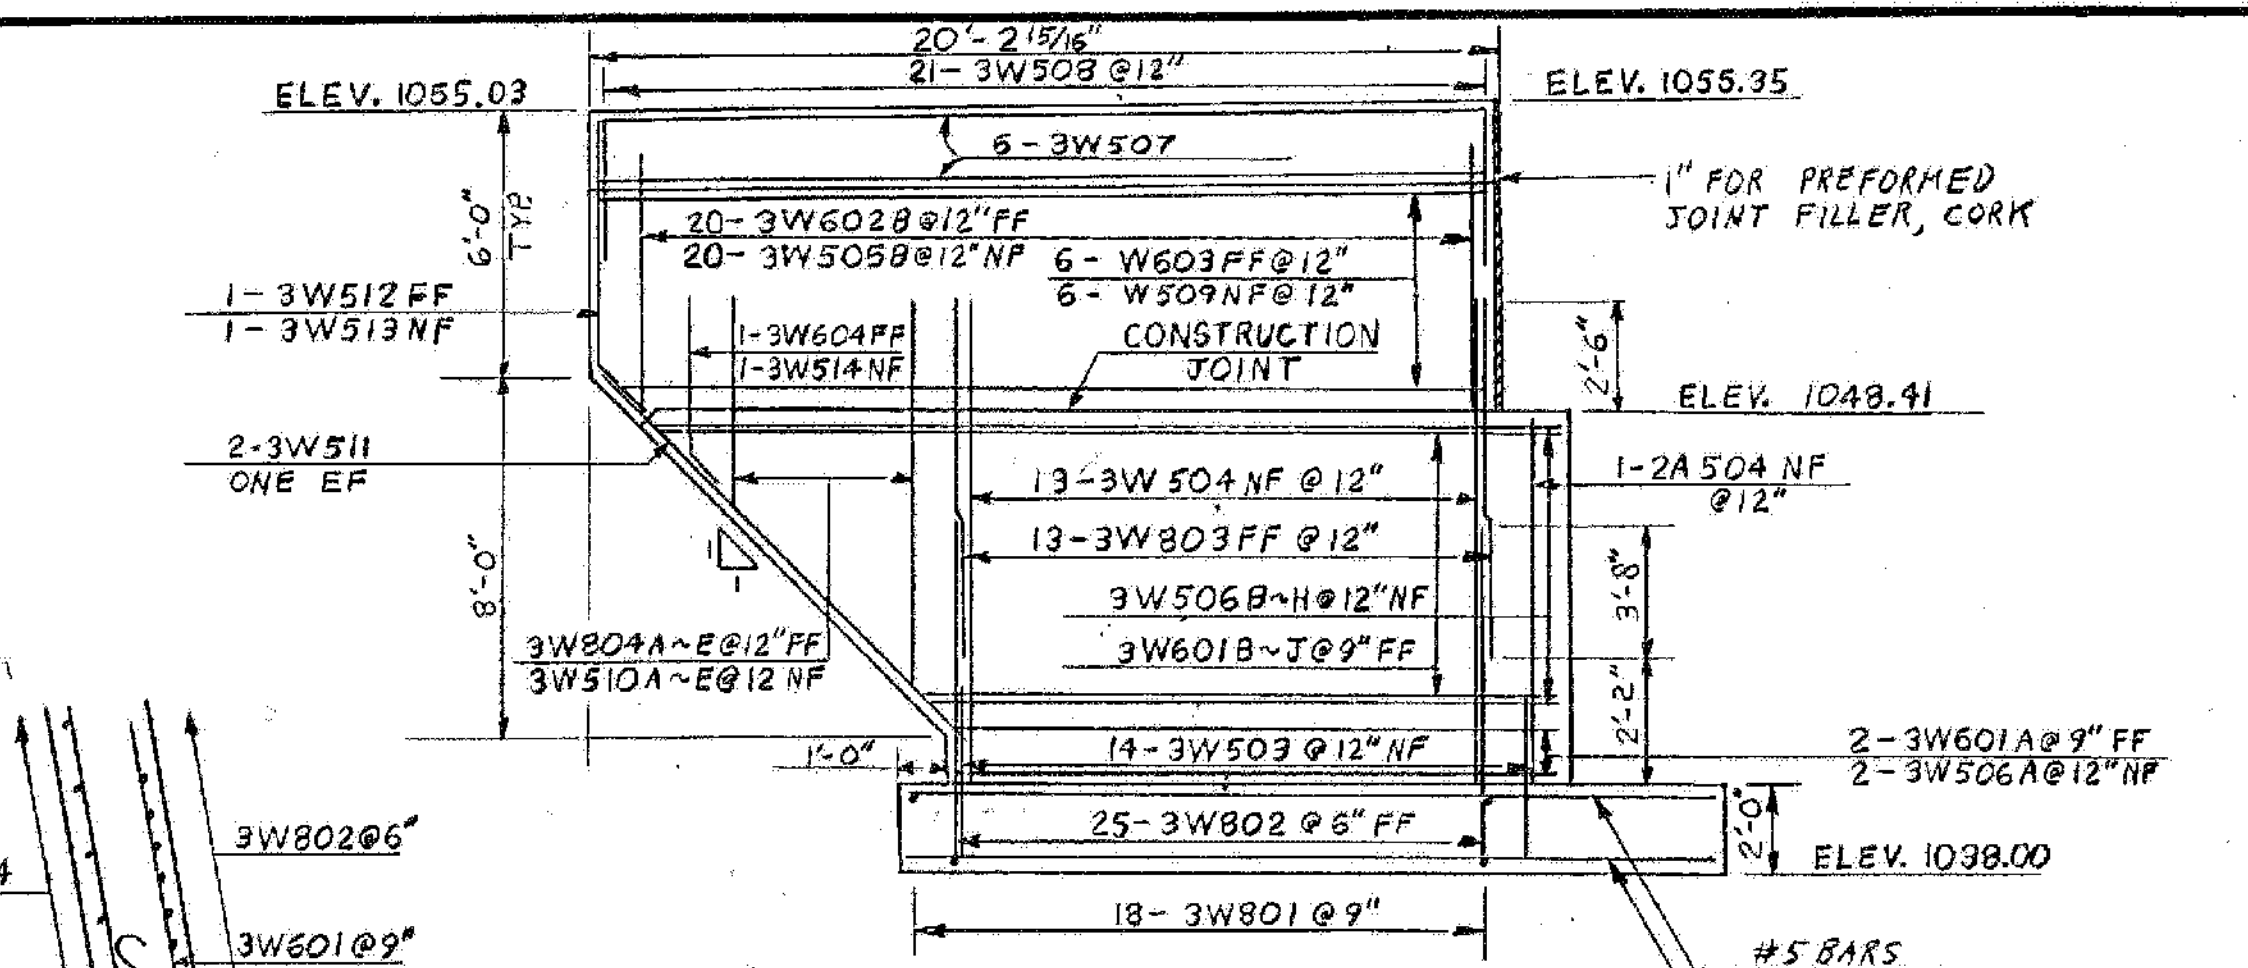


WINGWALL # 3
SCALE: 1/4" = 1'-0"

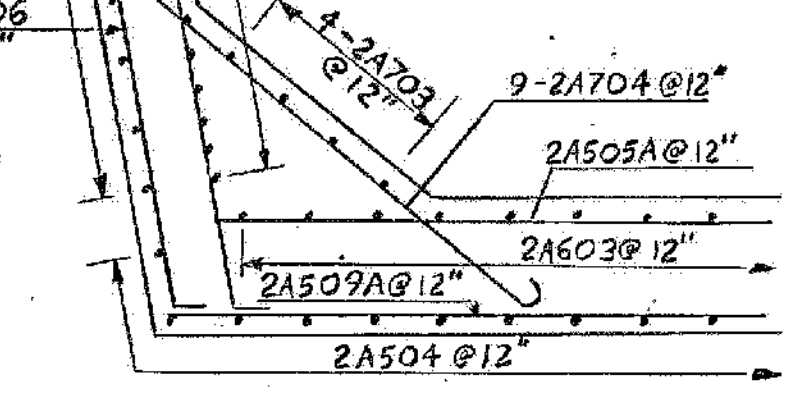


SECTION A-A
SCALE: 3/8" = 1'-0"

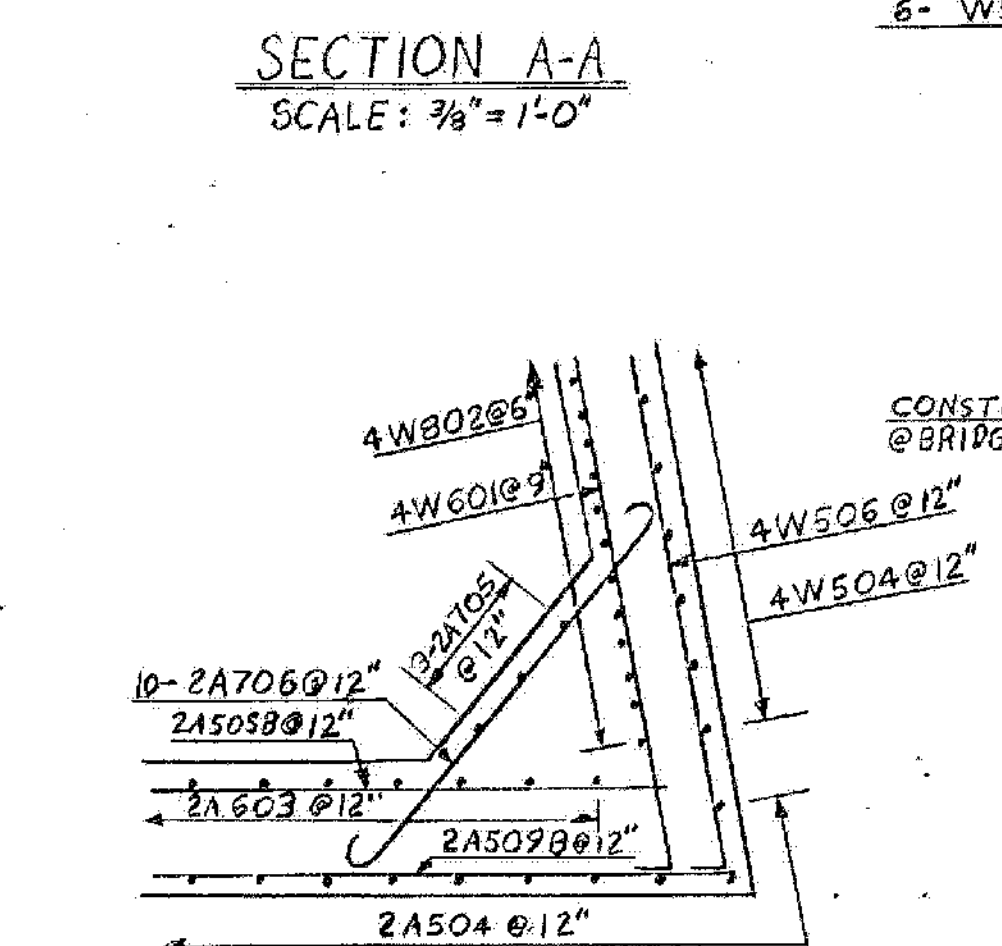

SECTION B-B
SCALE: 3/8" = 1'-0"

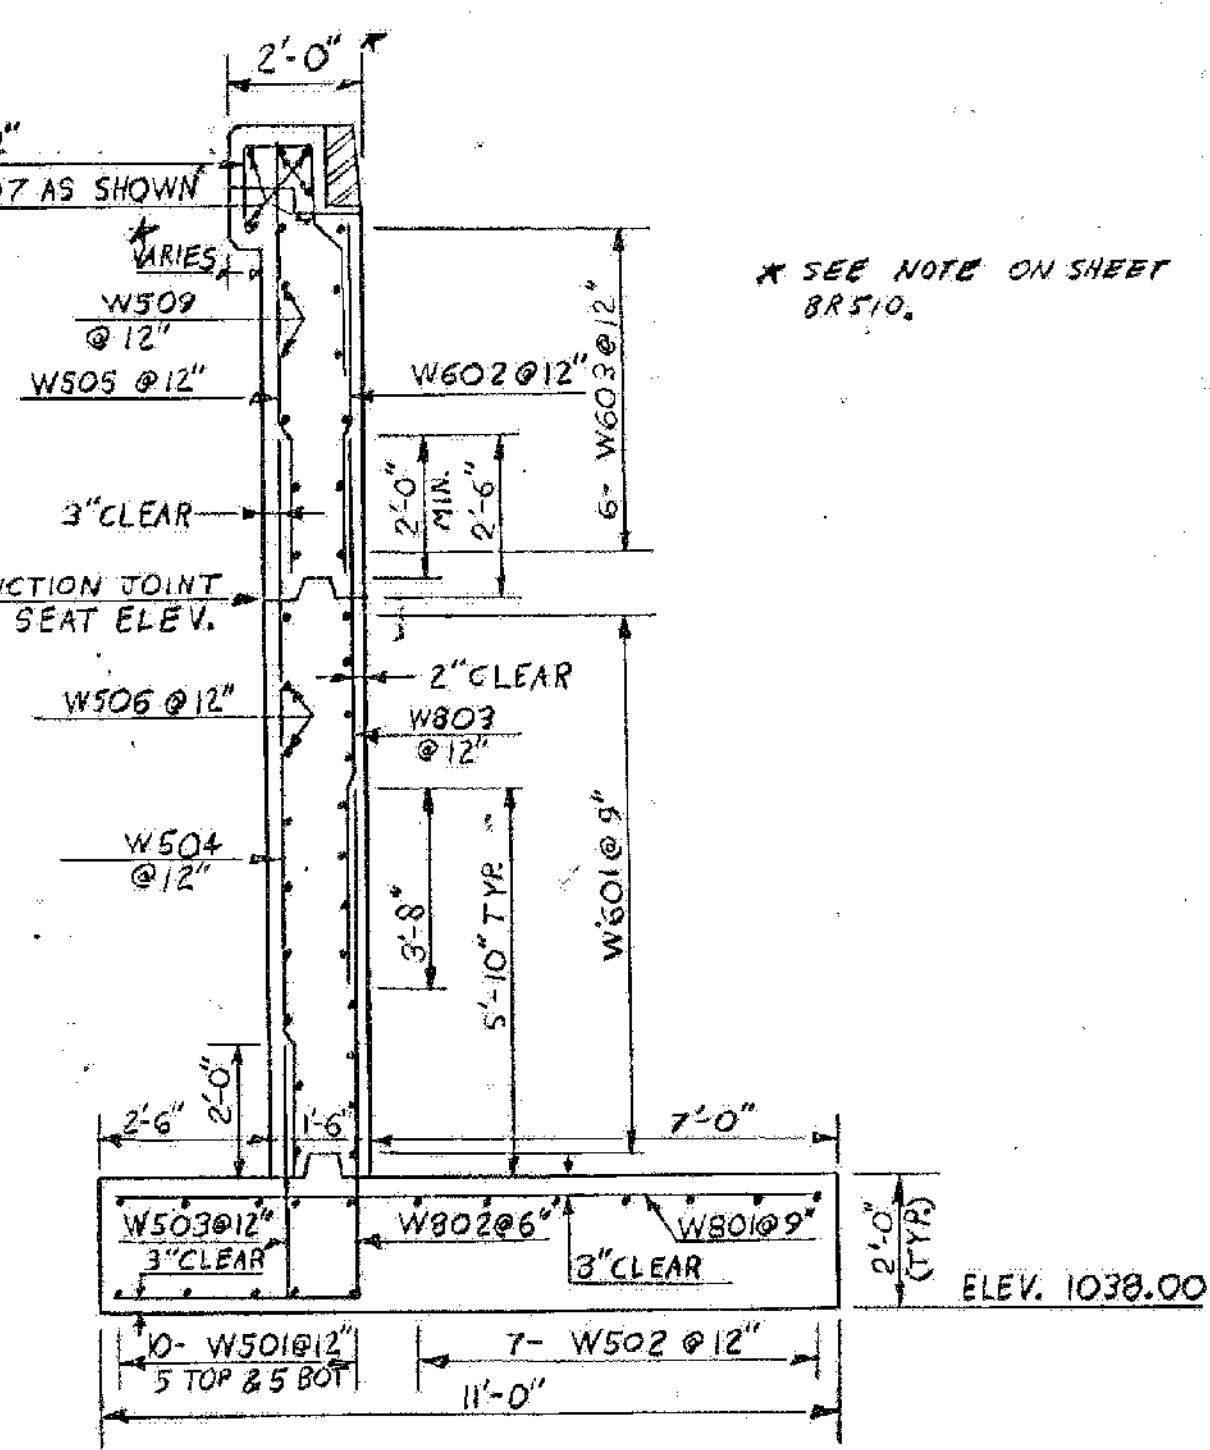


TYPICAL WINGWALL SECTION
SCALE: 3/8" = 1'-0"

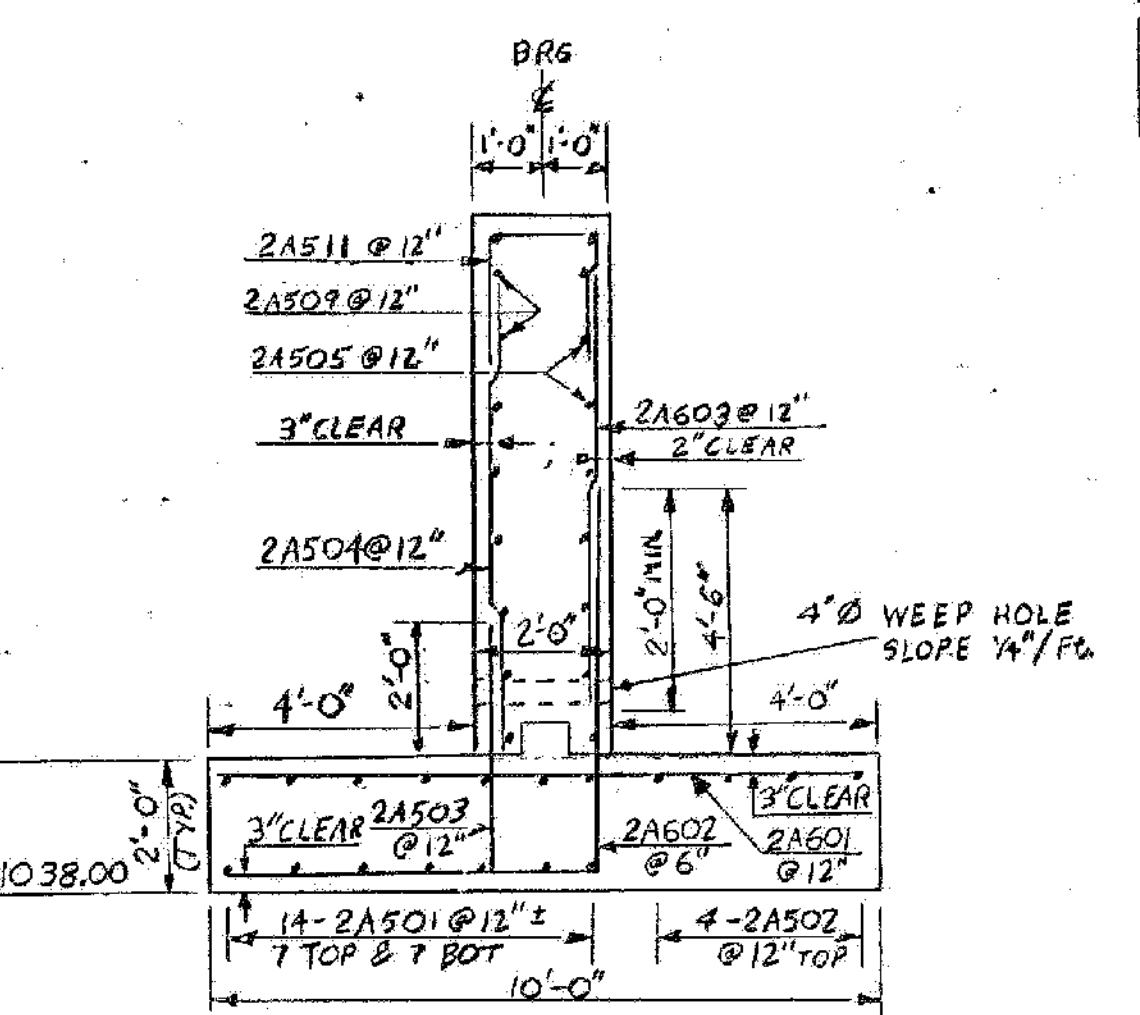


ABUTMENT # 2 - TYPICAL SECTION
SCALE: 3/8" = 1'-0"

1-93 BRIDGES 3N&S
WATERFORD
IM MEMB(31)
SHEET 31 OF 48
FOR REFERENCE ONLY

STATE OF VERMONT	
AGENCY OF TRANSPORTATION	
TOWN OF WATERFORD	Bridge No. B5
HIGHWAY NO. I 93	Log Sta. Surv. Sta. 251+70
NORTHBOUND OVER TH 12	
ABUTMENT # 2 & WINGWALL # 3 DETAILS	
Designed by S.G. FARNSWORTH	Drawn by S.G. FARNSWORTH
Checked by G. ROGERS	Bridge Design Supervisor
date 6/80	F.W. Bolkum date 7/80
PROJECT WATERFORD	PROJECT NO. I 93-1(3) 1/2
Bridge Sheet No. BR 511	Sheet 132 of 531

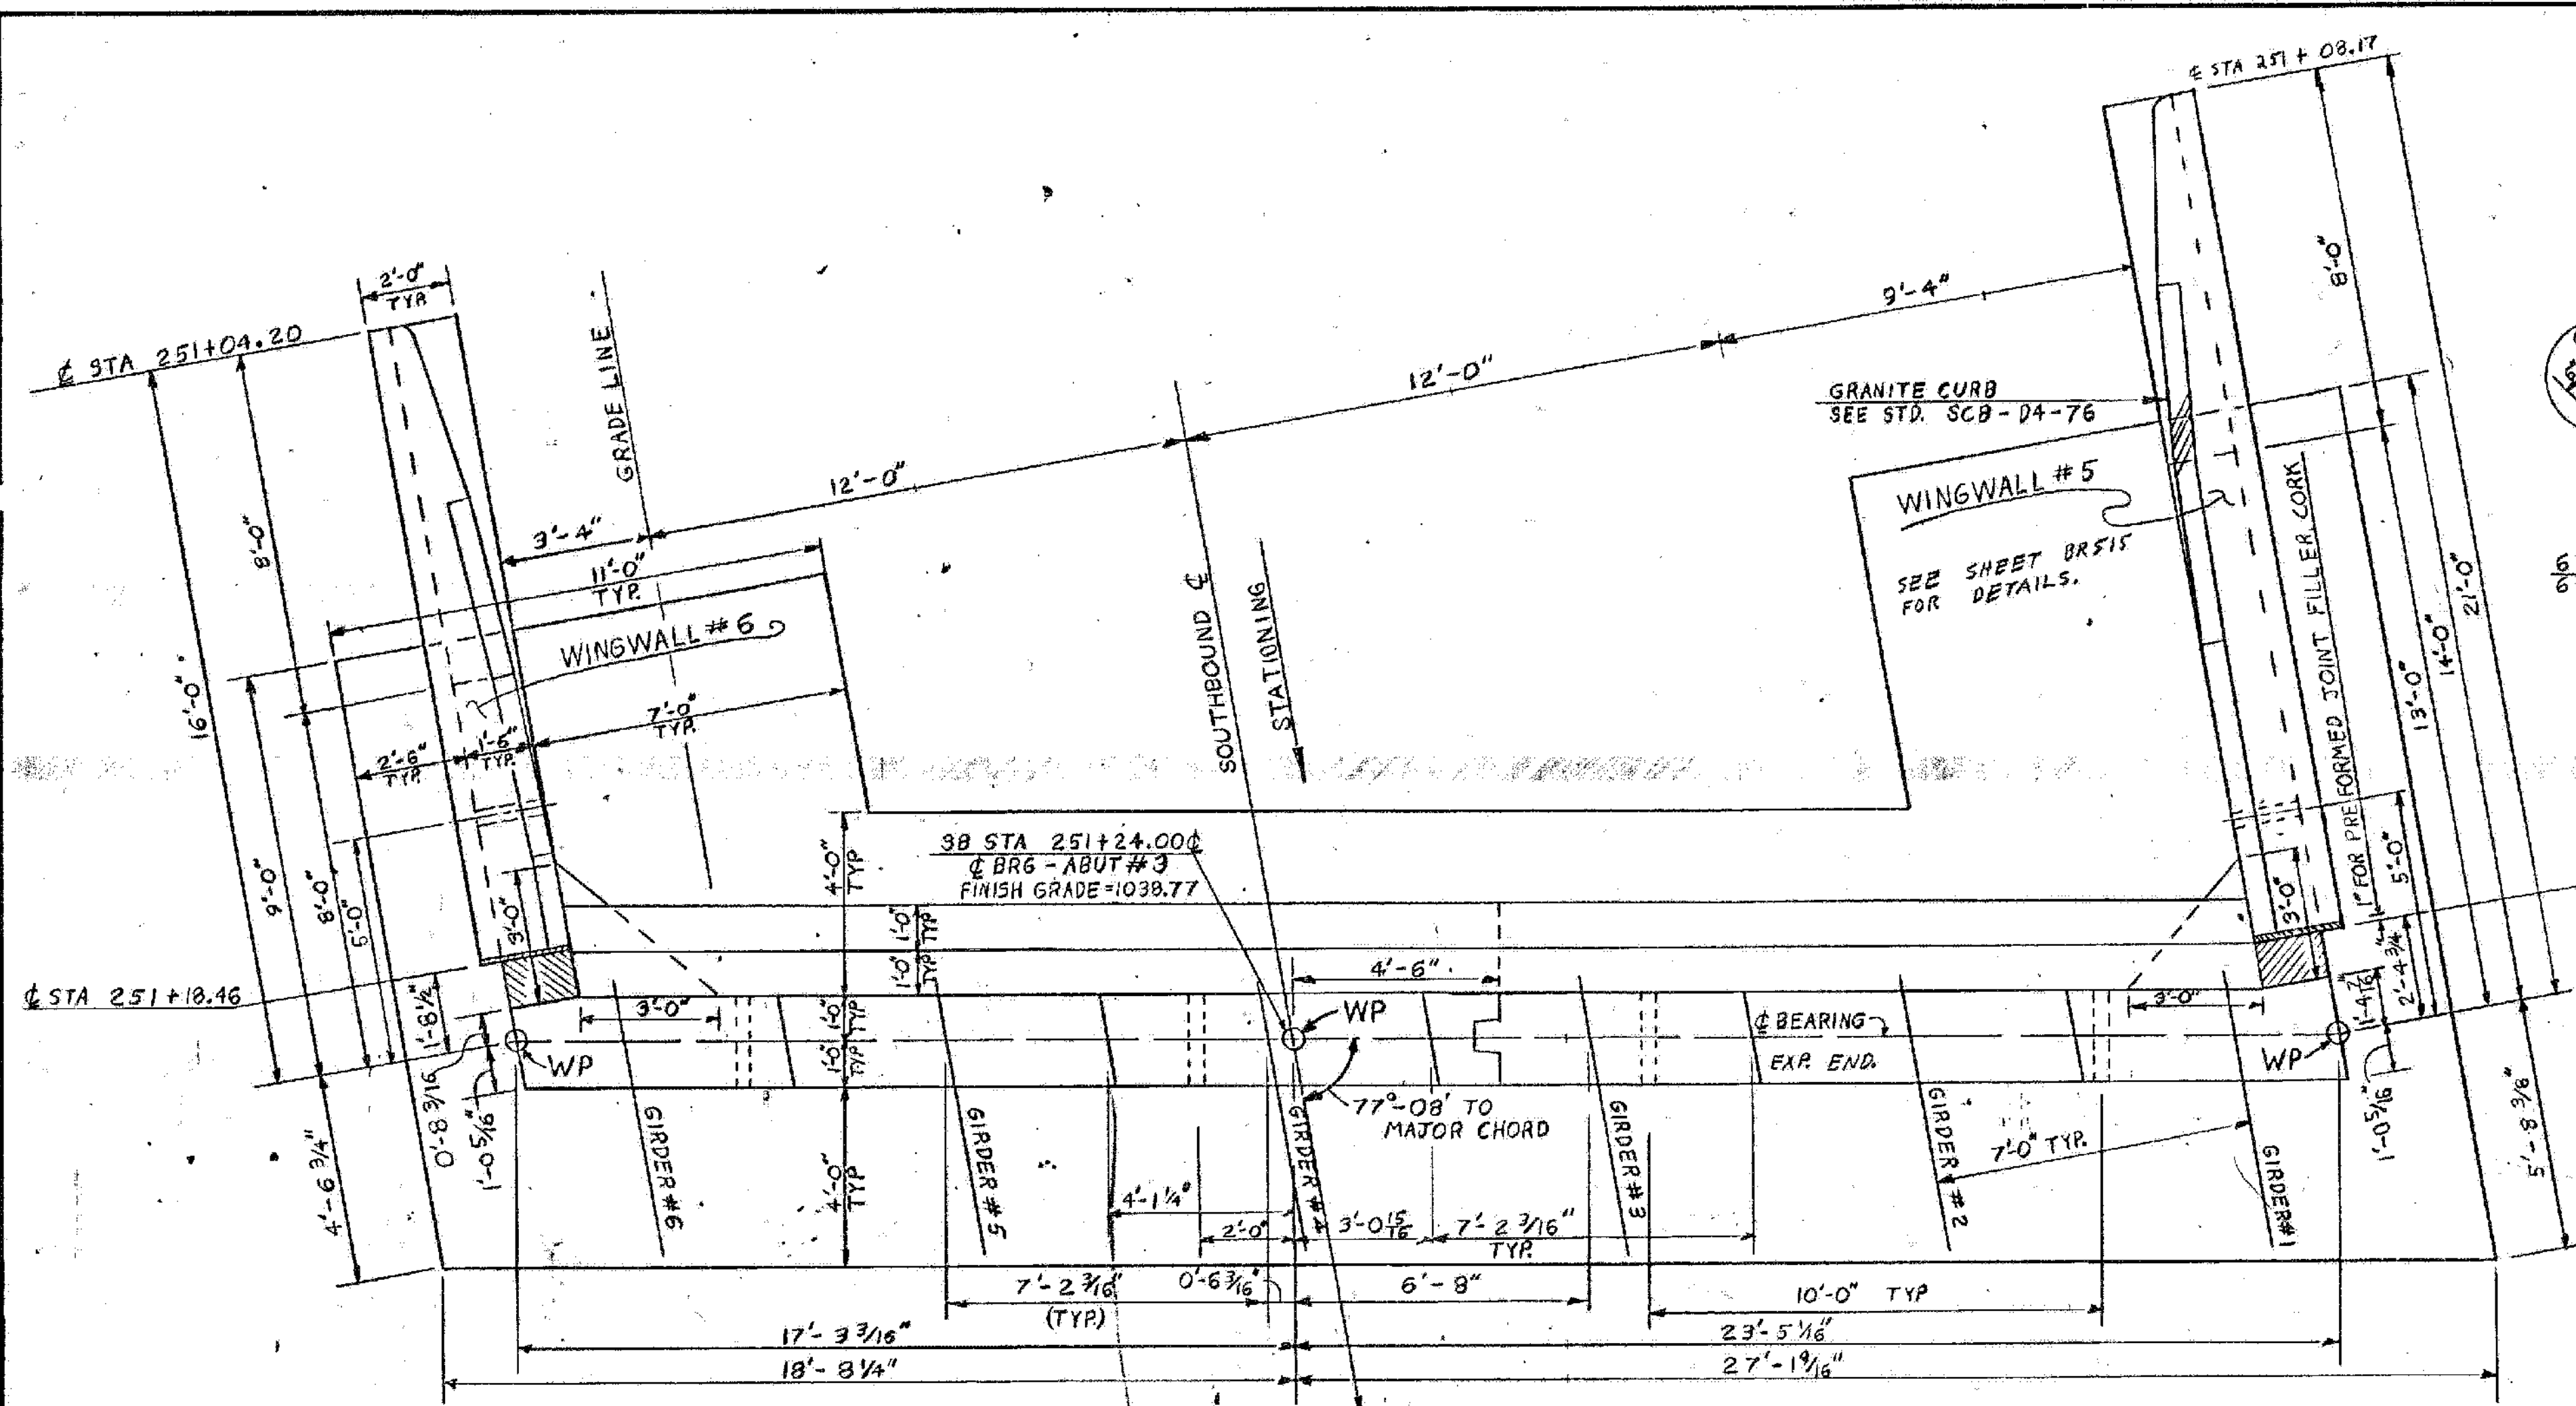


ABUTMENT #3 PLAN
SCALE: 3/8" = 1'-0"

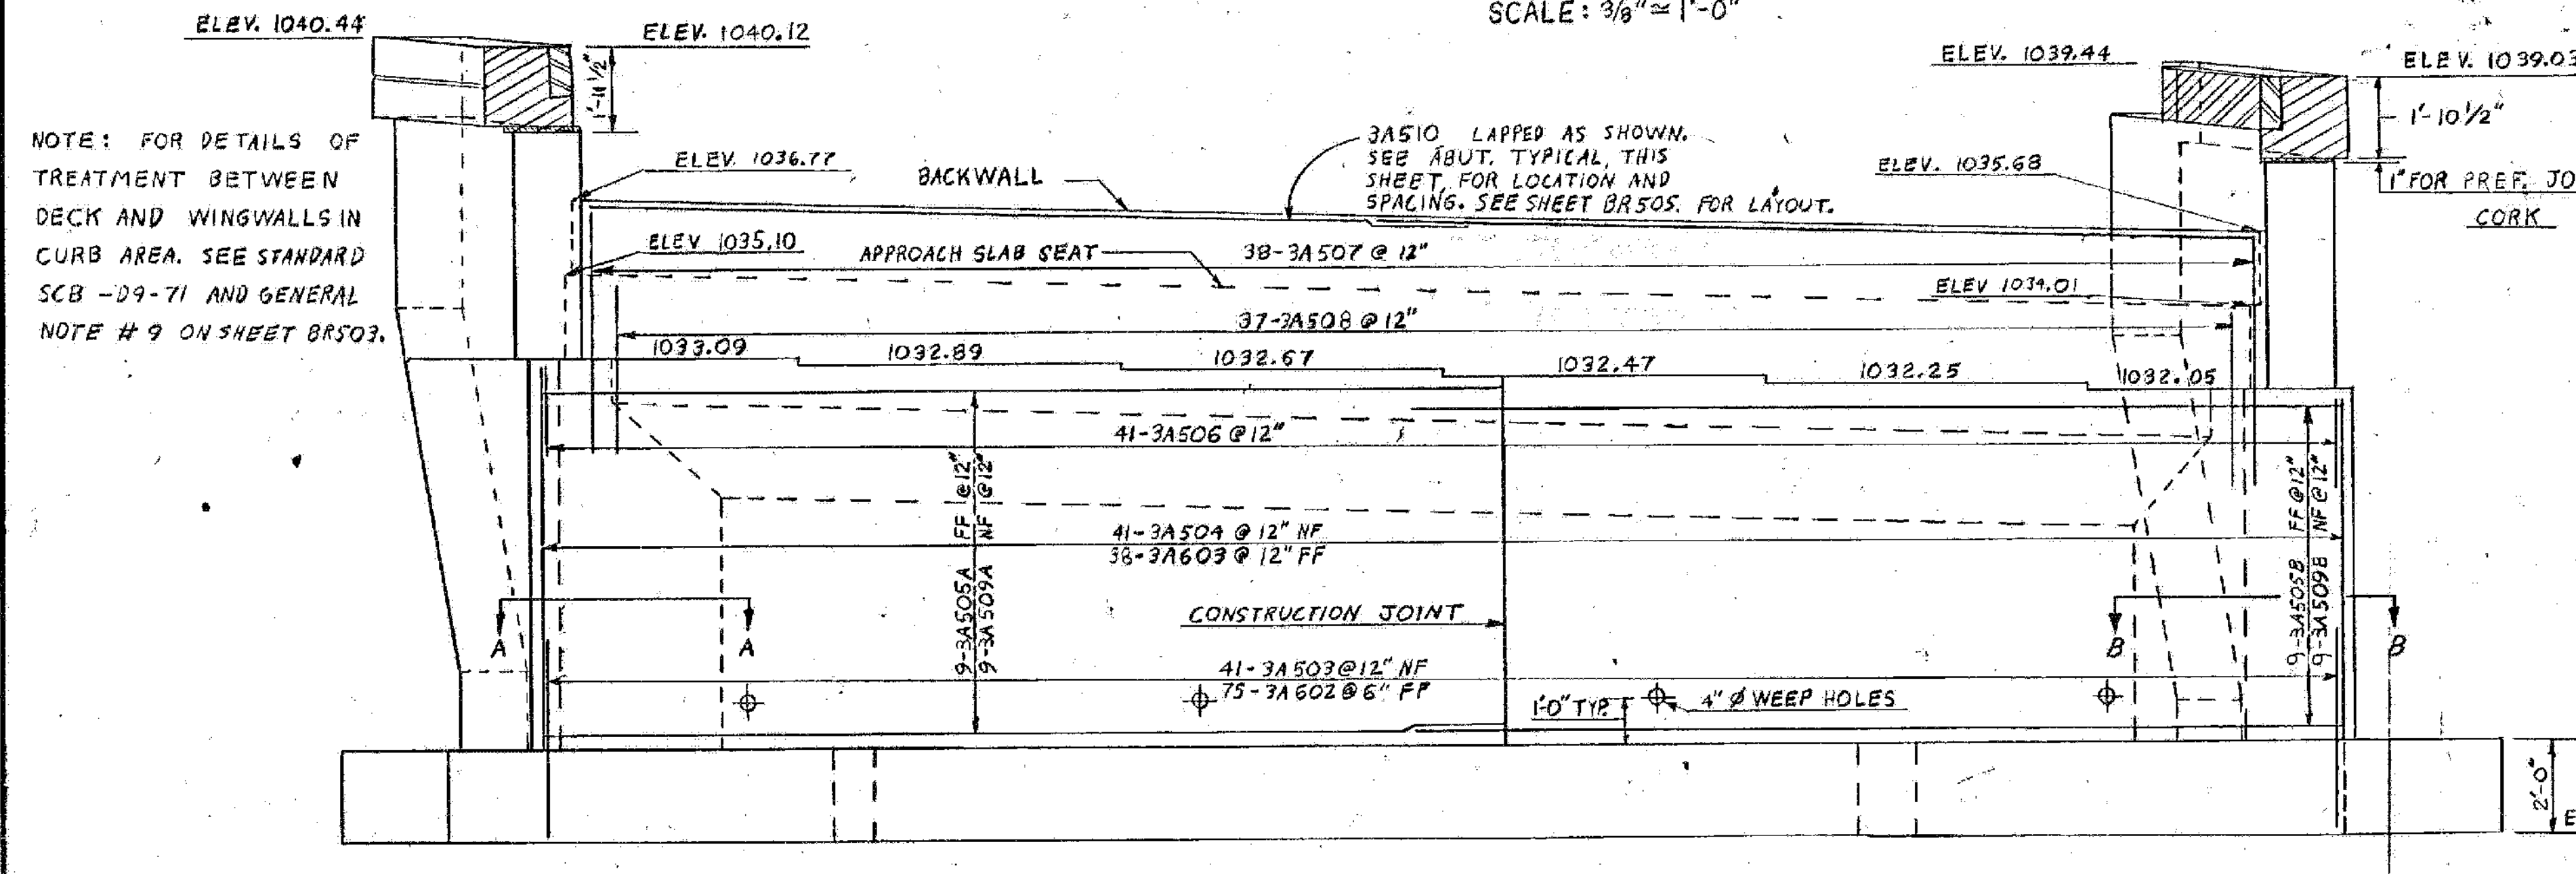

ABUTMENT #3 ELEVATION
SCALE: 3/8" = 1'-0"


NOTE: FOR DETAILS OF TREATMENT BETWEEN DECK AND WINGWALLS IN CURB AREA. SEE STANDARD SCB-D9-71 AND GENERAL NOTE #9 ON SHEET BR503.

3A510 LAPPED AS SHOWN. SEE ABUT. TYPICAL. THIS SHEET FOR LOCATION AND SPACING. SEE SHEET BR505 FOR LAYOUT.

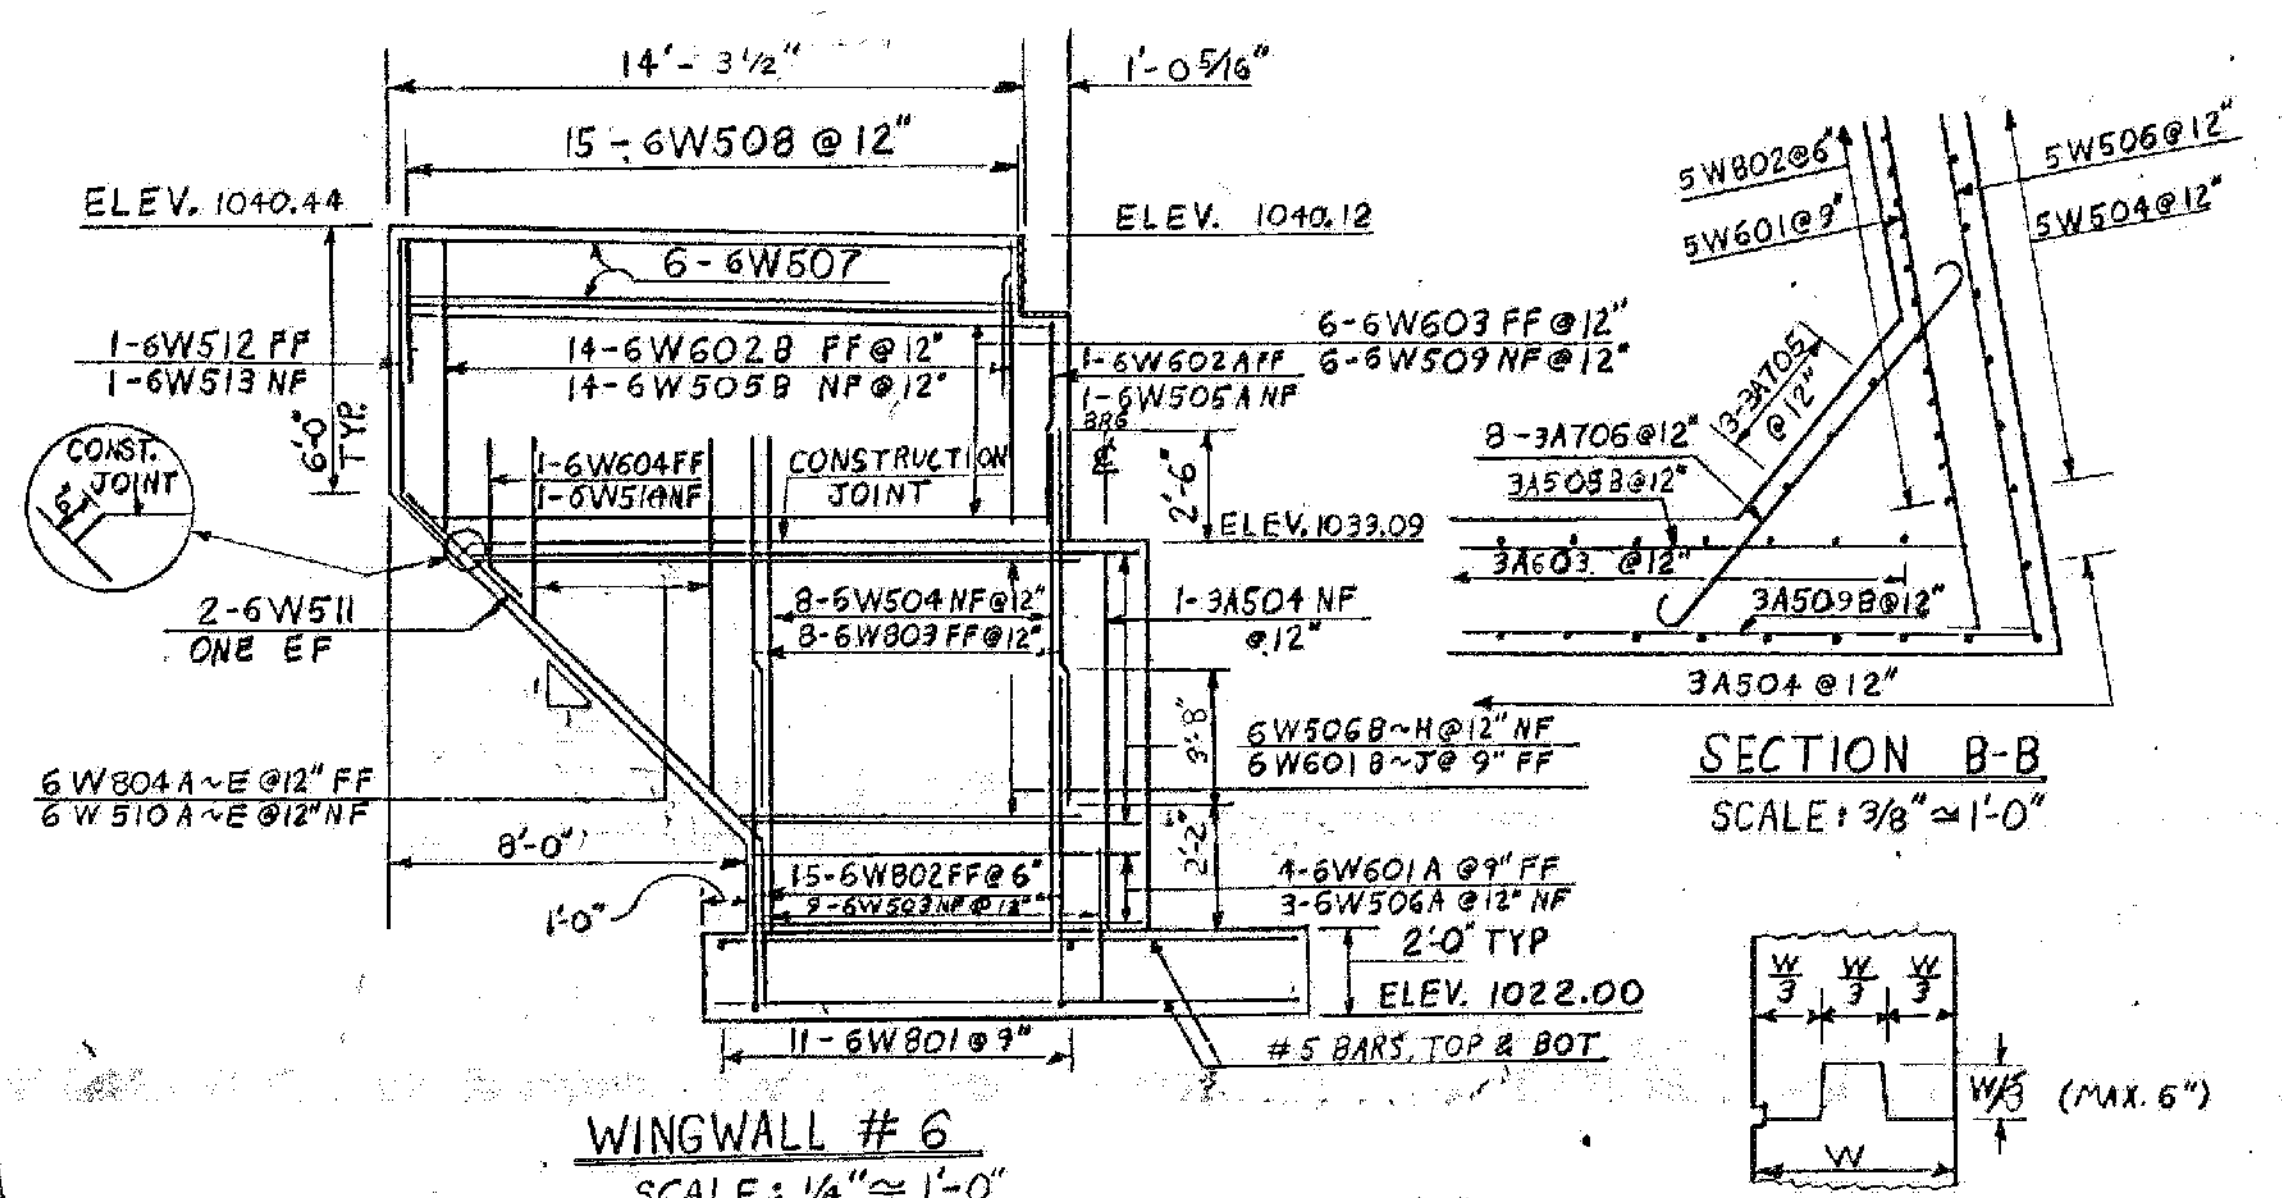


WINGWALL #6
SCALE: 1/4" = 1'-0"

SECTION B-B
SCALE: 3/8" = 1'-0"

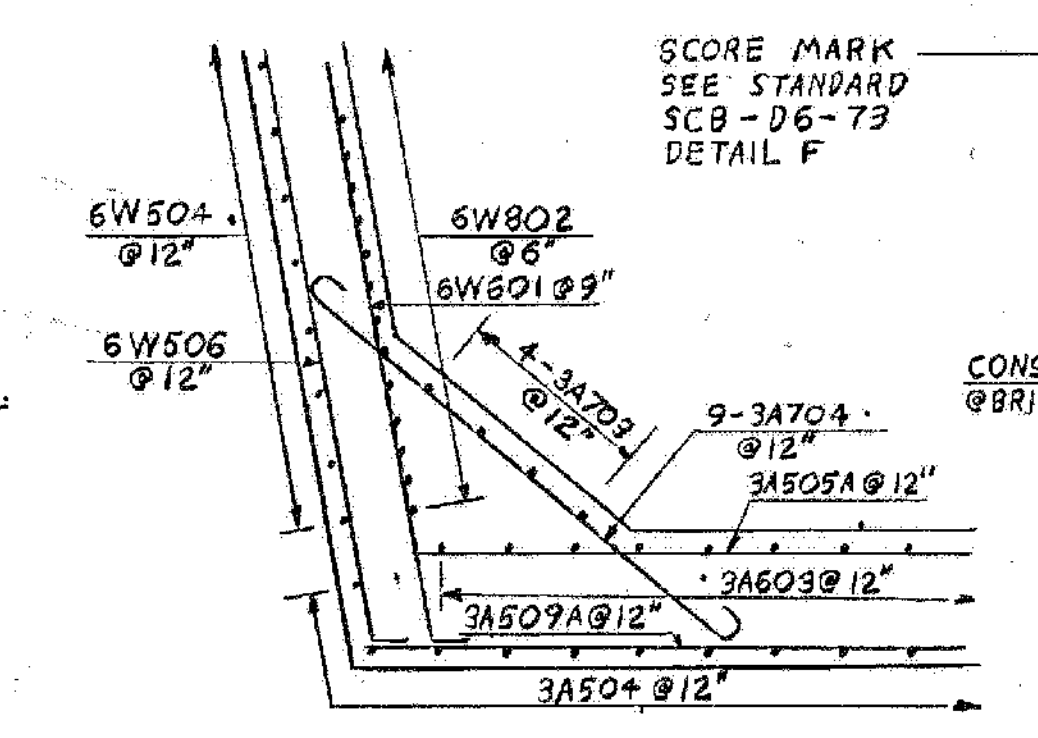


SECTION A-A
SCALE: 3/8" = 1'-0"

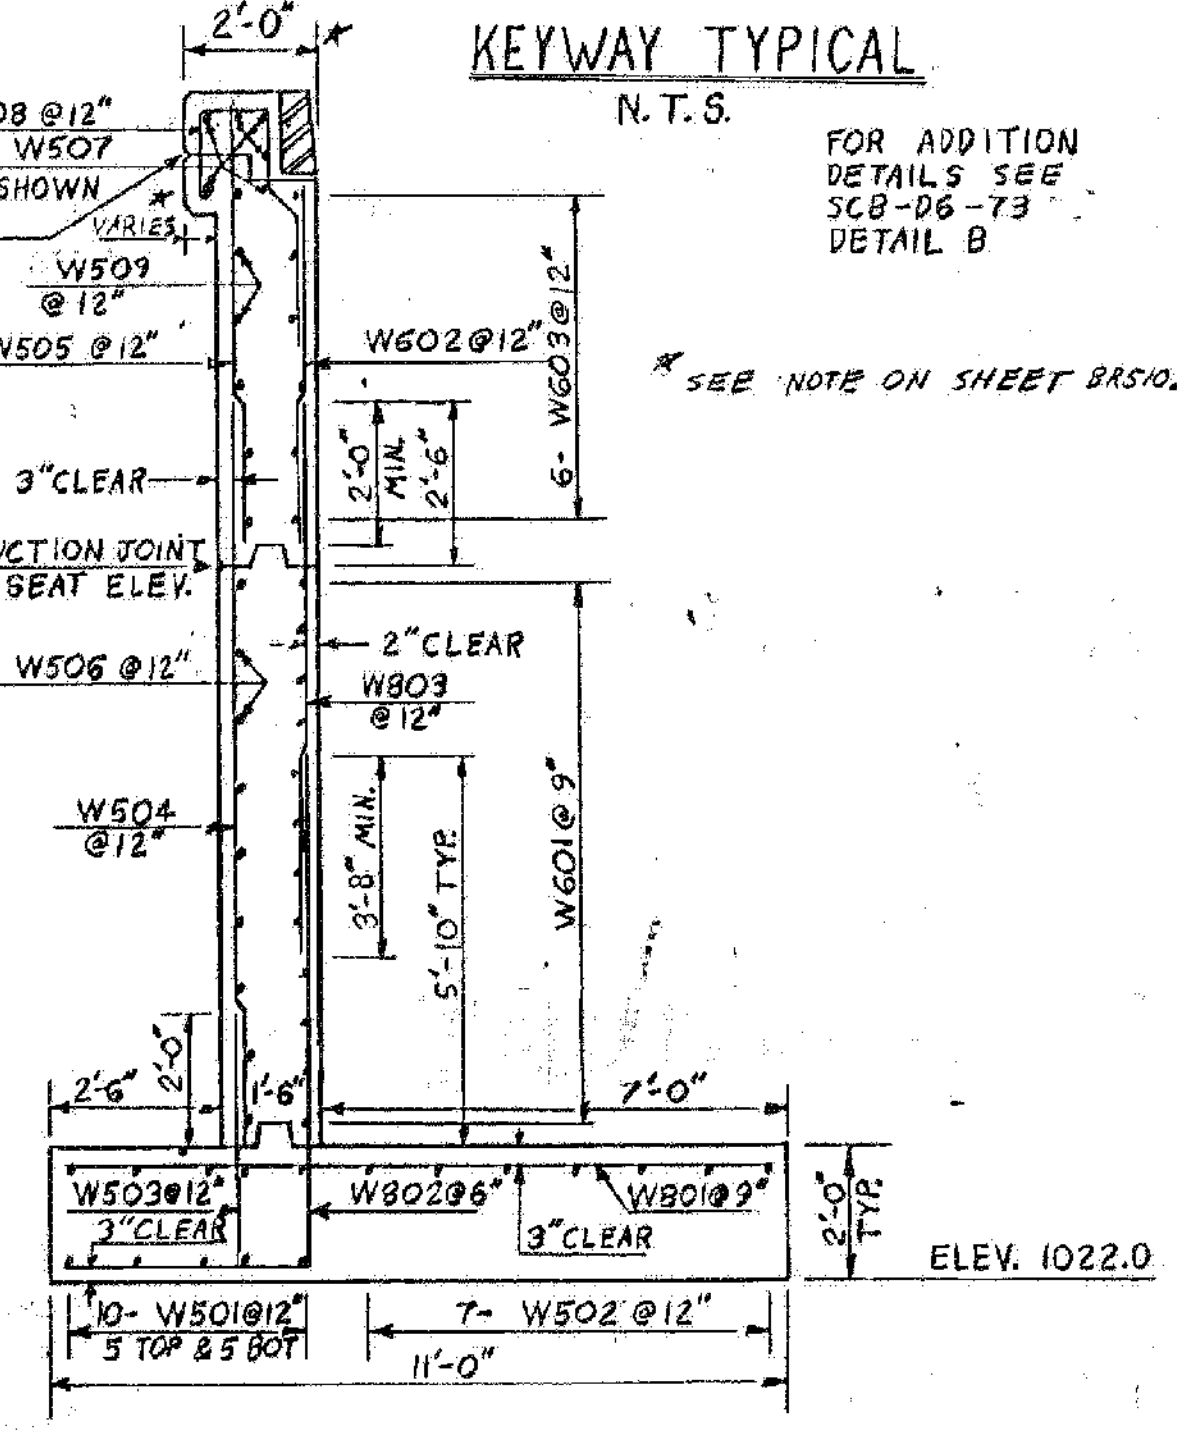


TYPICAL WINGWALL SECTION
SCALE: 3/8" = 1'-0"

93 BRIDGES 3N&S
WATERFORD
IM MEMB(31)
SHEET 32 OF 48
FOR REFERENCE ONLY

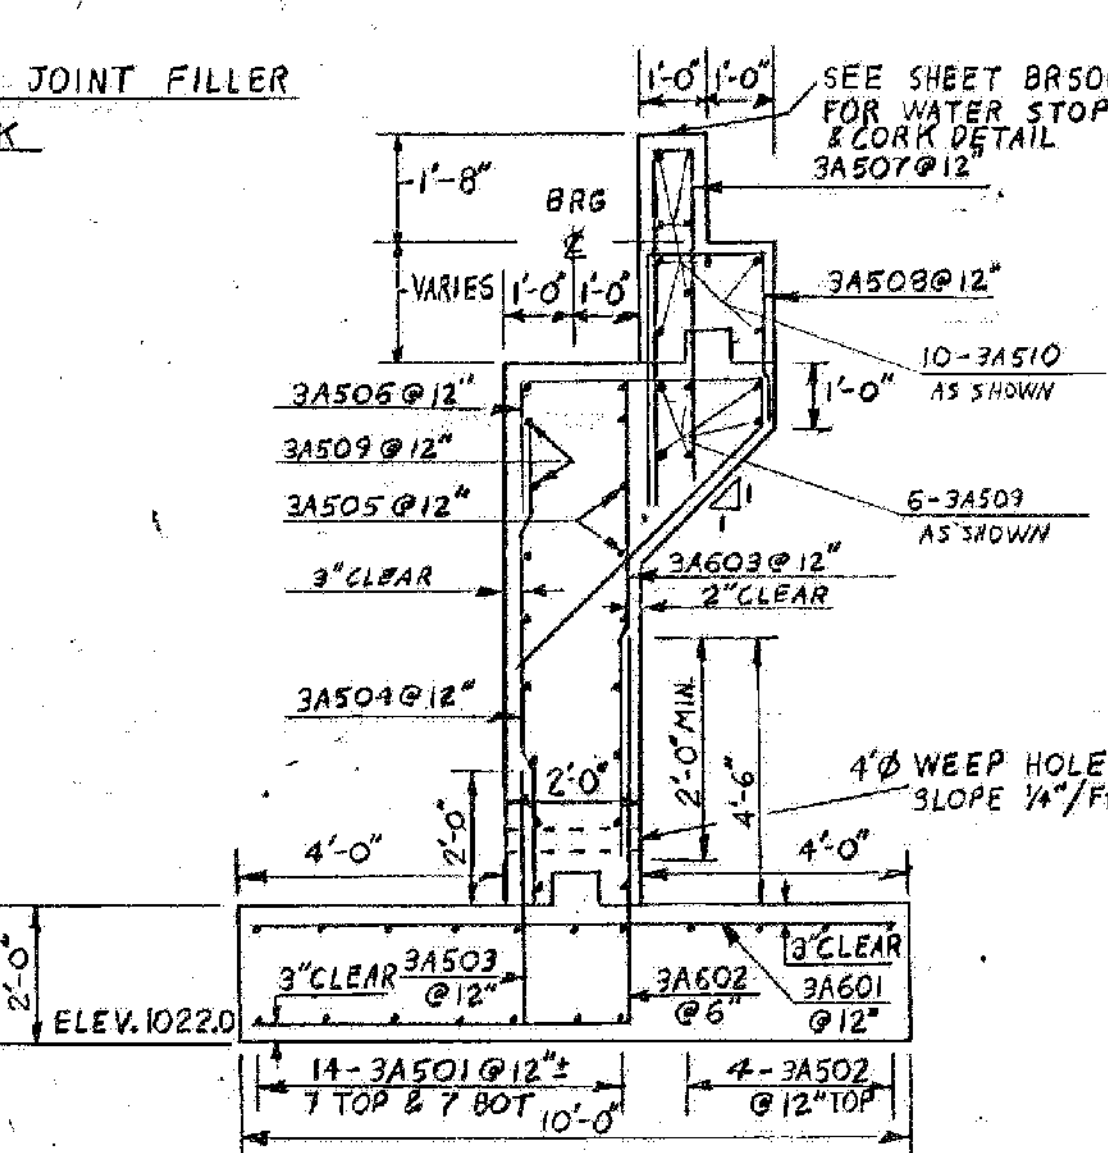


ABUTMENT #3 - TYPICAL SECTION
SCALE: 3/8" = 1'-0"

STATE OF VERMONT	
AGENCY OF TRANSPORTATION	
TOWN OF WATERFORD	Bridge No. B5
HIGHWAY No. I 93	Log Sta.
I93 SOUTHBOUND OVER TH.12	
ABUTMENT #3 & WINGWALL #6 DETAILS	
Designed by S.G. FARNSWORTH	Drawn by S.G. FARNSWORTH
Checked by G. ROGERS	Bridge Design Supervisor
date 6/30	FWY. Bolkom date 7/80
PROJECT WATERFORD	PROJECT NO. I93-1(3) 92
Bridge Sheet No. BR 513	Sheet 134 of 531

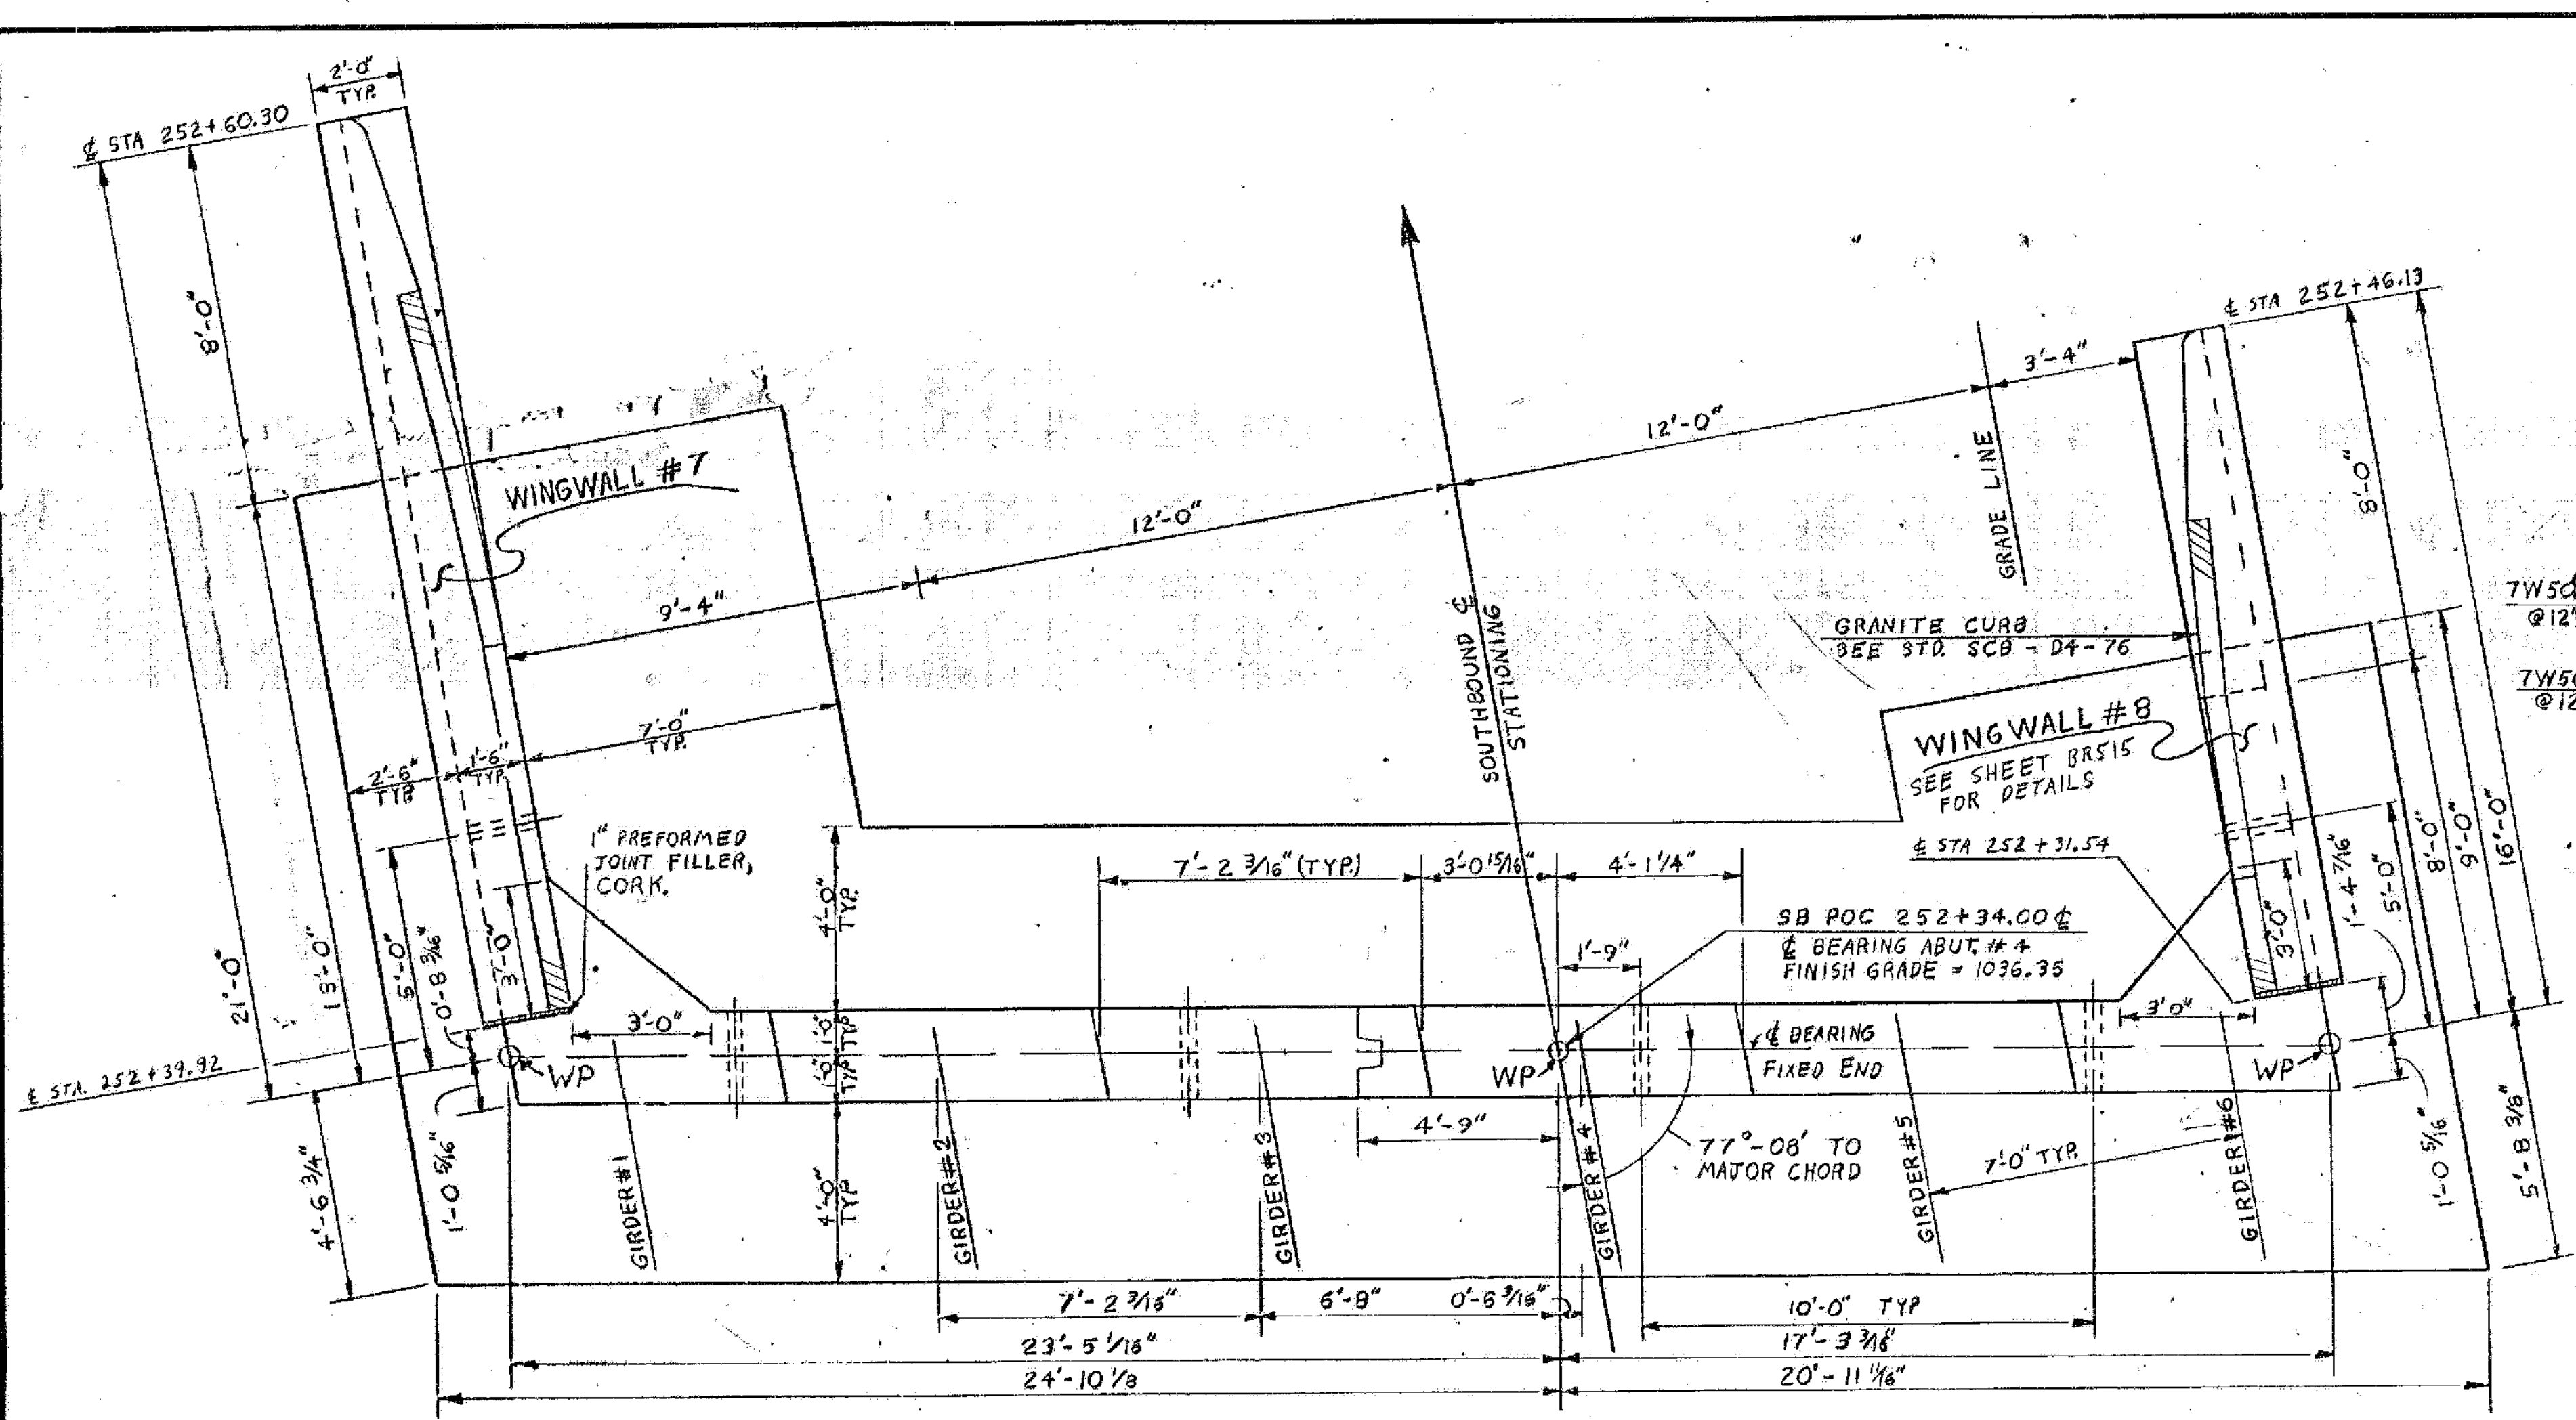


ABUTMENT #4 PLAN
SCALE: 3/8" = 1'-0"

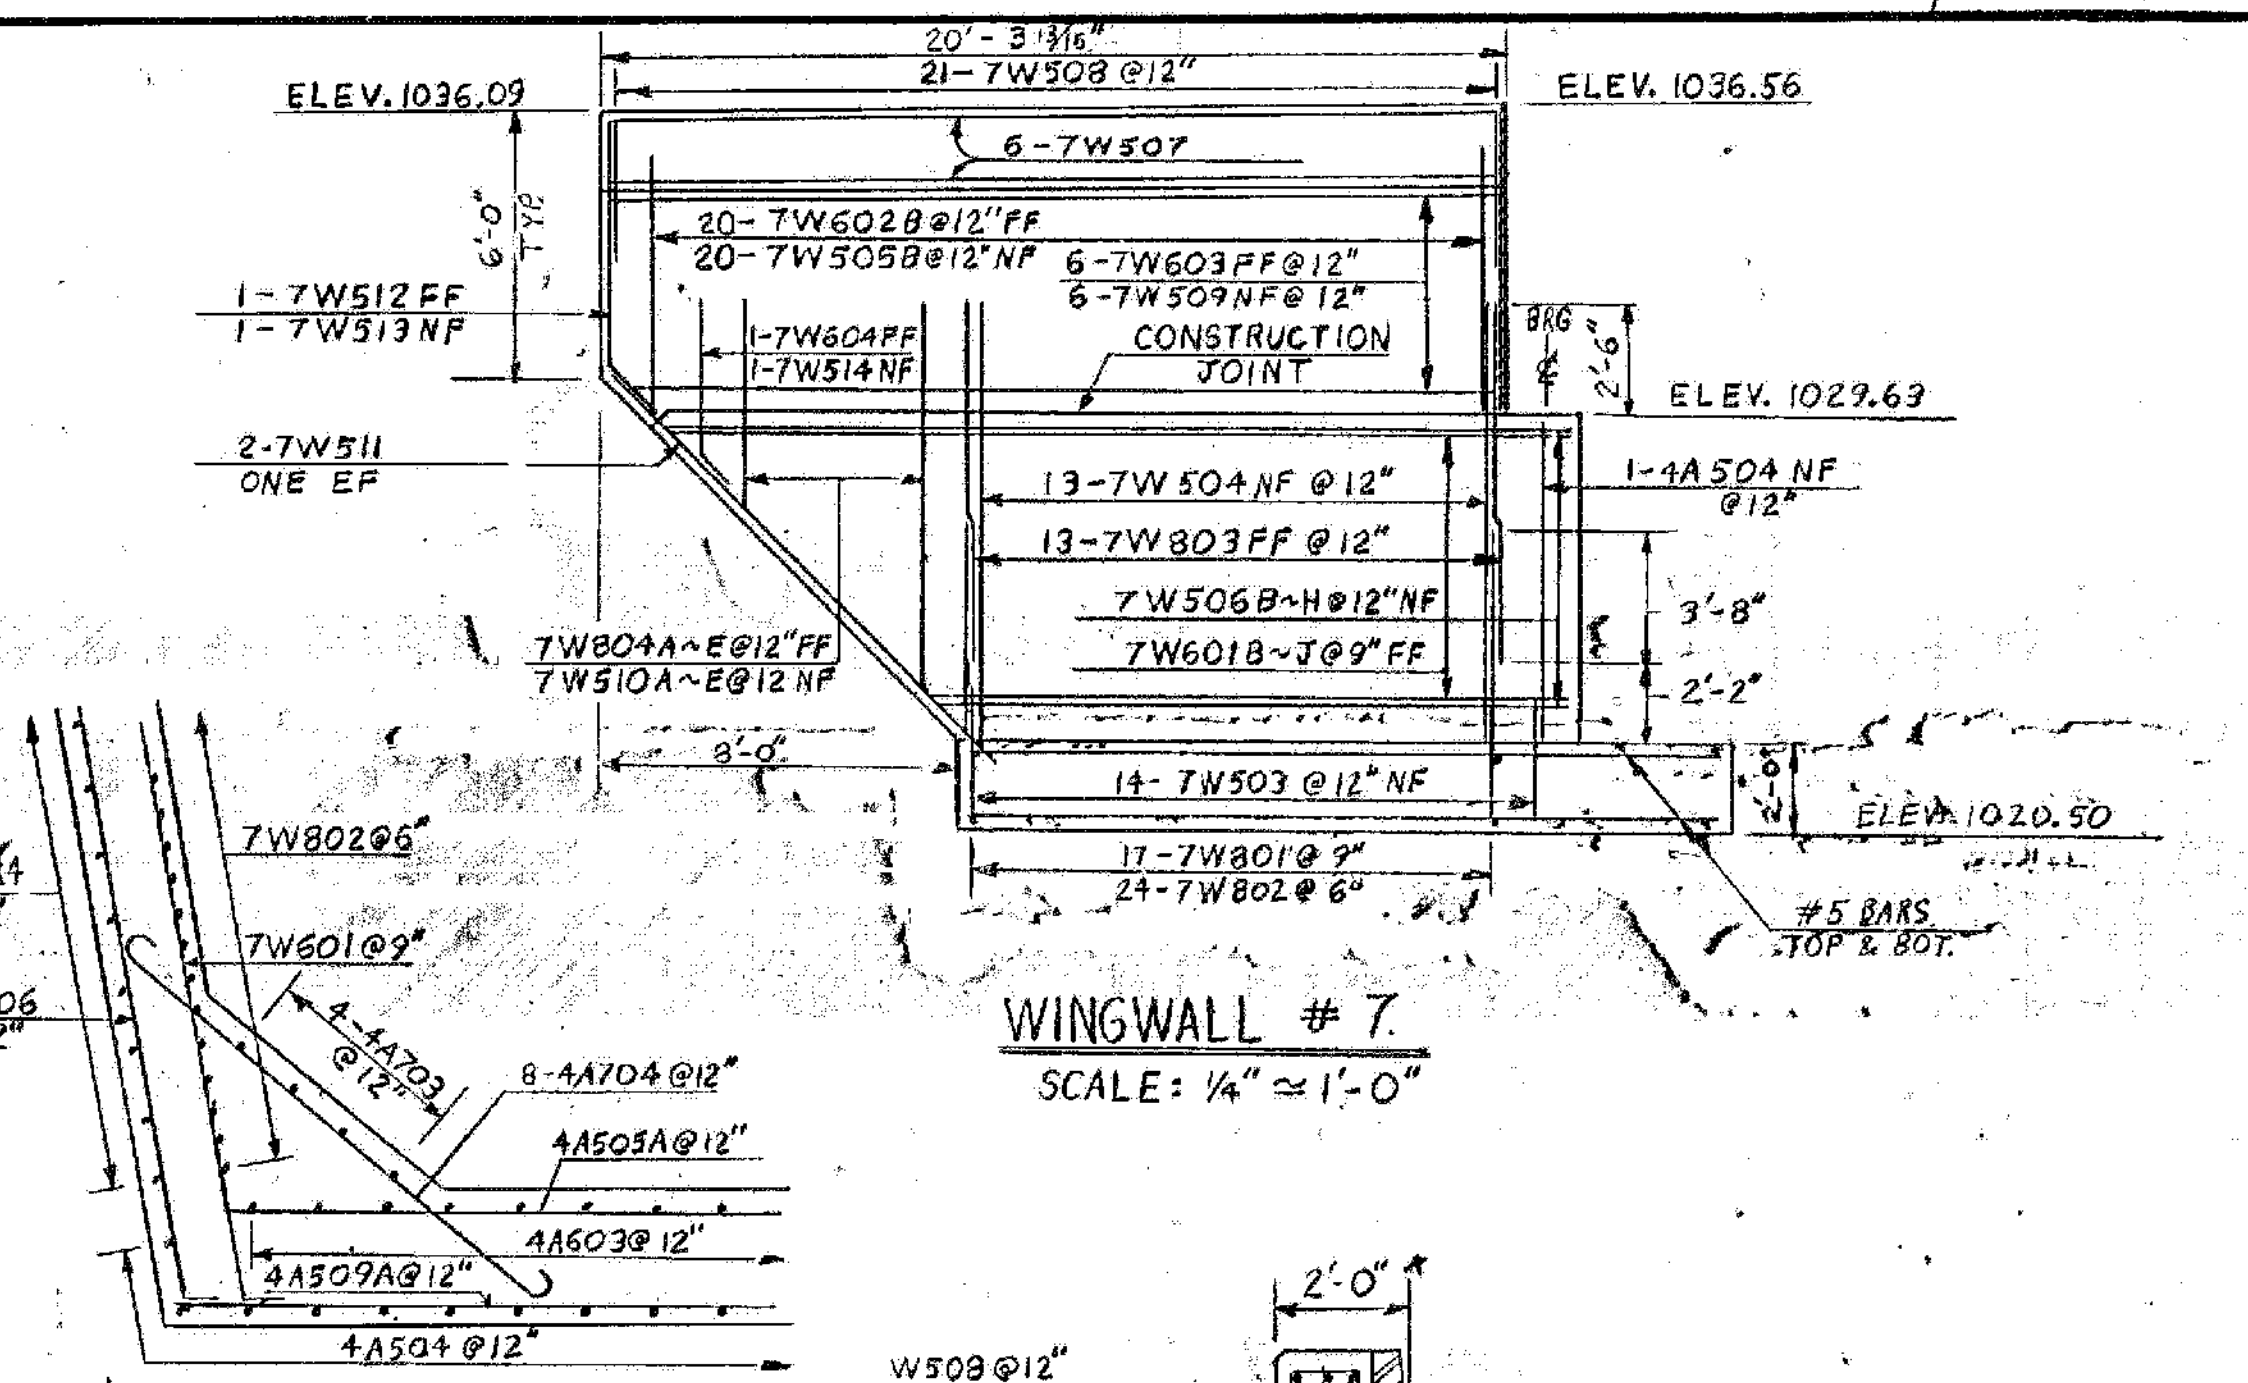


WINGWALL #7
SCALE: 1/4" = 1'-0"


SECTION A-A
SCALE: 3/8" = 1'-0"

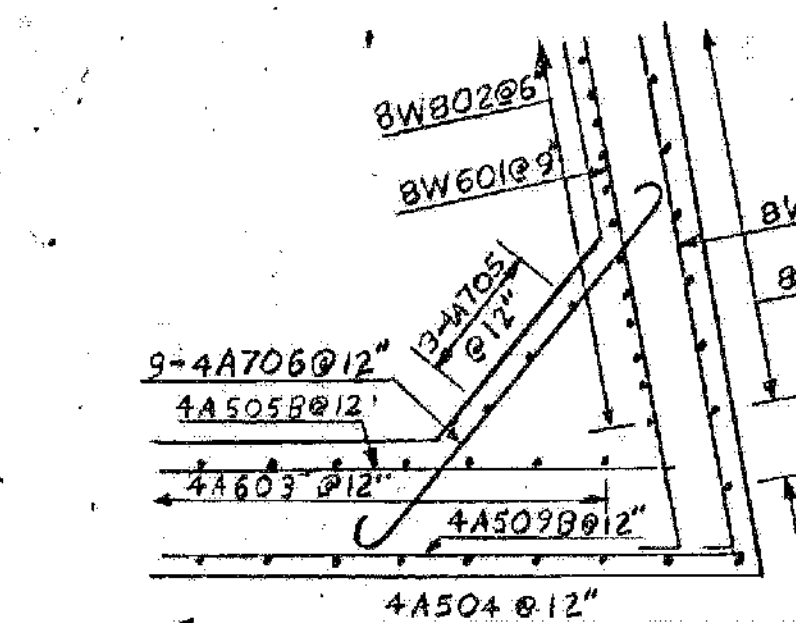


SECTION B-B
SCALE: 3/8" = 1'-0"

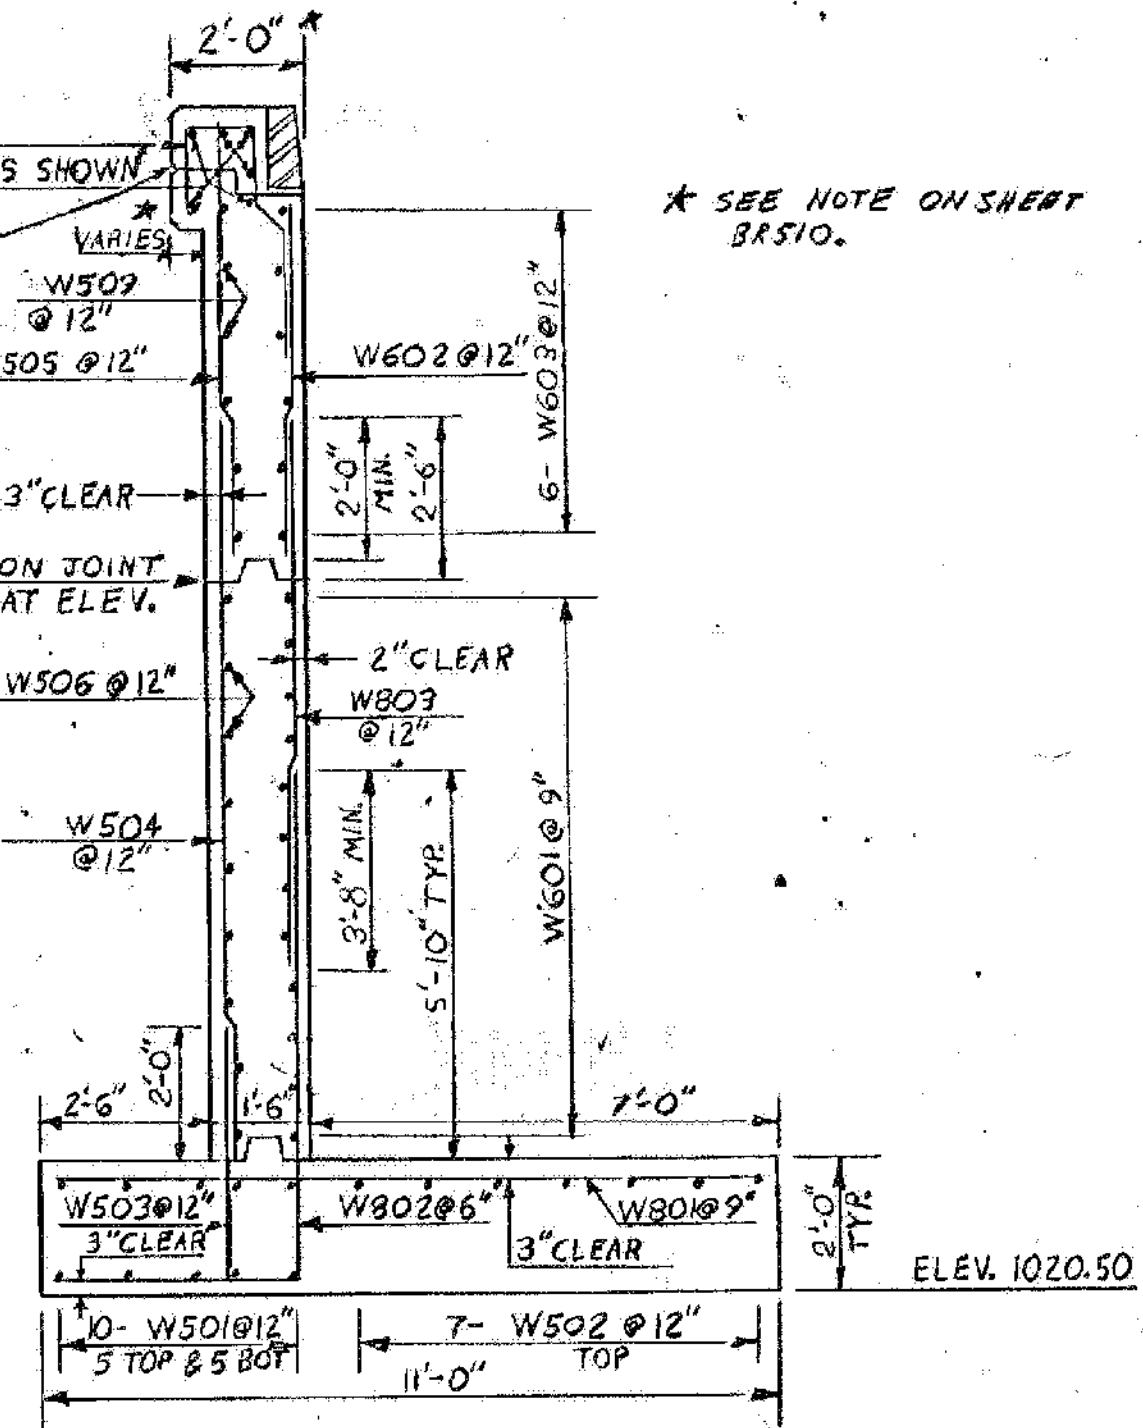

TYPICAL WINGWALL SECTION
SCALE: 3/8" = 1'-0"

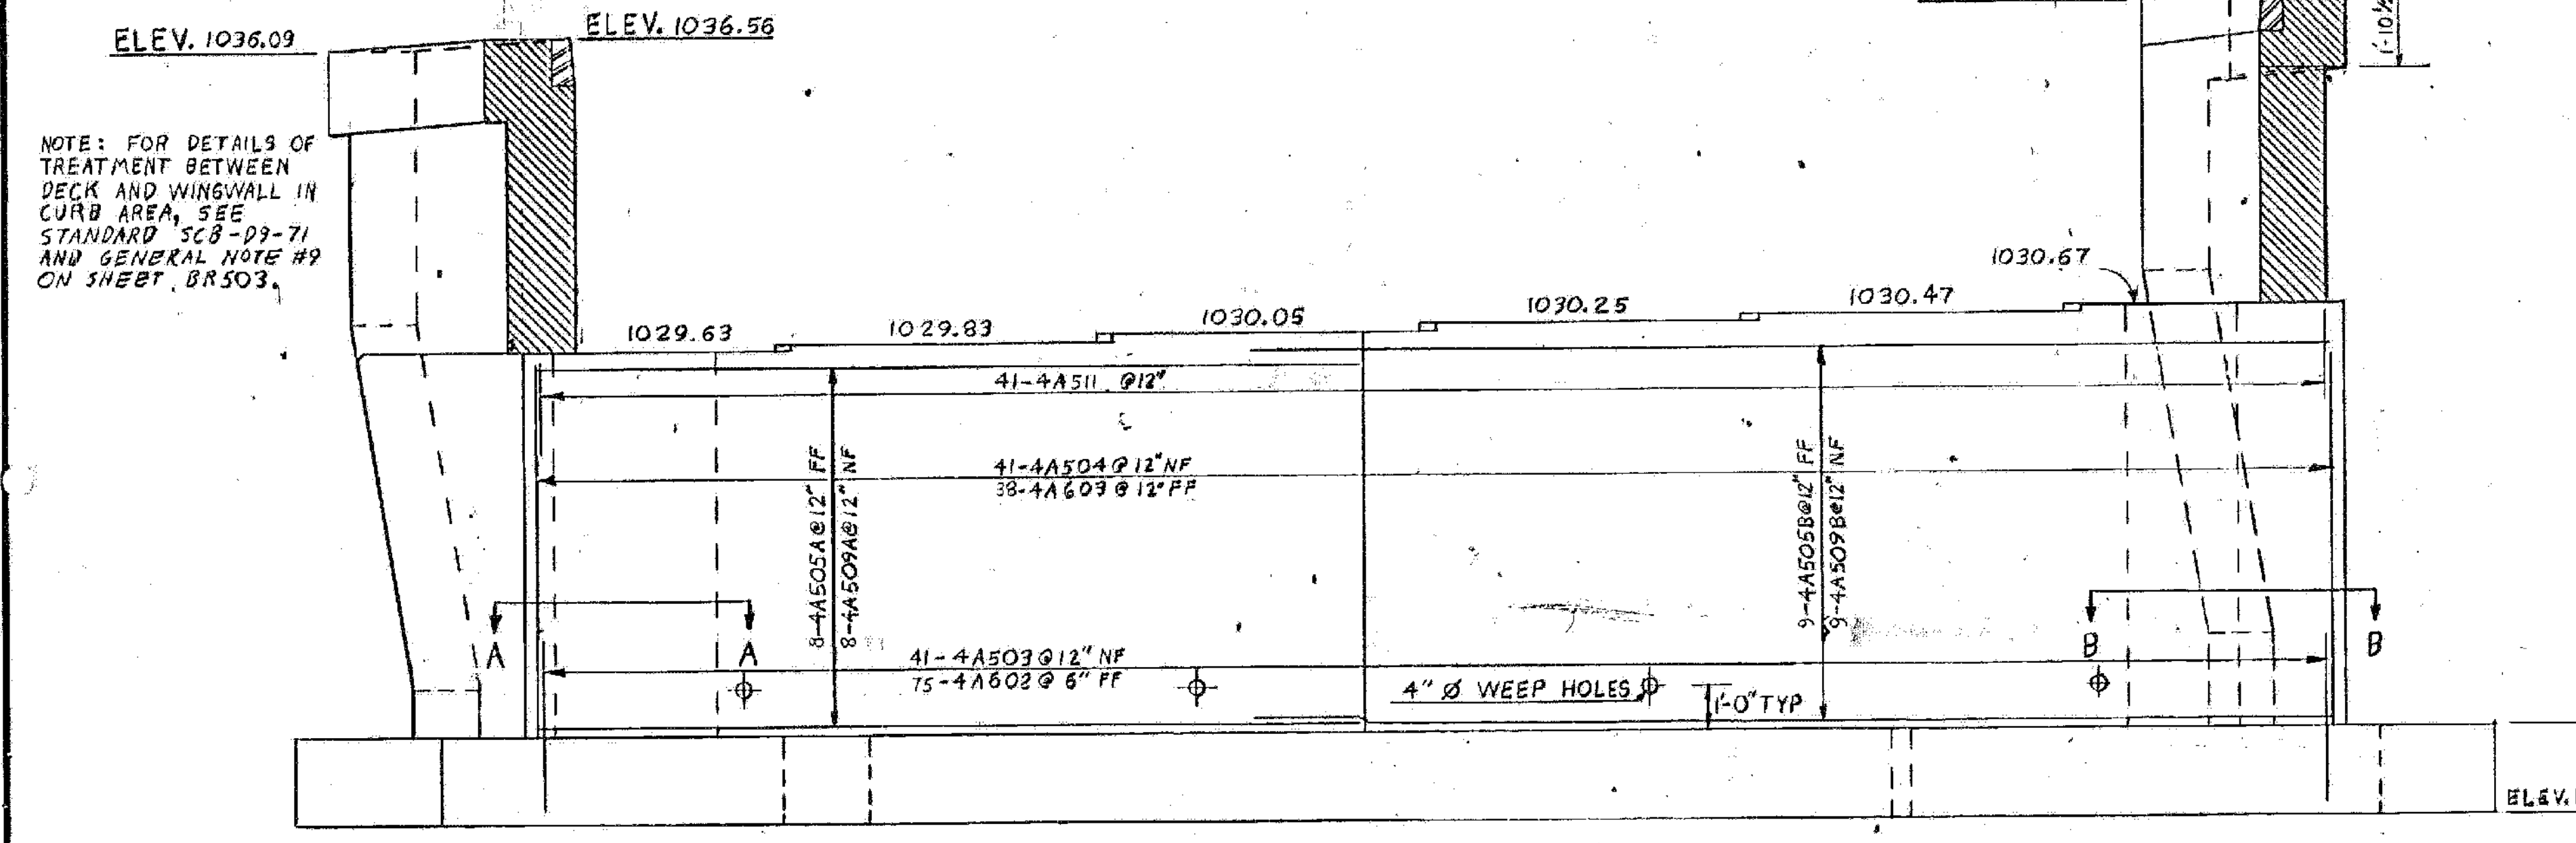

ABUTMENT #4 ELEVATION
SCALE: 3/8" = 1'-0"

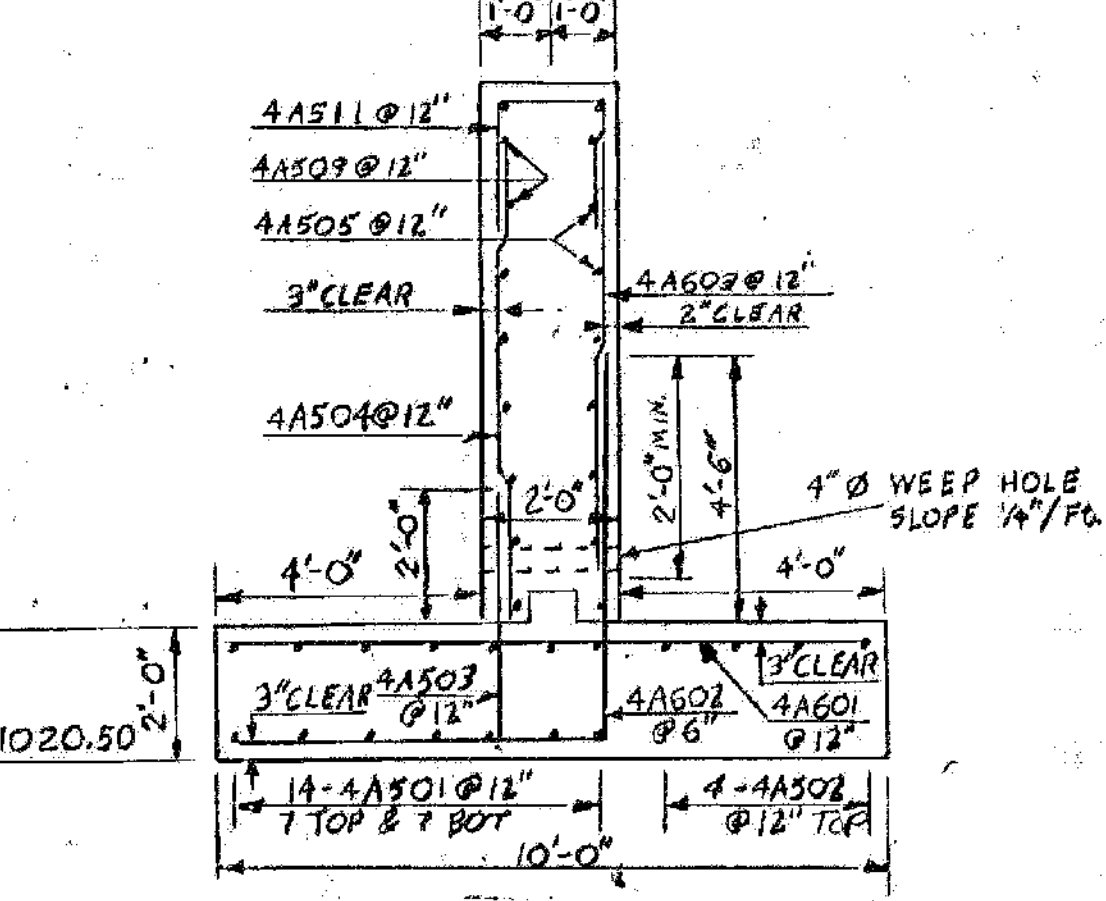




ABUTMENT #4 - TYPICAL SECTION
SCALE: 3/8" = 1'-0"

NOTE: FOR DETAILS OF TREATMENT BETWEEN DECK AND WINGWALL IN CURB AREA, SEE STANDARD SCB-D9-71 AND GENERAL NOTE #9 ON SHEET BR503.

* SEE NOTE ON SHEET BR510.

I-93 BRIDGES 3N&S
WATERFORD
IM MEMB(31)
SHEET 33 OF 48
FOR REFERENCE ONLY

STATE OF VERMONT AGENCY OF TRANSPORTATION	
TOWN OF WATERFORD	Bridge No. B5
HIGHWAY NO. I93	Log Sta. Surv. Sta. 251+70
I93 SOUTHBOUND OVER TH 12 ABUTMENT #4 & WINGWALL #7 DETAILS	
Designed by S.G. FARNSWORTH	Drawn by S.G. FARNSWORTH
Checked by G. ROGERS	Bridge Design Supervisor
date 6/80	F.W. Balkum date 7/80
PROJECT WATERFORD	PROJECT NO. I93-1(3) 9a
Bridge Sheet No. BR514	Sheet 135 of 531

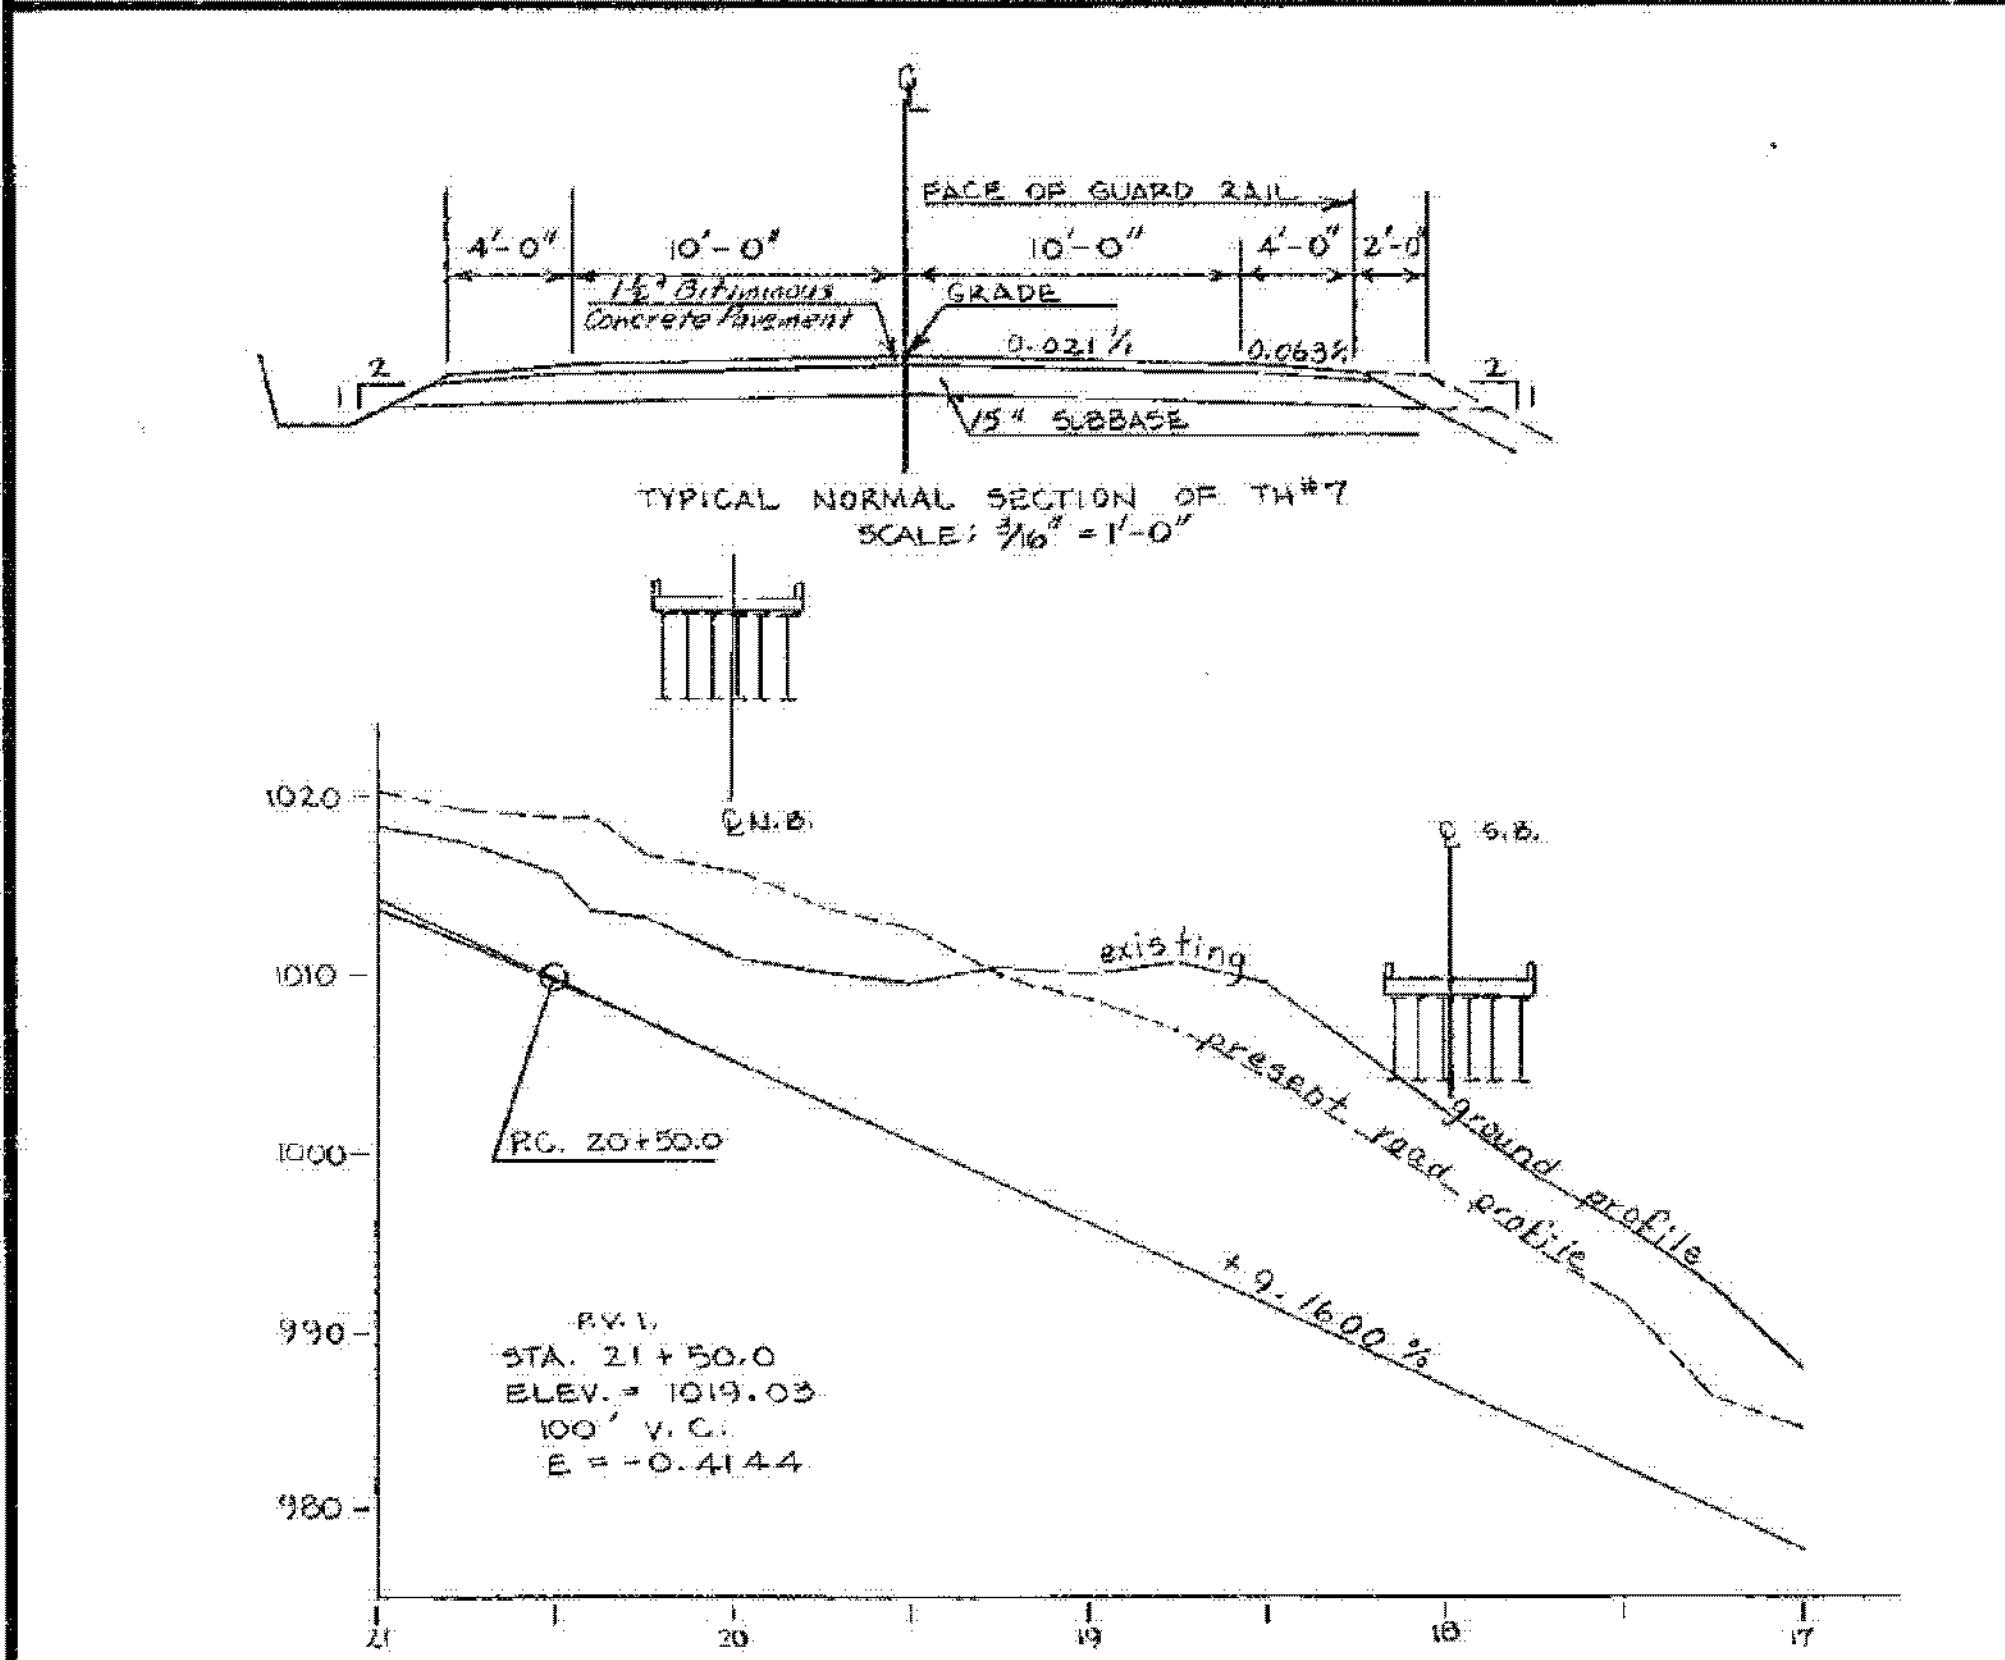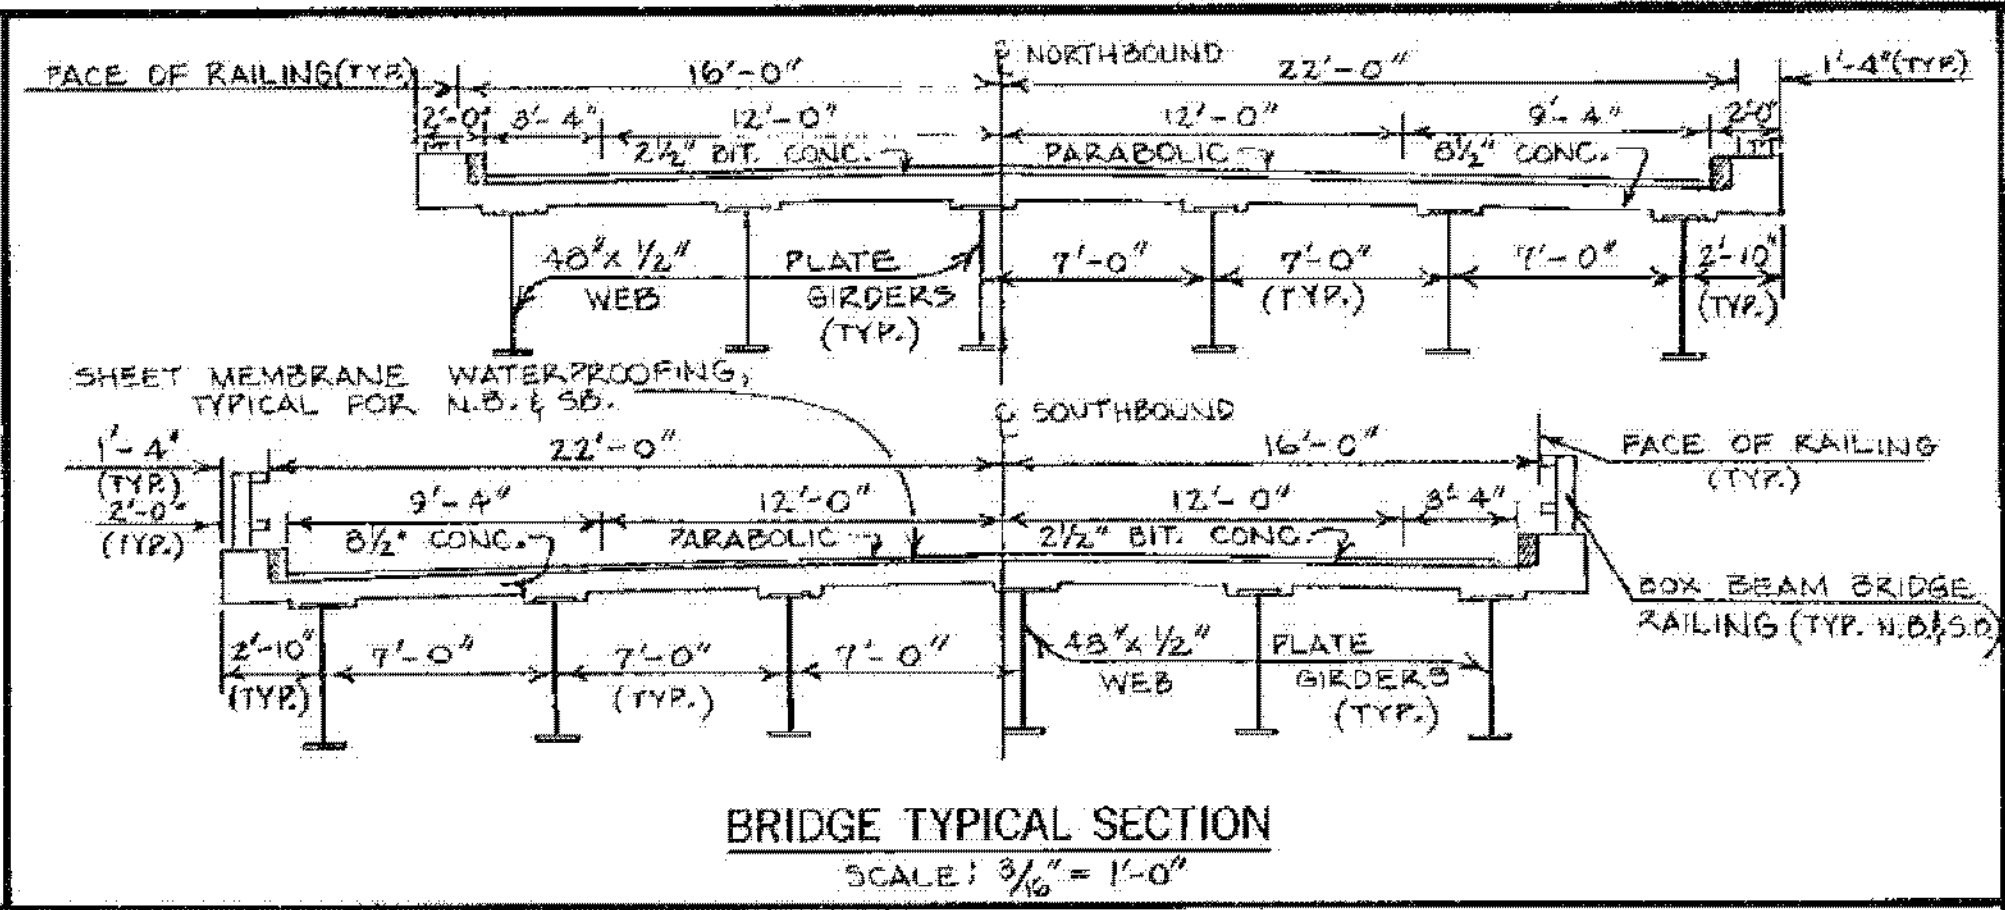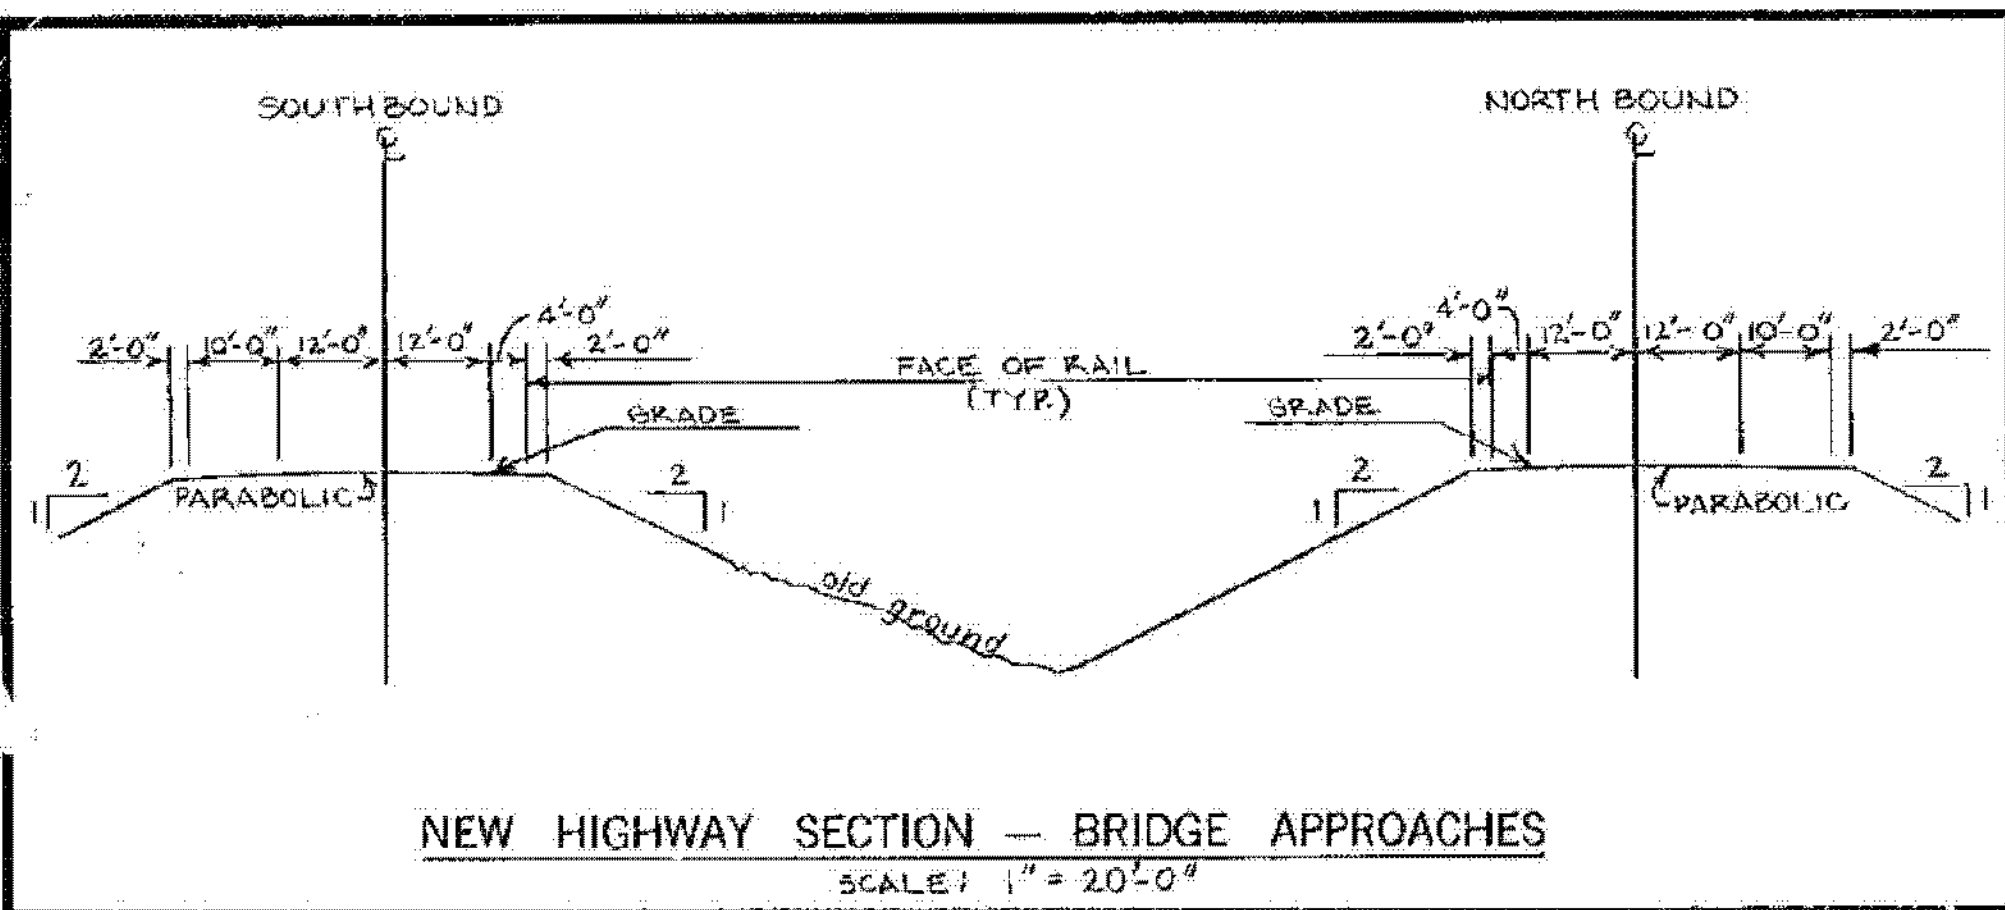

LIST OF SHEETS

- BR 700 PRELIMINARY INFORMATION SHEET
- BR 701 BRIDGE QUANTITY SHEET
- BR 702 PLAN & ELEVATION SHEET - (NORTHBOUND)
- BR 703 PLAN & ELEVATION SHEET - (SOUTHBOUND)
- BR 704 BORING LOGS - NORTHBOUND
- BR 705 BORING LOGS - SOUTHBOUND
- BR 706 SUPERSTRUCTURE DETAILS
- BR 707 SOLE PLATE, BEARING & CROSS FRAME DETAILS
- BR 708 BRIDGE APPROACH RAIL DETAILS
- BR 709 APPROACH SLAB & DECK REINFORCING PLAN
- BR 710 ABUTMENT NO. 1 DETAILS
- BR 711 ABUTMENT NO. 2 DETAILS
- BR 712 ABUTMENT NO. 3 DETAILS
- BR 713 ABUTMENT NO. 4 DETAILS
- BR 714 WINGWALL DETAILS - (NORTHBOUND)
- BR 715 WINGWALL DETAILS - (SOUTHBOUND)
- BR 716-BR 718 REINFORCING STEEL SCHEDULES



STANDARD SHEETS

- SCB-D1-75 APRIL 3, 1978 (R)
- SCB-D4-76 JANUARY 8, 1978 (R)
- SCB-D6-77 JANUARY 3, 1979 (R)
- SCB-D7-71 (Detail C) DECEMBER 15, 1976 (R)
- SCB-D9-71 JANUARY 27, 1975 (R)
- SB-24-73 NOVEMBER 21, 1979 (R)

REFERENCE SHEETS

- I-93, NBSSB PLAN, STA. 339+0 - 371+0 (2 SHEETS)
- I-93, NBSSB PROFILE, STA. 339+0 - 371+0 (2 SHEETS)
- TH #7 RELOCATION PLAN, STA. 24+0 - 24+0 (1 SHEET)
- TH #7 RELOCATION FACILITIES, STA. 6+0 - 22+0 (2 SHEETS)
- I-93, NB X-SECTIONS, STA. 352+0 - 355+50 (2 SHEETS)
- I-93, SB X-SECTIONS, STA. 352+0 - 359+50 (2 SHEETS)
- TH #7 RELOCATION X-SECTIONS, STA. 16+0 - 21+0 (4 SHEETS)

PROJECT LOCATION
SCALE: 1" = 1 MILE

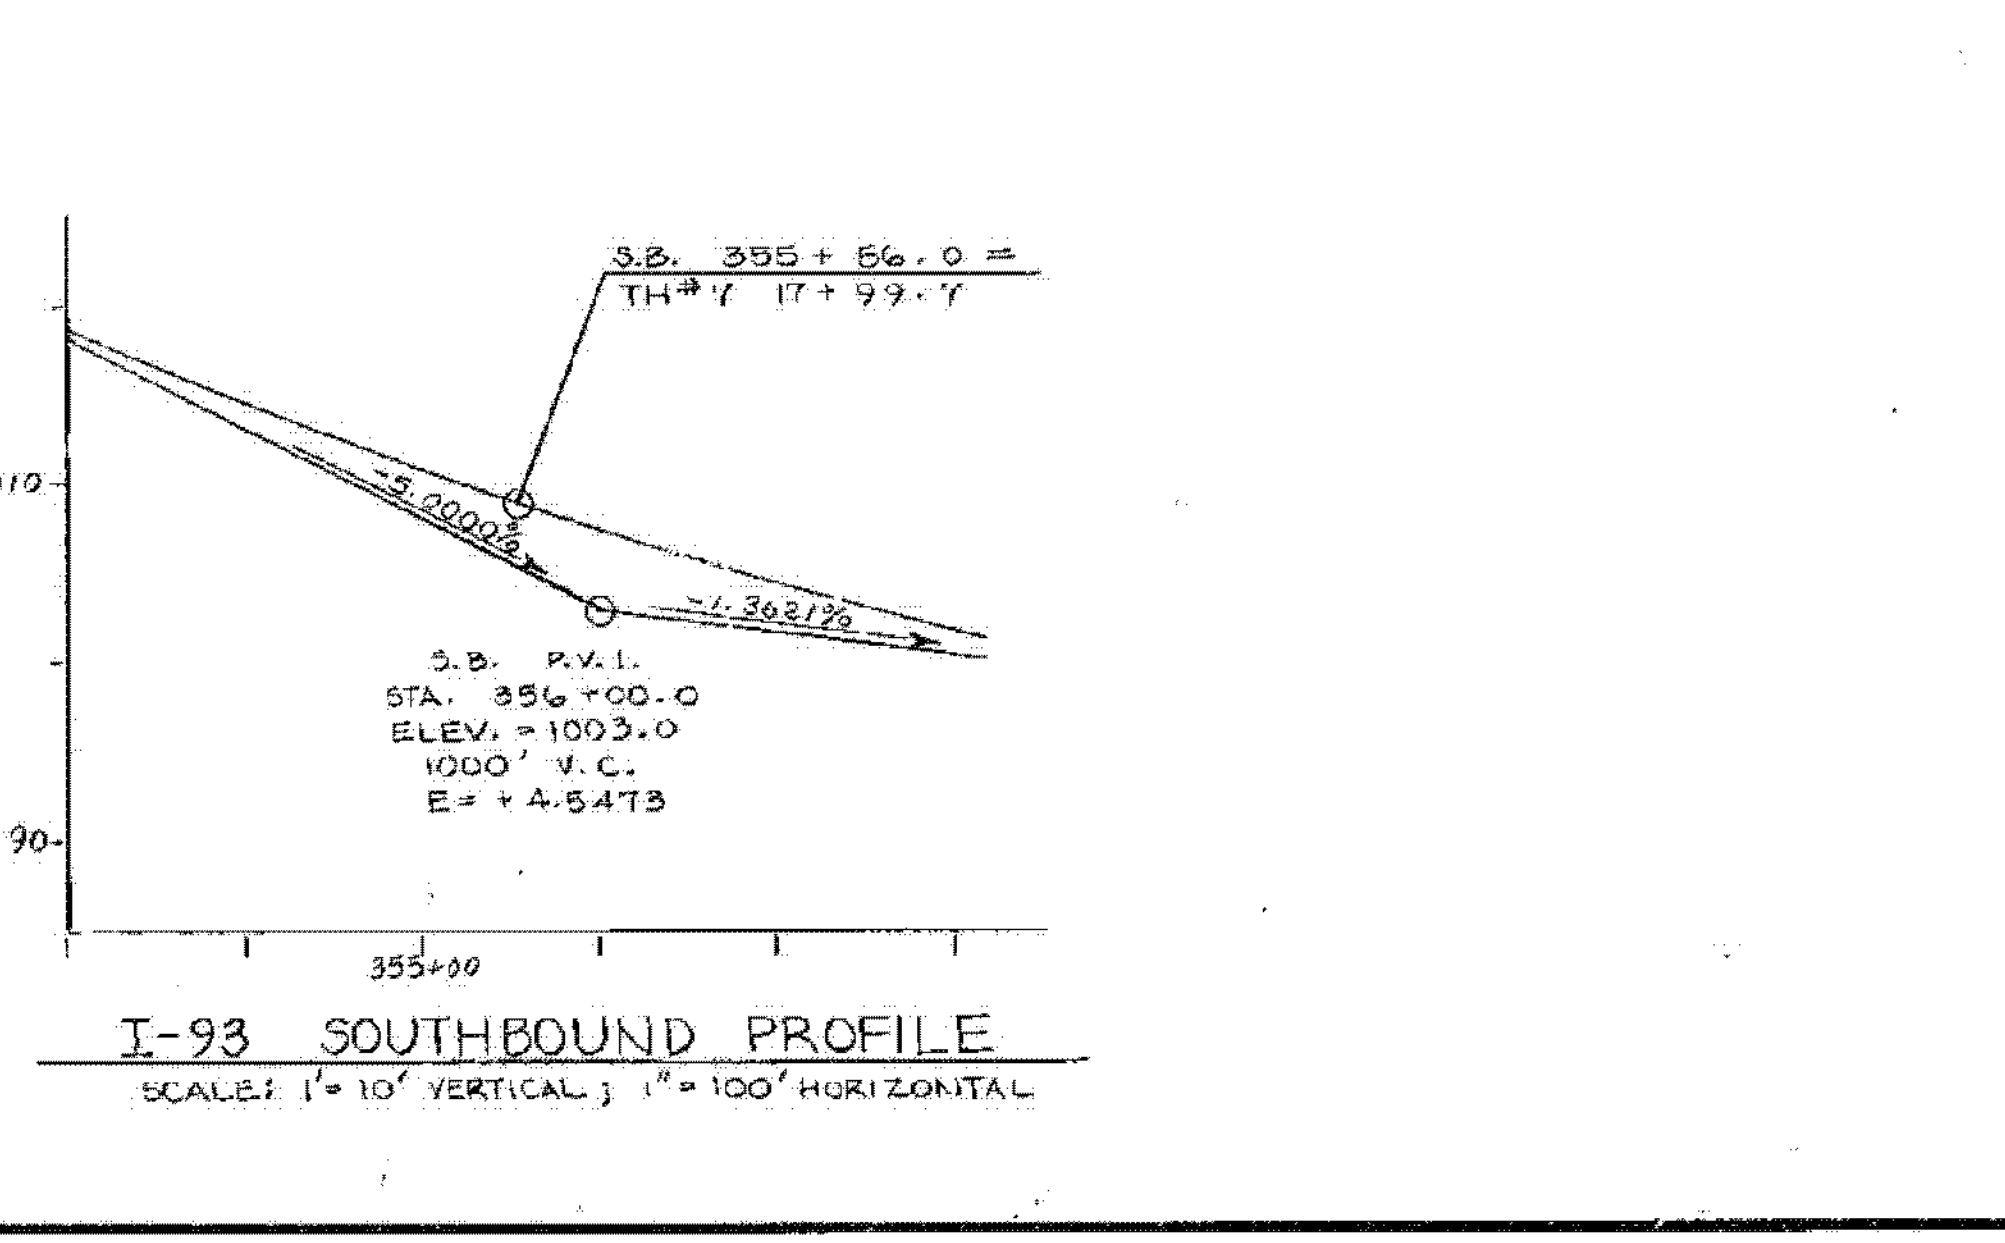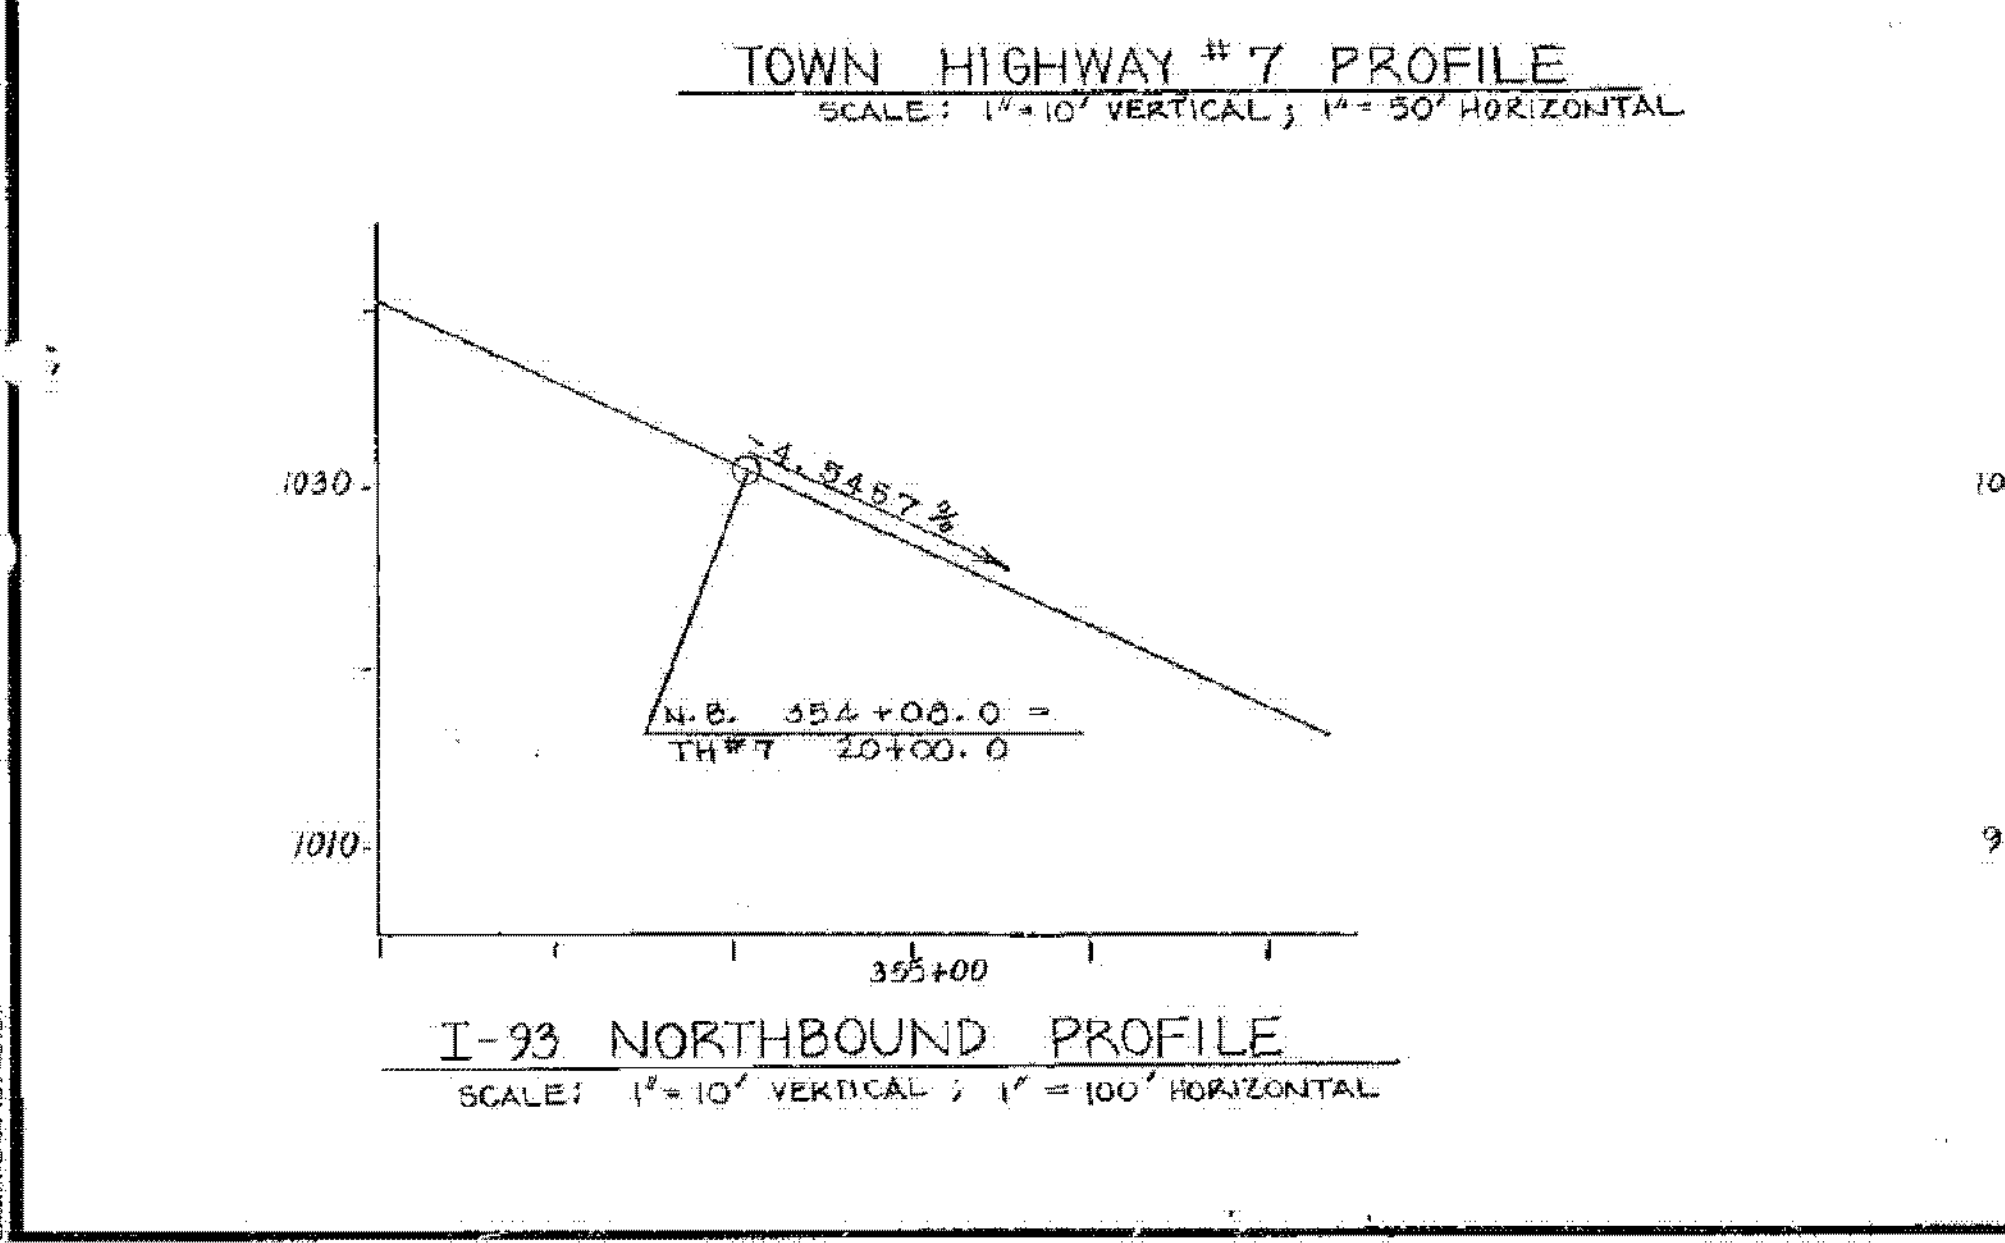

EXISTING STRUCTURE

- STRUCTURE TYPE: _____ OVERALL LENGTH: _____ INVENTORY RATING: _____
- SPAN LENGTH(S) CENTER TO CENTER OF BEARINGS: _____
- CLEAR SPAN LENGTH(S) NORMAL TO STREAM: _____ VERTICAL CLEARANCE ABOVE STREAMBED: _____
- WATERWAY AREA OF FULL OPENING (NORMAL TO STREAM): _____ WATER SURFACE ELEVATION @ Q: _____
- WATER SURFACE ELEVATION @ Q 2.33: _____ ESTIMATED DISCHARGE: _____
- WATER SURFACE ELEVATION AT FLOOD OF RECORD: _____ YEAR: _____
- DOES ALL WATER PASS THROUGH EXISTING STRUCTURE? IF NOT, AT WHAT FREQUENCY AND ELEVATION DOES RELIEF OCCUR? _____
- ADDITIONAL WATERWAY AREA PROVIDED BY RELIEF: _____
- TYPE OF SUBSIDIARY FOUNDATION MATERIAL: _____
- DISPOSITION OF STRUCTURE: _____

NEW STRUCTURE

STRUCTURE GEOMETRY:

- STRUCTURE TYPE: PLATE GIRDER BRIDGE OVERALL LENGTH: N.B. = 199.16' S.B. = 100.96'
- SPAN LENGTH(S) CENTER TO CENTER OF BEARINGS: 104'
- VERTICAL CLEARANCE ABOVE EXISTING ROAD UNDER: N.B. = 15'-6" MIN. S.B. = 15'-3" MIN.
- CLEAR SPAN LENGTH(S) NORMAL TO STREAM: N/A
- WATERWAY AREA OF FULL OPENING (NORMAL TO STREAM): N/A
- ARE PROVISIONS TO BE MADE FOR PUBLIC UTILITIES? NO

HYDRAULIC DATA:

- Q 2.33: WATER ELEVATION: _____ VELOCITY: _____
- Q 10: WATER ELEVATION: _____ VELOCITY: _____
- Q 25: WATER ELEVATION: _____ VELOCITY: _____
- Q 50: WATER ELEVATION: _____ VELOCITY: _____
- Q 100: WATER ELEVATION: _____ VELOCITY: _____

- DRAINAGE AREA: _____ CHARACTER OF TERRAIN: _____
- ARE THERE OBJECTIONS TO A PIER IN THE STREAM? _____ IS ORDINARY RISE RAPID? _____
- DOES STREAM REACH ITS MAXIMUM HIGH WATER ELEVATION RAPIDLY? _____
- NATURE OF NATURAL STREAMBED: _____
- ESTIMATED SCOUR DEPTH: _____ COMMENT ON: DRIFT: _____ ICE: _____
- WILL ALL WATER PASS THROUGH NEW STRUCTURE? IF NOT, WHAT FREQUENCY AND ELEVATION WILL RELIEF OCCUR? _____
- ADDITIONAL WATERWAY AREA PROVIDED BY RELIEF: _____
- VERTICAL CLEARANCE ABOVE Q: _____
- ALLOWABLE WATER SURFACE ELEVATION: _____ LIMITED BY: _____
- IS DESIGN STAGE AFFECTED BY UPSTREAM OR DOWNSTREAM CONDITIONS? IF YES, DESCRIBE: _____
- AVERAGE DAILY LOW FLOW: _____ DEPTH: _____
- AVERAGE DAILY HIGH FLOW: _____ DEPTH: _____
- STREAMBANK OR CHANNEL PROTECTION REQUIRED: _____
- DISTANCE TO EXISTING UPSTREAM STRUCTURE: _____ SPAN: _____ WATERWAY AREA OF FULL OPENING: _____
- DISTANCE TO EXISTING DOWNSTREAM STRUCTURE: _____ SPAN: _____ WATERWAY AREA OF FULL OPENING: _____

ALLOWABLE STRESSES:

- DESIGN LIVE LOAD: H525-44
- ALLOWABLE LOAD FOR SPREAD FOOTINGS ON SOIL: 4.0 KSF ON LEDGE: 10.0 KSF
- ALLOWABLE LOAD FOR PILING: _____ TYPE: _____ ESTIMATED LENGTH: _____
- ALLOWABLE STRESS FOR STRUCTURAL STEEL ASTM A 588: TENSION: 27,000 psi
- ALLOWABLE STRESS FOR REINFORCING STEEL GRADE 60: TENSION: 24,000 psi COMPRESSION: 20,000 psi
- ALLOWABLE STRESS FOR CONCRETE CLASS A: 3,500 psi CLASS B: 3,500 psi

TRAFFIC MAINTENANCE:

- IS TRAFFIC TO BE MAINTAINED? N/A IF YES, ON EXISTING STRUCTURE: N/A OR ON TEMPORARY BRIDGE: N/A
- TEMPORARY BRIDGE REQUIREMENTS: ONE OR TWO WAY: _____ TRAFFIC CONTROL SIGNALS REQUIRED: _____
- MINIMUM CLEAR SPAN: _____ MINIMUM CLEAR HEIGHT: _____ MINIMUM WATERWAY AREA: _____
- ARE SIDEWALKS REQUIRED? _____ IF SO, ON WHAT SIDE? _____

ADDITIONAL DESIGN CONSIDERATIONS

LOAD RATING (TONS)

STRESS LEVELS	TRUCK						
	H	H8	3S2	6 A4E	3A STR.	4A STR.	5A SEAM
INVENTORY 0.95 P ₂ = 27.0	49	44					
POSTED 0.67 P ₂ = 33.5		69	88	112	73	82	
OPERATING 0.75 P ₂ = 37.5			107	125			

RECOMMENDED FOR APPROVAL: W. M. Smith 1-30-80, STRUCTURES ENGINEER, DATE

RECOMMENDED FOR APPROVAL: Arthur J. Hill 1-30-80, CHIEF OF DESIGN, DATE

APPROVED BY: S. J. Clague 1-30-80, DIRECTOR OF ENGINEERING & CONSTRUCTION, DATE

REVISIONS:

NO.	DESCRIPTION	BY & DATE

STATE OF VERMONT AGENCY OF TRANSPORTATION

TOWN OF: WATERFORD Bridge No. 67

HIGHWAY NO.: I-93 Log Sta. 354+83

I-93 N.B. & S.B. OVER TH #7

PRELIMINARY INFORMATION SHEET




Designed by: G. S. ROGERS Drawn by: G. L. DAVIS

Checked by: R. W. JENSEN Bridge Design Supervisor, date 1/15/80

F. W. Bolkum date 1/80


PROJECT: WATERFORD PROJECT NO.: I-93-1(3) CONTR. 2

Bridge Sheet No. BR 700 Sheet 151 of 531

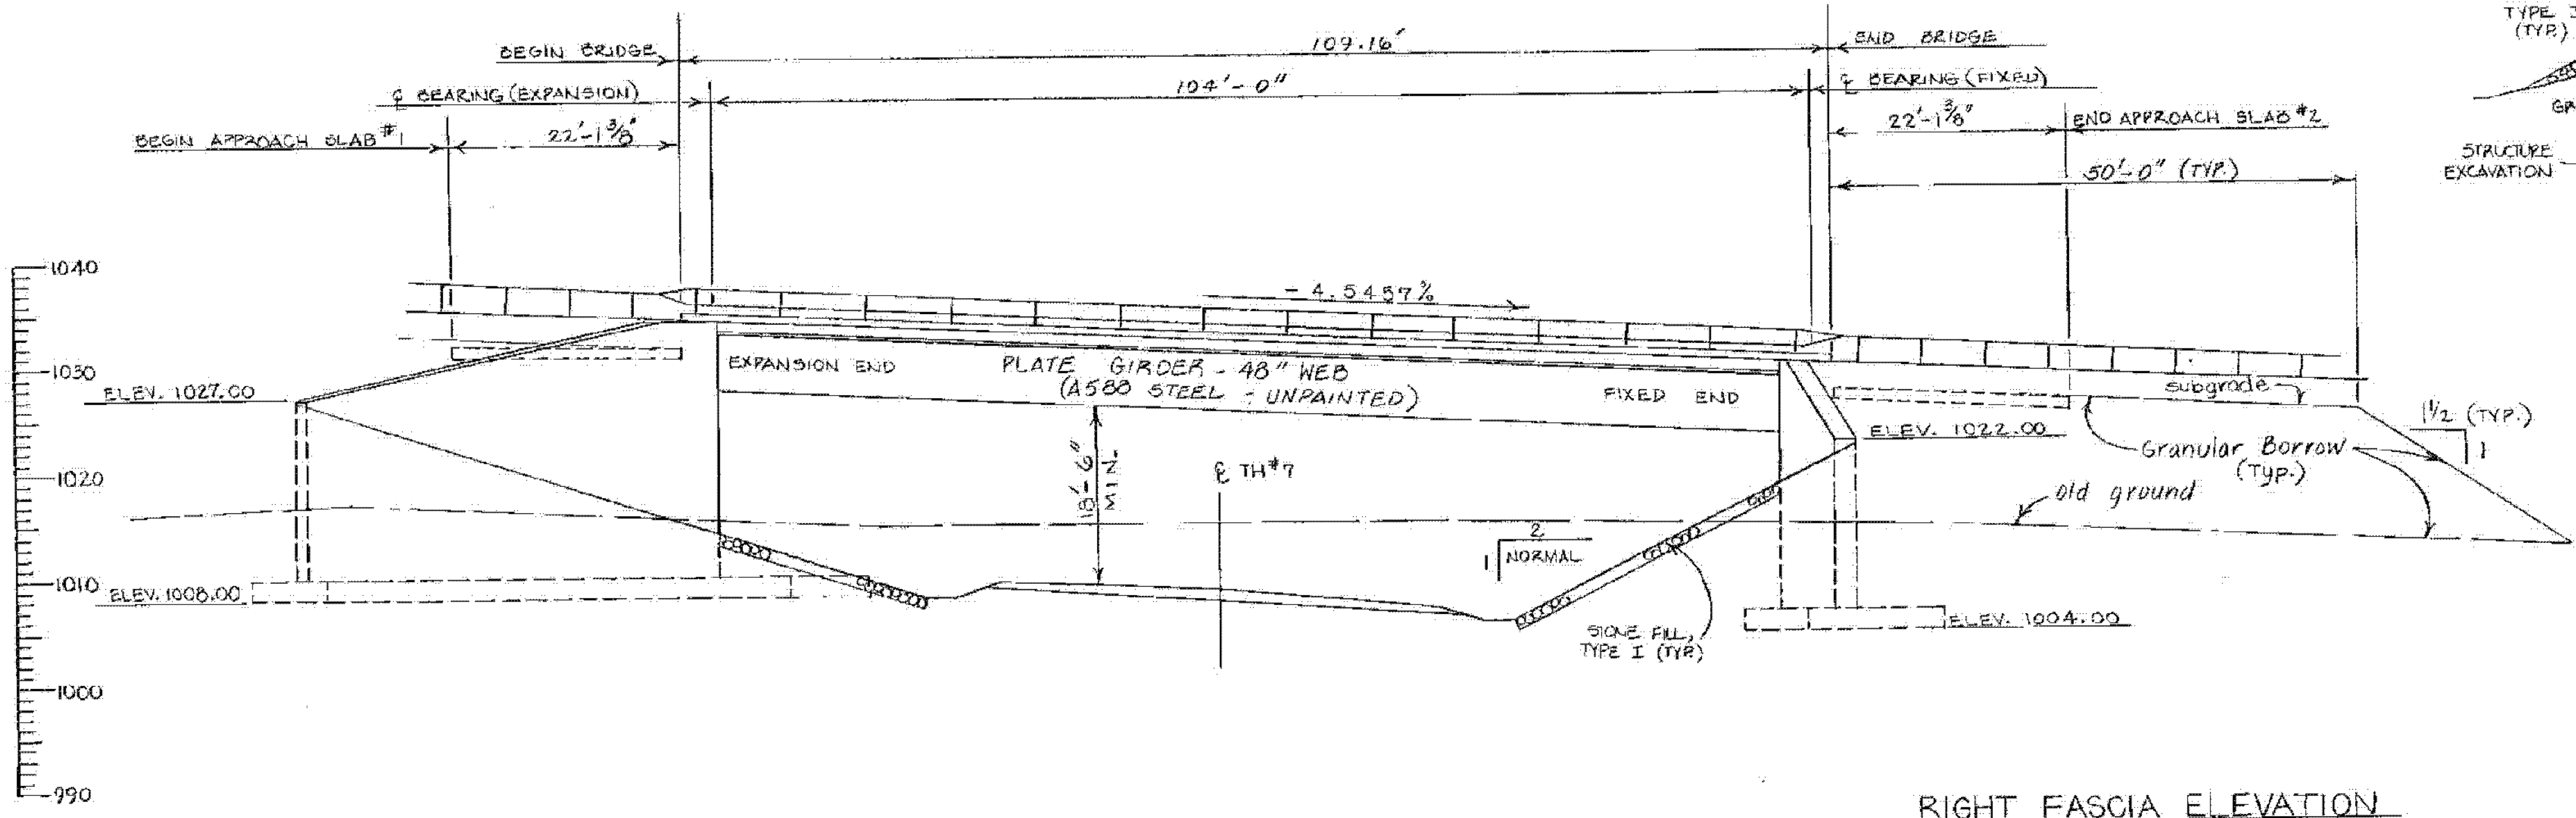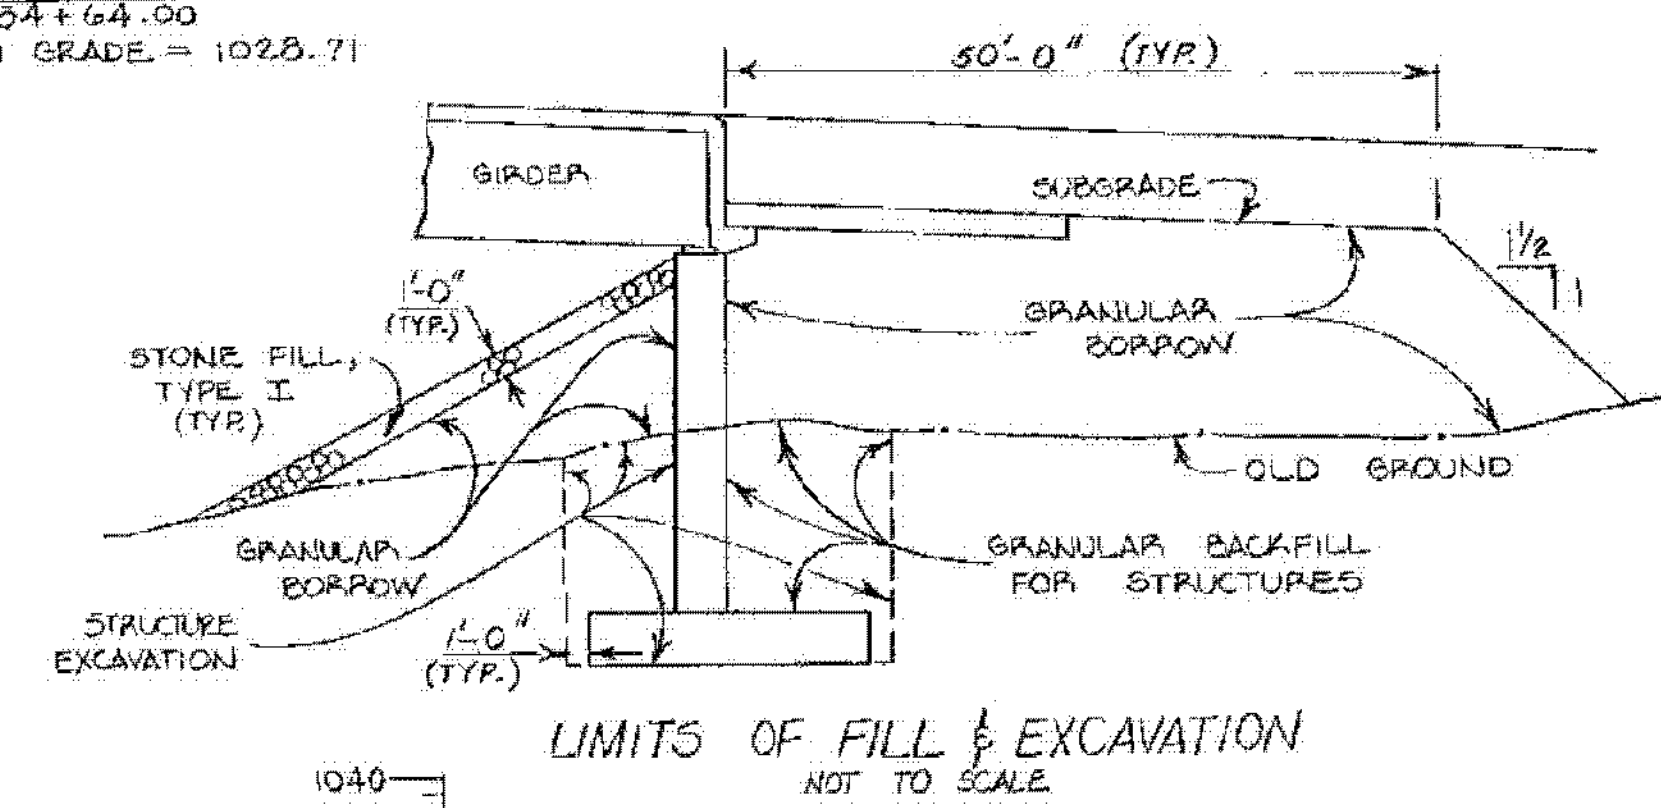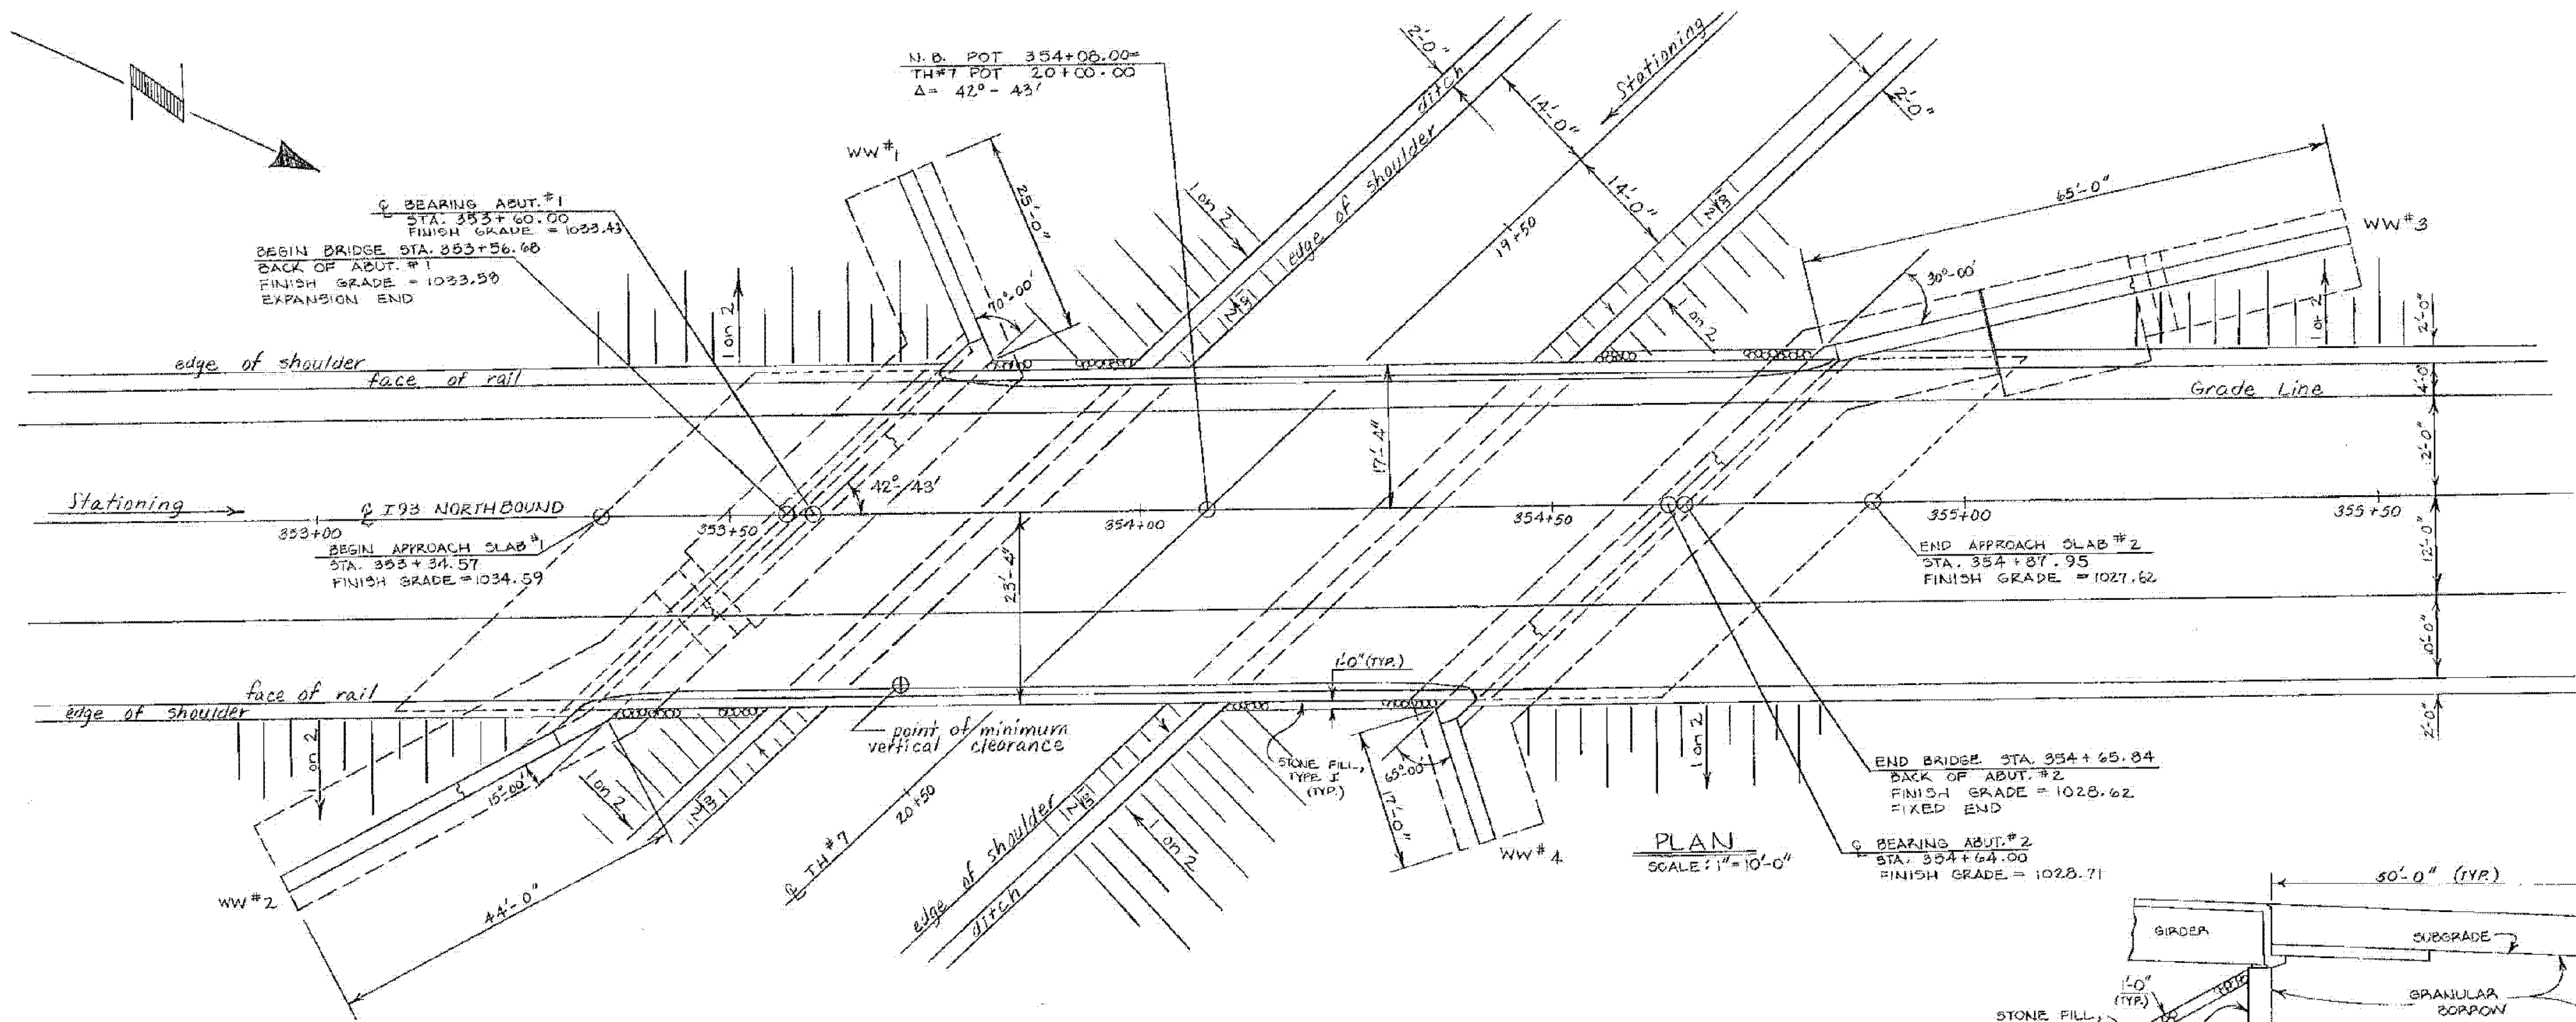


I-93 BRIDGES S&S
 WATERFORD
 IM MEMB(31)
 SHEET 35 OF 48
 FOR REFERENCE ONLY

STATE OF VERMONT	
AGENCY OF TRANSPORTATION	
TOWN OF WATERFORD	Bridge No. 87
HIGHWAY NO. I 93	Log Sta.
I 93 NORTHBOUND OVER TH#7	
PLAN & ELEVATION SHEET	
Designed by G. S. ROGERS	Drawn by G. L. DAVIS
Checked by R. W. JENSEN	Bridge Design Supervisor
date 1/22/80	F.Y. Bolkin date 1/80
PROJECT WATERFORD	PROJECT NO. I93-(3)CONTR.#2
Bridge Sheet No. 02,702	Sheet 153 of 531



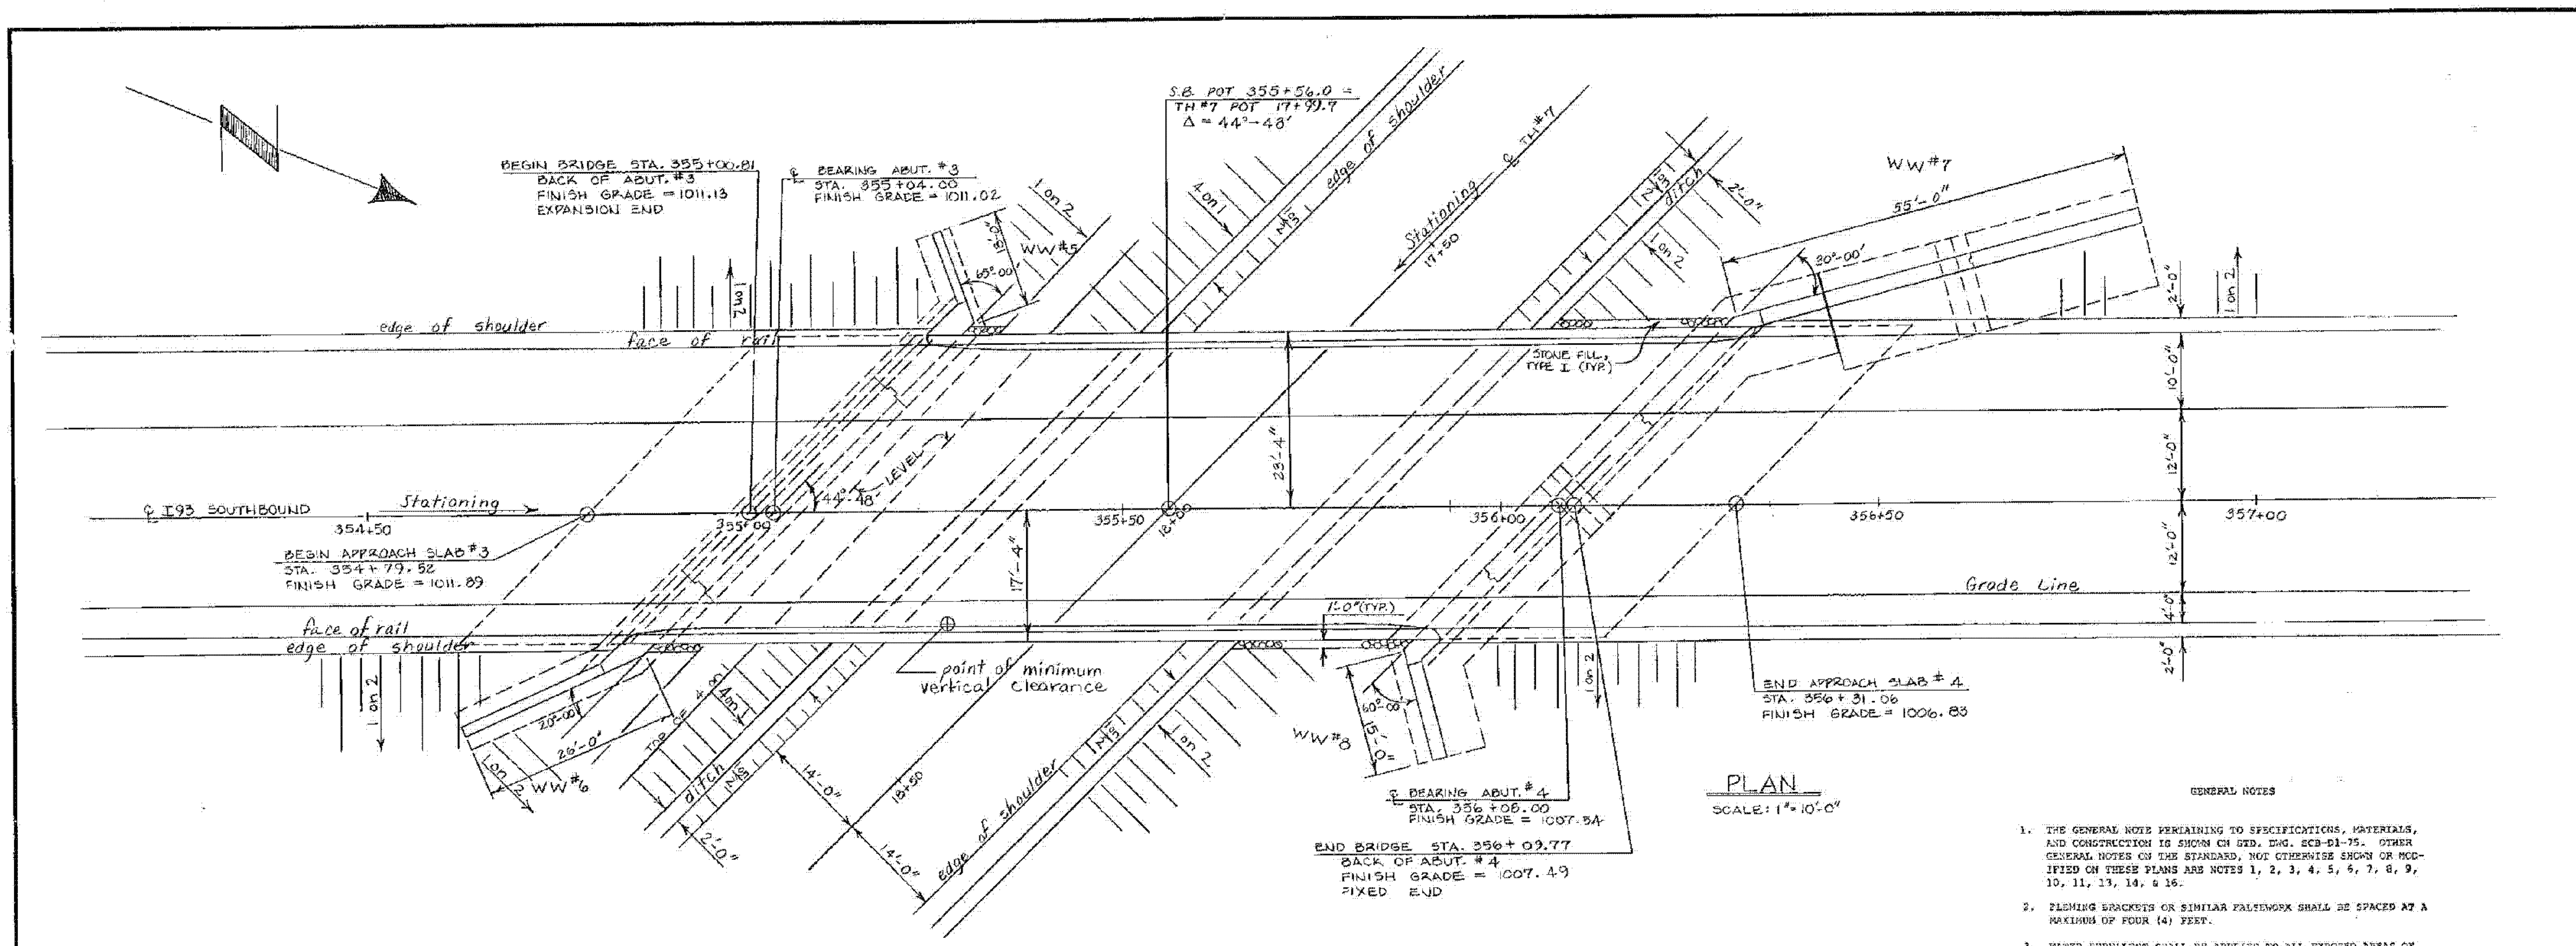


- GENERAL NOTES
1. THE GENERAL NOTE PERTAINING TO SPECIFICATIONS, MATERIALS, AND CONSTRUCTION IS SHOWN ON SHEET 36 OF 48. OTHER GENERAL NOTES ON THE STANDARD, NOT OTHERWISE SHOWN OR MODIFIED ON THESE PLANS ARE NOTES 1, 2, 3, 4, 5, 6, 7, 8, 9, 10, 11, 13, 14, & 16.
 2. FLEMING BRACKETS OR SIMILAR FALSEWORK SHALL BE SPACED AT A MAXIMUM OF FOUR (4) FEET.
 3. WATER REPELLENT SHALL BE APPLIED TO ALL EXPOSED AREAS OF THE ABUTMENTS, RINGWALLS, CURBS, FASCIA, AND TO THE CURB SOFFIT BACK TO THE DRIP NOTCH.
 4. ALL WEEP PIPES SHALL NOT BE PLACED MORE THAN TEN (10) FEET APART OR WITHIN TWO (2) HORIZONTAL FEET OF ABUTMENT OR CROSS-FASCIA, AND ONLY BETWEEN THE ABUTMENTS AND EDGES OF THE SHOULDERS.

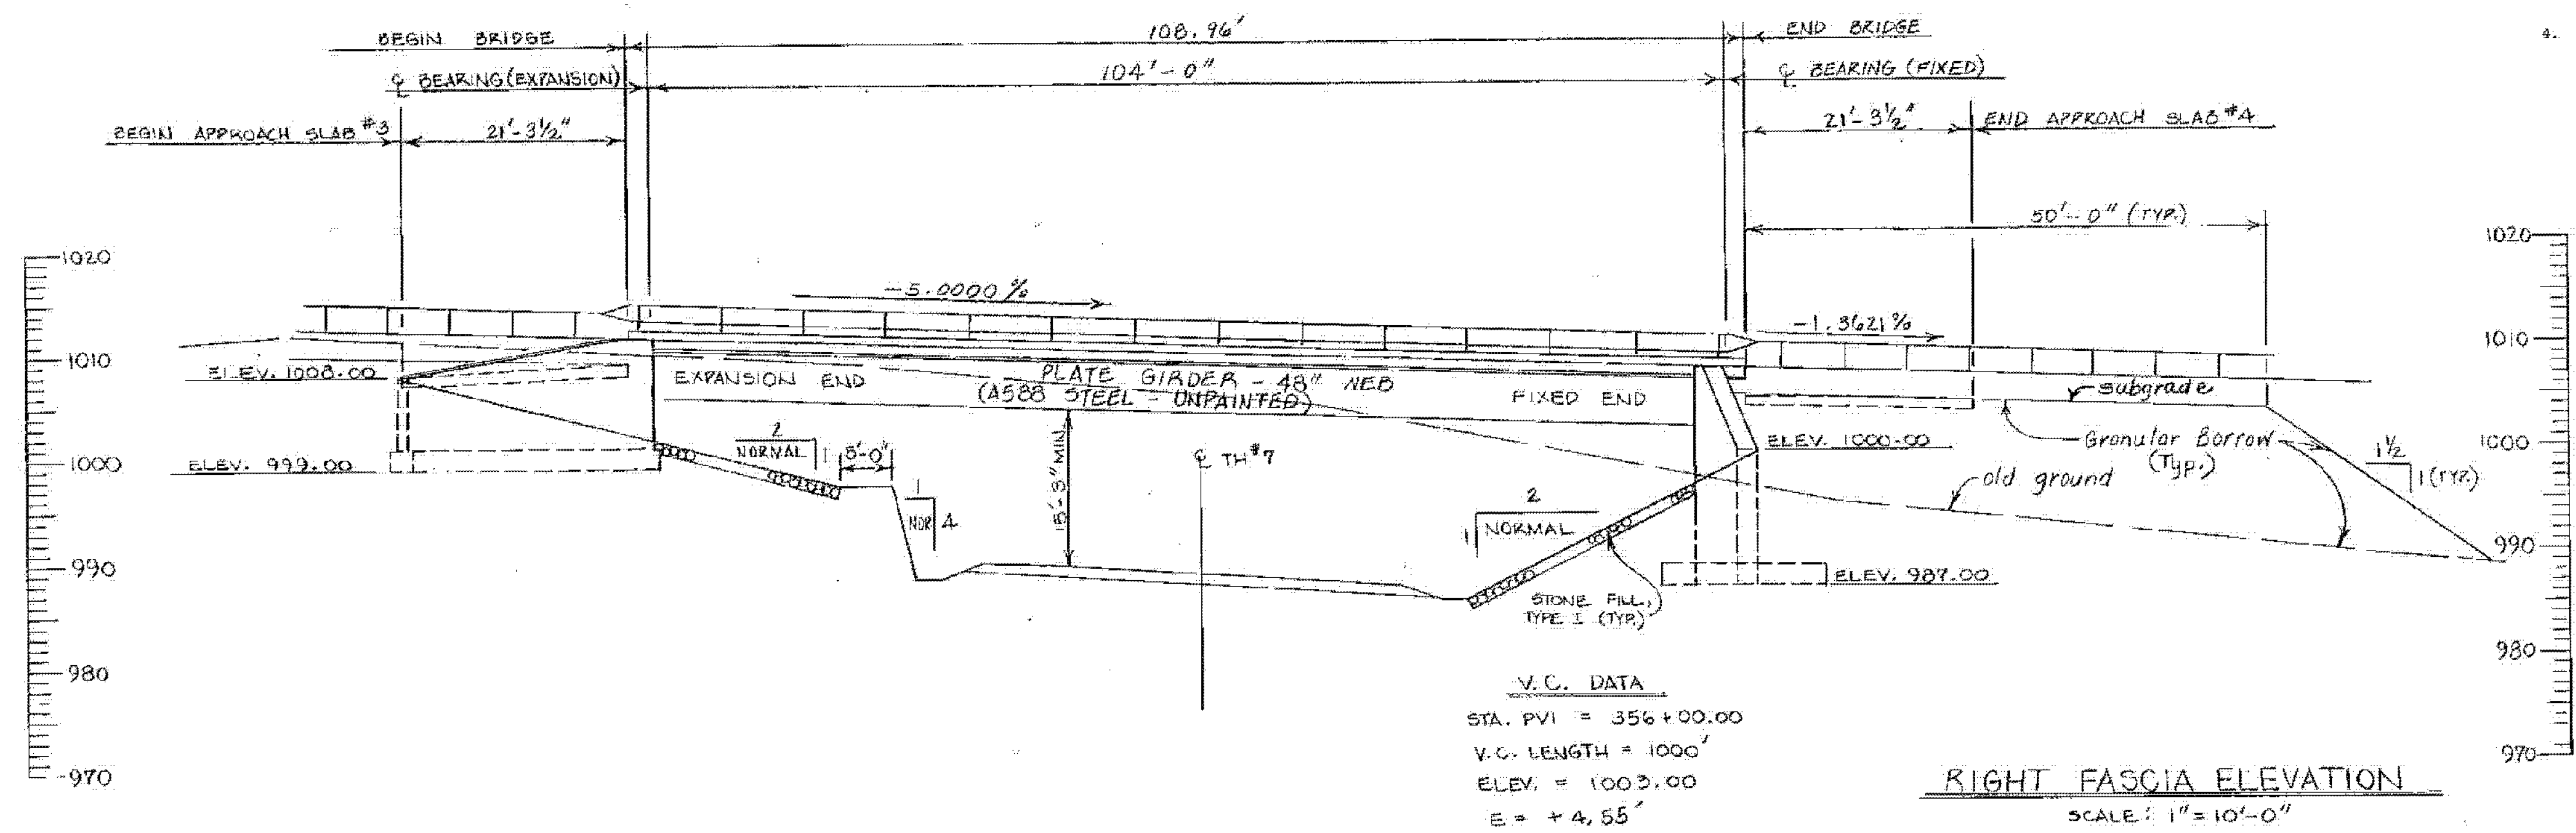







I-93 BRIDGES 5N&S	
WATERFORD IM MEMB(31) SHEET 36 OF 48 FOR REFERENCE ONLY	
STATE OF VERMONT AGENCY OF TRANSPORTATION	
TOWN OF WATERFORD	Bridge No. 87
HIGHWAY NO. I 93	Log Sta. Surv. Sta. 354+83
I-93 SOUTHBOUND OVER TH #7 PLAN & ELEVATION SHEET	
Designed by G. S. ROSEZ	Drawn by G. L. DAVIS
Checked by E. W. JENSEN date 1/22/80	Bridge Design Supervisor F. W. Balkum date 7/80
PROJECT WATERFORD	PROJECT NO. I93-1(3)CONTR.#2
Bridge Sheet No. BR703	Sheet 154 of 531

BR4

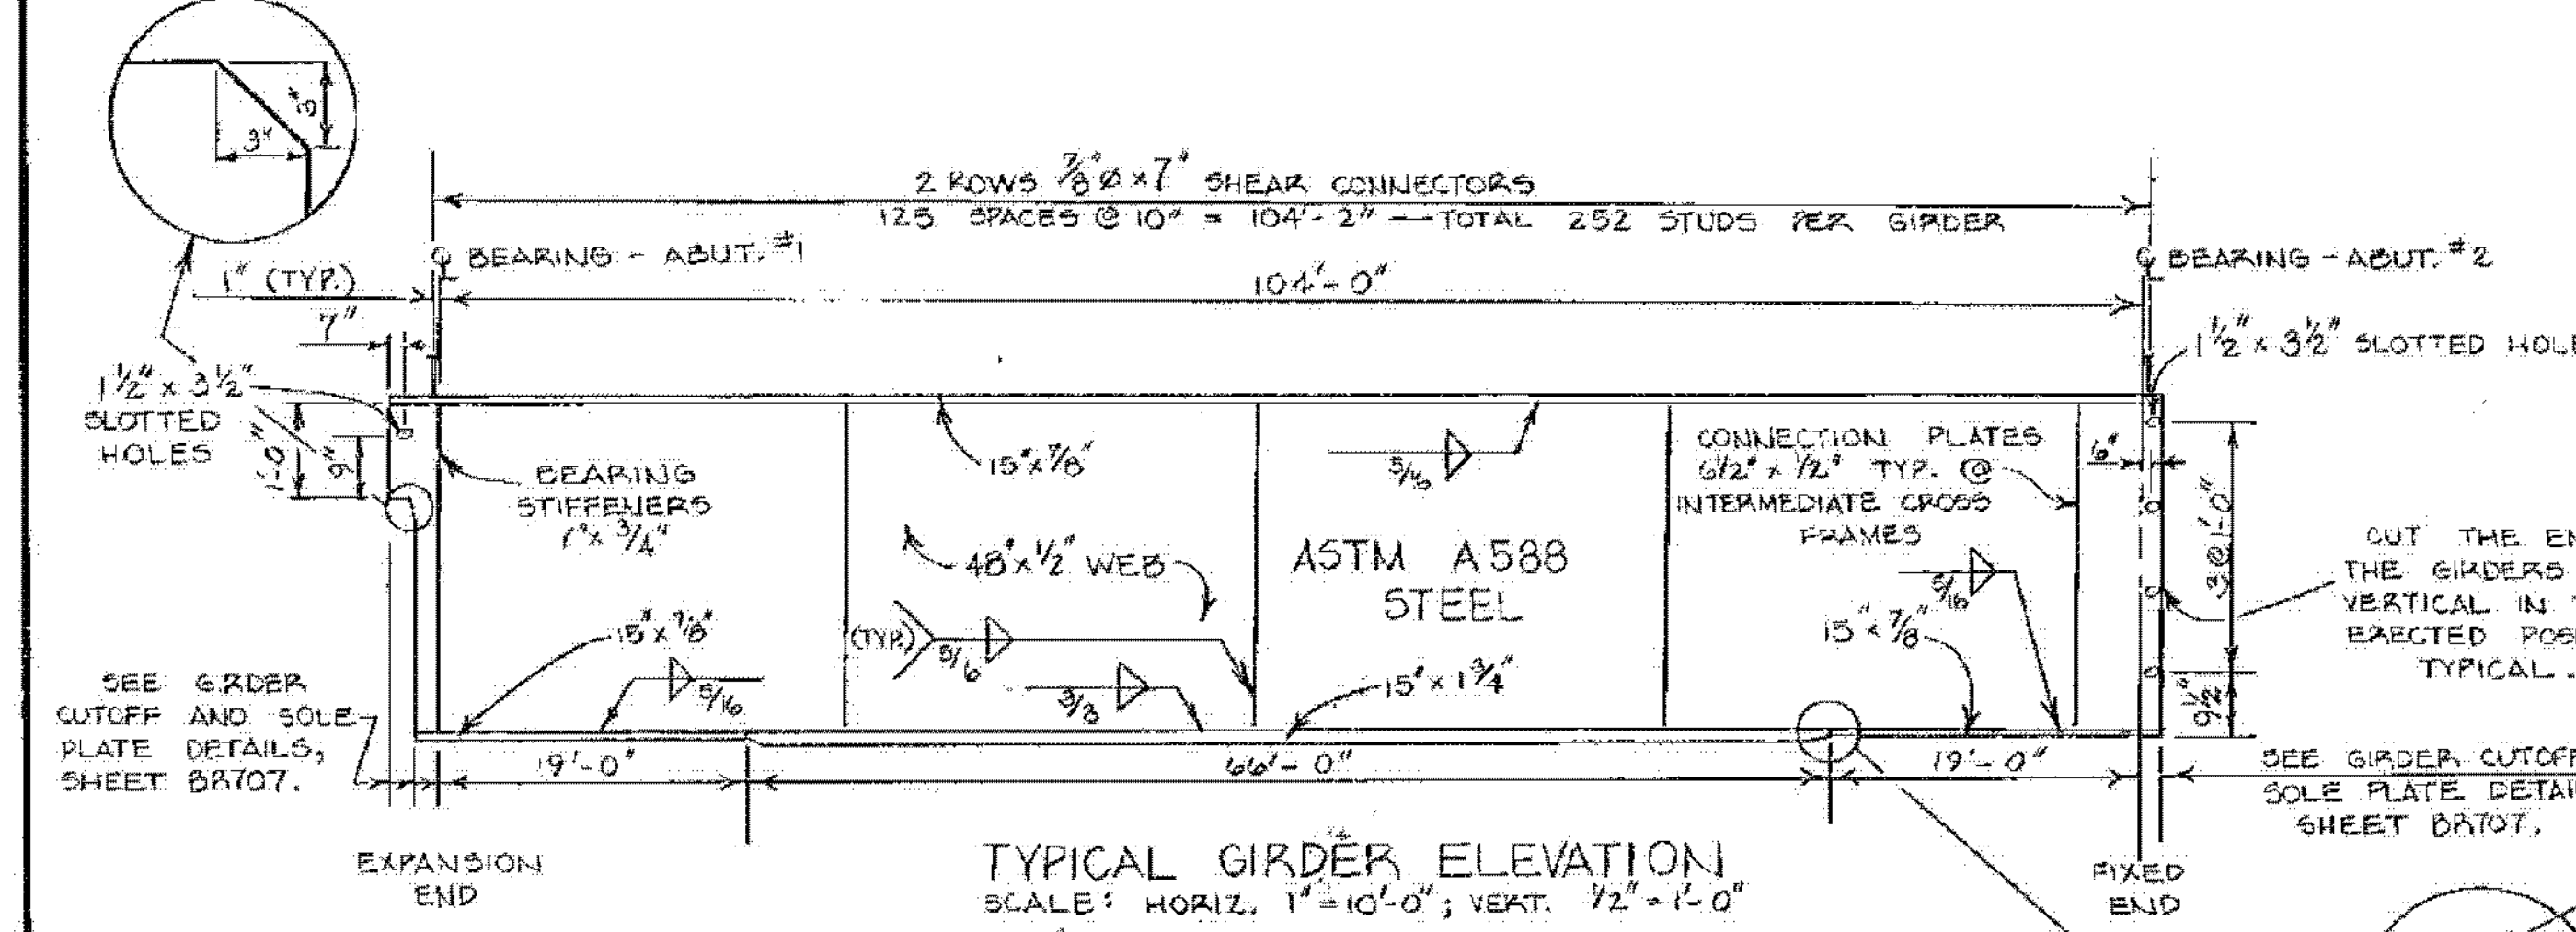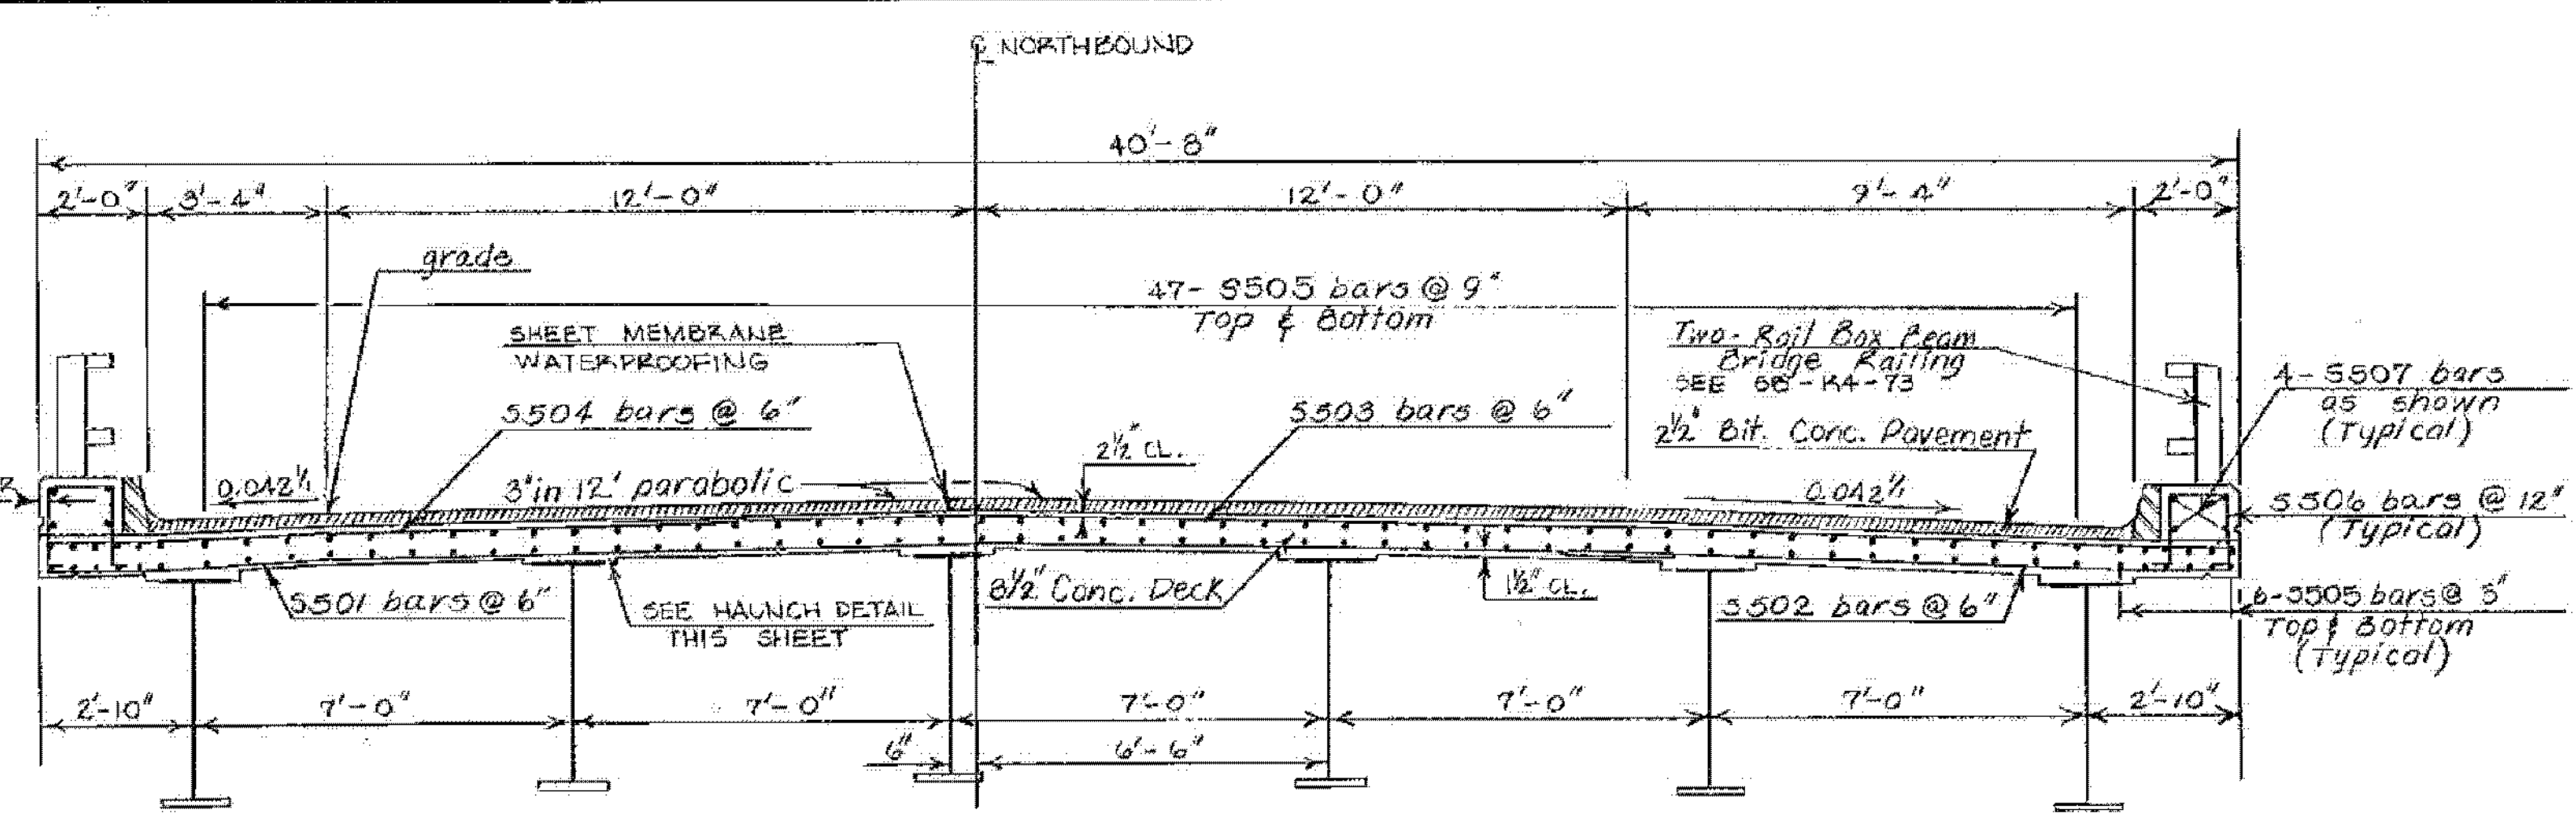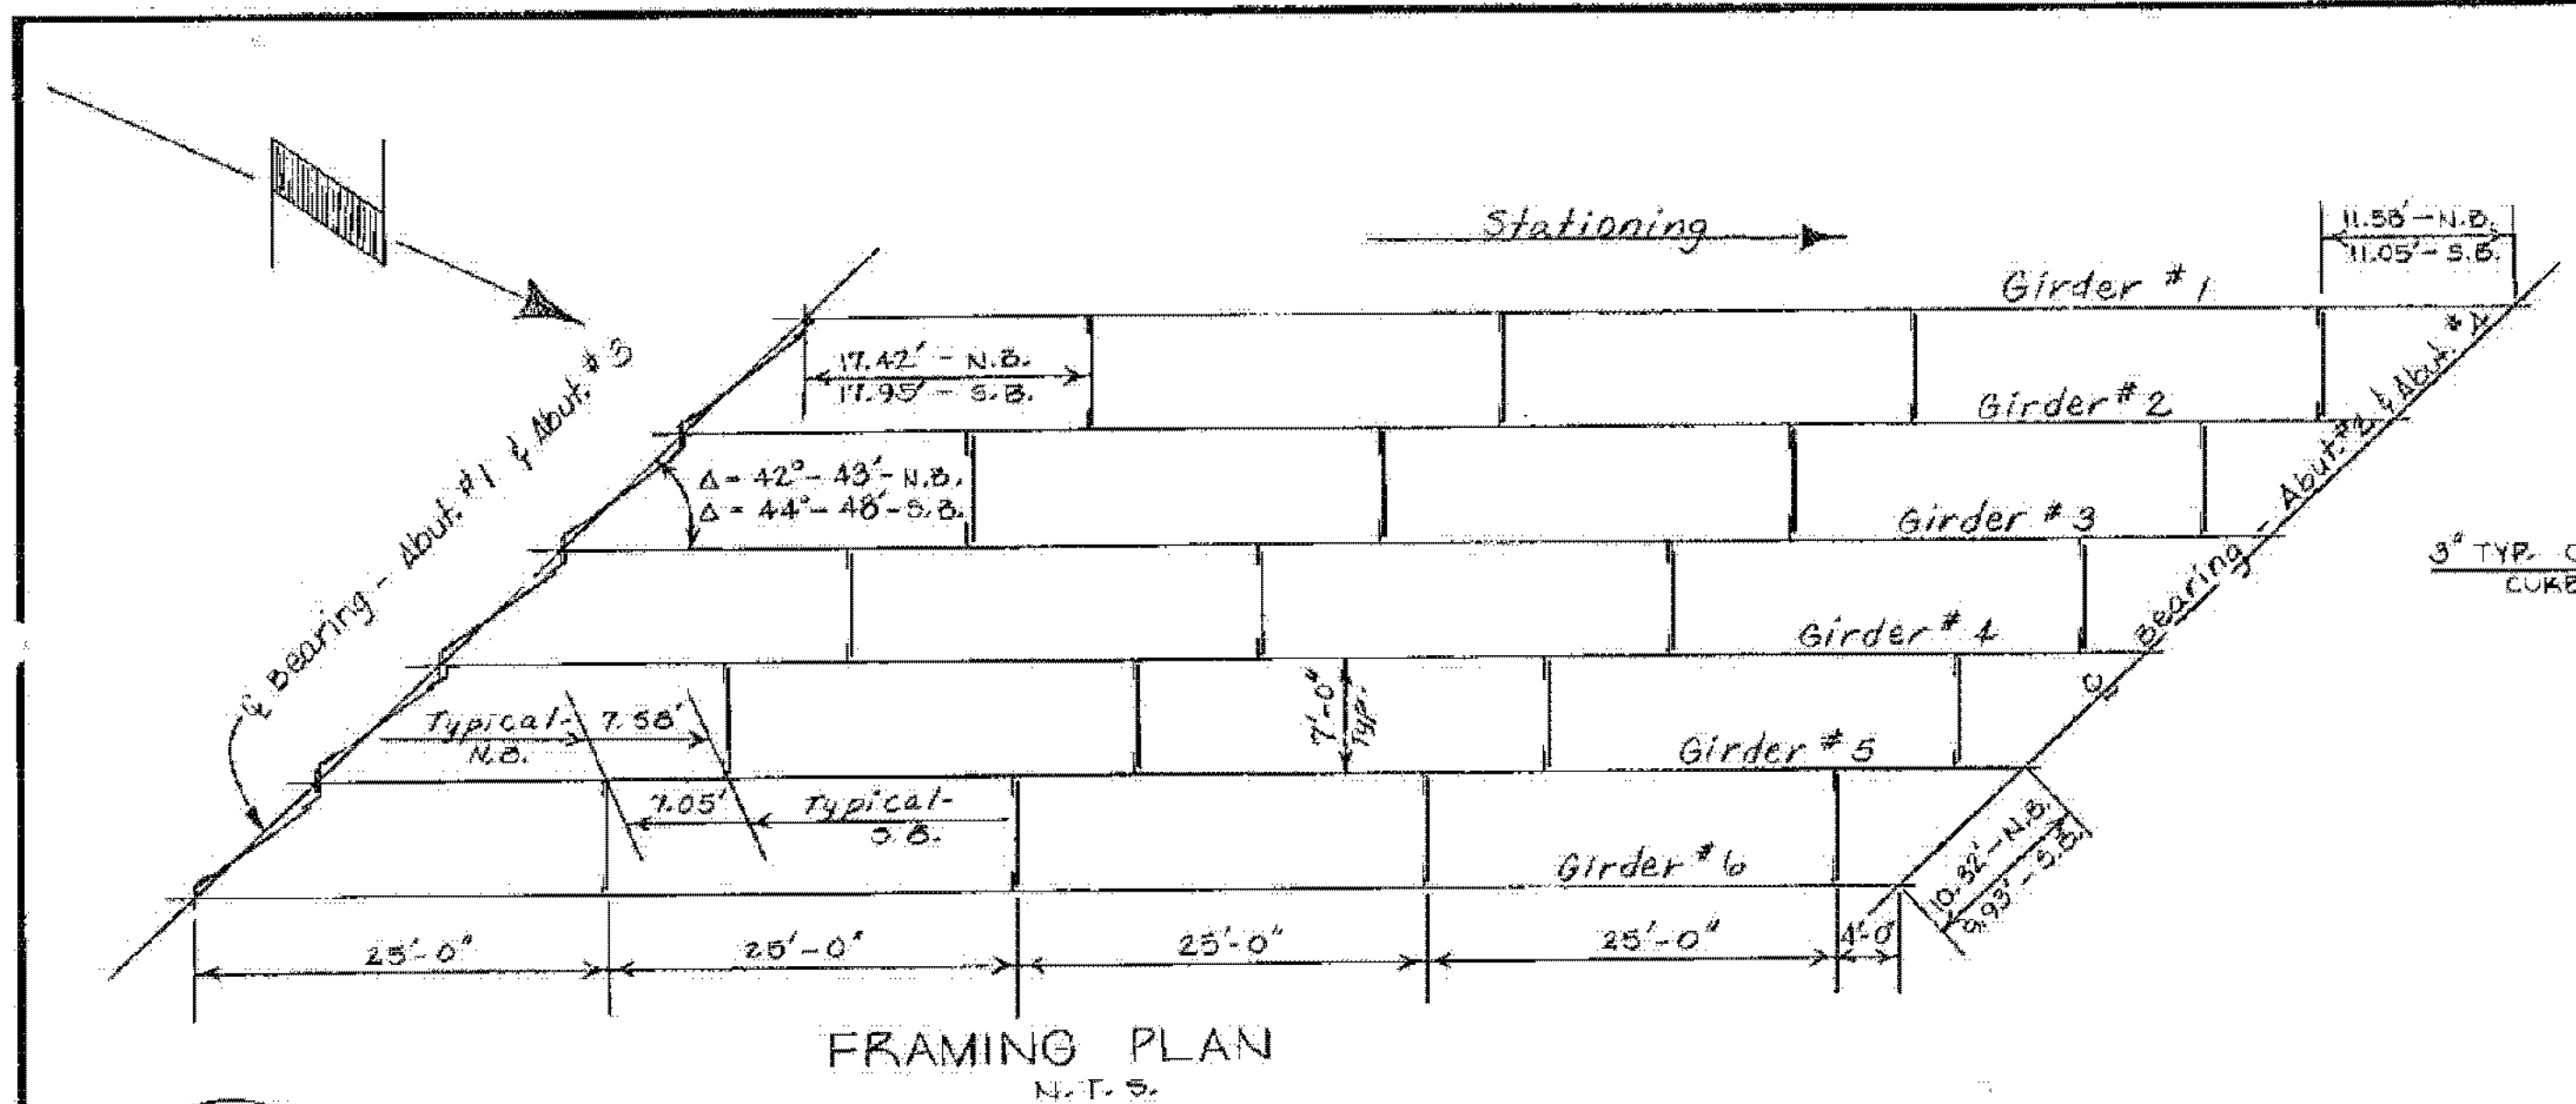

NOTE: SOUTHBOUND BRIDGE IS SIMILAR, BUT DIMENSIONS ARE REVERSED.

NOTE: FOR GRANITE CURB DETAILS, SEE STD. DWG. SCB-D6-73, AND DETAILS BELOW.

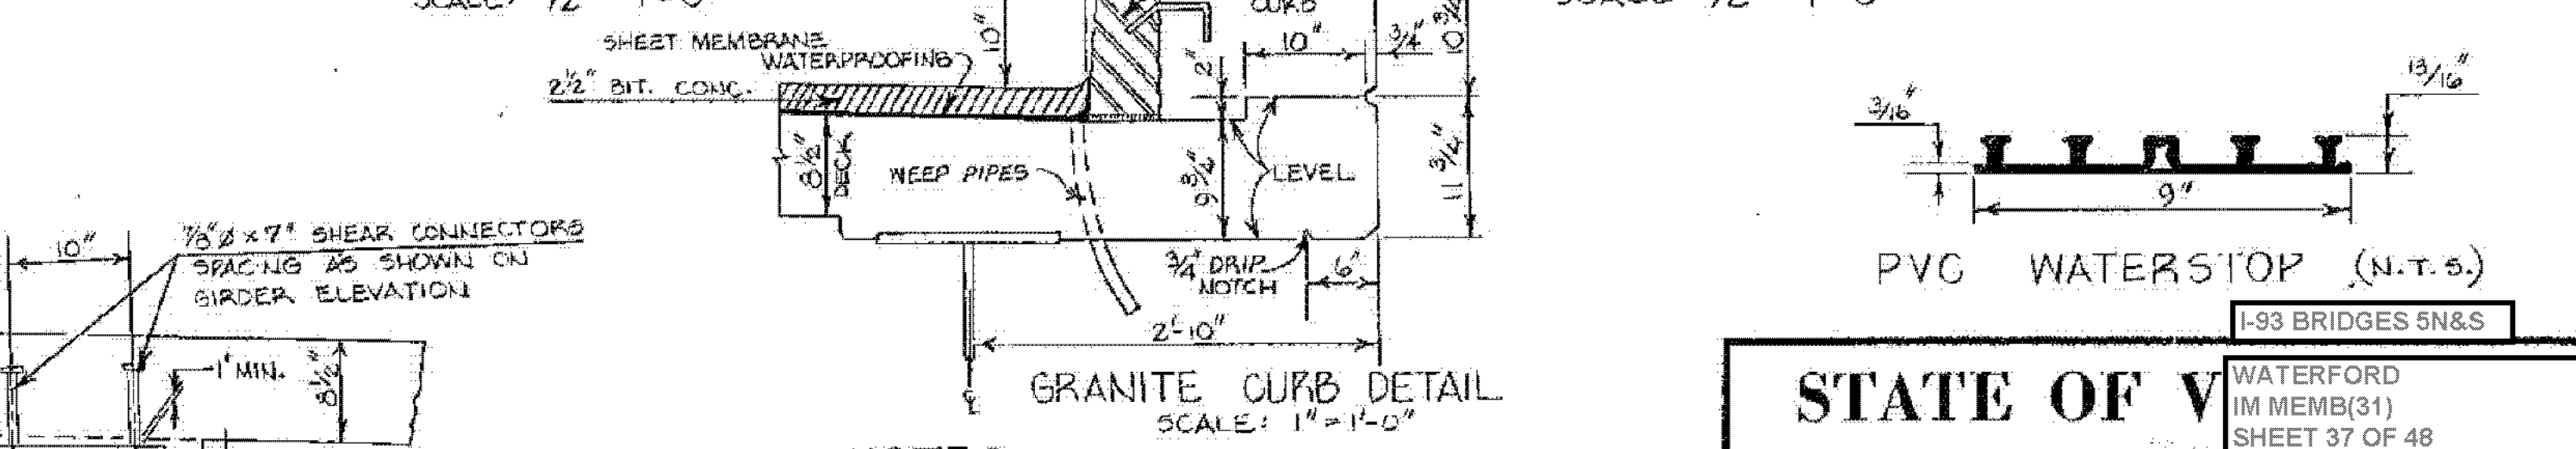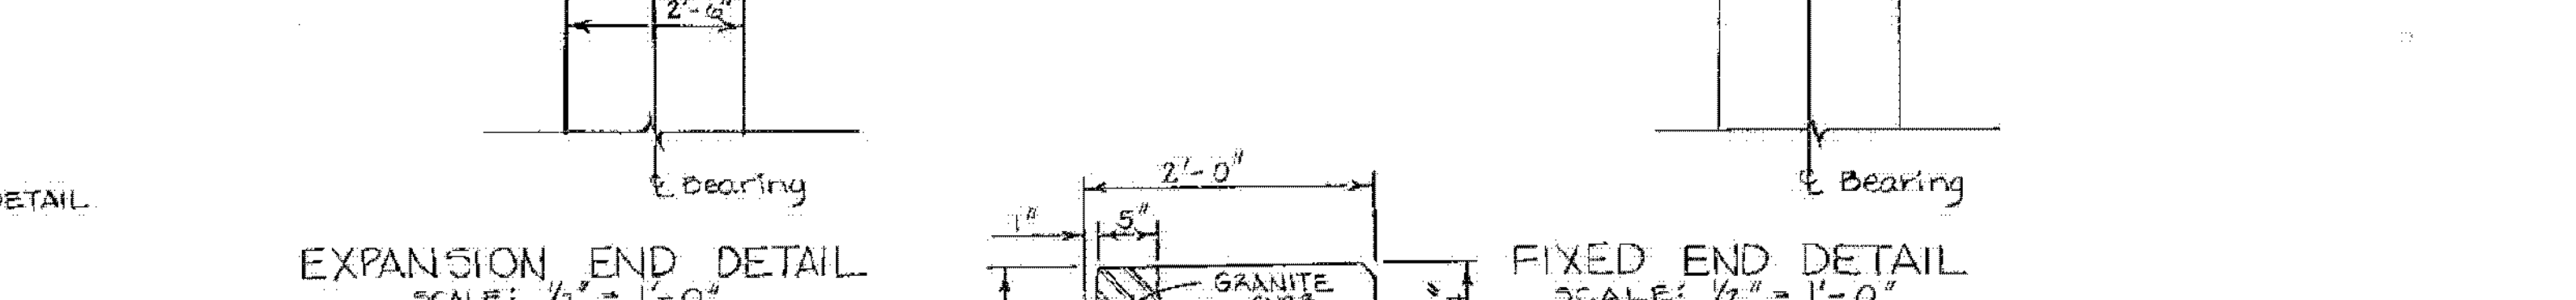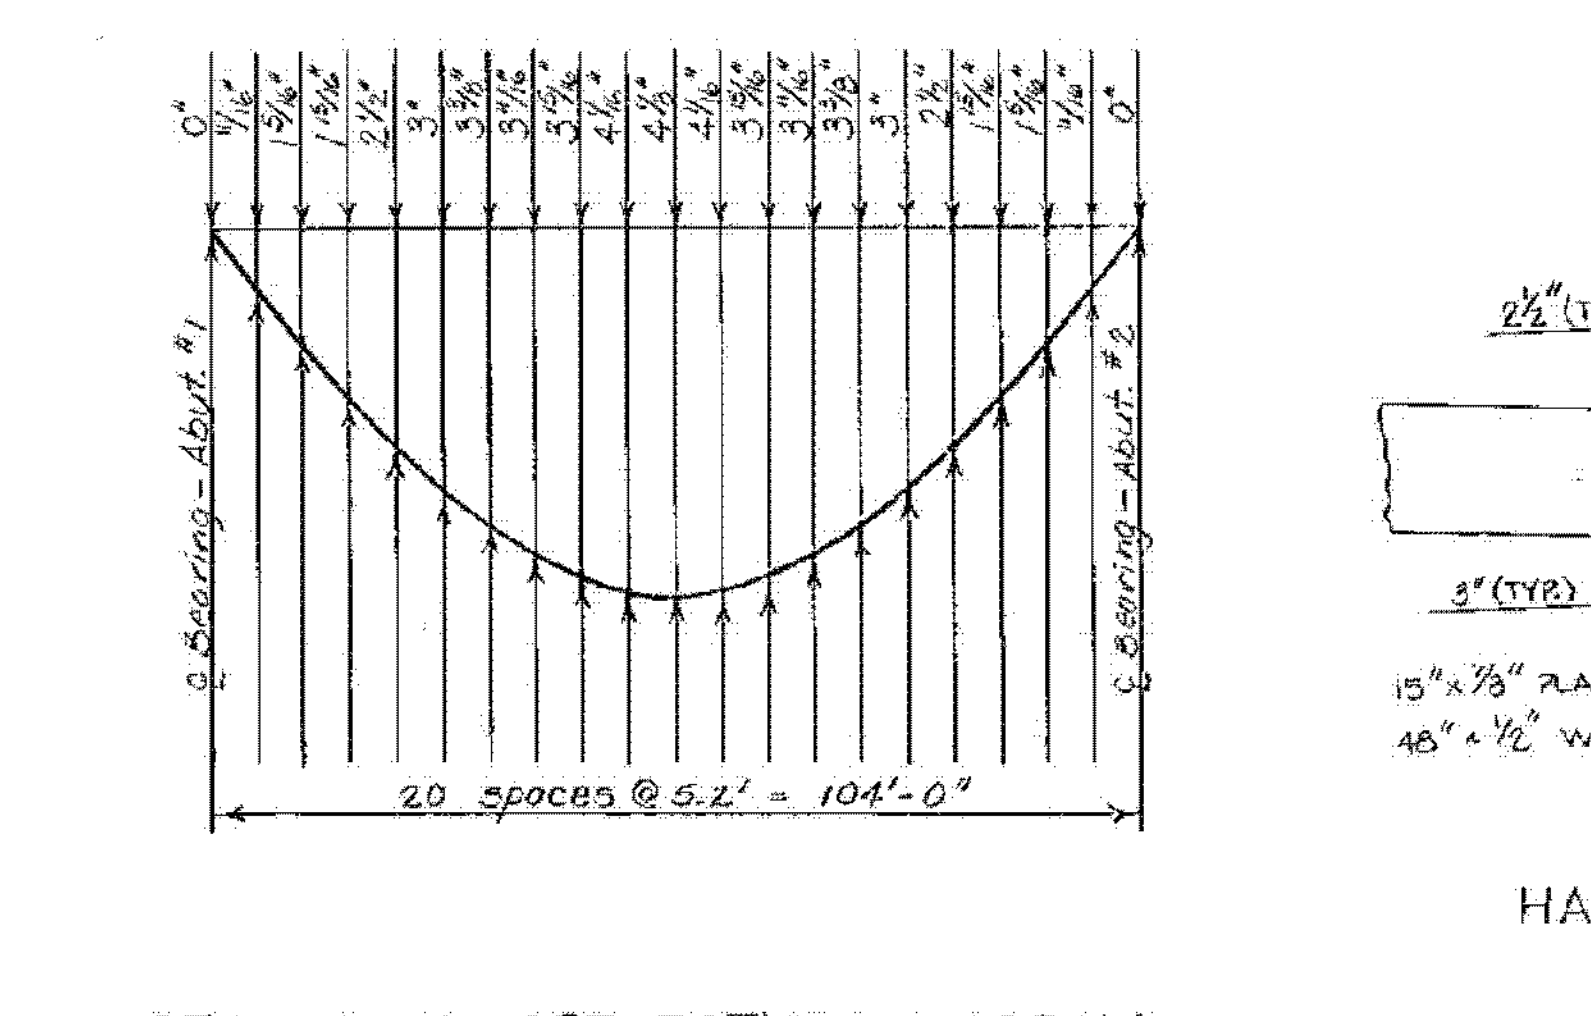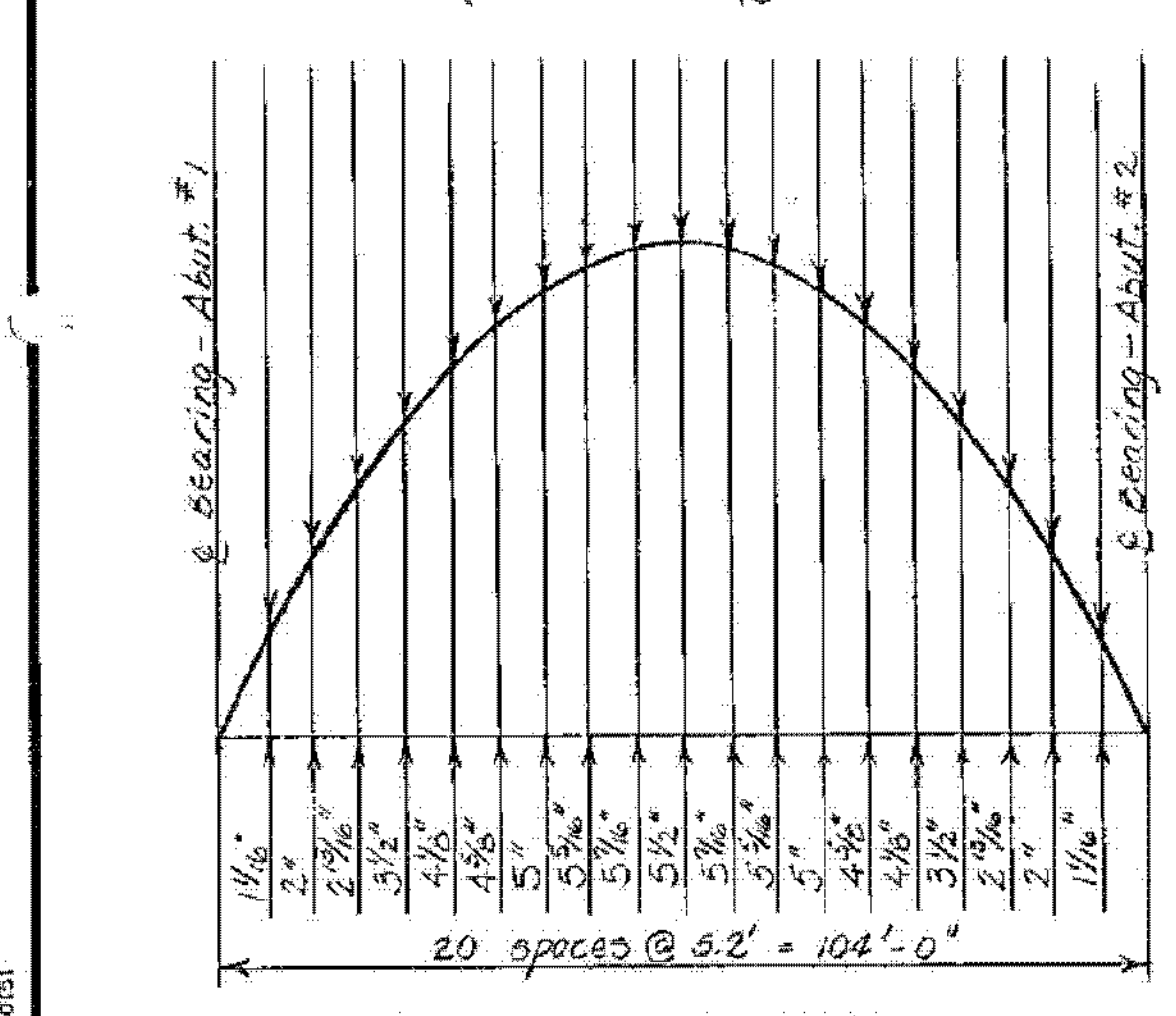
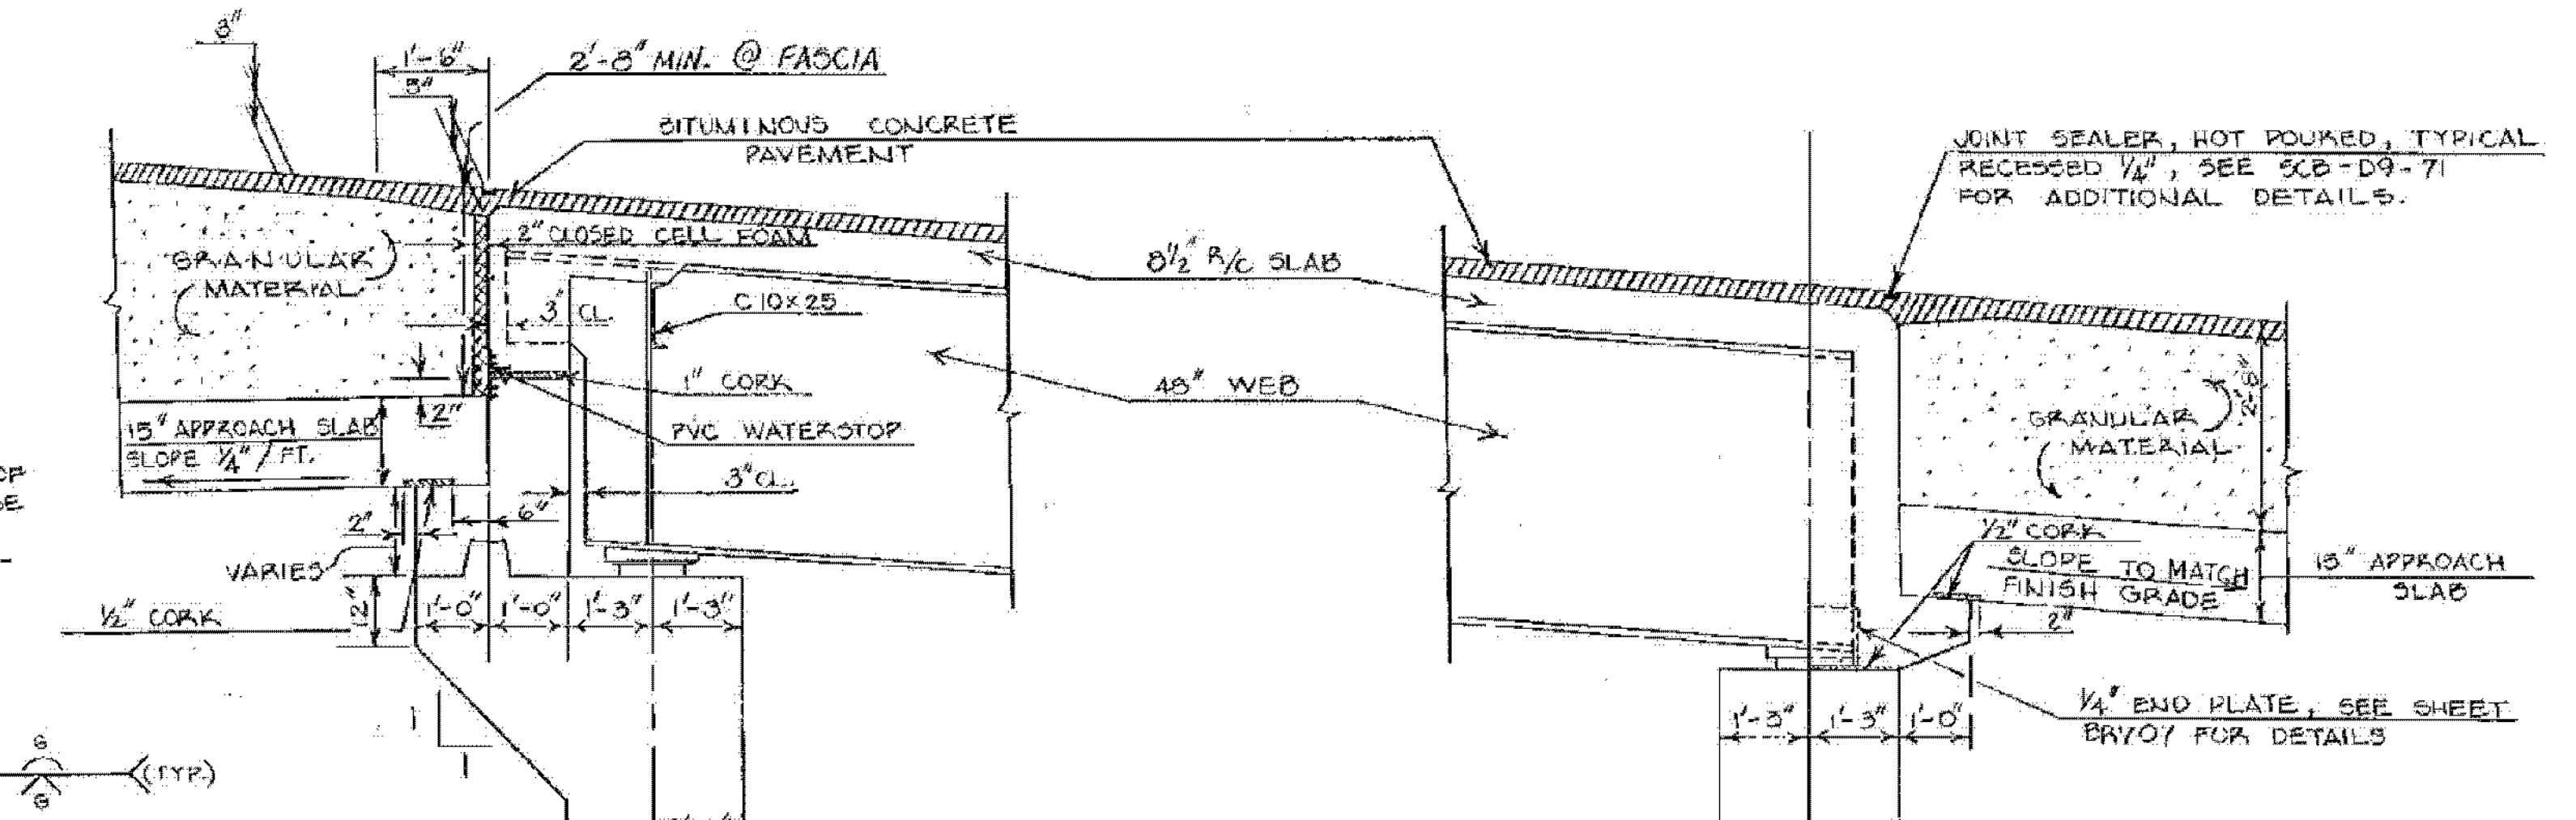
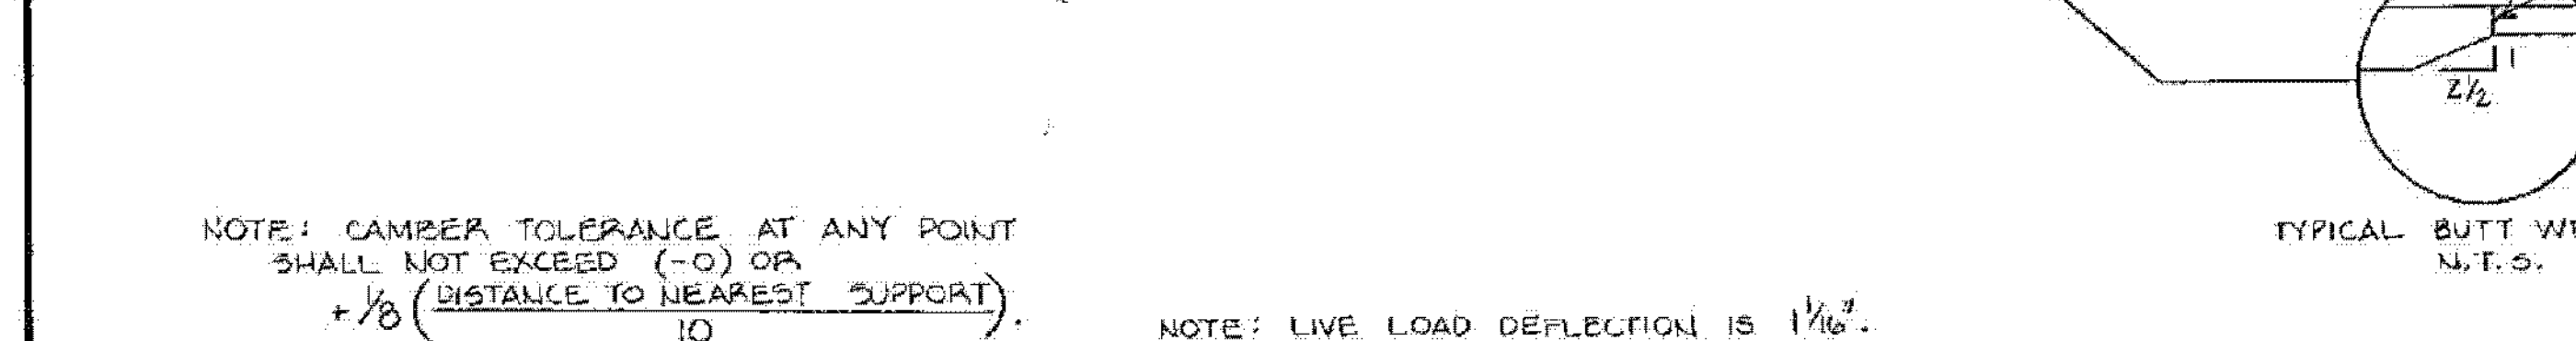


- NOTES:**
1. THE PREFORMED JOINT SEALER, VINYLFOAM, SHALL BE SEMI-RIGID GRADE AND SHALL MEET THE REQUIREMENTS OF SUBSECTION 707.25. PAYMENT SHALL BE INCLUDED IN THE UNIT BID PRICE FOR CONCRETE, CLASS A.
 2. THE PVC WATERSTOP SHALL BE AS SPECIFIED IN SUBSECTION 707.30. THE COST OF THE WATERSTOP SHALL BE INCLUDED IN THE UNIT BID PRICE FOR CONCRETE, CLASS A.
 3. DRIP PLATES ON GIRDERS 1 & 6 ARE TO BE PLACED ACCORDING TO DETAIL (C) ON STANDARD SHEET SCB-07-71.

BRUNING 44.131.40151

DEAD LOAD DEFLECTION DUE TO BEAM, DECK, DIAPHRAGMS, CURB, RAIL, AND PAVEMENT.








STATE OF VERMONT		WATERFORD IM MEMB(31) SHEET 37 OF 48 FOR REFERENCE ONLY	
TOWN OF	WATERFORD	Bridge No.	B7
HIGHWAY NO.	I 93	Log Sta.	
I 93 OVER TOWN HIGHWAY #7		Surr. Sta.	354+83
SUPERSTRUCTURE DETAILS			
Designed by	G.S. ROGERS	Drawn by	G.L. DAVIS
Checked by	G.S. ROGERS date 6-80	Bridge Design Supervisor	F.W. Balkum date 7/80
PROJECT	WATERFORD	PROJECT NO.	I 93-(3)CONTR #2
Bridge Sheet No.	BR706	Sheet	157 of 531

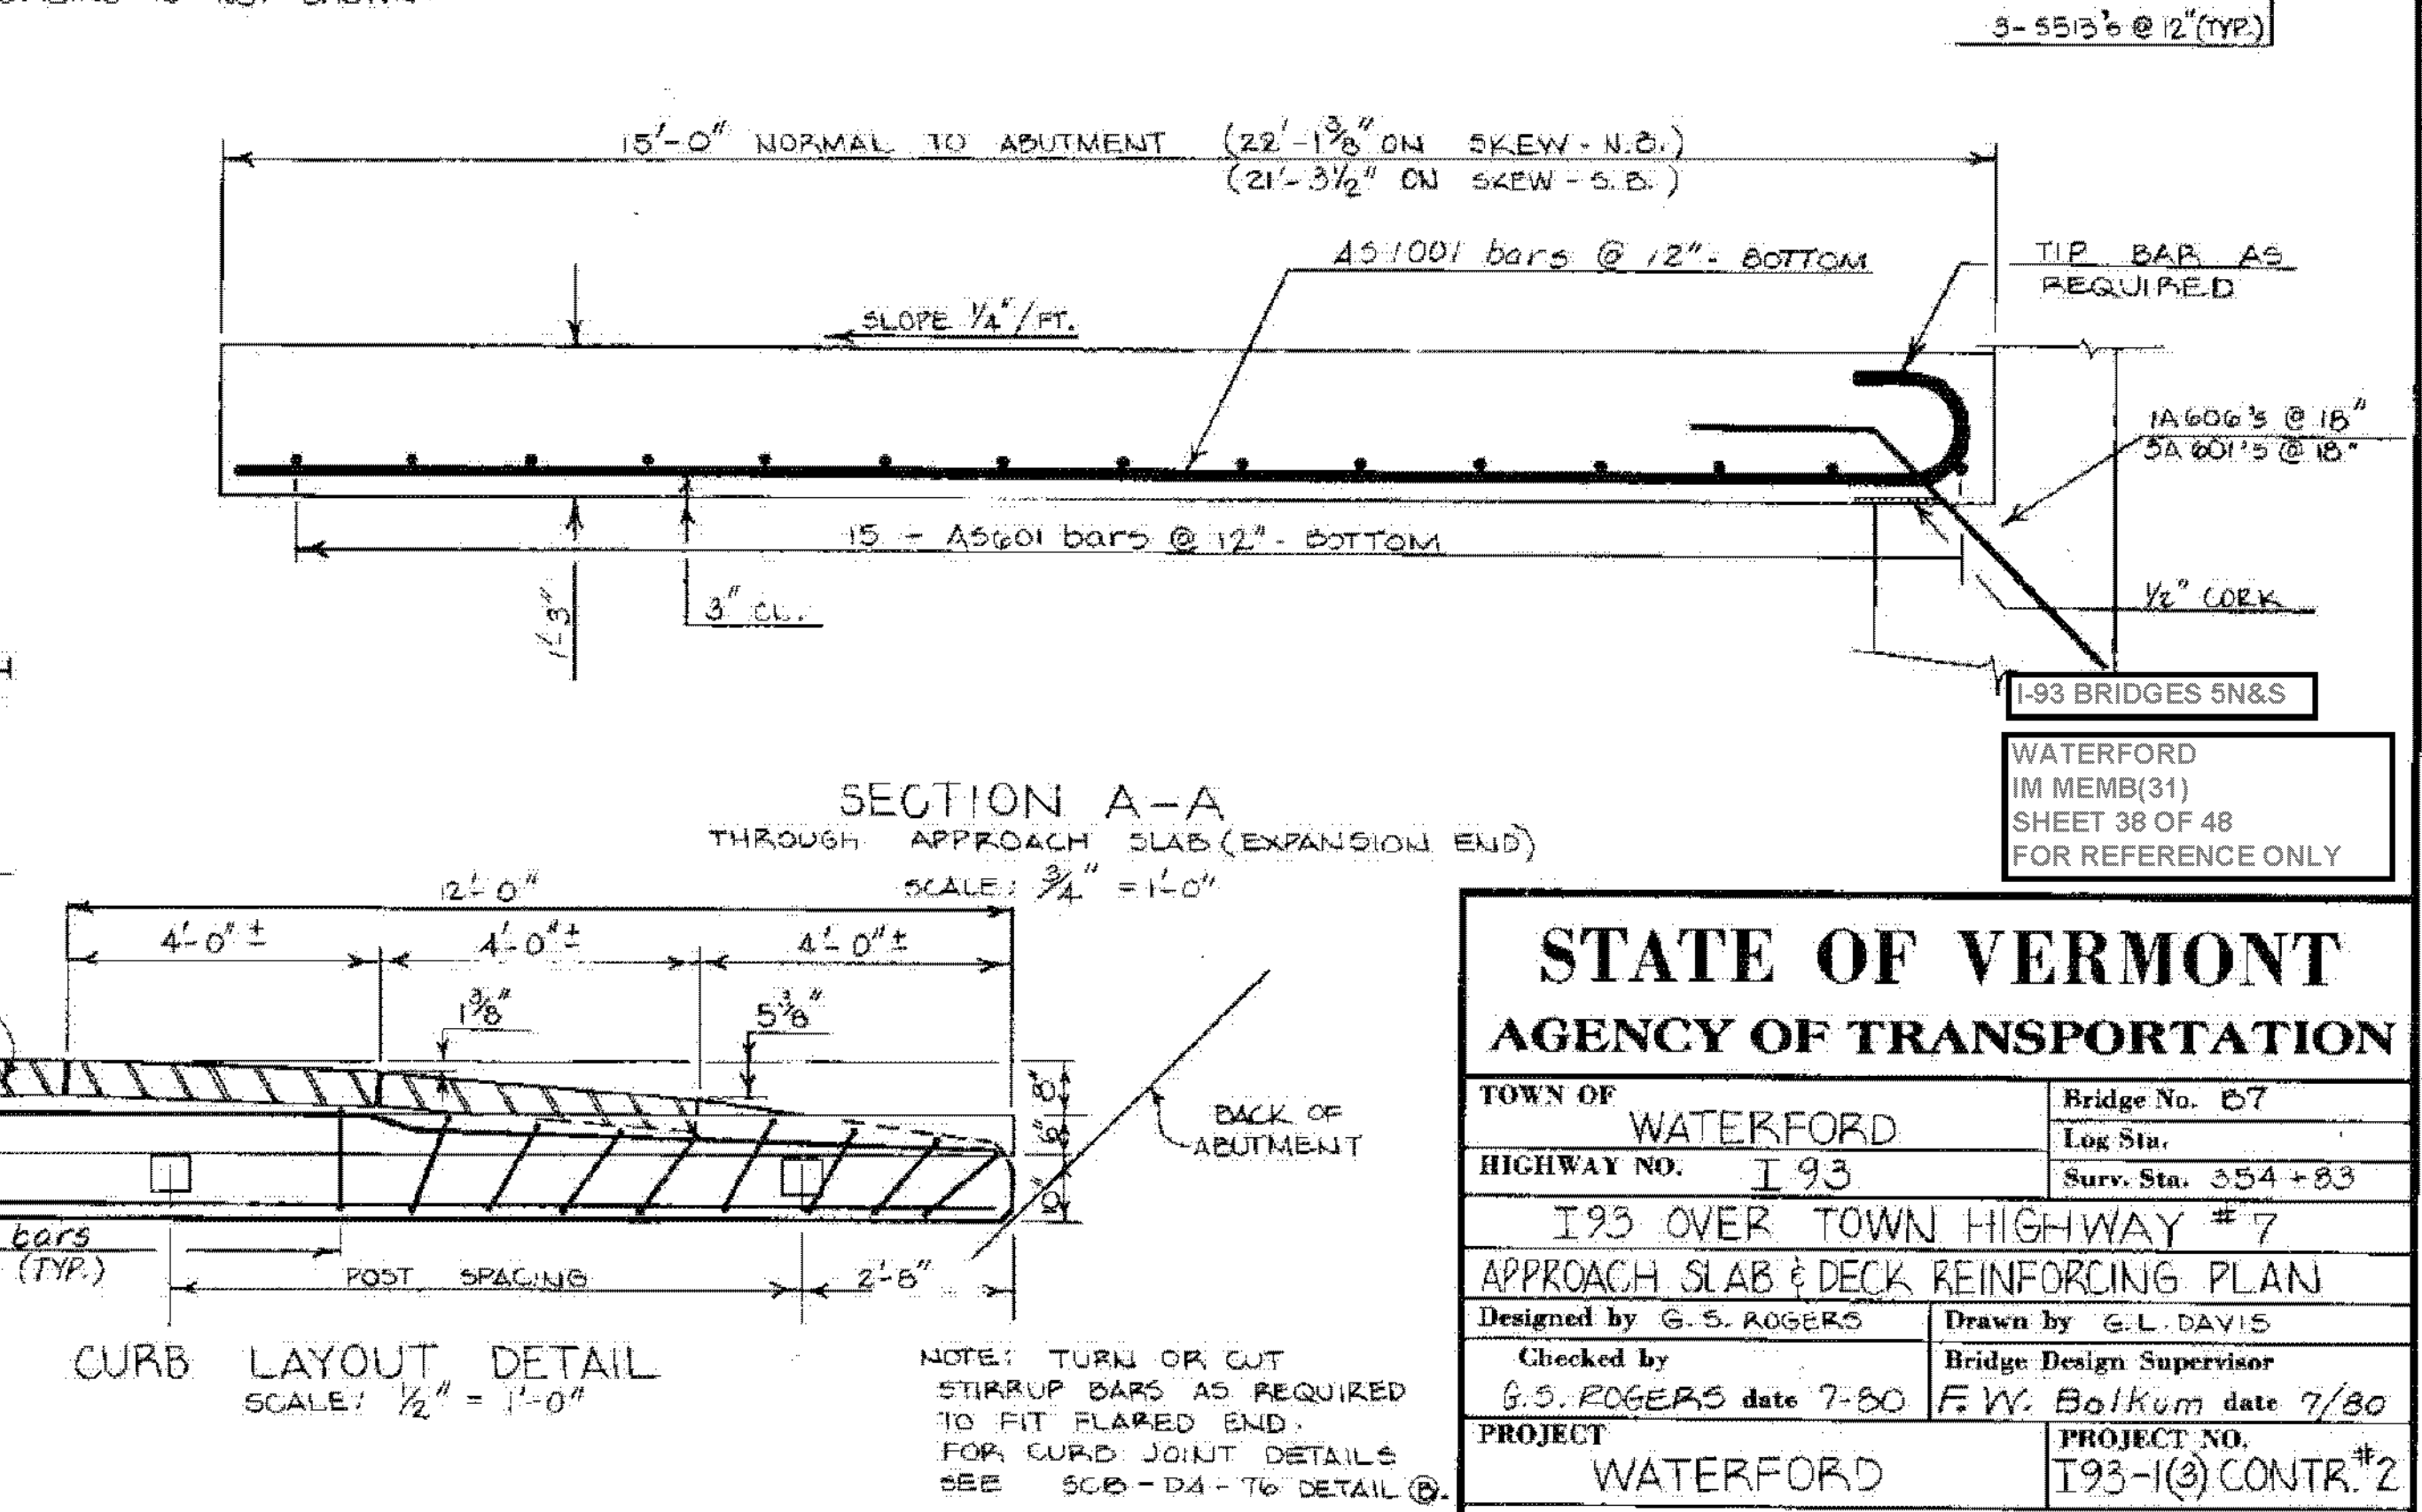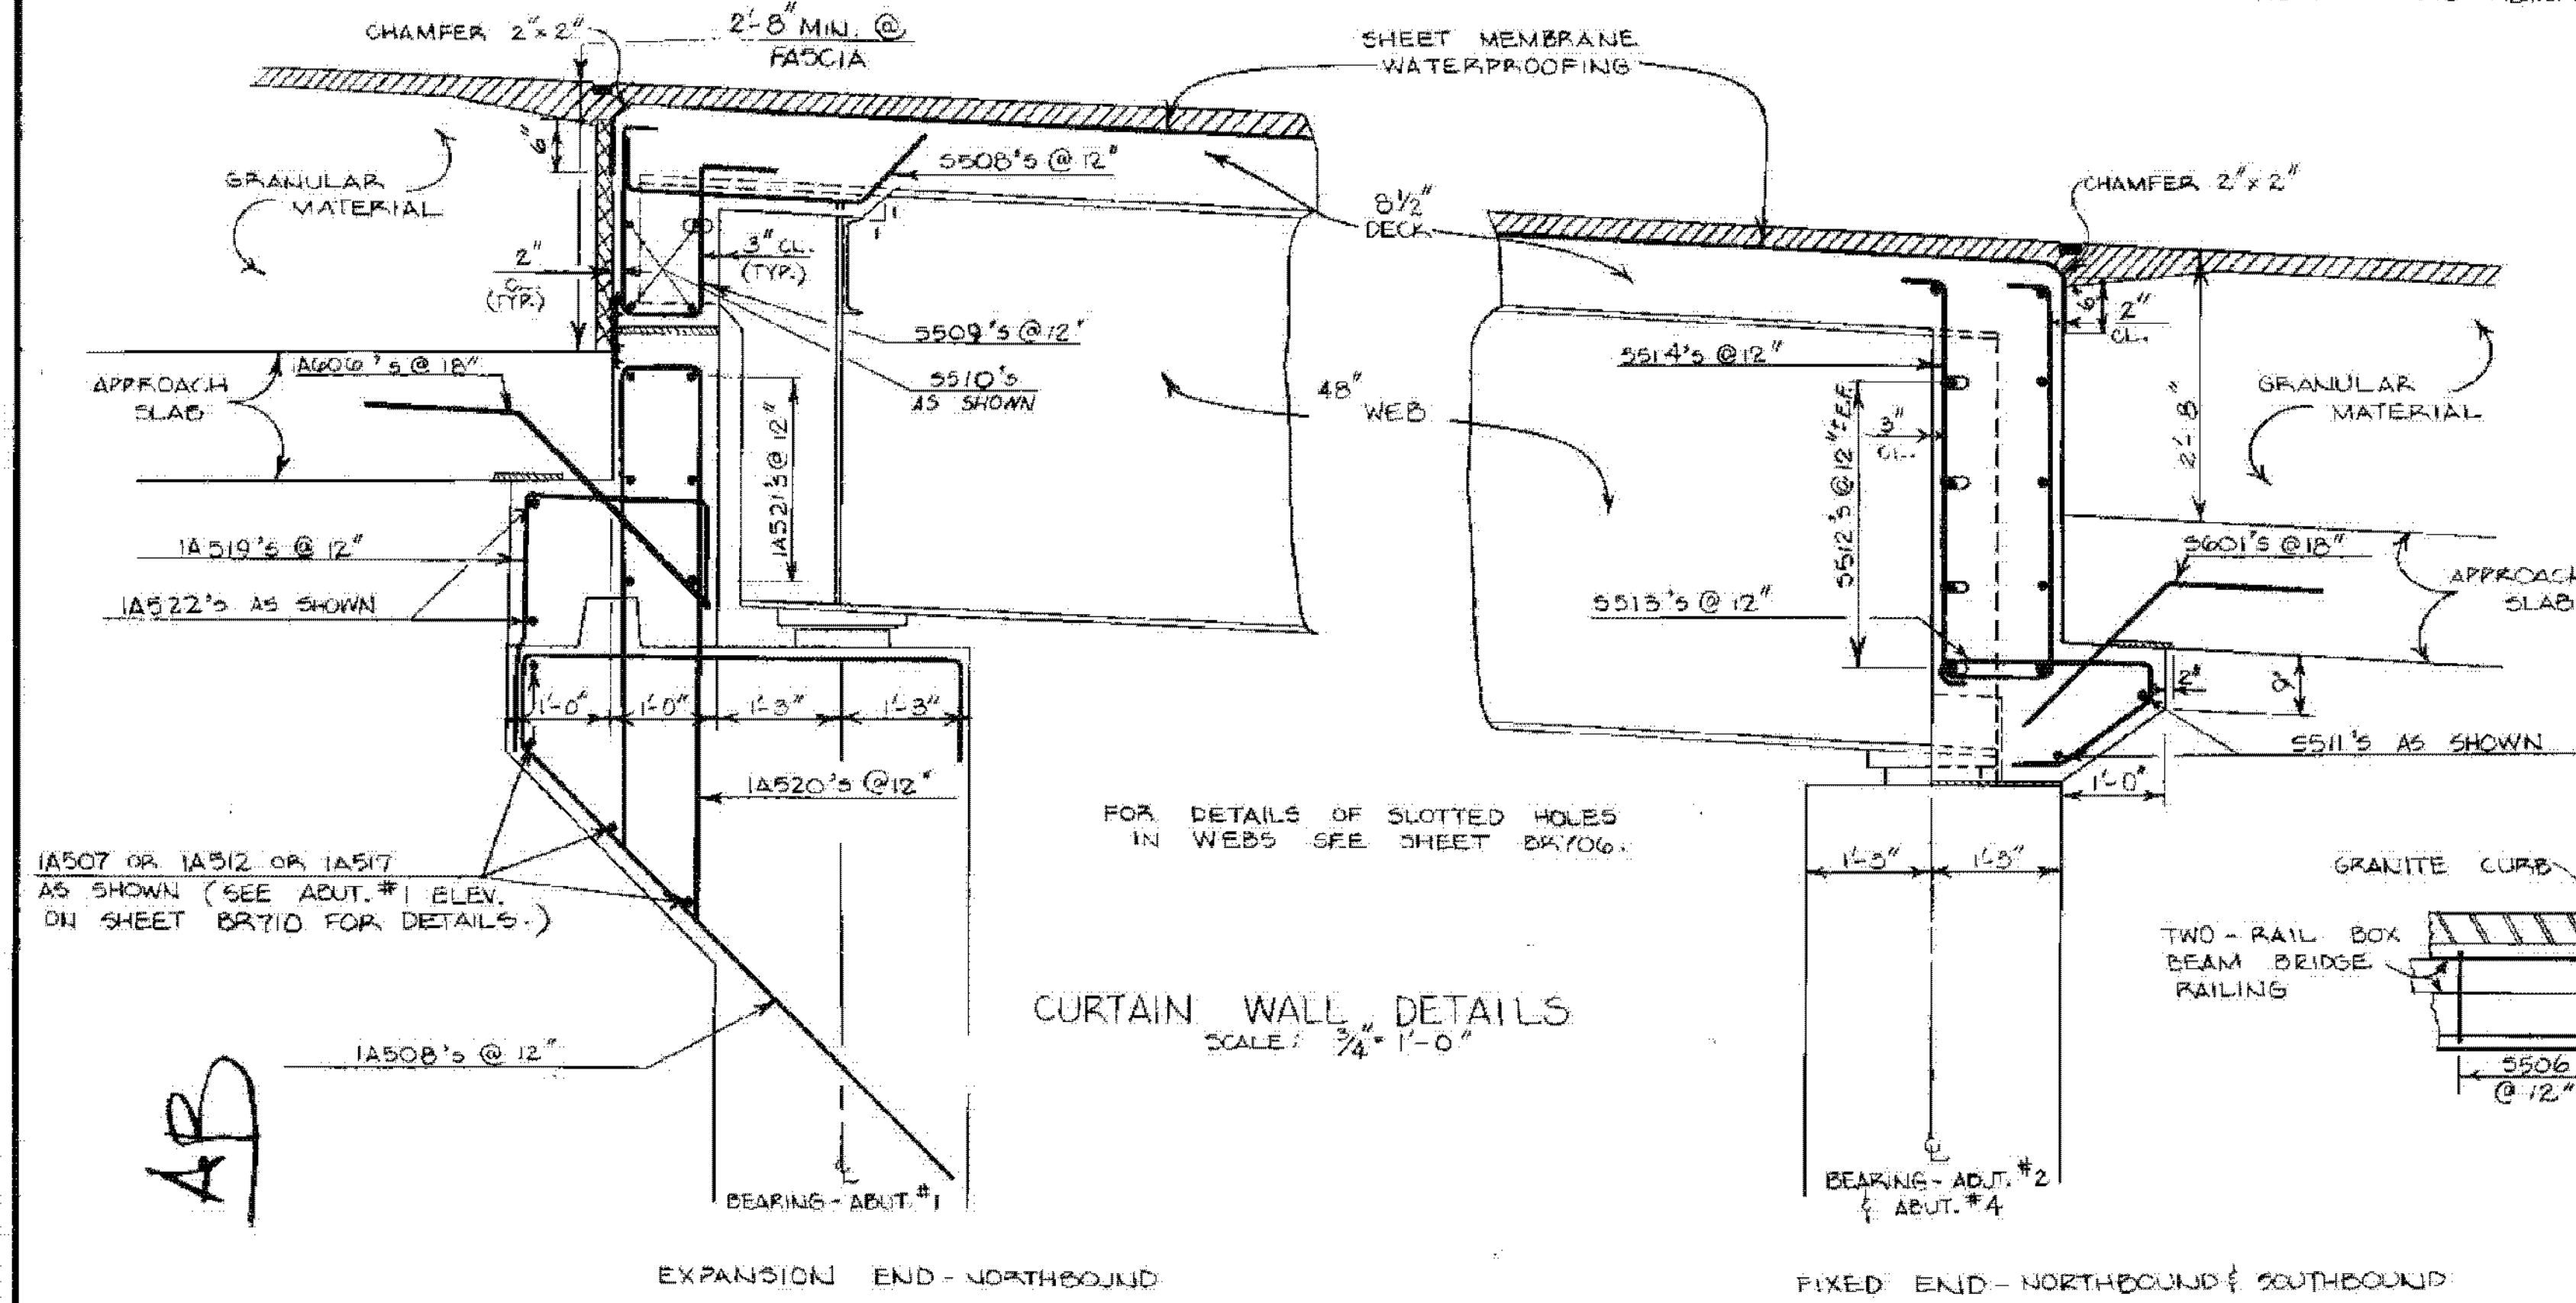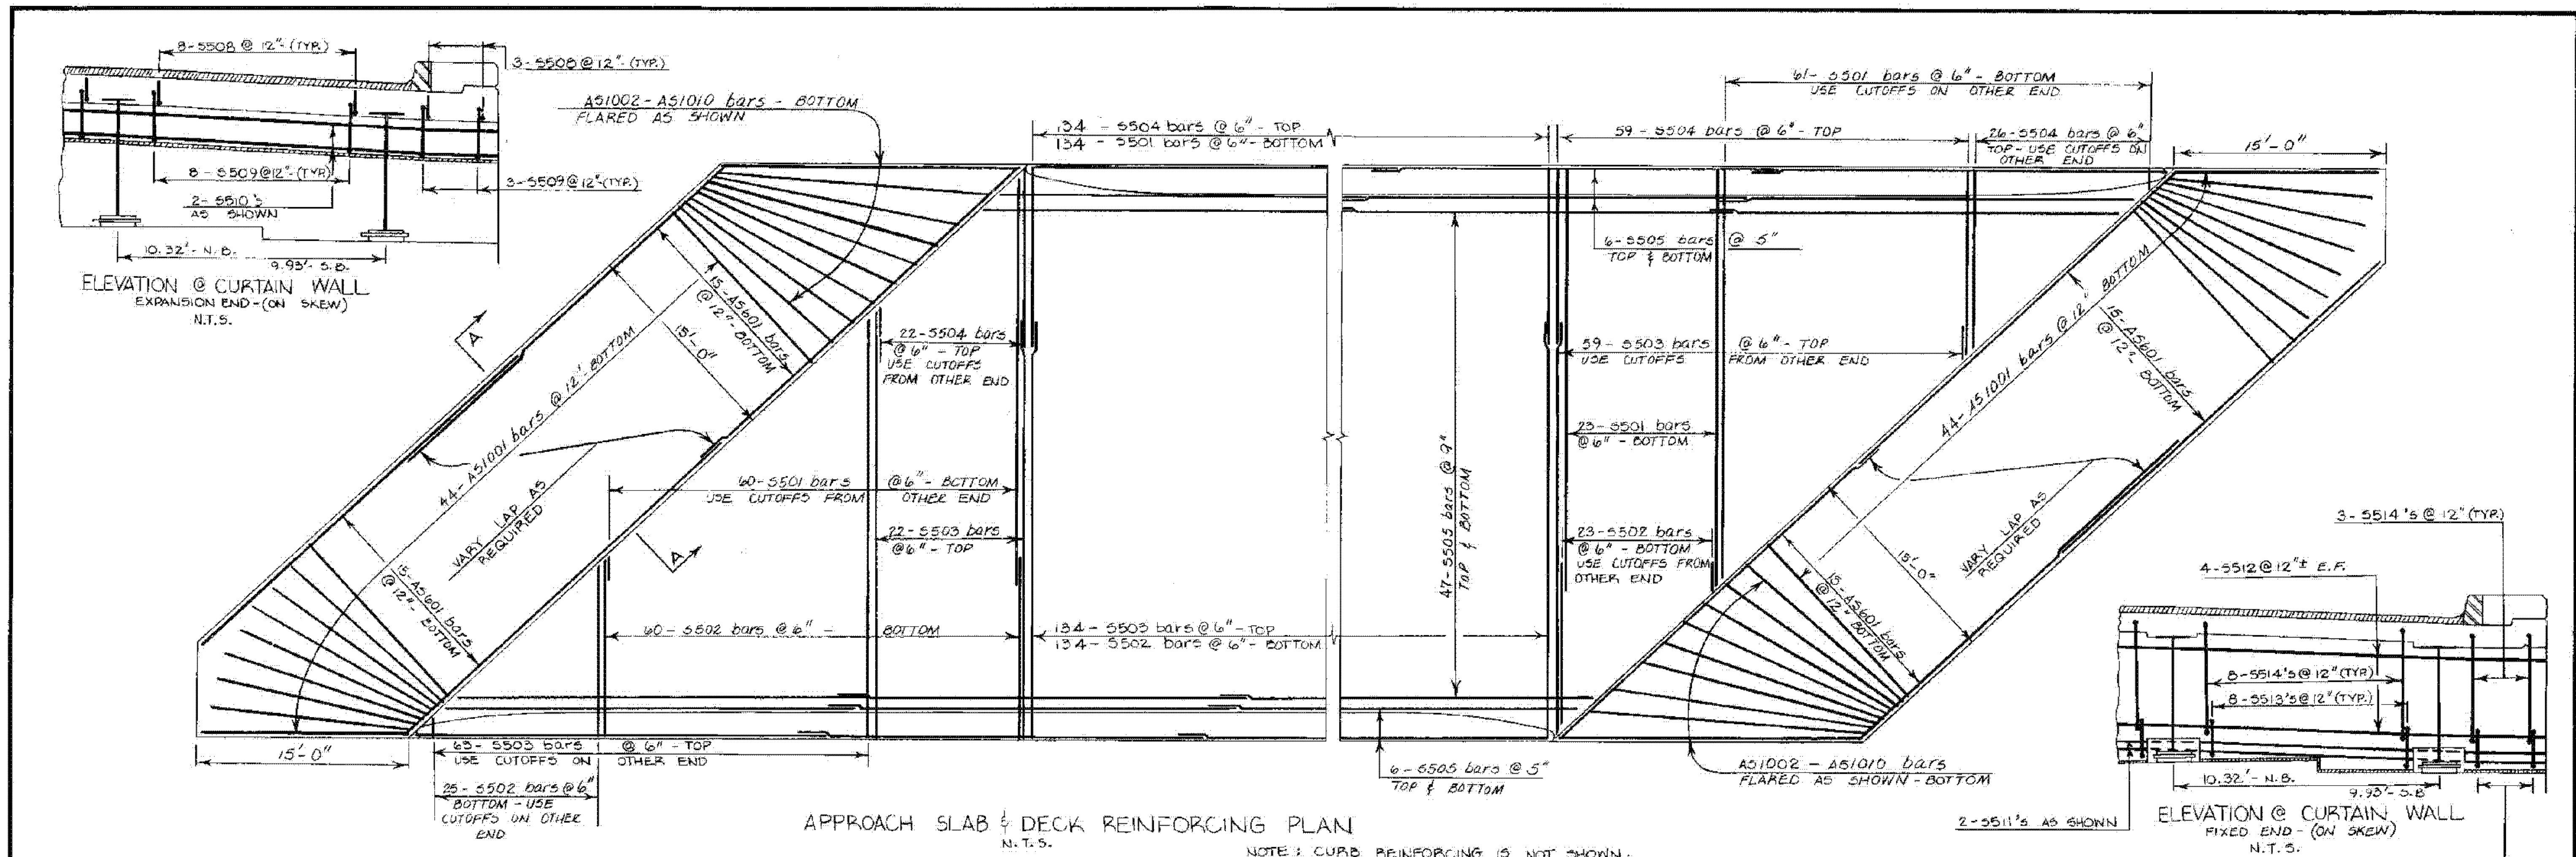

STATE OF VERMONT	
AGENCY OF TRANSPORTATION	
TOWN OF WATERFORD	Bridge No. 67
HIGHWAY NO. I 93	Log Sta. Surv. Sta. 554+83
I 93 OVER TOWN HIGHWAY # 7	
APPROACH SLAB & DECK REINFORCING PLAN	
Designed by G.S. ROGERS	Drawn by G.L. DAVIS
Checked by G.S. ROGERS date 7-80	Bridge Design Supervisor F.W. Bolkum date 7/80
PROJECT WATERFORD	PROJECT NO. I 93-1(3) CONTR. # 2
Bridge Sheet No. 08709	Sheet 160 of 531

BRIDGE 44-131-4031

C BEARING - ABUT. #1
 STA. 553+60.00
 FINISH GRADE = 1033.43
 EXPANSION END
 BEGIN BRIDGE - BACK OF ABUT. #1
 STA. 553+56.45
 FINISH GRADE = 1033.58

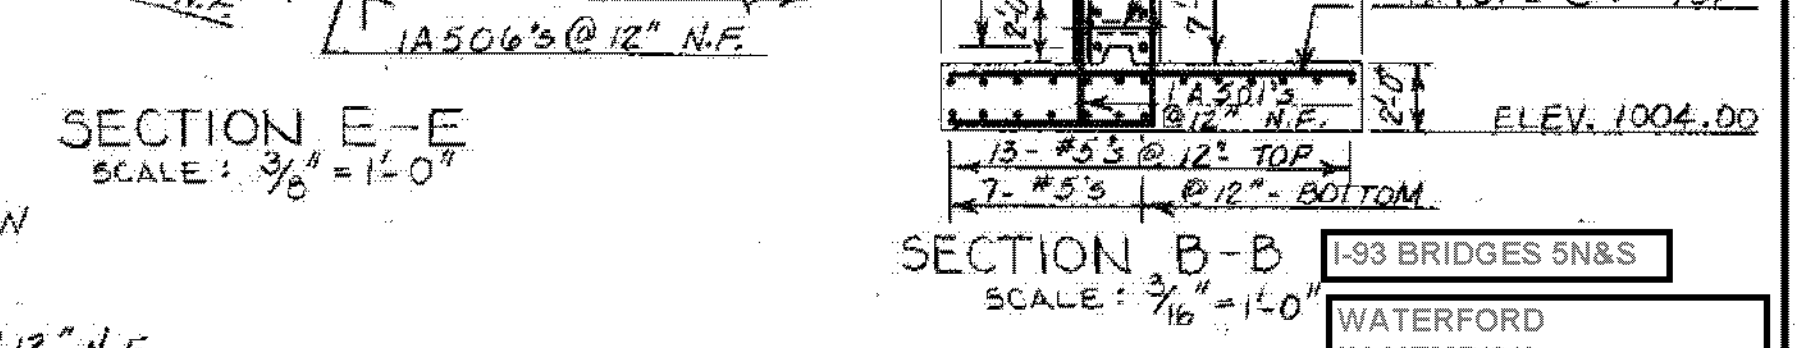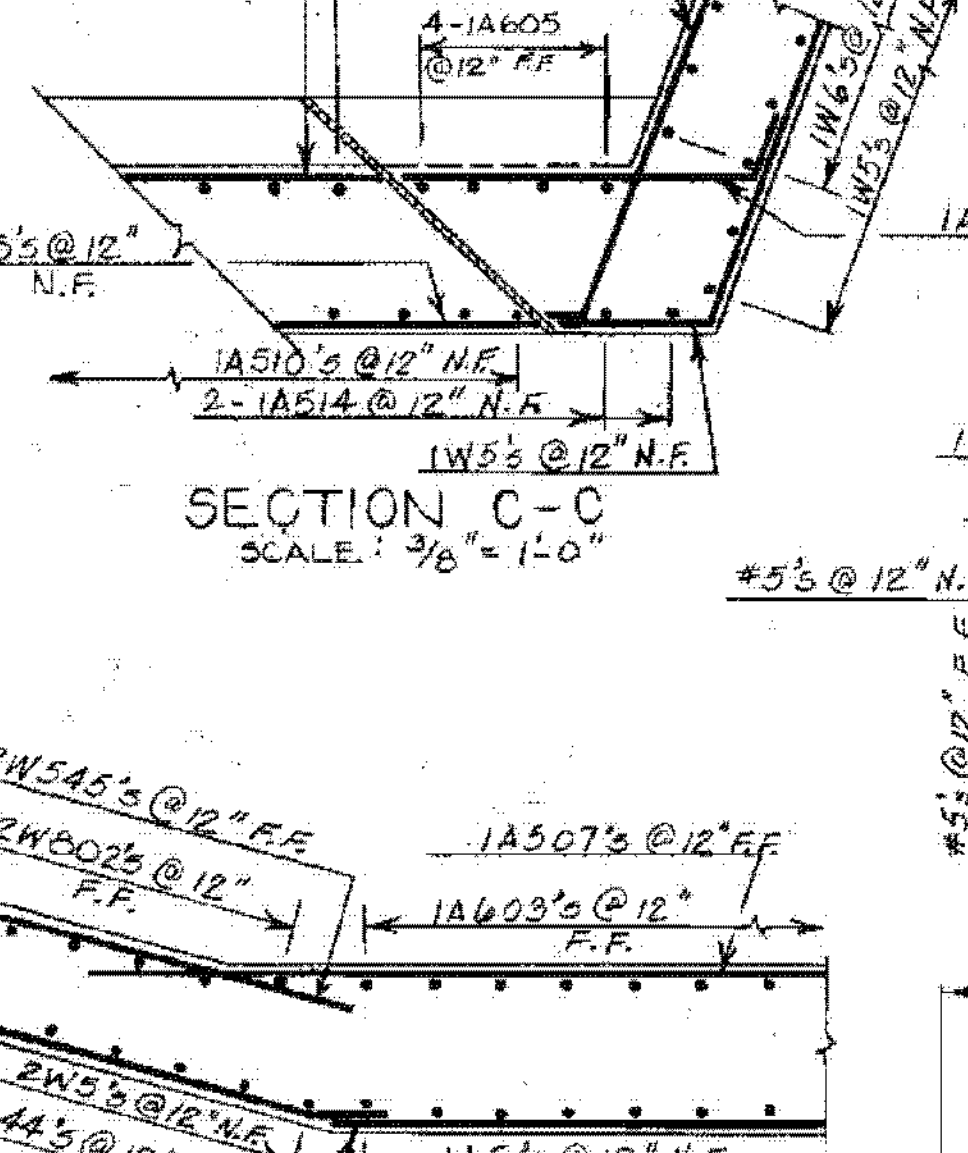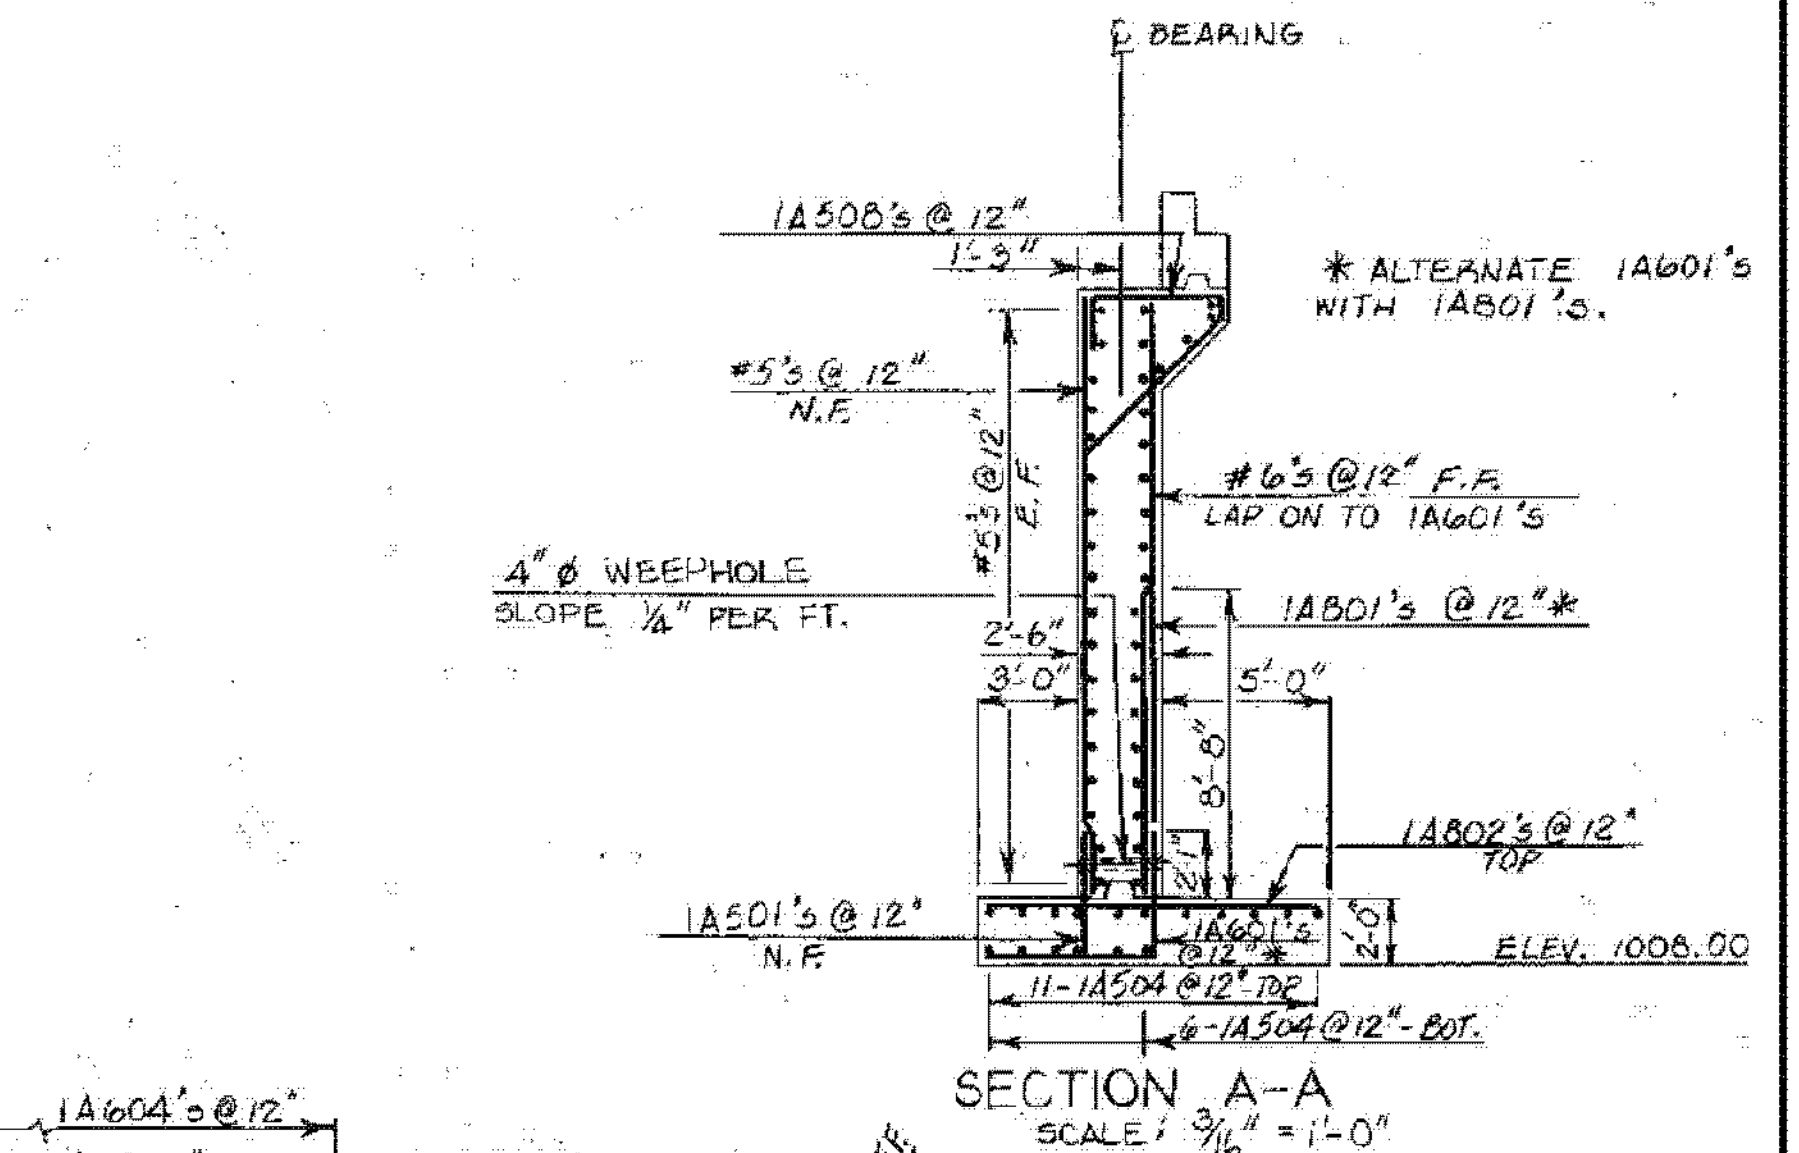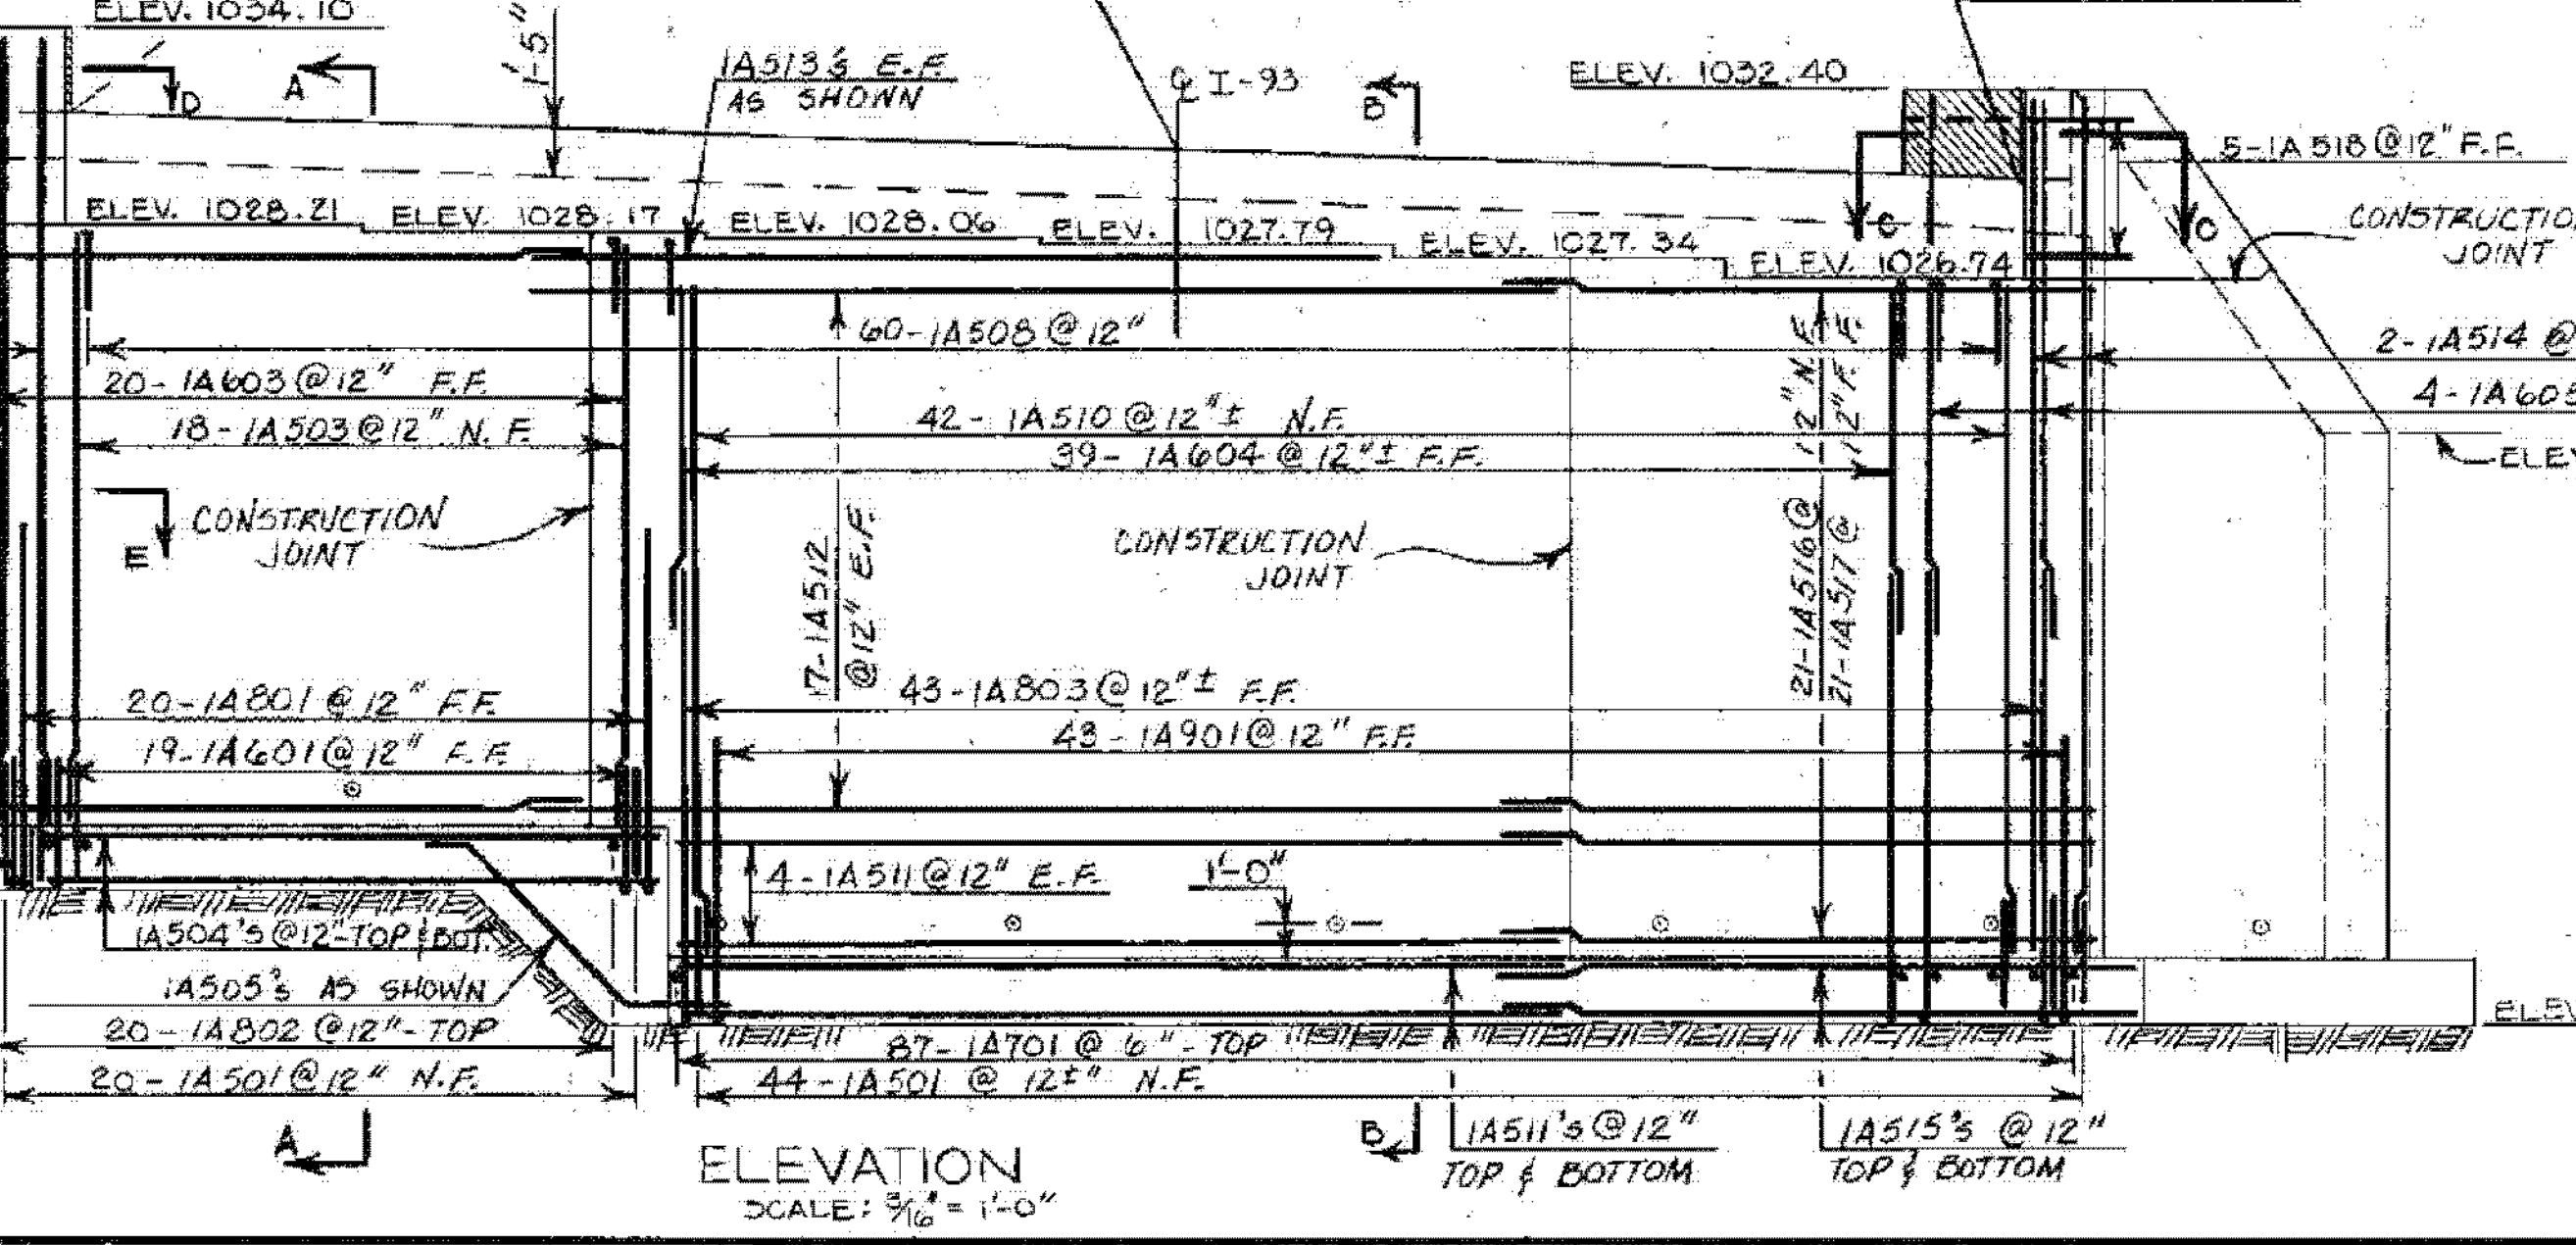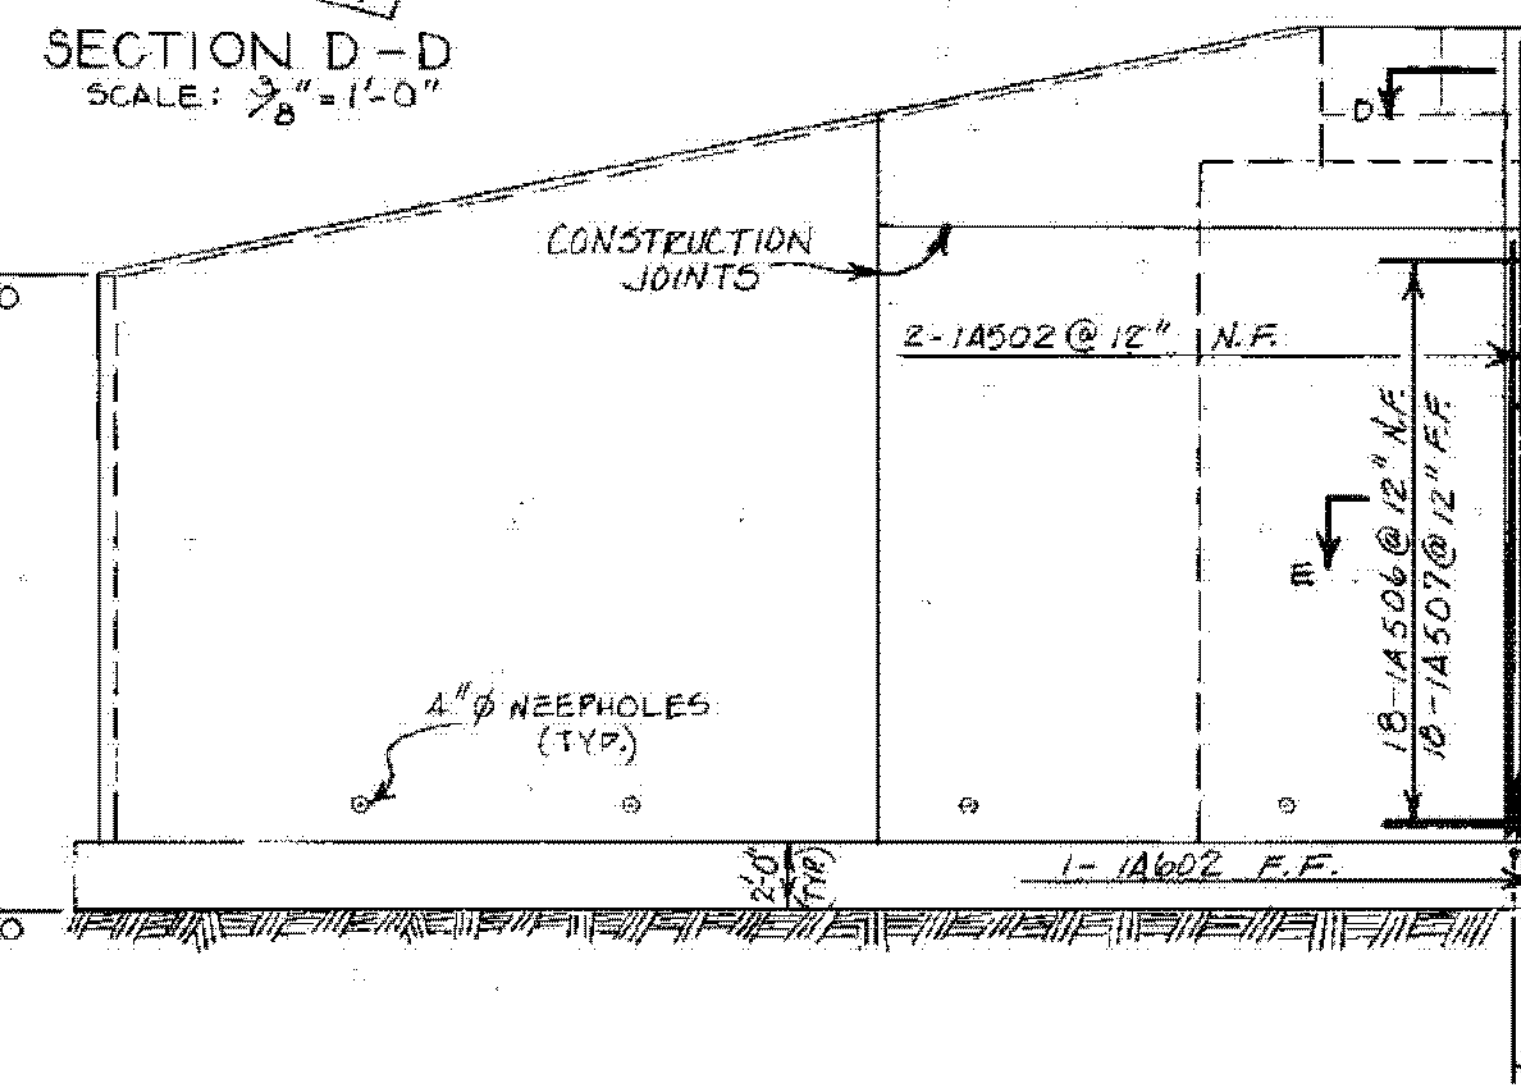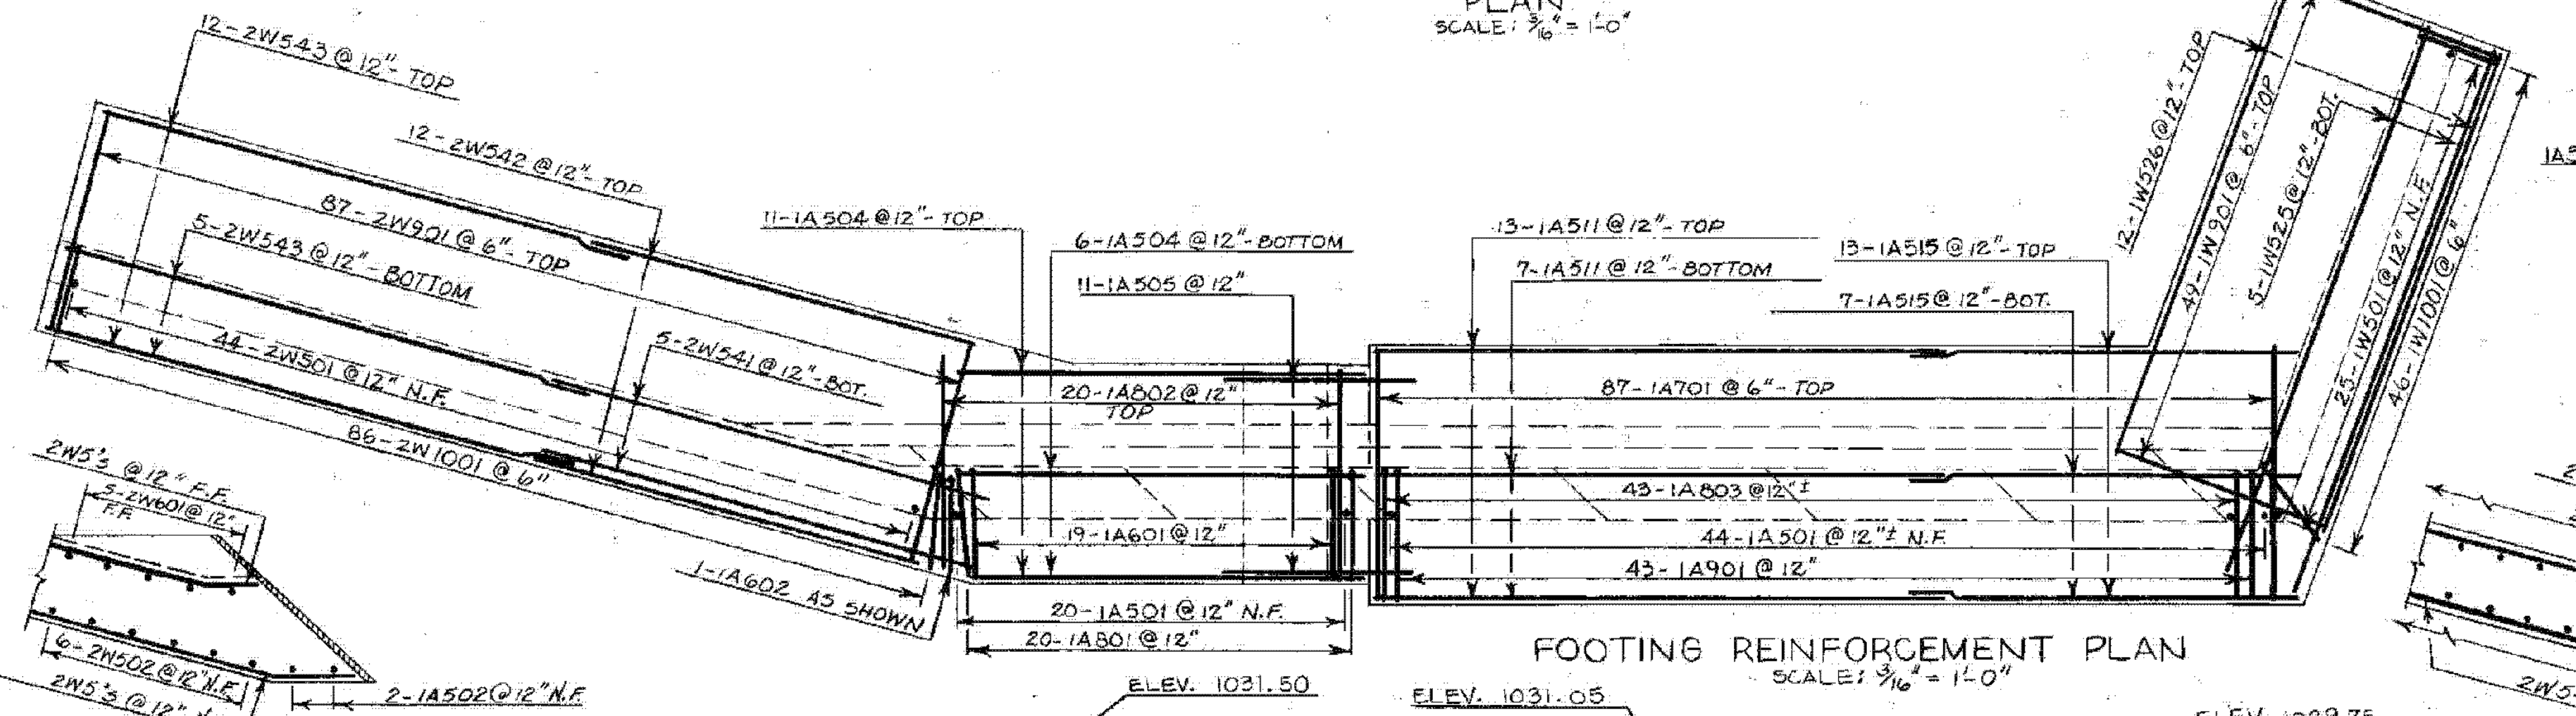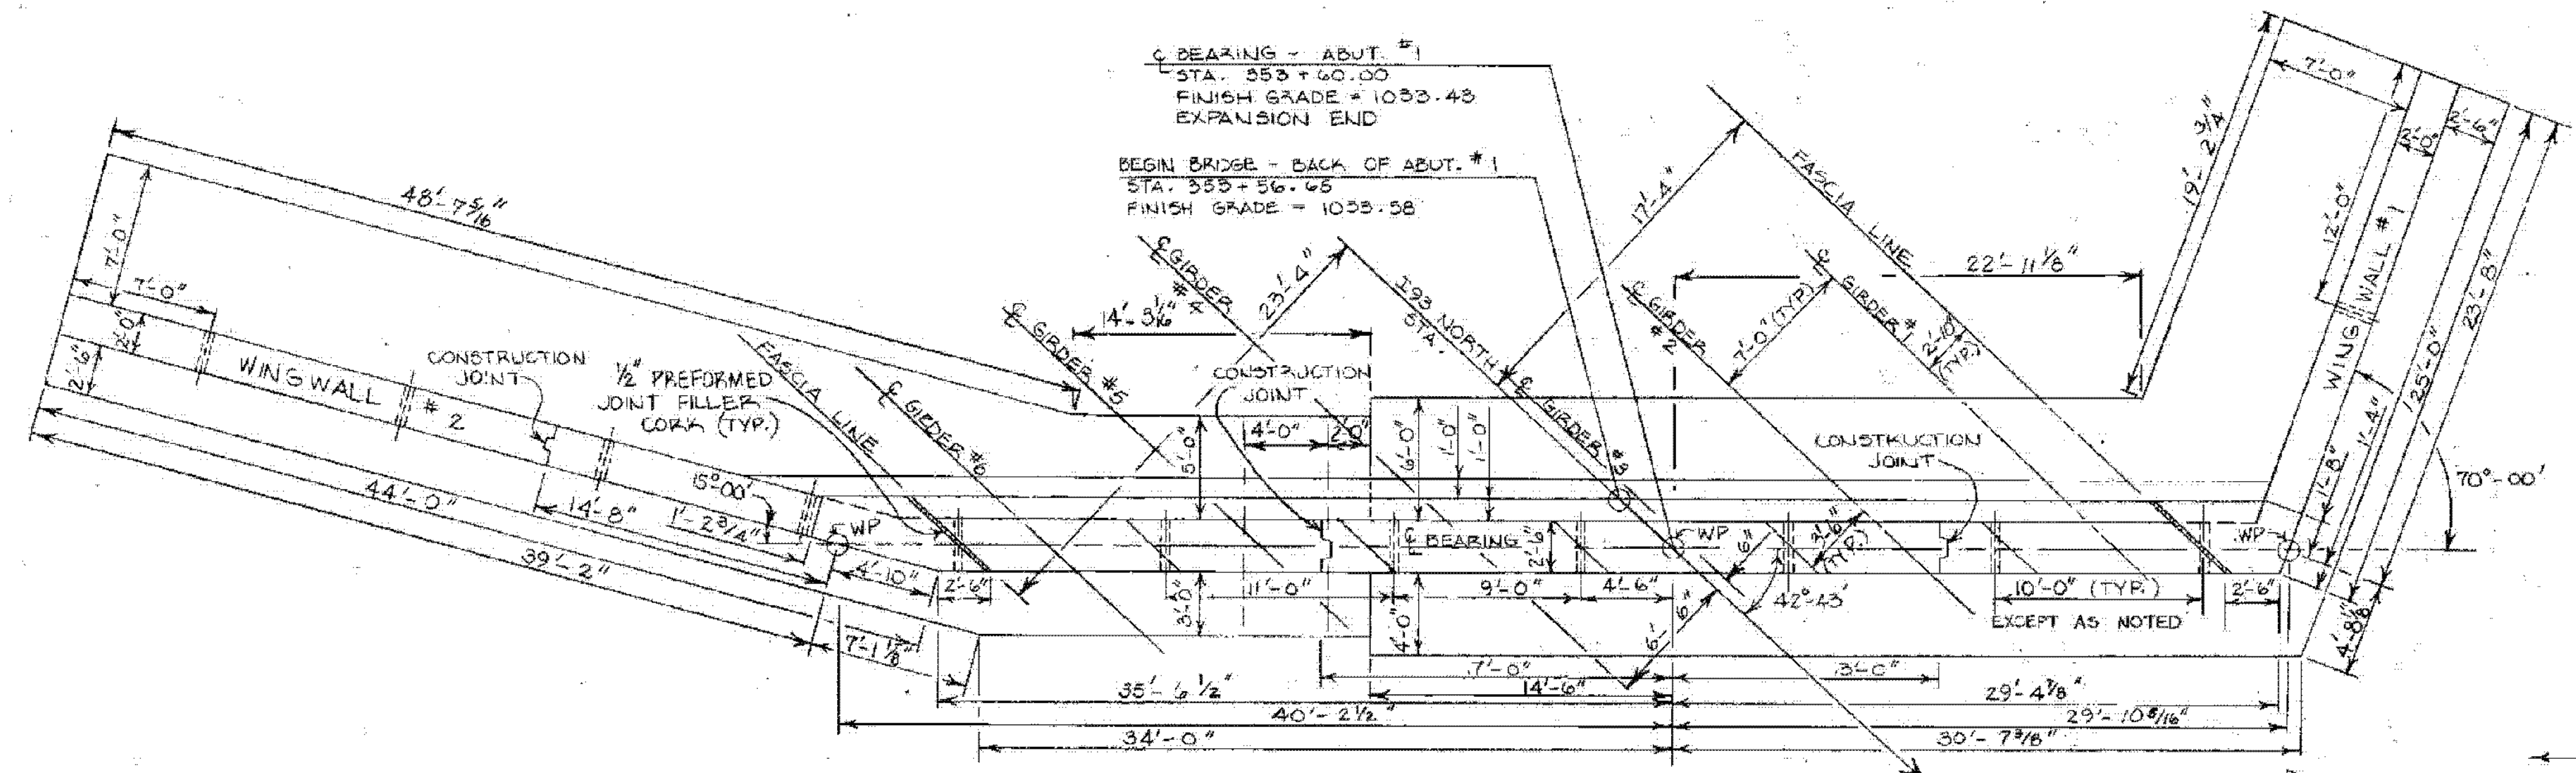


STATE OF VERMONT	
AGENCY OF TRANSPORTATION	
TOWN OF WATERFORD	Bridge No. 57
HIGHWAY NO. 193	Log Sta. 354+83
I-93 NORTHBOUND OVER TH #7	
ABUTMENT NO. 1 DETAILS	
Designed by G.S. ROGERS	Drawn by G.L. DAVIS
Checked by G.S. ROGERS date 6-80	Bridge Design Supervisor F.W. Bolkorn date 7/80
PROJECT WATERFORD	PROJECT NO. I-93-(3) CONTR. #2
Bridge Street No. BR710	Sheet 161 of 531

DRAWING 44-191-0151







NOTES:

1. THE ABUTMENTS SHALL REST ON LEDGE EXCEPT AS NOTED. LEDGE SHALL BE REMOVED AS NECESSARY TO INSURE THE SURFACE BENEATH ANY CROSS SECTION OF ABUTMENT STEM OR WING IS SOUND AND REASONABLY LEVEL, AS SHOWN. LEDGE REMOVAL SHALL BE INCLUDED UNDER THE ITEM "STRUCTURE EXCAVATION". LEDGE SURFACES SHALL BE COMPLETELY CLEANED OF ALL LOOSE SOIL AND OTHER DEBRIS PRIOR TO PLACING OF CONCRETE.
2. IF NO LEDGE IS ENCOUNTERED WITHIN TWO (2) FT. BELOW THE BOTTOM OF THE FOOTING ELEVATIONS, AS SHOWN ON THESE PLANS, THE STRUCTURES ENGINEER SHALL BE CONTACTED. PROFILES OF THE LEDGE MAY BE REQUIRED IN ORDER TO ADJUST FOOTING ELEVATIONS AND SIZE. NO FURTHER WORK SHALL BE DONE ON THE FOOTINGS UNTIL A REPLY IS RECEIVED FROM THE STRUCTURES ENGINEER.
3. ALL OVERSPERAGE BELOW INDICATED BOTTOM OF FOOTING SHALL BE REPLACED WITH CONCRETE, CLASS B. A MAXIMUM OF 6" AVERAGE DEPTH SHALL BE PAID FOR AS "STRUCTURE EXCAVATION" AND "CONCRETE, CLASS B"; ANY ADDITIONAL CONCRETE REQUIRED SHALL BE PLACED AT COST OF THE CONTRACTOR.
4. ALL FOOTINGS ARE DESIGNED TO BEAR ON LEDGE AT A MAXIMUM PRESSURE OF 7.2 K.S.F., EXCEPT FOR PORTIONS OF WINGWALLS 3 & 7 WHICH ARE DESIGNED TO BEAR ON BARTH WHERE THE MAXIMUM PRESSURE IS 4.0 K.S.F.
5. ALL REINFORCING STEEL SHALL BE LAPPED A MINIMUM OF 2'-0" UNLESS OTHERWISE SHOWN.

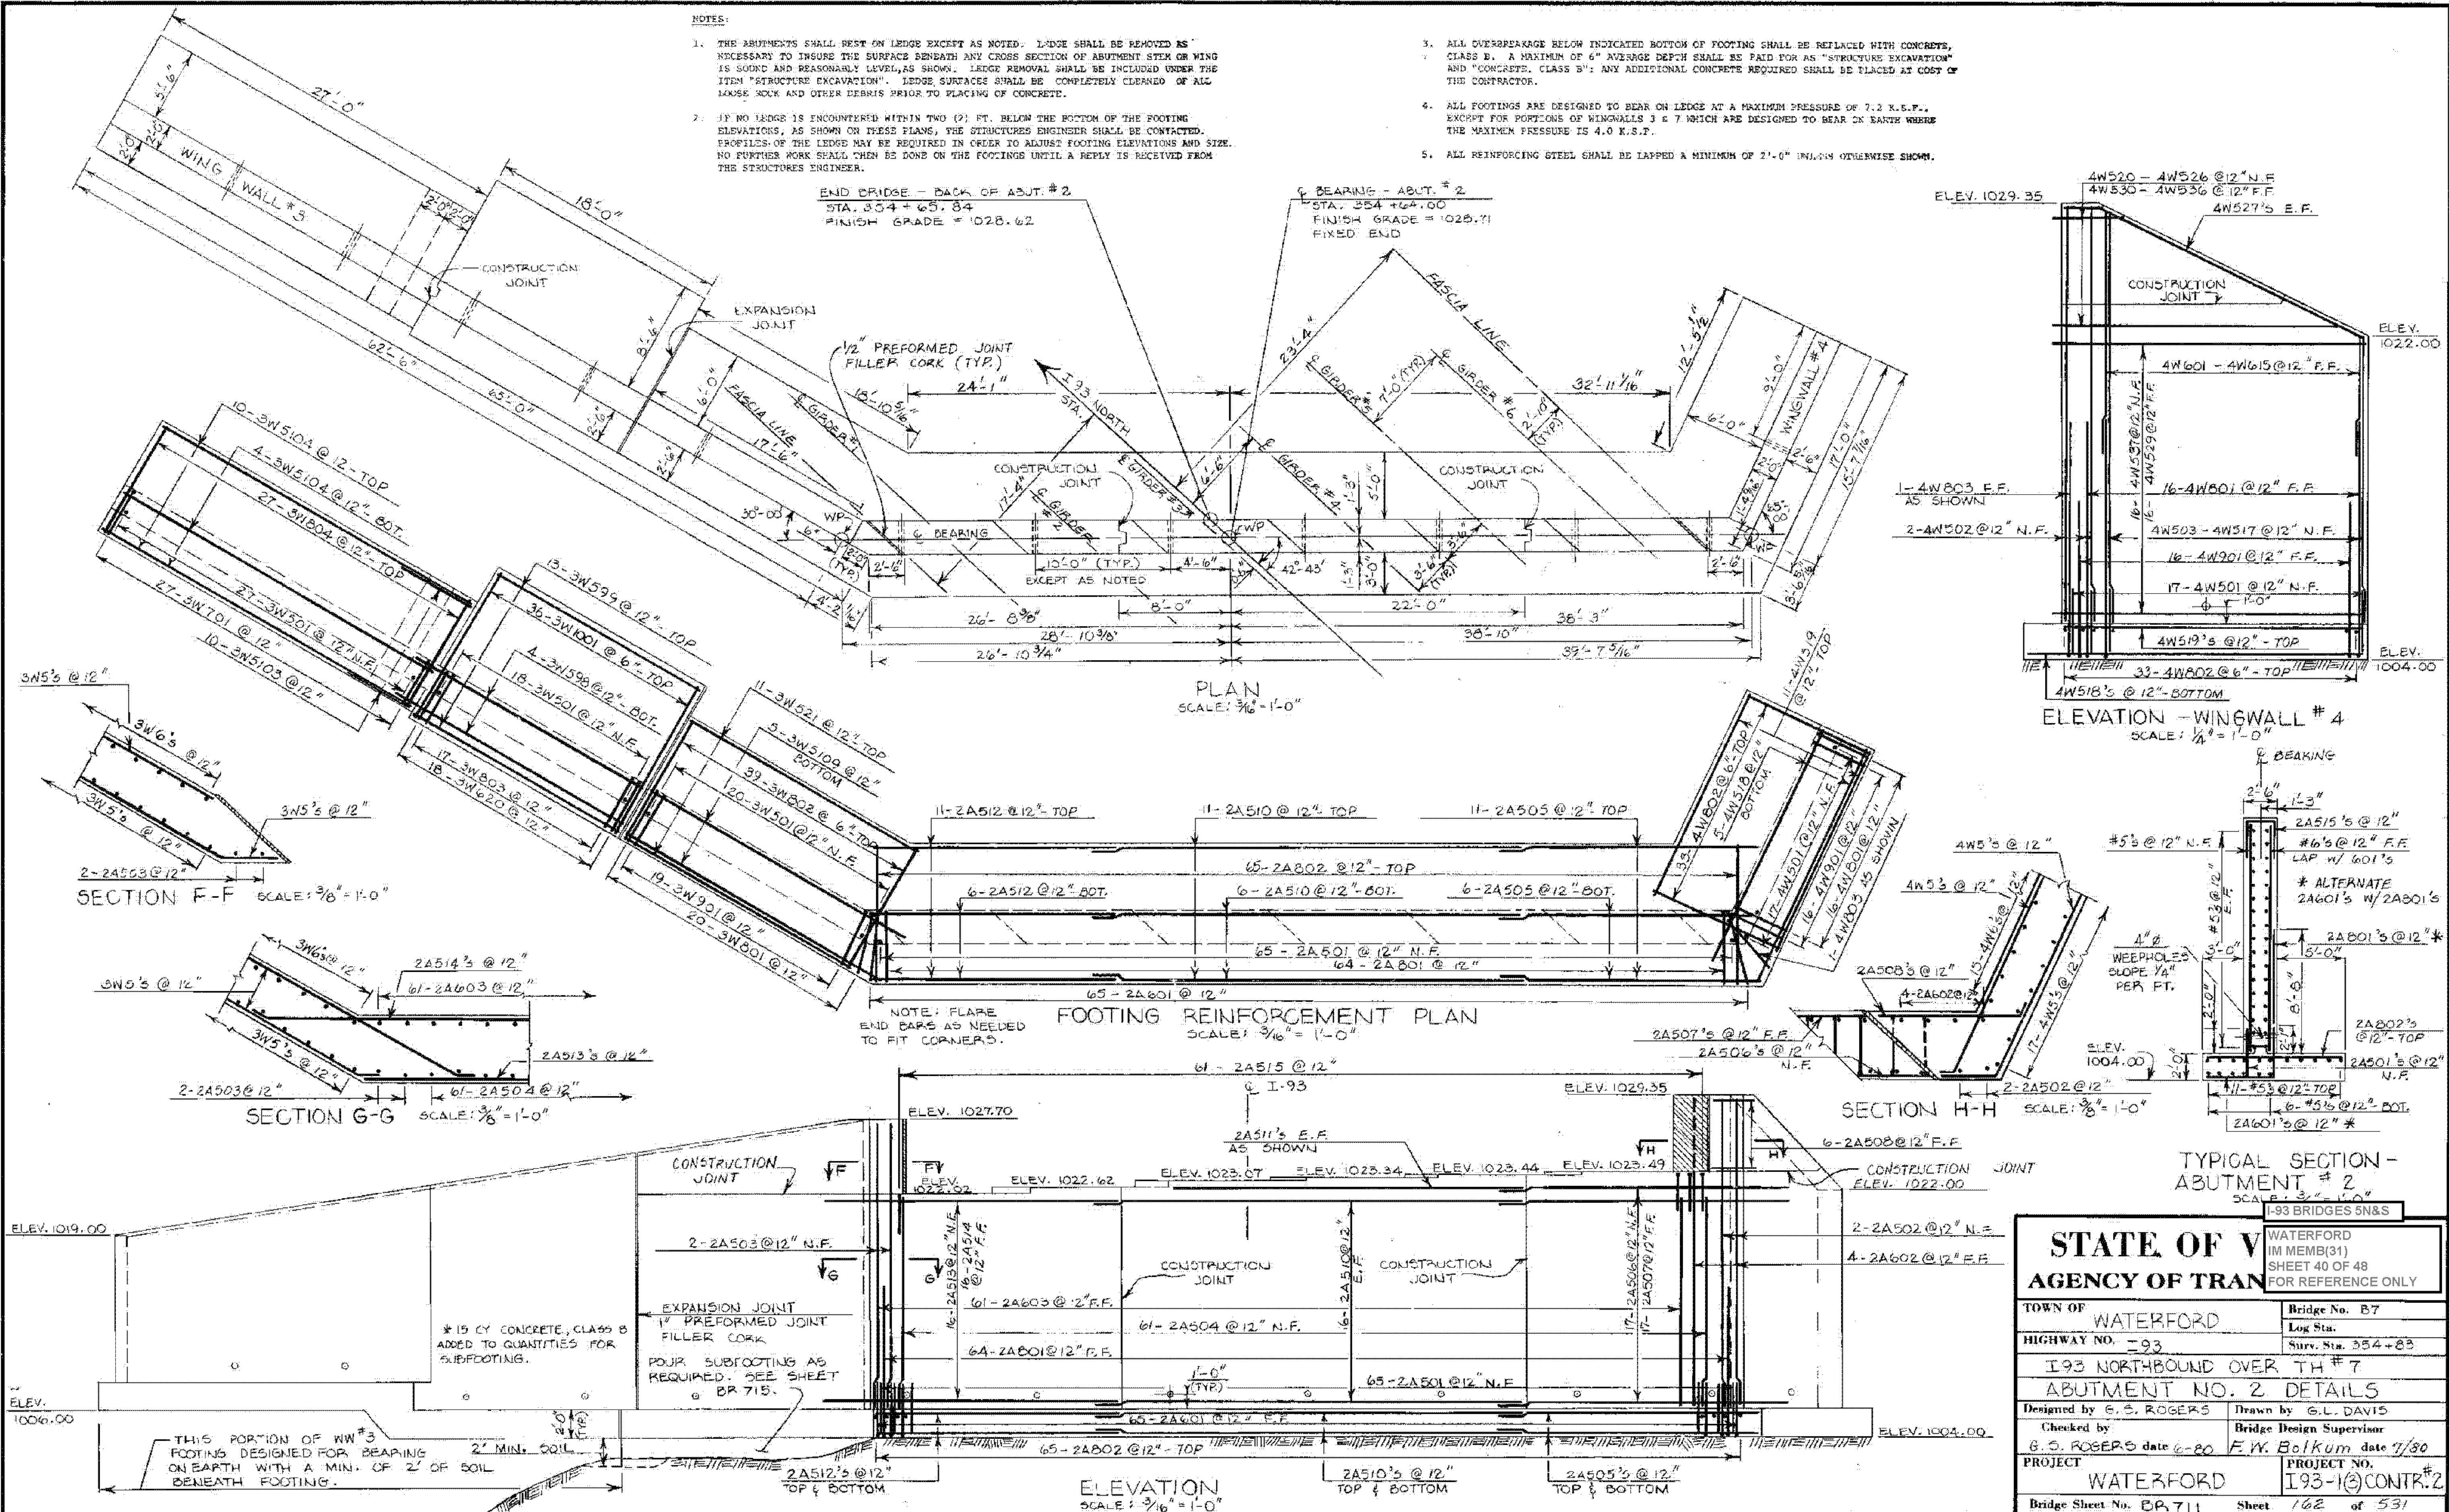


STATE OF VERMONT		WATERFORD	
AGENCY OF TRANSPORTATION		IM MEMB(31)	
SHEET 40 OF 48		FOR REFERENCE ONLY	
TOWN OF	WATERFORD	Bridge No.	B7
HIGHWAY NO.	93	Log Sta.	
		Surv. Sta.	354+83
I-93 NORTHBOUND OVER TH #7			
ABUTMENT NO. 2 DETAILS			
Designed by	E. S. ROGERS	Drawn by	G. L. DAVIS
Checked by	G. S. ROGERS date 6-20	Bridge Design Supervisor	F. W. Bolkum date 7/30
PROJECT	WATERFORD	PROJECT NO.	I93-10)CONTR.#2
Bridge Sheet No.	BR. 711	Sheet	162 of 531

BR-4

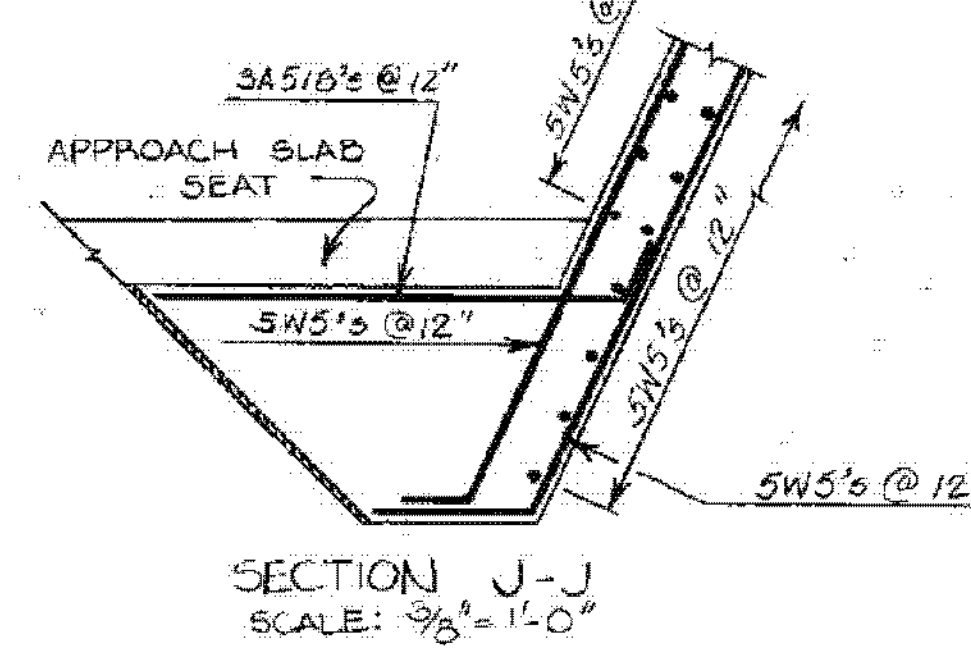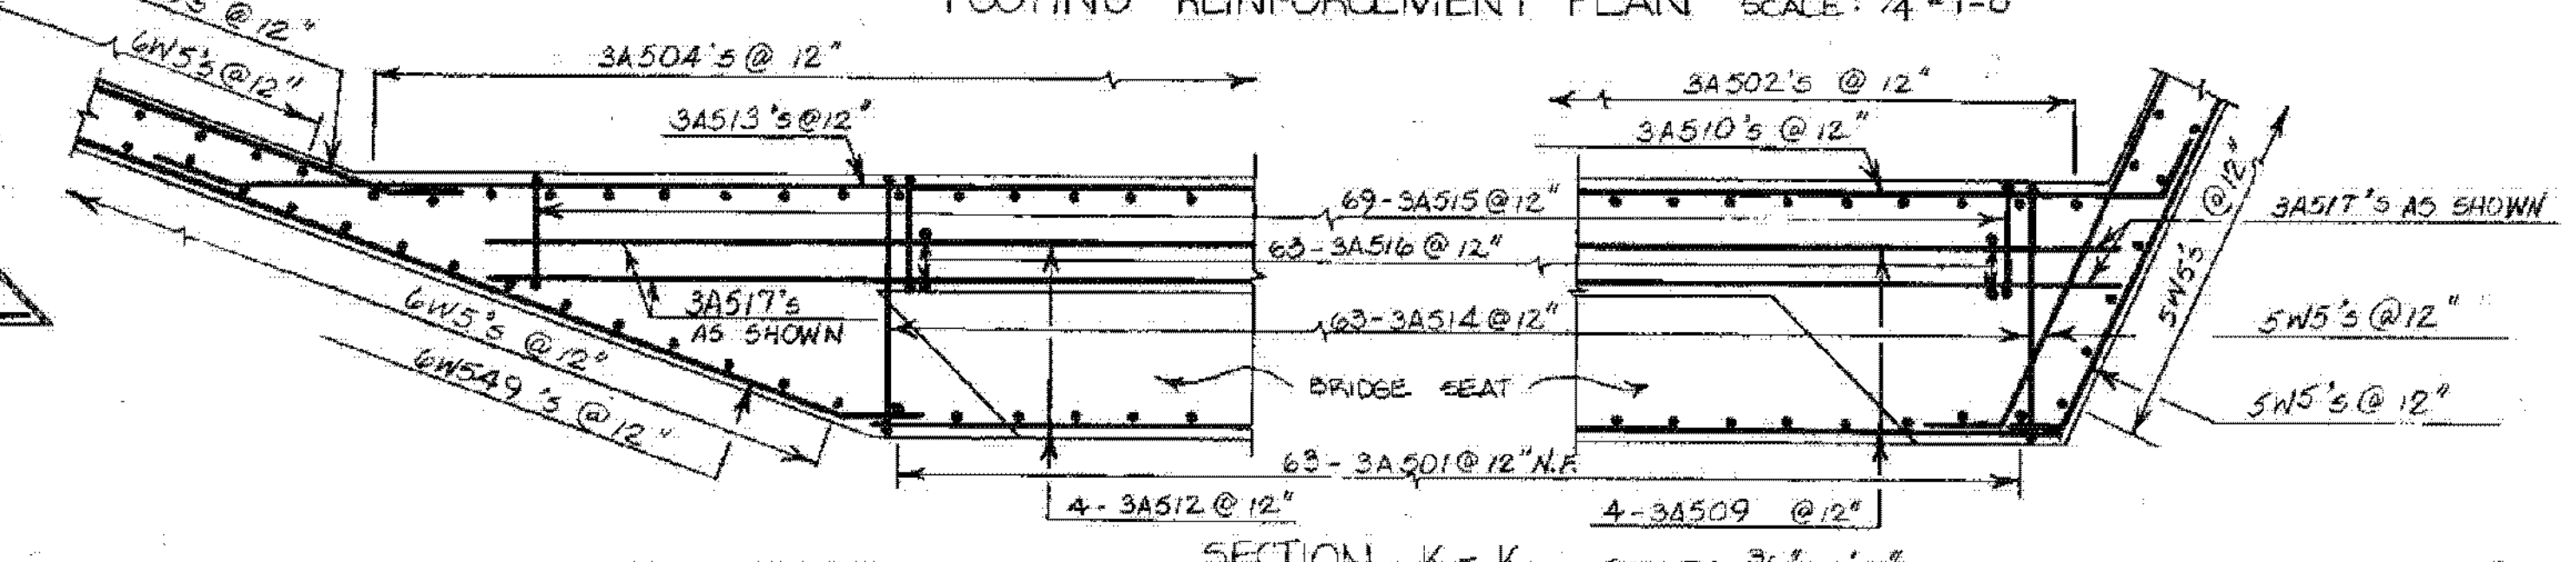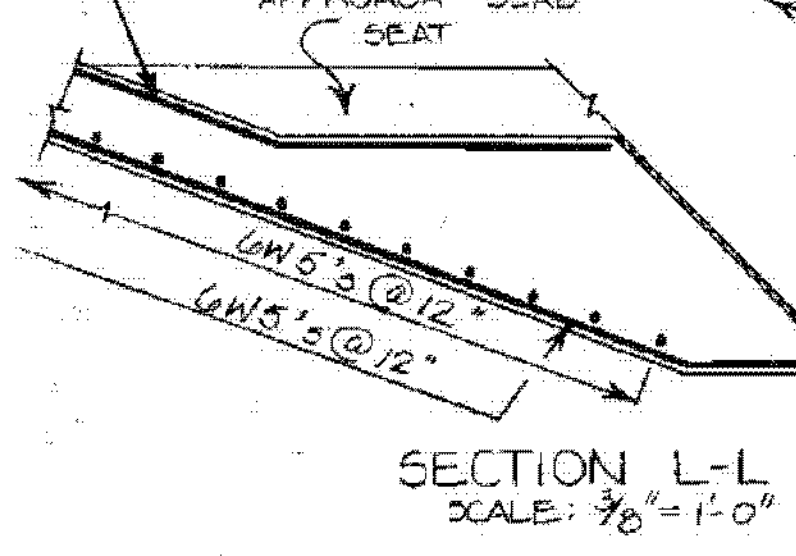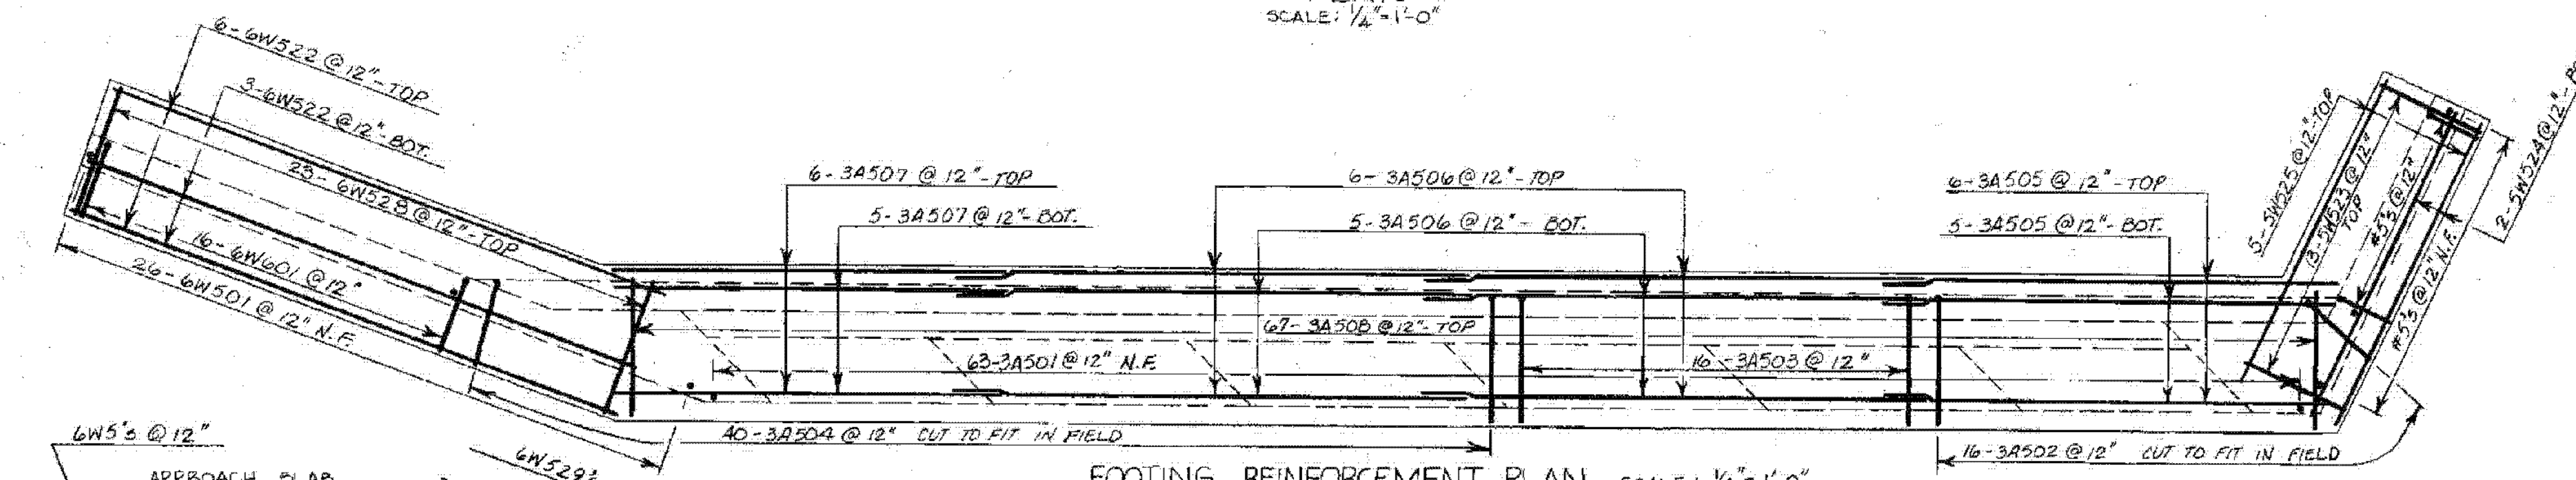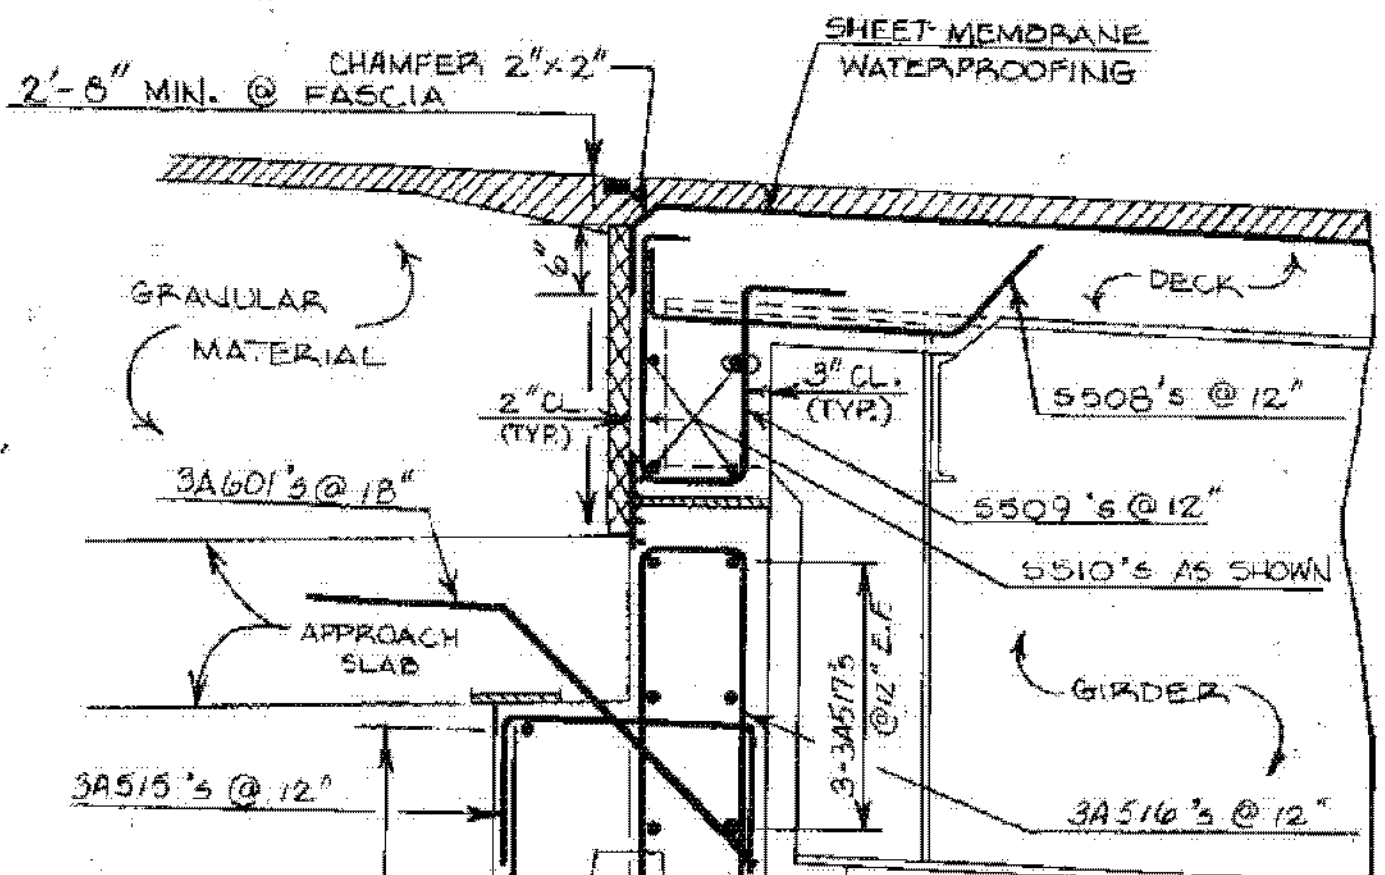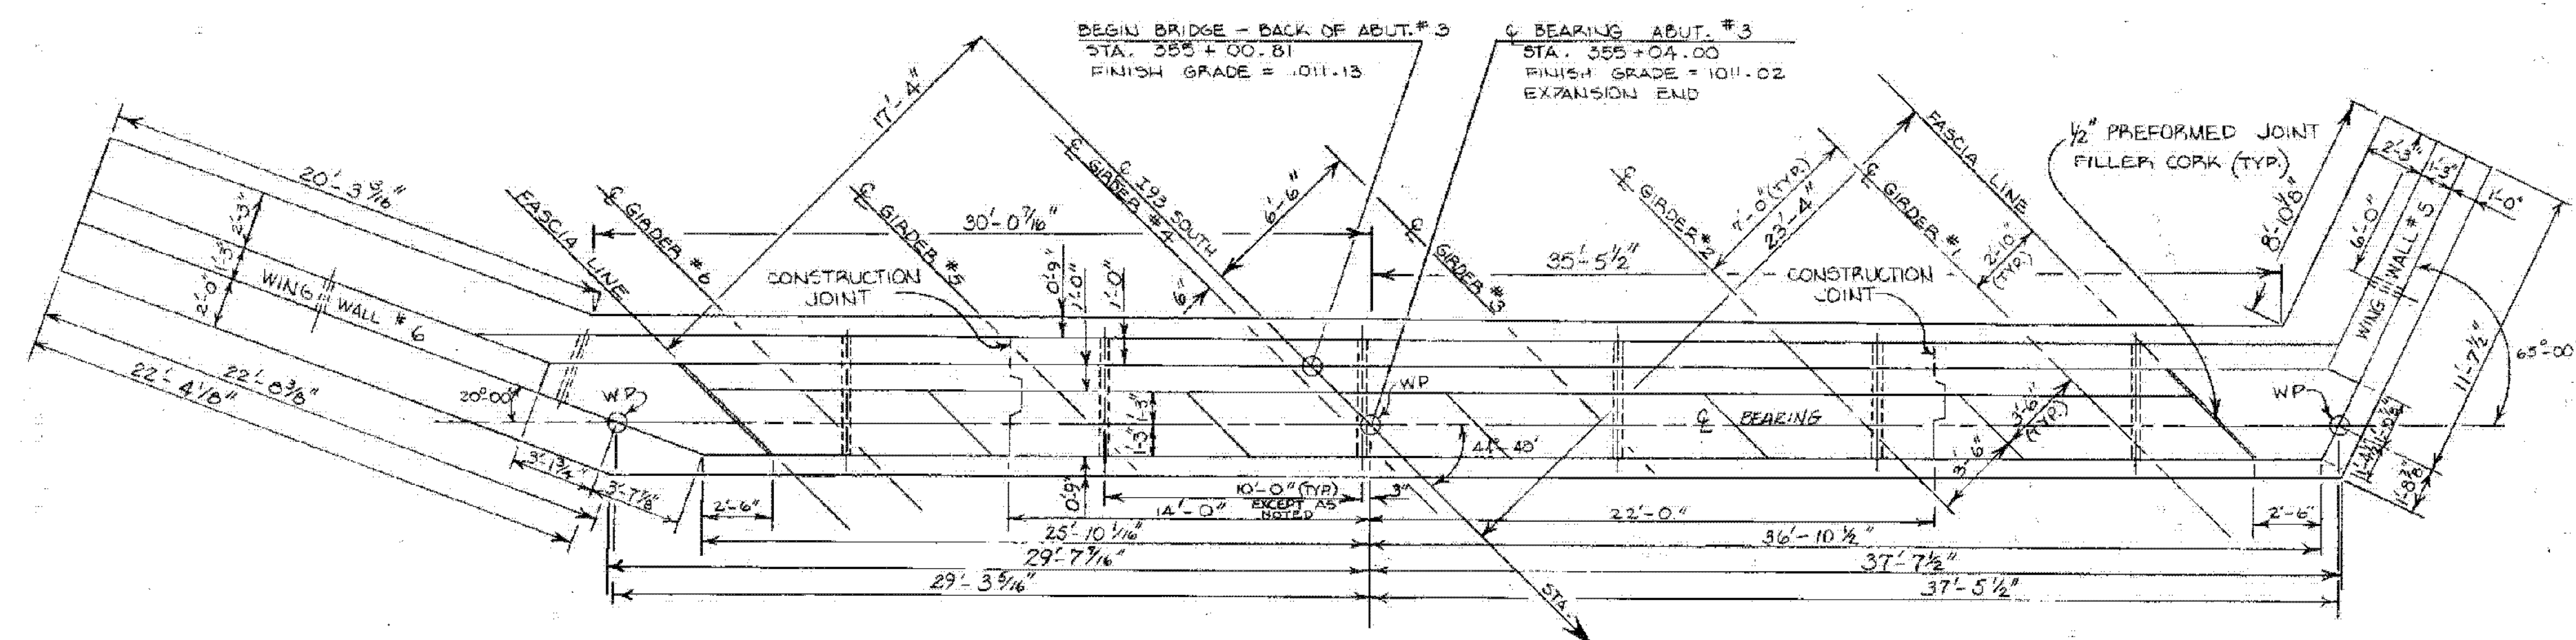


TYPICAL SECTION - ABUT. # 3
EXPANSION END
SCALE: 3/4" = 1'-0"

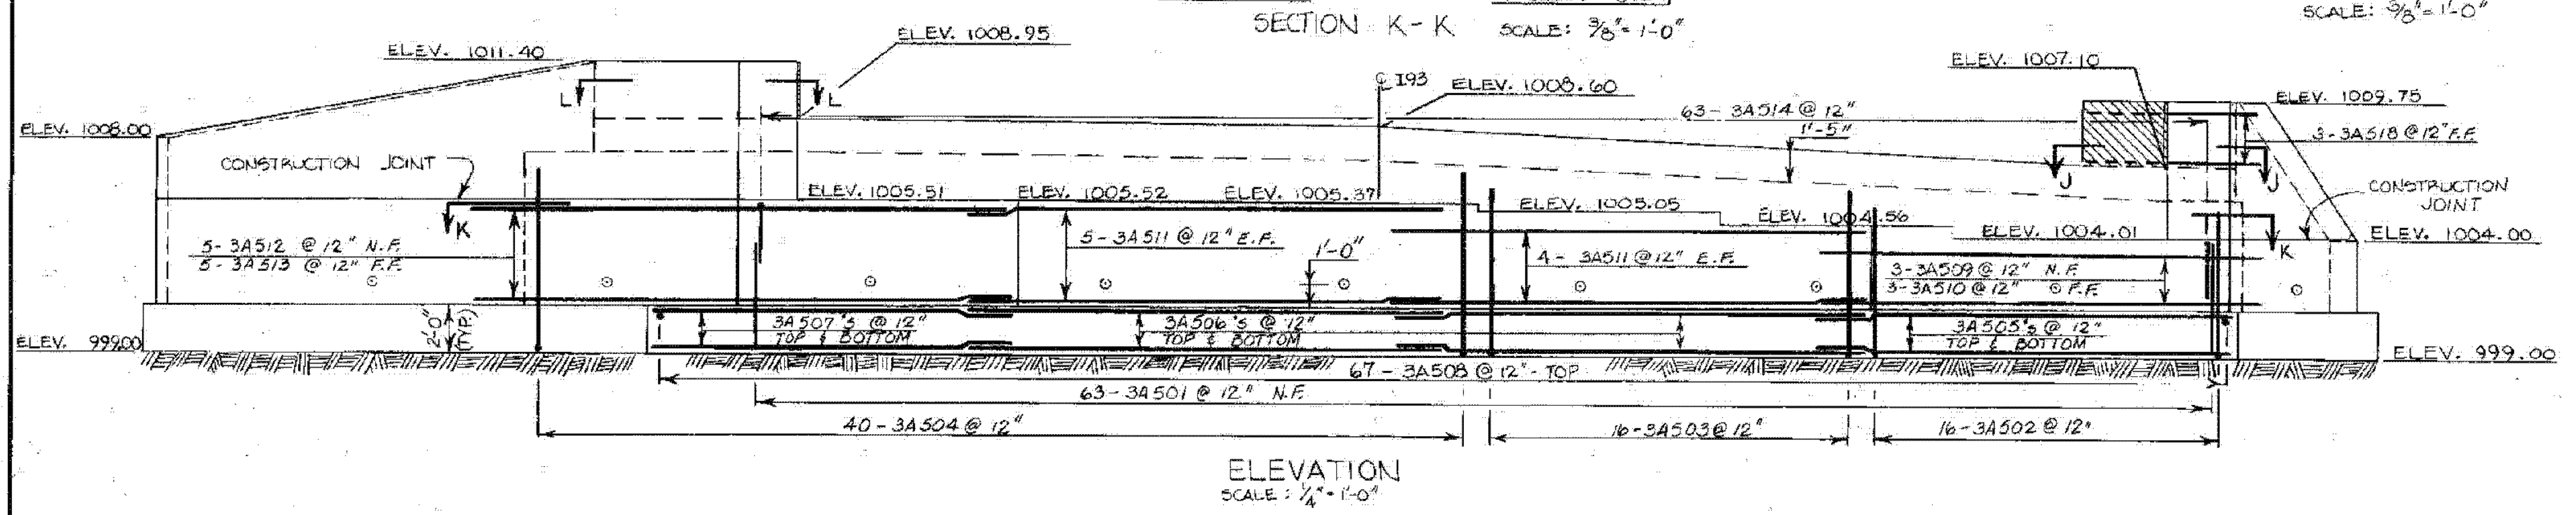

I-93 BRIDGES 5N&S
WATERFORD
IM MEMB(31)
SHEET 41 OF 48
FOR REFERENCE ONLY


**STATE OF VERMONT
AGENCY OF TRANSPORTATION**

TOWN OF WATERFORD	Bridge No. 57
HIGHWAY NO. I-93	Log Sta. Surv. Sta. 354+83
I 93 SOUTHBOUND OVER TH #7	
ABUTMENT NO. 3 DETAILS	
Designed by G. S. ROGERS	Drawn by G. L. DAVIS
Checked by G. S. ROGERS date 6-80	Bridge Design Supervisor F.W. Bolcum date 7/80
PROJECT WATERFORD	PROJECT NO. I93-1(3) CONTR. #2
Bridge Sheet No. 38712	Sheet 163 of 531

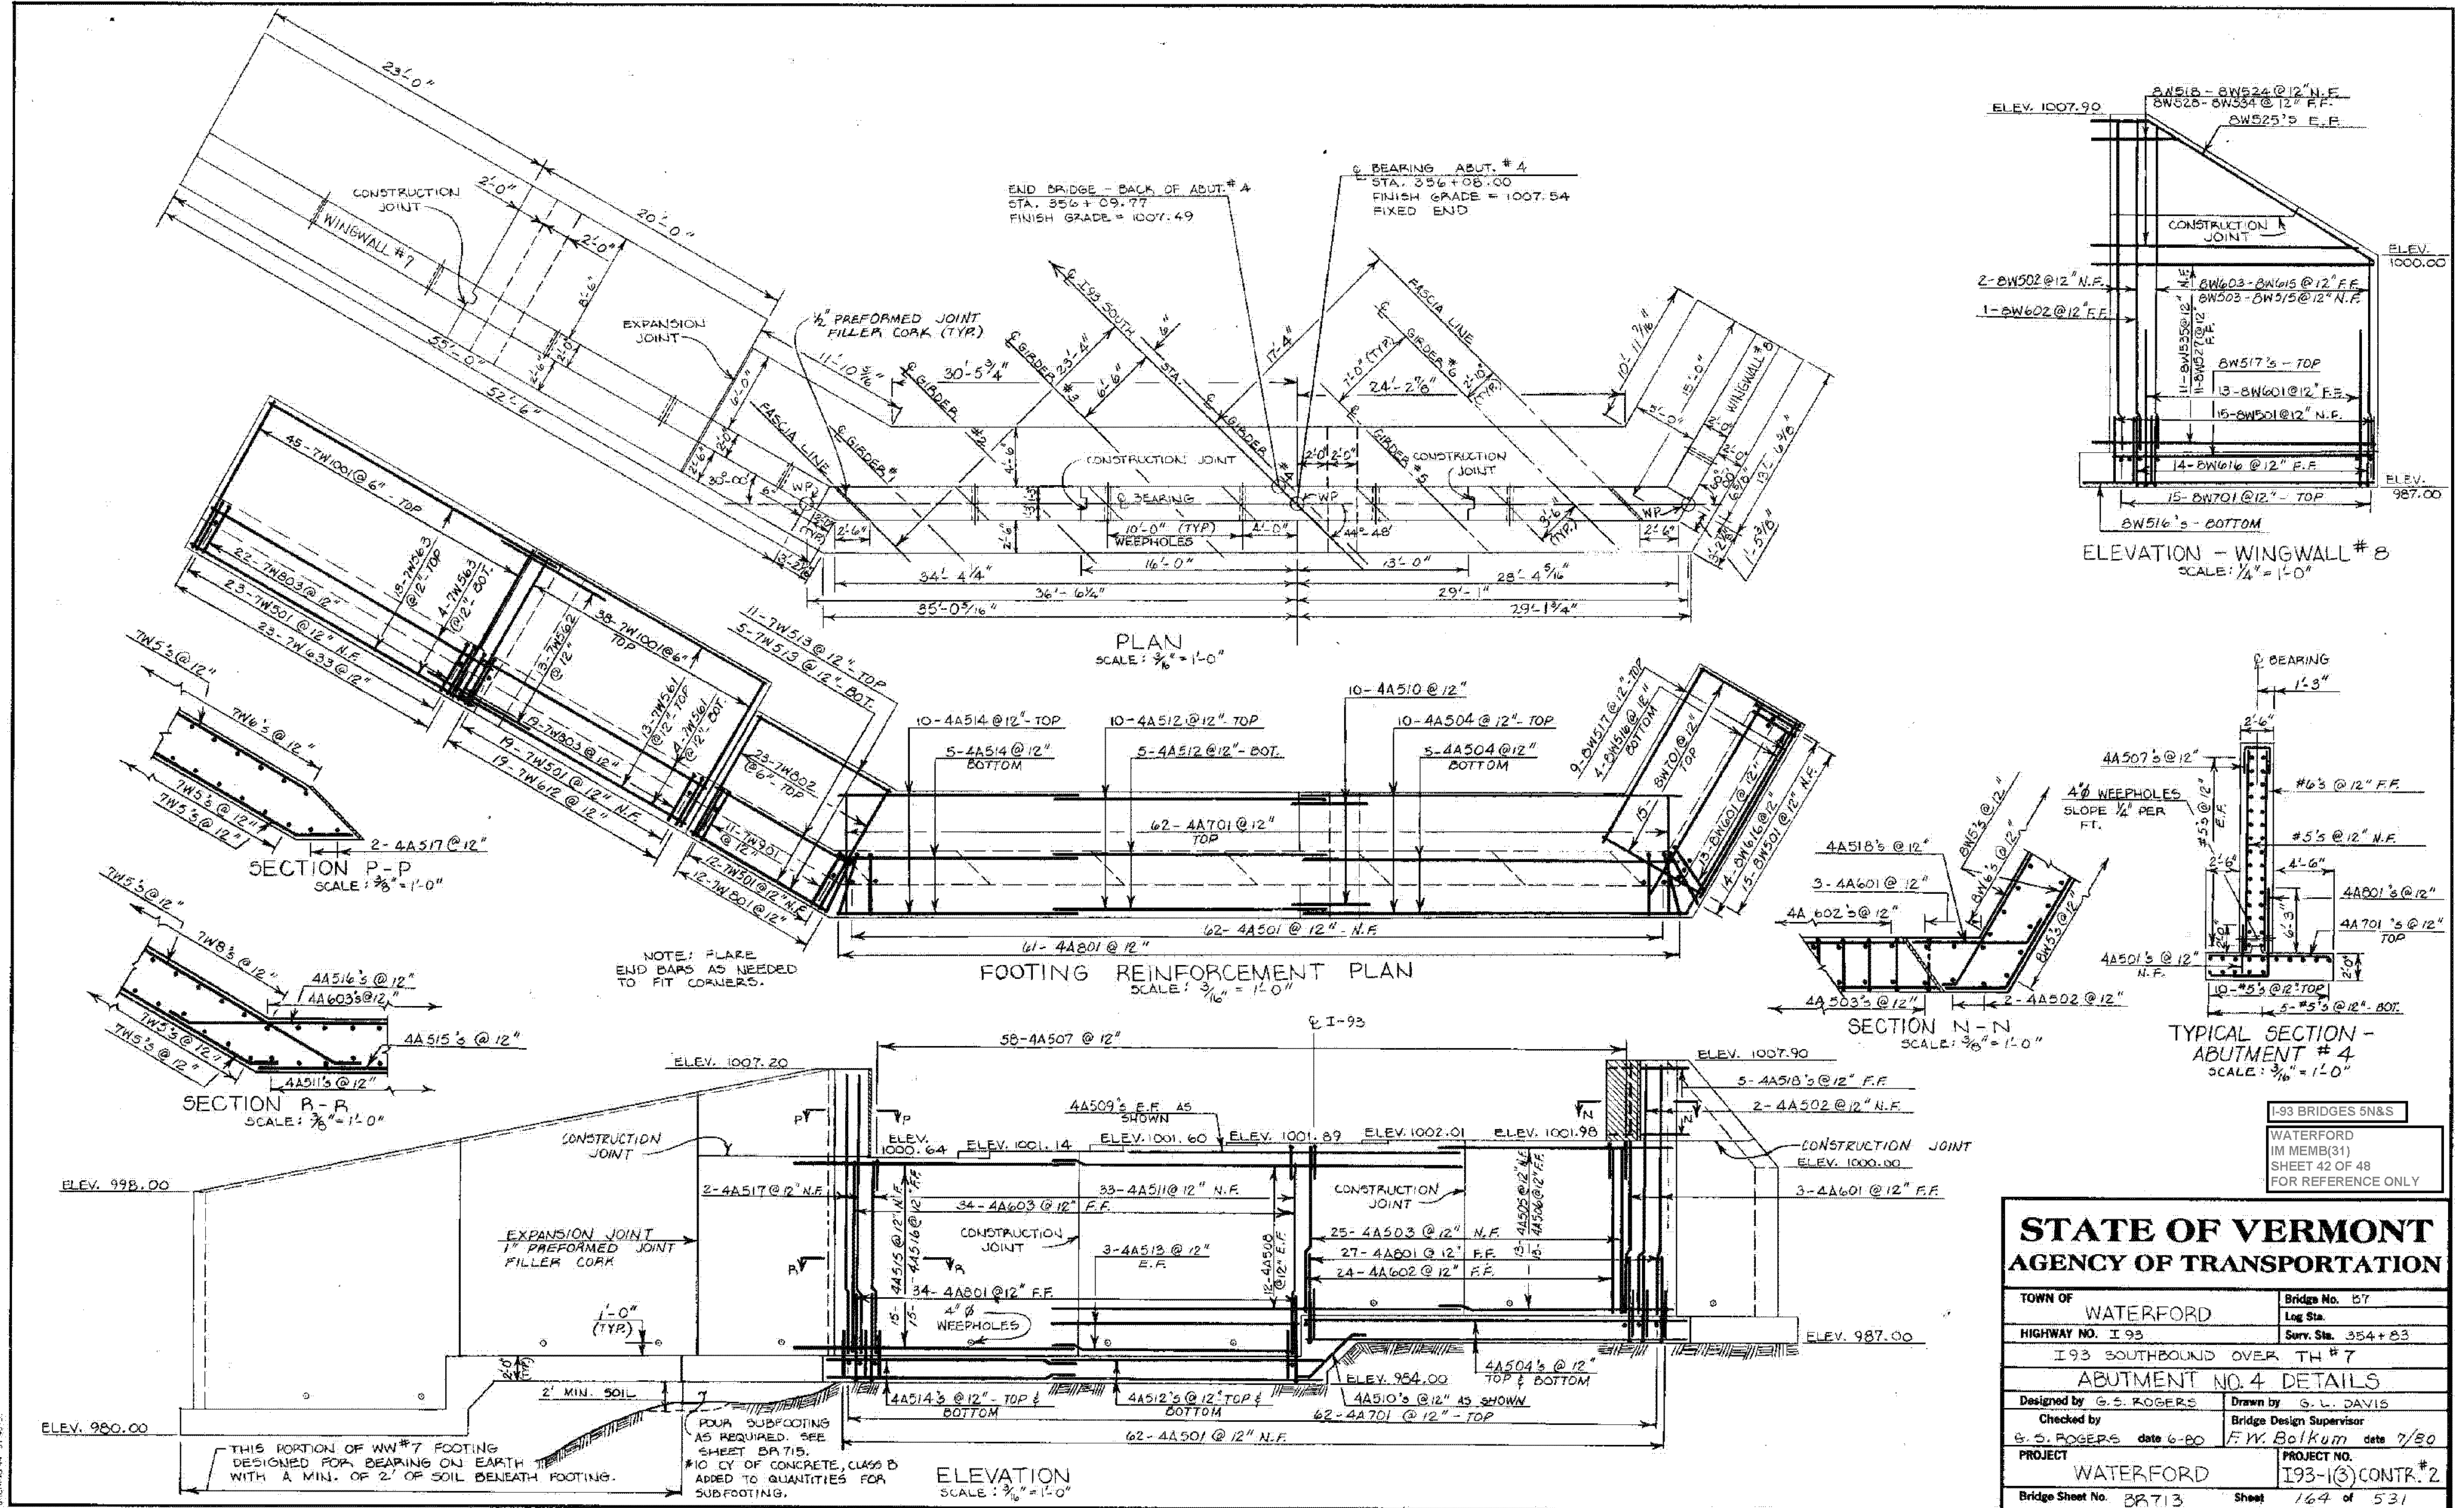


I-93 BRIDGES 5N&S
WATERFORD
IM MEMB(31)
SHEET 42 OF 48
FOR REFERENCE ONLY


STATE OF VERMONT AGENCY OF TRANSPORTATION	
TOWN OF WATERFORD	Bridge No. 87
HIGHWAY NO. I 93	Log Sta.
I 93 SOUTHBOUND OVER TH # 7	
ABUTMENT NO. 4 DETAILS	
Designed by G. S. ROGERS	Drawn by G. L. DAVIS
Checked by G. S. ROGERS date 6-80	Bridge Design Supervisor F. W. Bolcum date 7/80
PROJECT WATERFORD	PROJECT NO. I93-1(3) CONTR. # 2
Bridge Sheet No. 32713	Sheet 164 of 531

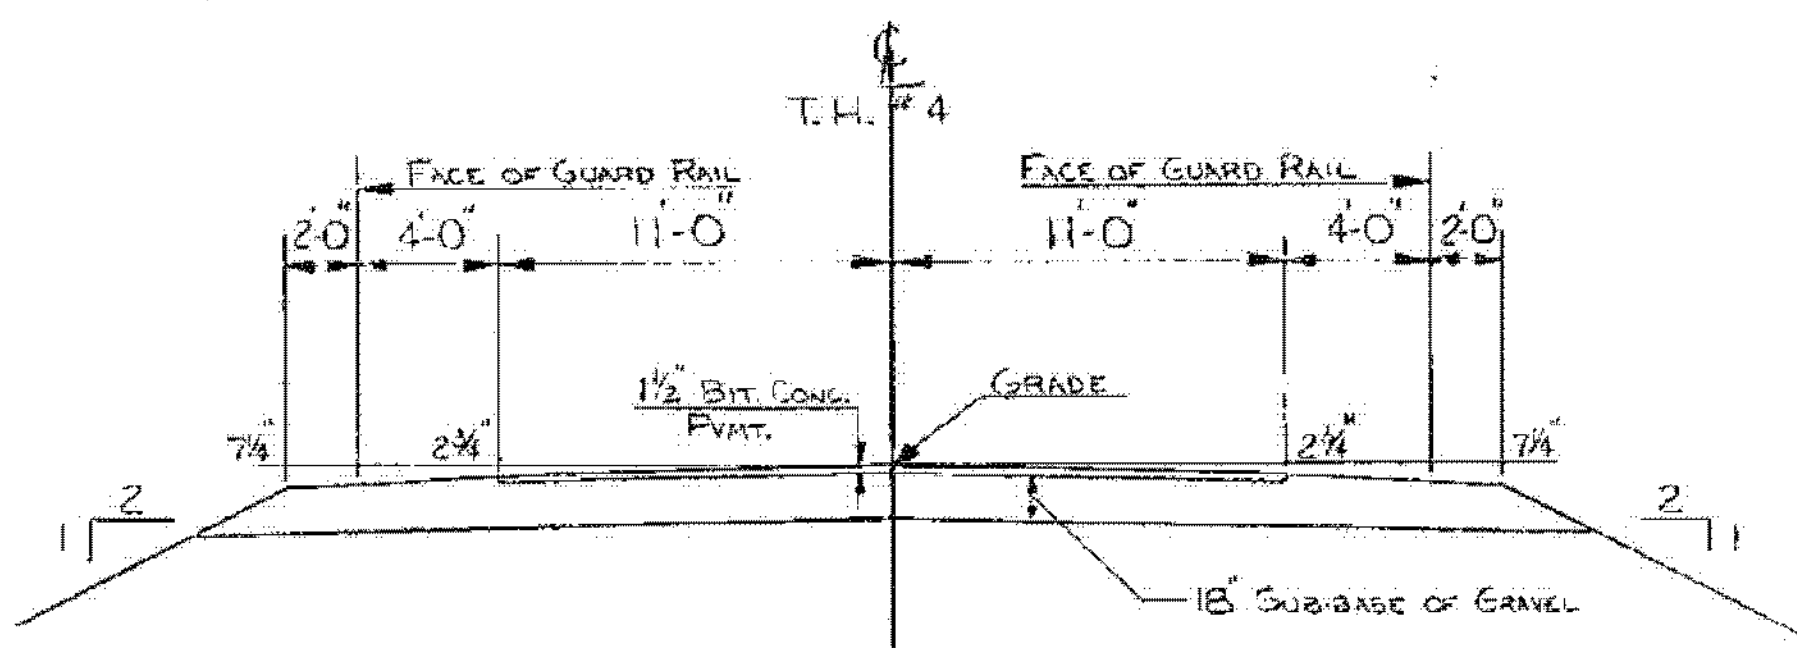


NEW HIGHWAY SECTION - BRIDGE APPROACHES
SCALE: 1" = 5'

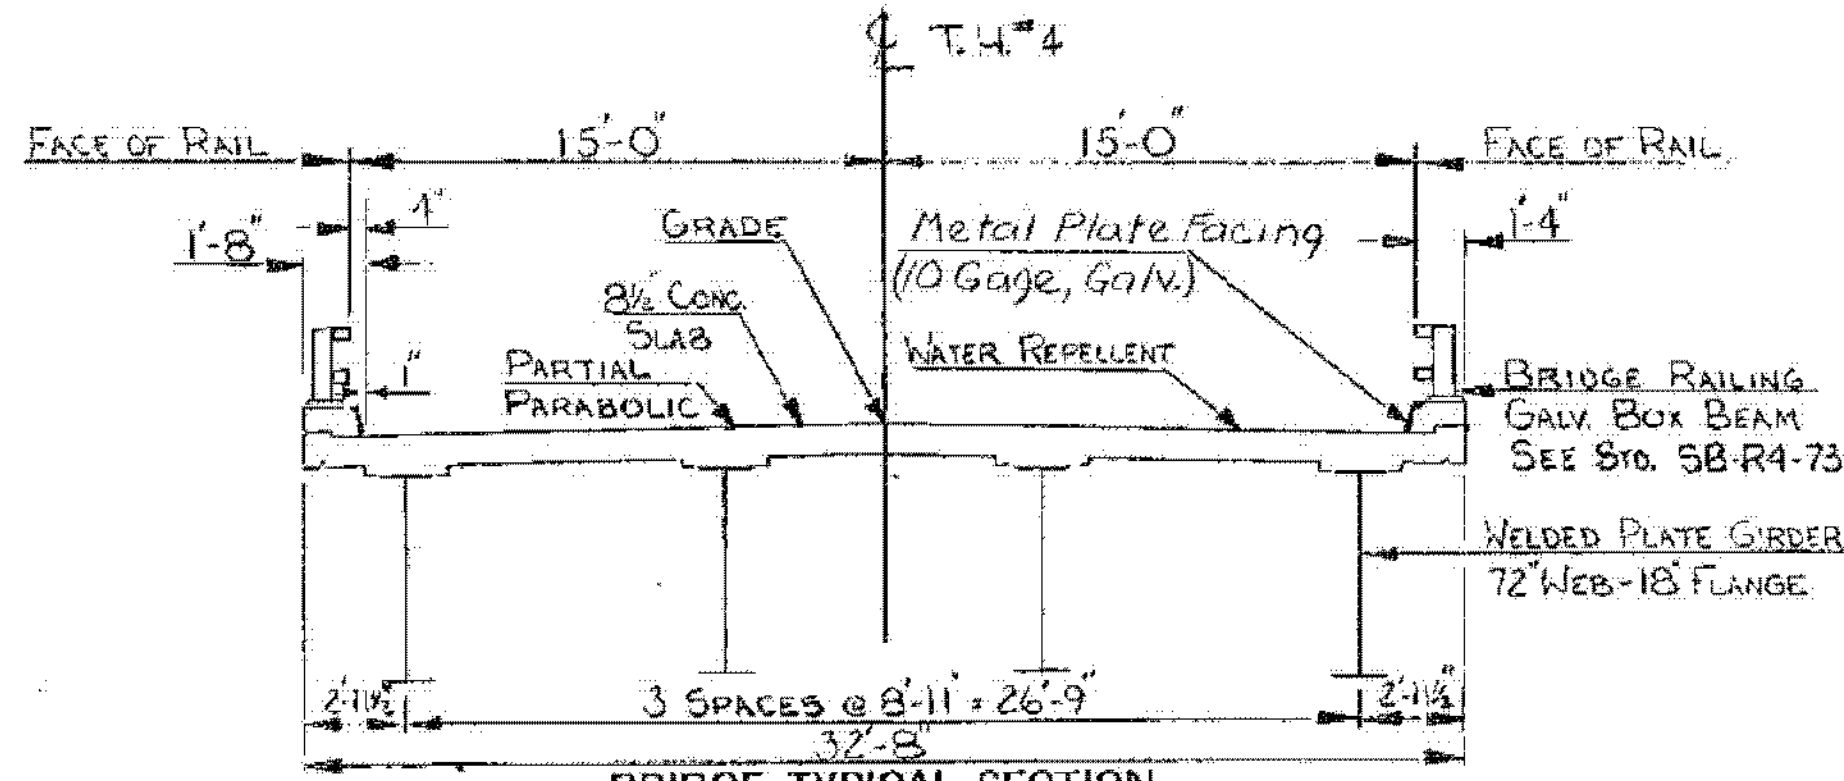


BRIDGE TYPICAL SECTION
SCALE: 1" = 5'

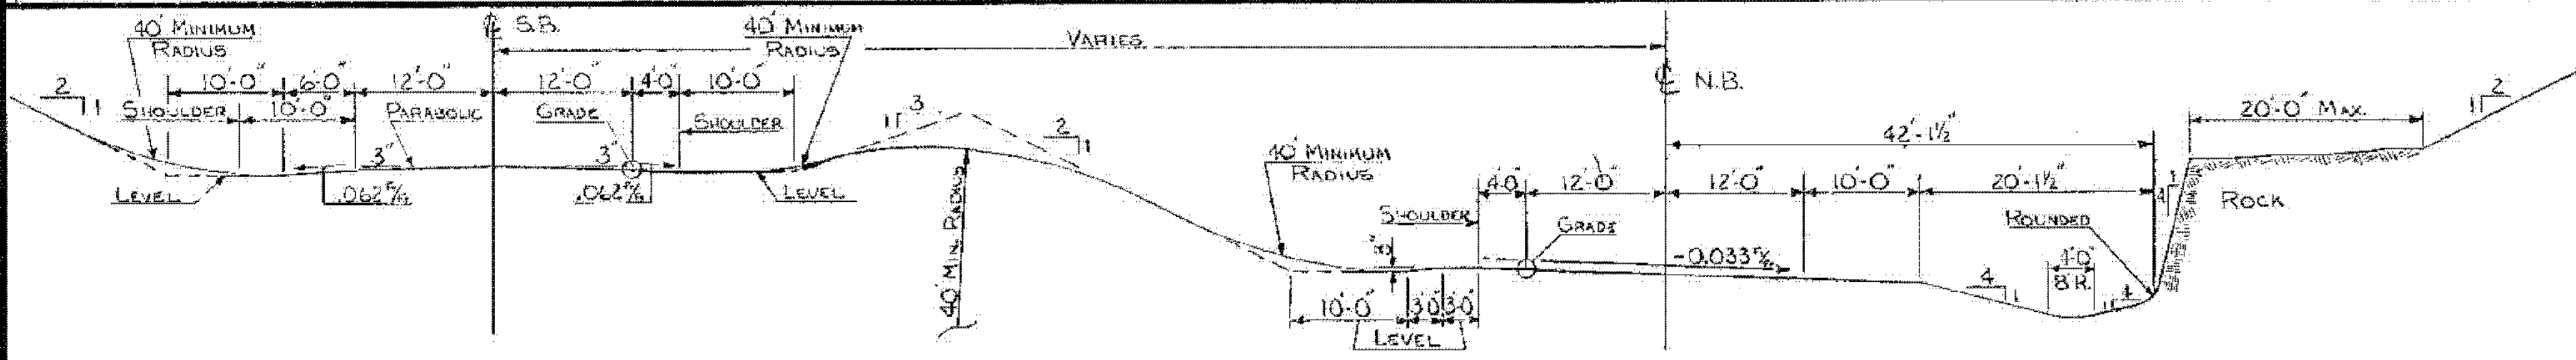



MODIFIED TYPICAL SECTION INTERSTATE 93 UNDER BRIDGE AT STA. 520+20.1
SCALE: 1" = 20'

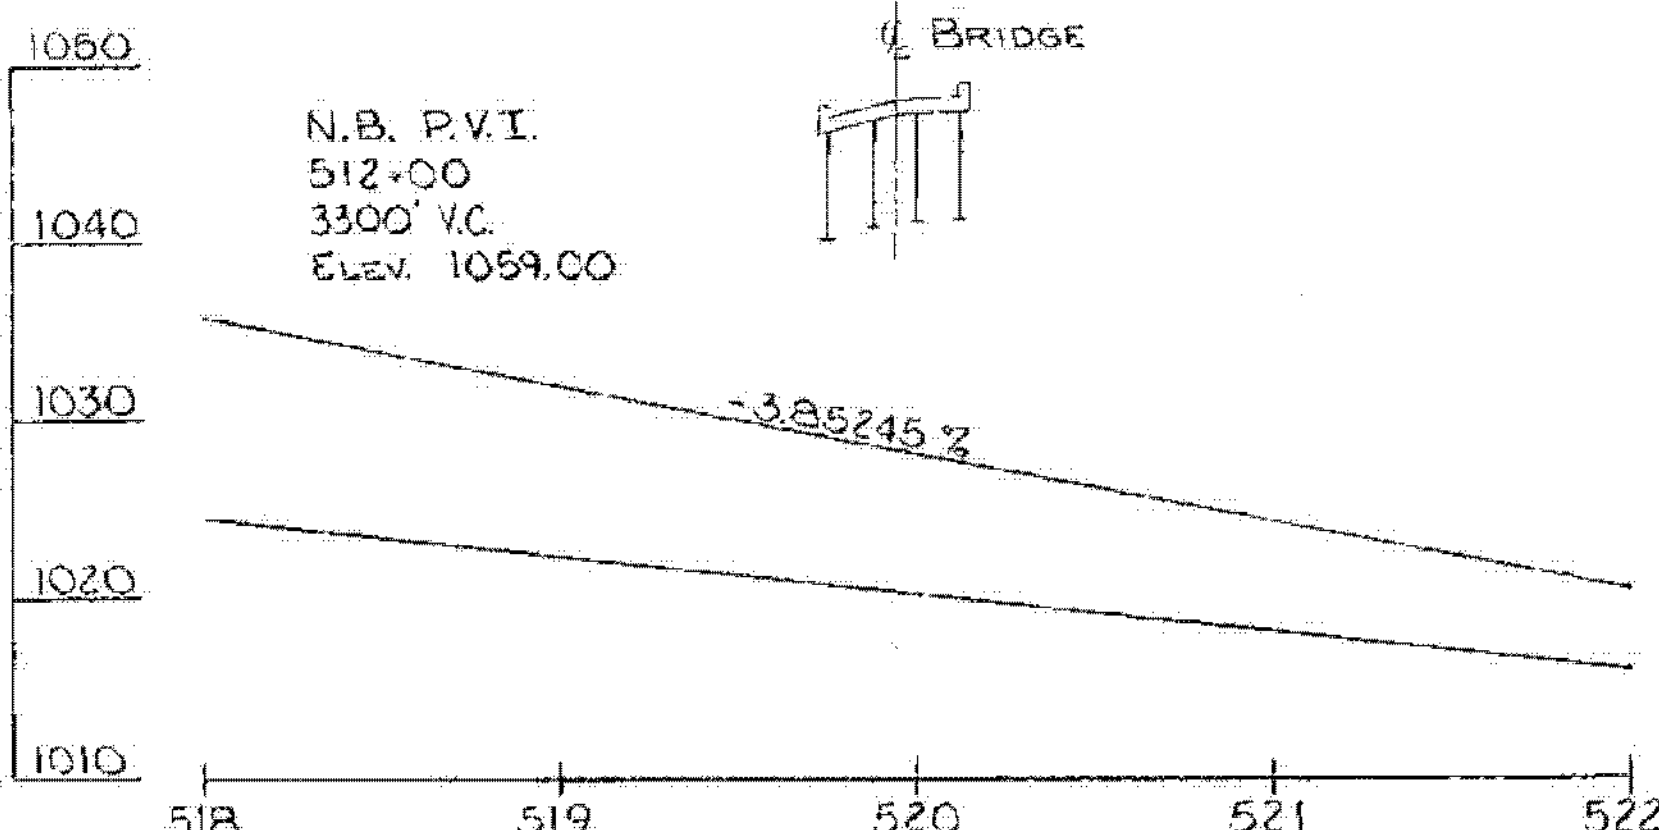

N.B. PROFILE I 93
SCALE: 1" = 50' HOR. 1" = 10' VERT.

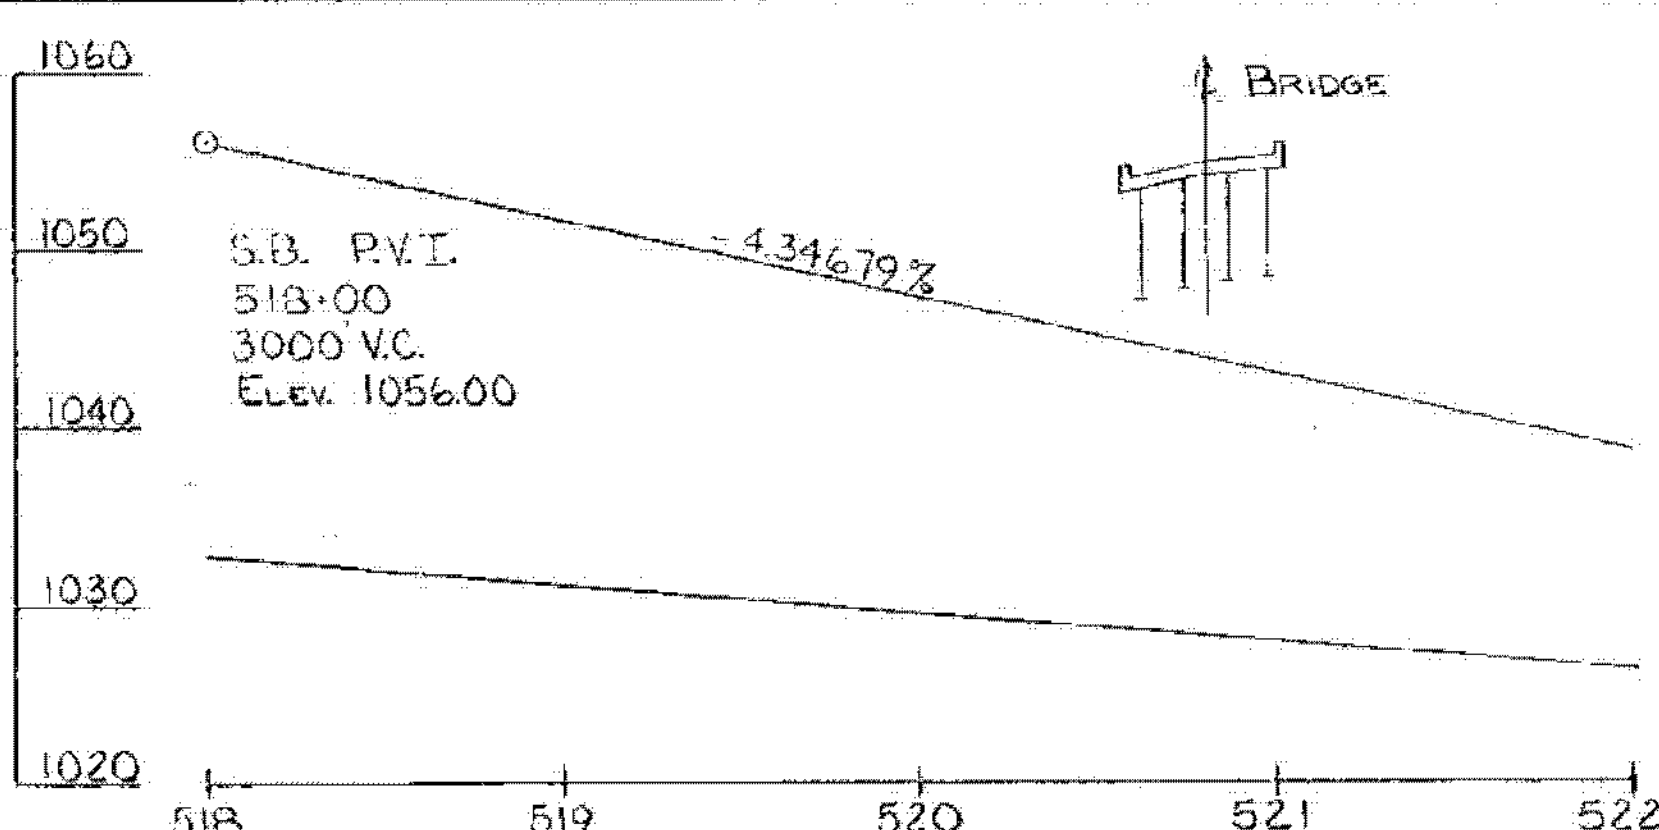

S.B. PROFILE I 93
SCALE: 1" = 50' HOR. 1" = 10' VERT.

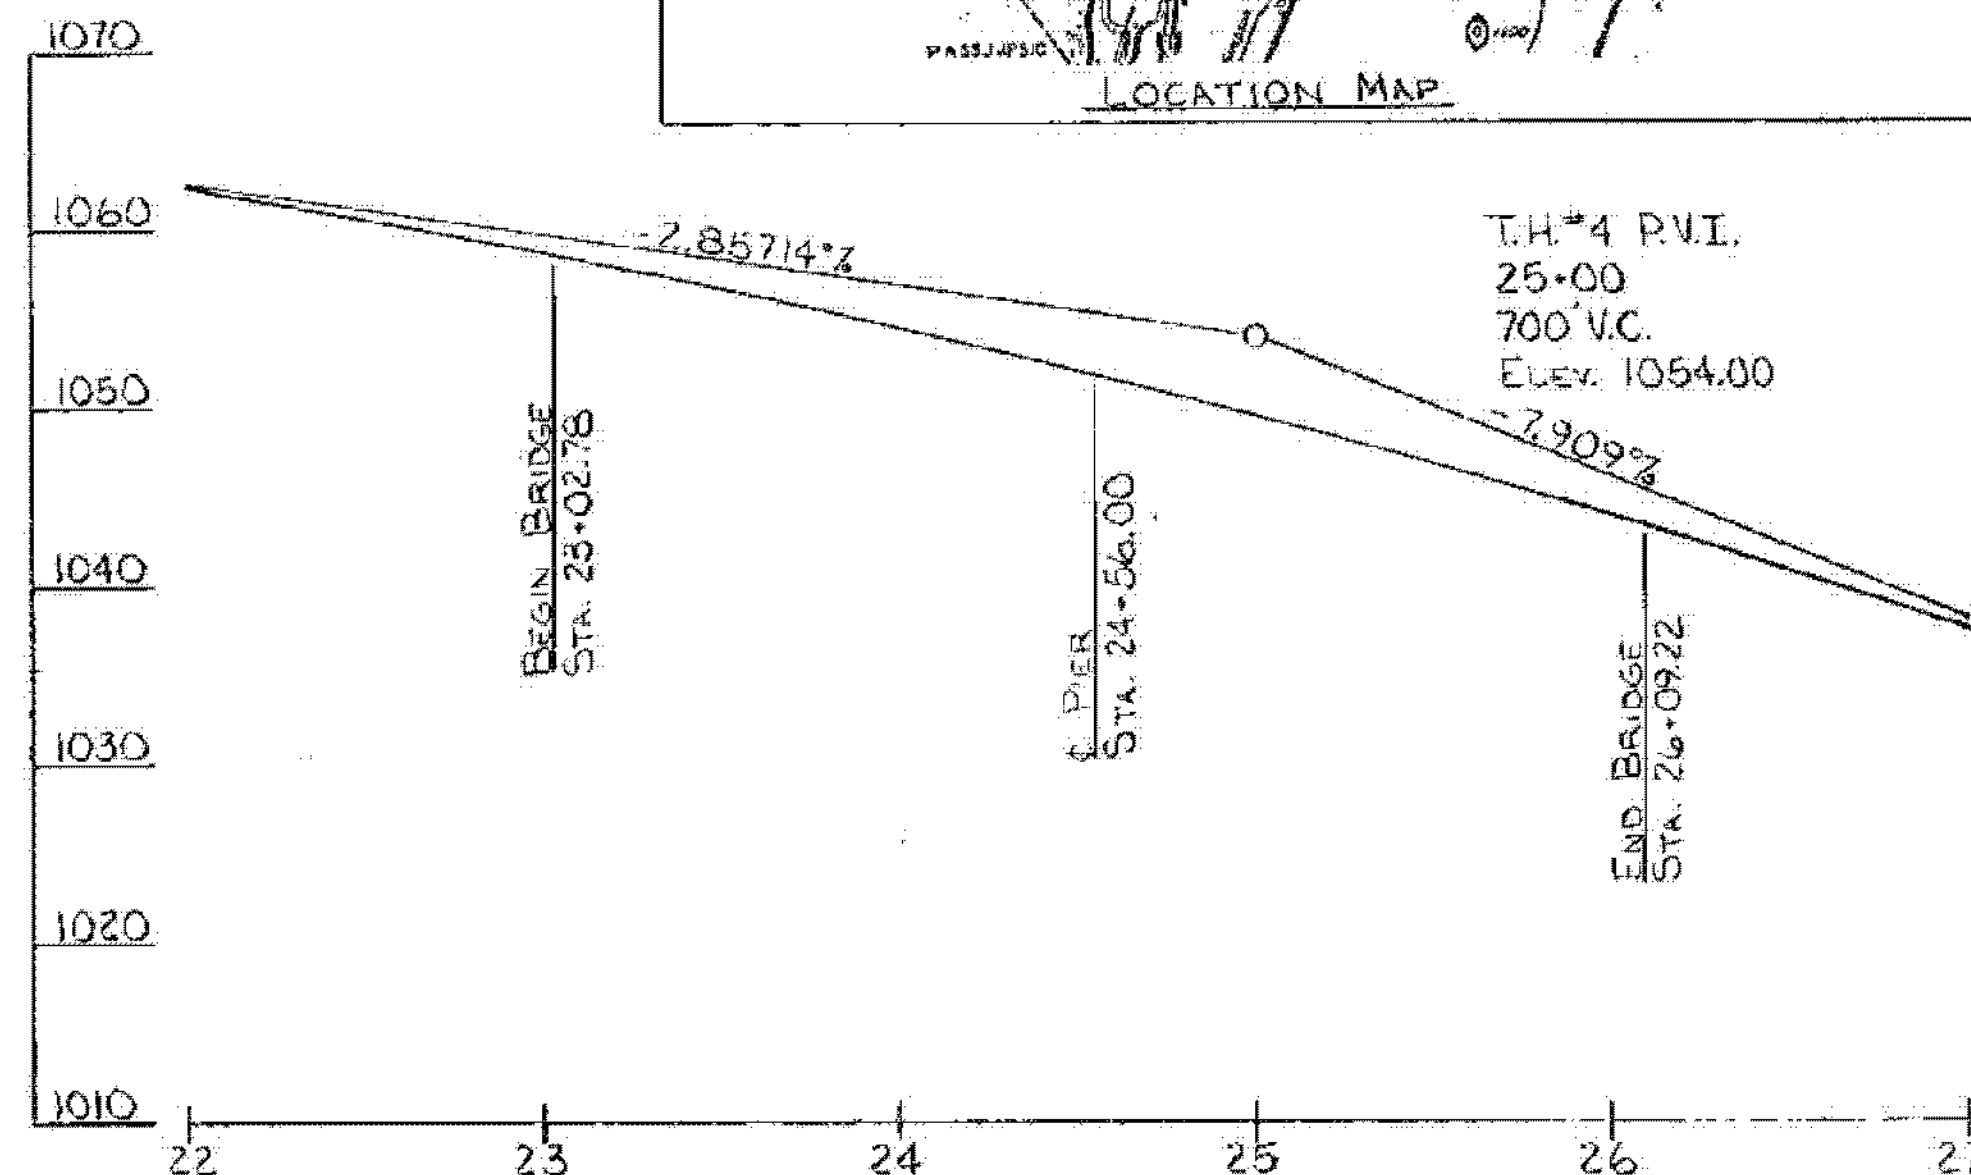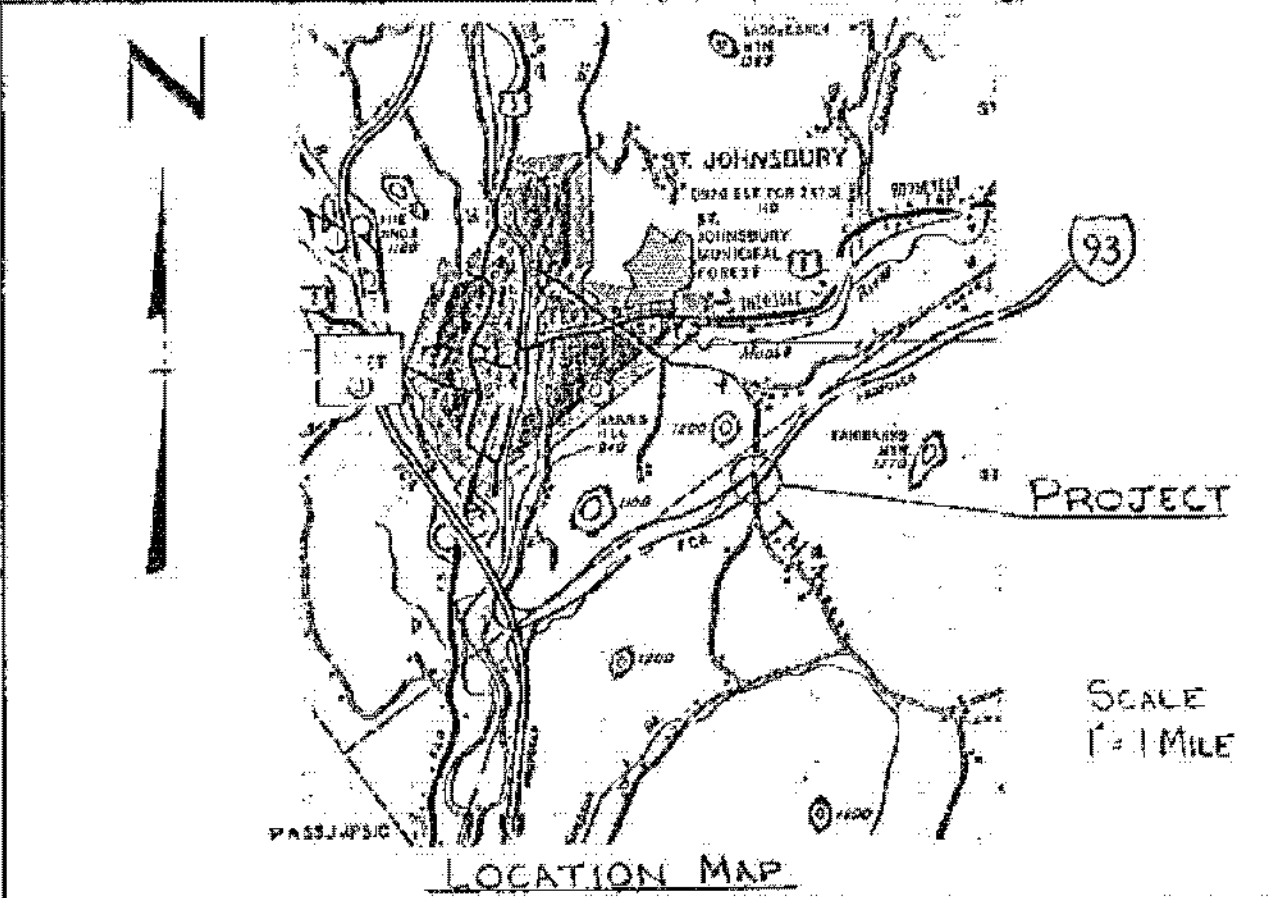

NEW HIGHWAY PROFILE ALONG TOWN HIGHWAY #4
SCALE: 1" = 50' HOR. 1" = 10' VERT.

EXISTING STRUCTURE	
1. STRUCTURE TYPE	OVERALL LENGTH
2. SPAN LENGTH(S) CENTER TO CENTER OF BEARINGS	INVENTORY RATING
3. CLEAR SPAN LENGTH(S) NORMAL TO STREAM	VERTICAL CLEARANCE ABOVE STREAMBED
4. WATERWAY AREA OF FULL OPENING (NORMAL TO STREAM)	WATER SURFACE ELEVATION @ Q
5. WATER SURFACE ELEVATION @ Q 2.33	ESTIMATED DISCHARGE
6. WATER SURFACE ELEVATION AT FLOOD OF RECORD	IF NOT, AT WHAT FREQUENCY AND ELEVATION DOES RELIEF OCCUR?
7. DOES ALL WATER PASS THROUGH EXISTING STRUCTURE?	ADDITIONAL WATERWAY AREA PROVIDED BY RELIEF
8. TYPE OF SUBSTRUCTURE FOUNDATION MATERIAL	
9. DISPOSITION OF STRUCTURE	

NEW STRUCTURE	
1. STRUCTURE TYPE	OVERALL LENGTH
2. SPAN LENGTH(S) CENTER TO CENTER OF BEARINGS	
3. VERTICAL CLEARANCE ABOVE STREAMBED OR ROAD UNDER	
4. CLEAR SPAN LENGTH(S) NORMAL TO STREAM	
5. WATERWAY AREA OF FULL OPENING (NORMAL TO STREAM)	
6. ARE PROVISIONS TO BE MADE FOR PUBLIC UTILITIES?	

HYDRAULIC DATA:		
1. Q 2.33	WATER ELEVATION	VELOCITY
Q 10	WATER ELEVATION	VELOCITY
Q 25	WATER ELEVATION	VELOCITY
Q 50	WATER ELEVATION	VELOCITY
Q 100	WATER ELEVATION	VELOCITY
2. DRAINAGE AREA	CHARACTER OF TERRAIN	
3. ARE THERE OBJECTIONS TO A PIER IN THE STREAM?		
4. DOES STREAM REACH ITS MAXIMUM HIGH WATER ELEVATION RAPIDLY?	IS ORDINARY RISE RAPID?	
5. NATURE OF NATURAL STREAMBED		
6. ESTIMATED SCOUR DEPTH	COMMENT ON: DRIFT	ICE
7. WILL ALL WATER PASS THROUGH NEW STRUCTURE?	IF NOT, WHAT FREQUENCY AND ELEVATION WILL RELIEF OCCUR?	
8. VERTICAL CLEARANCE ABOVE Q		
9. ALLOWABLE WATER SURFACE ELEVATION	LIMITED BY	
10. IS DESIGN STAGE AFFECTED BY UPSTREAM OR DOWNSTREAM CONDITIONS?	IF YES, DESCRIBE	
11. AVERAGE DAILY LOW FLOW	AVERAGE DAILY HIGH FLOW	DEPTH
12. STREAMBANK OR CHANNEL PROTECTION REQUIRED		
13. DISTANCE TO EXISTING UPSTREAM STRUCTURE	SPAN	WATERWAY AREA OF FULL OPENING
14. DISTANCE TO EXISTING DOWNSTREAM STRUCTURE	SPAN	WATERWAY AREA OF FULL OPENING

ALLOWABLE STRESSES:	
1. DESIGN LIVE LOAD AASHTO	HS 20-44
2. ALLOWABLE LOAD FOR SPREAD FOOTINGS ON SOIL	TYPE HP 12-53 ON LEDGE 10'x5' ESTIMATED LENGTH 30'
3. ALLOWABLE LOAD FOR PILING	TYPE HP 12-53
4. ALLOWABLE STRESS FOR STRUCTURAL STEEL ASTM A-588	TENSION 27,000 PSI
5. ALLOWABLE STRESS FOR REINFORCING STEEL GRADE 60 TENSION	24,000 PSI COMPRESSION 20,000 PSI
6. ALLOWABLE STRESS FOR CONCRETE CLASS A	f _c 3500 f _t 1400
	CLASS B f _c 3500 f _t 1400

TRAFFIC MAINTENANCE:	
1. IS TRAFFIC TO BE MAINTAINED?	IF YES, ON EXISTING STRUCTURE N.A. OR ON TEMPORARY BRIDGE
2. TEMPORARY BRIDGE REQUIREMENTS: ONE OR TWO WAY	TRAFFIC CONTROL SIGNALS REQUIRED
	MINIMUM CLEAR SPAN
	MINIMUM CLEAR HEIGHT
	MINIMUM WATERWAY AREA
	ARE SIDEWALKS REQUIRED? IF SO, ON WHAT SIDE?

INDEX OF BRIDGE SHEETS		STANDARD SHEETS	
BR. 1600	PRELIMINARY INFORMATION SHEET	SB-R4-75	CALVANIZED BOX BEAMS (NOV. 21, 1979 R)
BR. 1601	BRIDGE QUANTITY SHEET	SCB-01-75	GENERAL INFORMATION (APRIL 3, 1978 R)
BR. 1602	PLAN & ELEVATION (GENERAL NOTES)	SCB-06-75	SCUppers, JOINTS, PILING DETAILS A, B, C, D, & E (JAN. 3, 1979 R)
BR. 1603	BORING LOGS	SCB-07-71	DRIP PLATE, HAUNCH, STUDS DETAILS C & F (DEC. 15, 1976 R)
BR. 1604	SUBSTRUCTURE DETAILS		
BR. 1605	FRAMING PLAN & GIRDER ELEVATION		
BR. 1606	CROSS FRAME & SPLICE DETAILS		
BR. 1607	BEARING DEVICES & DETAILS		
BR. 1608	EXPANSION JOINT DETAILS		
BR. 1609	BRIDGE APPROACH RAIL DETAILS		
BR. 1610	ABUTMENT NO. 1 DETAILS		
BR. 1611	ABUTMENT NO. 2 DETAILS		
BR. 1612	ABUTMENT NOS. 1 & 2 DETAILS		
BR. 1613	PIER DETAILS		
BR. 1614-1615	REINFORCING STEEL SCHEDULES		

STRESS LEVELS	LOAD RATING (TONS)					
	H	HS	392	5 AXLE	5A STR.	5A SEMI
INVENTORY	40	42				
0.55 F _y - POSTED	60	71		62	63	68
0.67 F _y - OPERATING			89	98		
0.75 F _y - OPERATING						

RECOMMENDED FOR APPROVAL	W.M. Smith	1-30-80
	STRUCTURES ENGINEER	DATE
RECOMMENDED FOR APPROVAL	Robert J. ...	1-30-80
	CHIEF OF DESIGN	DATE
APPROVED BY	J. J. Geage	1/30/80
	DIRECTOR OF ENGINEERING & CONSTRUCTION	DATE

REVISIONS		
NO.	DESCRIPTION	BY & DATE

STATE OF CONNECTICUT
AGENCY OF TRANSPORTATION

TOWN OF WATERFORD
HIGHWAY NO. I 93

Bridge No. B-16
Log Sta. 520+18


T.H. #4 OVER I-93

PRELIMINARY INFORMATION

Designed by N. DANFORTH
Checked by M. GARCIA date 1-30
PROJECT WATERFORD

Drawn by W. FLANDERS
Bridge Design Supervisor F.W. Bolkom date 1/80
PROJECT I 93-1(13)C-3

Bridge Sheet No. BR 1600 Sheet 139 of 330

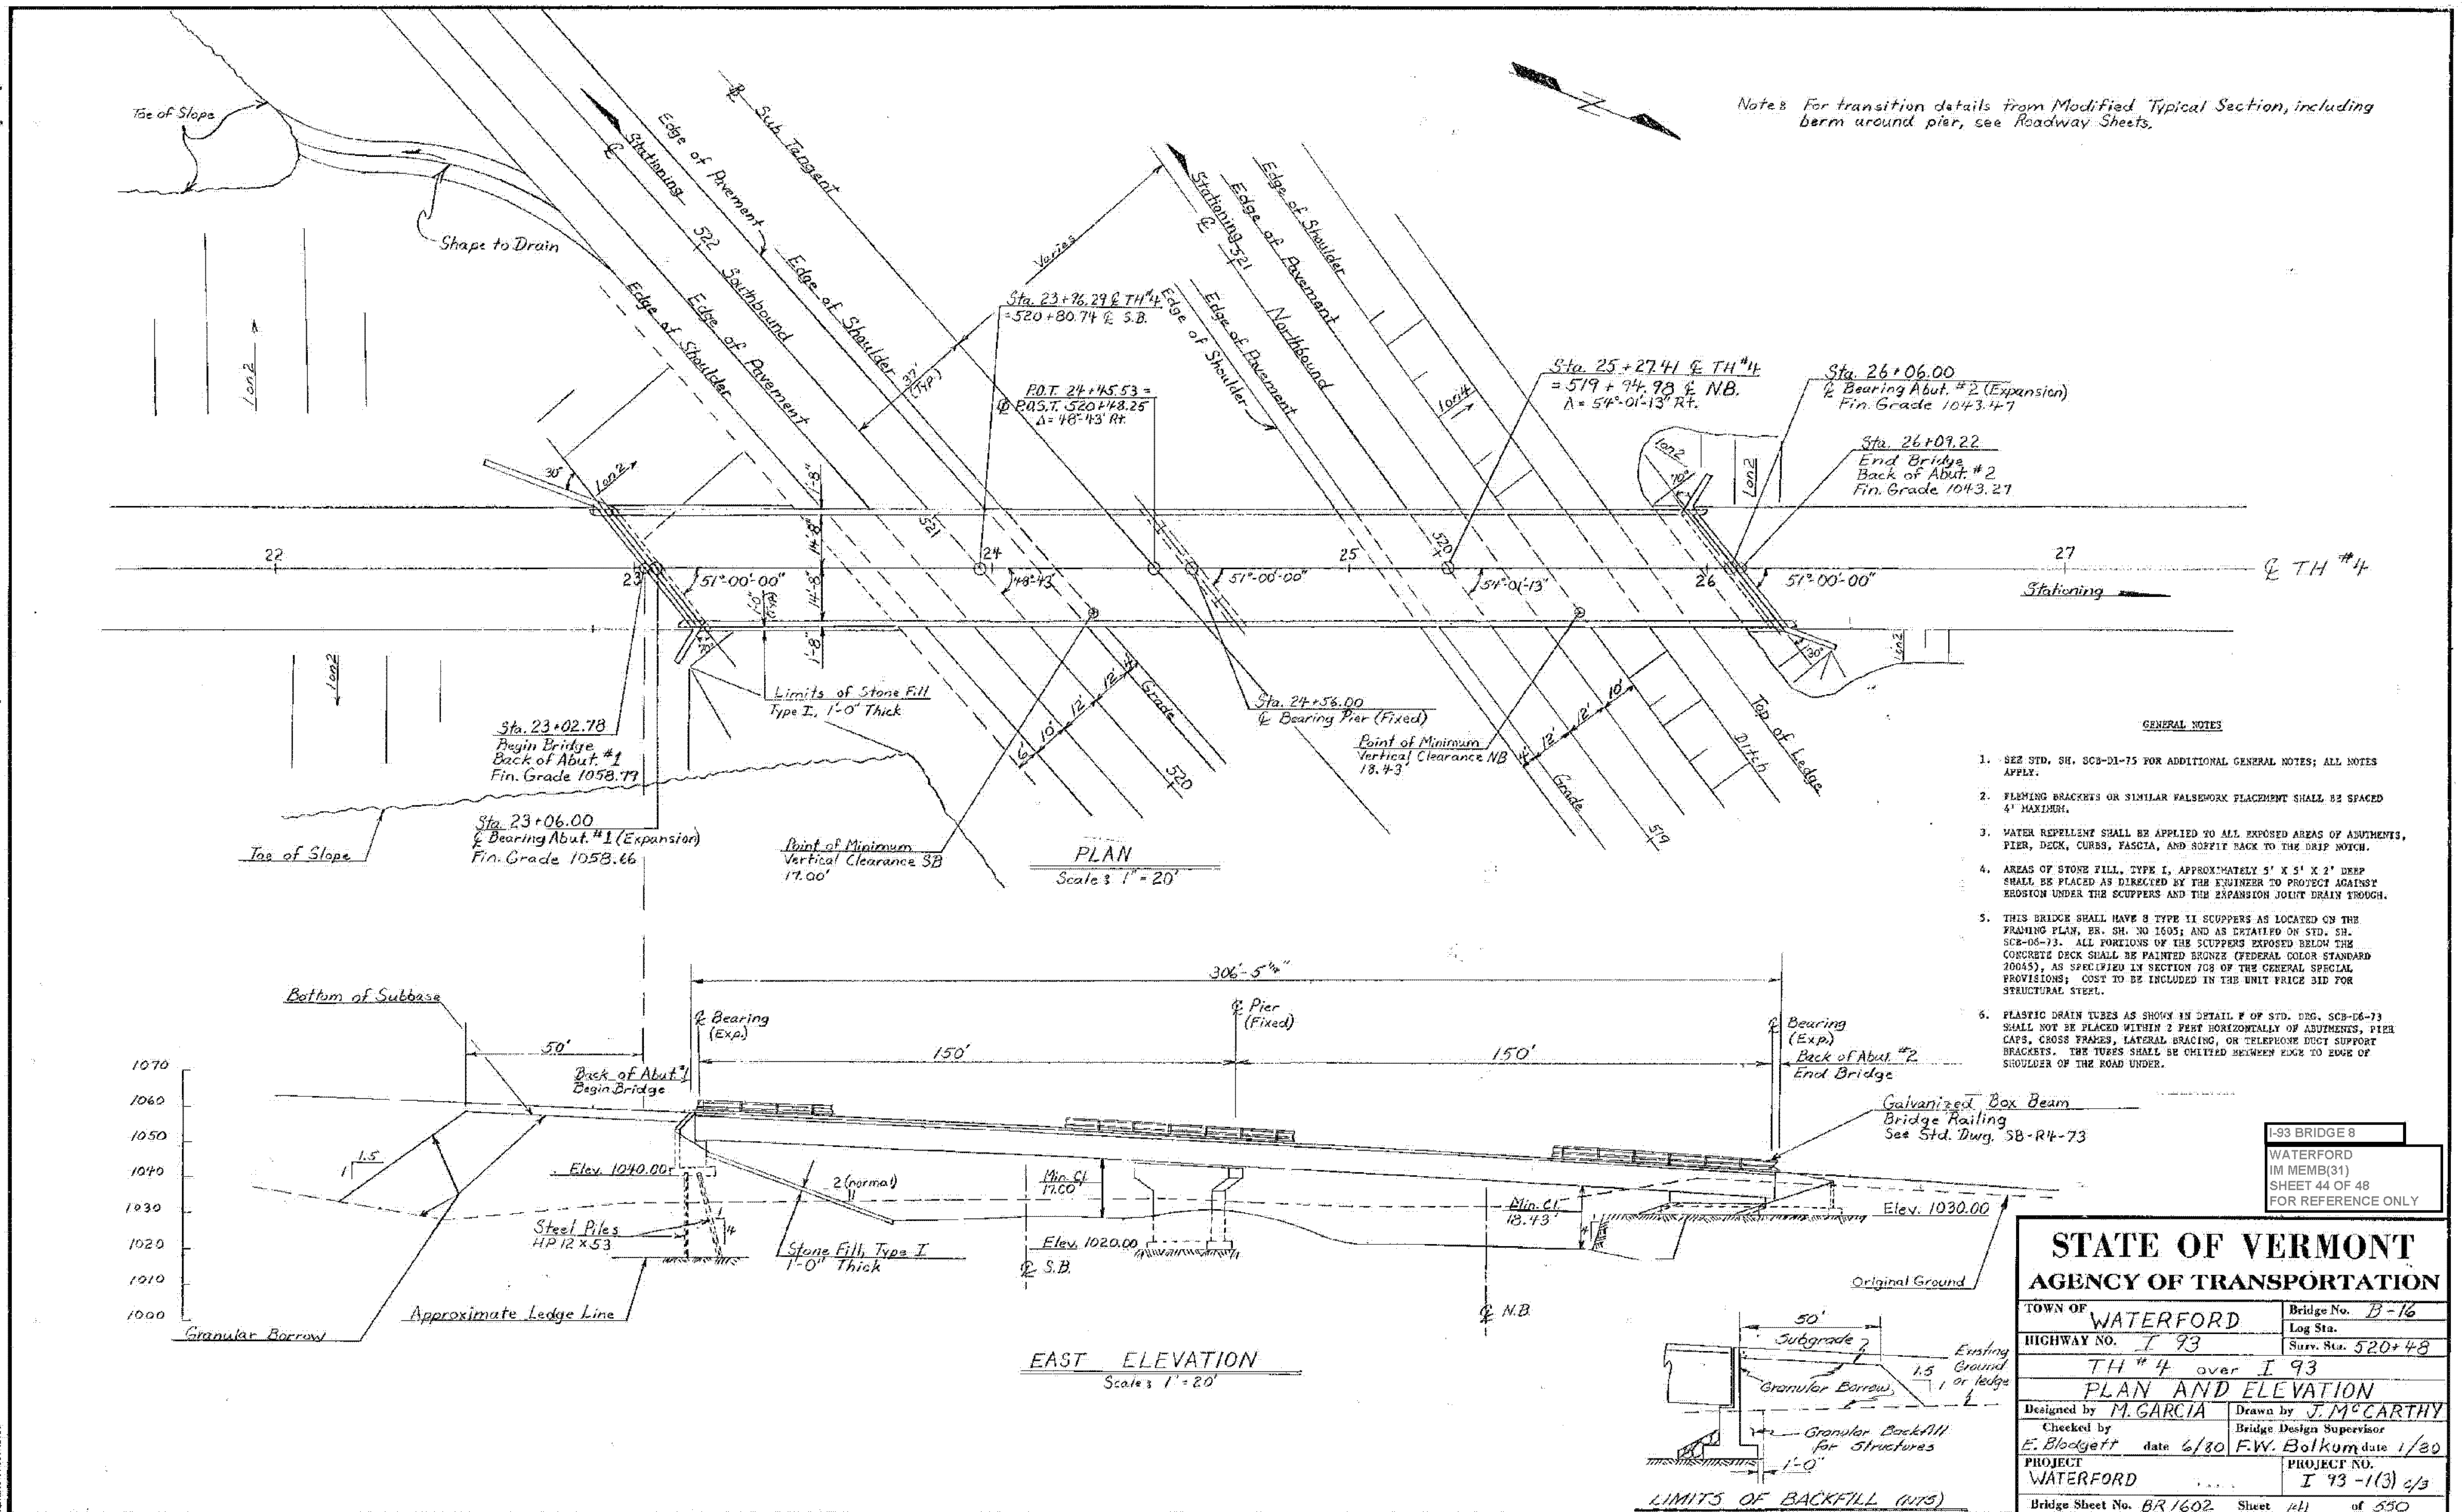

Notes: For transition details from Modified Typical Section, including berm around pier, see Roadway Sheets.


GENERAL NOTES

- SEE STD. SH. SCB-DI-75 FOR ADDITIONAL GENERAL NOTES; ALL NOTES APPLY.
- FLEMING BRACKETS OR SIMILAR FALSEWORK PLACEMENT SHALL BE SPACED 4' MAXIMUM.
- WATER REPELLENT SHALL BE APPLIED TO ALL EXPOSED AREAS OF ADJUSTMENTS, PIER, DECK, CURBS, FASCIA, AND SCUPPER BACK TO THE DRIP NOTCH.
- AREAS OF STONE FILL, TYPE I, APPROXIMATELY 5' X 5' X 2' DEEP SHALL BE PLACED AS DIRECTED BY THE ENGINEER TO PROTECT AGAINST EROSION UNDER THE SCUPPERS AND THE EXPANSION JOINT DRAIN TROUGH.
- THIS BRIDGE SHALL HAVE 8 TYPE II SCUPPERS AS LOCATED ON THE FRAMING PLAN, EN. SH. NO 1505; AND AS DETAILED ON STD. SH. SCB-06-73. ALL PORTIONS OF THE SCUPPERS EXPOSED BELOW THE CONCRETE DECK SHALL BE PAINTED BRONZE (FEDERAL COLOR STANDARD 20045), AS SPECIFIED IN SECTION 708 OF THE GENERAL SPECIAL PROVISIONS; COST TO BE INCLUDED IN THE UNIT PRICE BID FOR STRUCTURAL STEEL.
- PLASTIC DRAIN TUBES AS SHOWN IN DETAIL F OF STD. DRG. SCB-06-73 SHALL NOT BE PLACED WITHIN 2 FEET HORIZONTALLY OF ADJUSTMENTS, PIER CAPS, CROSS FRAMES, LATERAL BRACING, OR TELEPHONE DUCT SUPPORT BRACKETS. THE TUBES SHALL BE CHASED BETWEEN EDGE TO EDGE OF SHOULDER OF THE ROAD UNDER.

I-93 BRIDGE 8
 WATERFORD
 IM MEMB(31)
 SHEET 44 OF 48
 FOR REFERENCE ONLY


STATE OF VERMONT	
AGENCY OF TRANSPORTATION	
TOWN OF WATERFORD	Bridge No. B-16
HIGHWAY NO. I 93	Log Sta. Surr. Sta. 520+48
TH # 4 over I 93	
PLAN AND ELEVATION	
Designed by M. GARCIA	Drawn by J. MCCARTHY
Checked by E. Bloodgett date 6/80	Bridge Design Supervisor F.W. Bolkom date 1/80
PROJECT WATERFORD	PROJECT NO. I 93 -1(3) c/s
Bridge Sheet No. BR 1602	Sheet 44 of 550

DRAWING 44-131-40151

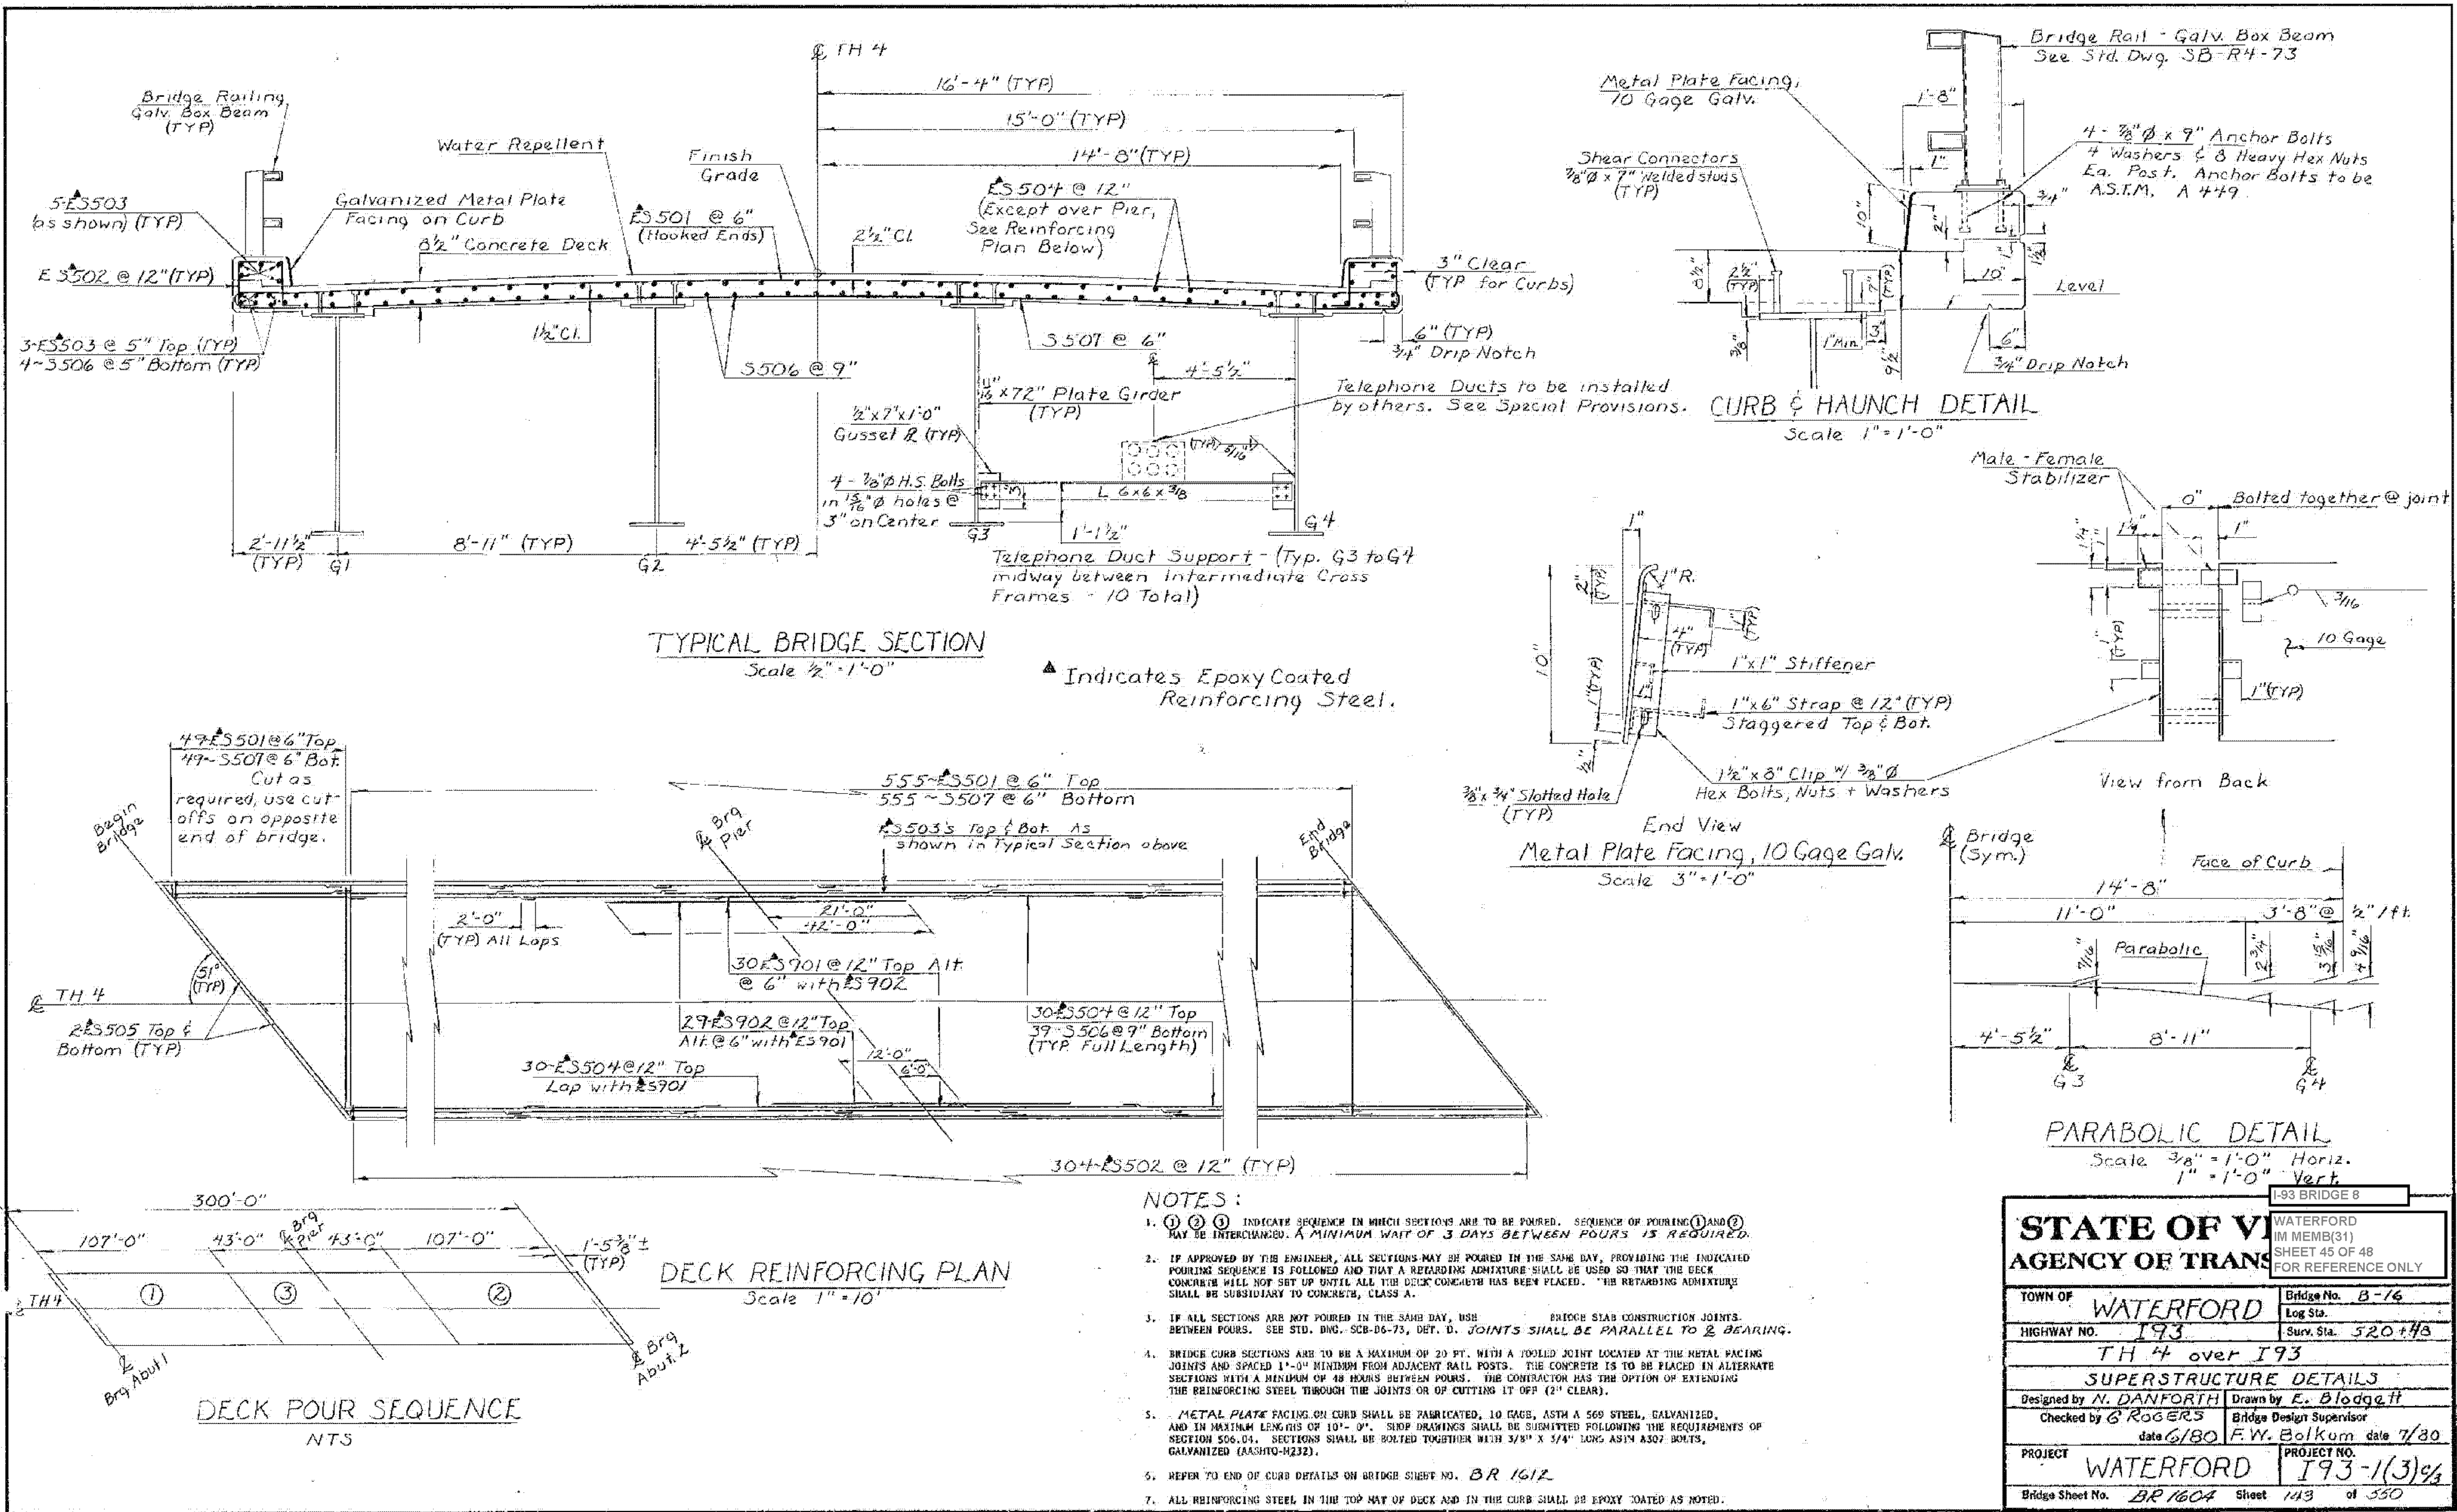

STATE OF VERMONT		WATERFORD	
AGENCY OF TRANSPORTATION		IM MEMB(31)	
TOWN OF WATERFORD		Log Sta.	
HIGHWAY NO. 193		Surv. Sta. 520+48	
TH 4 over I93			
SUPERSTRUCTURE DETAILS			
Designed by N. DANFORTH		Drawn by E. Blodgett	
Checked by G. ROGERS		Bridge Design Supervisor	
date 6/80		F.V. Balkum date 7/80	
PROJECT WATERFORD		PROJECT NO. I93-1(3)C4	
Bridge Sheet No. BR 1604		Sheet 113 of 350	

DRAWING 4-131-20751

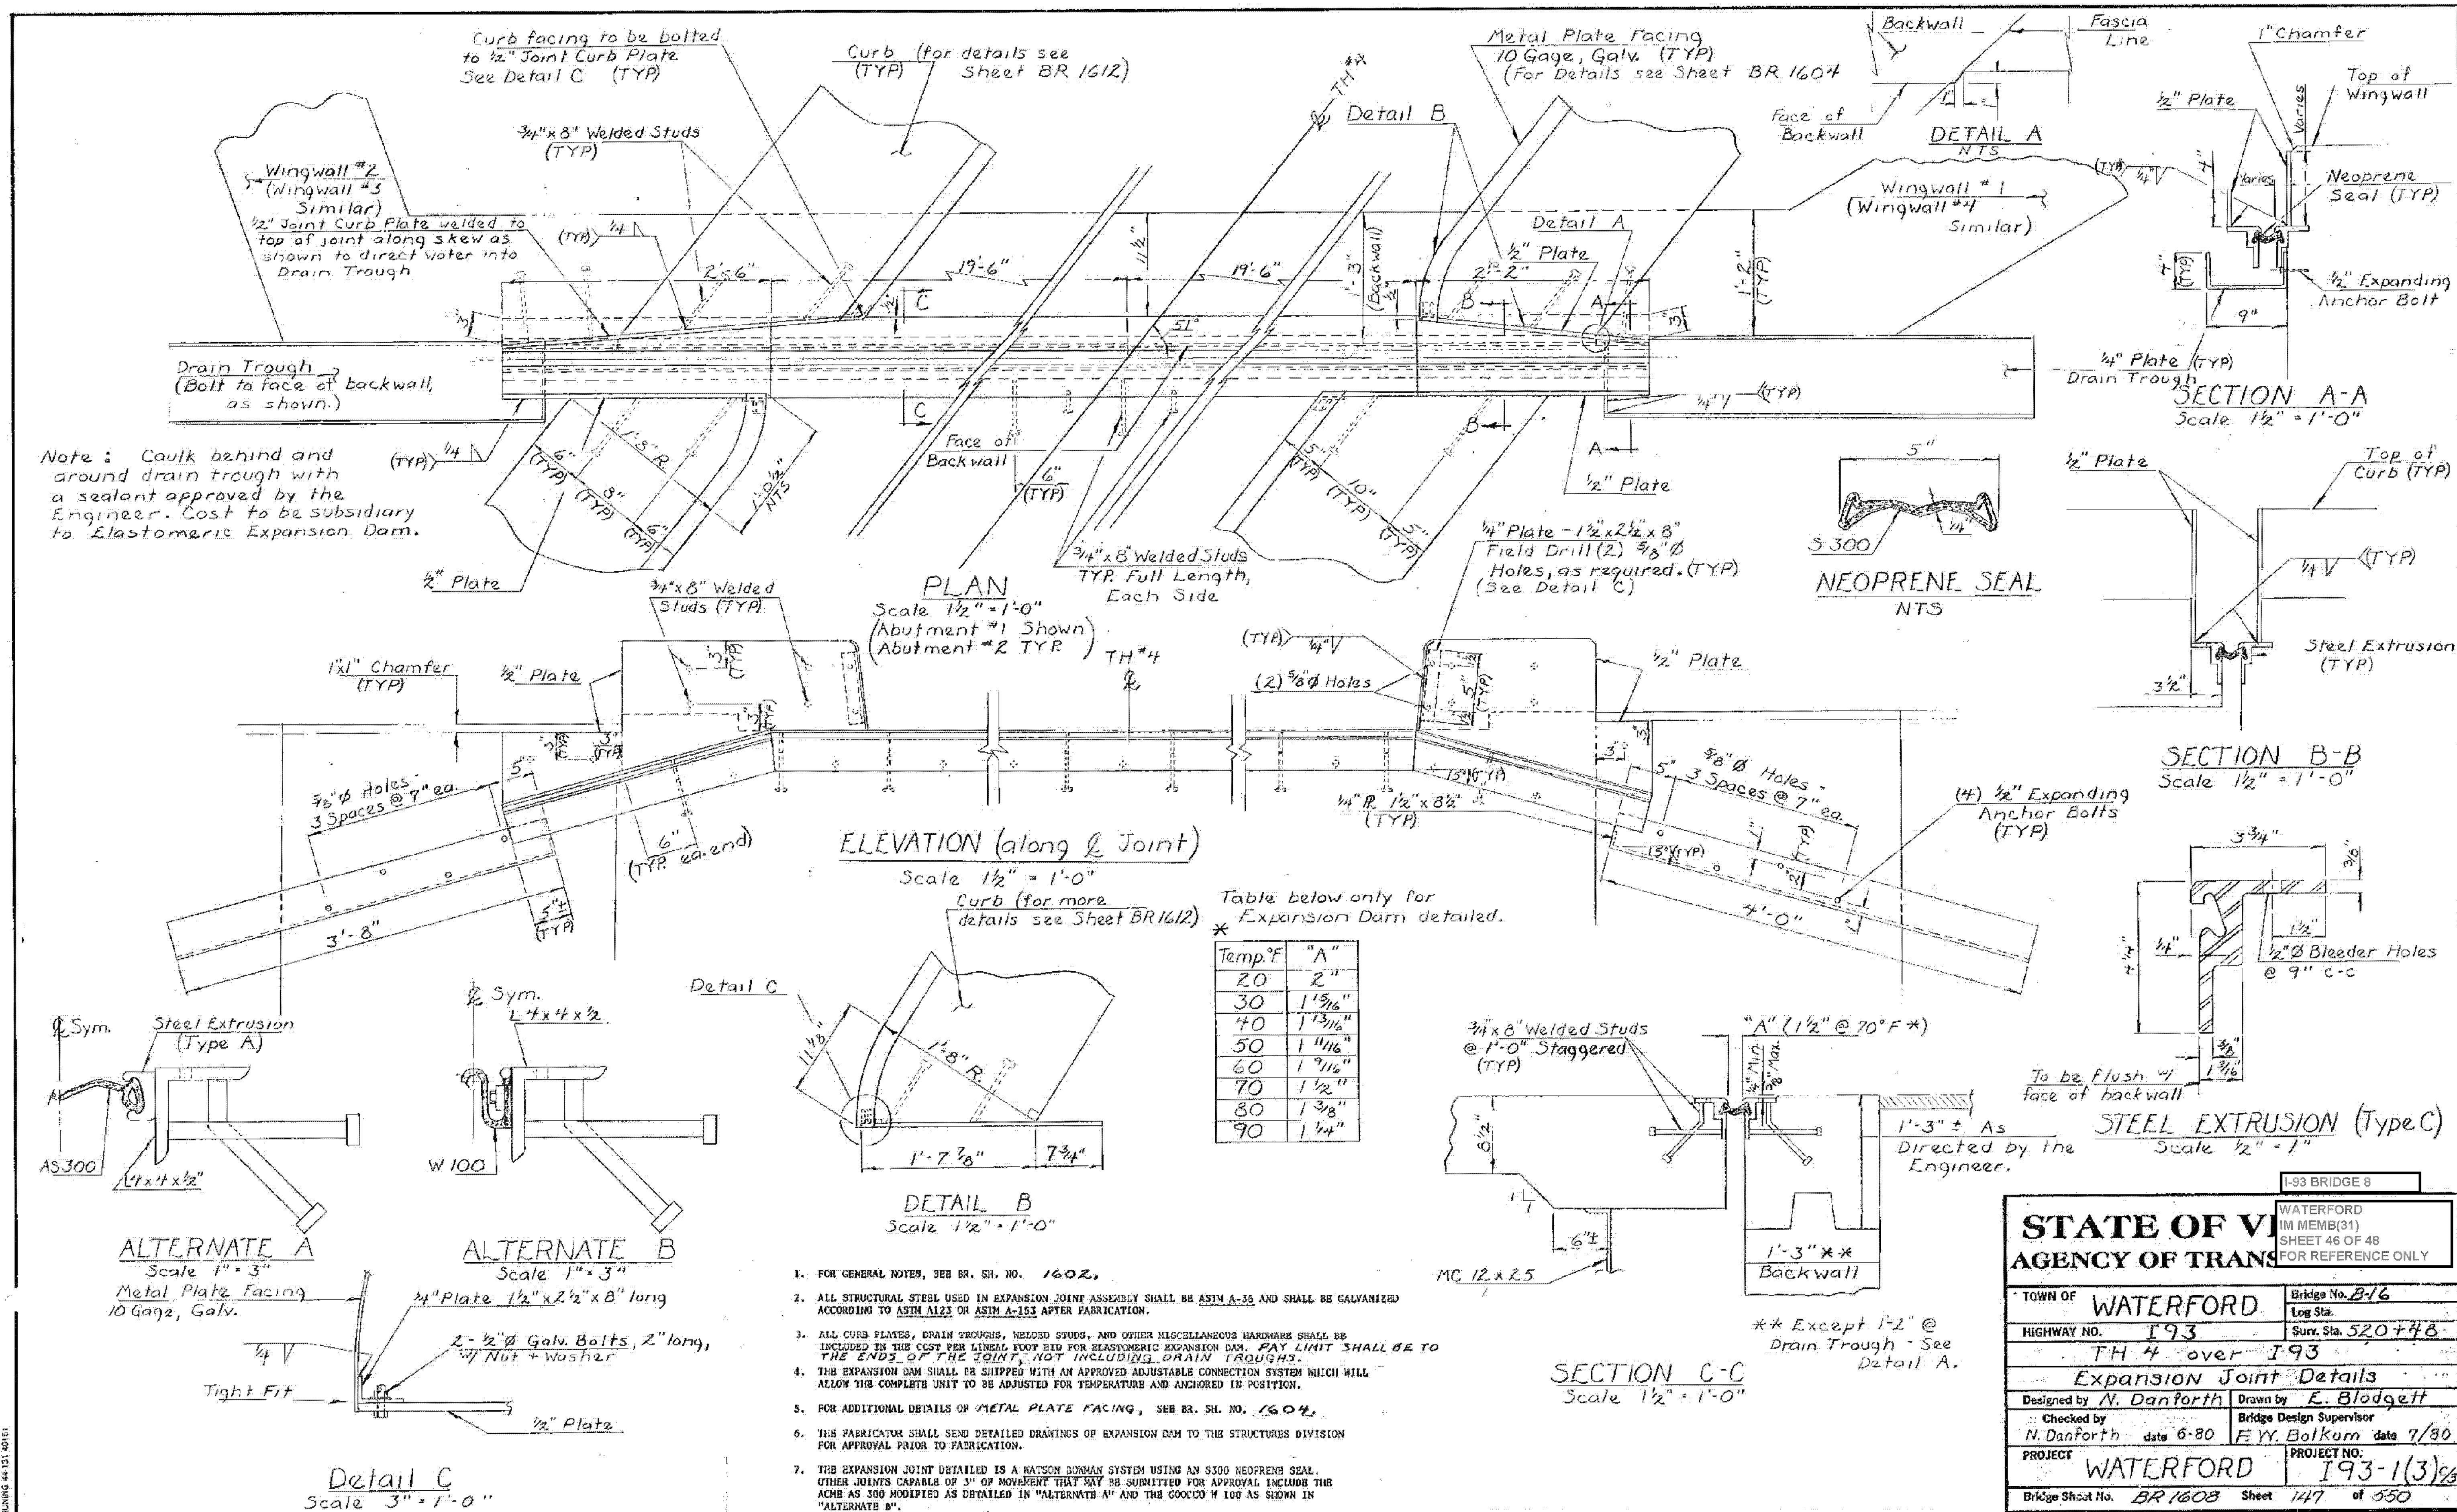

Note: Caulk behind and around drain trough with a sealant approved by the Engineer. Cost to be subsidiary to Elastomeric Expansion Dam.

ELEVATION (along Joint)
Scale 1/2" = 1'-0"

Table below only for Expansion Dam detailed.

Temp. °F	"A"
20	2"
30	1 15/16"
40	1 13/16"
50	1 11/16"
60	1 9/16"
70	1 7/16"
80	1 5/16"
90	1 3/16"

I-93 BRIDGE 8

STATE OF VERMONT
AGENCY OF TRANSPORTATION

WATERFORD
 IM MEMB(31)
 SHEET 46 OF 48
 FOR REFERENCE ONLY

TOWN OF	WATERFORD	Bridge No.	B-16
HIGHWAY NO.	I-93	Log Sta.	
	TH 4 over I-93	Surv. Sta.	520+48

Expansion Joint Details

Designed by N. Danforth
 Checked by N. Danforth date 6-80
 PROJECT WATERFORD I93-1(3) 9/80

Drawn by E. Blodgett
 Bridge Design Supervisor
 F.Y. Balkum date 7/80

PROJECT NO. WATERFORD I93-1(3) 9/80

Bridge Sheet No. BR 1603 Sheet 147 of 550

- FOR GENERAL NOTES, SEE BR. SH. NO. 1602.
- ALL STRUCTURAL STEEL USED IN EXPANSION JOINT ASSEMBLY SHALL BE ASTM A-36 AND SHALL BE GALVANIZED ACCORDING TO ASTM A123 OR ASTM A-153 AFTER FABRICATION.
- ALL CURB PLATES, DRAIN TROUGHS, WELDED STUDS, AND OTHER MISCELLANEOUS HARDWARE SHALL BE INCLUDED IN THE COST PER LINEAL FOOT BID FOR ELASTOMERIC EXPANSION DAM. PAY LIMIT SHALL BE TO THE ENDS OF THE JOINTS, NOT INCLUDING DRAIN TROUGHS.
- THE EXPANSION DAM SHALL BE SHIPPED WITH AN APPROVED ADJUSTABLE CONNECTION SYSTEM WHICH WILL ALLOW THE COMPLETE UNIT TO BE ADJUSTED FOR TEMPERATURE AND ANCHORED IN POSITION.
- FOR ADDITIONAL DETAILS OF METAL PLATE FACING, SEE BR. SH. NO. 1604.
- THE FABRICATOR SHALL SEND DETAILED DRAWINGS OF EXPANSION DAM TO THE STRUCTURES DIVISION FOR APPROVAL PRIOR TO FABRICATION.
- THE EXPANSION JOINT DETAILED IS A WATSON-DOMAN SYSTEM USING AN S300 NEOPRENE SEAL. OTHER JOINTS CAPABLE OF 3" OF MOVEMENT THAT MAY BE SUBMITTED FOR APPROVAL INCLUDE THE ACME AS 300 MODIFIED AS DETAILED IN "ALTERNATE A" AND THE COCCO W 100 AS SHOWN IN "ALTERNATE B".

ALTERNATE A
Scale 1" = 3"

ALTERNATE B
Scale 1" = 3"


Detail C
Scale 3" = 1'-0"

DETAIL B
Scale 1/2" = 1'-0"


SECTION C-C
Scale 1/2" = 1'-0"

SECTION B-B
Scale 1/2" = 1'-0"

SECTION A-A
Scale 1/2" = 1'-0"

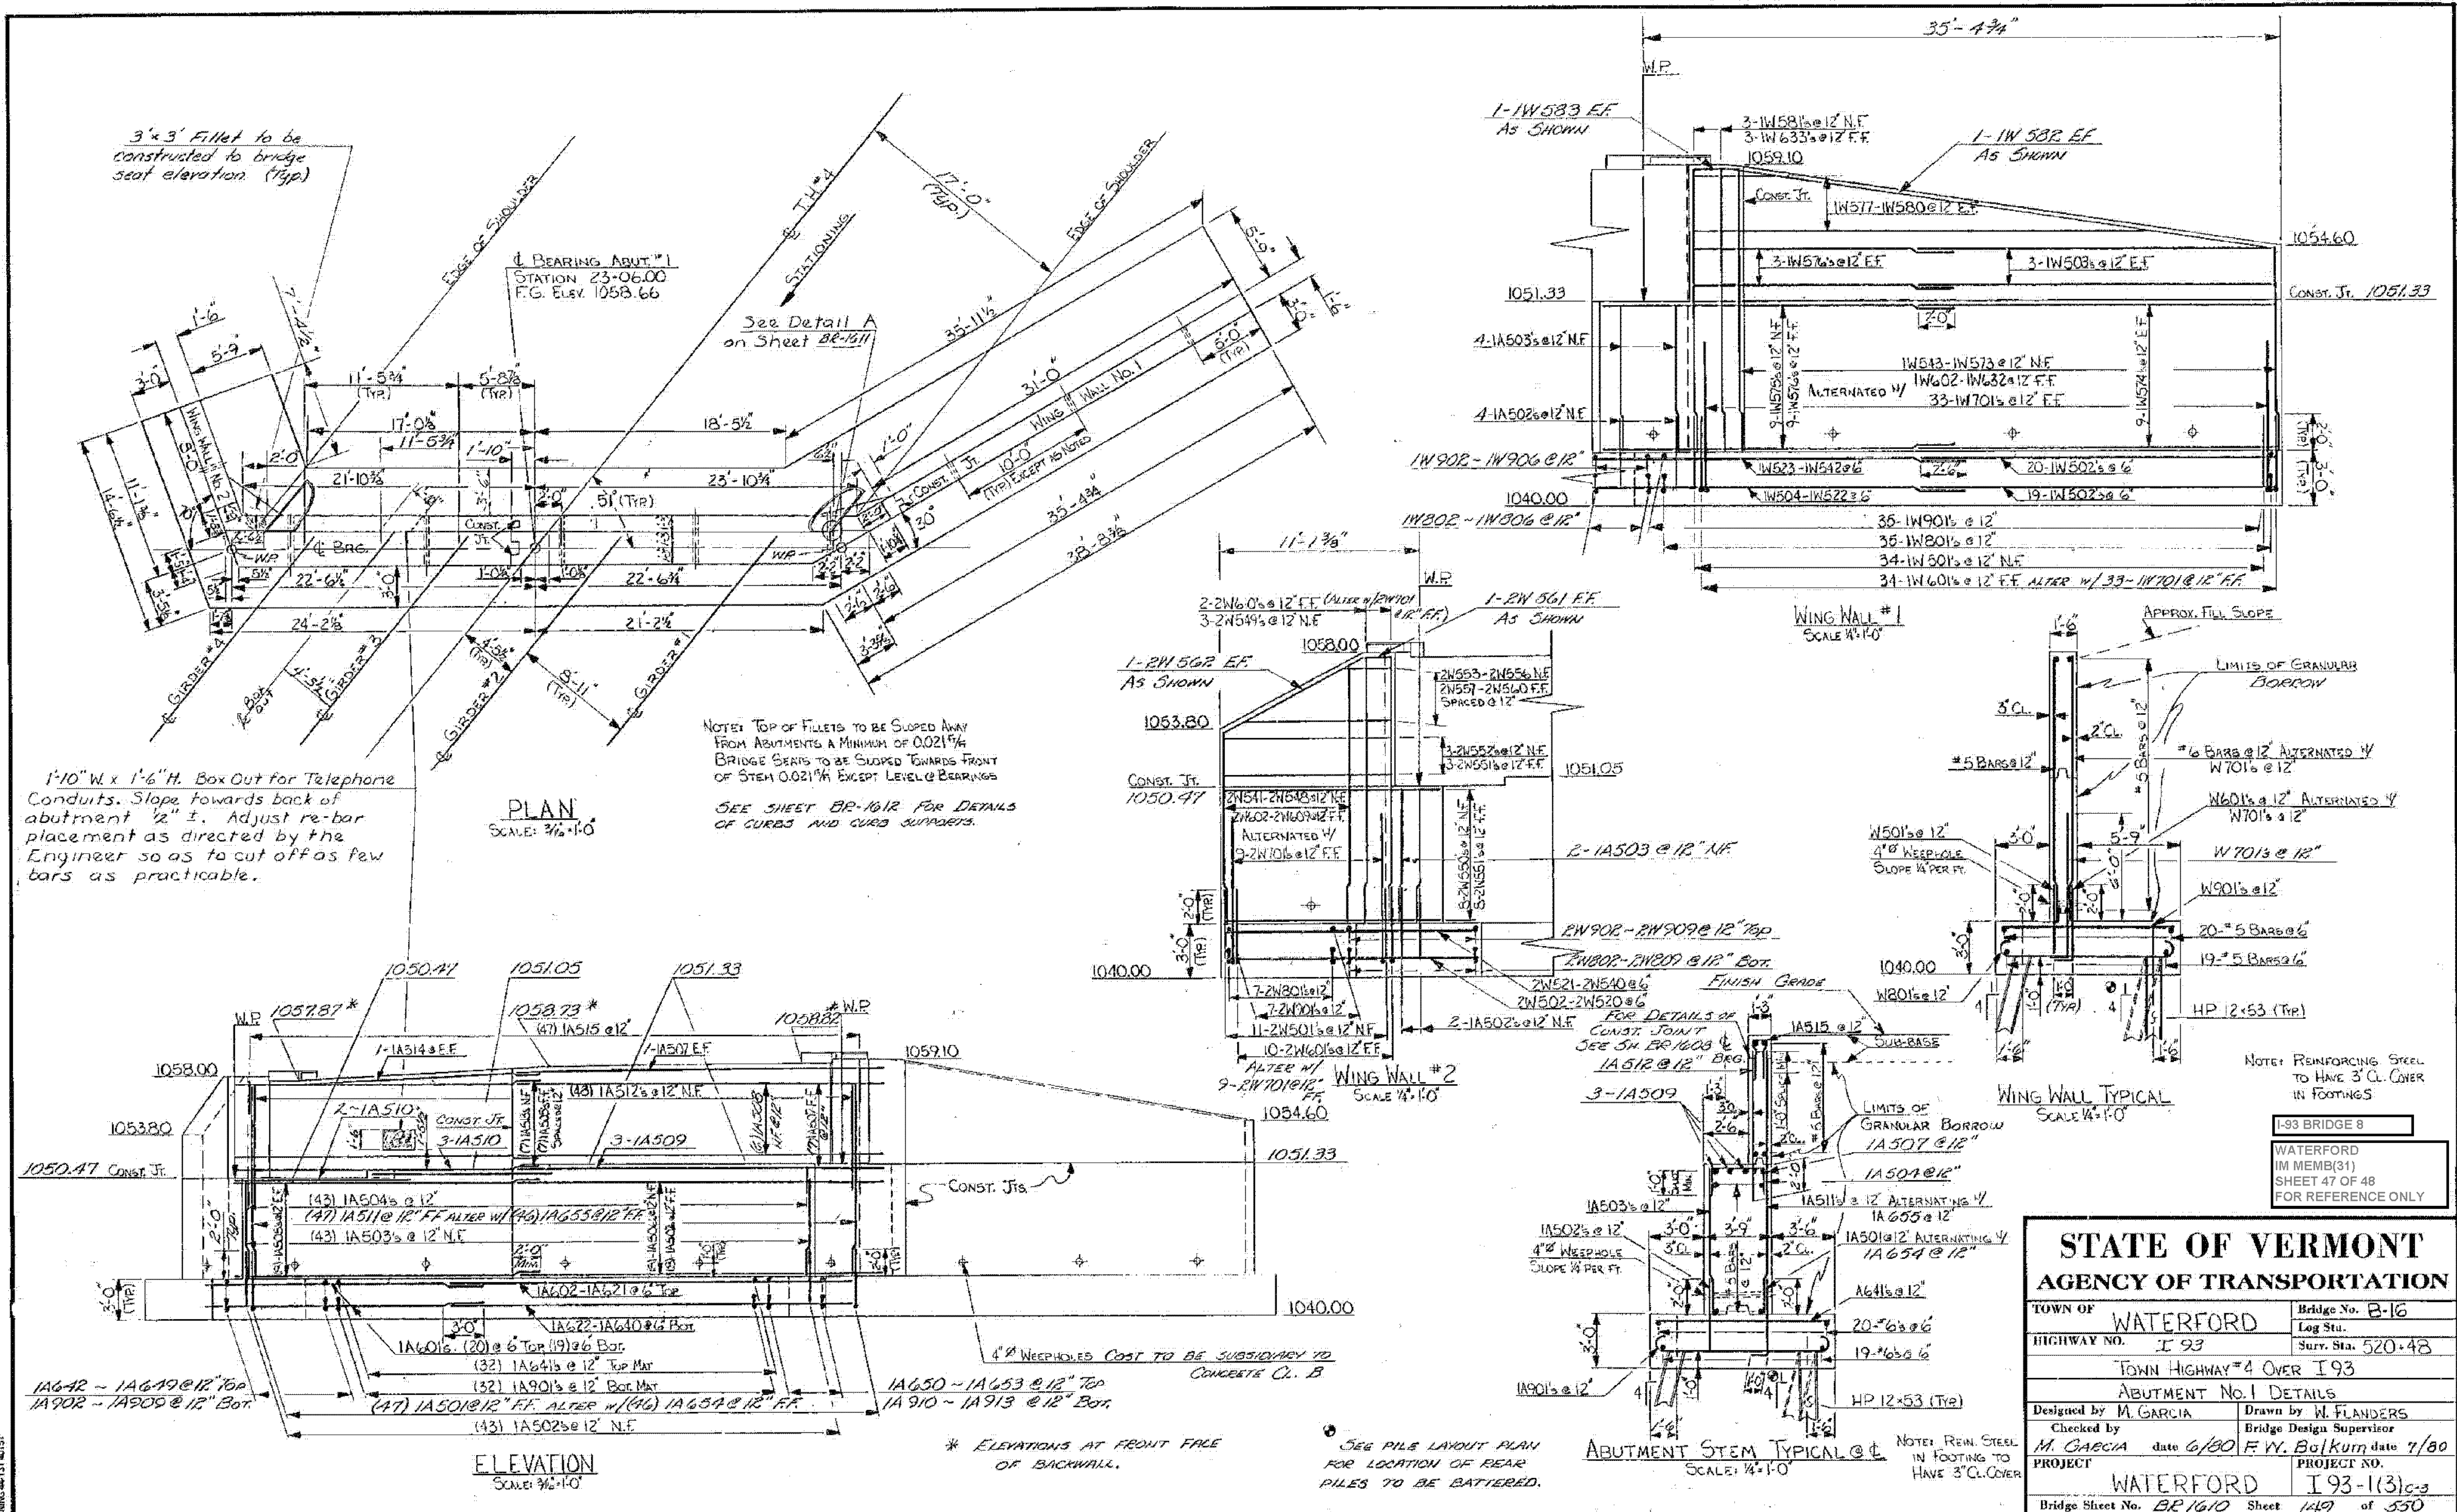


STATE OF VERMONT	
AGENCY OF TRANSPORTATION	
TOWN OF WATERFORD	Bridge No. B-16
HIGHWAY NO. I 93	Log Sta.
TOWN HIGHWAY #4 OVER I 93	
ABUTMENT No. 1 DETAILS	
Designed by M. GARCIA	Drawn by W. FLANDERS
Checked by M. GARCIA	Bridge Design Supervisor
PROJECT WATERFORD I 93-1131	date 6/80 F.Y. Balkum date 7/80
Bridge Sheet No. BR-1610	Sheet 149 of 350

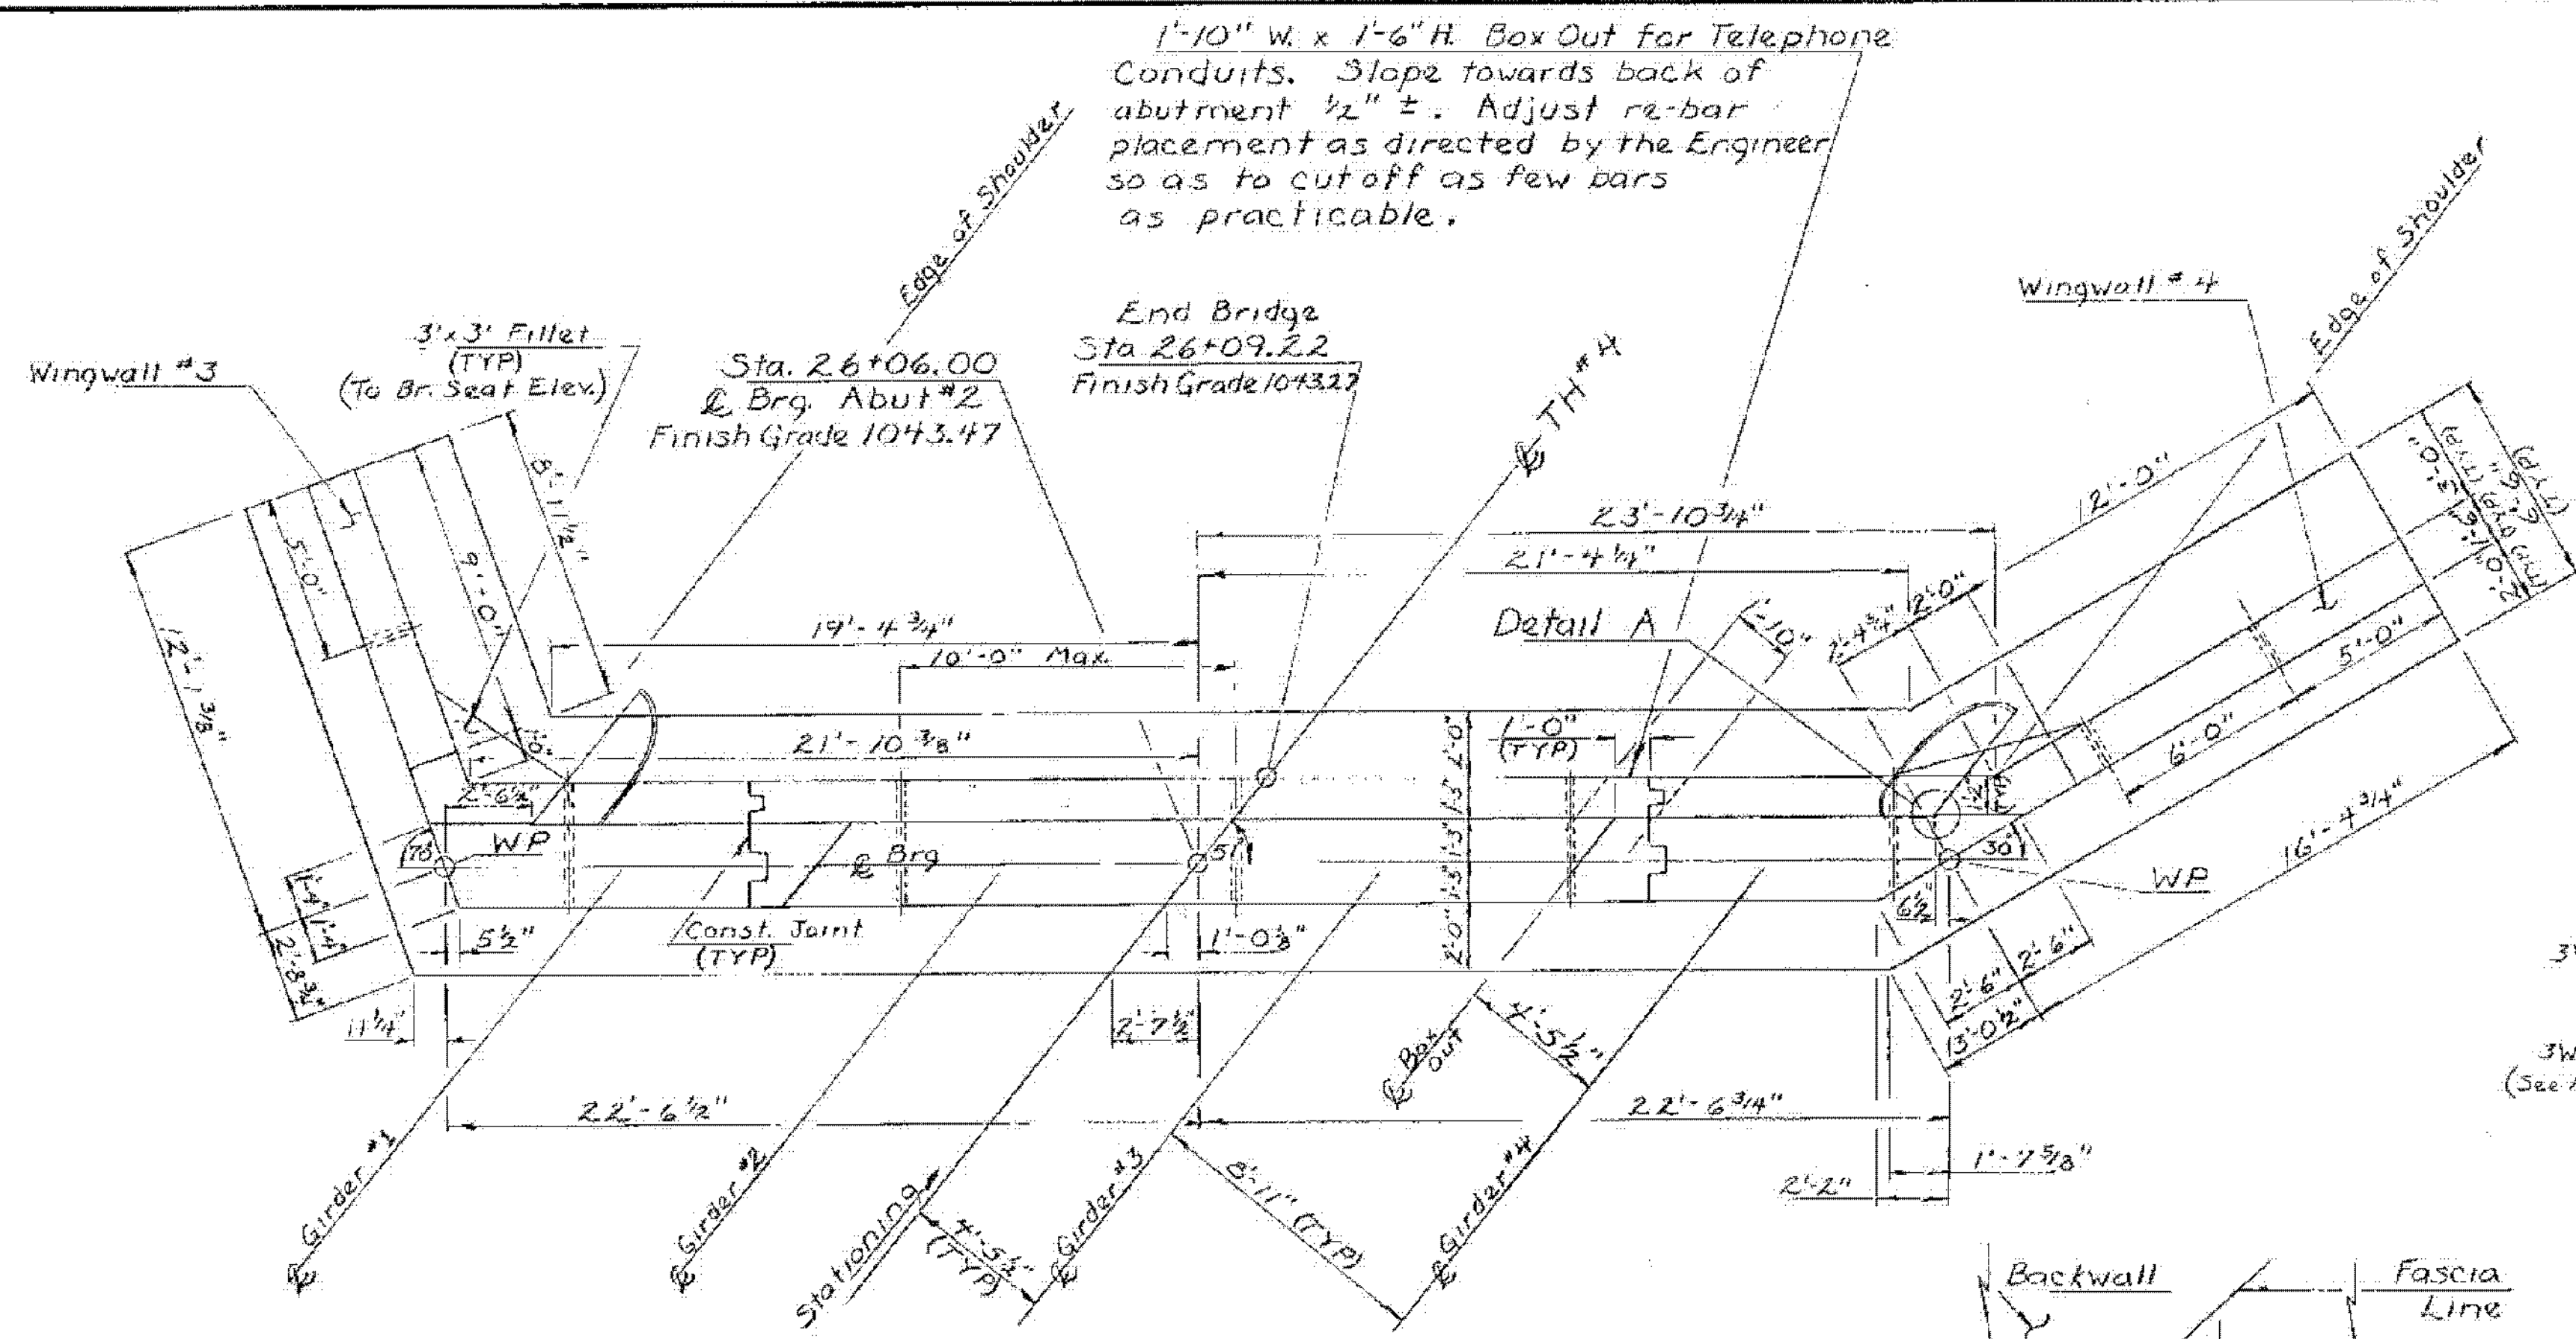


Note: See Br. Sh. 1612 for Curb & Curb Support Details.

PLAN
Scale 1/4" = 1'-0"

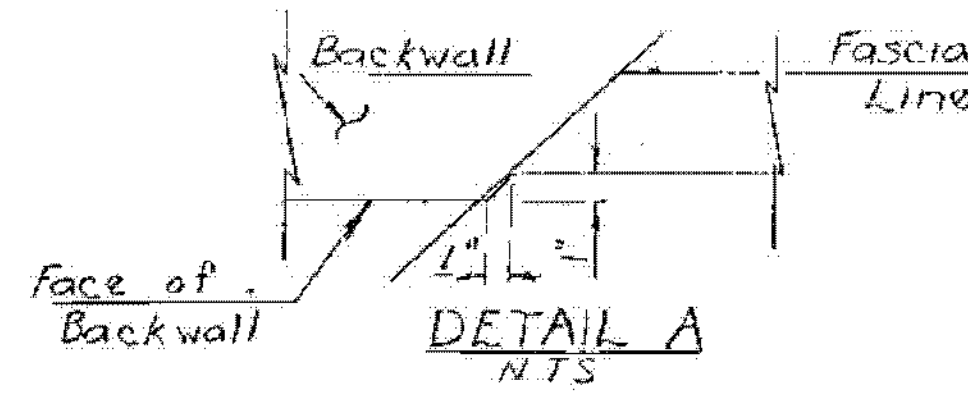


DETAIL A
NTS

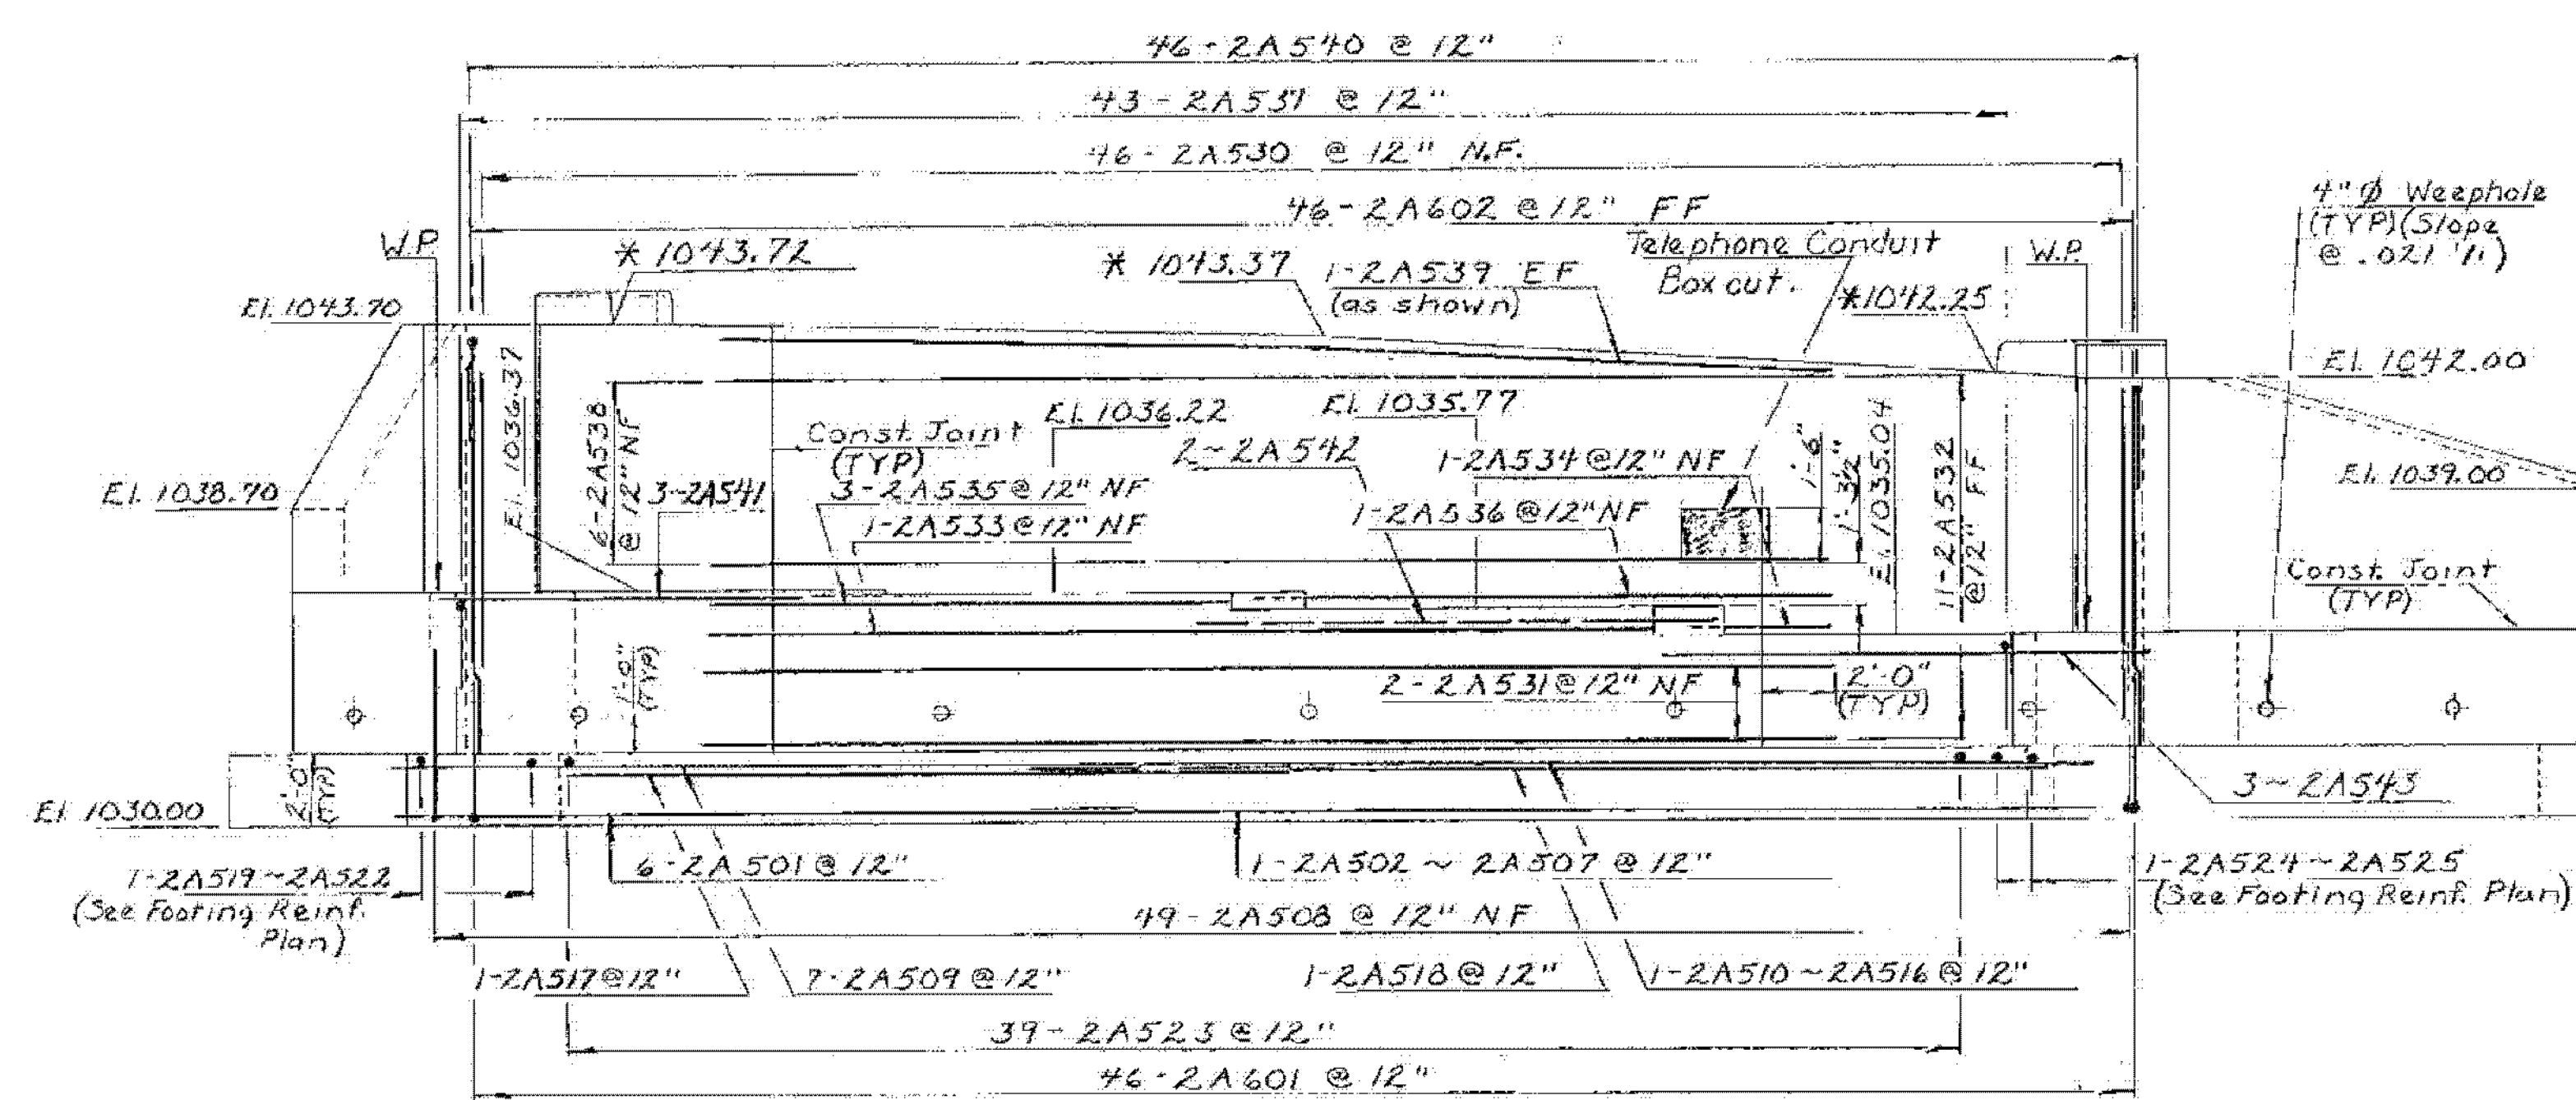


* Elevations at front face of backwall.


ELEVATION
Scale 1/4" = 1'-0"

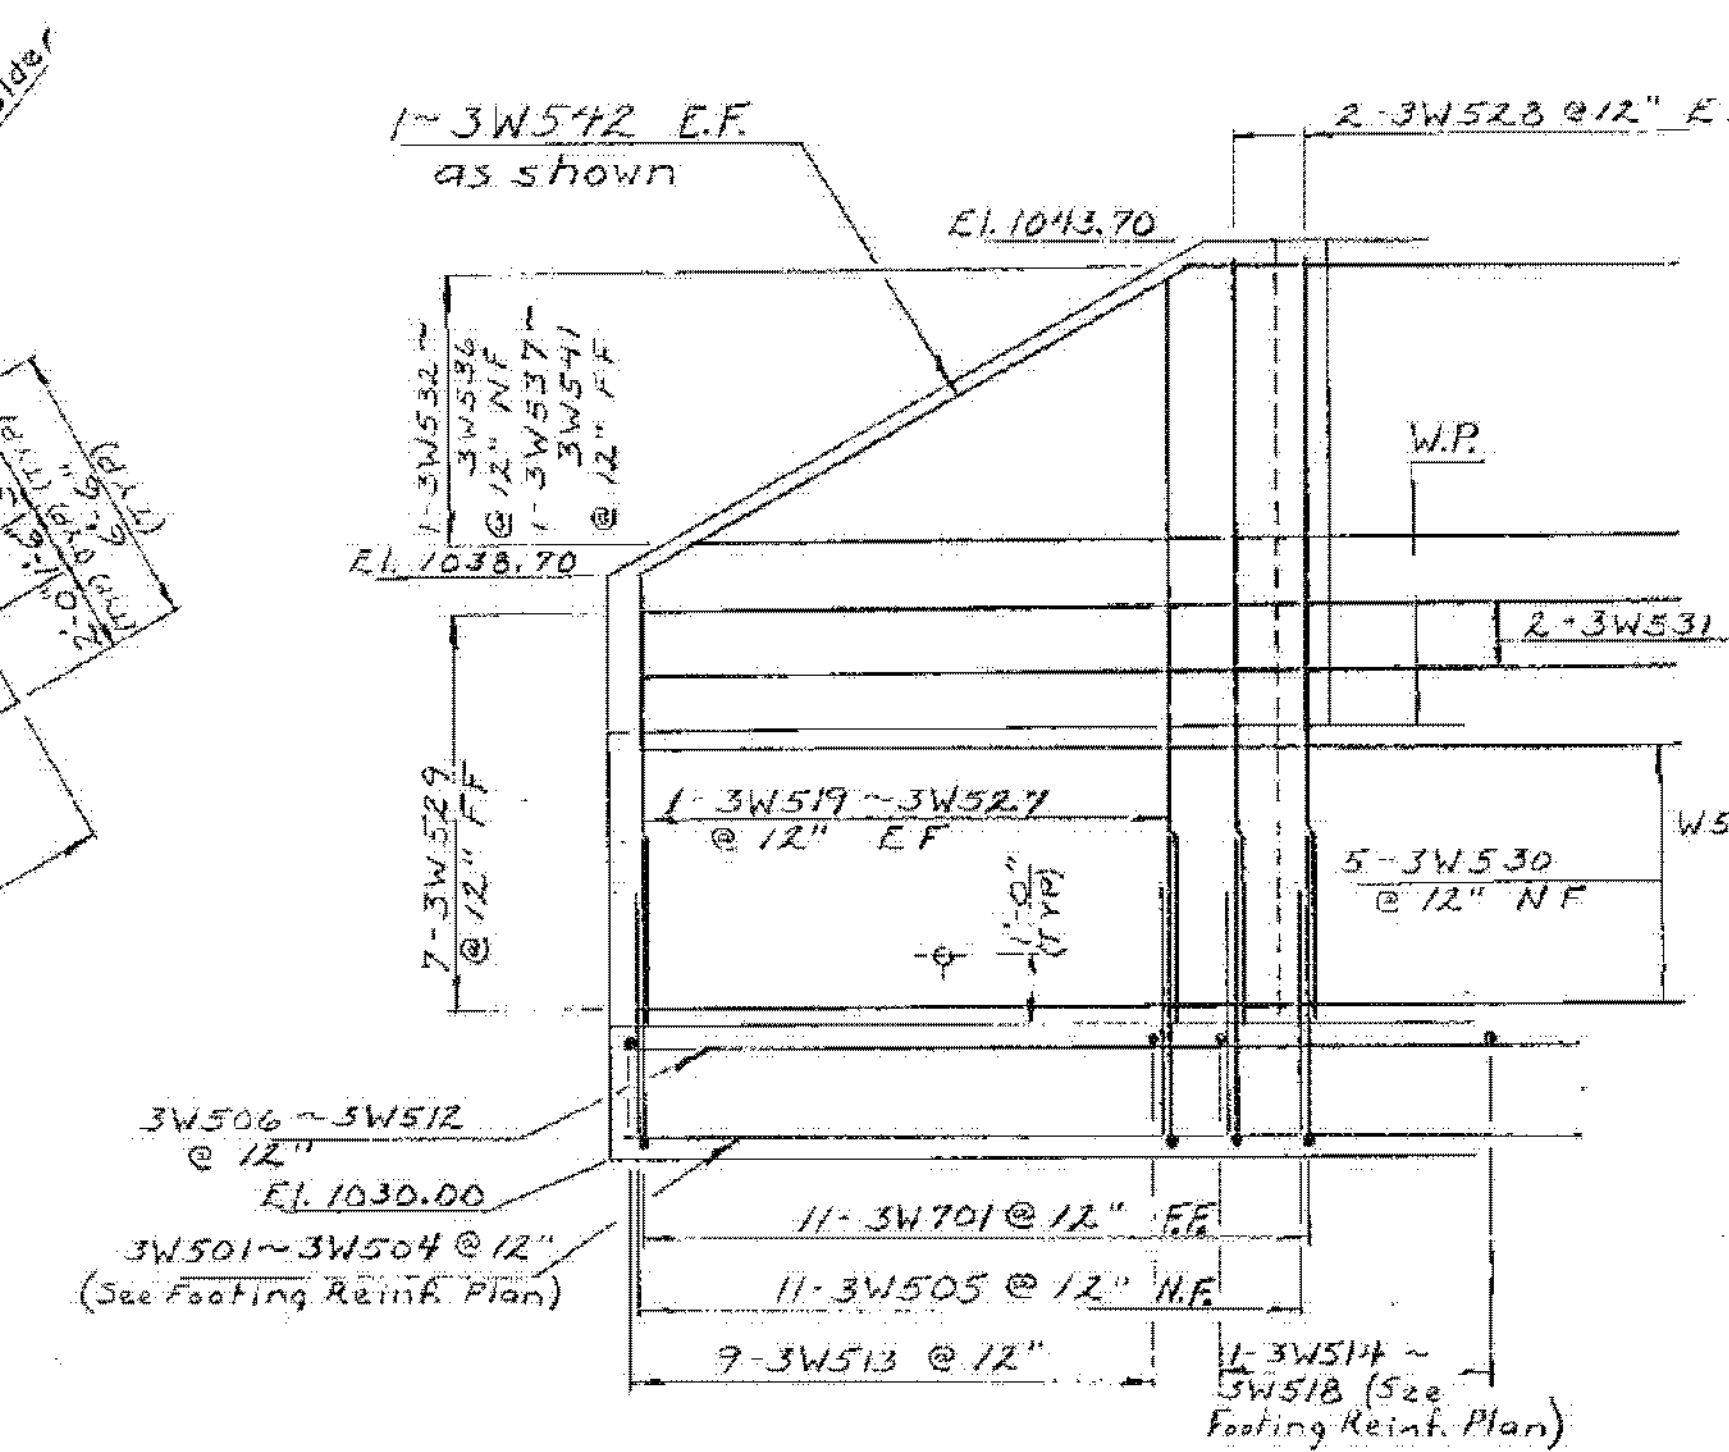


WINGWALL #3
Scale 3/8" = 1'-0"

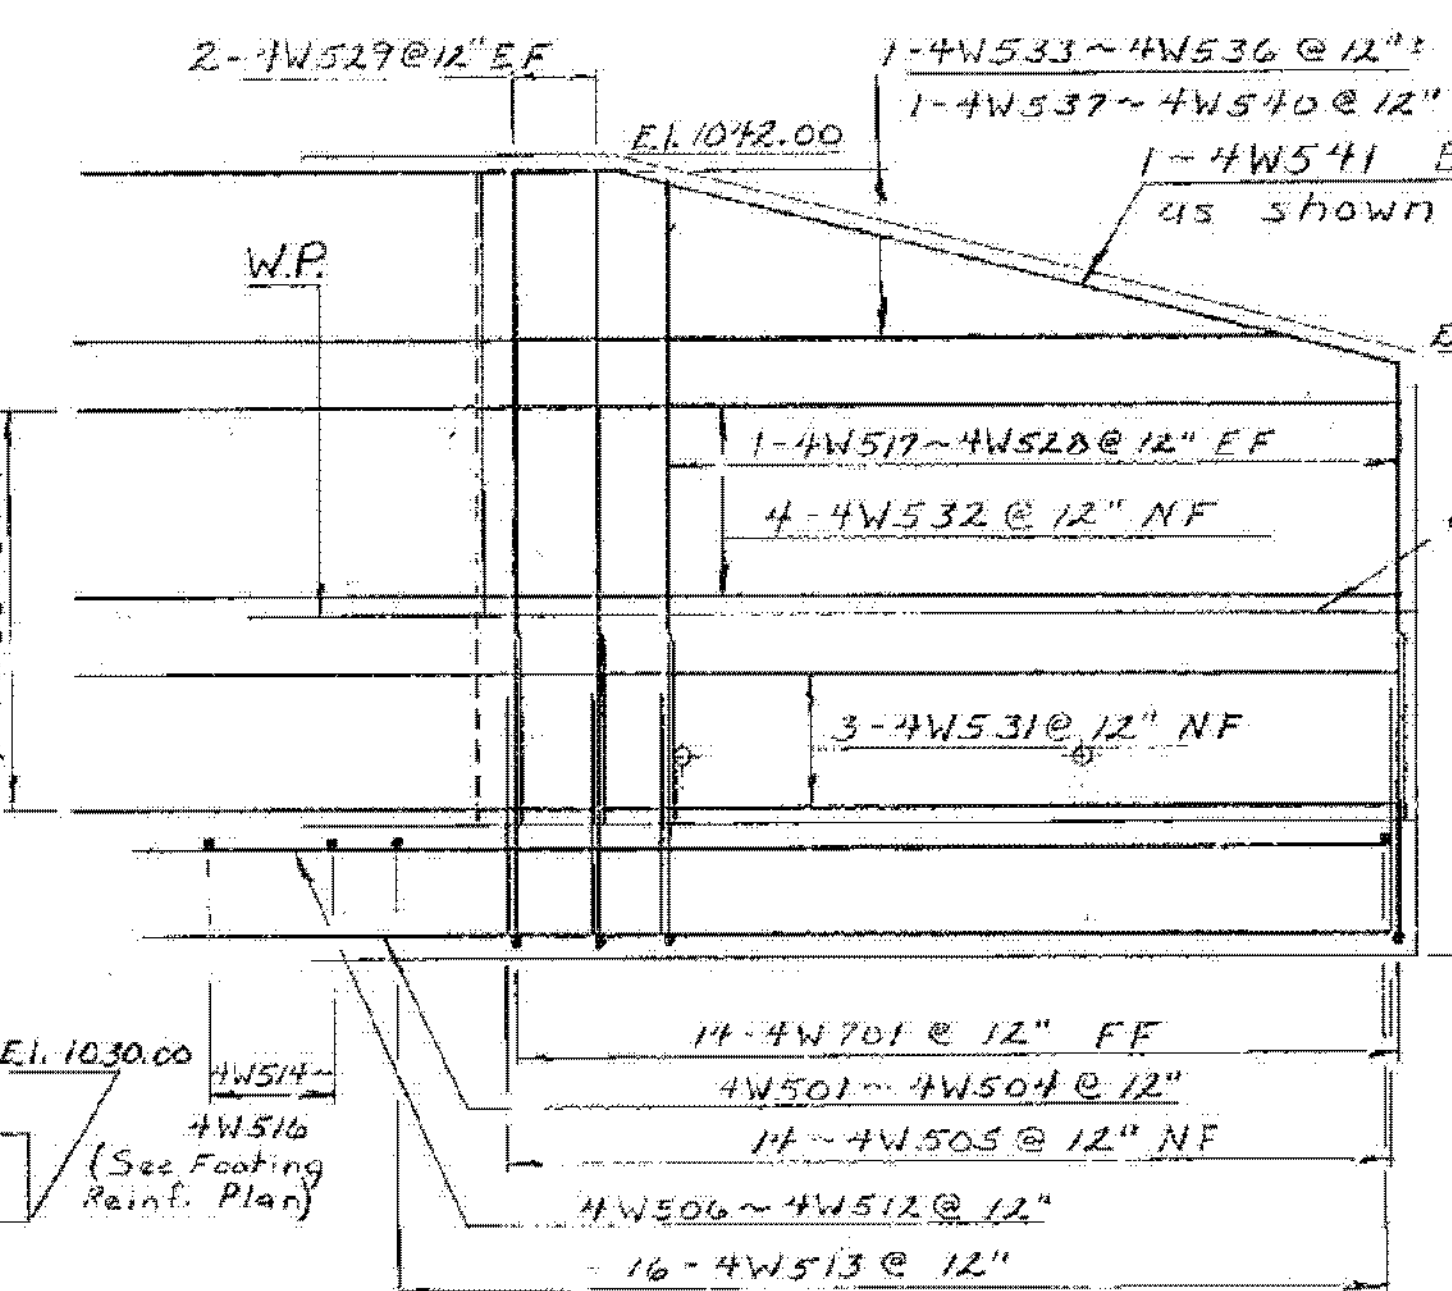

WINGWALL #4
Scale 3/8" = 1'-0"

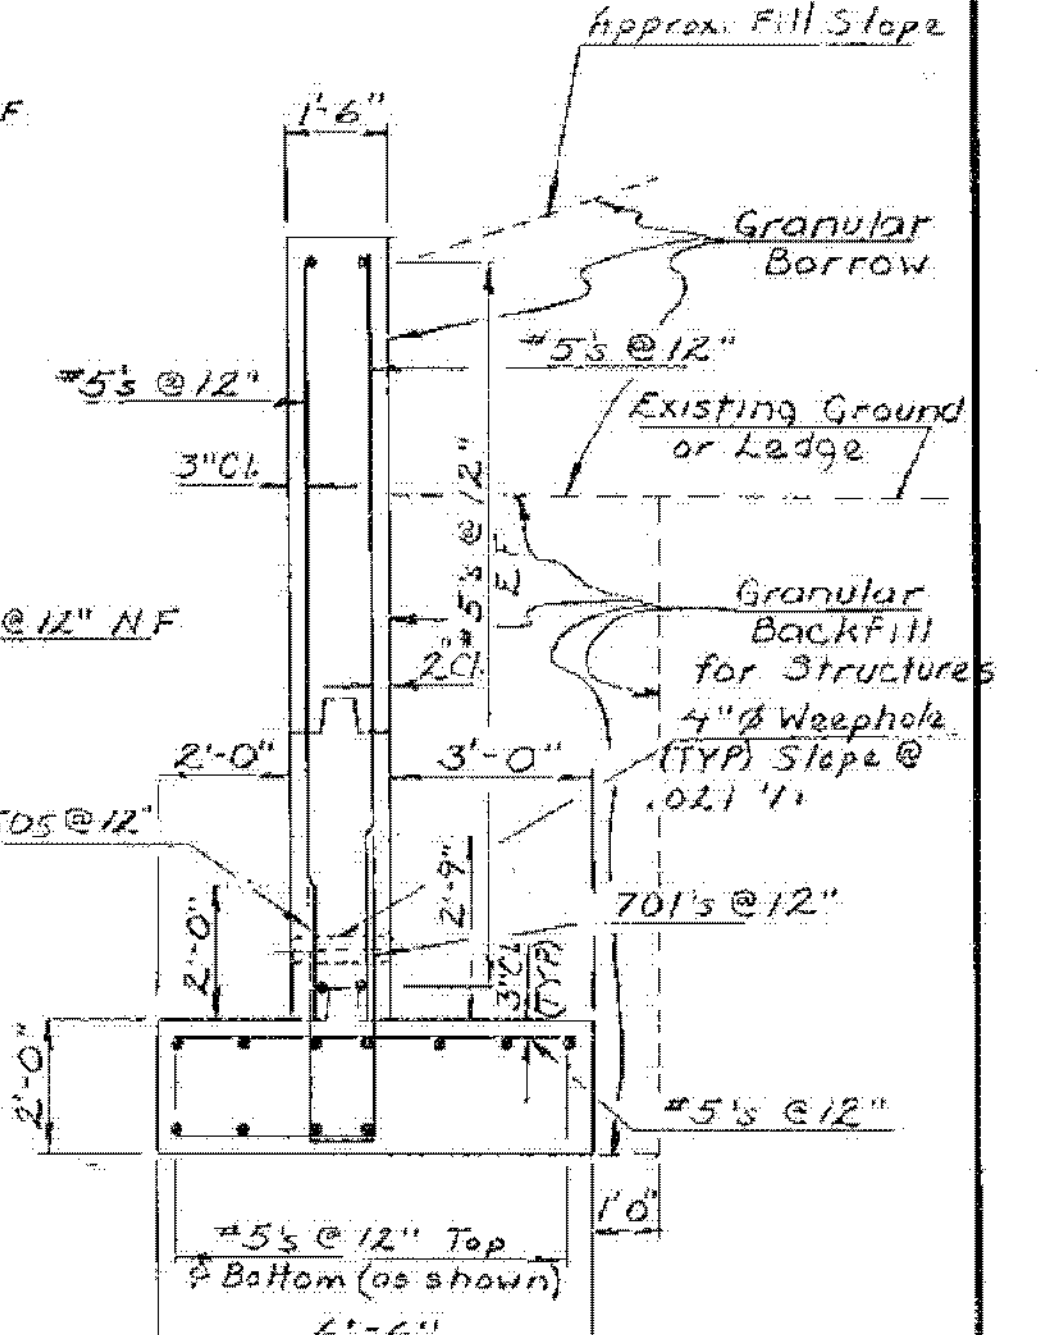

WINGWALL TYPICAL
Scale 3/8" = 1'-0"

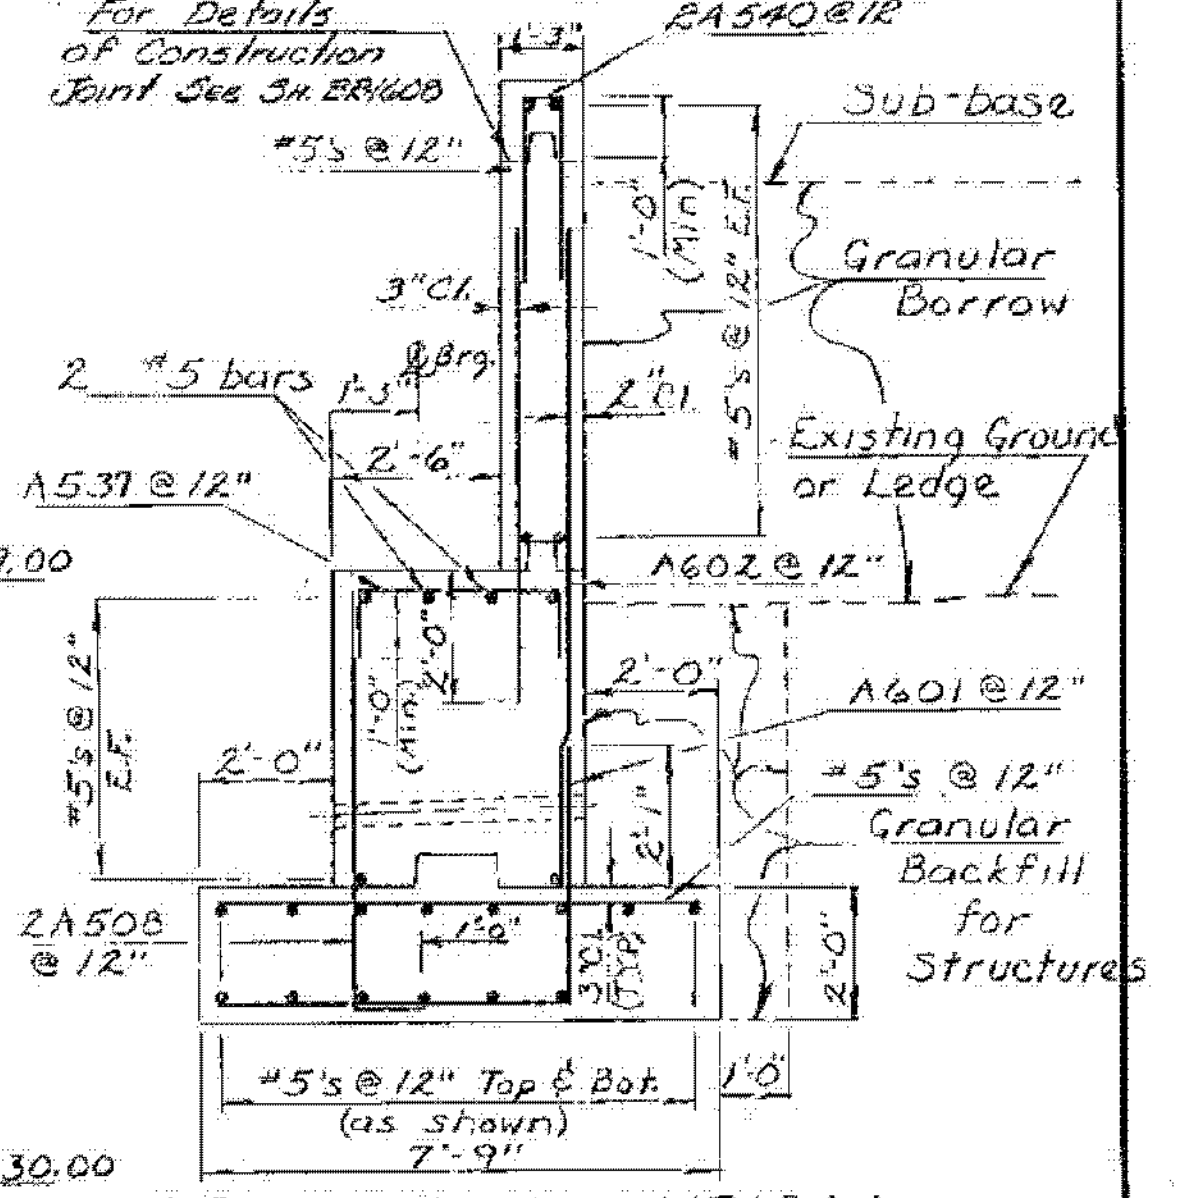

ABUTMENT TYPICAL
Scale 3/8" = 1'-0"

Note: Footing Reinforcing Steel shall have a Clear Cover of 3".

STATE OF VERMONT		WATERFORD	
MEMBER (31)		BRIDGE NO. B-16	
AGENCY OF TRANSPORTATION		LOG STA. 520+48	
TOWN OF WATERFORD		SURV. STA. 520+48	
HIGHWAY NO. 193		TH #4 over 193	
ABUTMENT No. 2 Details			
Designed by J. McCarthy	Checked by J. McCarthy	Drawn by E. Blodgett	Bridge Design Supervisor
date 6/80		date 7/80	
PROJECT WATERFORD		PROJECT NO. I93-1(3)g	
Bridge Sheet No. BR 1611		Sheet 150 of 350	