




Wingwall # 5 Elev. View
Scale 1/4" = 1'-0"

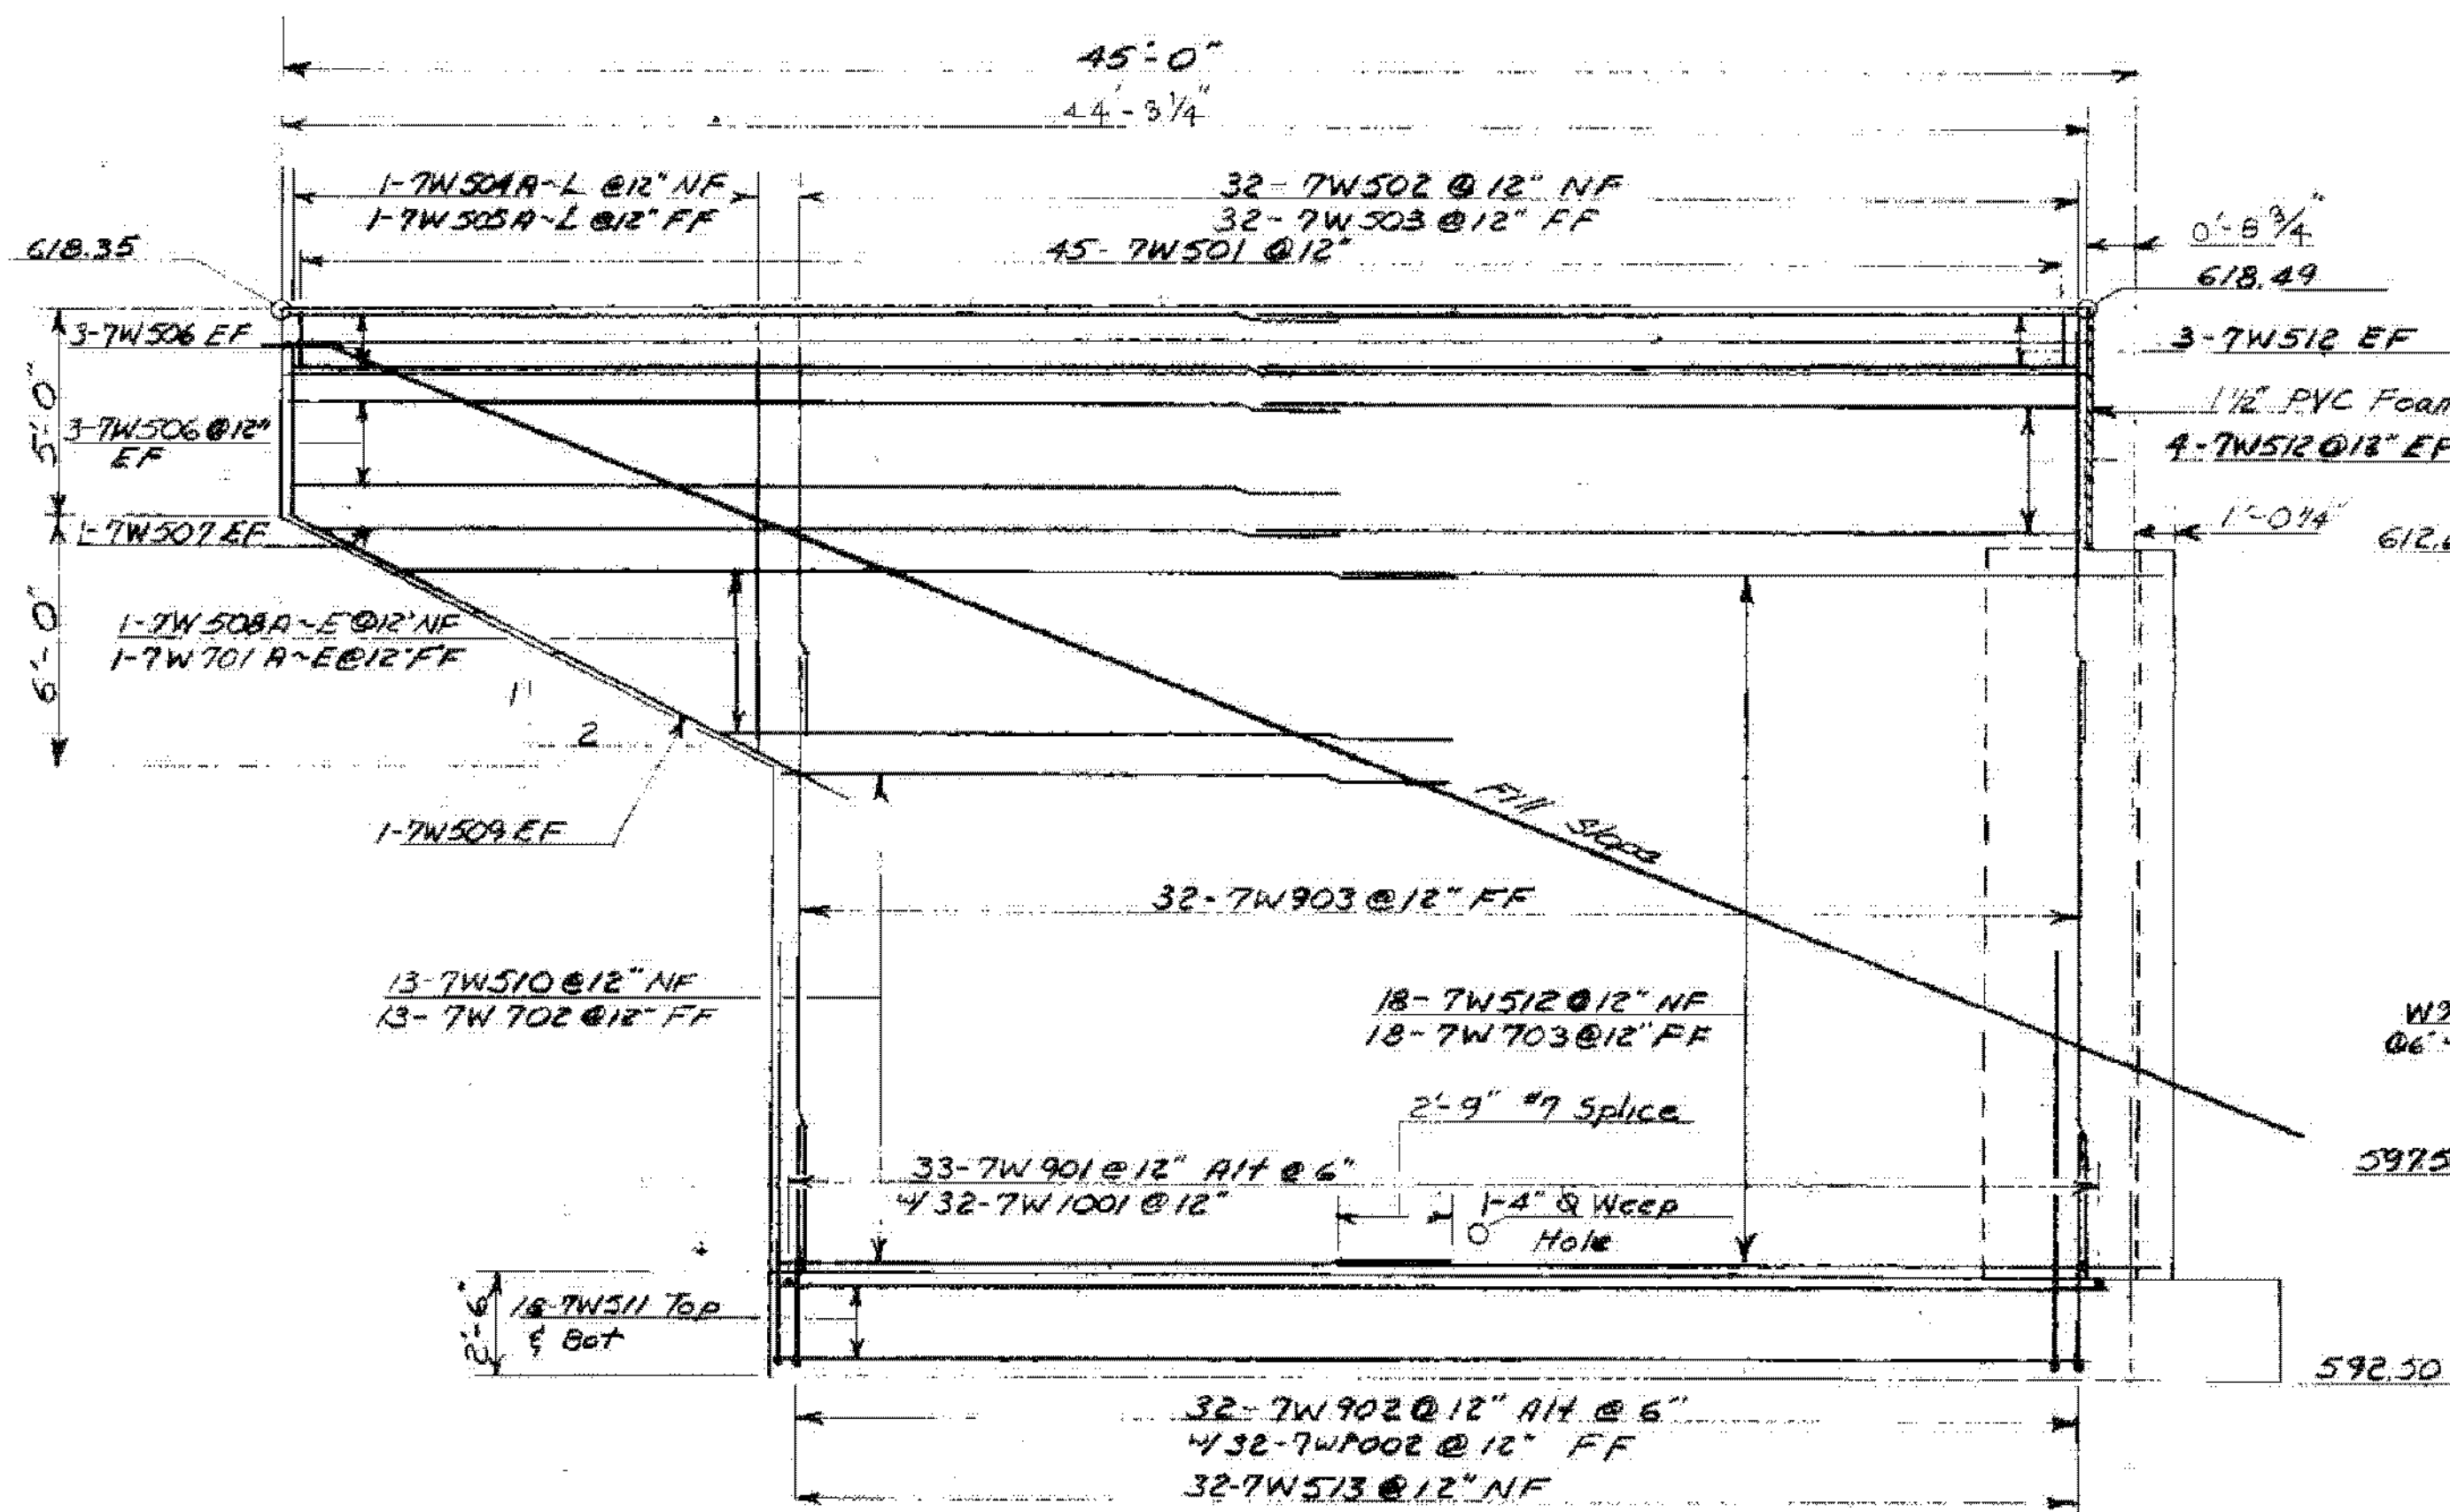


Wingwall # 7 Elev. View
Scale 1/4" = 1'-0"

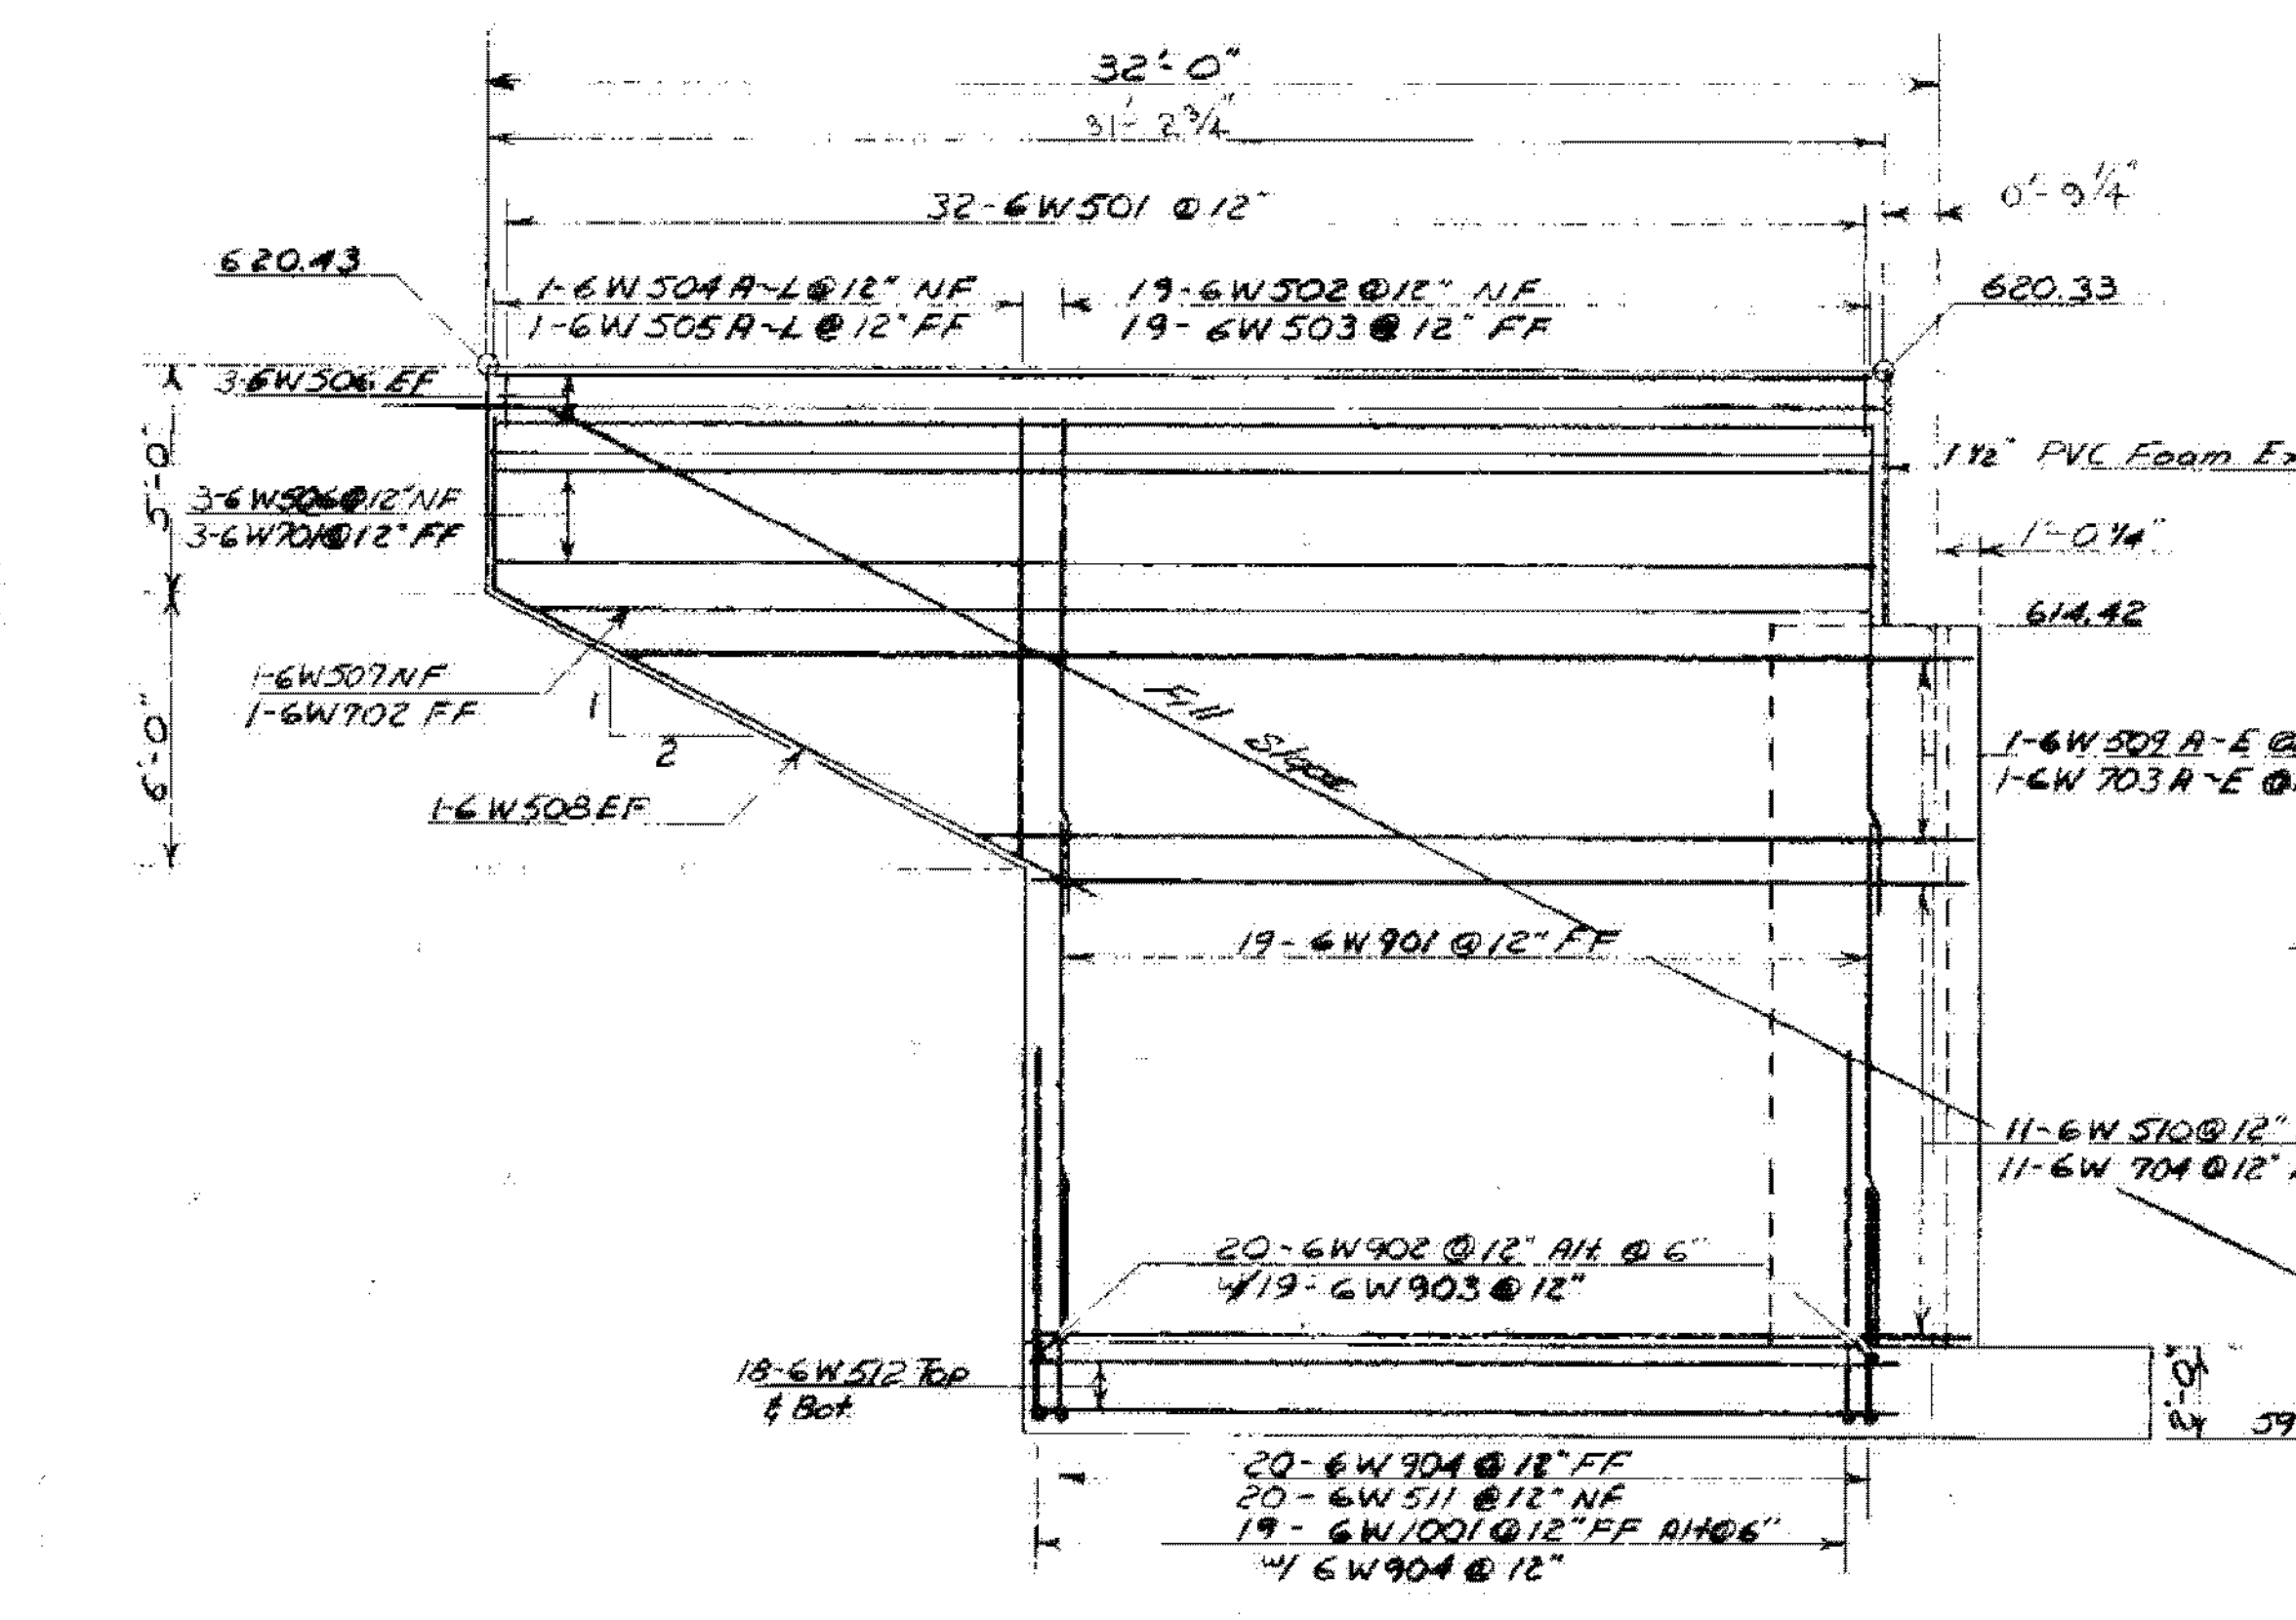


Wingwall # 6 Elev. View
Scale 1/4" = 1'-0"

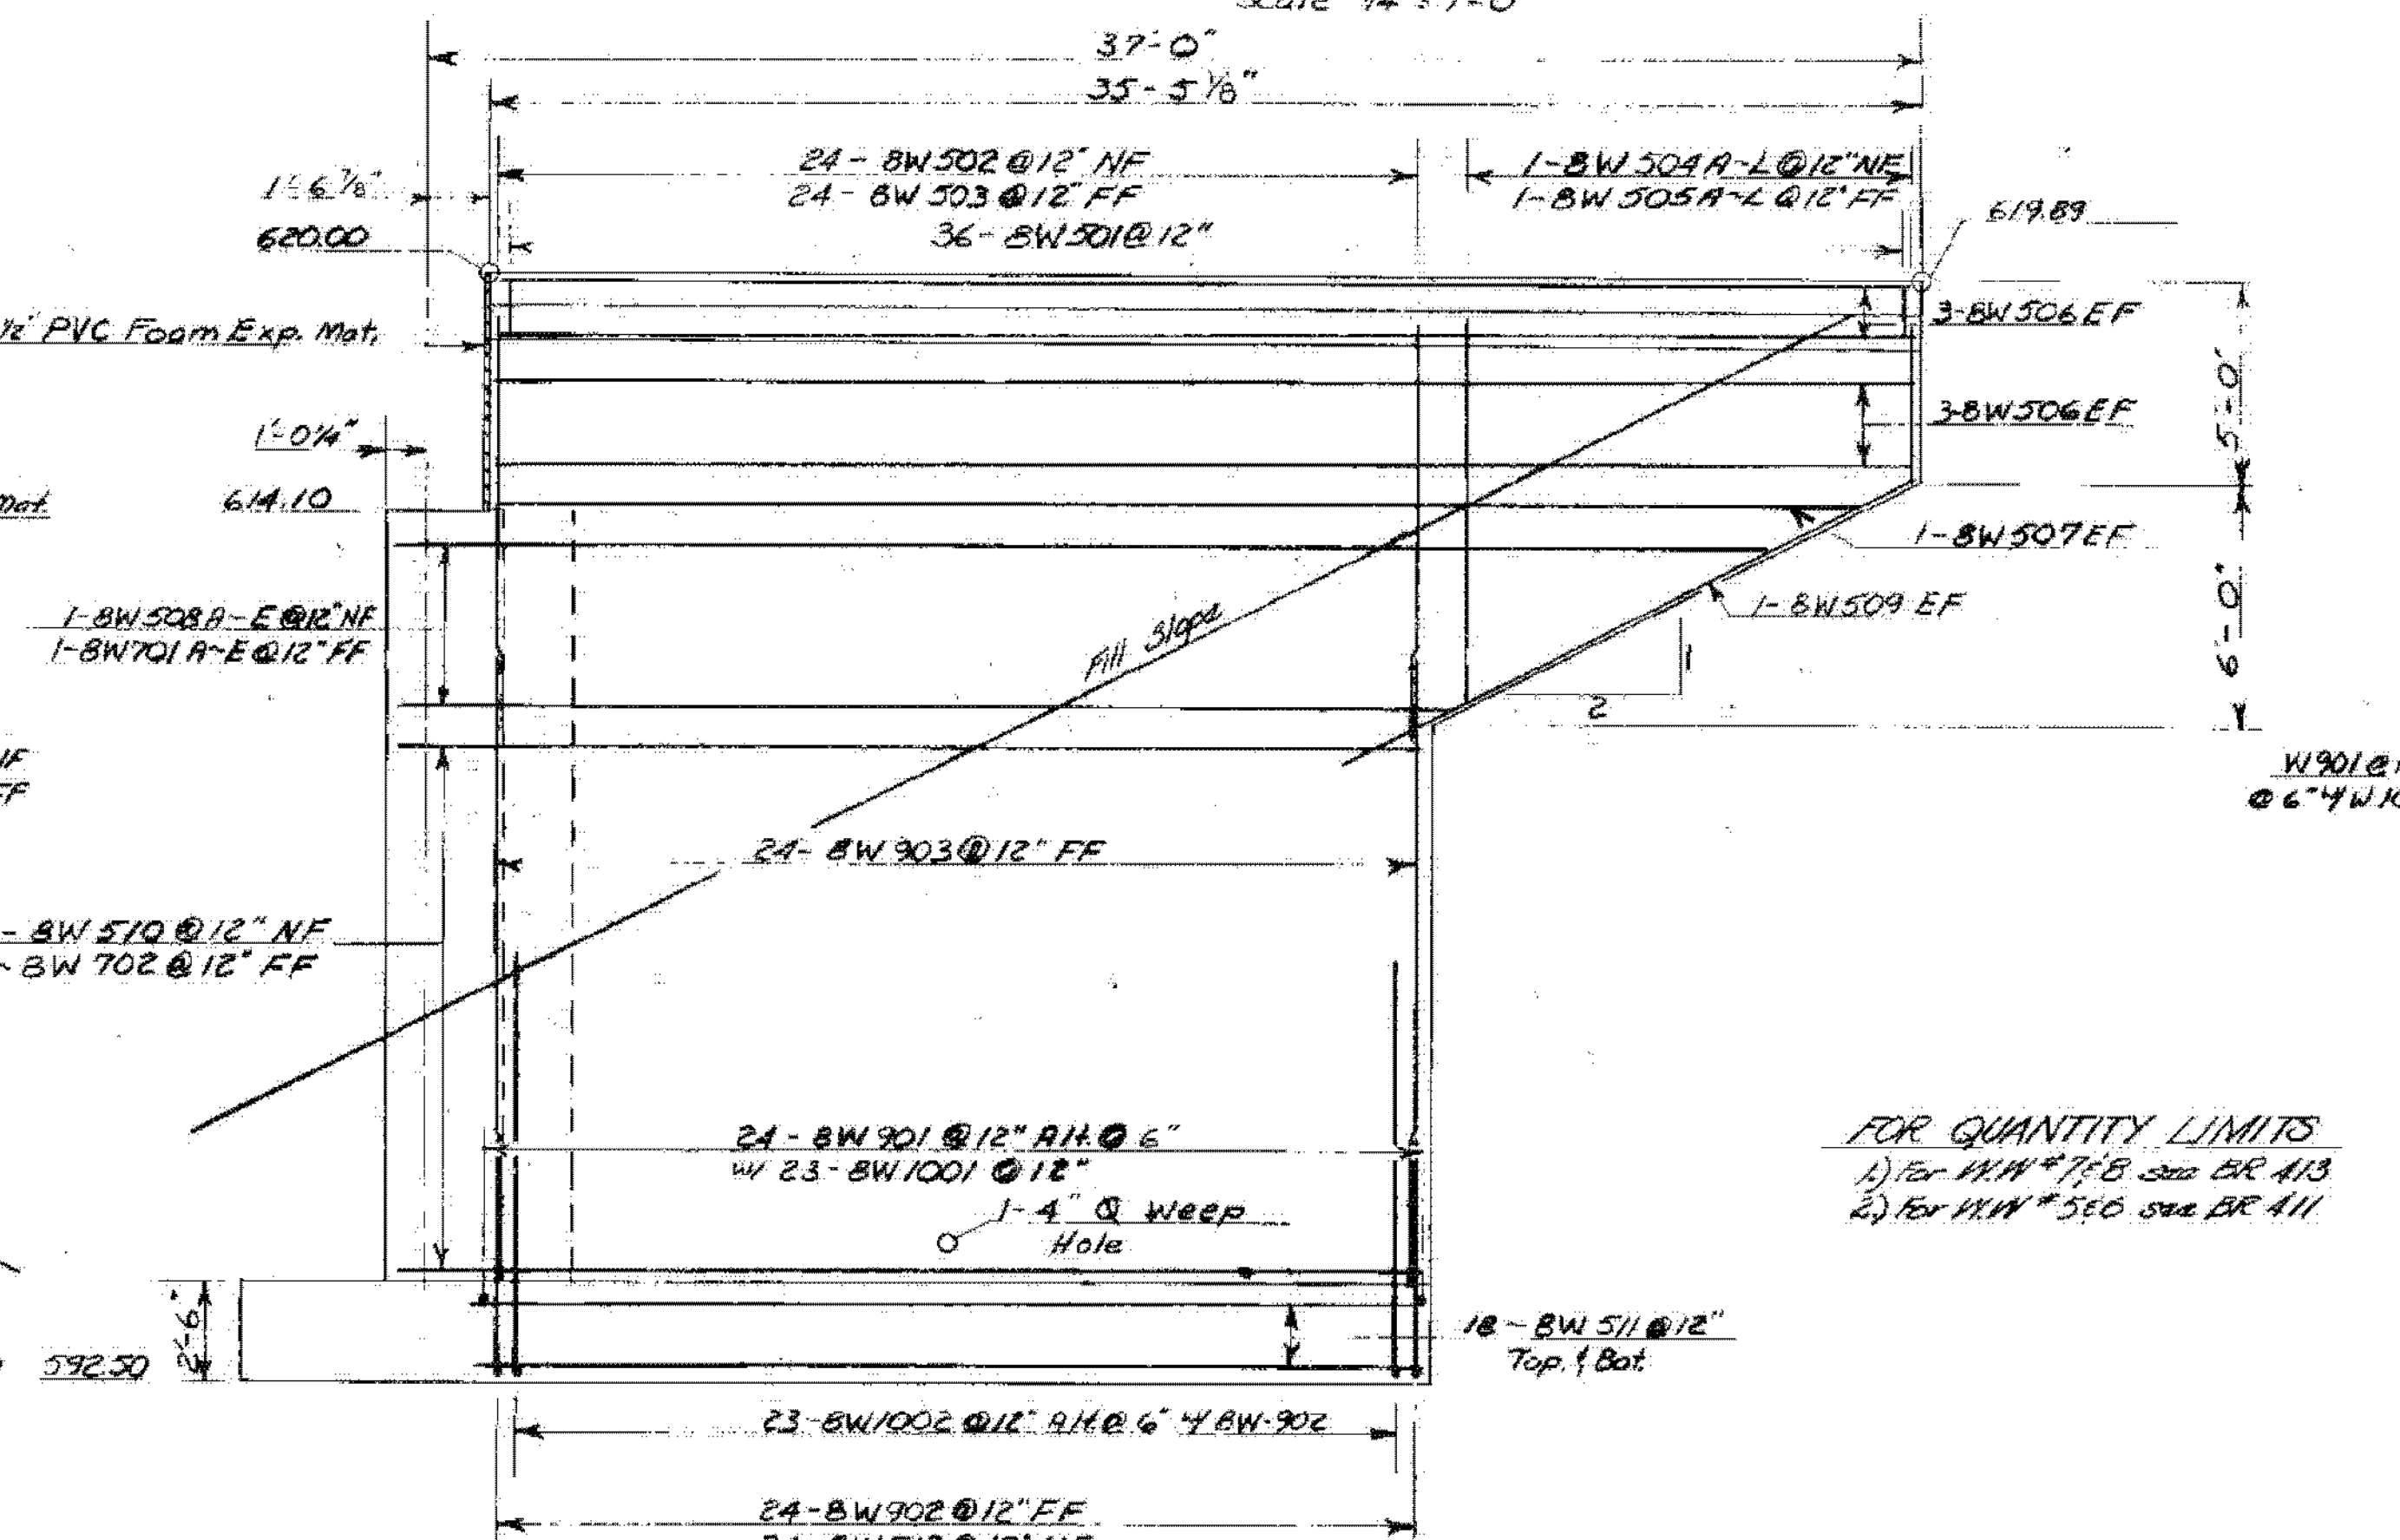

Wingwall # 8 Elev. View
Scale 1/4" = 1'-0"

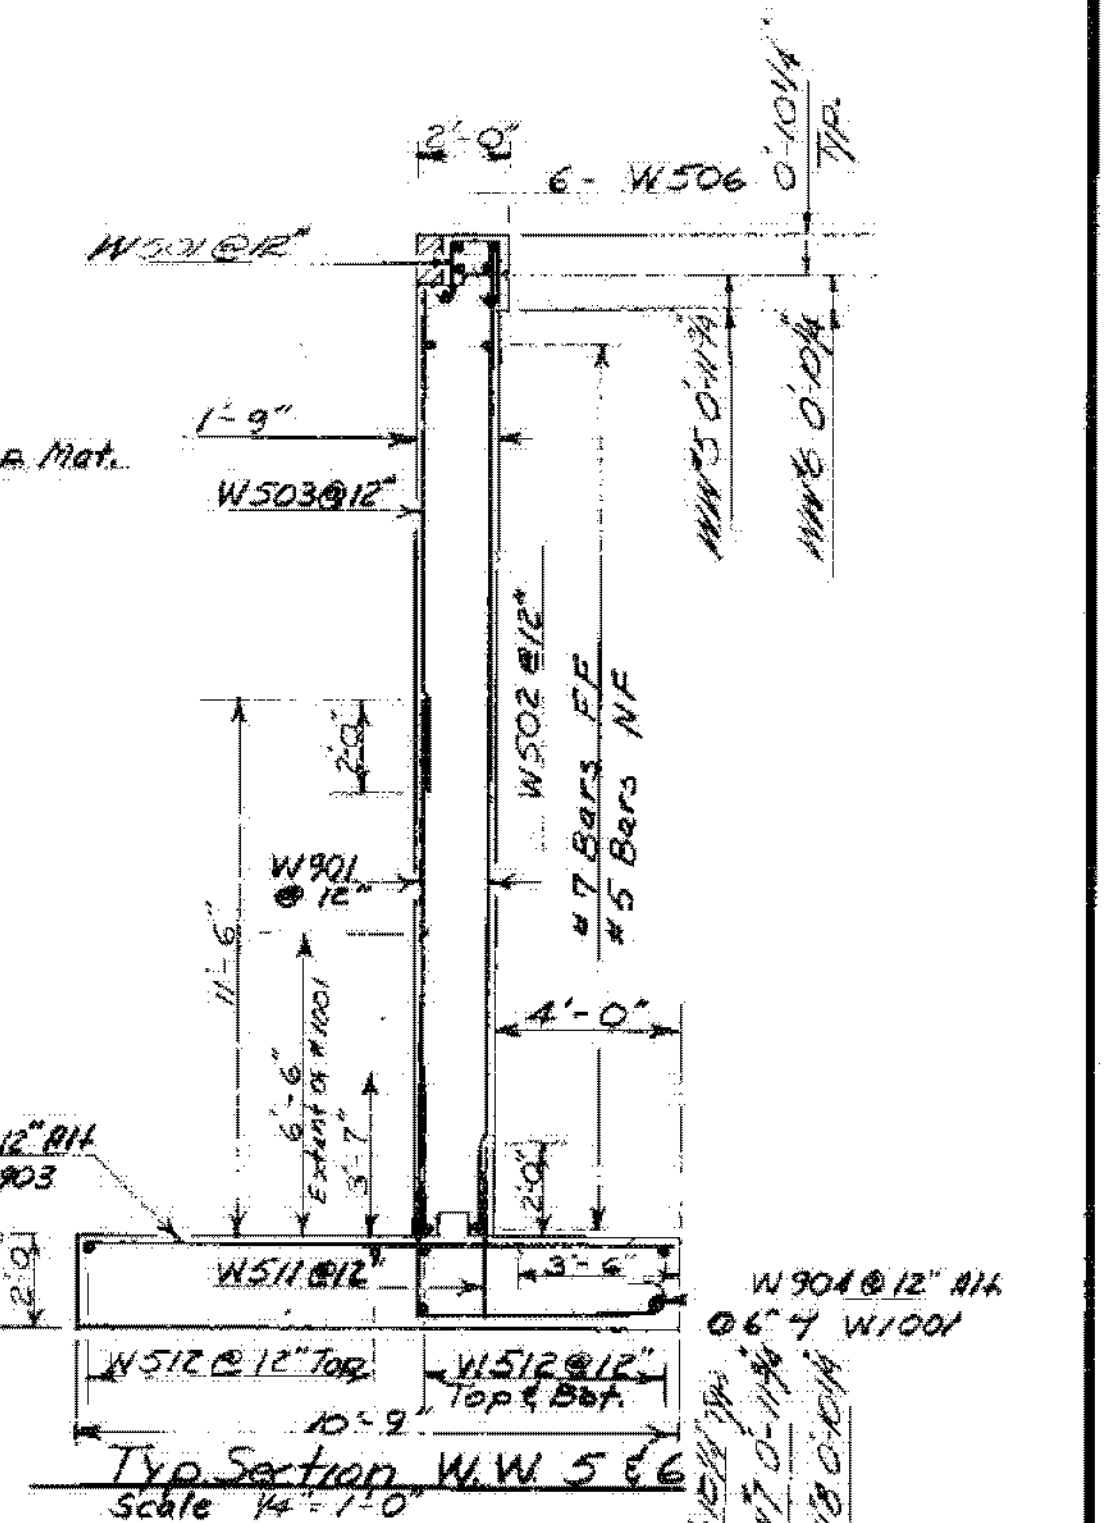

Typ. Section W.W. 5 & 6
Scale 1/4" = 1'-0"

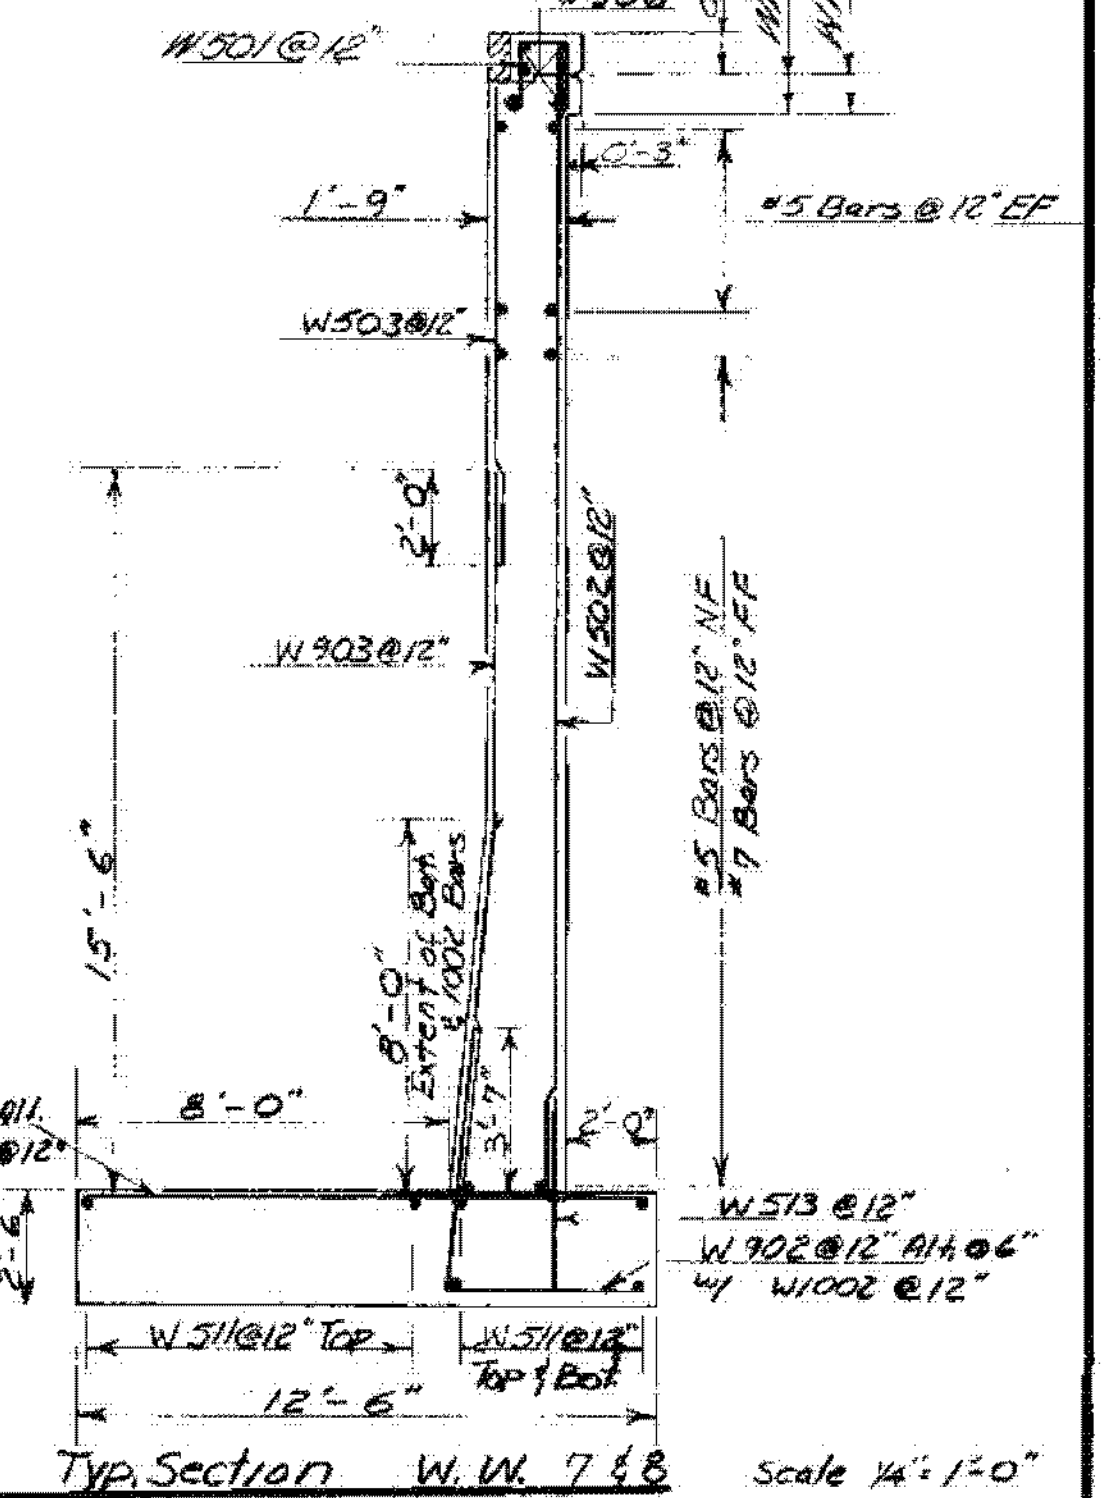

Typ. Section W.W. 7 & 8
Scale 1/4" = 1'-0"

FOR QUANTITY LIMITS
1) For W.W. # 7 & 8 see BR 413
2) For W.W. # 5 & 6 see BR 411

STATE OF DEPARTMENT WATERFORD - ST. JOHNSBURY MM MEMB(32) SHEET 23 OF 43 FOR REFERENCE ONLY		I-91 BRIDGES 81N&S Bridge No. 4 Log Sta. _____ Surv. Sta. 6812+0
		TOWN OF WATERFORD HIGHWAY NO. I 91 INT. RTE. 91 NB & SB OVER RAMP S. TO E. WINGWALL 5, 6, 7 & 8 DETAILS Designed by J. BURNETT Checked by J. BURNETT date 3/19/76 PROJECT BARNET - ST. JOHNSBURY Bridge Sheet No. BR 415
Drawn by W. STODDARD Bridge Design Supervisor date 3/76 PROJECT NO. EACI 91-2(59) Sheet 119 p of 358		

WINGWALL DIMENSIONS
REVISION 12/8/76