
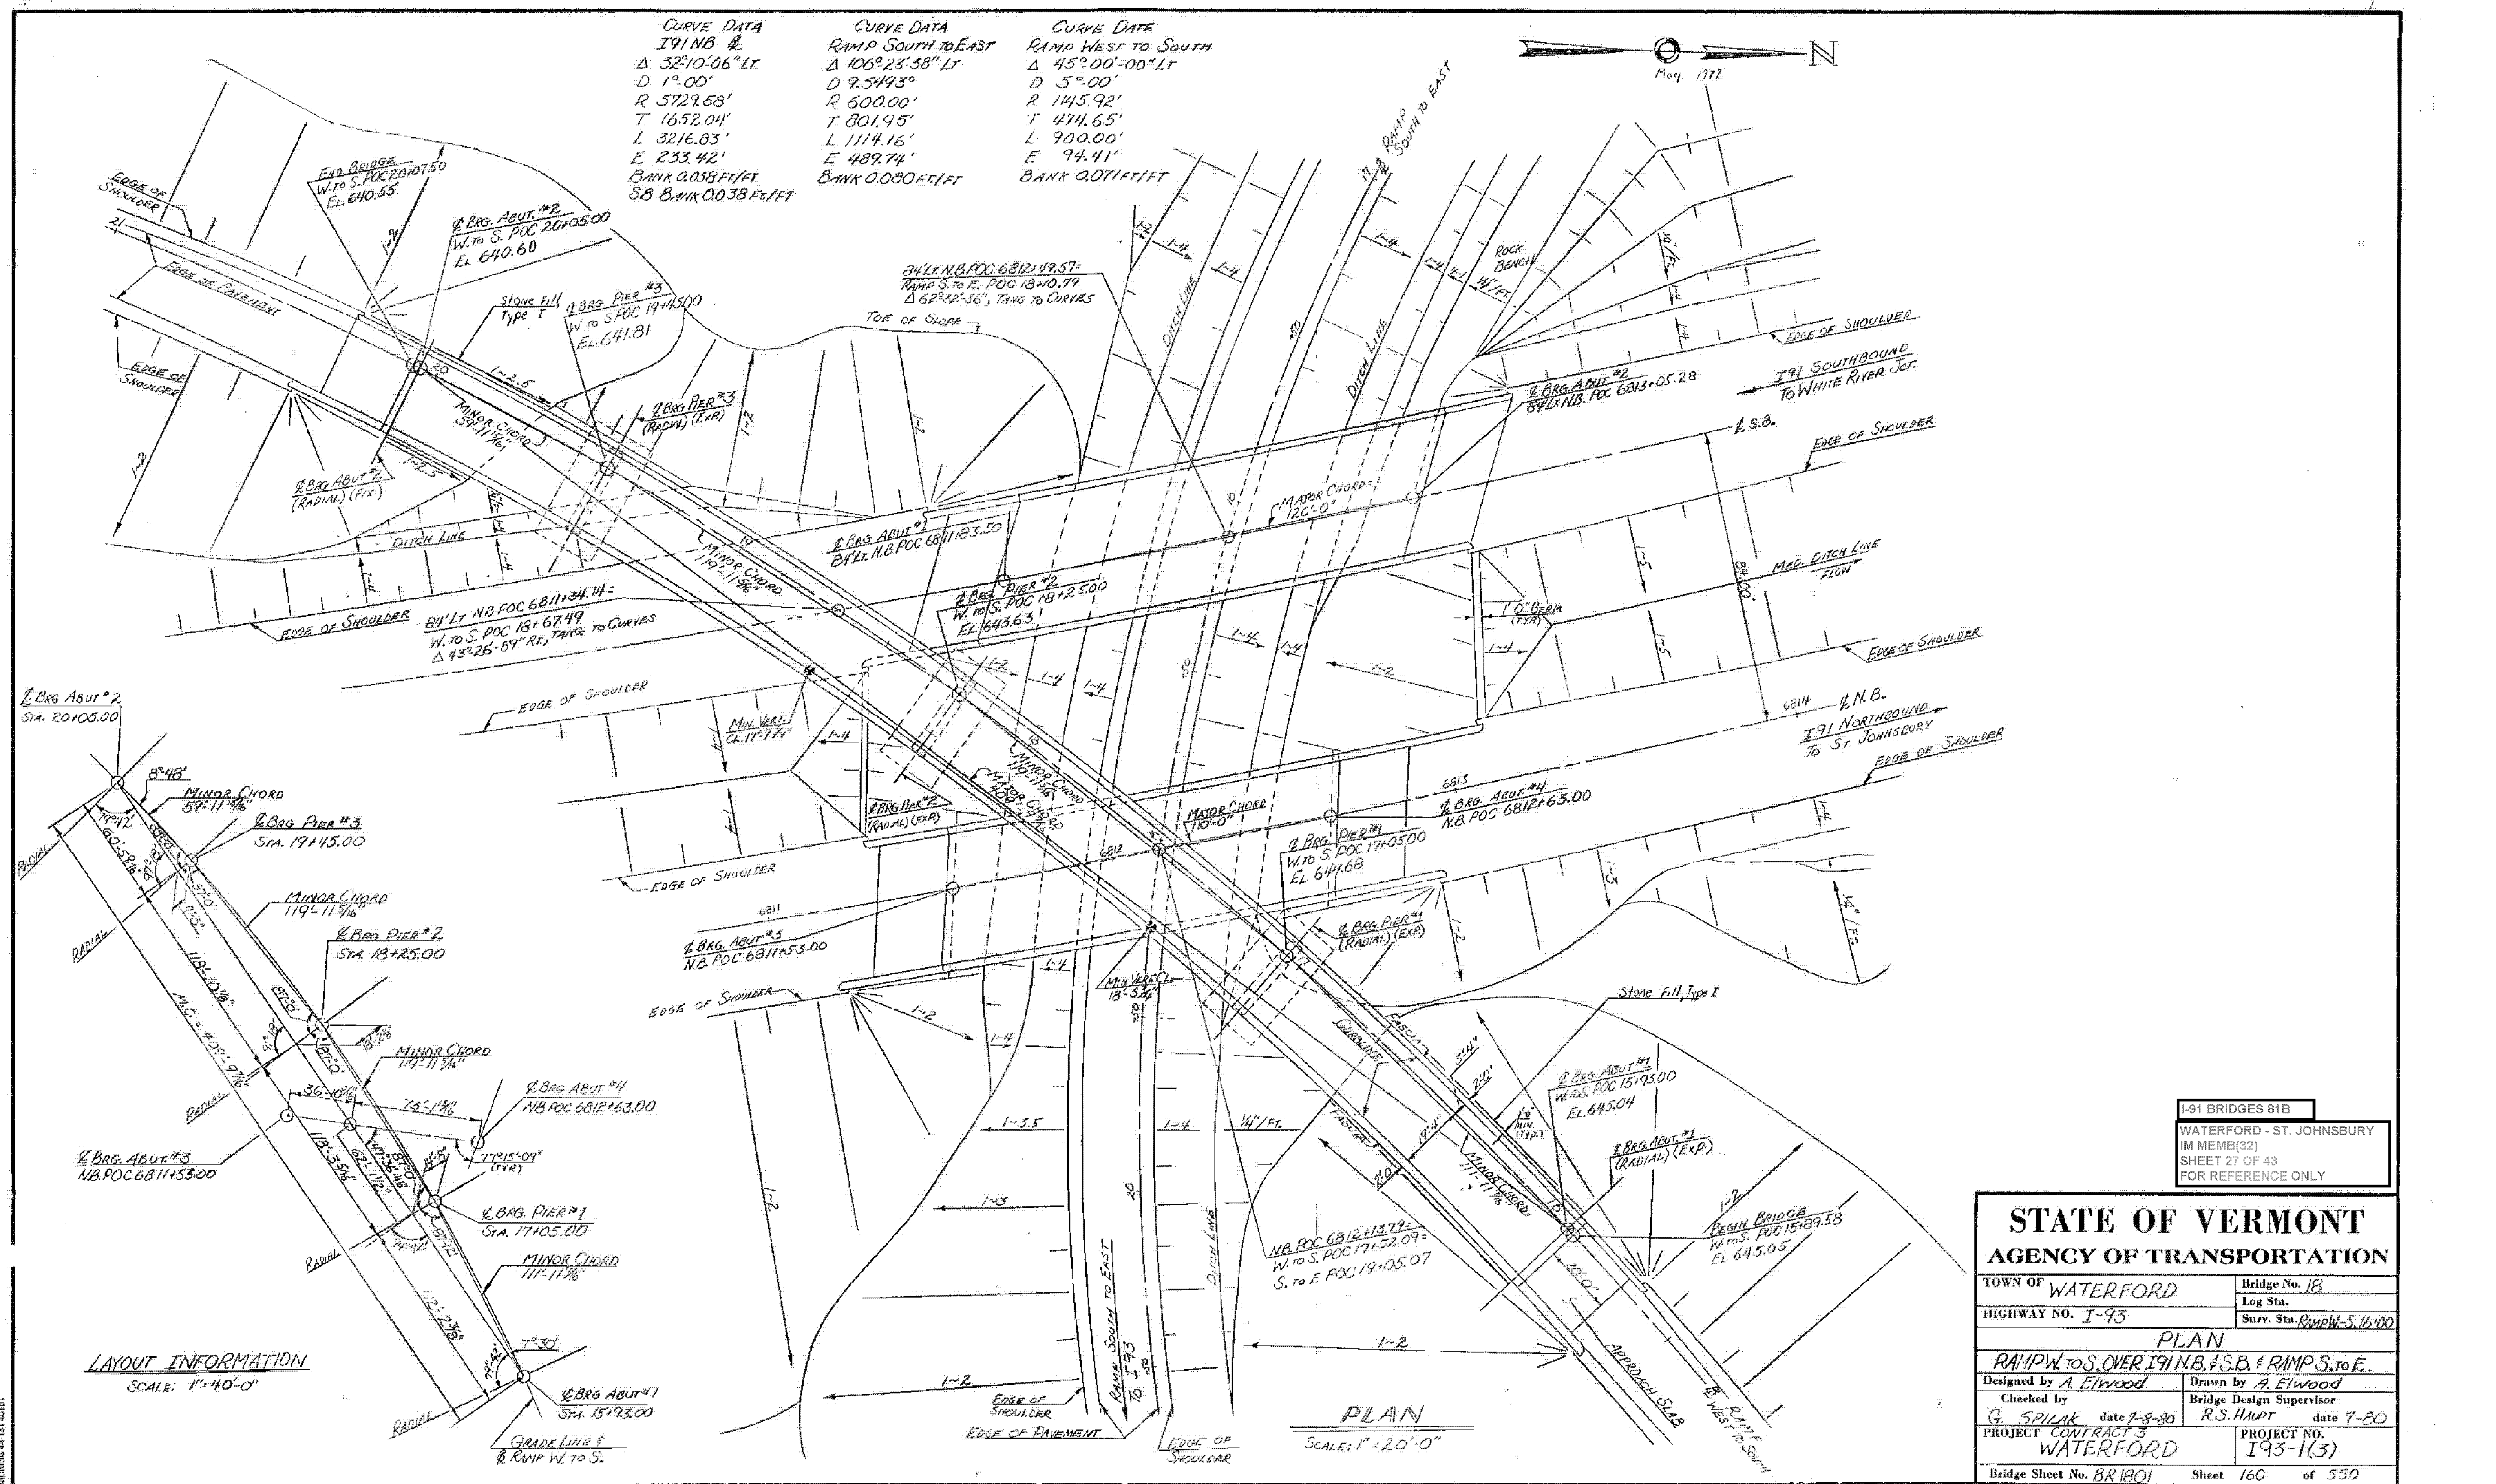


CURVE DATA	CURVE DATA	CURVE DATA
I91 NB #2	RAMP SOUTH TO EAST	RAMP WEST TO SOUTH
Δ 32°10'06" LT	Δ 106°23'38" LT	Δ 45°00'00" LT
D 1°00'	D 9.5493°	D 5°00'
R 5729.58'	R 600.00'	R 1745.92'
T 1652.04'	T 801.95'	T 474.65'
L 3216.83'	L 1114.16'	L 900.00'
E 233.42'	E 489.74'	E 94.41'
BANK 0.058 FE/FT	BANK 0.080 FE/FT	BANK 0.071 FE/FT
S/B BANK 0.038 FE/FT		

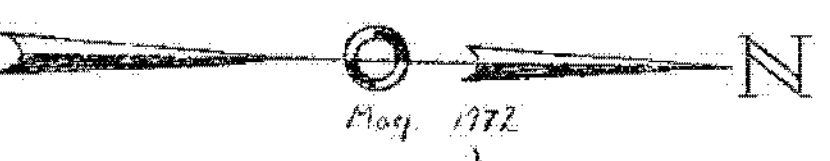

LAYOUT INFORMATION
SCALE: 1" = 40'-0"

PLAN
SCALE: 1" = 20'-0"

I-91 BRIDGES 81B
WATERFORD - ST. JOHNSBURY
IM MEMB(32)
SHEET 27 OF 43
FOR REFERENCE ONLY

STATE OF VERMONT	
AGENCY OF TRANSPORTATION	
TOWN OF WATERFORD	Bridge No. 18
HIGHWAY NO. I-93	Log Sta.
	Surv. Sta. RAMP W-S, 15+00
PLAN	
RAMP W TO S OVER I91 NB, S/B, & RAMP S TO E.	
Designed by A. Elwood	Drawn by A. Elwood
Checked by G. Spilak date 7-8-80	Bridge Design Supervisor R.S. Haupt date 7-80
PROJECT CONTRACT NO. WATERFORD	PROJECT NO. I93-1(3)
Bridge Sheet No. BR1801	Sheet 160 of 550

BRIDGE 44-13-1-02151