


W/REPAIRS ~ ST. JOHNSBURY
IM MEMB (32)

BRIDGE 81B

HORIZ: 1" = 6'

VERT: 1" = 30'

LCB
10/19/12

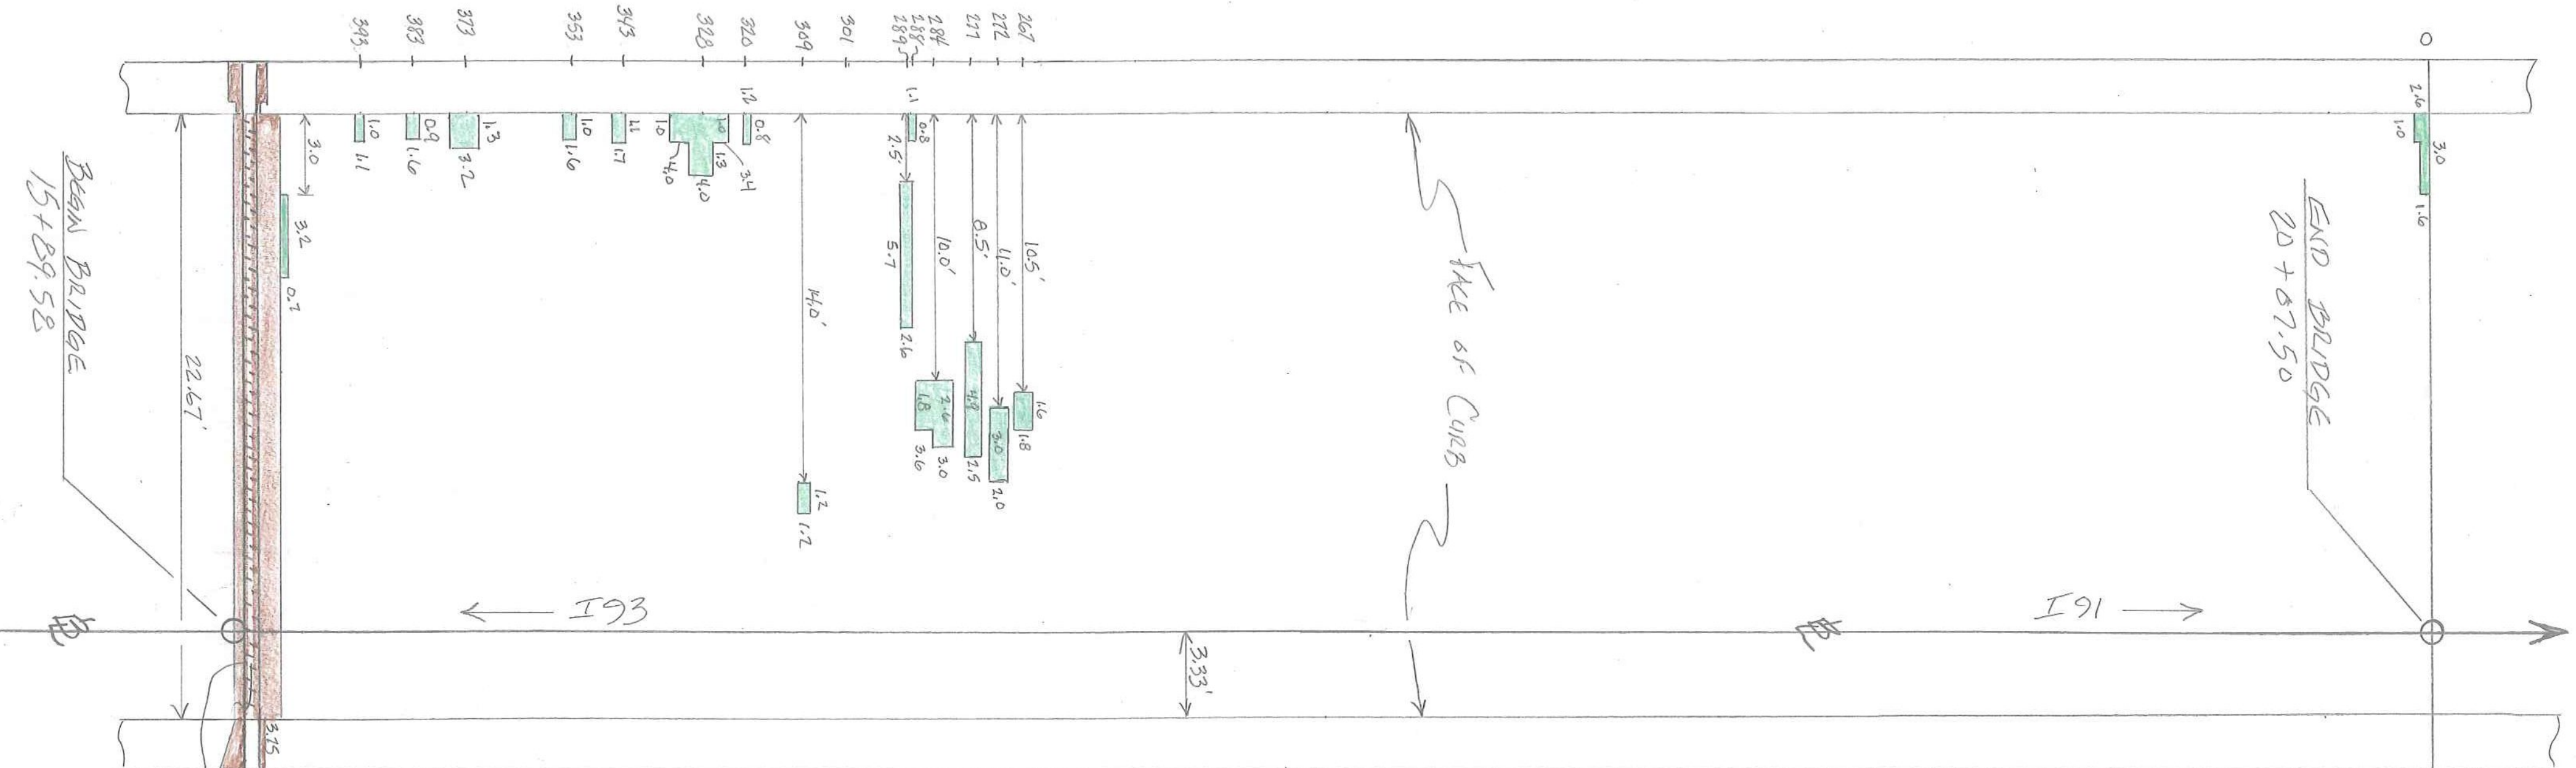

== Deck REPAIRS ==
CLASS I
CLASS III

Basal BRIDGE
15+89.58

END BRIDGE
20+87.50

FRIDGEPLATE (NEW)