


WATERFORD-ST JOHNSBURY IM MEMB (32)

CURB

IDR 7-13-12

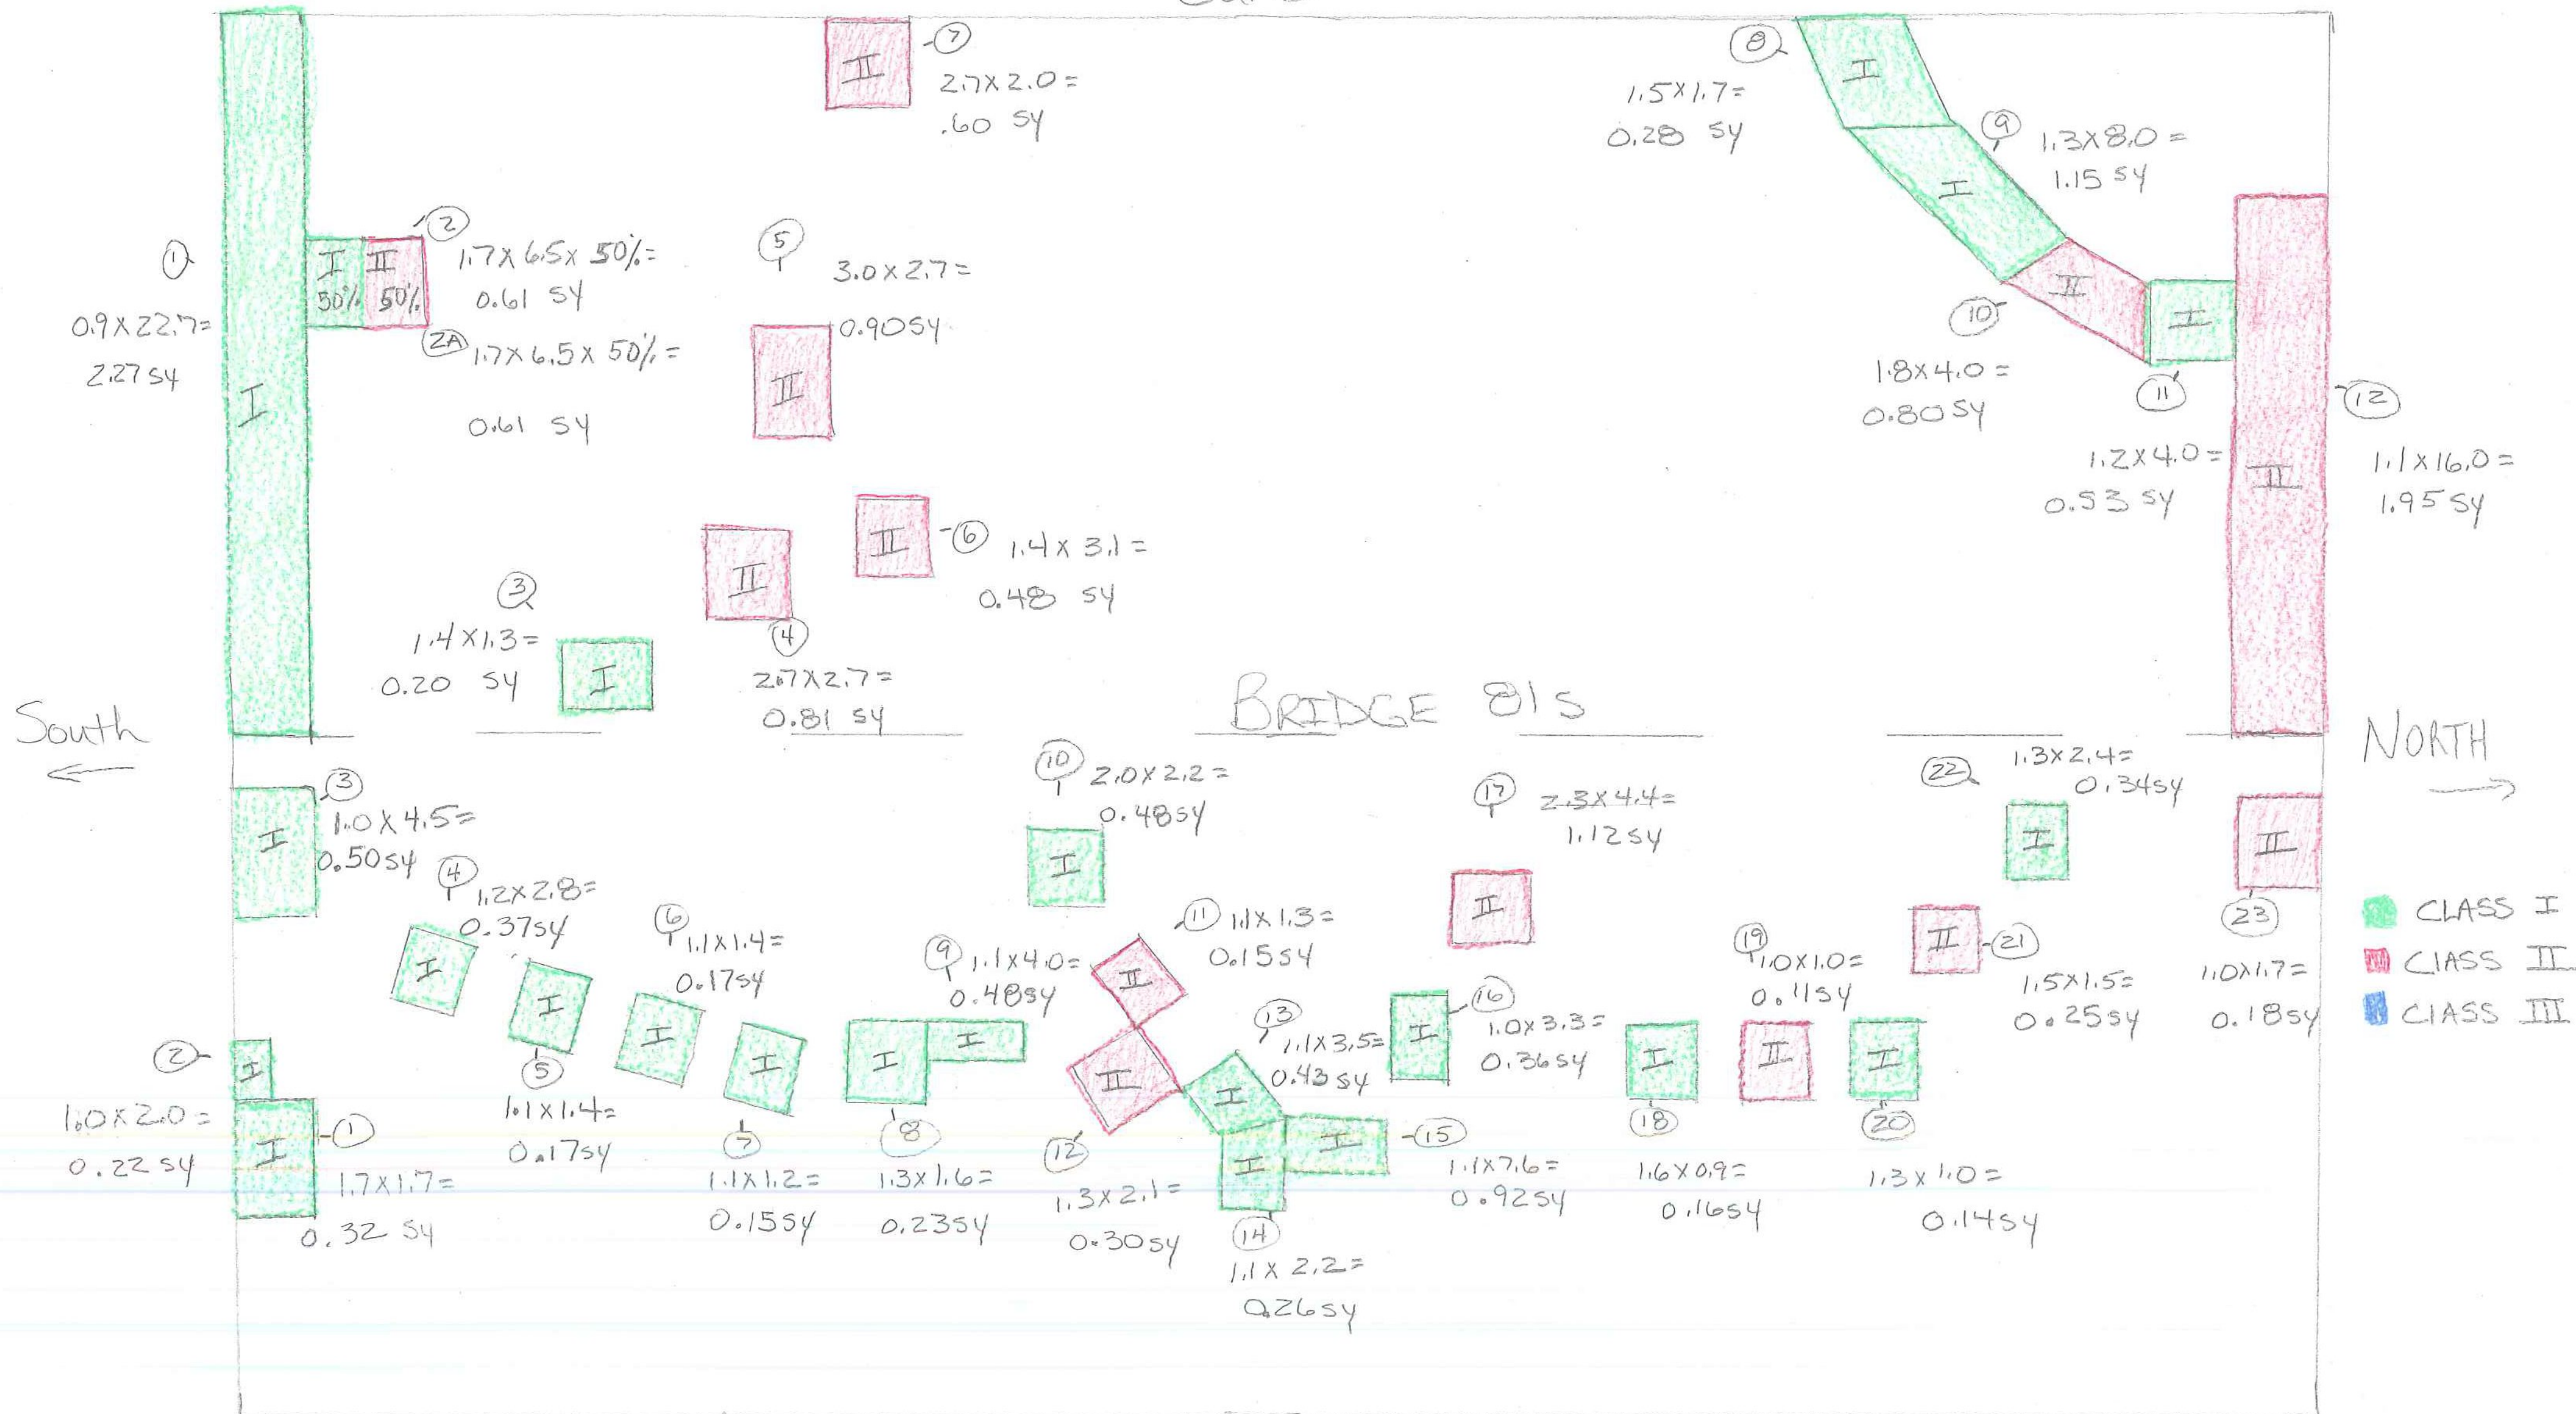

CURB

IDR 8-16-12

Drawn By  
Cindy Porter