

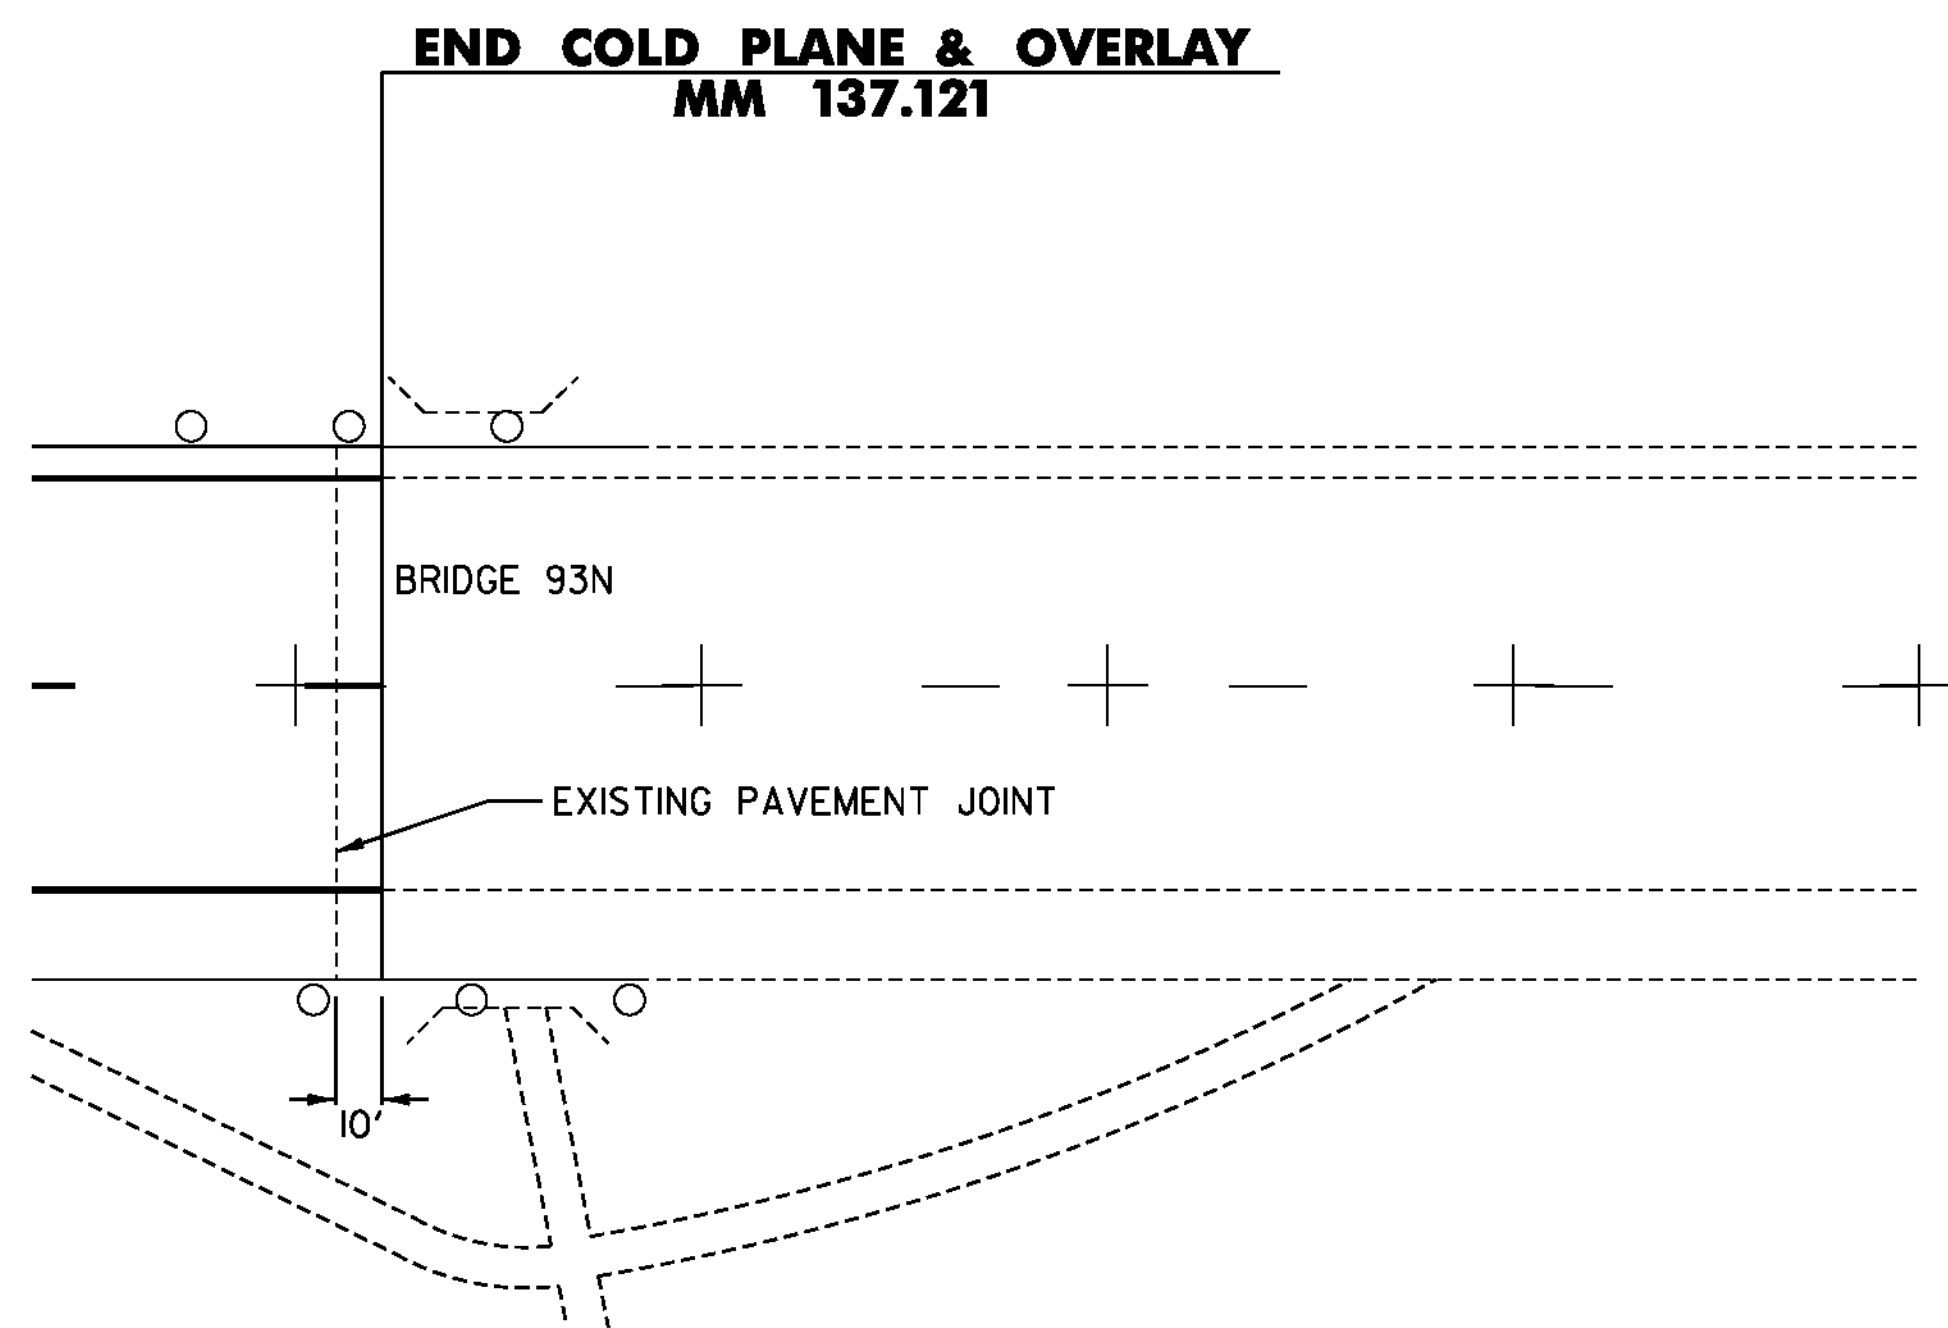


EXIT 23
RAMP A - SB ON RAMP
RAMP C - NB OFF RAMP
RAMP E - SB ON RAMP

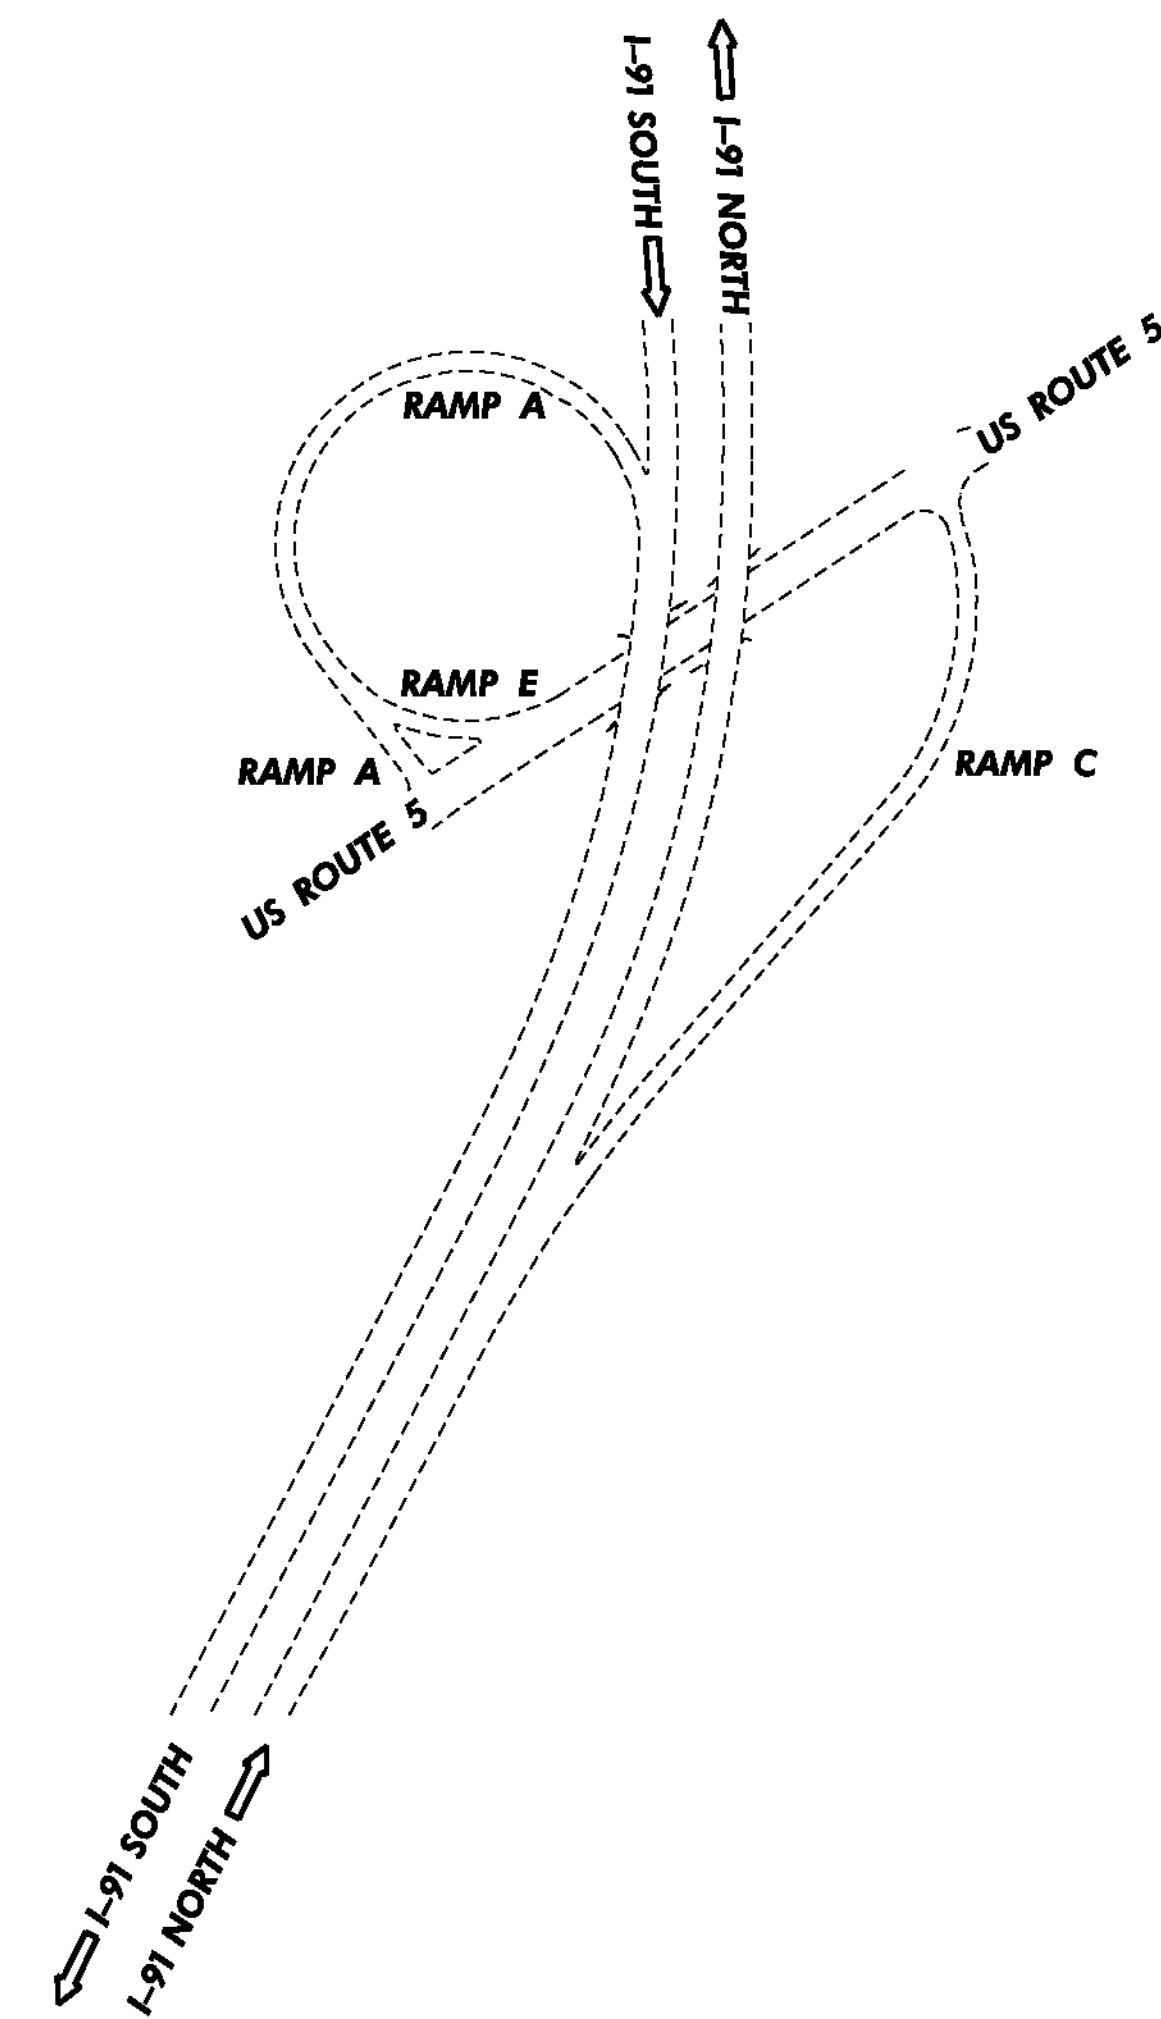

INTERSTATE 91 NB
END IM 091-3(50)

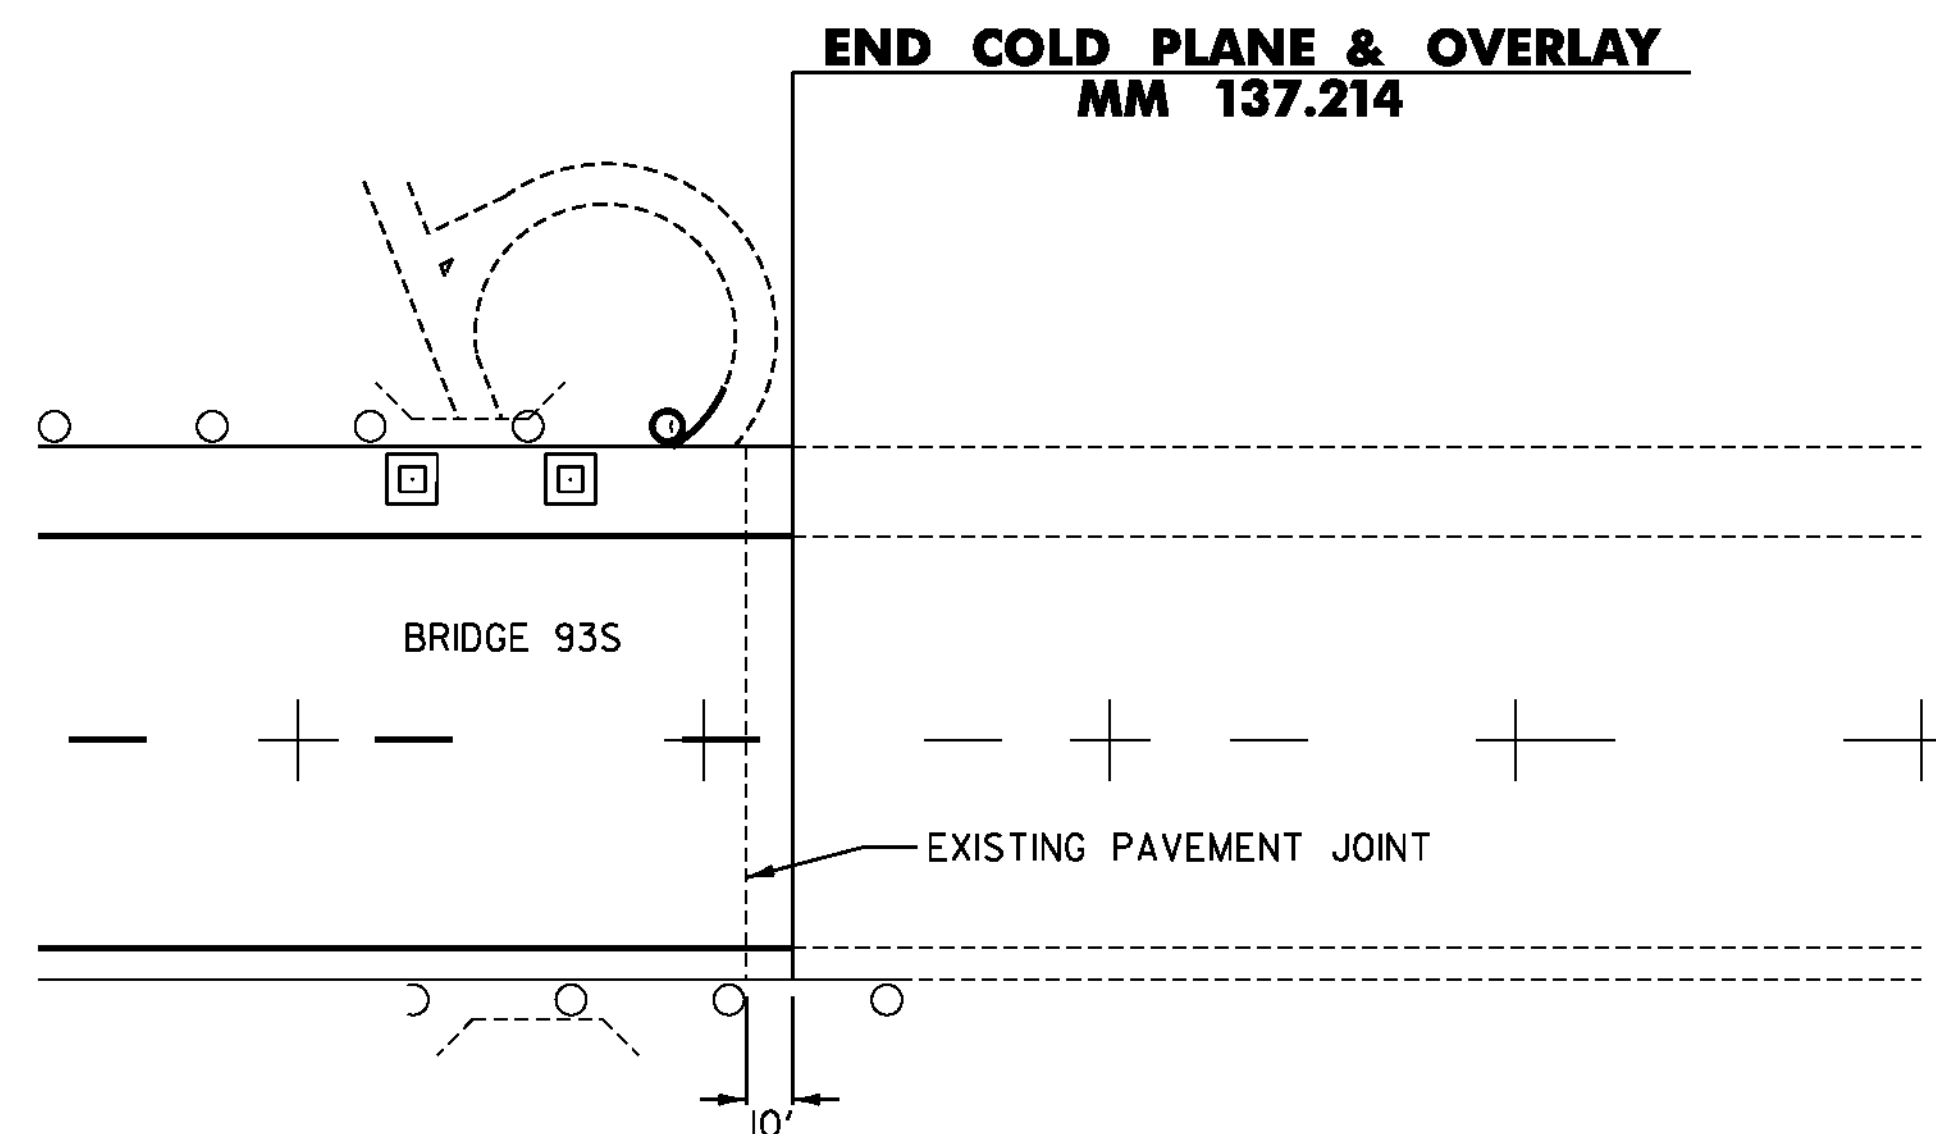

INTERSTATE 91 SB
END IM 091-3(50)

EXIT 23 LAYOUT

TIE SHEET 4

PROJECT NAME:	ST. JOHNSBURY-LYNDON	FILE NAME:	lla346/cos/zlla346+1.dgn	PLOT DATE:	10/17/2013
PROJECT NUMBER:	IM 091-3(50)	PROJECT LEADER:	PTS	DRAWN BY:	JLS
		DESIGNED BY:	NLL	CHECKED BY:	PTS
		IPARM FILE NAME:	plla346_06	SHEET	6 OF 72

NOT TO SCALE