


NOTE
 1. SEE ITEM DETAIL SHEET FOR REMOVAL OF EXISTING GUARDRAIL.

GUARDRAIL TREATMENT - BRIDGE 82N AND 82S

NORTHBOUND MM 128.632
 SOUTHBOUND MM 128.626
 INTERSTATE 91 OVER TH 77/RR

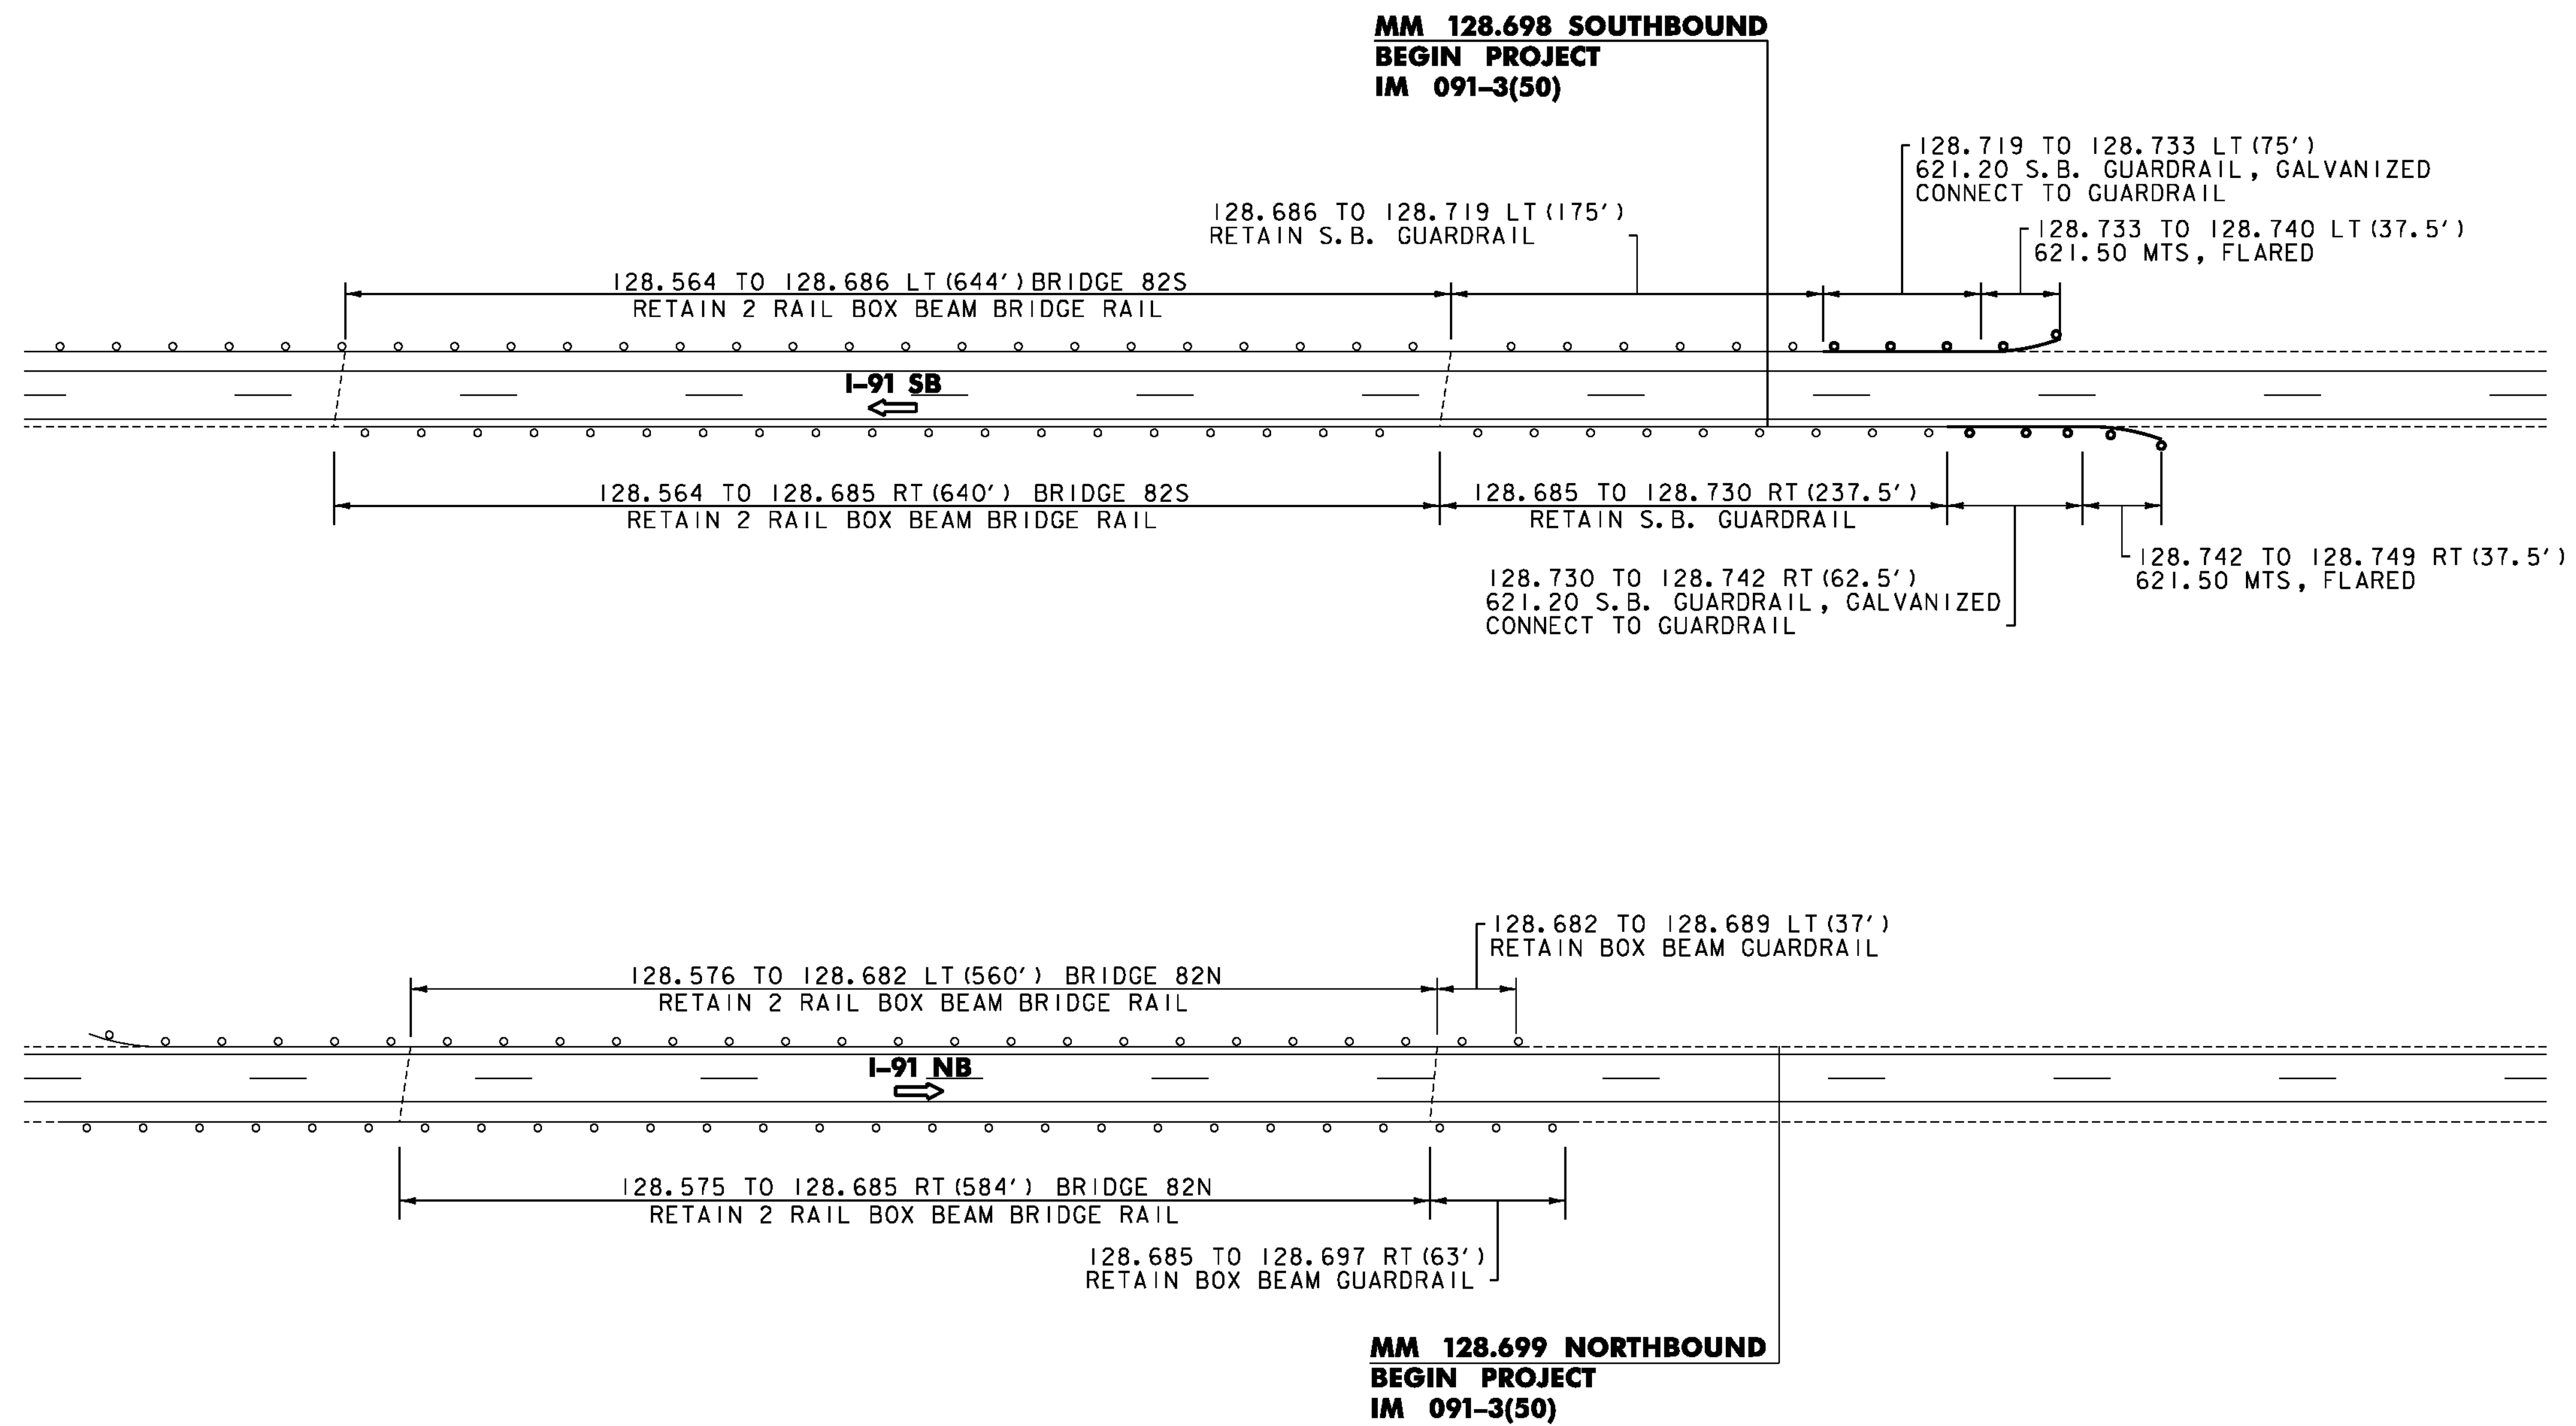

NOT TO SCALE

**BRIDGE /GUARDRAIL
 TREATMENT DETAIL SHEET 1**

PROJECT NAME: ST. JOHNSBURY-LYNDON	
PROJECT NUMBER: IM 091-3(50)	
FILE NAME: Ila346/cos/zlla346frm.dgn	PLOT DATE: 10/17/2013
PROJECT LEADER: PTS	DRAWN BY: JLS
DESIGNED BY: NULL	CHECKED BY: PTS
IPARM FILE NAME: plla346_23	SHEET 23 OF 72