


NOTE
 1. SEE ITEM DETAIL SHEET FOR REMOVAL OF EXISTING GUARDRAIL.

GUARDRAIL TREATMENT - BRIDGE 83N AND 83S

NORTHBOUND MM 128.930
 SOUTHBOUND MM 128.907
 INTERSTATE 91 OVER US ROUTE 5

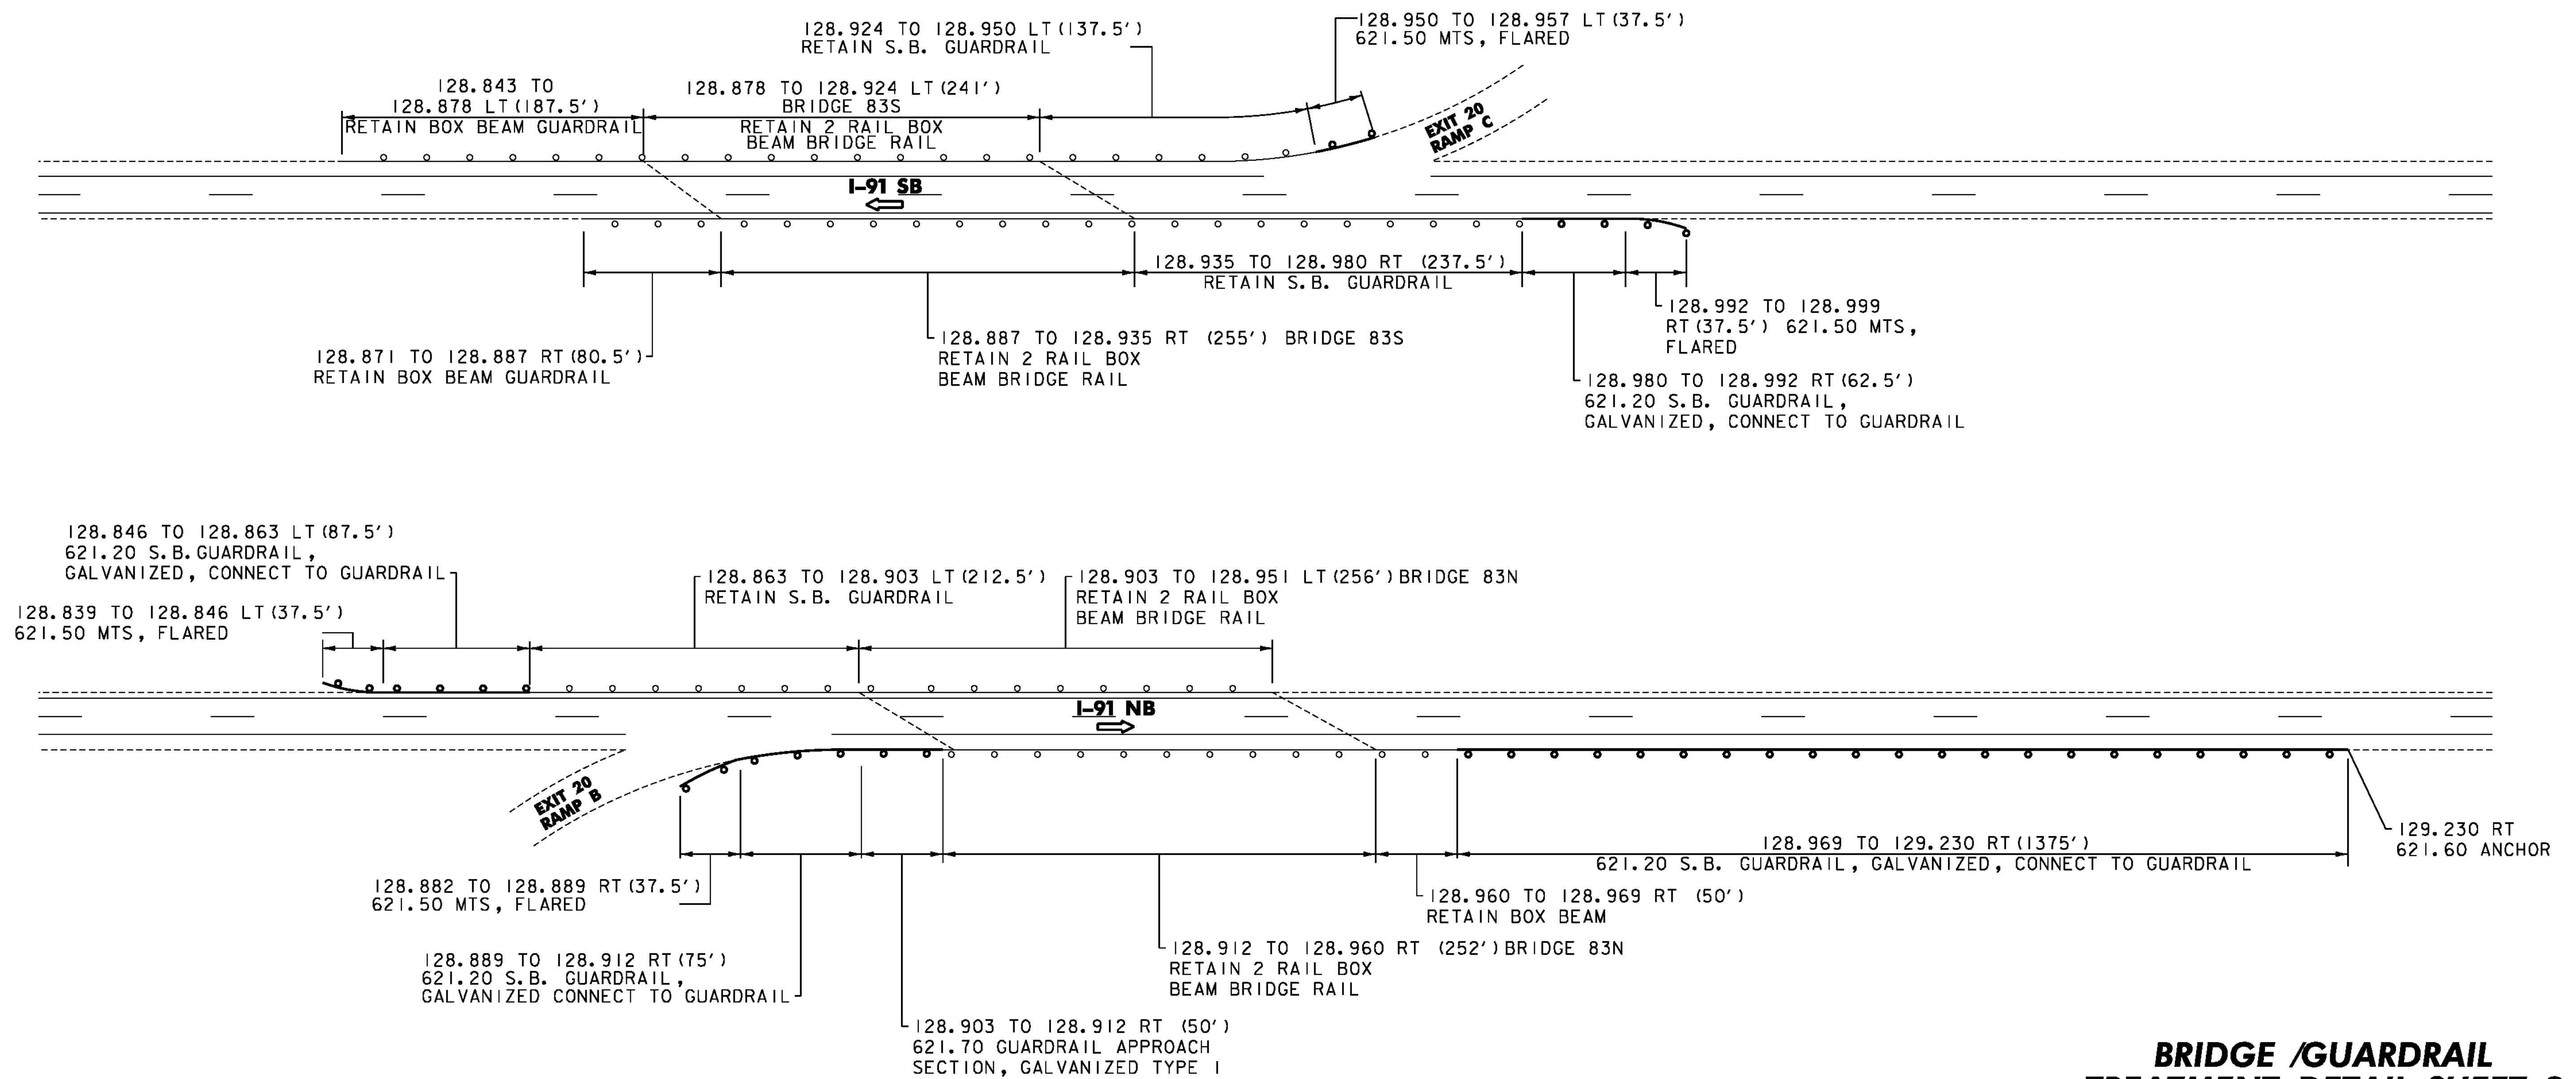

NOT TO SCALE

**BRIDGE /GUARDRAIL
 TREATMENT DETAIL SHEET 2**

PROJECT NAME: ST. JOHNSBURY-LYNDON	PROJECT NUMBER: IM 091-3(50)
FILE NAME: Ila346/cos/zlla346frm.dgn	PLOT DATE: 10/17/2013
PROJECT LEADER: PTS	DRAWN BY: JLS
DESIGNED BY: NULL	CHECKED BY: PTS
IPARM FILE NAME: plla346_24	SHEET 24 OF 72