


NOTE
 1. SEE ITEM DETAIL SHEET FOR REMOVAL OF EXISTING GUARDRAIL.

GUARDRAIL TREATMENT - BRIDGE 84N AND 84S

NORTHBOUND MM 129.782
 SOUTHBOUND MM 129.774
 INTERSTATE 91 OVER TH 68

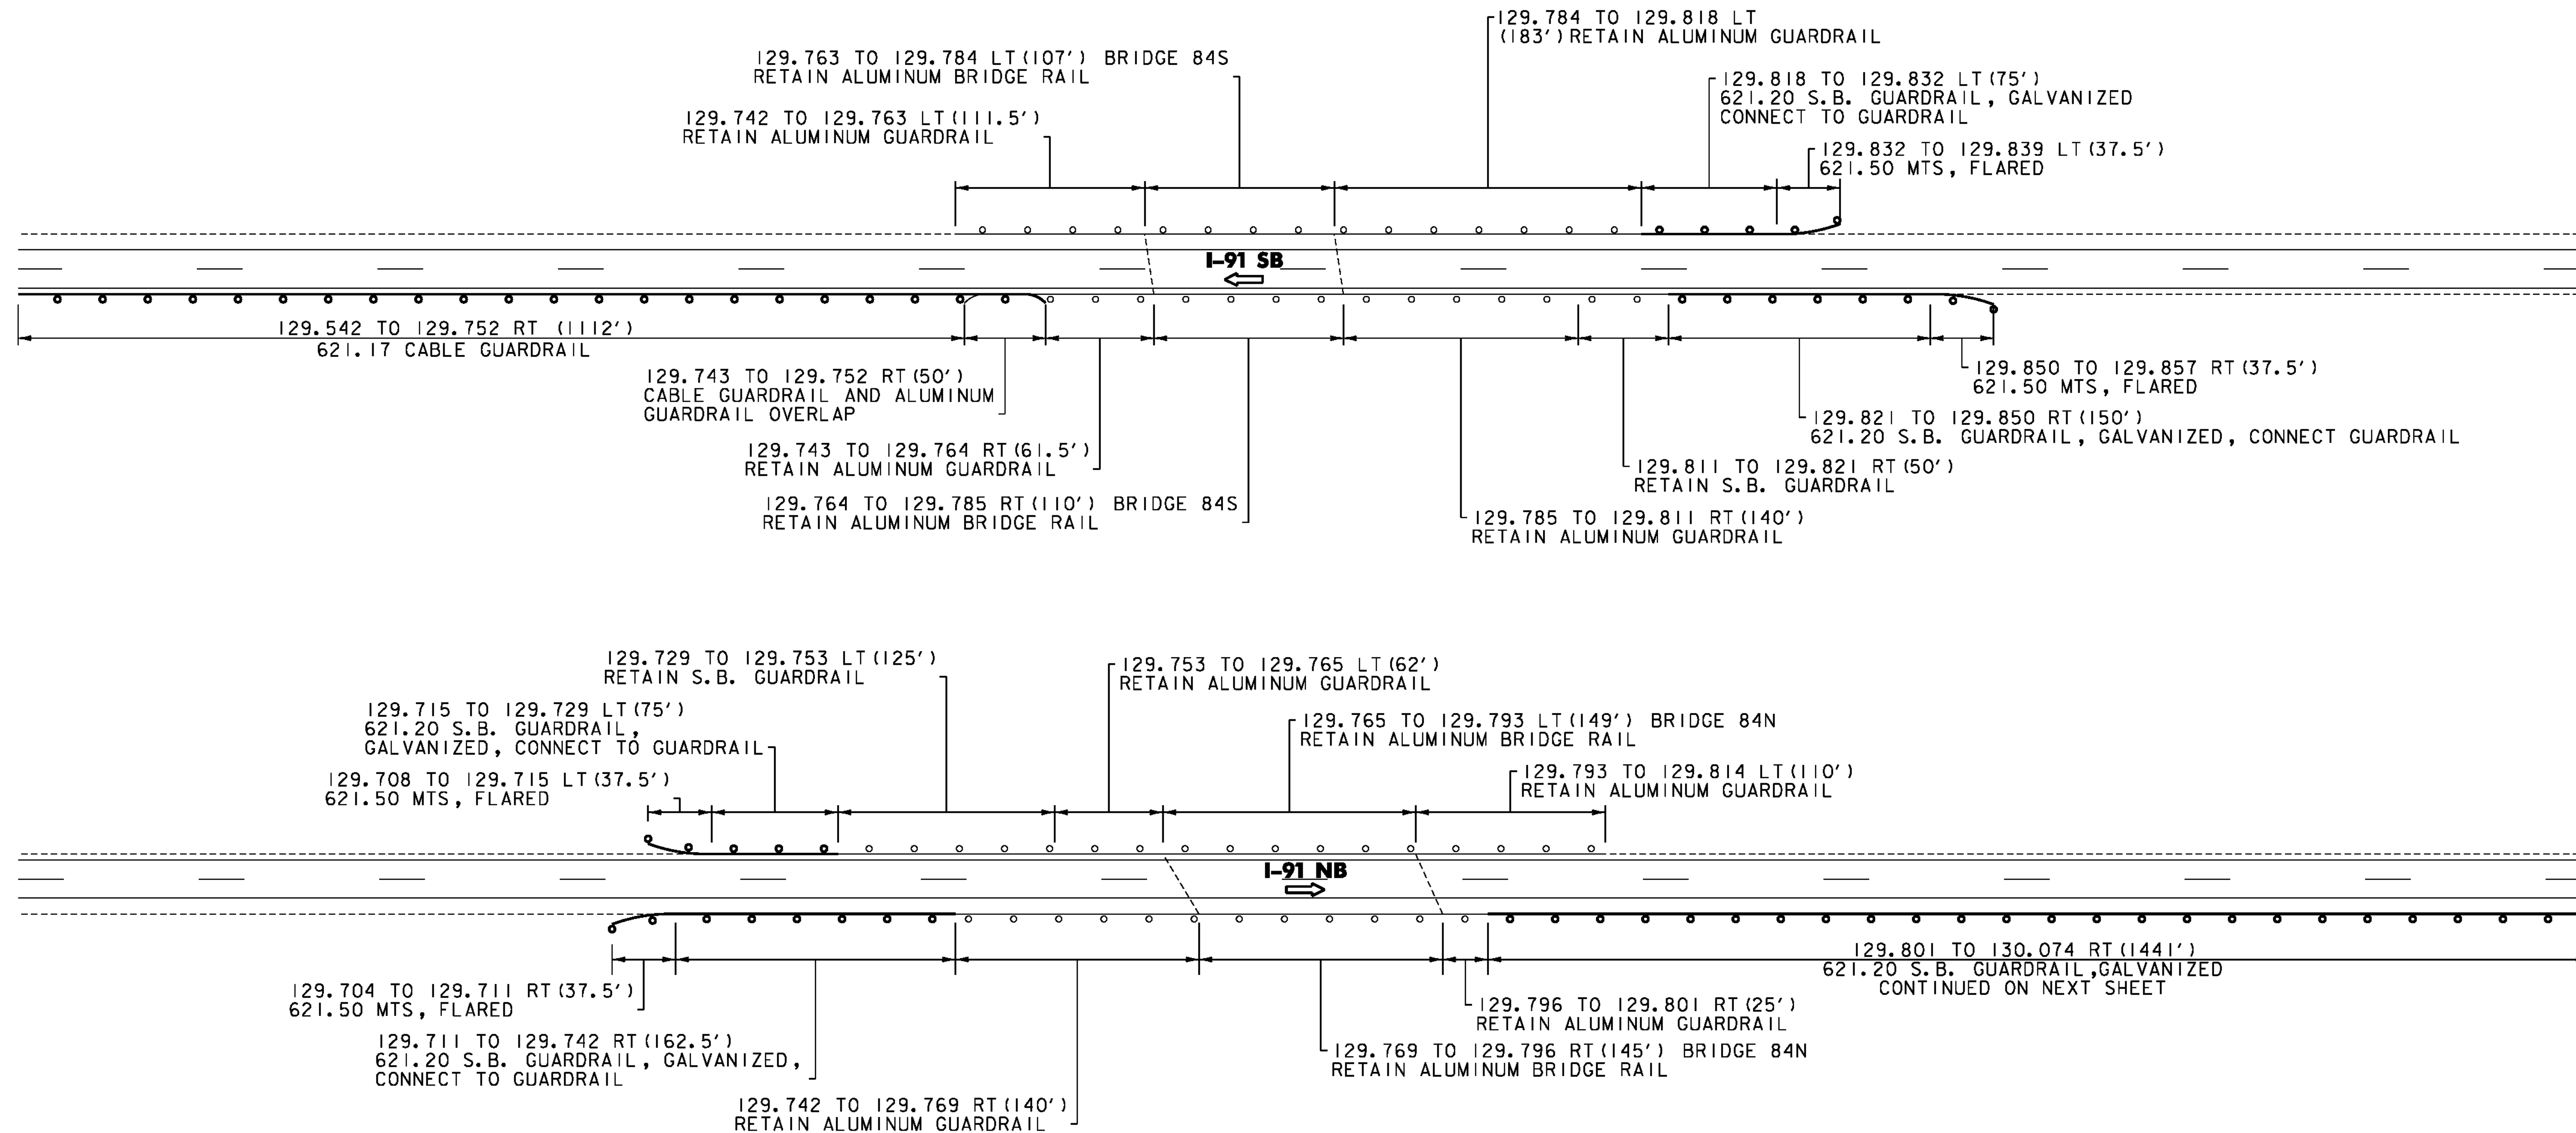

NOT TO SCALE

**BRIDGE /GUARDRAIL
 TREATMENT DETAIL SHEET 3**

PROJECT NAME: ST. JOHNSBURY-LYNDON	
PROJECT NUMBER: IM 091-3(50)	
FILE NAME: Ila346/cos/zlla346frm.dgn	PLOT DATE: 10/17/2013
PROJECT LEADER: PTS	DRAWN BY: JLS
DESIGNED BY: NLL	CHECKED BY: PTS
IPARM FILE NAME: plla346_25	SHEET 25 OF 72