


NOTE
 1. SEE ITEM DETAIL SHEET FOR REMOVAL OF EXISTING GUARDRAIL.

GUARDRAIL TREATMENT - BRIDGE 93N AND 93S

NORTHBOUND MM 137.148
 SOUTHBOUND MM 137.156
 INTERSTATE 91 OVER US ROUTE 5

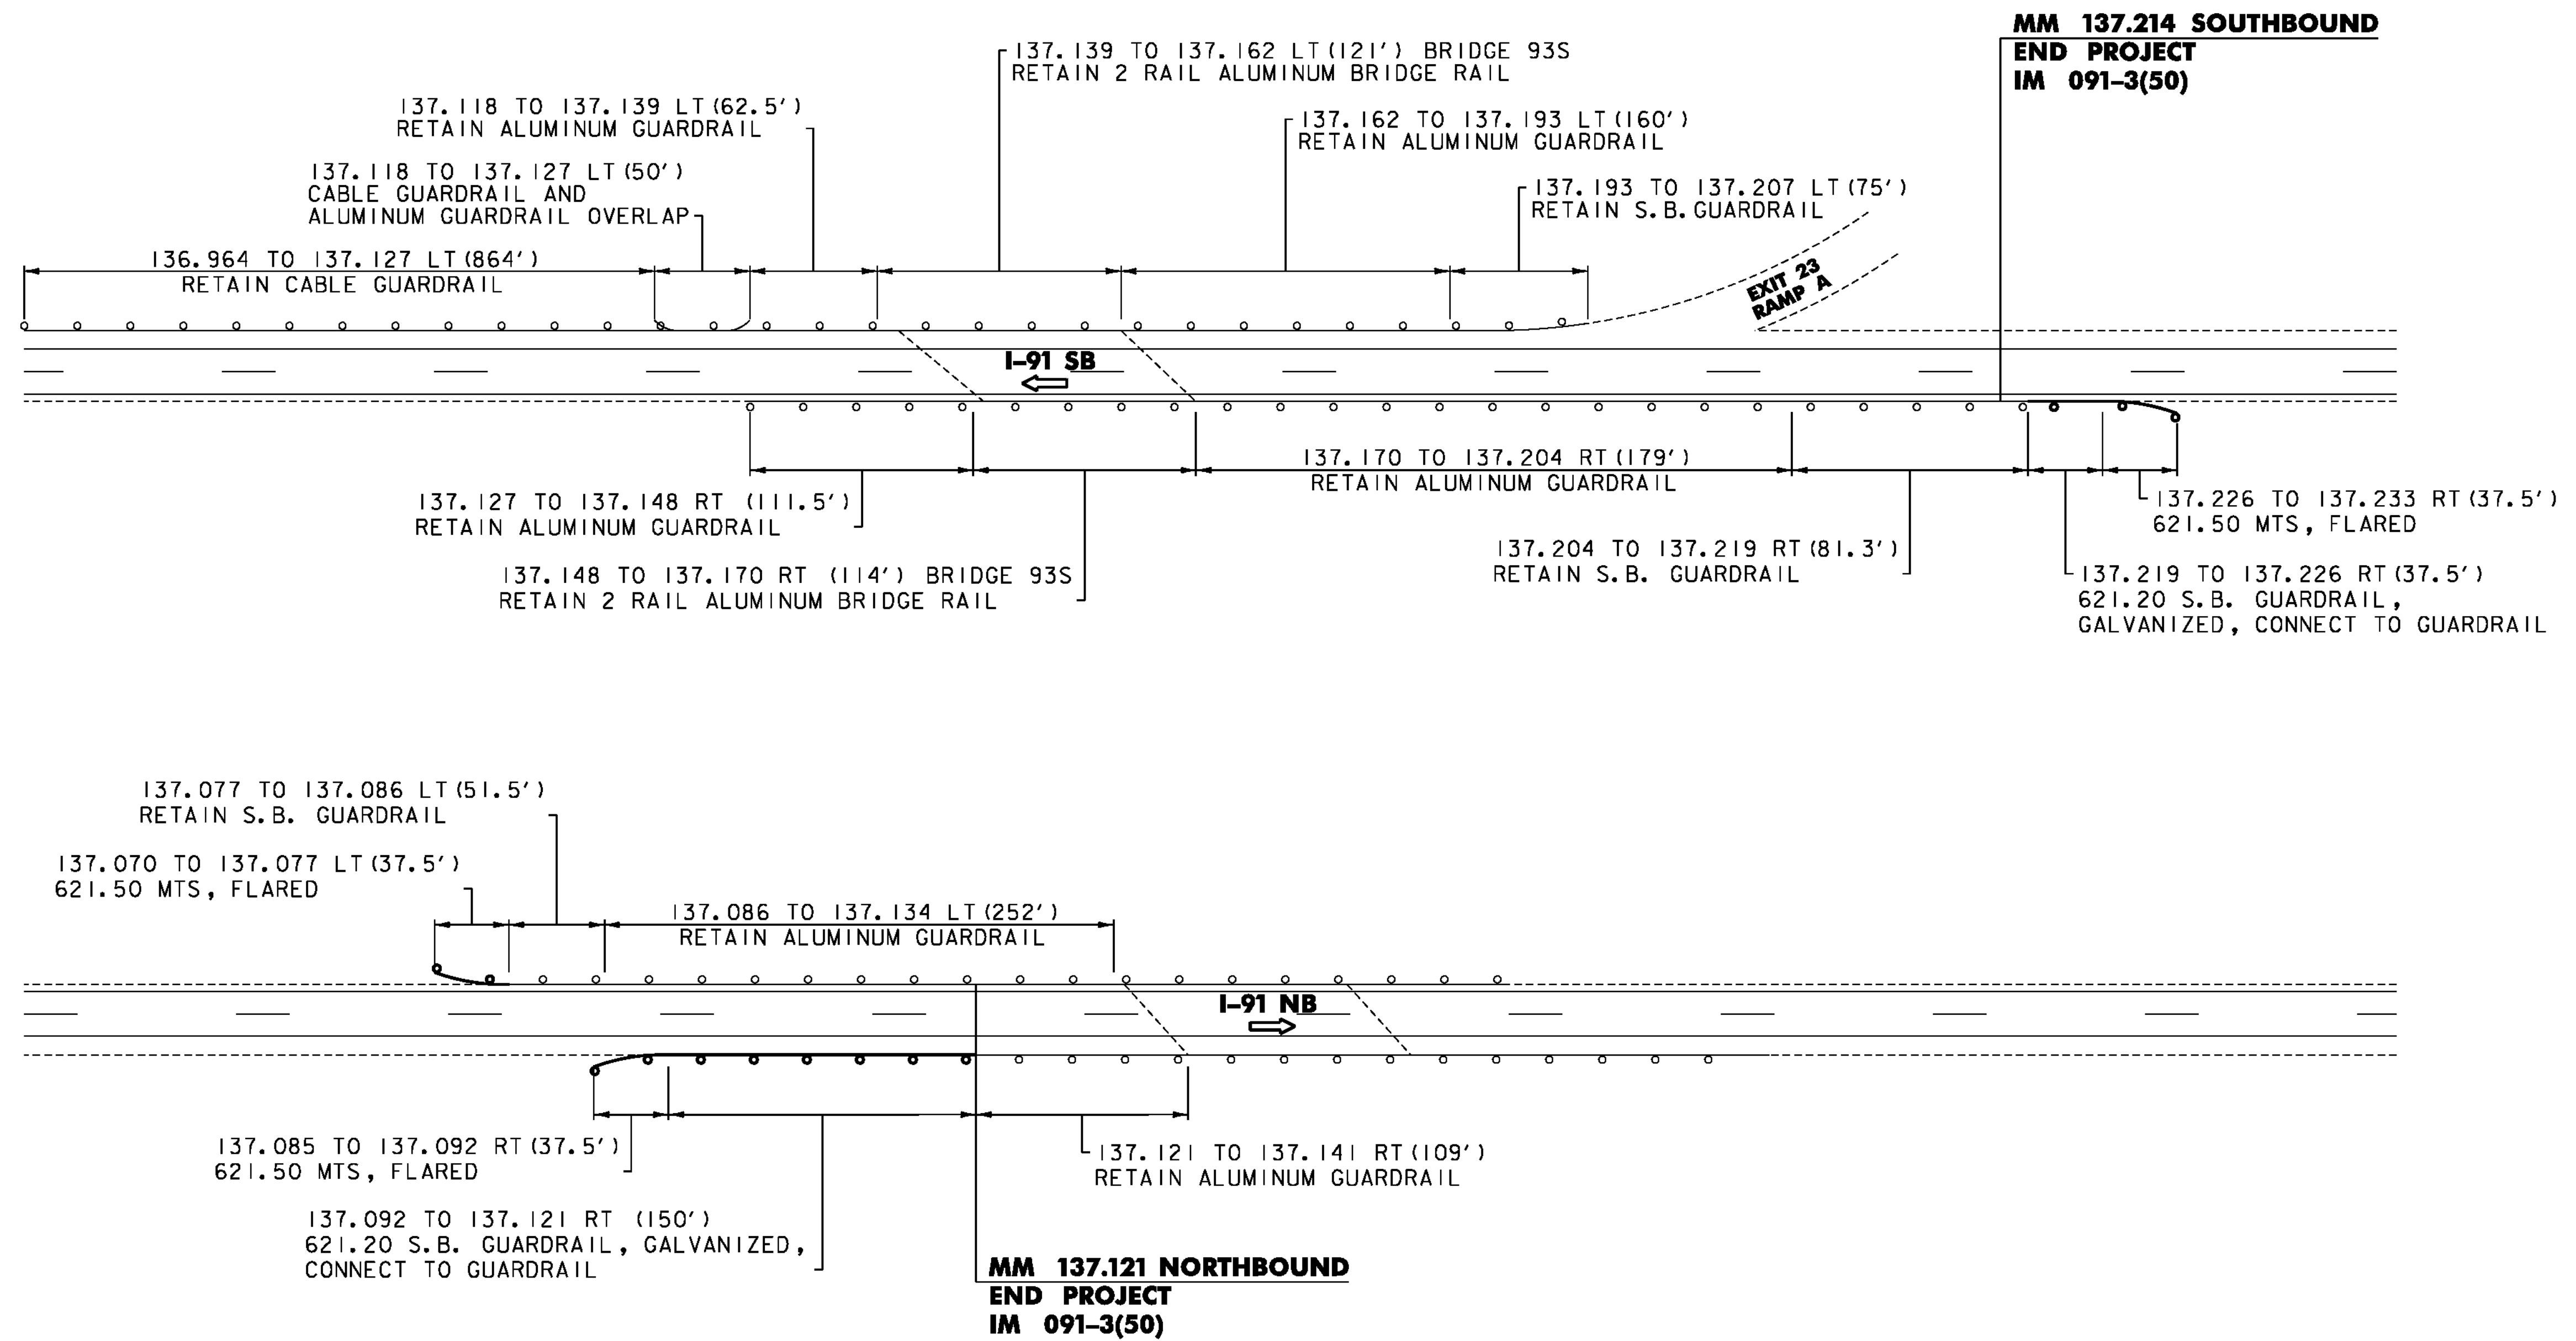

**BRIDGE /GUARDRAIL
 TREATMENT DETAIL SHEET 8**

PROJECT NAME: ST. JOHNSBURY-LYNDON	
PROJECT NUMBER: IM 091-3(50)	
FILE NAME: Ila346/cos/zlla346frm.dgn	PLOT DATE: 10/17/2013
PROJECT LEADER: PTS	DRAWN BY: JLS
DESIGNED BY: NLL	CHECKED BY: PTS
IPARM FILE NAME: plla346_30	SHEET 30 OF 72

NOT TO SCALE