


PLAN

**ITEM 621.70
GUARDRAIL
APPROACH SECTION,
TYPE I**

POST NO.	SPACING
1	3'-1/2"
2	3'-1/2"
3	3'-1/2"
4	3'-1/2"
5	3'-1/2"
6	3'-1/2"
7	3'-1/2"
8	3'-1/2"
9	4'-2"
10	4'-2"
11	4'-2"
12	4'-2"
13	6'-3"
14	6'-3"

50'-0" PAY LENGTH GUARDRAIL APPROACH SECTION, TYPE I

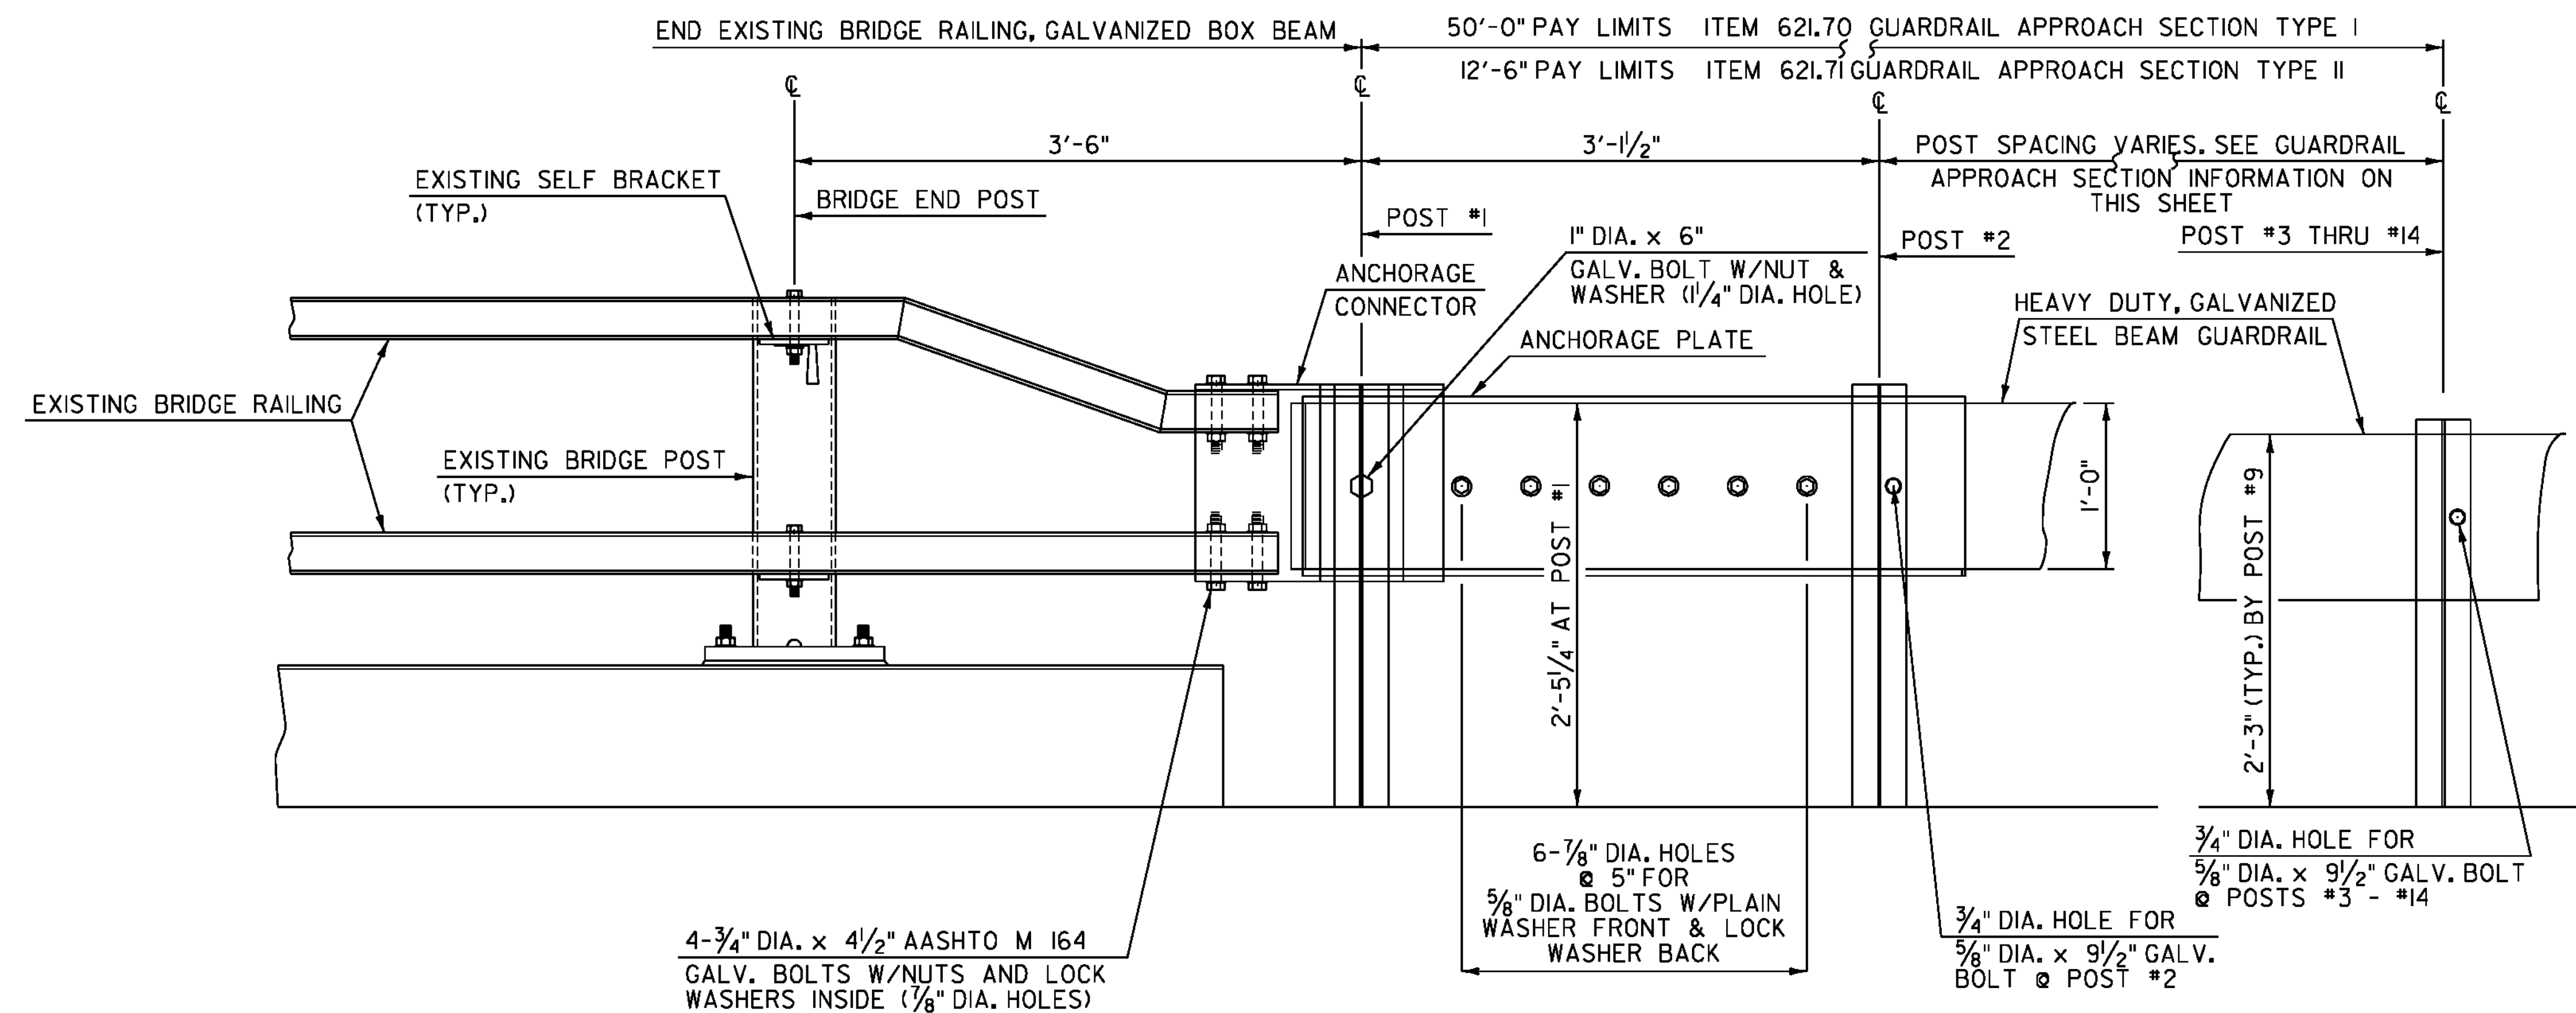

ELEVATION

GUARDRAIL APPROACH SECTION DETAIL

GUARDRAIL APPROACH SECTION DETAIL SHEET 1

PROJECT NAME: ST. JOHNSBURY-LYNDON

PROJECT NUMBER: IM 091-3(50)

FILE NAME: Ila346/cos/zlla346_frm.dgn

PLOT DATE: 10/17/2013

PROJECT LEADER: PTS

DRAWN BY: JLS

DESIGNED BY: NULL

CHECKED BY: PTS

IPARM FILE NAME: plla346_31

SHEET 31 OF 72