

TEMPORARY 6 INCH WHITE LINE, PAINT
 DURABLE 6 INCH WHITE LINE, POLYUREA
 RAMP B SOLID RT 645'
 130.382 TO 130.609 DOTTED RT 1200'


TEMPORARY 6 INCH YELLOW LINE, PAINT
 DURABLE 6 INCH YELLOW LINE, POLYUREA
 RAMP B SOLID LT 682'

TEMPORARY 12 INCH WHITE LINE, PAINT
 DURABLE 12 INCH WHITE LINE, POLYUREA
 I-91 SOLID RT 118'
 RAMP B SOLID LT 66'

REMOVAL OF EXISTING CURB
 STEEL BEAM GUARDRAIL, GALVANIZED
 ANCHOR FOR STEEL BEAM RAIL
 REMOVAL AND DISPOSAL OF GUARDRAIL
 DELINEATOR WITH STEEL POST
 SEE ITEM DETAIL SUMMARY SHEETS

SPECIAL PROVISION
 (DECOMMISSION CURB DROP INLET)
 RAMP B RT (2)

STONE FILL, TYPE I
 GEOTEXTILE UNDER STONE FILL
 SEE NORTHBOUND DITCH CLEANING SHEET

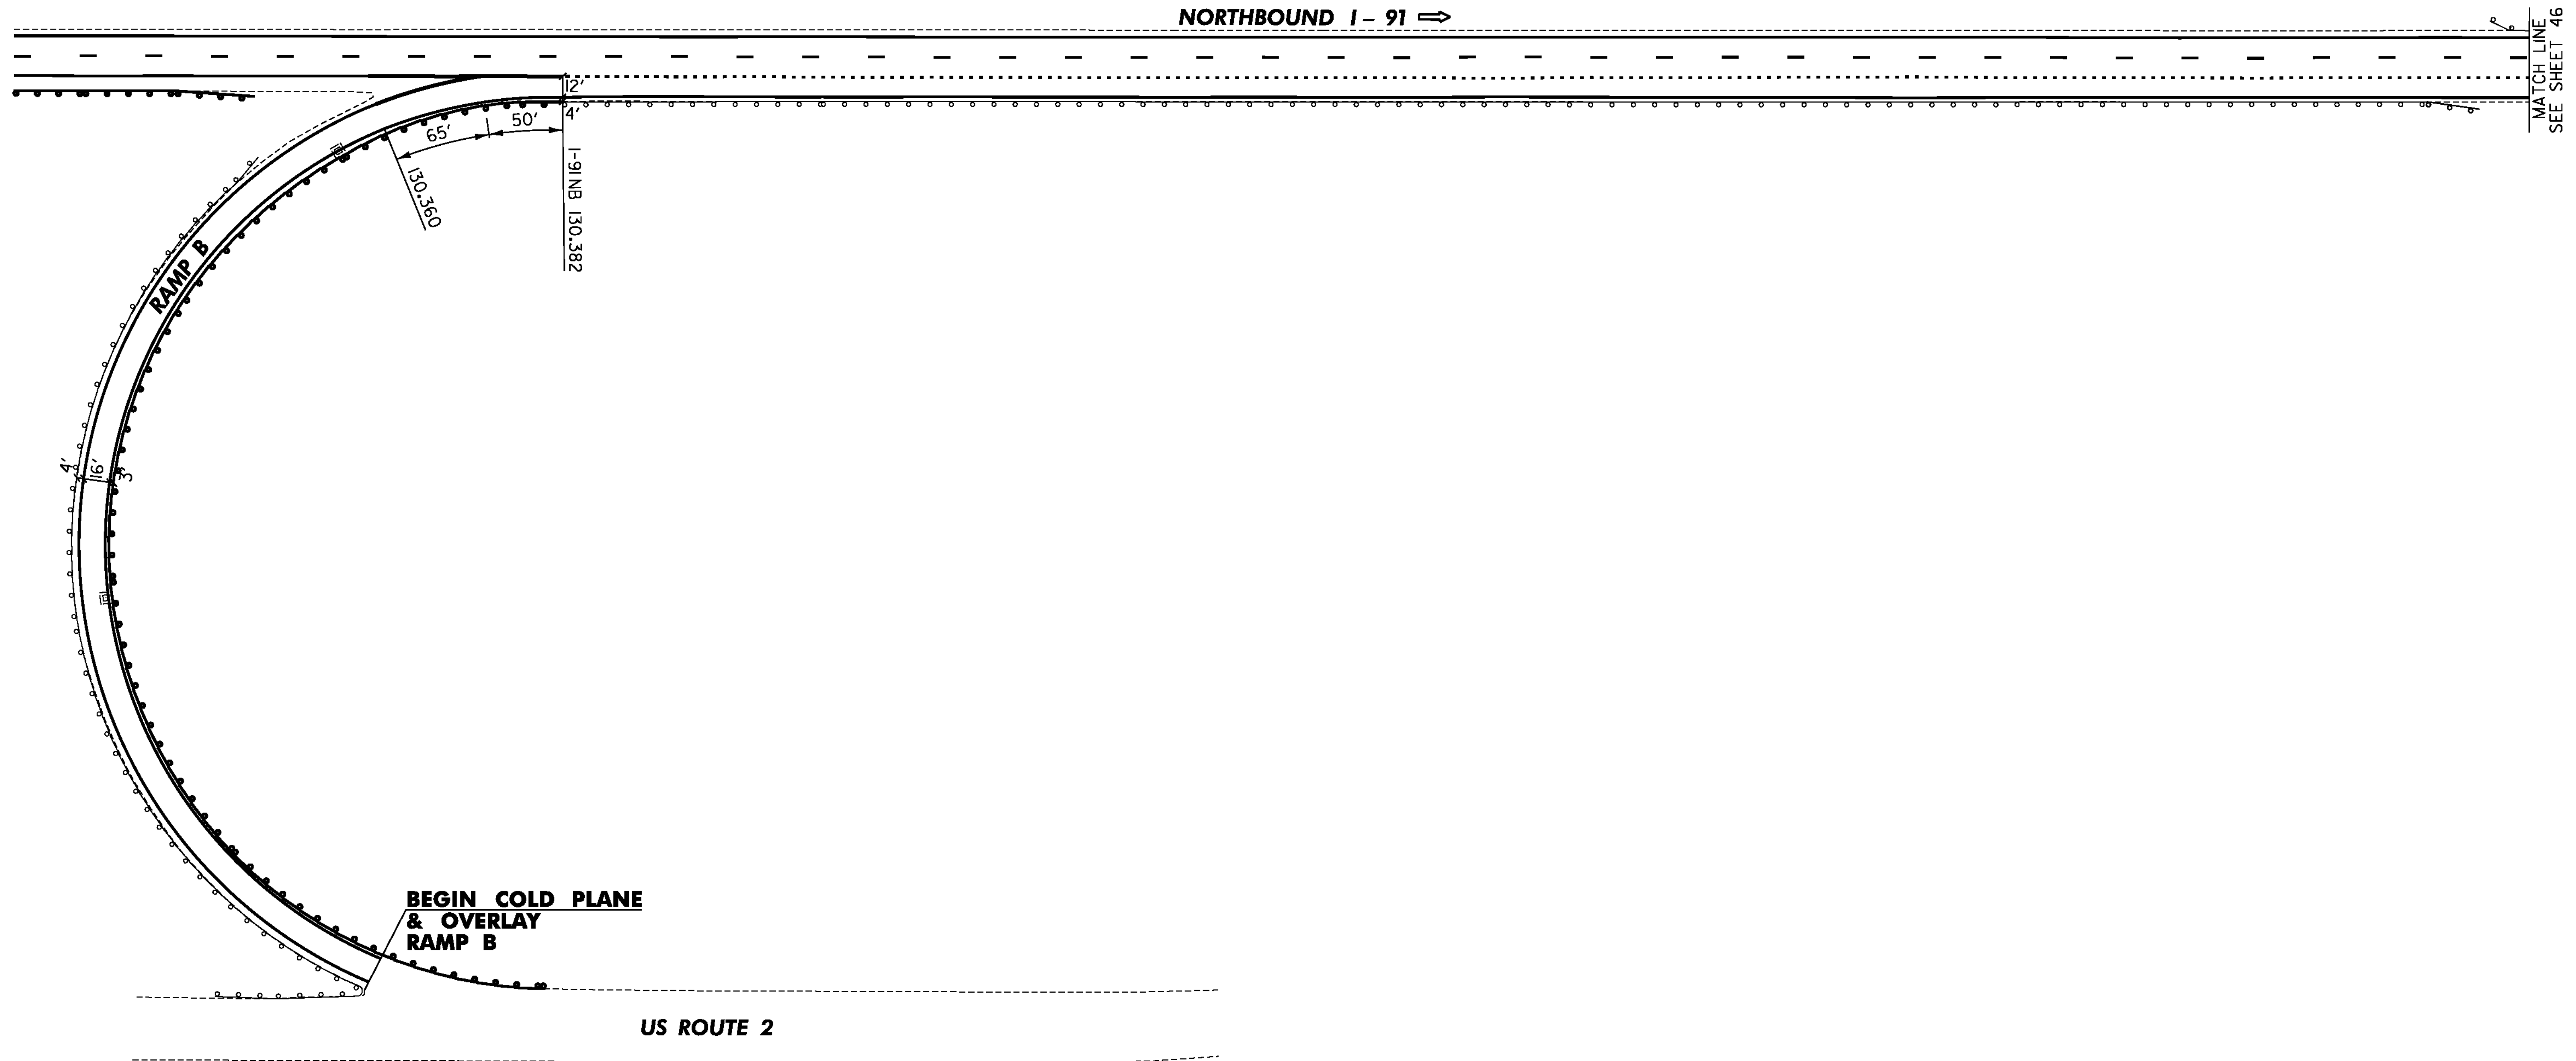

**EXIT 21 NORTHBOUND
 DETAIL SHEET 1**

PROJECT NAME:	ST. JOHNSBURY-LYNDON
PROJECT NUMBER:	IM 091-3(50)
FILE NAME:	lla346/cos/zlla346int2tbl.dgn
PROJECT LEADER:	PTS
DESIGNED BY:	NLL
IPARM FILE NAME:	plla346_45
PLOT DATE:	10/17/2013
DRAWN BY:	JLS
CHECKED BY:	PTS
SHEET	45 OF 72

NOT TO SCALE