


TEMPORARY 6 INCH WHITE LINE, PAINT  
DURABLE 6 INCH WHITE LINE, POLYUREA  
RAMP A SOLID RT 996'  
130.056 TO 130.382 DOTTED LT 1722'

TEMPORARY 6 INCH YELLOW LINE, PAINT  
DURABLE 6 INCH YELLOW LINE, POLYUREA  
RAMP A SOLID LT 1003'

TEMPORARY 12 INCH WHITE LINE, PAINT  
DURABLE 12 INCH WHITE LINE, POLYUREA  
I-91 SOLID LT 145'  
RAMP A SOLID LT 94'

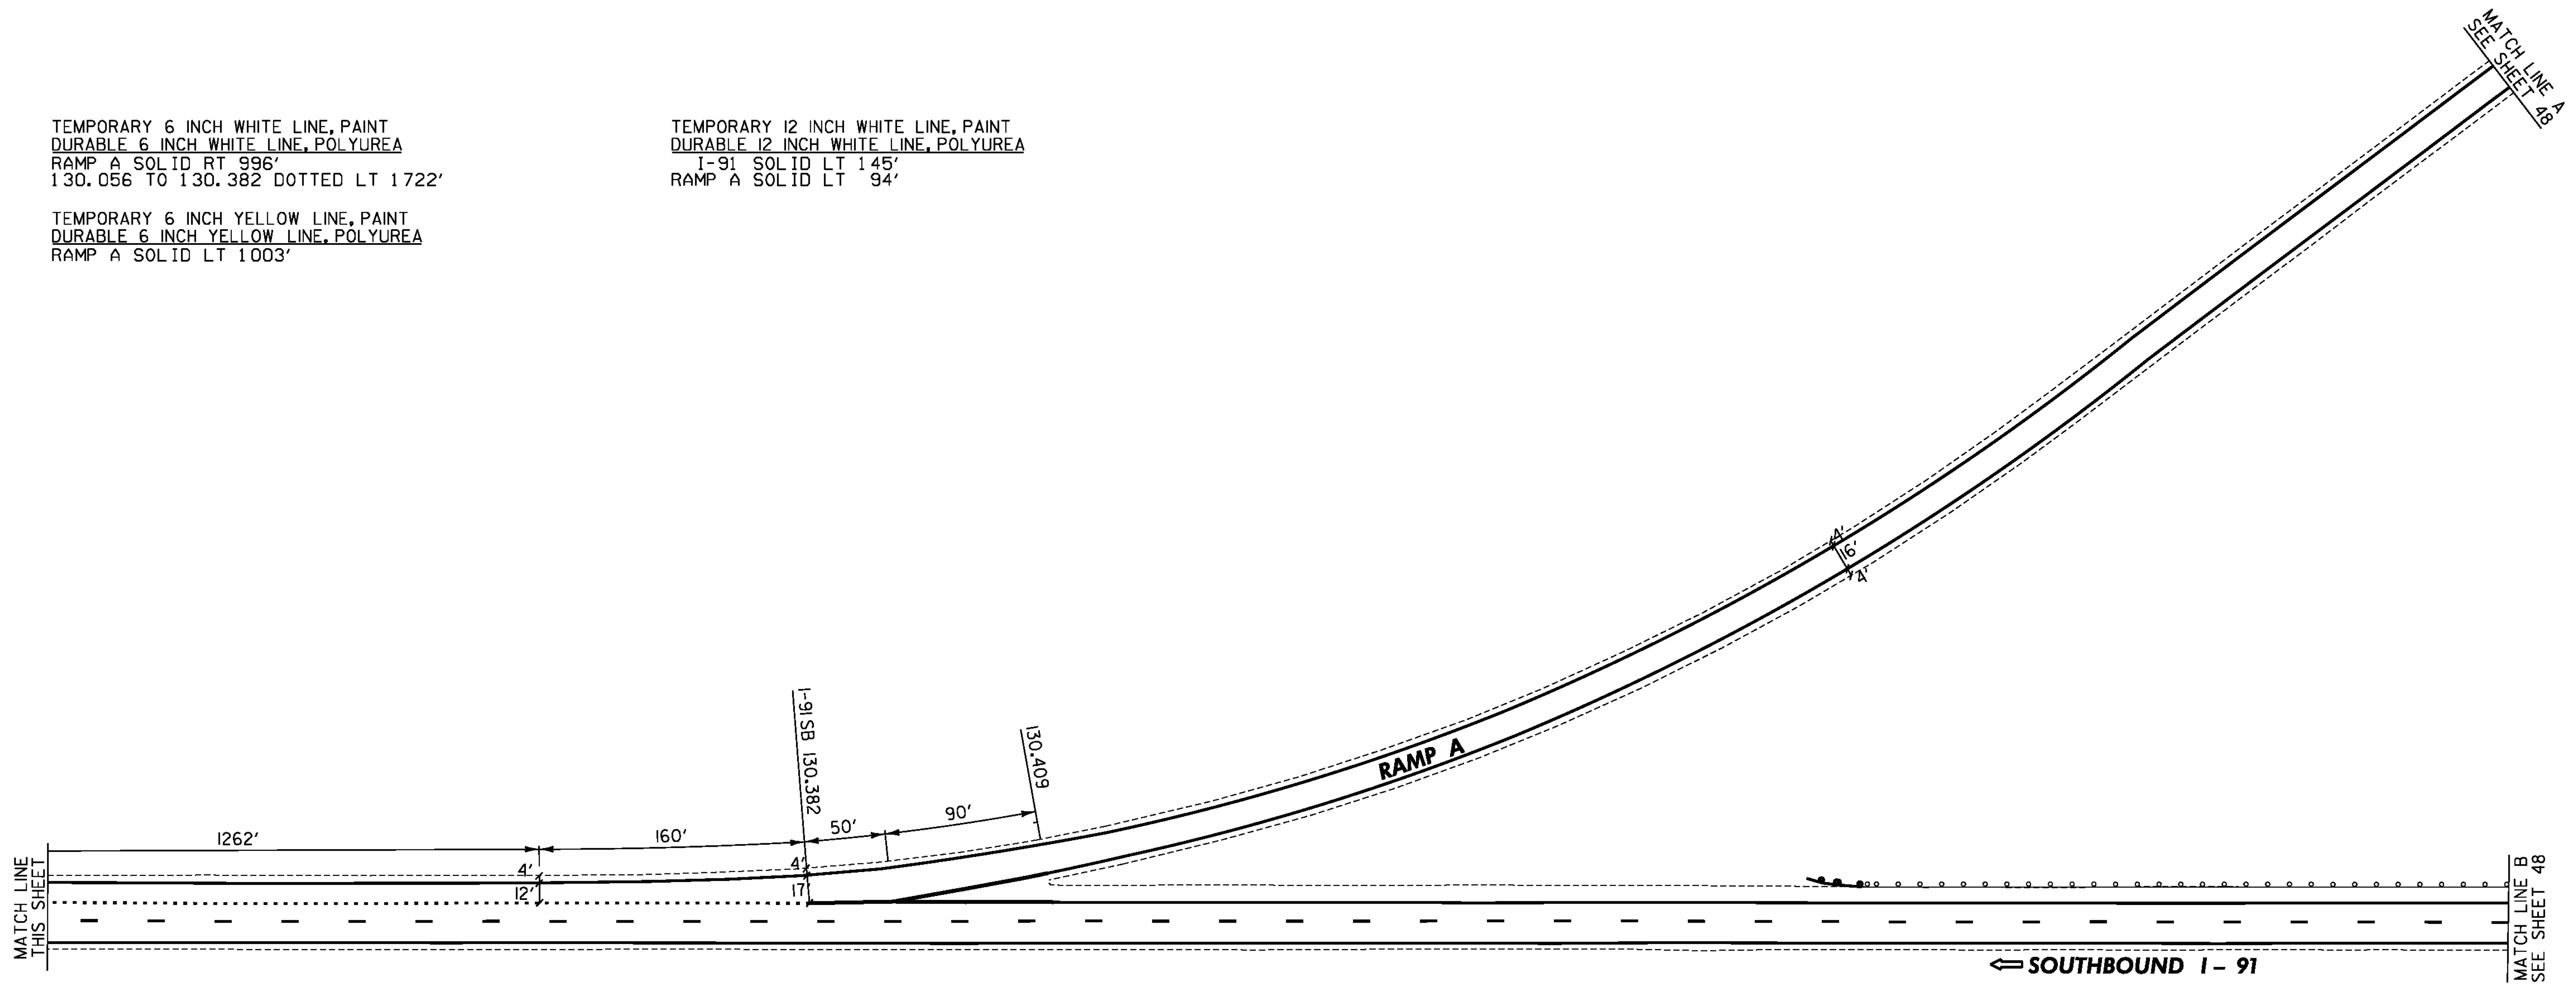

**EXIT 21 SOUTHBOUND  
DETAIL SHEET 1**

PROJECT NAME: ST. JOHNSBURY-LYNDON	PROJECT NUMBER: IM 091-3(50)
FILE NAME: Ila346/cos/zlla346int2lsbl.dgn	PROJECT LEADER: PTS
DESIGNED BY: NULL	DRAWN BY: JLS
IPARM FILE NAME: plla346_47	CHECKED BY: PTS
	PLOT DATE: 10/17/2013
	SHEET 47 OF 72

NOT TO SCALE