


TEMPORARY 6 INCH WHITE LINE, PAINT
 DURABLE 6 INCH WHITE LINE, POLYUREA
 RAMP B SOLID RT 1078'
 132.825 TO 133.033 DOTTED RT 1100'

TEMPORARY 6 INCH YELLOW LINE, PAINT
 DURABLE 6 INCH YELLOW LINE, POLYUREA
 RAMP B SOLID LT 1051'

TEMPORARY 12 INCH WHITE LINE, PAINT
 DURABLE 12 INCH WHITE LINE, POLYUREA
 I-91 SOLID RT 192'
 RAMP B SOLID LT 145'

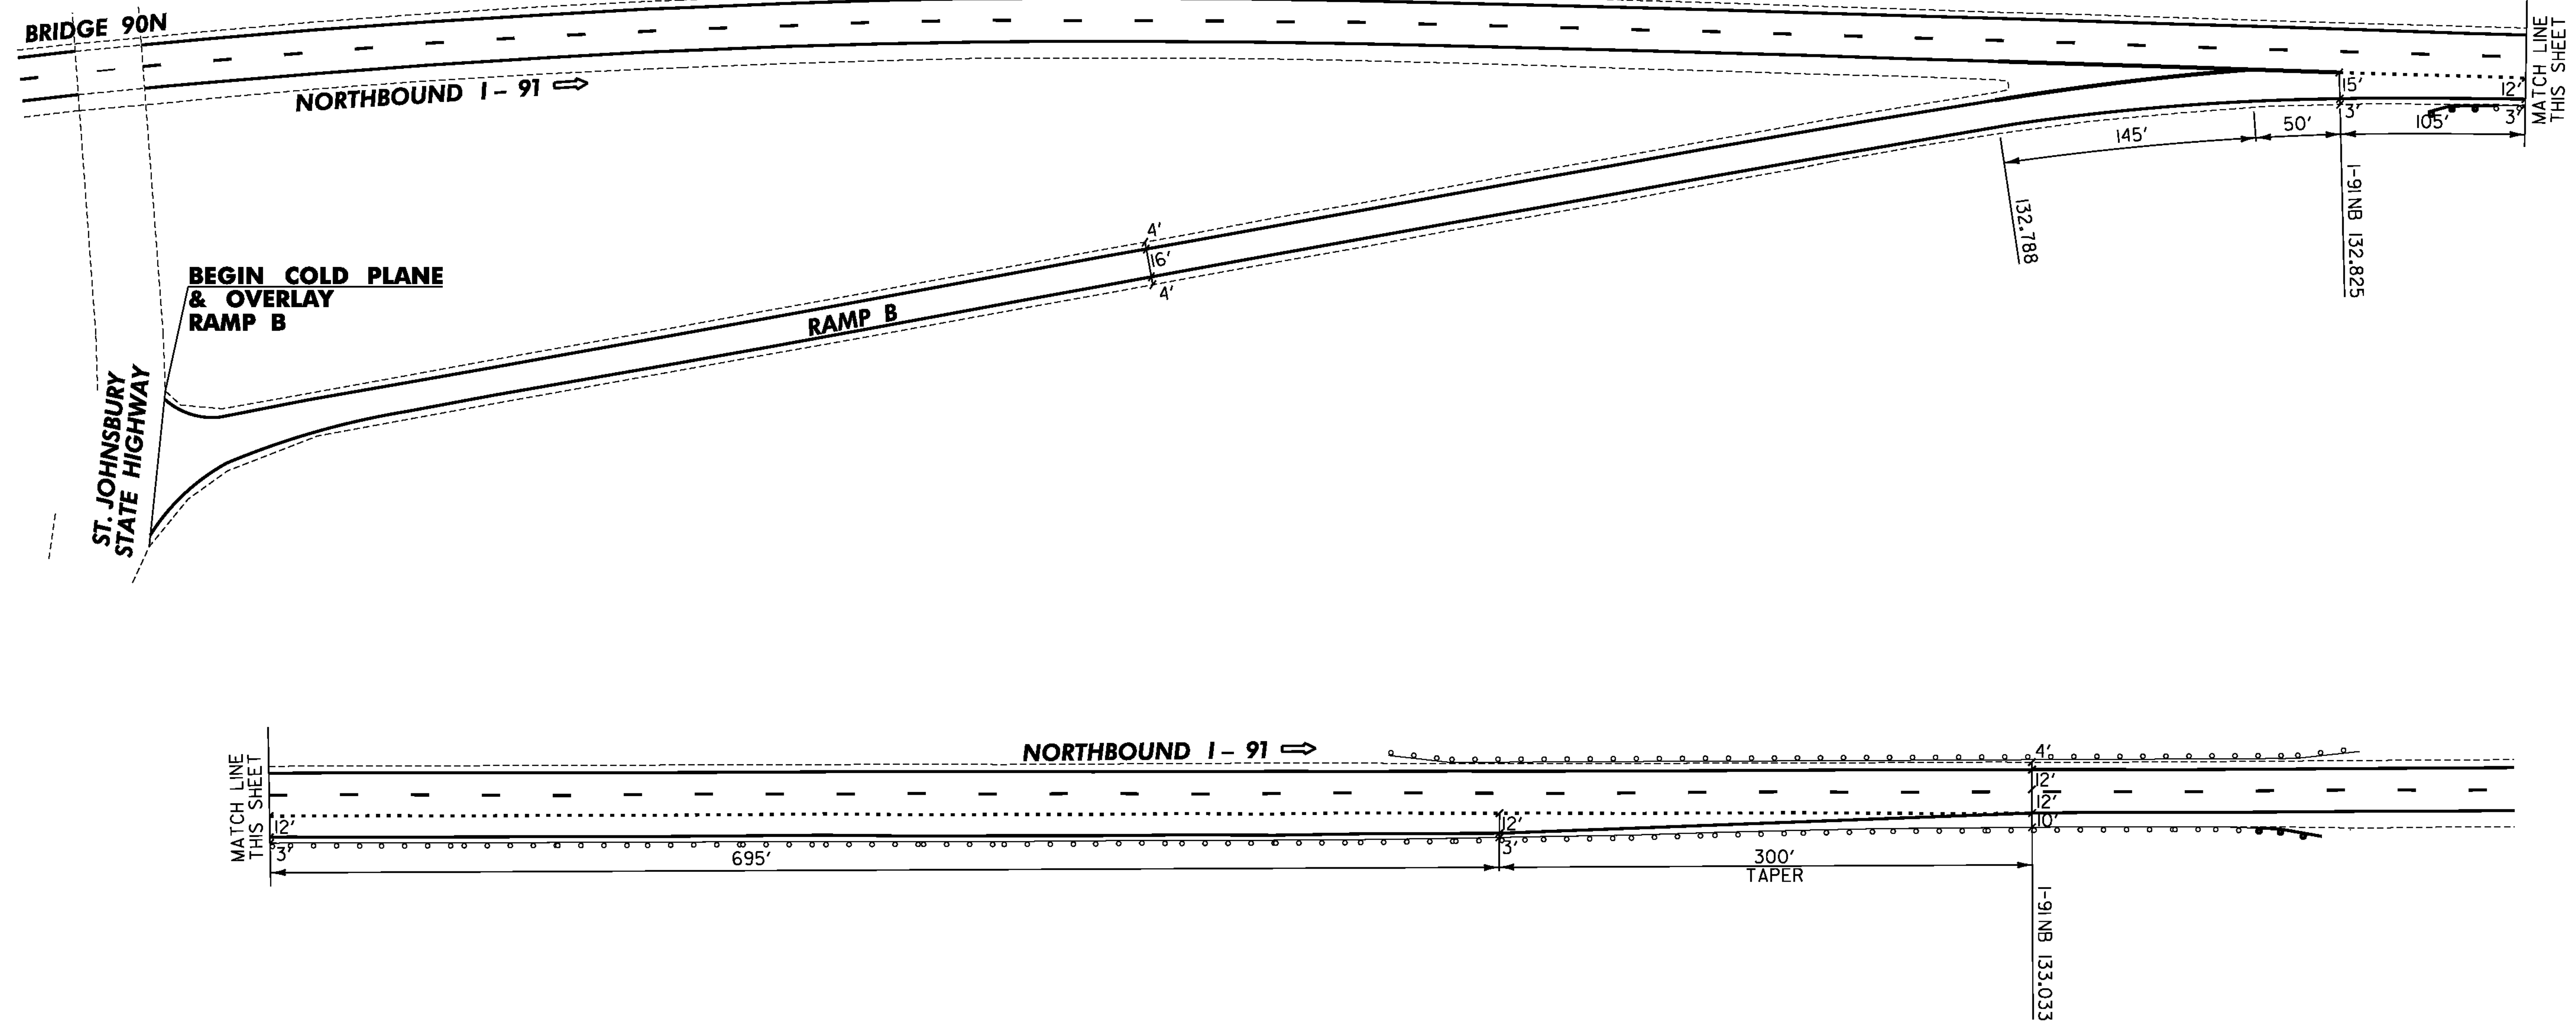

**EXIT 22 NORTHBOUND
 DETAIL SHEET 2**

PROJECT NAME:	ST. JOHNSBURY-LYNDON
PROJECT NUMBER:	IM 091-3(50)
FILE NAME:	lla346/cos/zlla346int22nb2.dgn
PROJECT LEADER:	PTS
DESIGNED BY:	NLL
IPARM FILE NAME:	lla346_51
PLotted DATE:	10/17/2013
DRAWN BY:	JLS
CHECKED BY:	PTS
SHEET	51 OF 72

NOT TO SCALE