


TEMPORARY 6 INCH WHITE LINE, PAINT
 DURABLE 6 INCH WHITE LINE, POLYUREA
 RAMP D SOLID RT 1042'
 132.148 TO 132.360 DOTTED LT 1120'

TEMPORARY 6 INCH YELLOW LINE, PAINT
 DURABLE 6 INCH YELLOW LINE, POLYUREA
 RAMP D SOLID LT 1020'

TEMPORARY 12 INCH WHITE LINE, PAINT
 DURABLE 12 INCH WHITE LINE, POLYUREA
 I-91 SOLID RT 171'
 RAMP D SOLID LT 121'

SPECIAL PROVISION
 (DECOMMISSION CURB DROP INLET)
 RAMP D RT (2)

REMOVAL OF EXISTING CURB
 CABLE GUARDRAIL J-BOLT, GALVANIZED
 CABLE GUARDRAIL SPLICE UNIT
 REPLACEMENT OF GUARDRAIL CABLE
 SEE ITEM DETAIL SUMMARY SHEETS

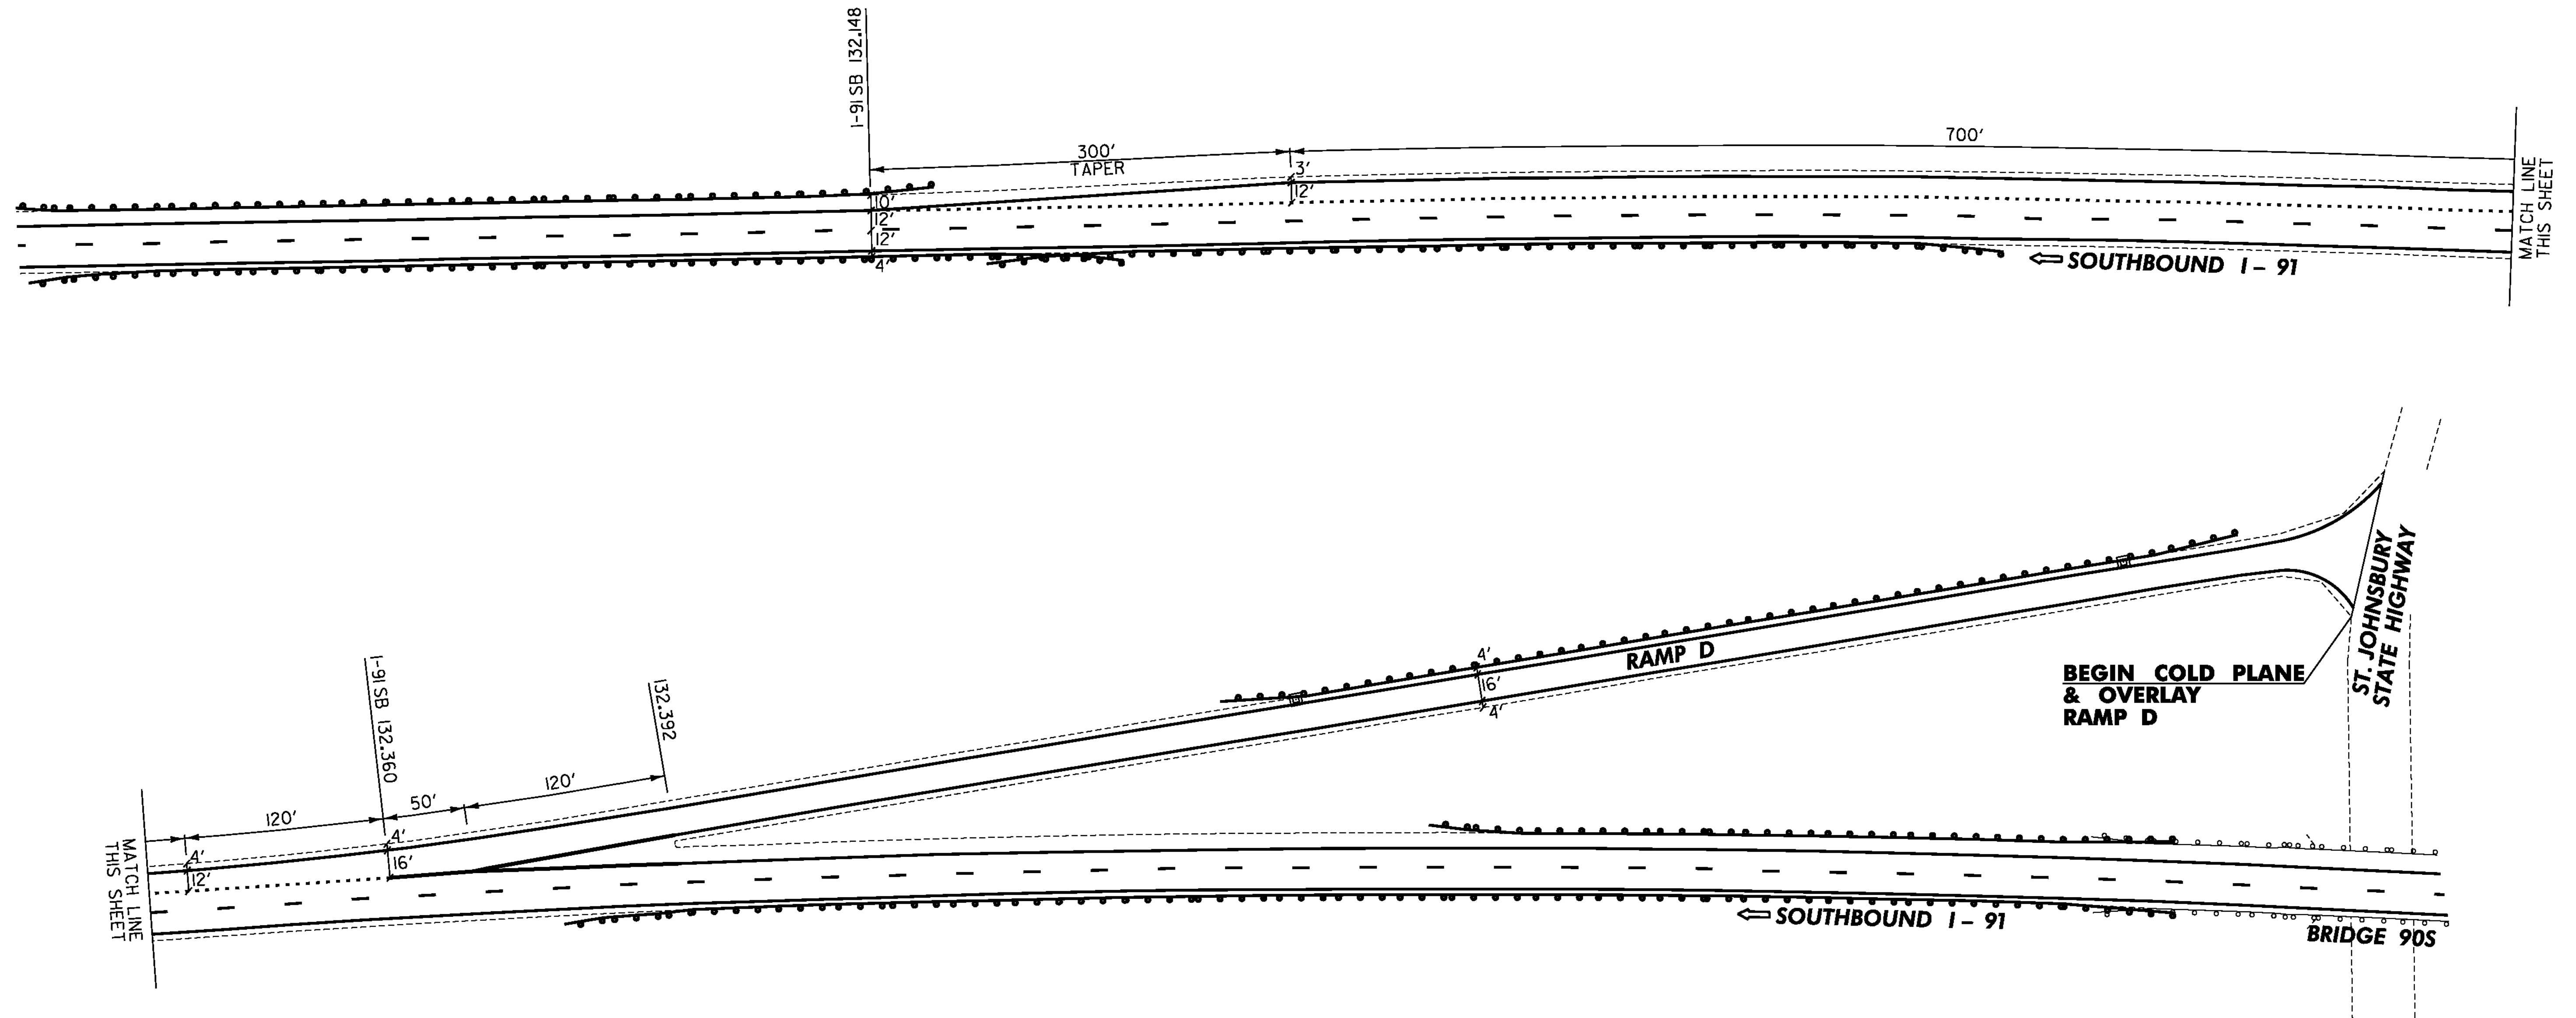

**EXIT 22 SOUTHBOUND
 DETAIL SHEET 2**

| | |
|------------------|--------------------------------|
| PROJECT NAME: | ST. JOHNSBURY-LYNDON |
| PROJECT NUMBER: | IM 091-3(50) |
| FILE NAME: | lla346/cos/zlla346int22sb2.dgn |
| PROJECT LEADER: | PTS |
| DESIGNED BY: | NLL |
| IPARM FILE NAME: | plla346_53 |
| PLLOT DATE: | 10/17/2013 |
| DRAWN BY: | JLS |
| CHECKED BY: | PTS |
| SHEET | 53 OF 72 |

NOT TO SCALE