


TEMPORARY 6 INCH WHITE LINE, PAINT
 DURABLE 6 INCH WHITE LINE, POLYUREA
 RAMP C SOLID RT 1060'
 136.842 TO 136.976 DOTTED RT 710'

TEMPORARY 6 INCH YELLOW LINE, PAINT
 DURABLE 6 INCH YELLOW LINE, POLYUREA
 RAMP C SOLID LT 1035'

TEMPORARY 12 INCH WHITE LINE, PAINT
 DURABLE 12 INCH WHITE LINE, POLYUREA
 I-91 SOLID RT 163'
 RAMP C SOLID LT 115'
 RAMP C SOLID LT (GORE STRIPES) 110'
 TEMPORARY 24 INCH STOP BAR, PAINT
 DURABLE 24 INCH STOP BAR (OPTION BID ITEM)
 RAMP C 30'

TEMPORARY LETTER OR SYMBOL, PAINT
 DURABLE LETTER OR SYMBOL (OPTION BID ITEM)
 RAMP C *STOP*
 RAMP C *AHEAD*
 RAMP C WRONG WAY ARROW
 RAMP C *STOP*
 TEMPORARY CROSSWALK MARKING, PAINT
 DURABLE CROSSWALK MARKING (OPTION BID ITEM)
 RAMP C 57'

REHAB. DROP INLETS,
 CATCH BASINS, OR MANHOLES,
 CLASS I OR CLASS II
 RAMP C LT (1)

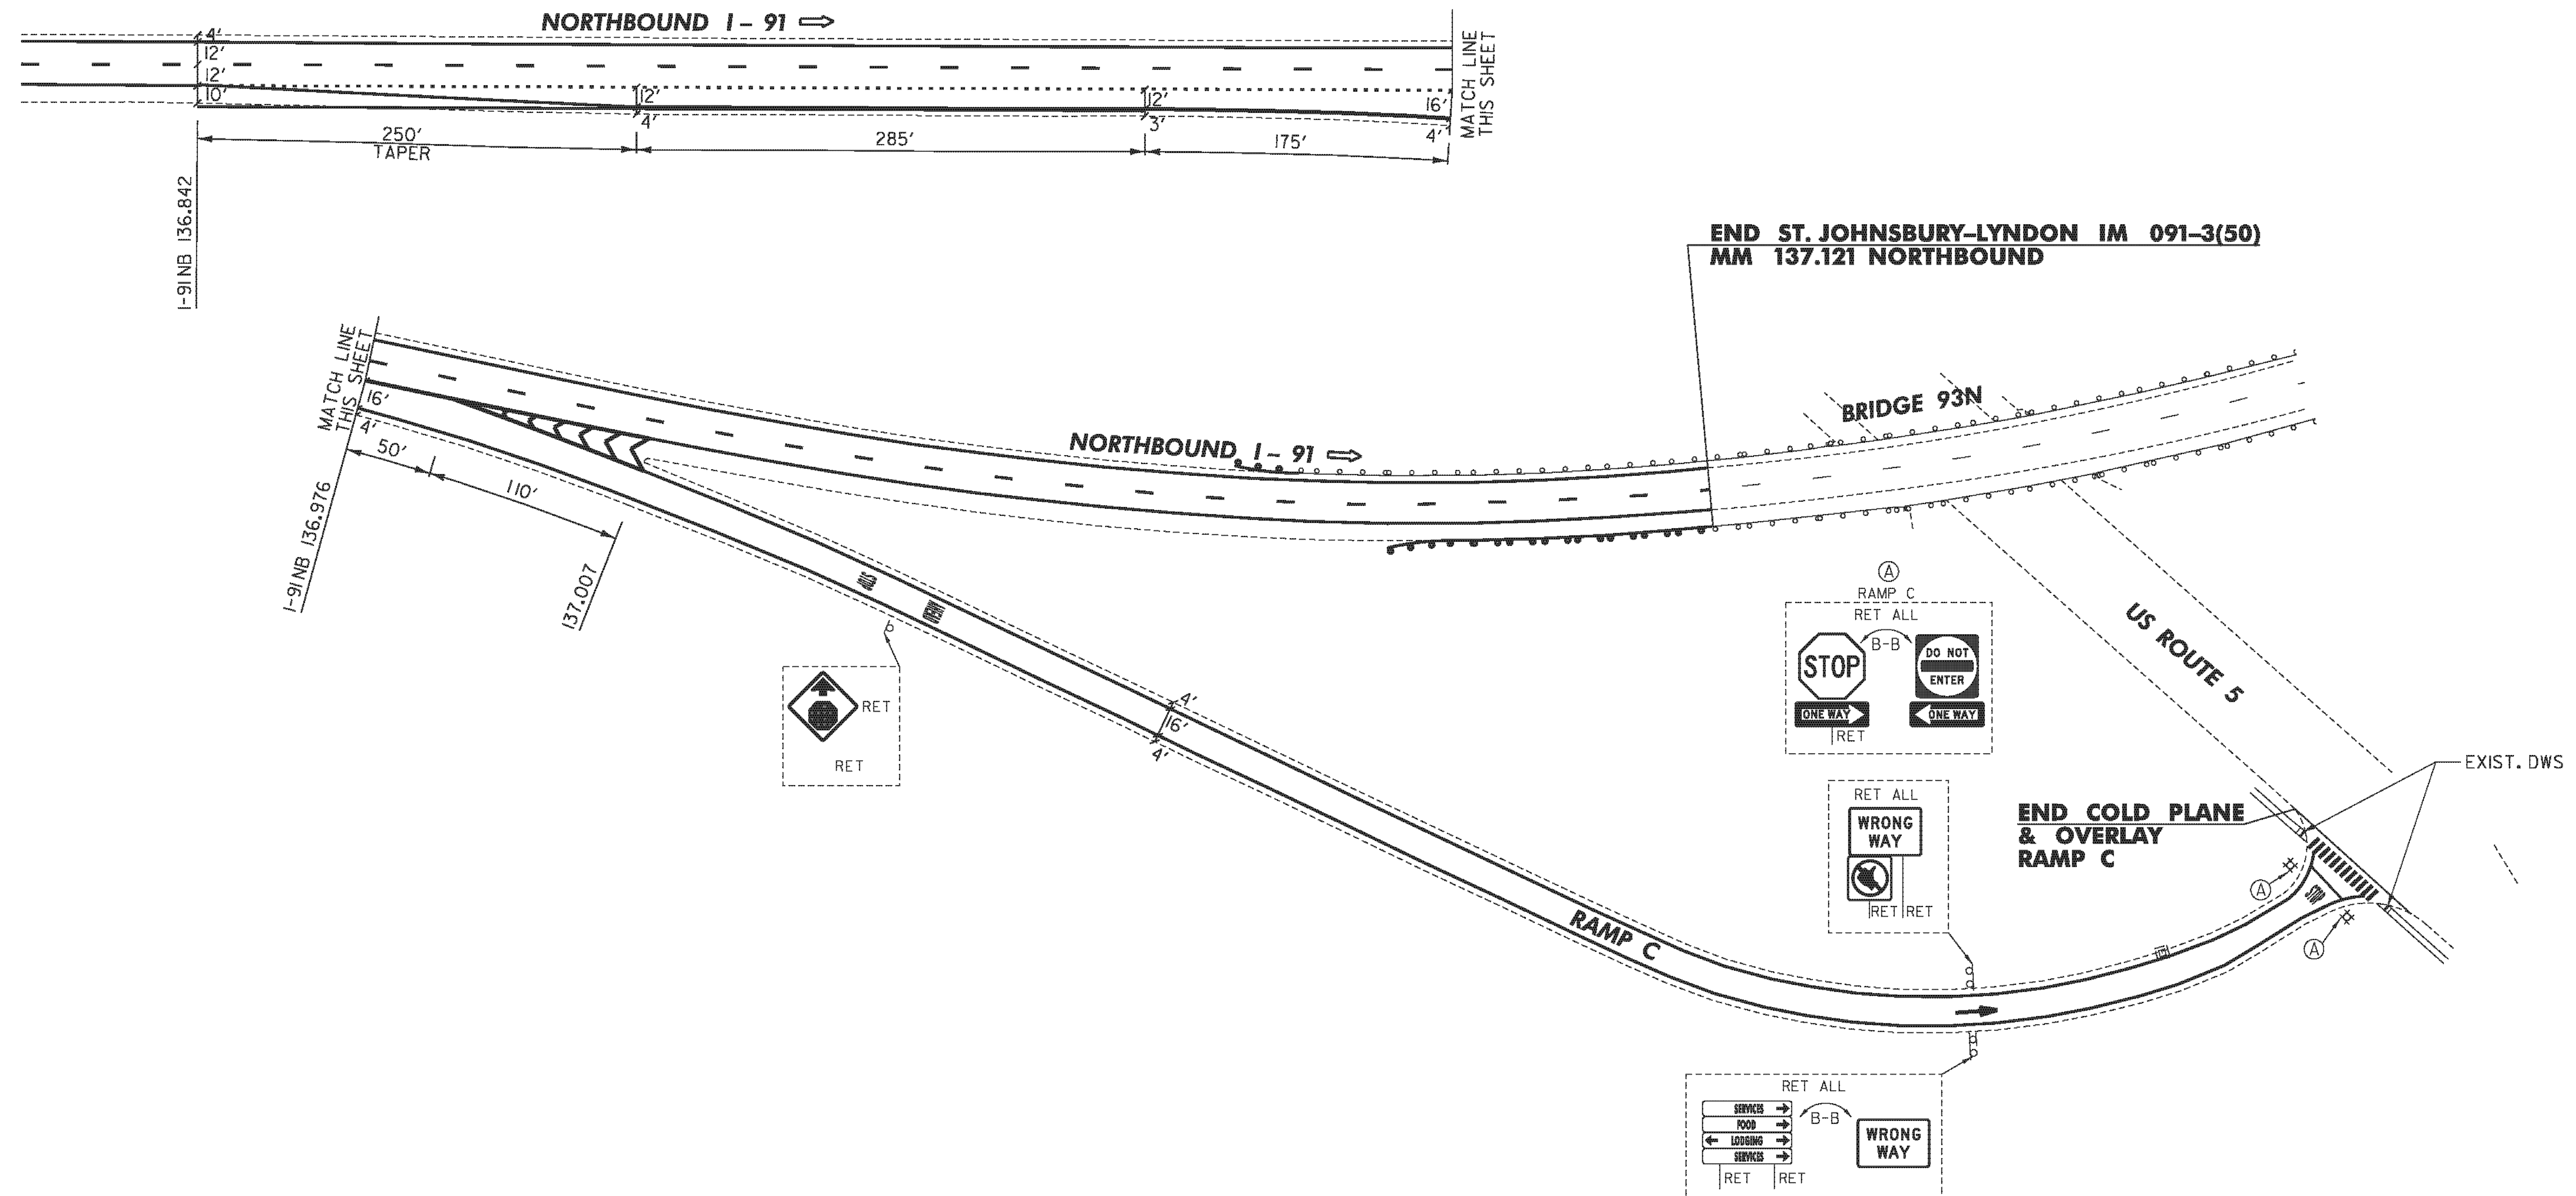

**EXIT 23 NORTHBOUND
 DETAIL SHEET**

PROJECT NAME: ST. JOHNSBURY-LYNDON	PROJECT NUMBER: IM 091-3(50)
FILE NAME: Ila346/cos/zlla346Int23nb.dgn	PROJECT LEADER: PTS
DESIGNED BY: NULL	CHECKED BY: PTS
IPARM FILE NAME: plla346_54	DRAWN BY: JLS
	SHEET 54 OF 72

NOT TO SCALE