


TEMPORARY 6 INCH WHITE LINE, PAINT  
 DURABLE 6 INCH WHITE LINE, POLYUREA  
 RAMP A SOLID RT 914'  
 RAMP E SOLID RT 103'  
 136.700 TO 137.184 DOTTED LT 2555'

TEMPORARY 6 INCH YELLOW LINE, PAINT  
 DURABLE 6 INCH YELLOW LINE, POLYUREA  
 RAMP A SOLID LT 1054'  
 RAMP E SOLID LT 108'

TEMPORARY 12 INCH WHITE LINE, PAINT  
 DURABLE 12 INCH WHITE LINE, POLYUREA  
 I-91 SOLID RT 98'  
 RAMP A SOLID LT 49'  
 RAMP A SOLID RT 103'  
 RAMP E SOLID LT 23'

TEMPORARY LETTER OR SYMBOL, PAINT  
 DURABLE LETTER OR SYMBOL (OPTION BID ITEM)  
 RAMP E YIELD MARKINGS (5)

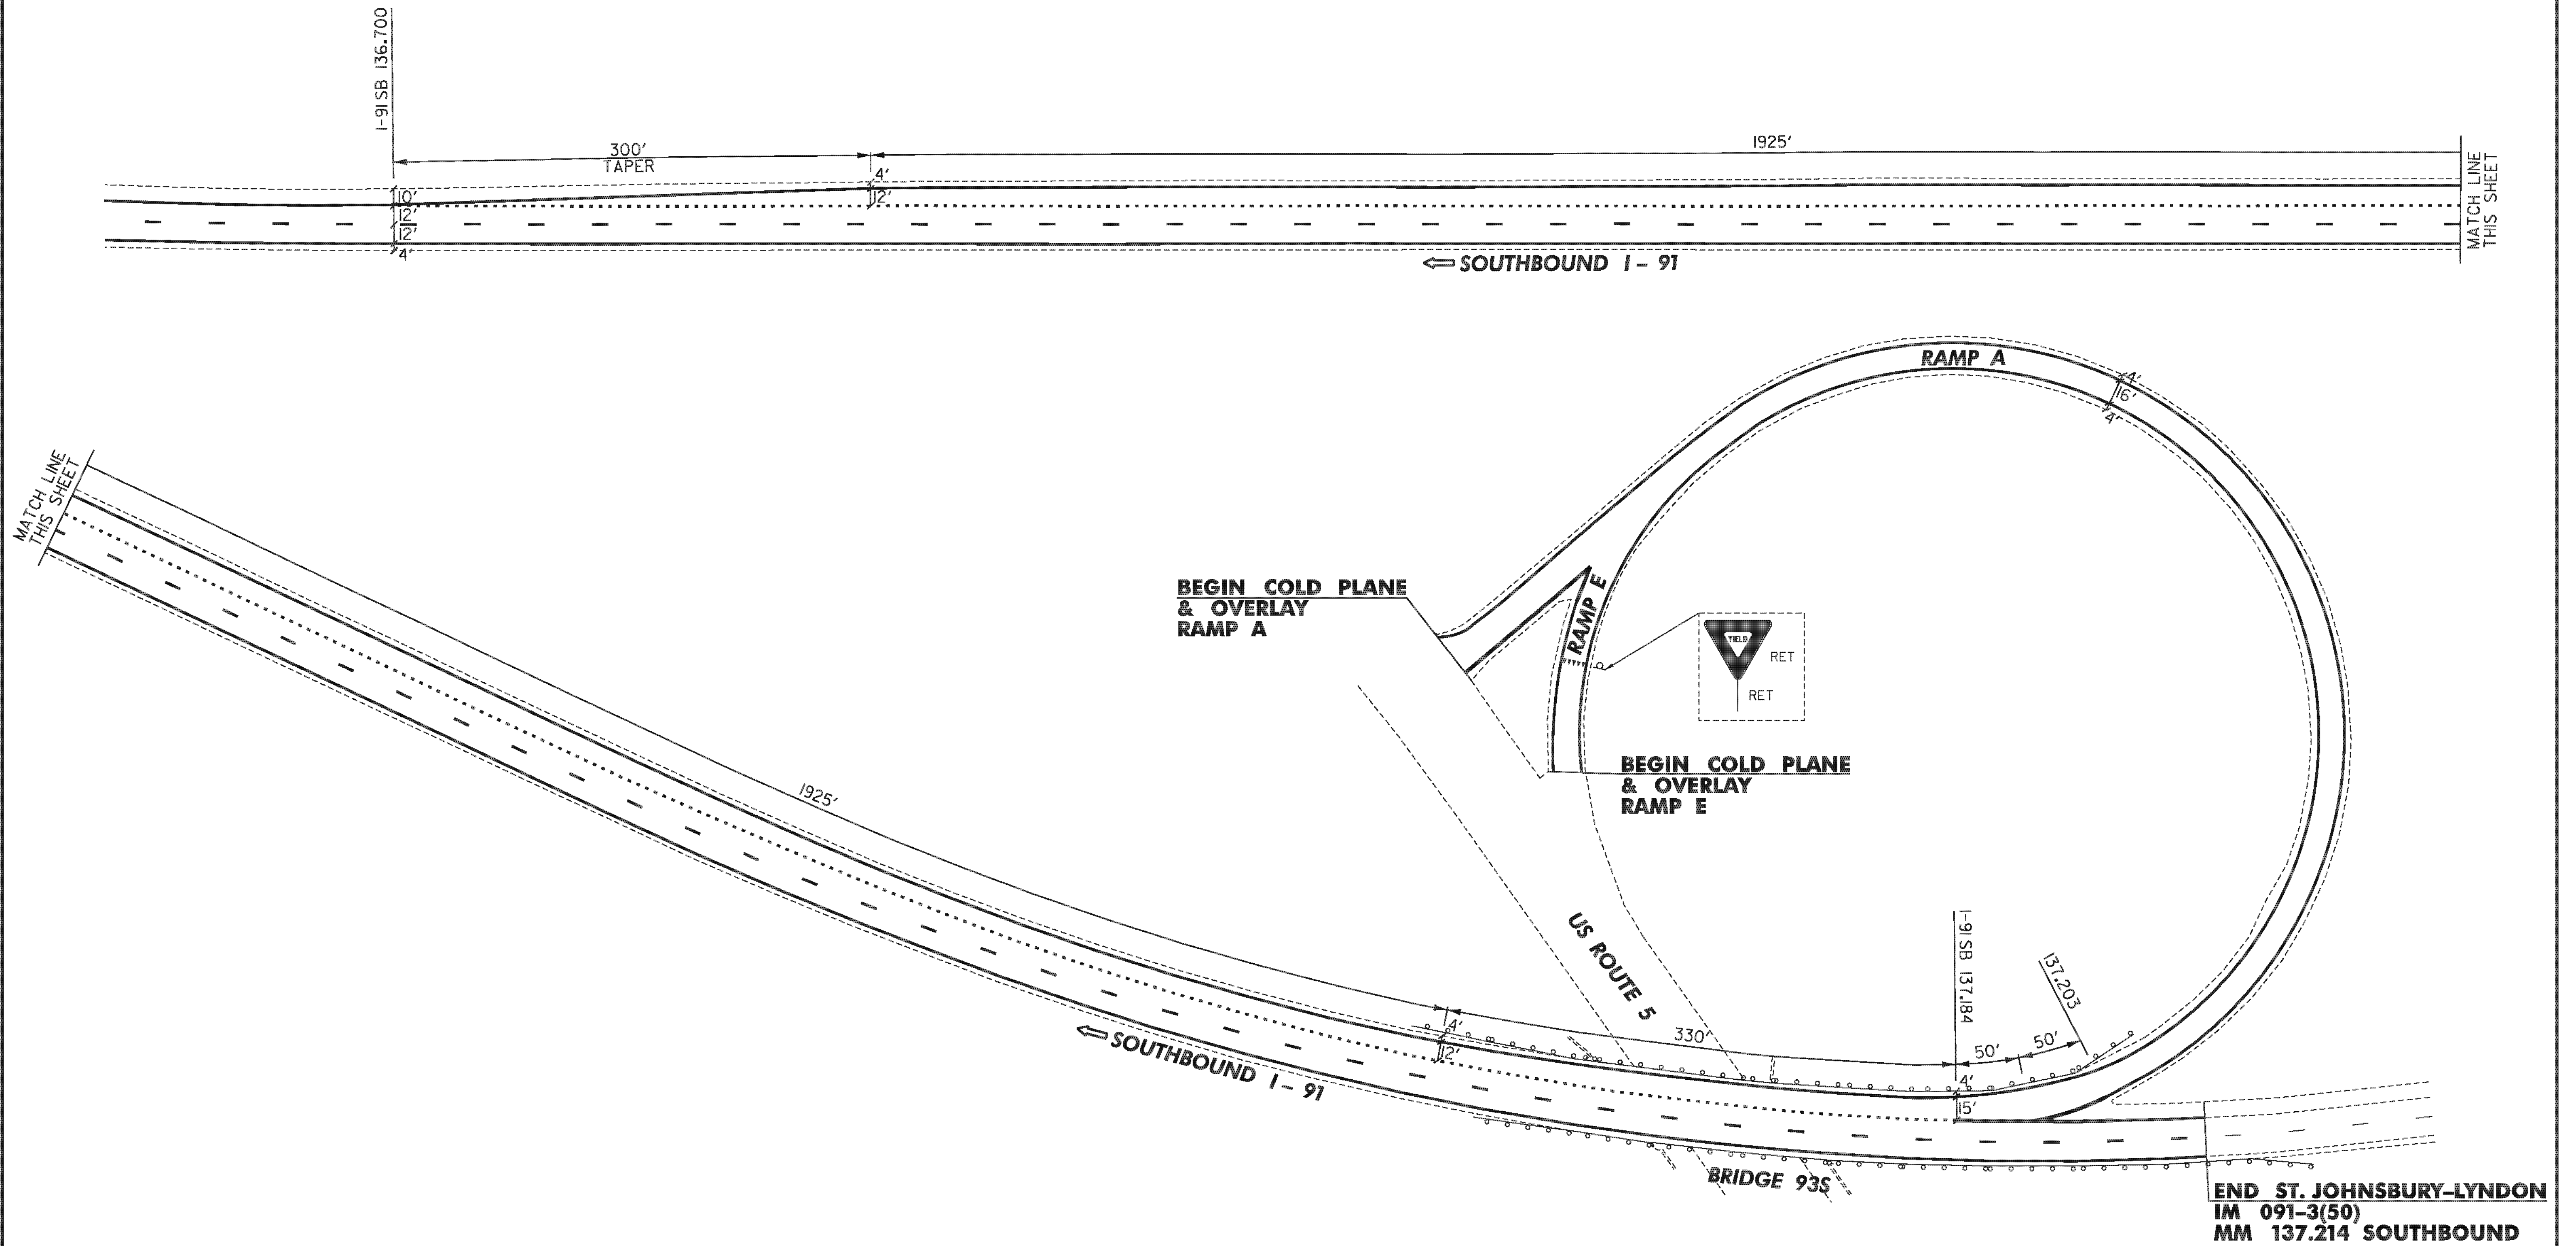

**EXIT 23 SOUTHBOUND  
 DETAIL SHEET**

PROJECT NAME:	ST. JOHNSBURY-LYNDON
PROJECT NUMBER:	IM 091-3(50)
FILE NAME:	11a346/cos/z11a346Int23sb.dgn
PROJECT LEADER:	PTS
DESIGNED BY:	NLL
IPARM FILE NAME:	pl1a346_55
PLOT DATE:	10/17/2013
DRAWN BY:	JLS
CHECKED BY:	PTS
SHEET	55 OF 72

NOT TO SCALE