

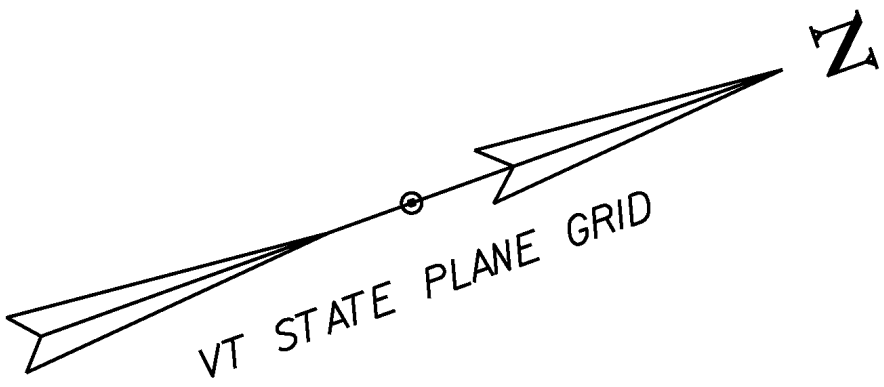


621.75 - REMOVE AND RESET GUARDRAIL  
MSH STA 101+79.40 LT TO MSH STA 105+00.00 LT

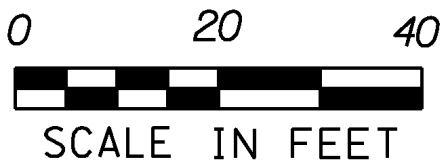

MSH MM 0.028 =  
STATION 101+50  
BEGIN PROJECT  
NH 028-2(9)

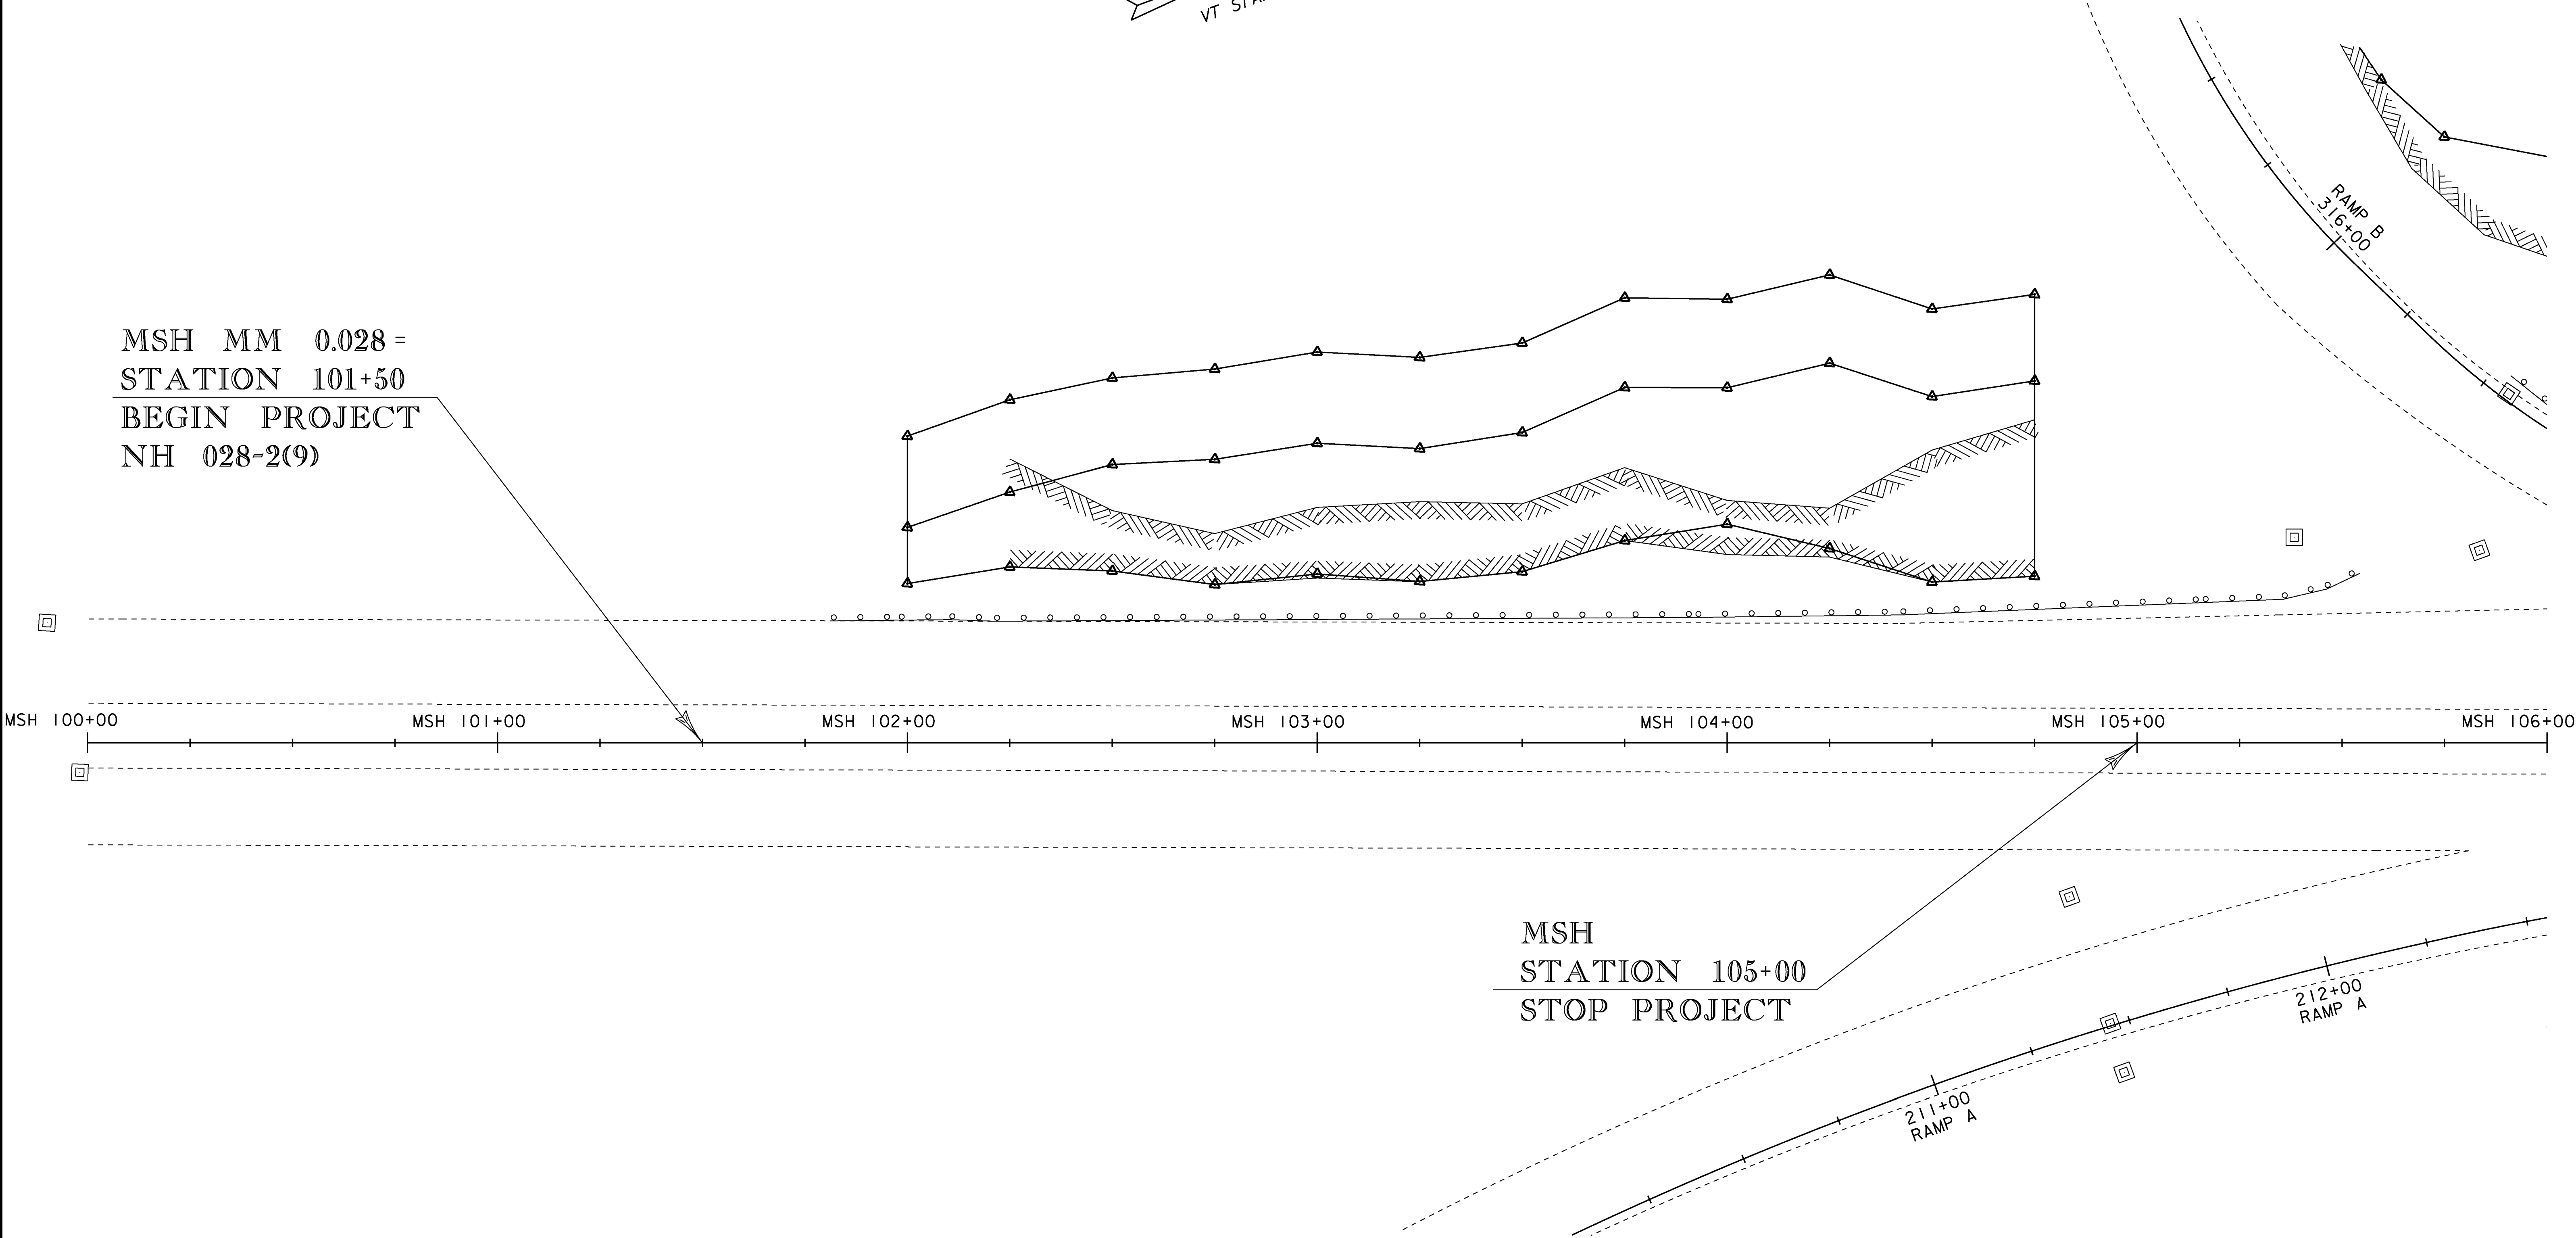

|                 |                               |
|-----------------|-------------------------------|
| PROJECT NAME:   | MONTPELIER                    |
| PROJECT NUMBER: | NH 028-2(9)                   |
| FILE NAME:      | lib066\Design\dlb066bdrms.dgn |
| DATE:           | 24-MAY-2013                   |
| PROJECT LEADER: | P. PELOQUIN                   |
| DRAWN BY:       | P. PELOQUIN                   |
| DESIGNED BY:    | P. PELOQUIN                   |
| CHECKED BY:     | A. BOMBARDIER                 |
| LAYOUT SHEET    | 1                             |
| SHEET           | 7 OF 62                       |