
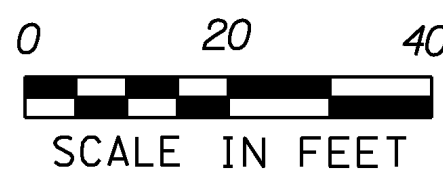
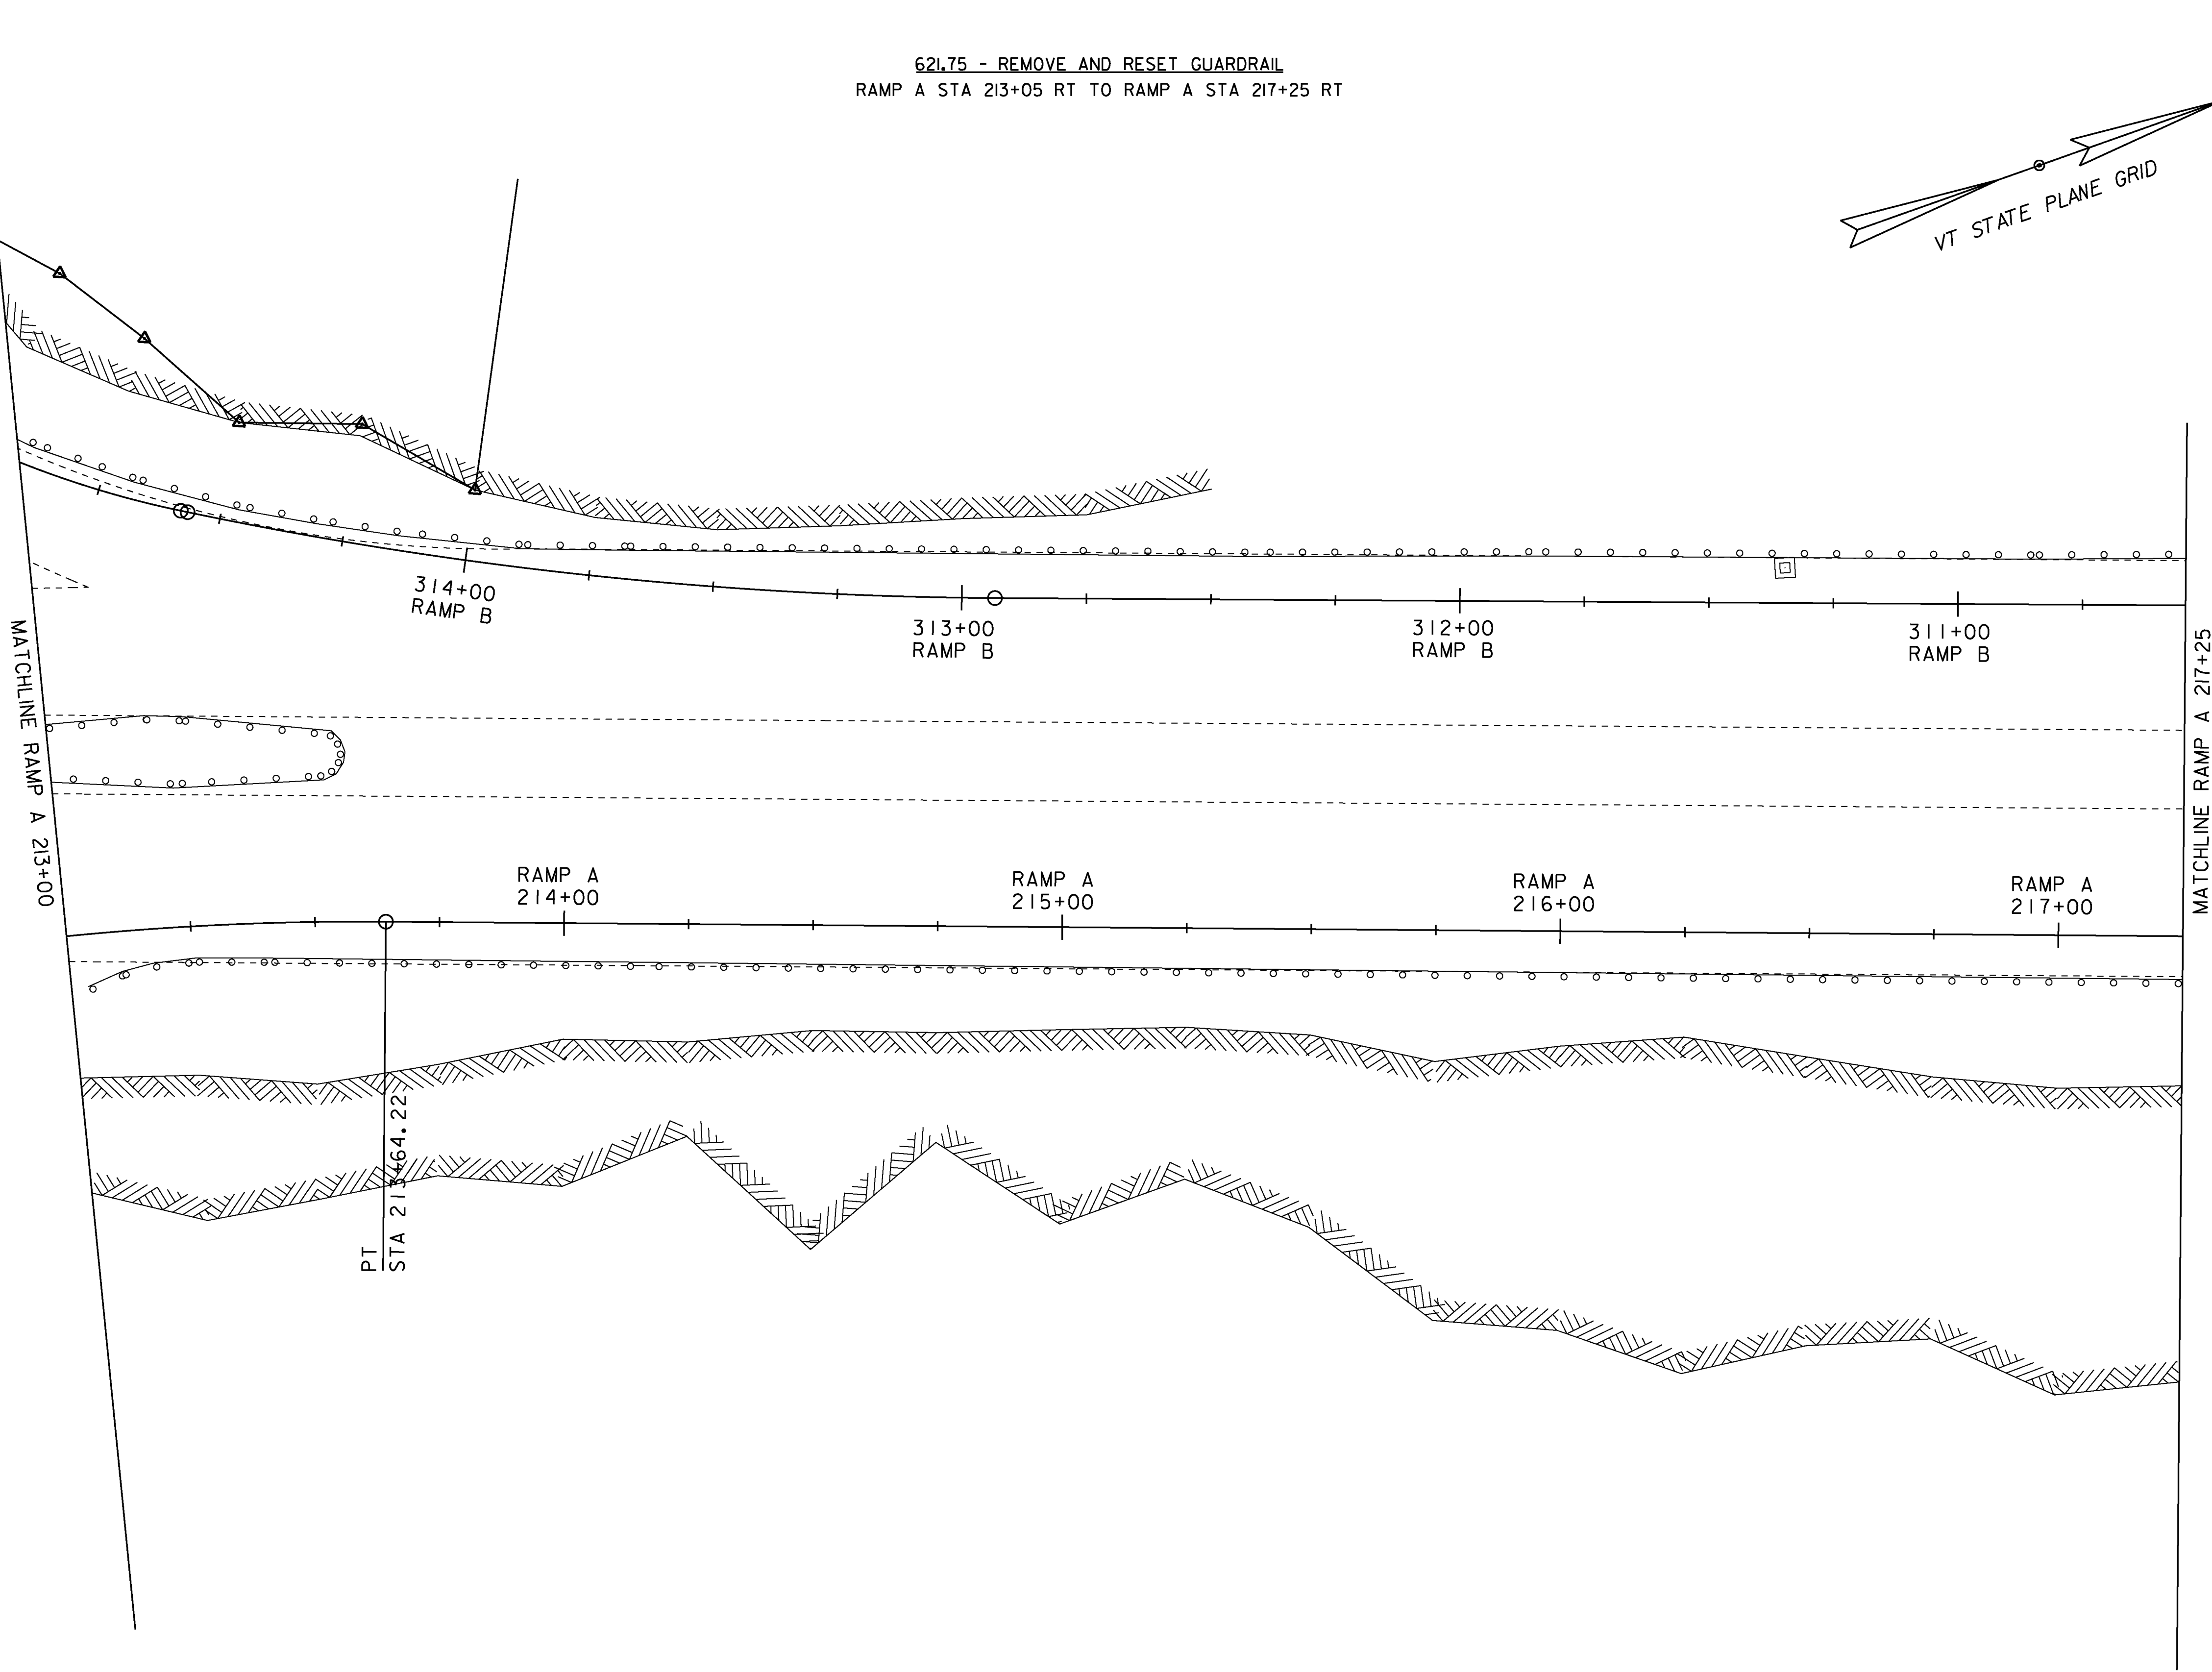


621.75 - REMOVE AND RESET GUARDRAIL
RAMP A STA 213+05 RT TO RAMP A STA 217+25 RT

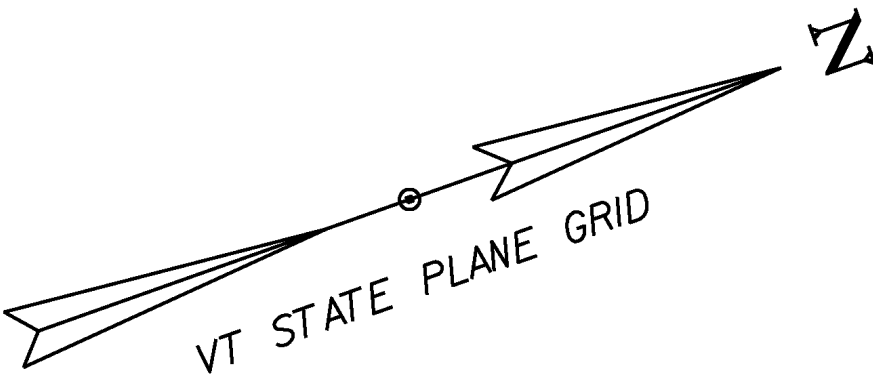

PLEASE SEE LAYOUT SHEET 6 FOR DETAILS ON RAMP B.

PROJECT NAME:	MONTPELIER
PROJECT NUMBER:	NH 028-2(9)
FILE NAME:	d:\b066\Design\dlib066bdra.dgn
PROJECT LEADER:	P. PELOQUIN
DESIGNED BY:	P. PELOQUIN
LAYOUT SHEET	3
PLOT DATE:	24-MAY-2013
DRAWN BY:	P. PELOQUIN
CHECKED BY:	A. BOMBARDIER
SHEET	9 OF 62