



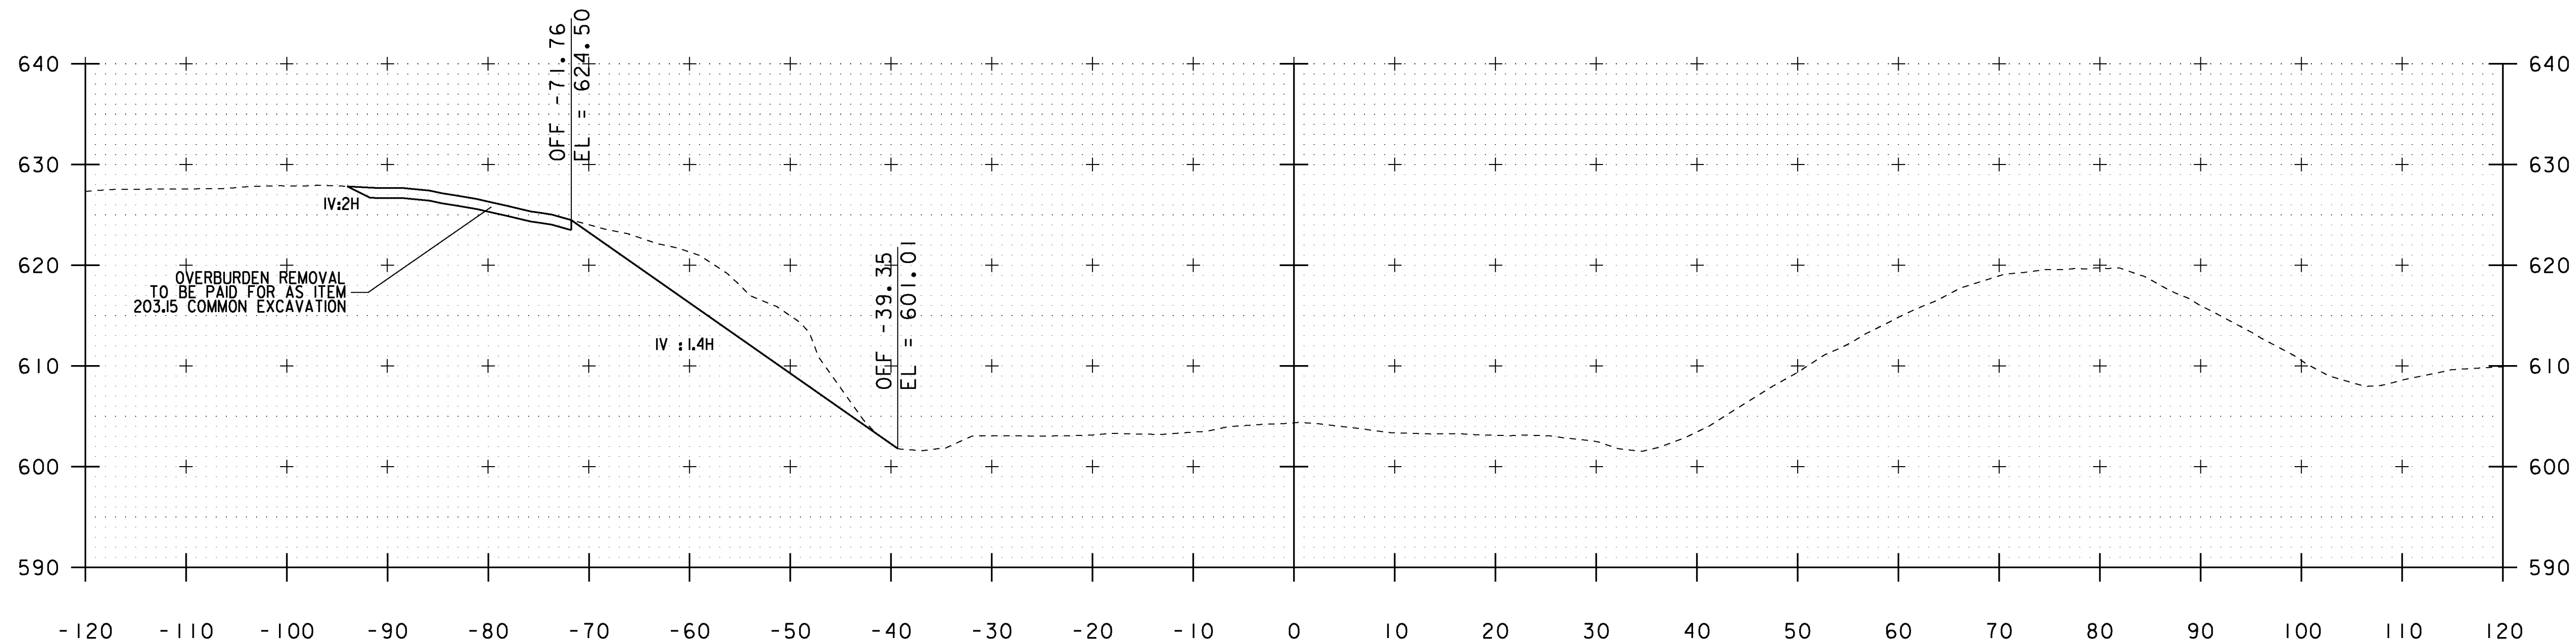


103+25

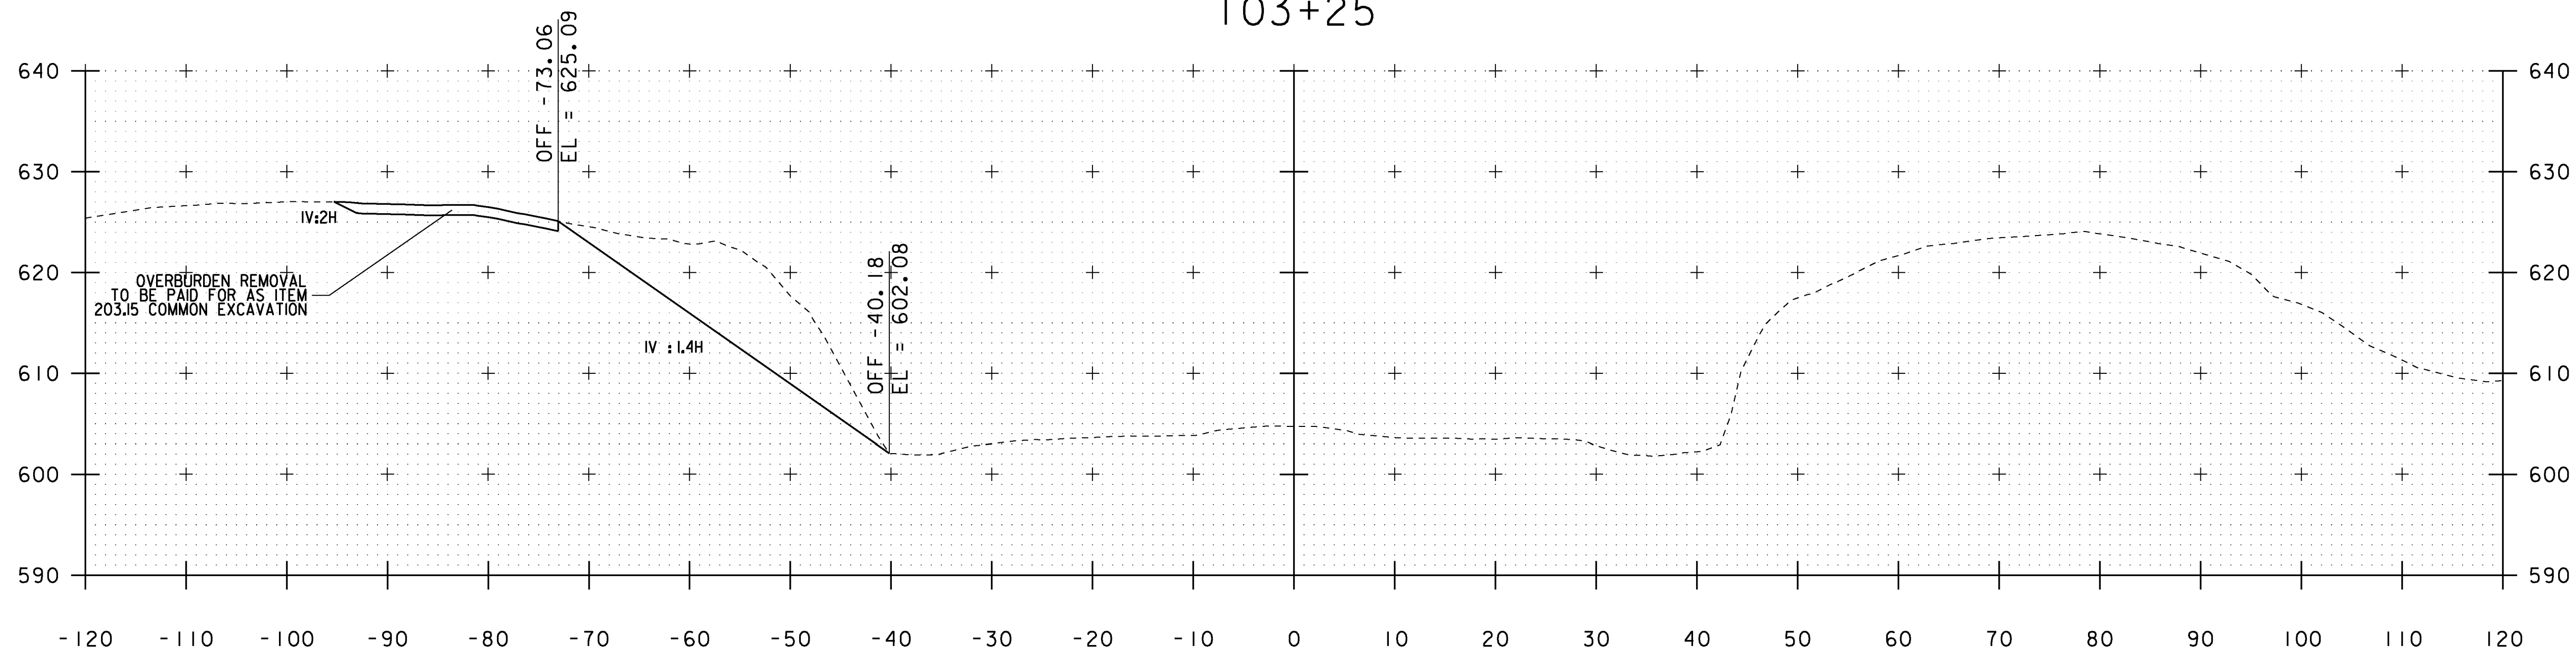

103+00

MONTPELIER STATE HIGHWAY

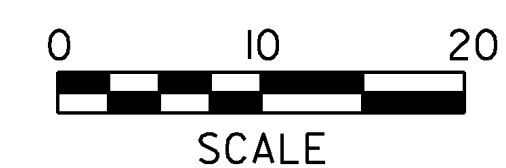

STA. 103+00 TO STA. 103+25

PROJECT NAME:	MONTPELIER	PLOT DATE:	24-MAY-2013
PROJECT NUMBER:	NH 028-2(9)	DRAWN BY:	P. PELOQUIN
FILE NAME:	lib066\Design\lib066xs.dgn	CHECKED BY:	A. BOMBARDIER
PROJECT LEADER:	P. PELOQUIN	SHEET	22 OF 62
DESIGNED BY:	P. PELOQUIN		
CROSS SECTION SHEET	4		