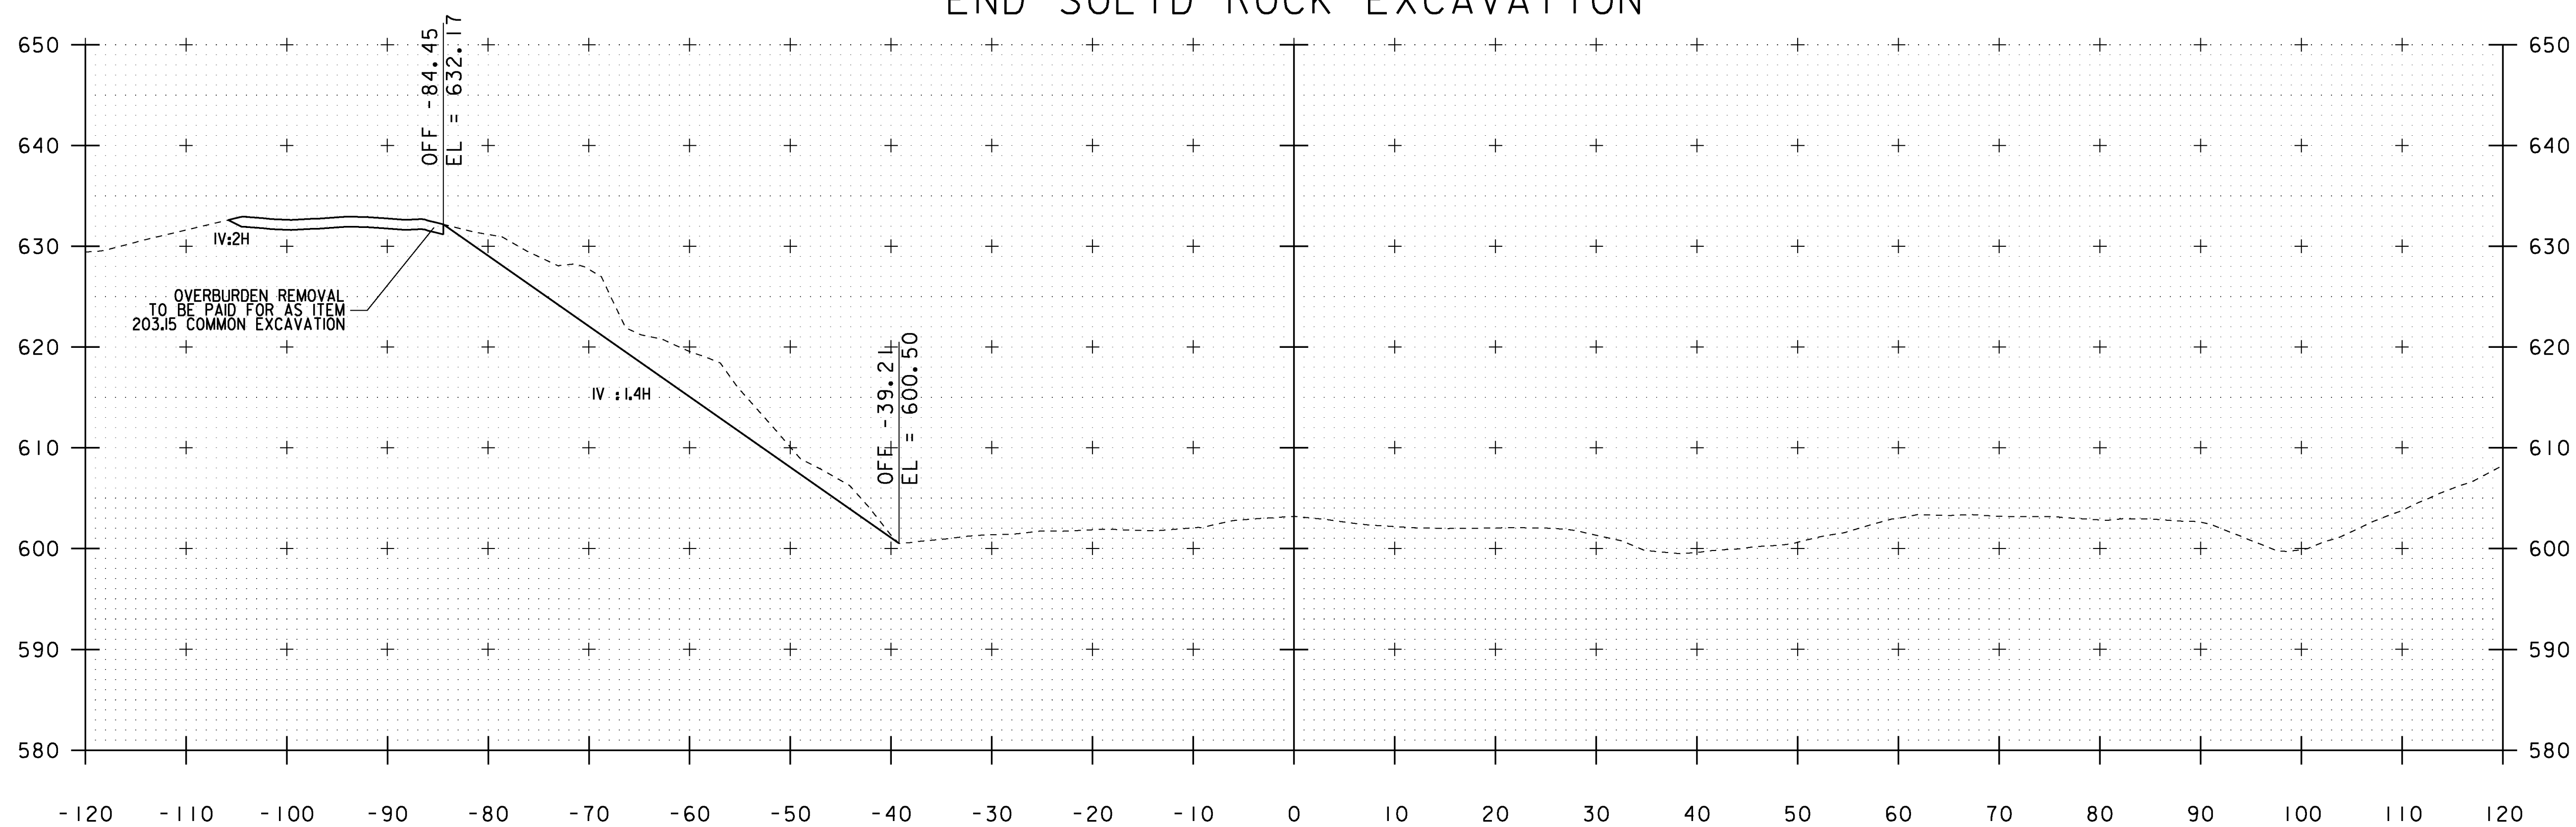
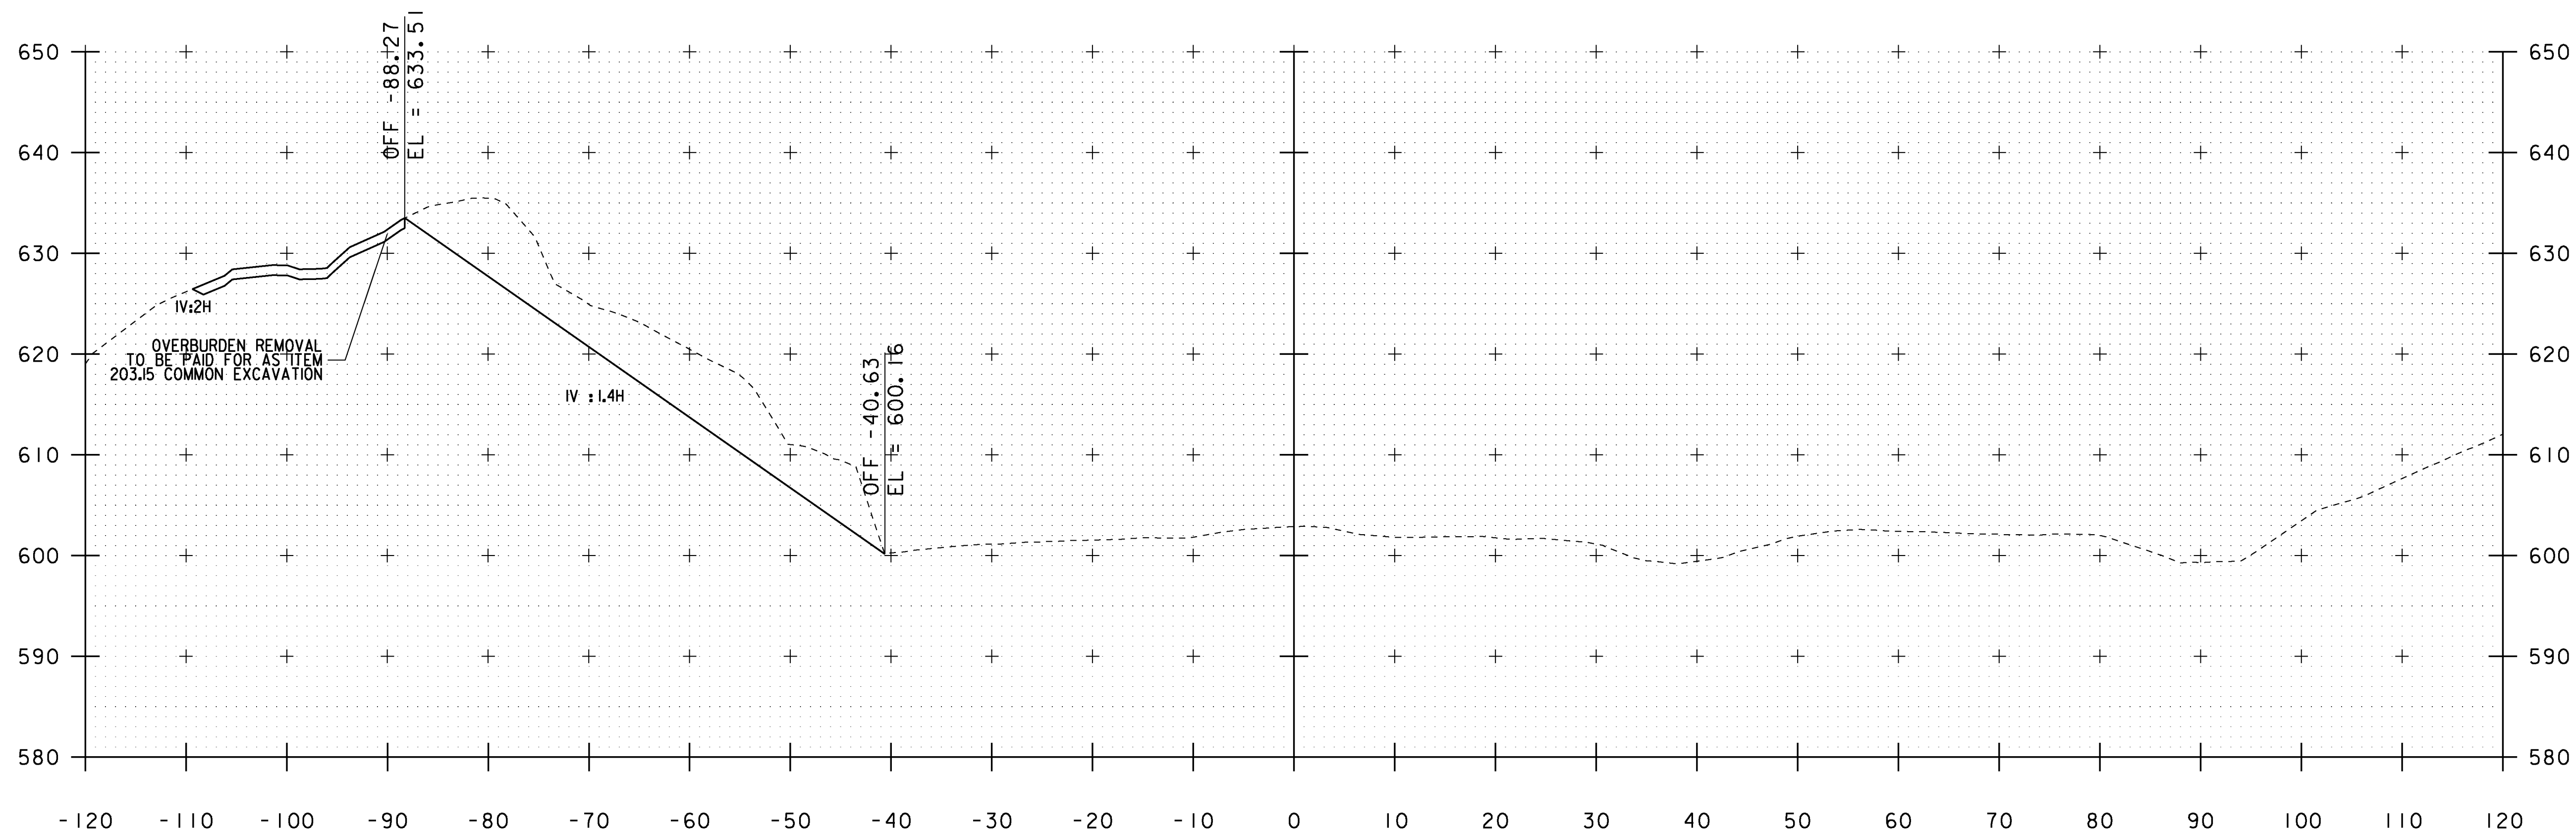


STA. 104+50 TO STA. 104+75

MONTPELIER STATE HIGHWAY

PROJECT NAME: MONTPELIER
PROJECT NUMBER: NH 028-2(9)

FILE NAME: I:\b066\Design\dlb066xs.dgn
PROJECT LEADER: P. PELOQUIN
DESIGNED BY: P. PELOQUIN
CROSS SECTION SHEET 7

PLOT DATE: 24-MAY-2013
DRAWN BY: P. PELOQUIN
CHECKED BY: A. BOMBARDIER
SHEET 25 OF 62