



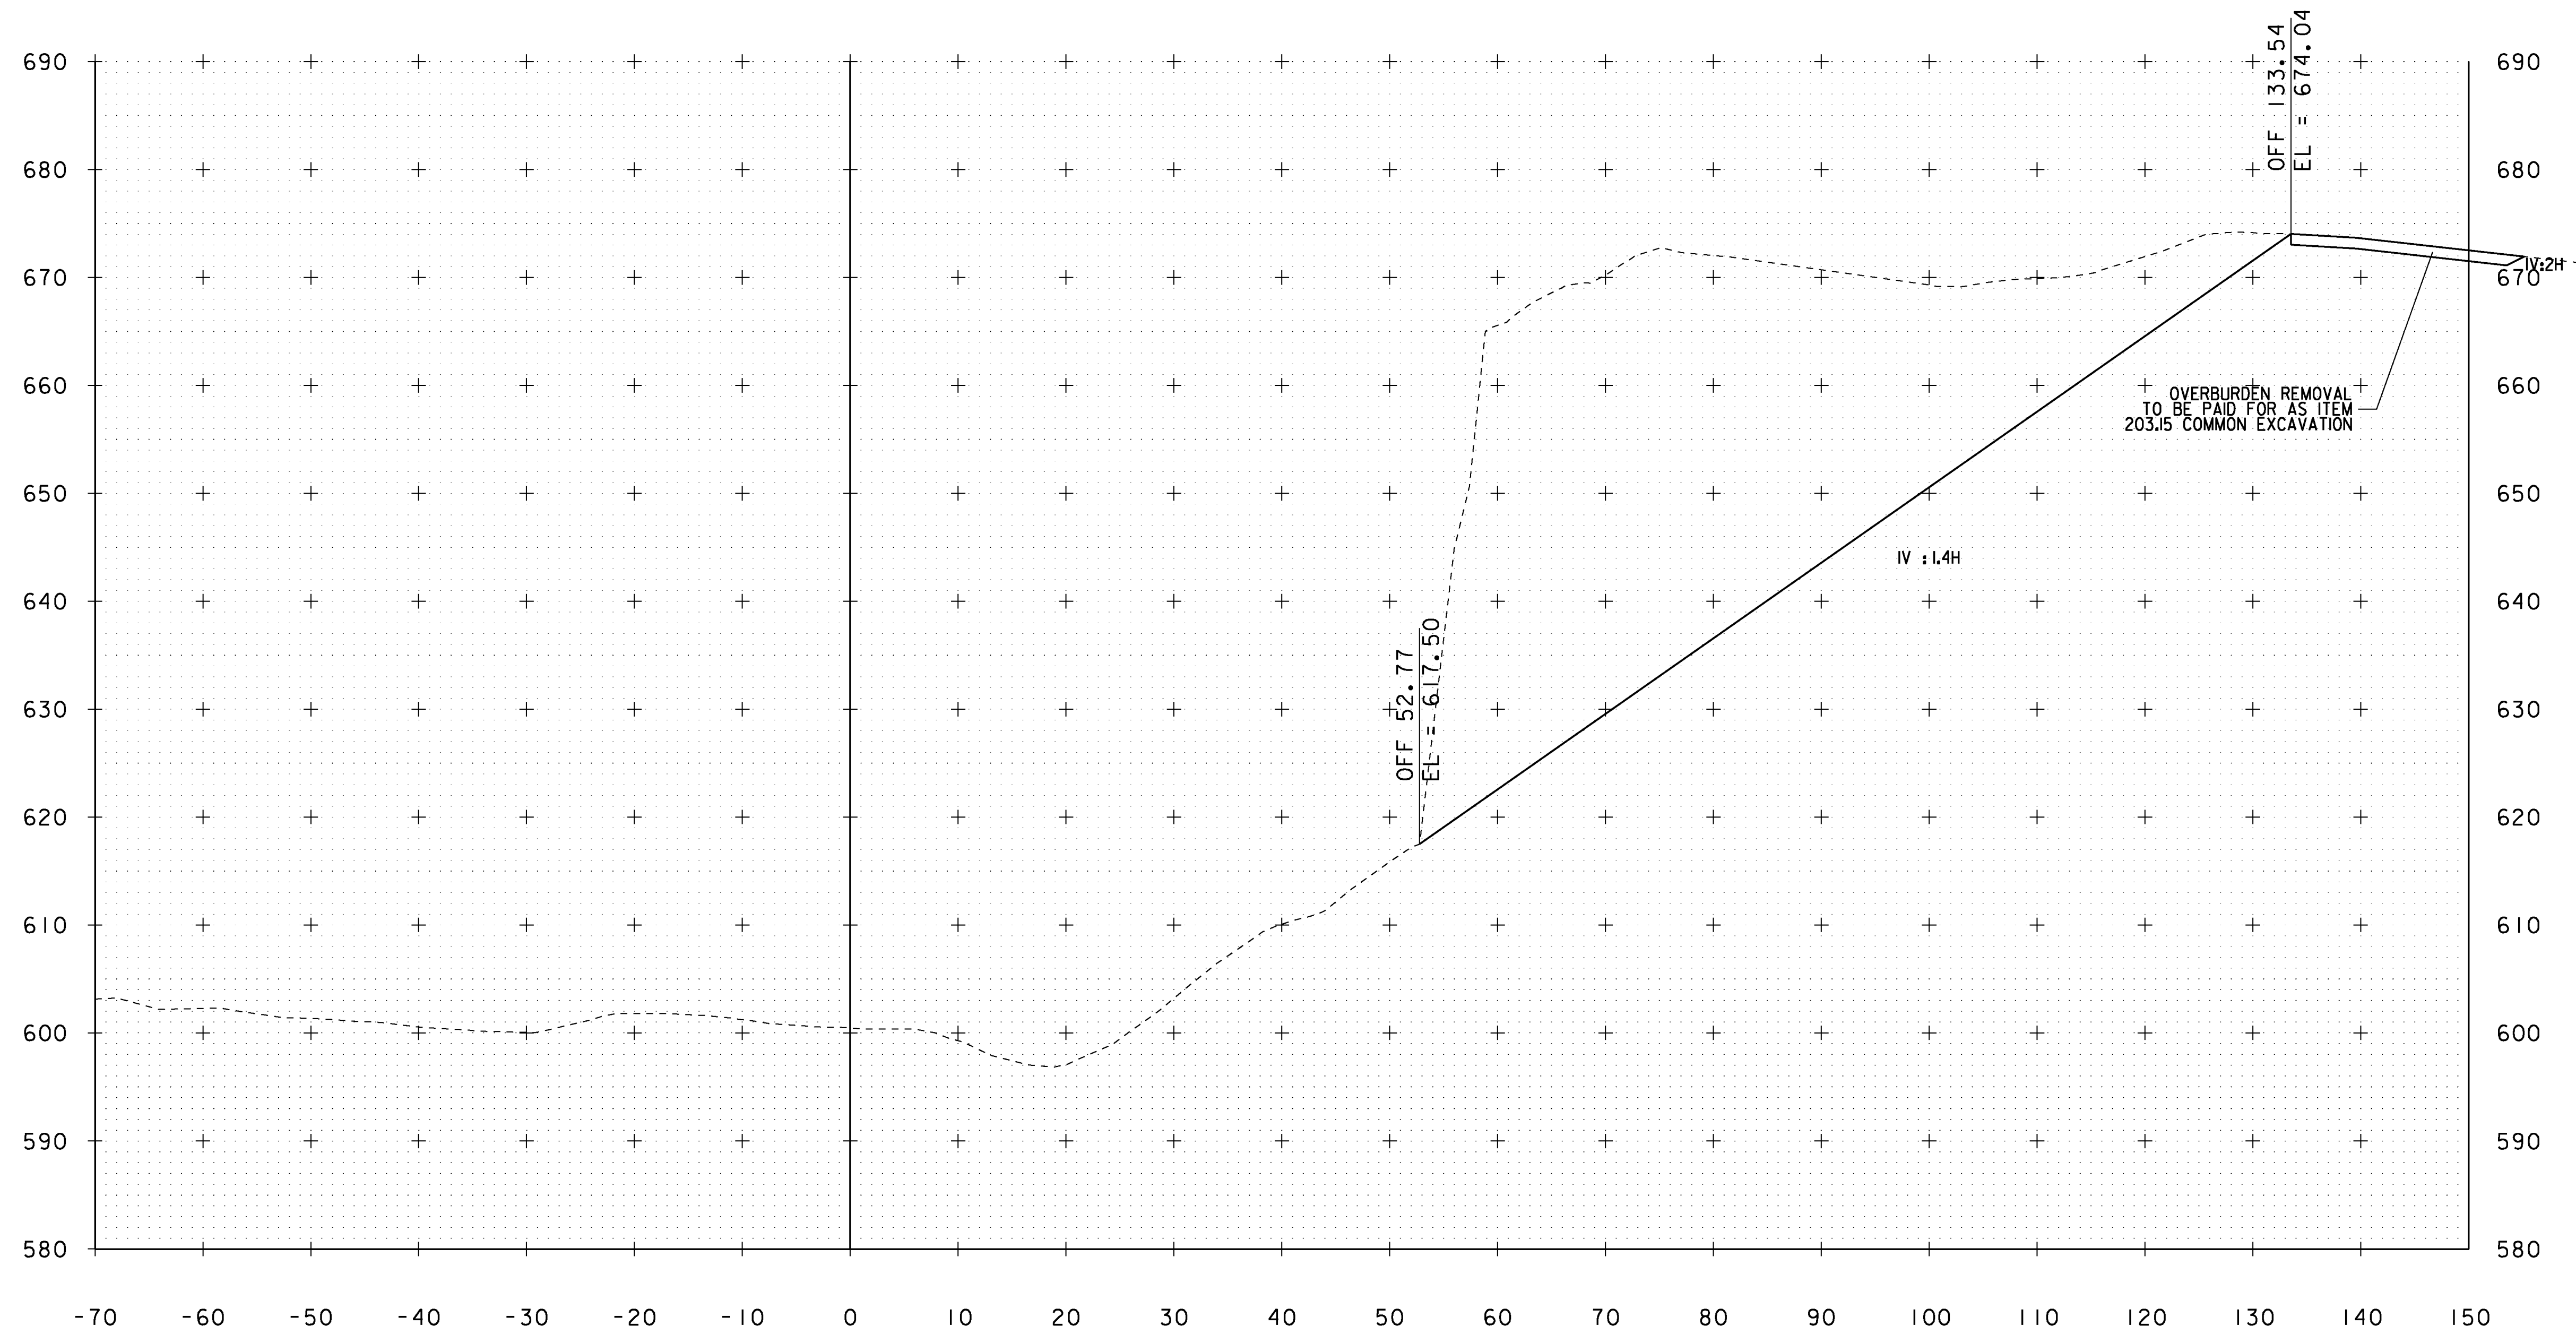

315+75

RAMP B

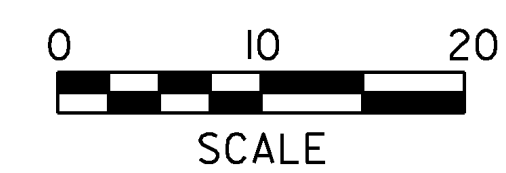

STA. 315+75

PROJECT NAME: MONTPELIER	
PROJECT NUMBER: NH 028-2(9)	
FILE NAME: I:\b066\Design\dlb066xs.dgn	PLOT DATE: 24-MAY-2013
PROJECT LEADER: P. PELOQUIN	DRAWN BY: P. PELOQUIN
DESIGNED BY: P. PELOQUIN	CHECKED BY: A. BOMBARDIER
CROSS SECTION SHEET 16	SHEET 34 OF 62