


316+50

RAMP B

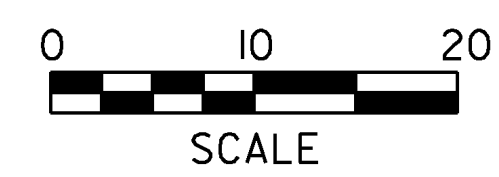

STA. 316+50

PROJECT NAME: MONTPELIER	PLOT DATE: 24-MAY-2013
PROJECT NUMBER: NH 028-2(9)	DRAWN BY: P. PELOQUIN
FILE NAME: I:\b066\Design\dlb066xs.dgn	CHECKED BY: A. BOMBARDIER
PROJECT LEADER: P. PELOQUIN	SHEET 37 OF 62
DESIGNED BY: P. PELOQUIN	
CROSS SECTION SHEET 19	