



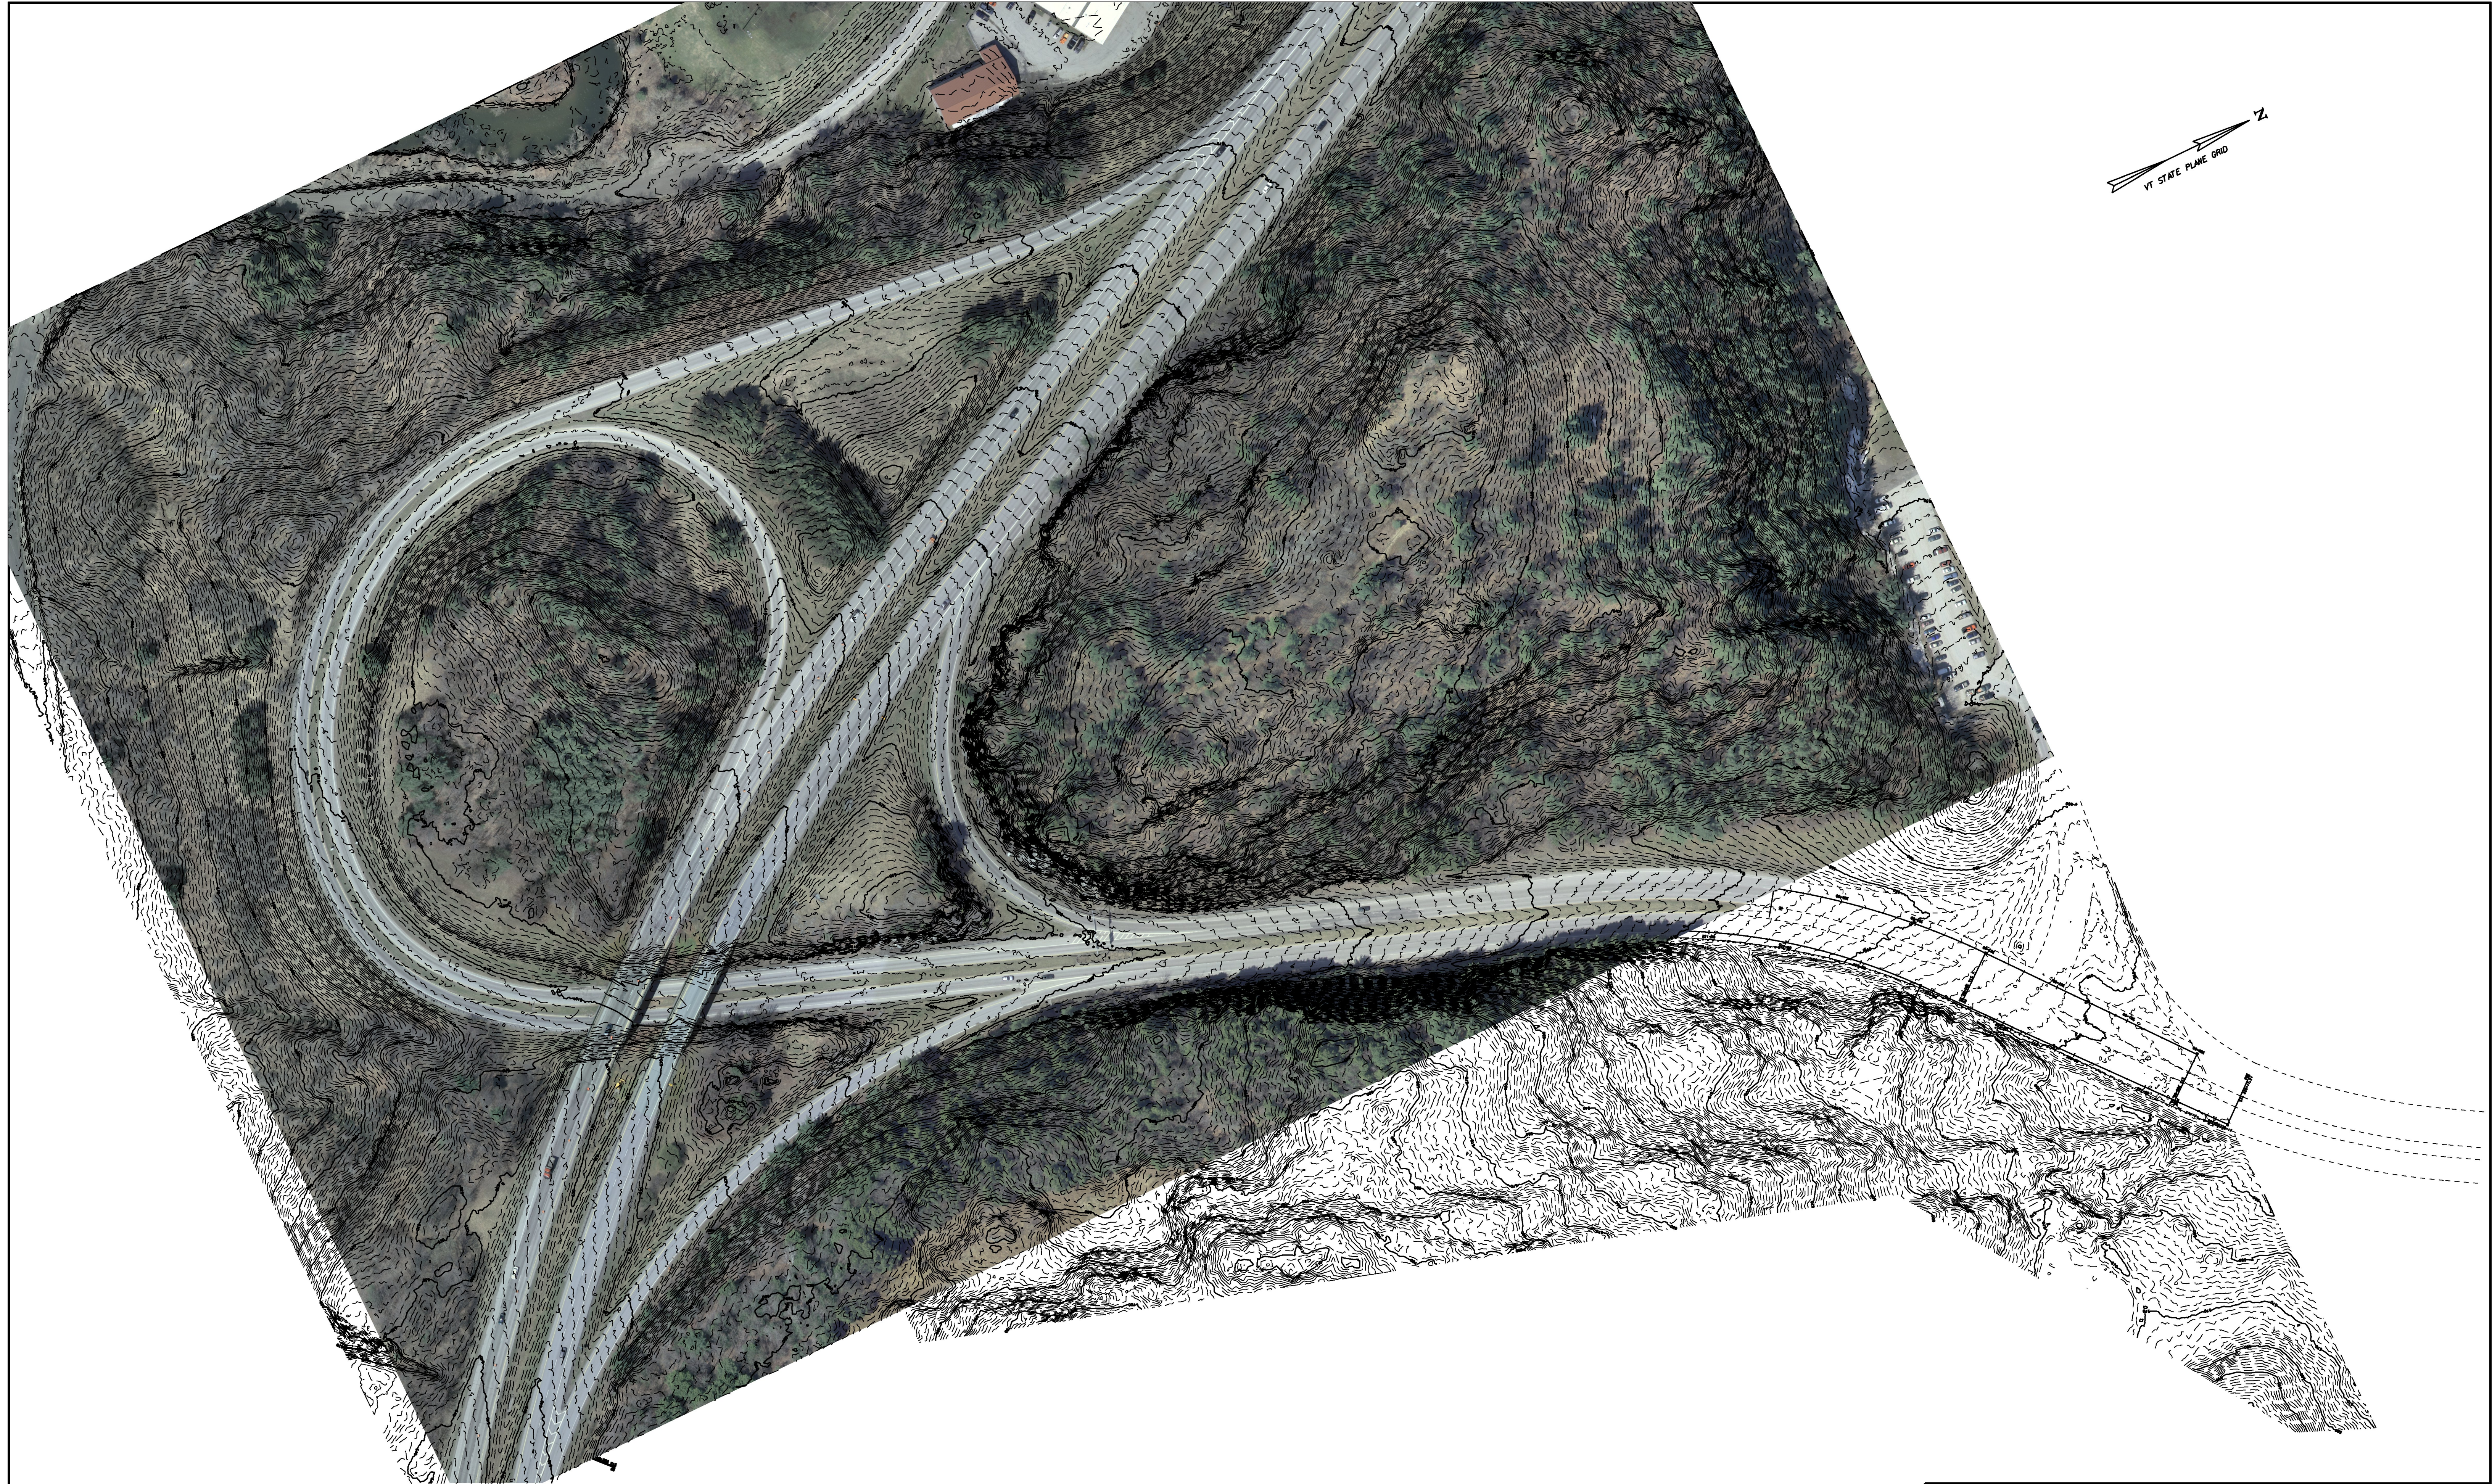

FOR INFORMATION ONLY
EXISTING CONDITIONS LAYOUT SHEET 1

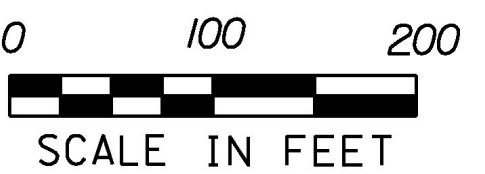

PROJECT NAME: MONTPELIER	
PROJECT NUMBER: NH 028-2(9)	
FILE NAME: Iib066\Design\dlb066env.dgn	PLOT DATE: 24-MAY-2013
PROJECT LEADER: P. PELOQUIN	DRAWN BY: P. PELOQUIN
DESIGNED BY: P. PELOQUIN	CHECKED BY: A. BOMBARDIER
EXISTING CONDITIONS LAYOUT SHEET 1	SHEET 41 OF 62