


INTERSTATE 89 MAINLINE TREATMENT SCHEMATIC
 (REFERENCE COMPUTATION BINDER SECTION 646.XXX)

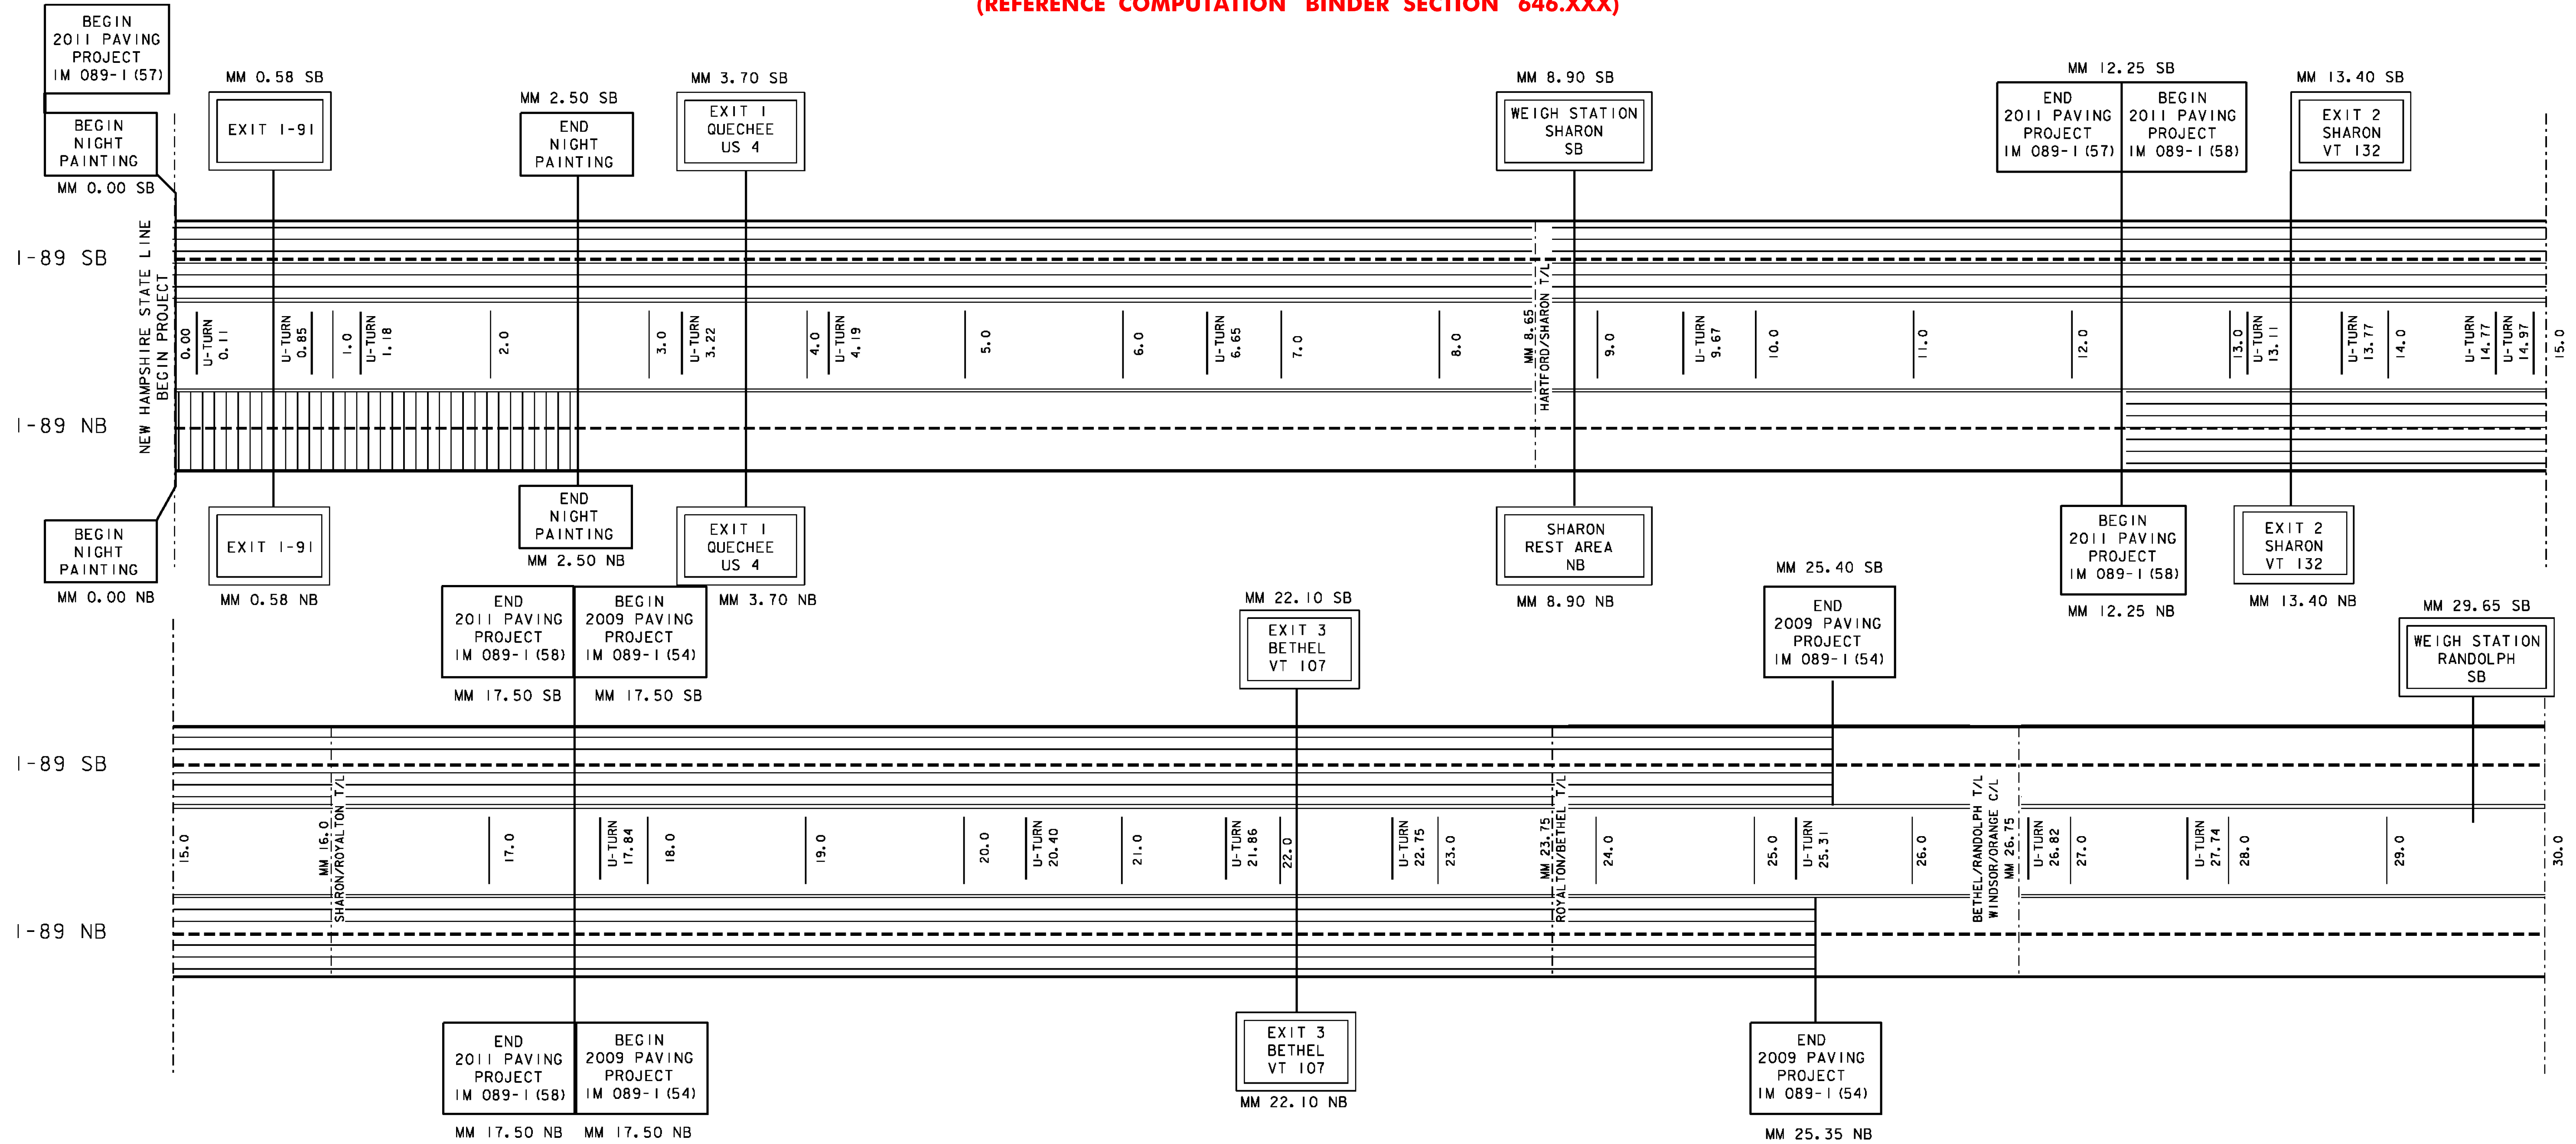

- LEGEND**
- = AREA NOT TO BE PAINTED
 - = AREA TO BE DONE AT NIGHT
 - = 6'' SOLID WHITE LINE
 - = 6'' DASHED WHITE LINE
 - = 6'' SOLID YELLOW LINE

NOT TO SCALE

I-89 MAINLINE TREATMENT SCHEMATIC SHEET 1	PROJECT NAME: STATEWIDE
	PROJECT NUMBER: IMG MARK (112)
	FILE NAME: 11k274.dgn
	PROJECT LEADER: A GAMBLE
	PLOT DATE: 25-JAN-2012
	DRAWN BY: KAS
	SHEET 15 OF 29