


**INTERSTATE 89 MAINLINE TREATMENT SCHEMATIC**  
 (REFERENCE COMPUTATION BINDER SECTION 646.XXX)

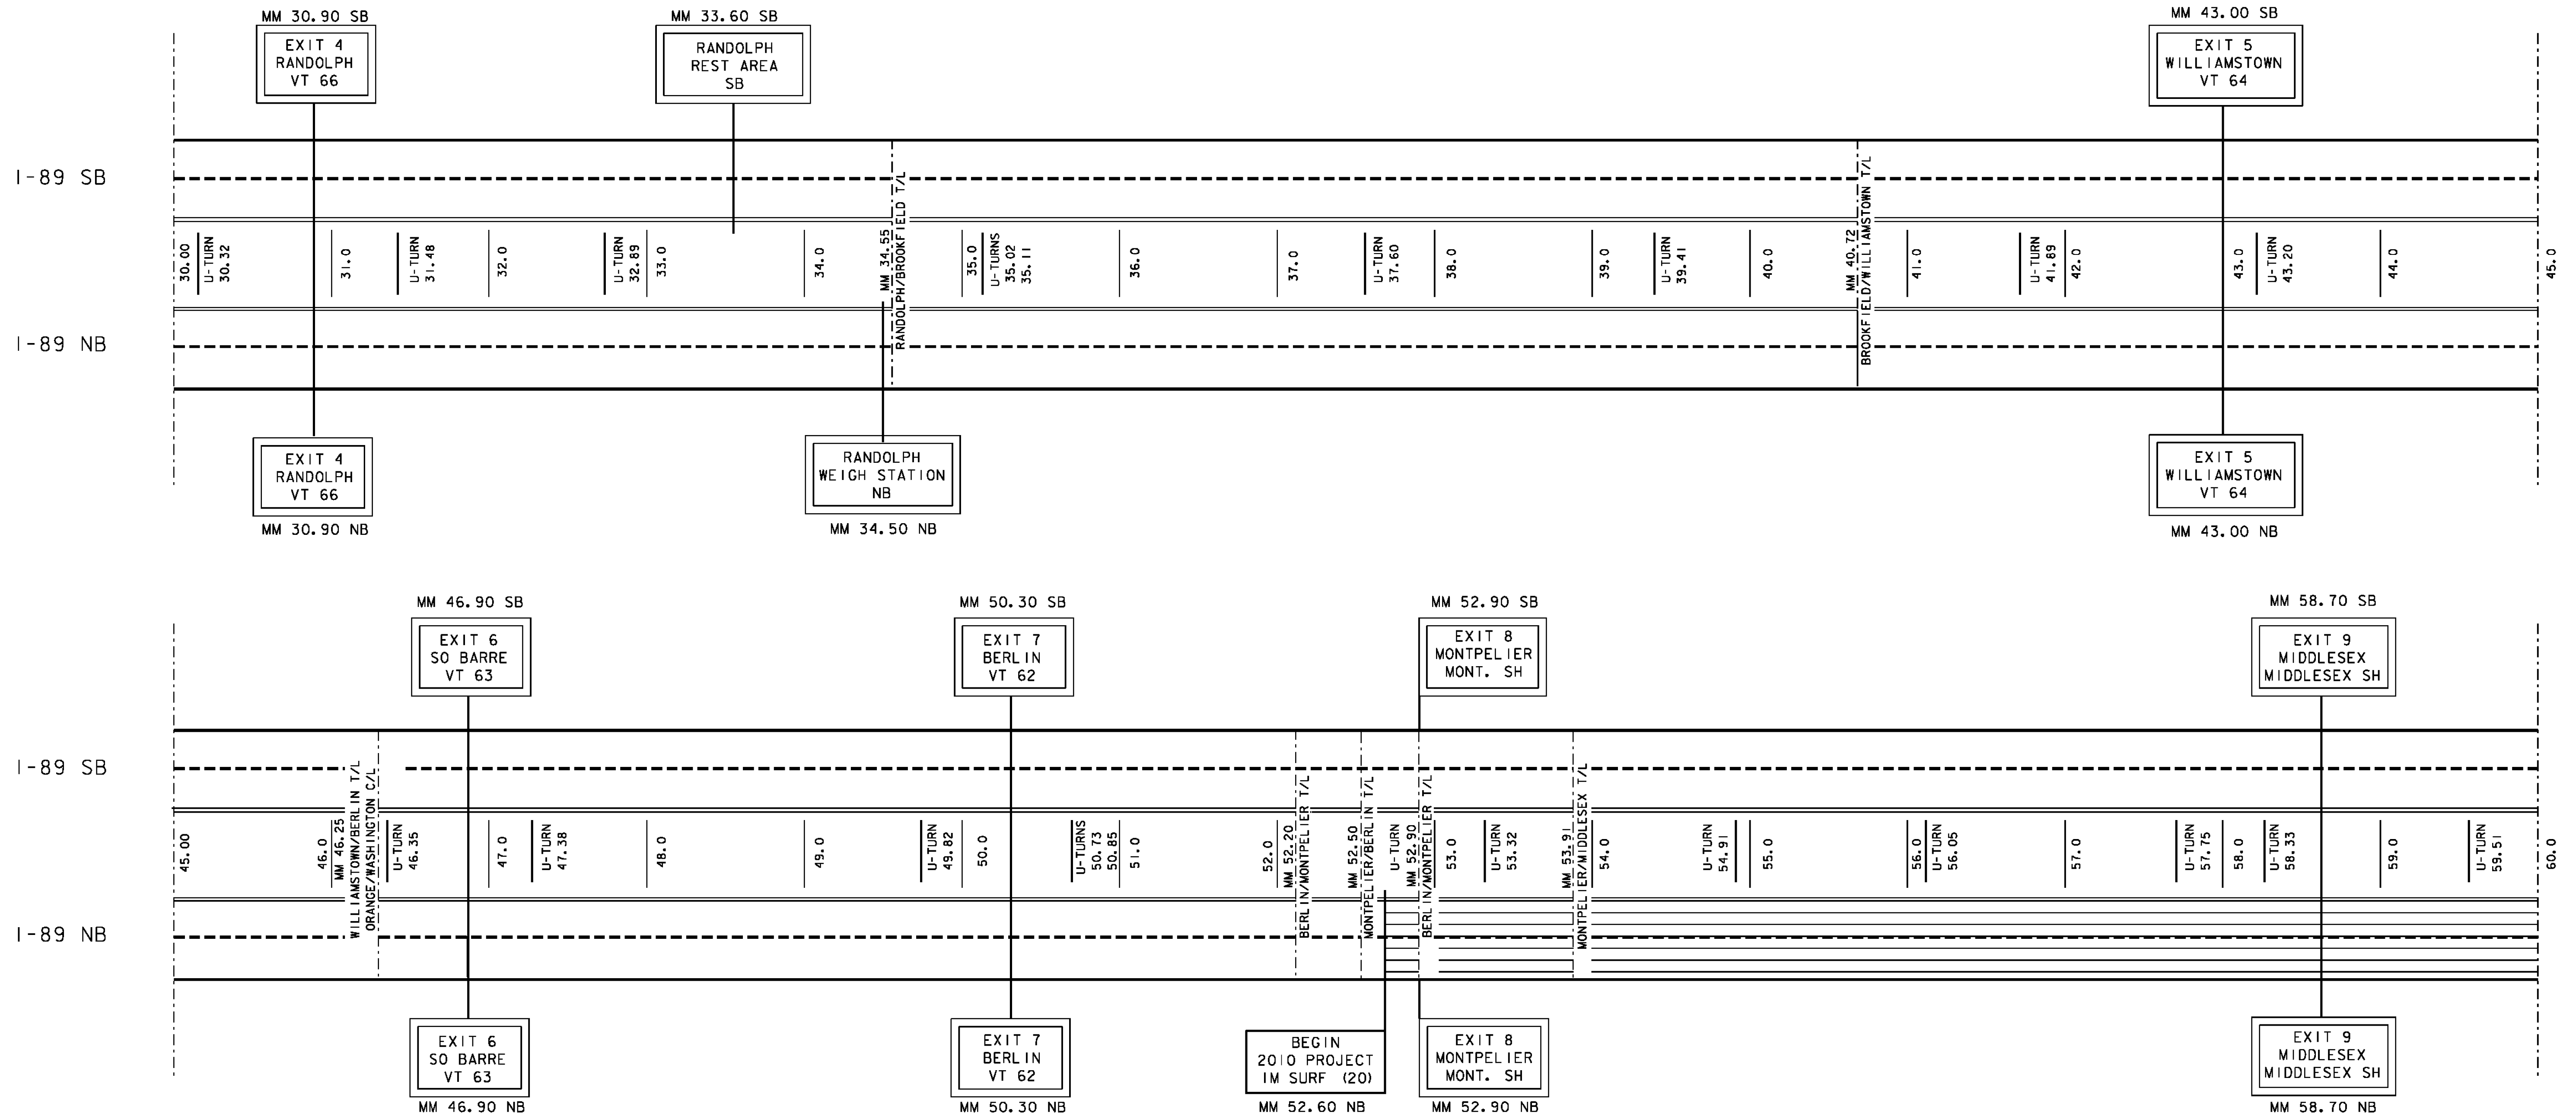

NOT TO SCALE

<b>I-89 MAINLINE TREATMENT SCHEMATIC SHEET 2</b>	PROJECT NAME: STATEWIDE
	PROJECT NUMBER: IMG MARK (I12)
	FILE NAME: I1k274.dgn
	PROJECT LEADER: A GAMBLE
	PLOT DATE: 25-JAN-2012
	DRAWN BY: KAS
	SHEET 16 OF 29