


INTERSTATE 89 MAINLINE TREATMENT SCHEMATIC

(REFERENCE COMPUTATION BINDER SECTION 646.XXX)

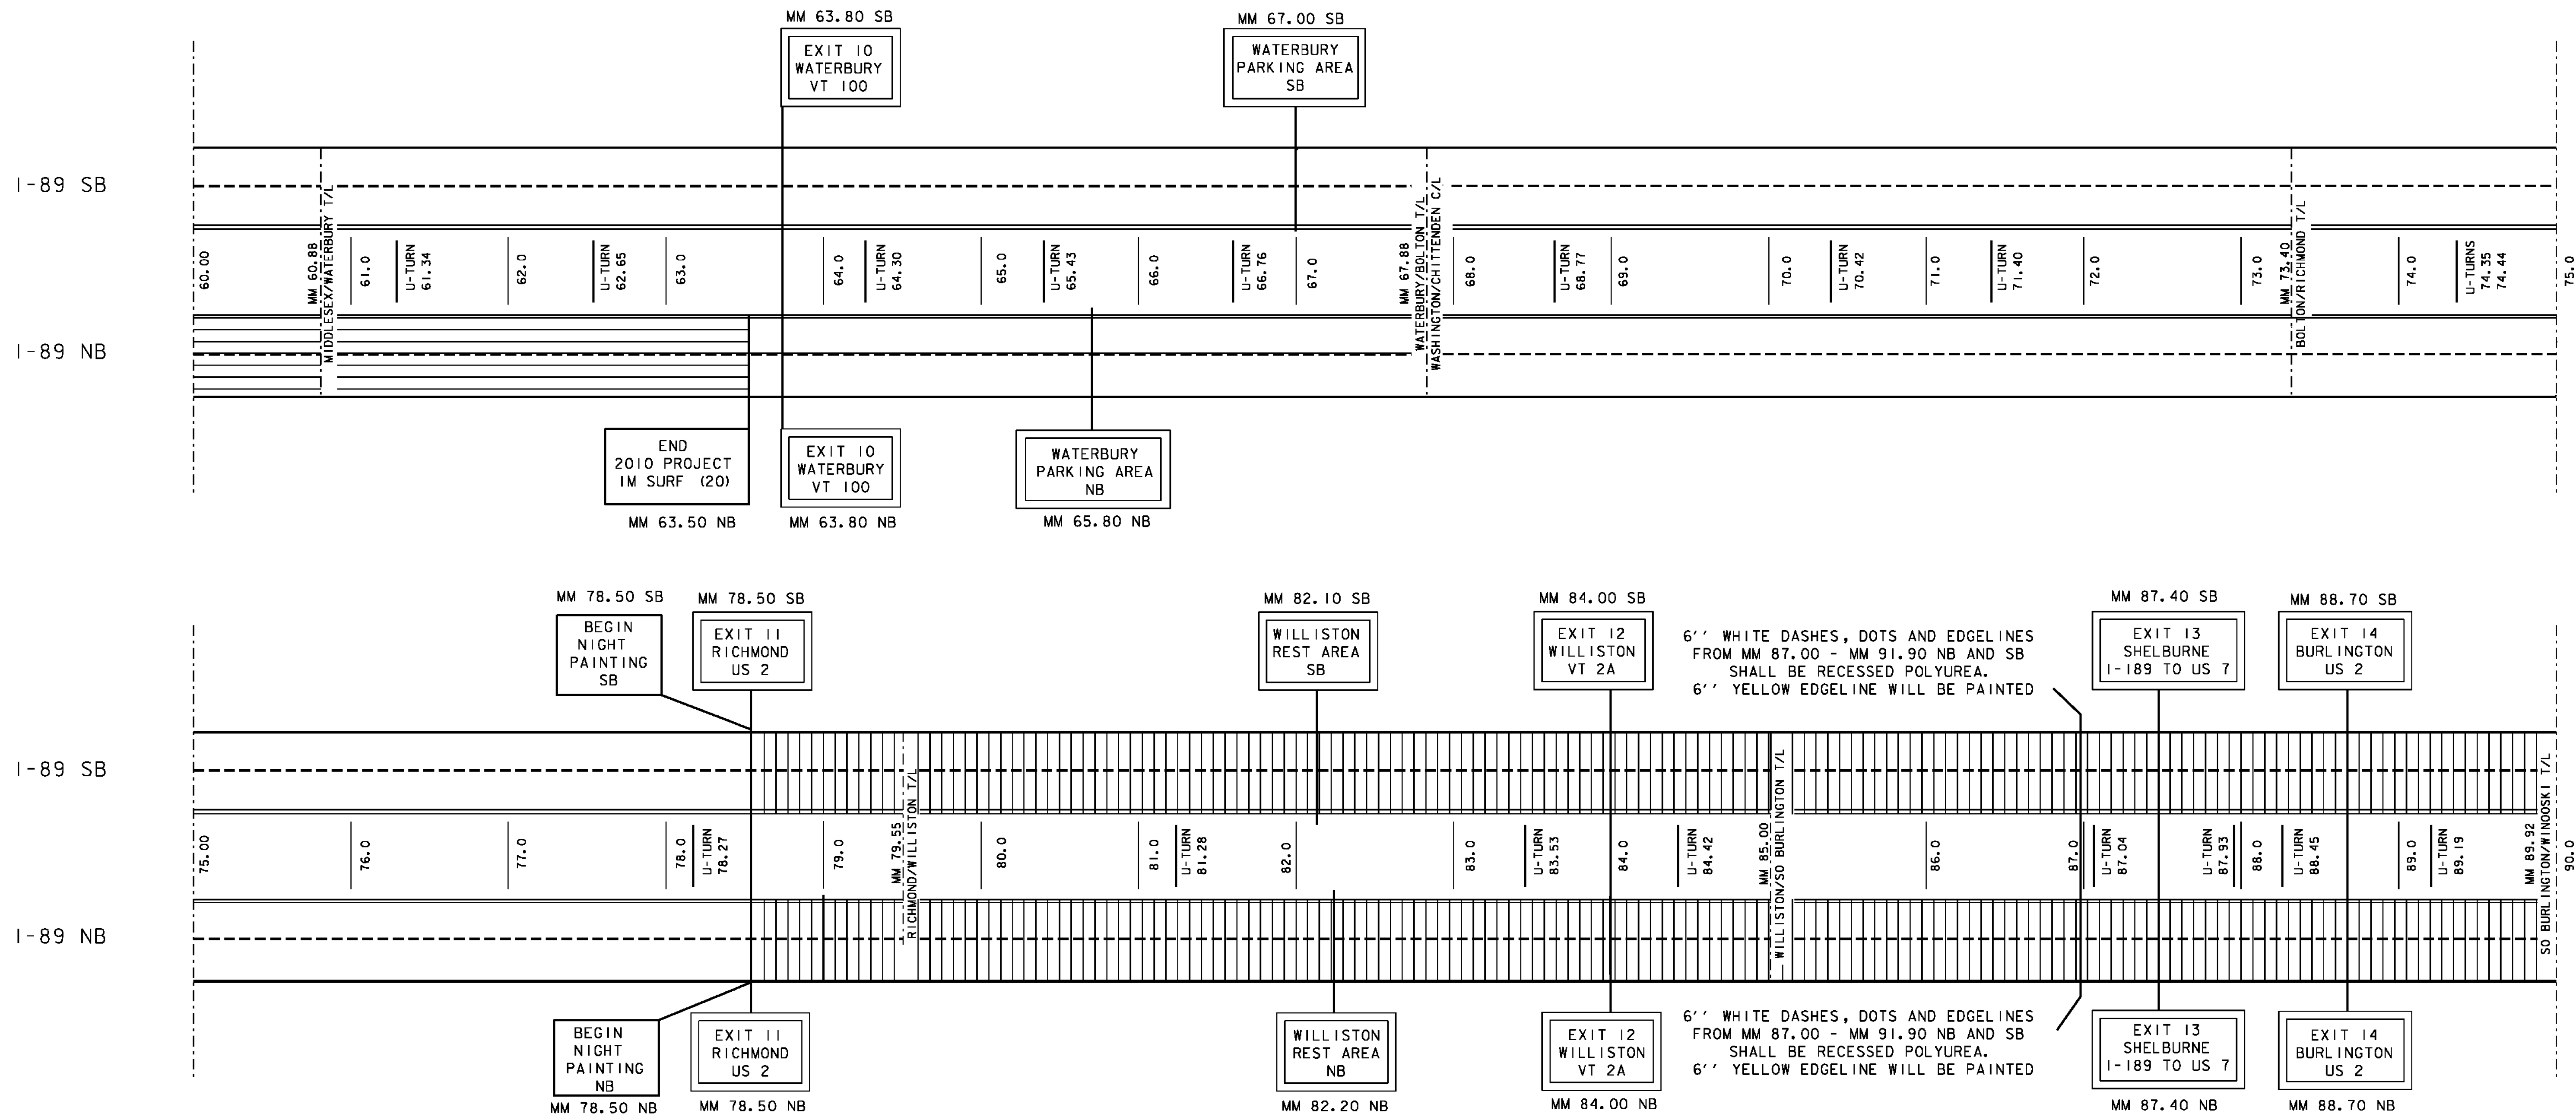

- LEGEND**
- = AREA NOT TO BE PAINTED
 - = AREA TO BE DONE AT NIGHT
 - = 6'' SOLID WHITE LINE
 - = 6'' DASHED WHITE LINE
 - = 6'' SOLID YELLOW LINE

NOT TO SCALE

I-89 MAINLINE TREATMENT SCHEMATIC SHEET 3	PROJECT NAME: STATEWIDE
	PROJECT NUMBER: IMG MARK (I12)
	FILE NAME: I1k274.dgn PLOT DATE: 25-JAN-2012
PROJECT LEADER: A GAMBLE DRAWN BY: KAS	
IPARM FLIE: 11k274ms3.i SHEET 17 OF 29	