


INTERSTATE 91 MAINLINE TREATMENT SCHEMATIC
(REFERENCE COMPUTATION BINDER SECTION 646.XXX)

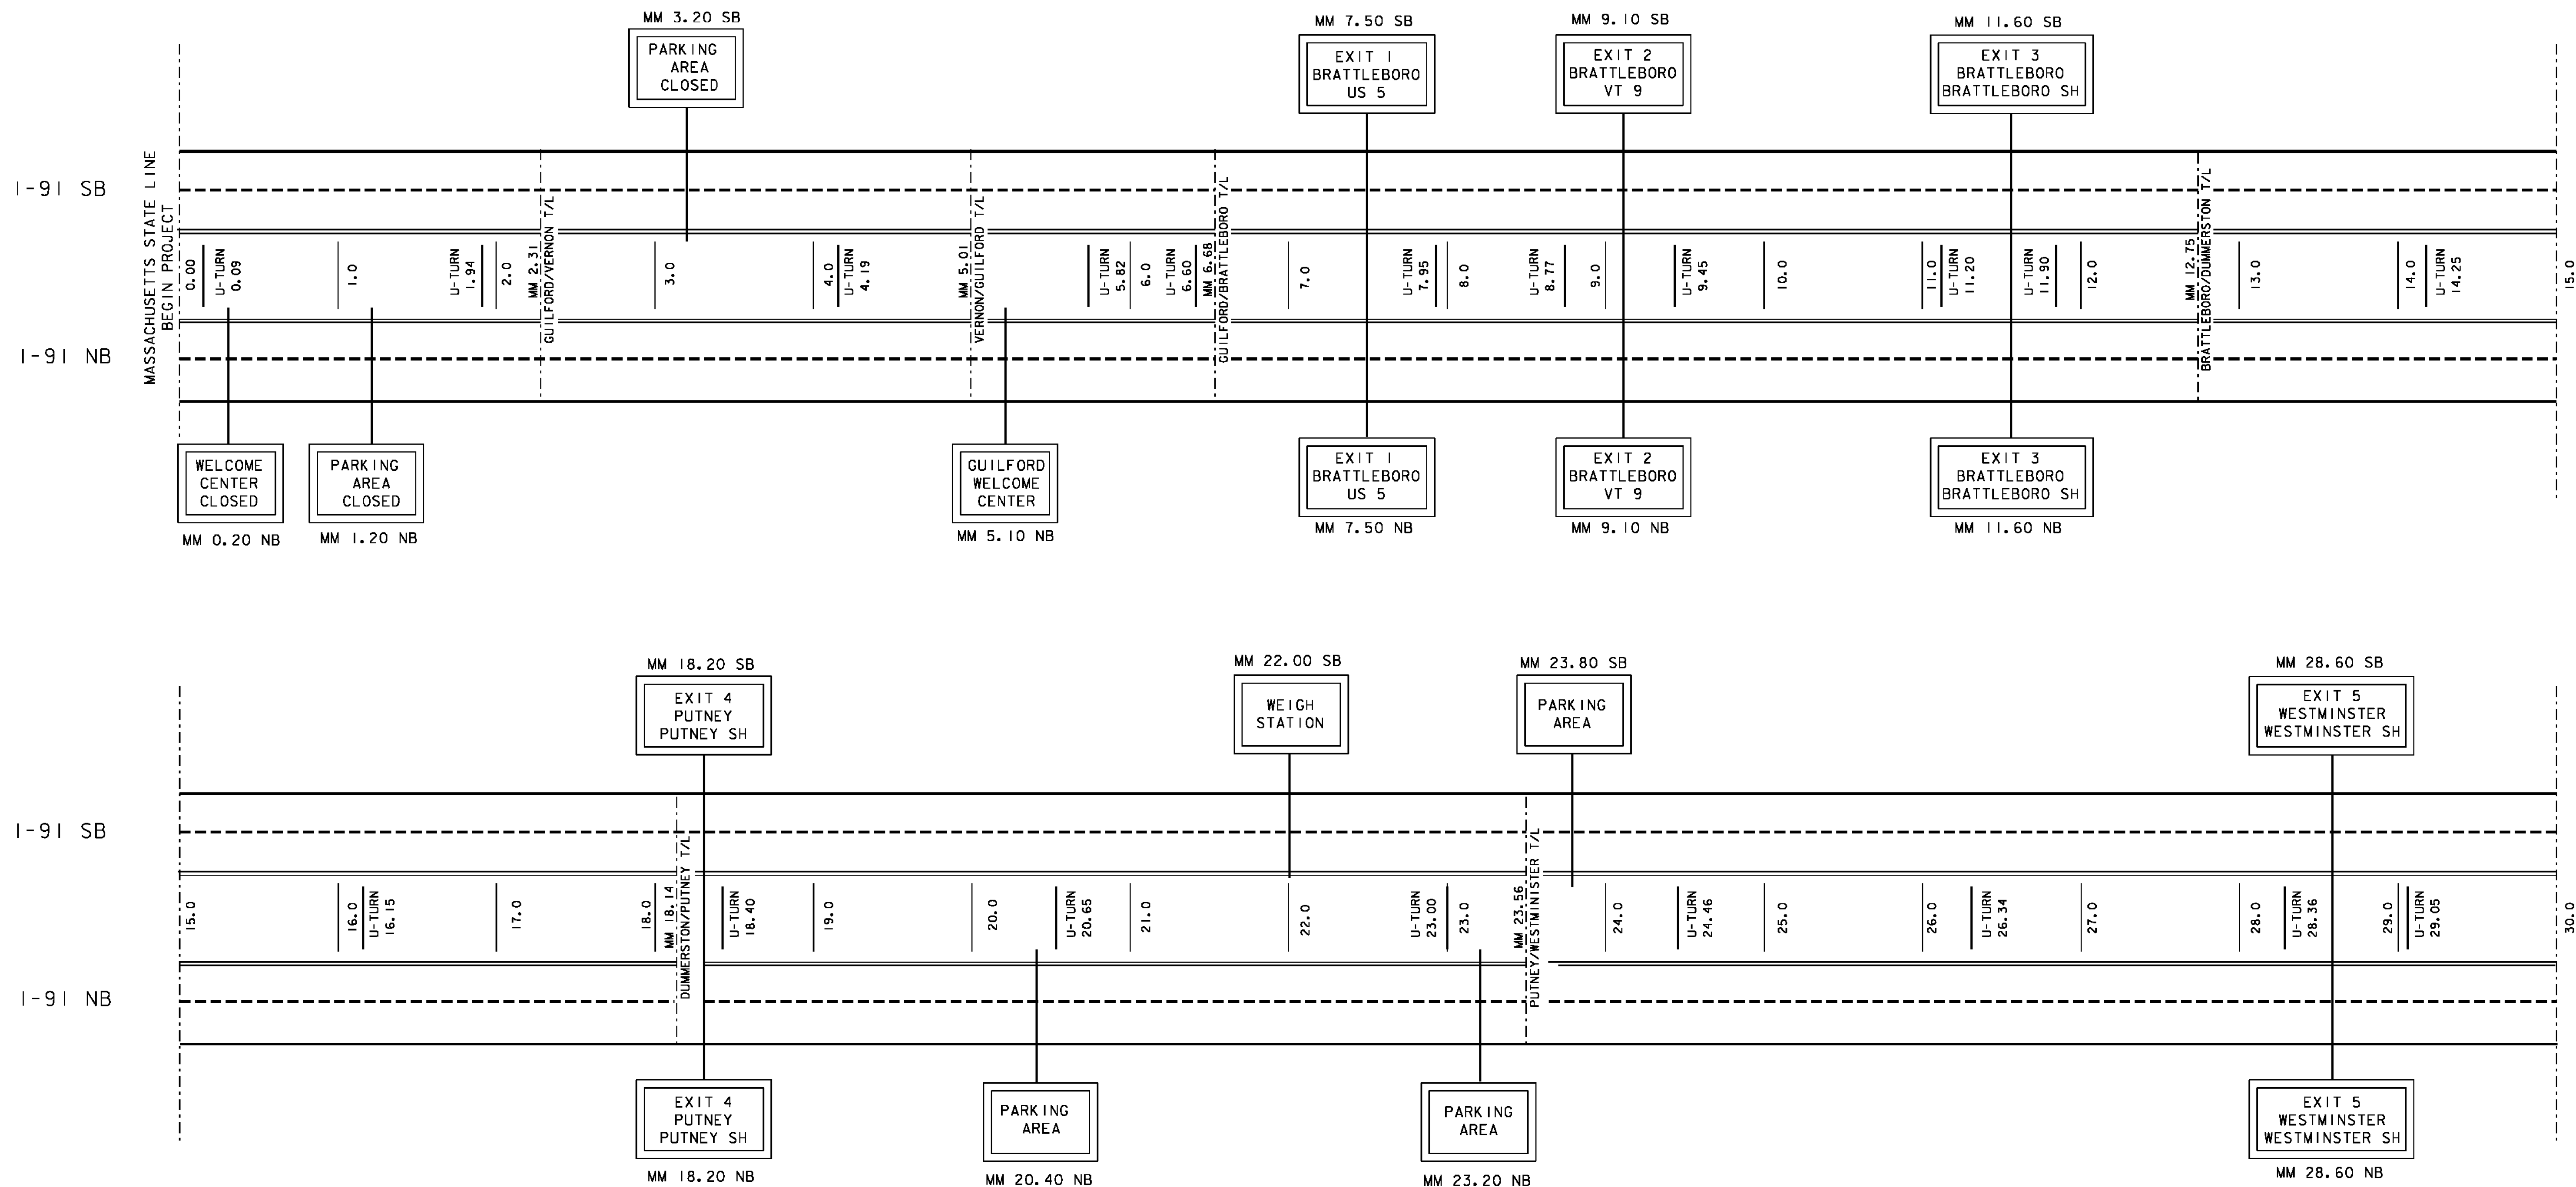

- LEGEND
- [Pattern] = AREA NOT TO BE PAINTED
 - [Pattern] = AREA TO BE DONE AT NIGHT
 - [Line] = 6'' SOLID WHITE LINE
 - [Line] = 6'' DASHED WHITE LINE
 - [Line] = 6'' SOLID YELLOW LINE

NOT TO SCALE

I-91 MAINLINE
TREATMENT SCHEMATIC
SHEET 1

PROJECT NAME:	STATEWIDE
PROJECT NUMBER:	IMG MARK (I12)
FILE NAME:	I1k274.dgn
PROJECT LEADER:	A GAMBLE
IPARM FLIE:	11k274ms6.i
PLOT DATE:	25-JAN-2012
DRAWN BY:	KAS
SHEET	21 OF 29