




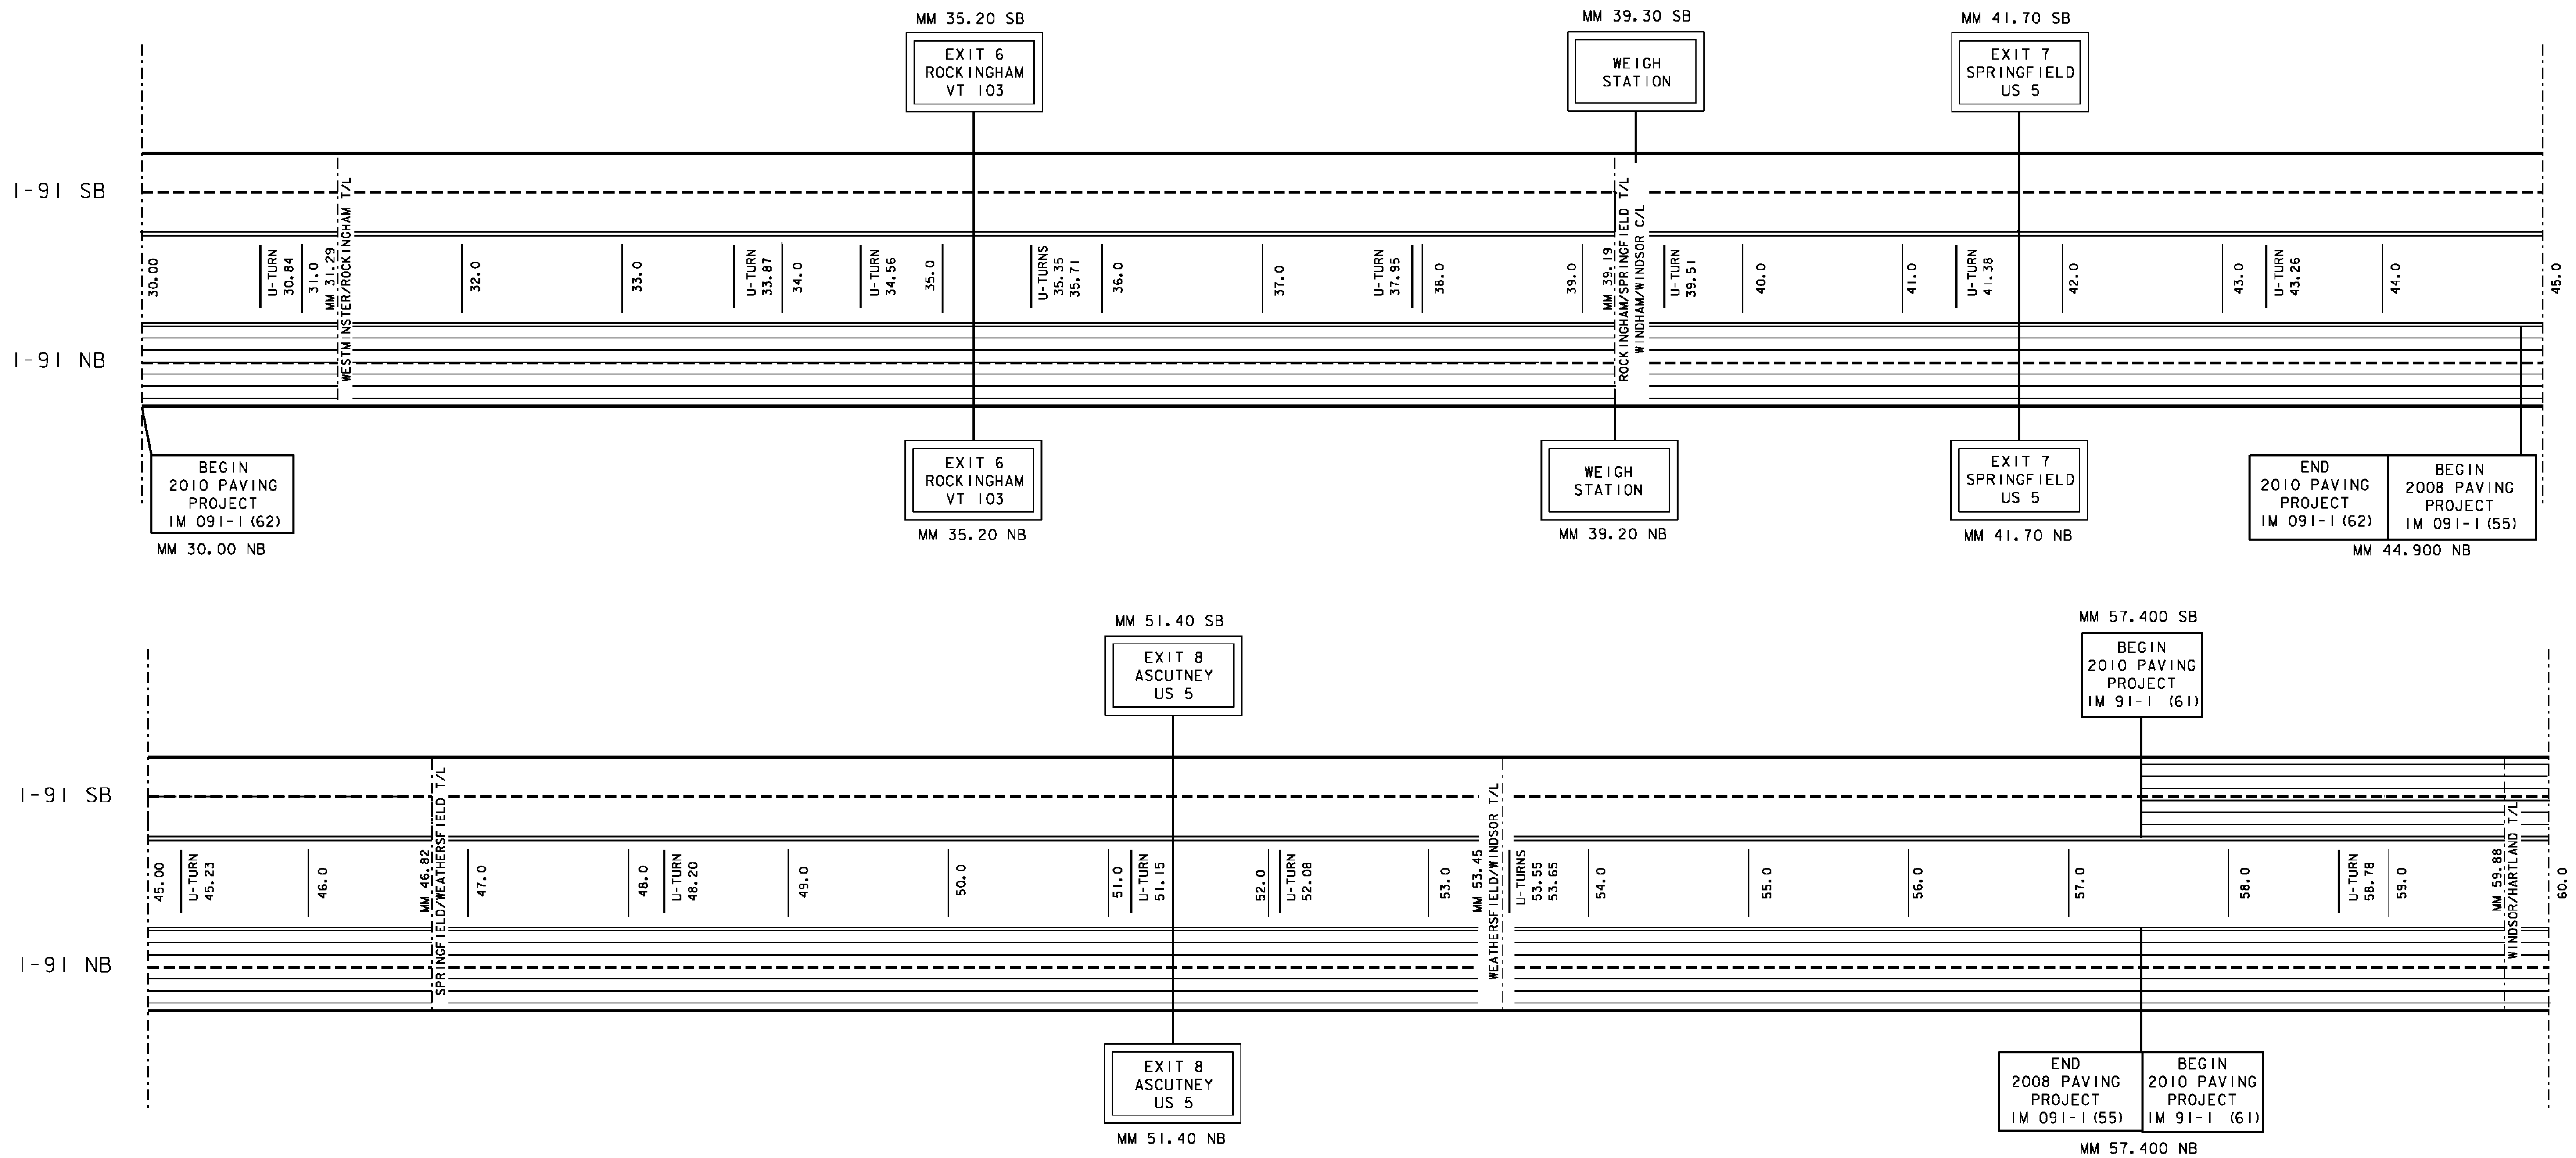


INTERSTATE 91 MAINLINE TREATMENT SCHEMATIC
 (REFERENCE COMPUTATION BINDER SECTION 646.XXX)

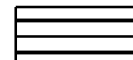

- LEGEND**
-  = AREA NOT TO BE PAINTED
 -  = AREA TO BE DONE AT NIGHT
 -  = 6'' SOLID WHITE LINE
 -  = 6'' DASHED WHITE LINE
 -  = 6'' SOLID YELLOW LINE

NOT TO SCALE

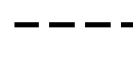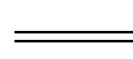I-91 MAINLINE TREATMENT SCHEMATIC SHEET 2	PROJECT NAME: STATEWIDE
	PROJECT NUMBER: IMG MARK (I12)
	FILE NAME: I1k274.dgn
	PLOT DATE: 25-JAN-2012
PROJECT LEADER: A GAMBLE	DRAWN BY: KAS
IPARM FLIE: 11k274ms7.i	SHEET 22 OF 29