




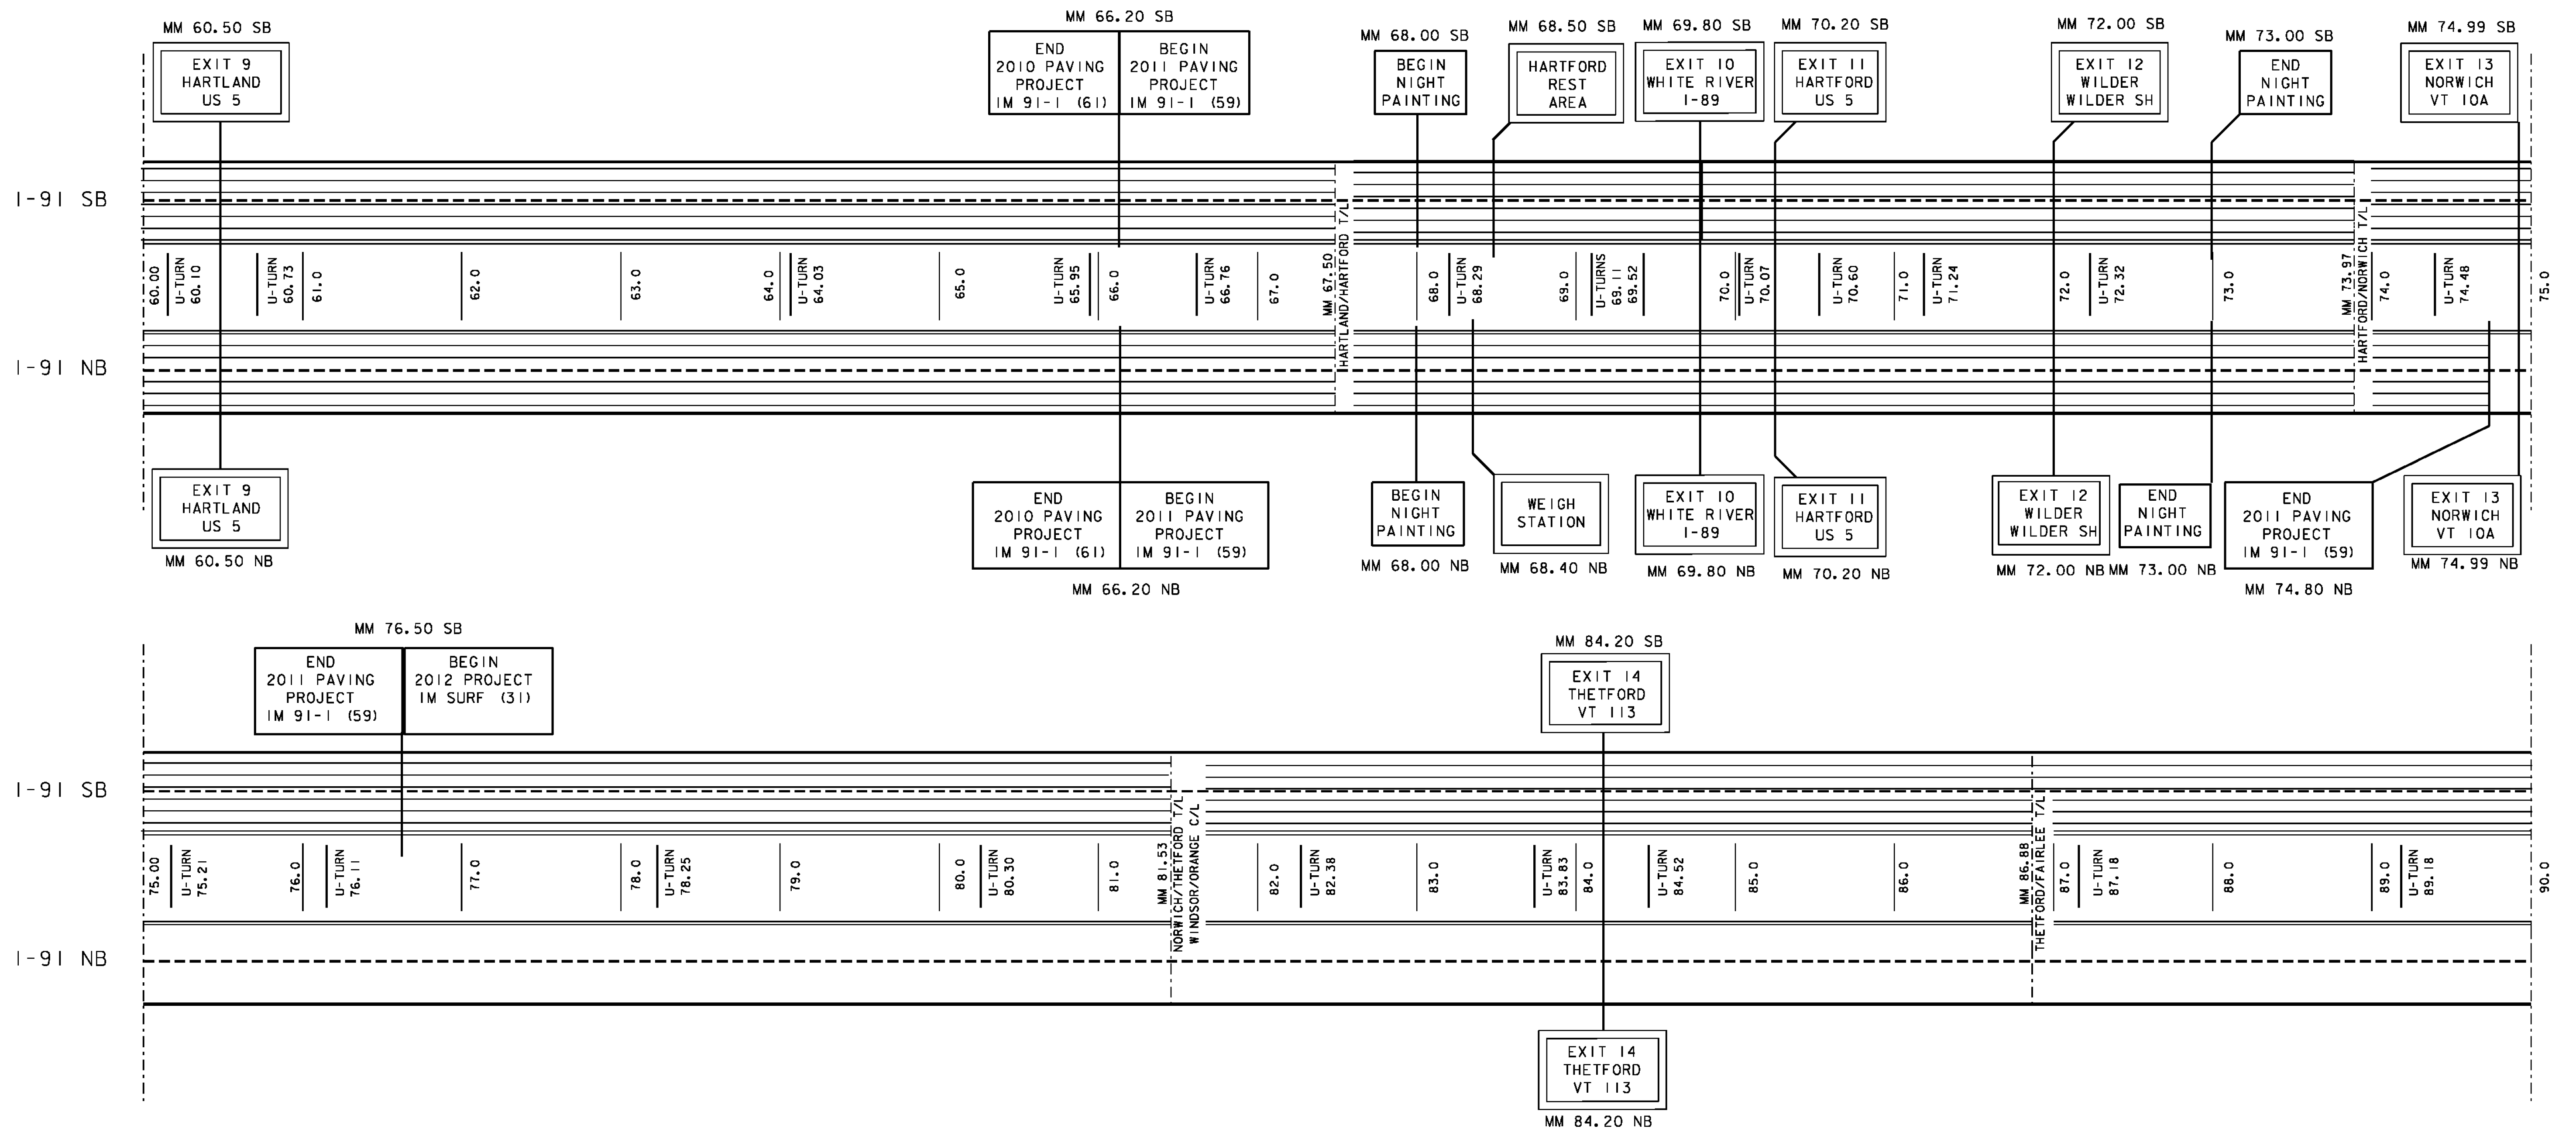 


INTERSTATE 91 MAINLINE TREATMENT SCHEMATIC

(REFERENCE COMPUTATION BINDER SECTION 646.XXX)

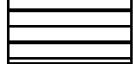

LEGEND

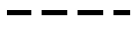-  = AREA NOT TO BE PAINTED
-  = AREA TO BE DONE AT NIGHT
-  = 6'' SOLID WHITE LINE
-  = 6'' DASHED WHITE LINE
-  = 6'' SOLID YELLOW LINE

NOT TO SCALE

**I-91 MAINLINE
TREATMENT SCHEMATIC
SHEET 3**

PROJECT NAME: STATEWIDE	PLOT DATE: 25-JAN-2012
PROJECT NUMBER: IMG MARK (112)	DRAWN BY: KAS
FILE NAME: 11k274.dgn	SHEET 23 OF 29
PROJECT LEADER: A GAMBLE	
IPARM FLIE: 11k274ms8.i	