


SUMMARY BY INTERCHANGE OF QUANTITIES & MATERIALS

(REFERENCE COMPUTATION BINDER SECTION 646.XXX FOR INSTALLED QUANTITIES)

TOWN	ROUTE	MM	EXIT	DIR	ROADWAY TYPE	6" WHITE LINE	MTL	6" YELLOW LINE	MTL	12" WHITE LINE	MTL	LETTER OR SYM.	MTL	STOP BAR	MTL	REM	4" WHITE LINE	CROSS WALK	REMARKS
HARTFORD	I-91	69.80	NN	NB	RAMP A	0	T*	0	T*	0	T*	0	T*	0	-	-	-	-	2011 PROJECT
RAMPS GO BETWEEN I-91 & I-89	I-91		10N	NB	RAMP B	0	T*	0	T*	0	T*	0	-	0	-	-	-	-	2011 PROJECT
	I-91		NN	NB	RAMP C	0	T*	0	T*	0	T*	0	-	0	-	-	-	-	2011 PROJECT
	I-91		10S	NB	RAMP D	0	T*	0	T*	0	T*	0	T*	0	-	-	-	-	2011 PROJECT
	I-91		NN	SB	RAMP E	0	T*	0	T*	0	T*	0	-	0	-	-	-	-	2011 PROJECT
	I-91		10S	SB	RAMP F	0	T*	0	T*	0	T*	0	-	0	-	-	-	-	2011 PROJECT
	I-91		NN	SB	RAMP G	0	T*	0	T*	0	T*	0	-	0	-	-	-	-	2011 PROJECT
	I-91		10N	SB	RAMP H	0	T*	0	T*	0	T*	0	-	0	-	-	-	-	2011 PROJECT
HARTFORD	I-91	70.20	11	NB	ON+OFF RAMPS	0	T*	0	T*	0	T*	0	T*	0	T*	-	-	-	2011 PROJECT
			11	SB	ON+OFF RAMPS	0	T*	0	T*	0	T*	0	T*	0	T*	-	-	-	2011 PROJECT
WILDER	I-91	72.00	12	NB	ON+OFF RAMPS	0	T*	0	T*	0	T*	0	T*	0	T*	-	-	-	2011 PROJECT
			12	SB	ON+OFF RAMPS	0	T*	0	T*	0	T*	0	T*	0	T*	-	-	-	2011 PROJECT
END NIGHT APPLICATIONS																			END NIGHT APPLICATIONS
SHEET TOTALS						0		0		0		0		0					

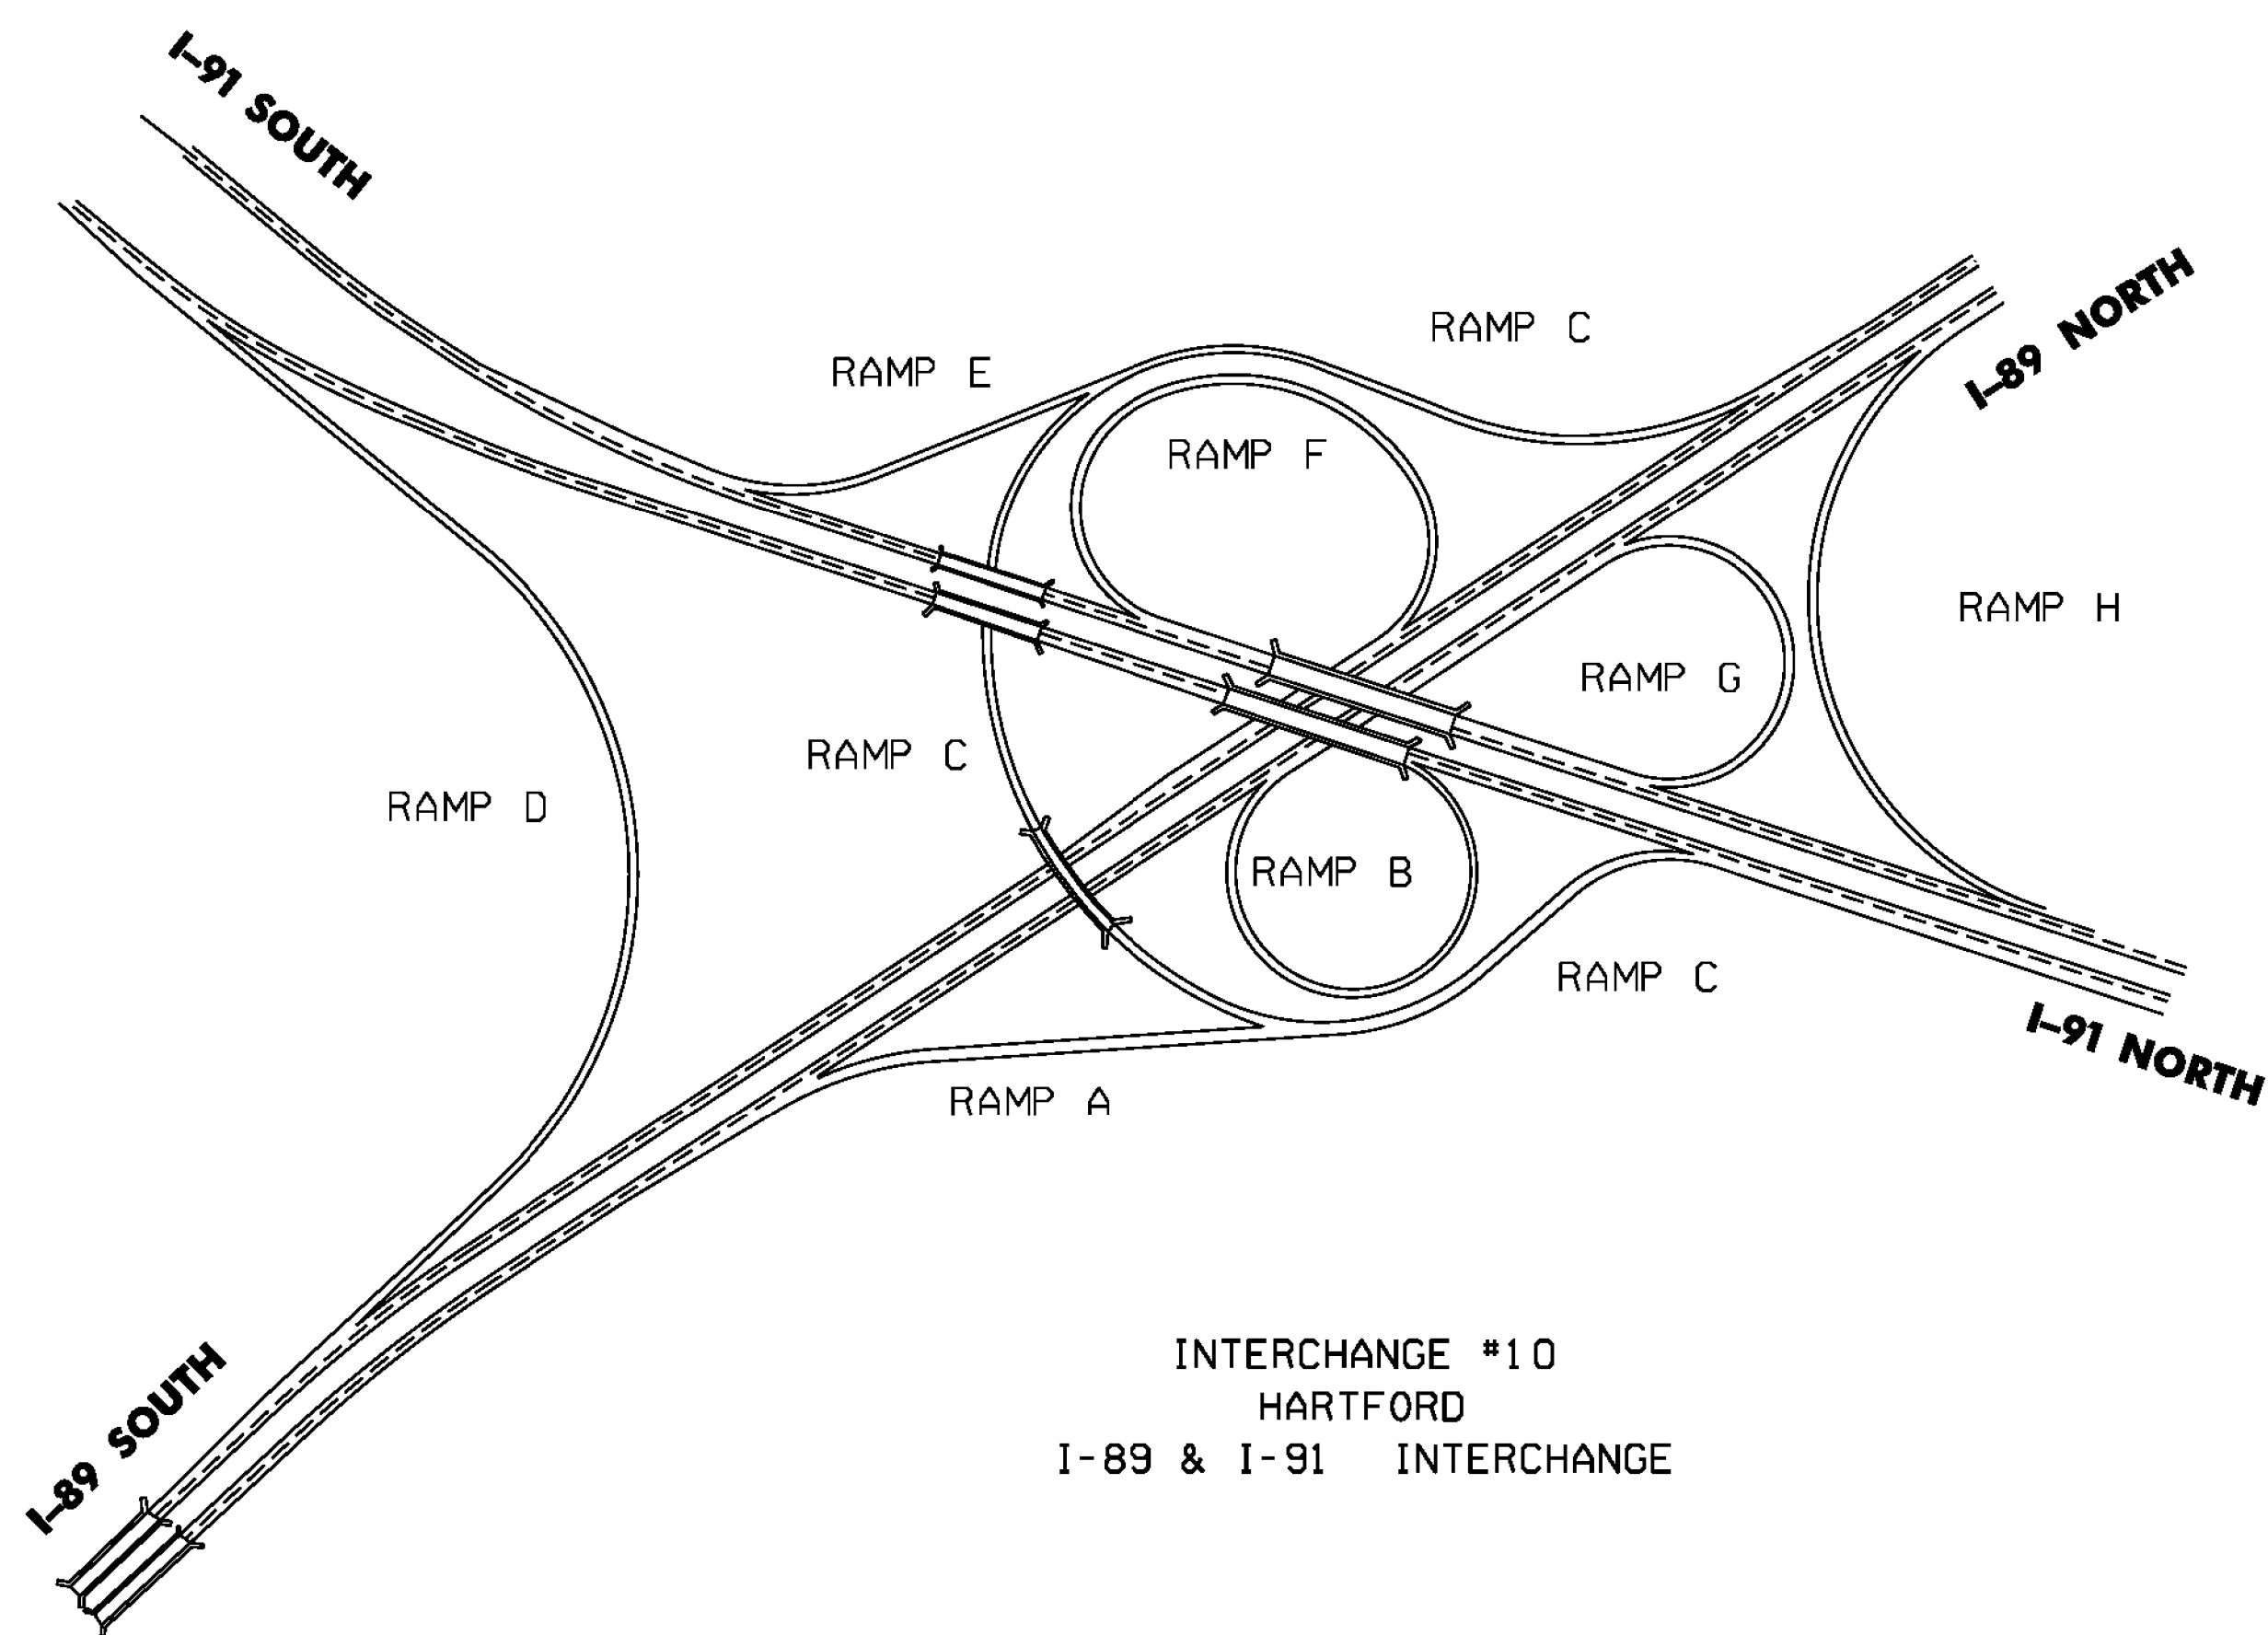

LEGEND

P= TO BE PAINTED
TP= TO BE PAINTED OVER OLD DURABLE
T*= DURABLE--NOT TO BE MARKED
TE= DURABLE EXPERIMENTAL NOT TO BE MARKED

NOT TO SCALE

INTERCHANGE QUANTITIES AND MATERIALS SHEET 4

PROJECT NAME: STATEWIDE
PROJECT NUMBER: IMG MARK (I12)
FILE NAME: I1k274.dgn
PROJECT LEADER: A GAMBLE
IPARM FLIE: 11k274iq4.i
PLOT DATE: 25-JAN-2012
DRAWN BY: KAS
SHEET 12 OF 29