


INTERSTATE 89 MAINLINE TREATMENT SCHEMATIC

(REFERENCE COMPUTATION BINDER SECTION 646.XXX)

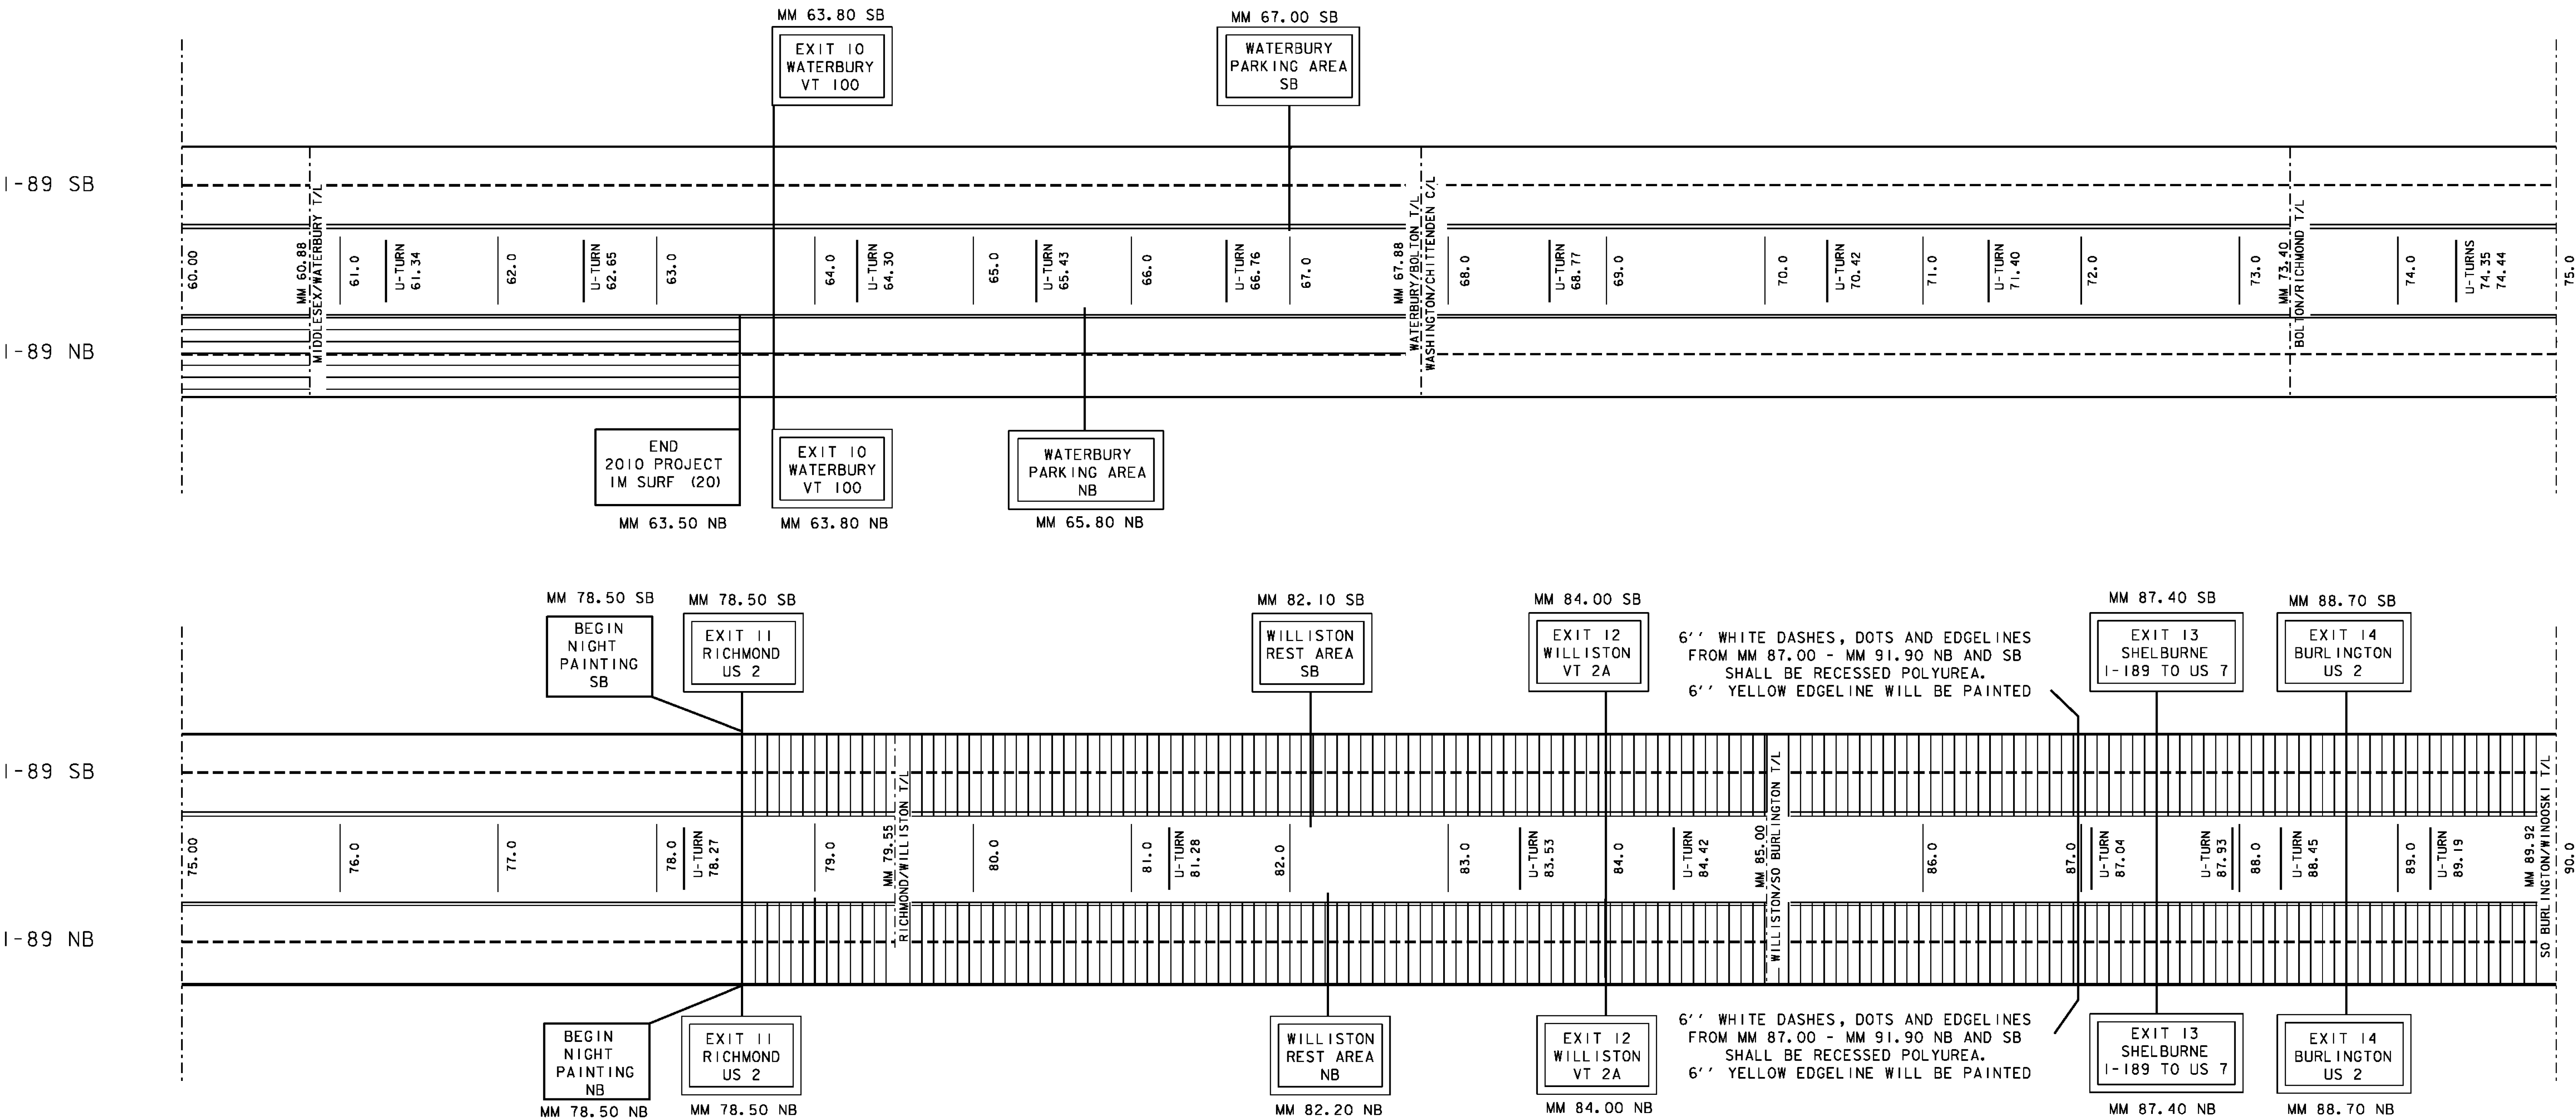

- LEGEND
- = AREA NOT TO BE PAINTED
 - = AREA TO BE DONE AT NIGHT
 - = 6'' SOLID WHITE LINE
 - = 6'' DASHED WHITE LINE
 - = 6'' SOLID YELLOW LINE

NOT TO SCALE

I-89 MAINLINE TREATMENT SCHEMATIC SHEET 3	PROJECT NAME: STATEWIDE	
	PROJECT NUMBER: IMG MARK (II2)	
	FILE NAME: Iik274.dgn	PLOT DATE: 25-JAN-2012
	PROJECT LEADER: A GAMBLE	DRAWN BY: KAS
IPARM FLIE: 11k274ms3.i		SHEET 17 OF 29