


INTERSTATE 89 MAINLINE TREATMENT SCHEMATIC

(REFERENCE COMPUTATION BINDER SECTION 646.XXX)

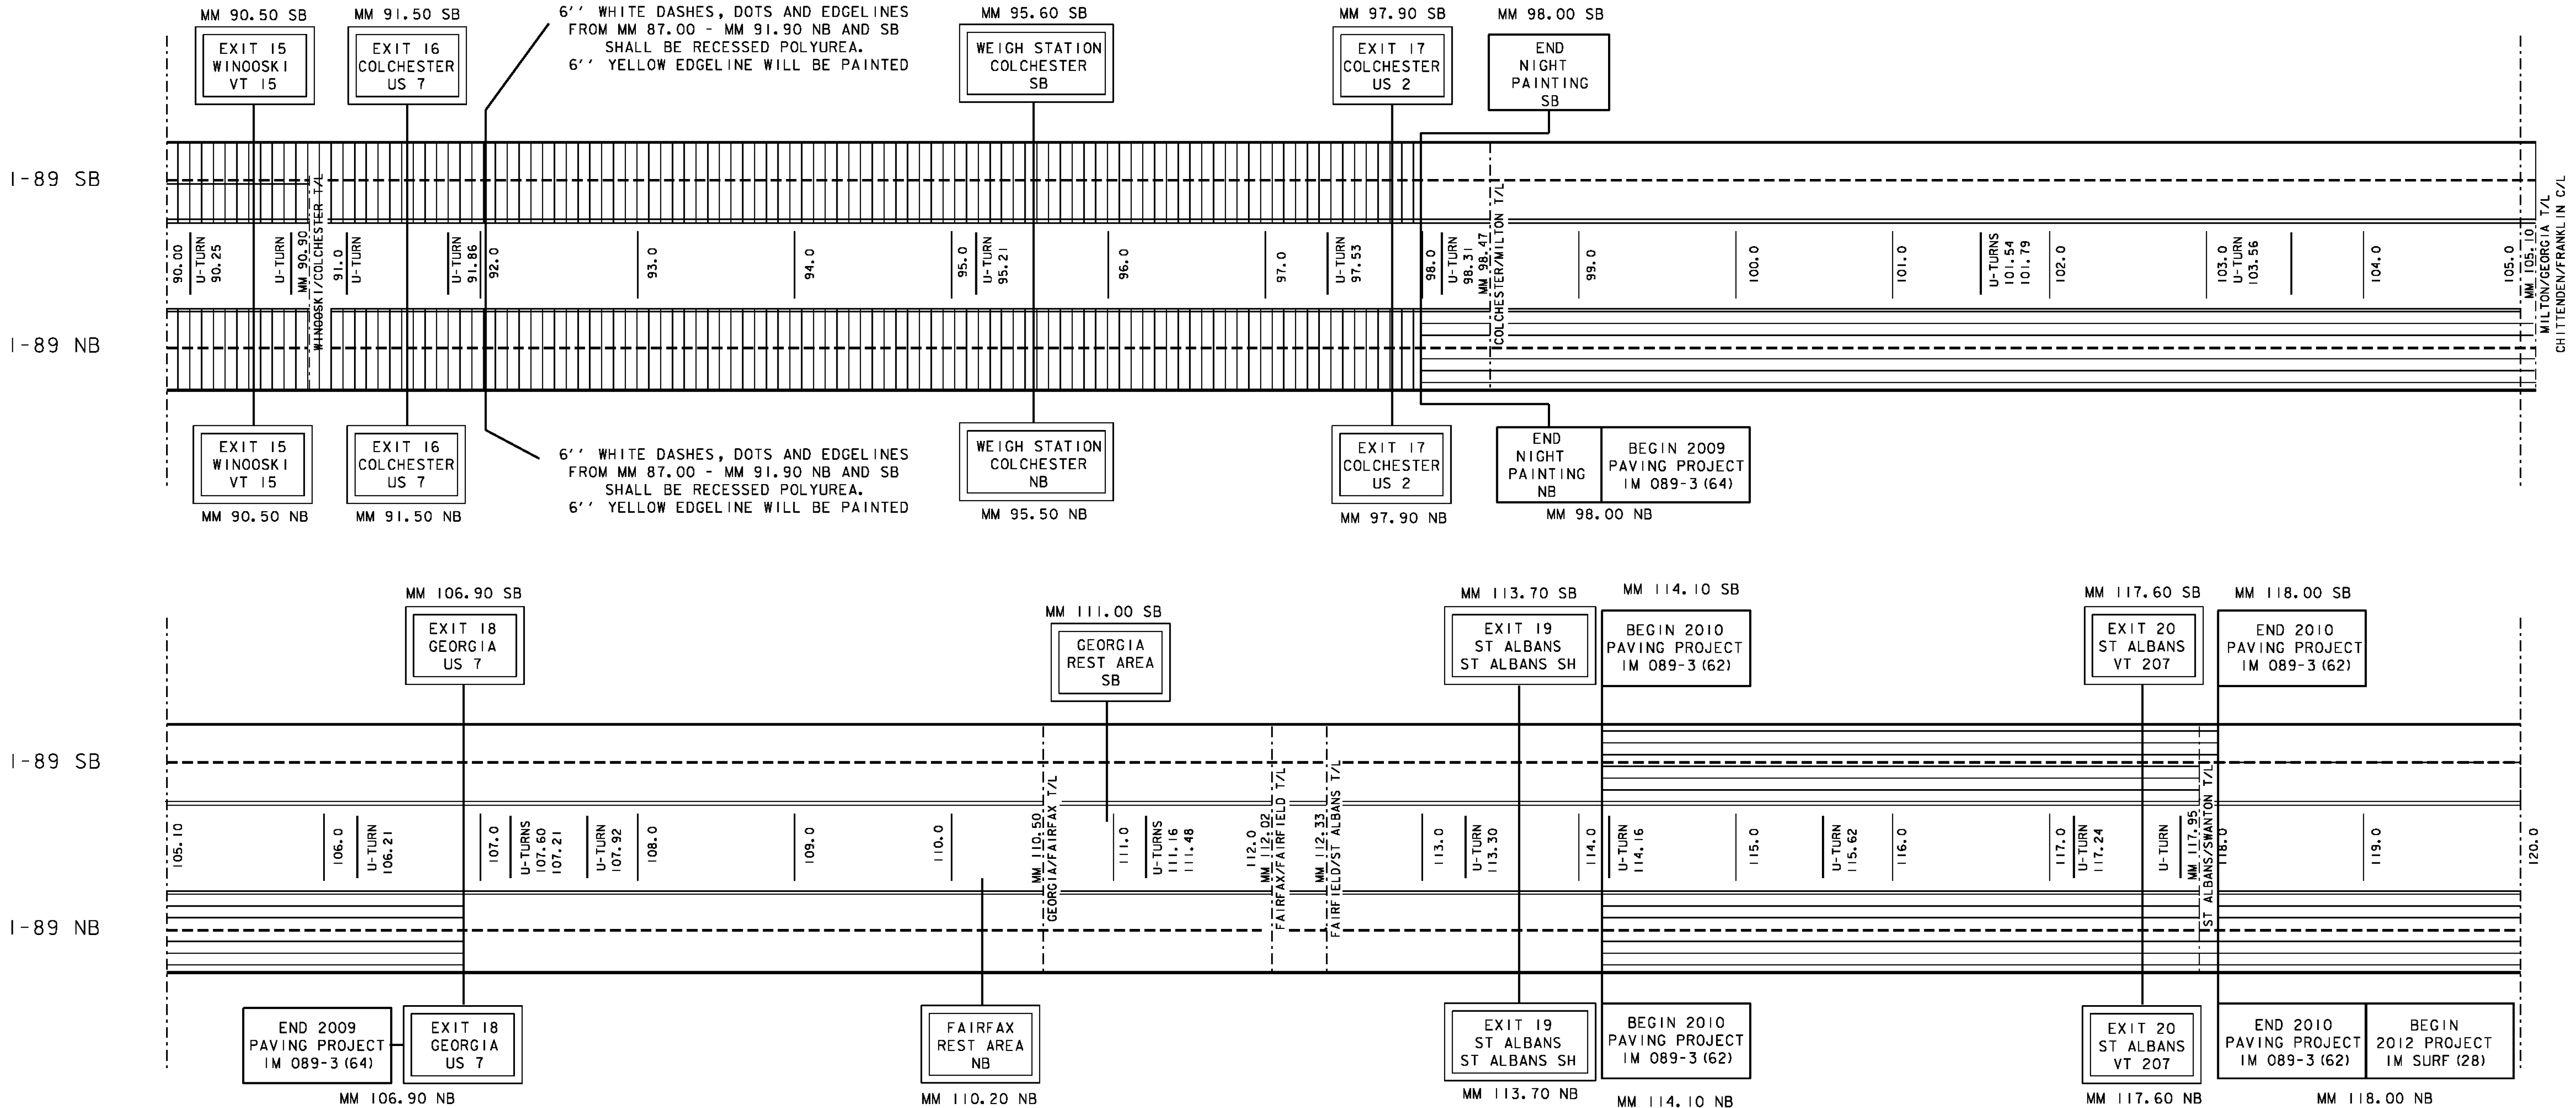

LEGEND

- = AREA NOT TO BE PAINTED
- = AREA TO BE DONE AT NIGHT
- = 6' SOLID WHITE LINE
- = 6' DASHED WHITE LINE
- = 6' SOLID YELLOW LINE

NOT TO SCALE

I-89 MAINLINE
TREATMENT SCHEMATIC
SHEET 4

PROJECT NAME:	STATEWIDE
PROJECT NUMBER:	IMG MARK (112)
FILE NAME:	11k274.dgn
PROJECT LEADER:	A GAMBLE
IPARM FLIE:	11k274ms4.i
PLOT DATE:	25-JAN-2012
DRAWN BY:	KAS
SHEET	18 OF 29