


INTERSTATE 91 MAINLINE TREATMENT SCHEMATIC
 (REFERENCE COMPUTATION BINDER SECTION 646.XXX)

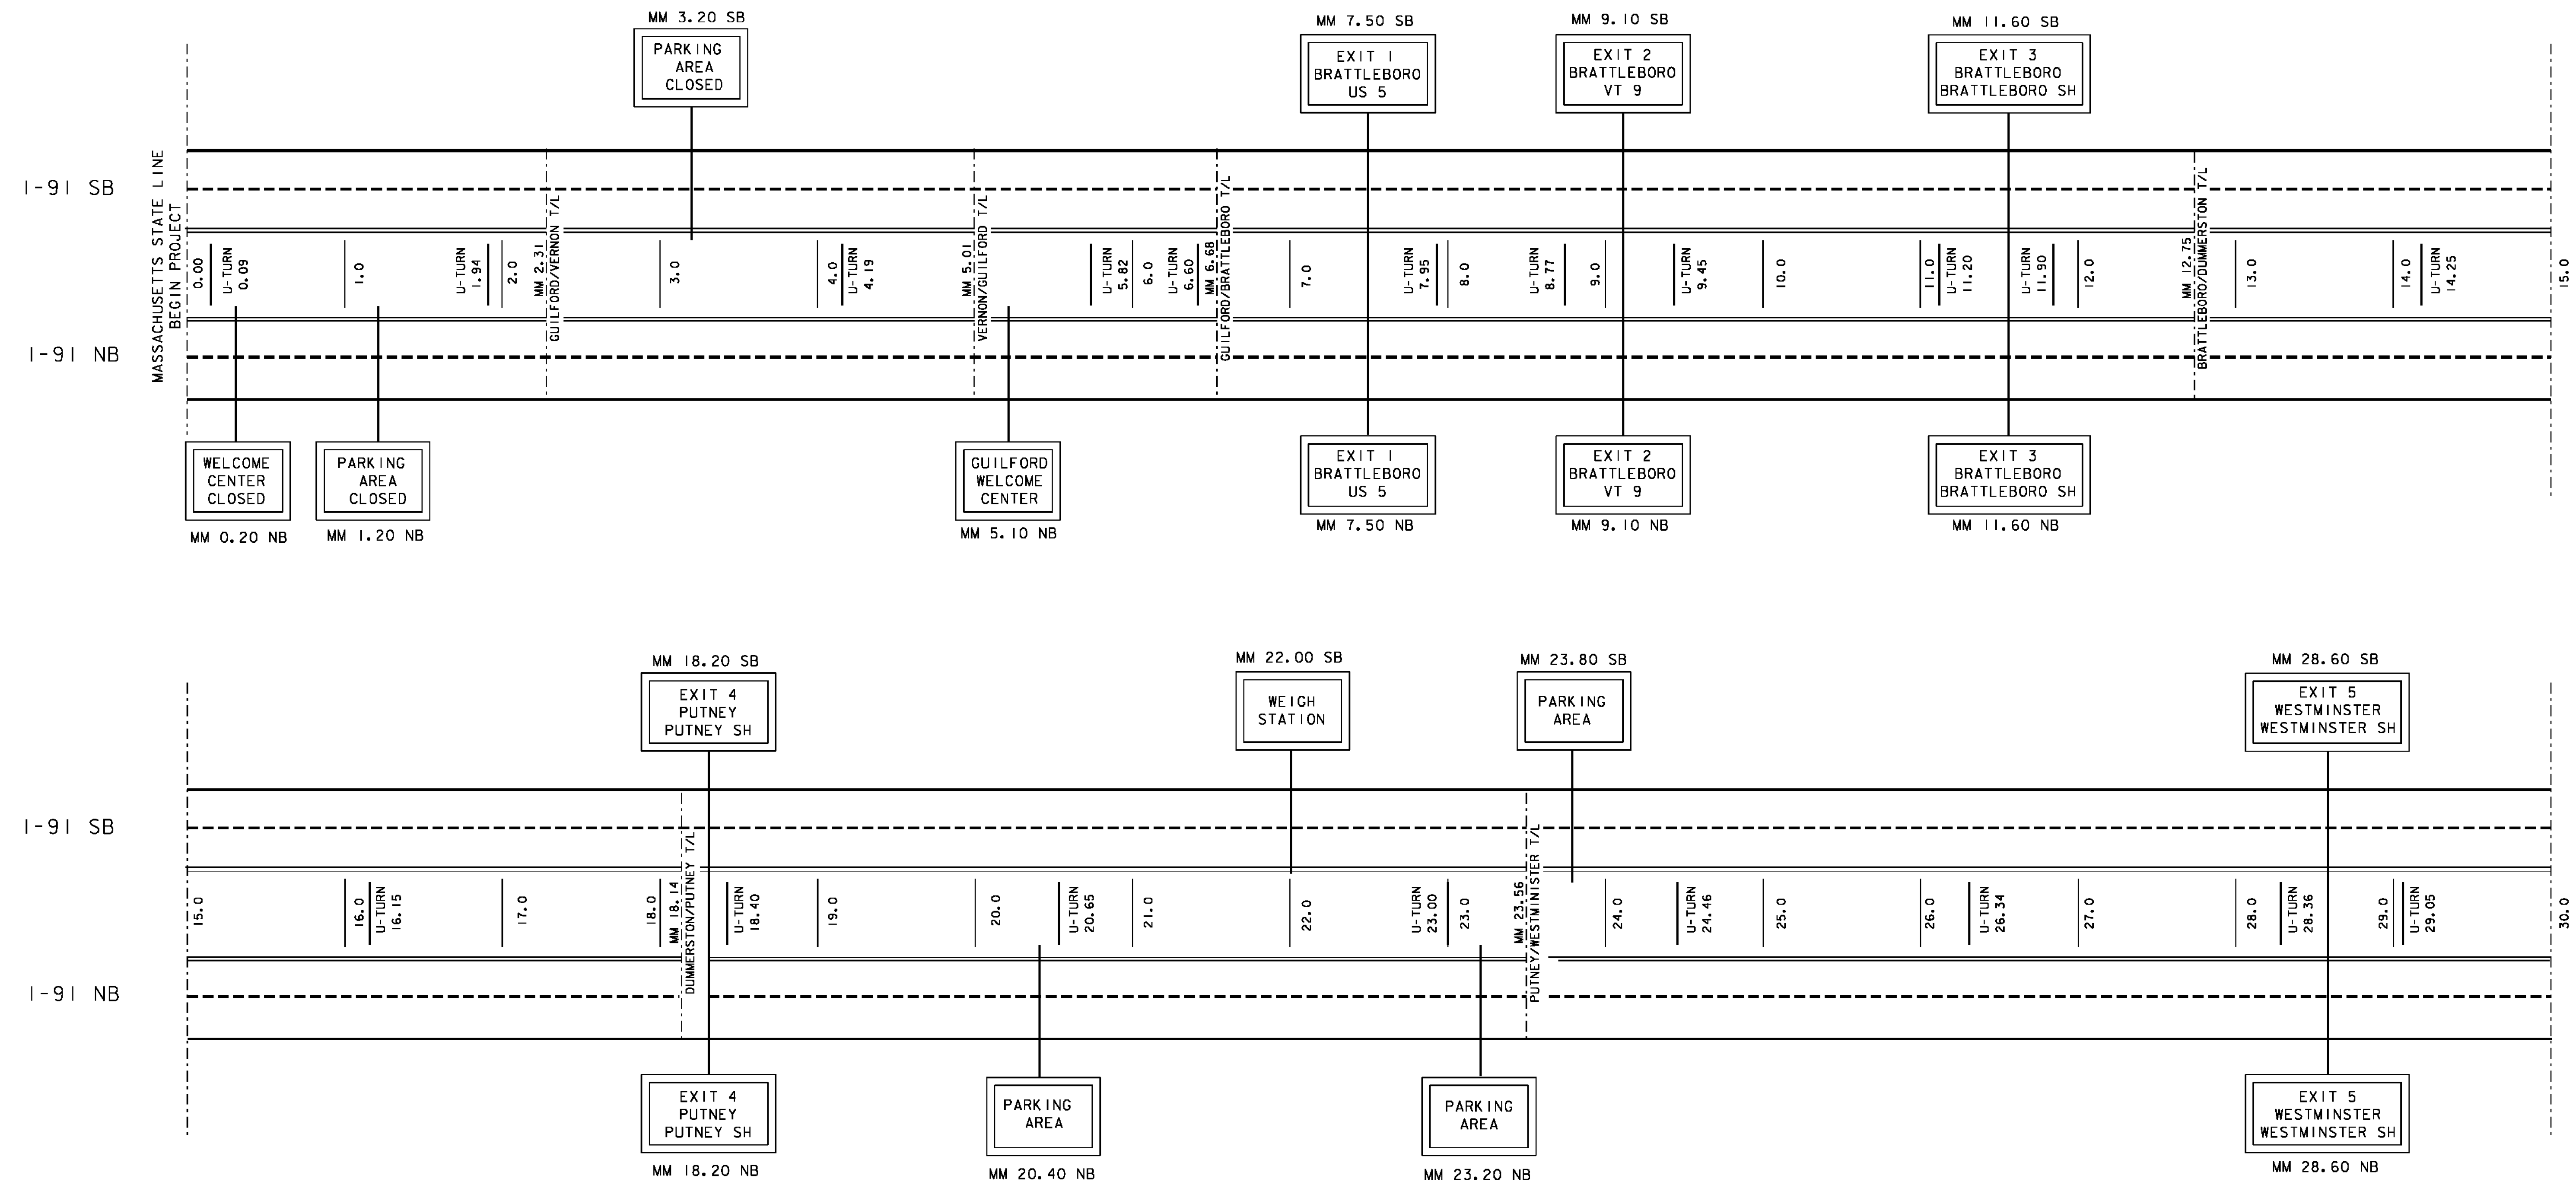

- LEGEND**
- = AREA NOT TO BE PAINTED
 - = AREA TO BE DONE AT NIGHT
 - = 6'' SOLID WHITE LINE
 - = 6'' DASHED WHITE LINE
 - = 6'' SOLID YELLOW LINE

NOT TO SCALE

I-91 MAINLINE TREATMENT SCHEMATIC SHEET 1	PROJECT NAME: STATEWIDE
	PROJECT NUMBER: IMG MARK (I12)
	FILE NAME: I1k274.dgn
PROJECT LEADER: A GAMBLE	PLOT DATE: 25-JAN-2012
IPARM FLIE: 11k274ms6.i	DRAWN BY: KAS
	SHEET 21 OF 29