


INTERSTATE 91 MAINLINE TREATMENT SCHEMATIC

(REFERENCE COMPUTATION BINDER SECTION 646.XXX)

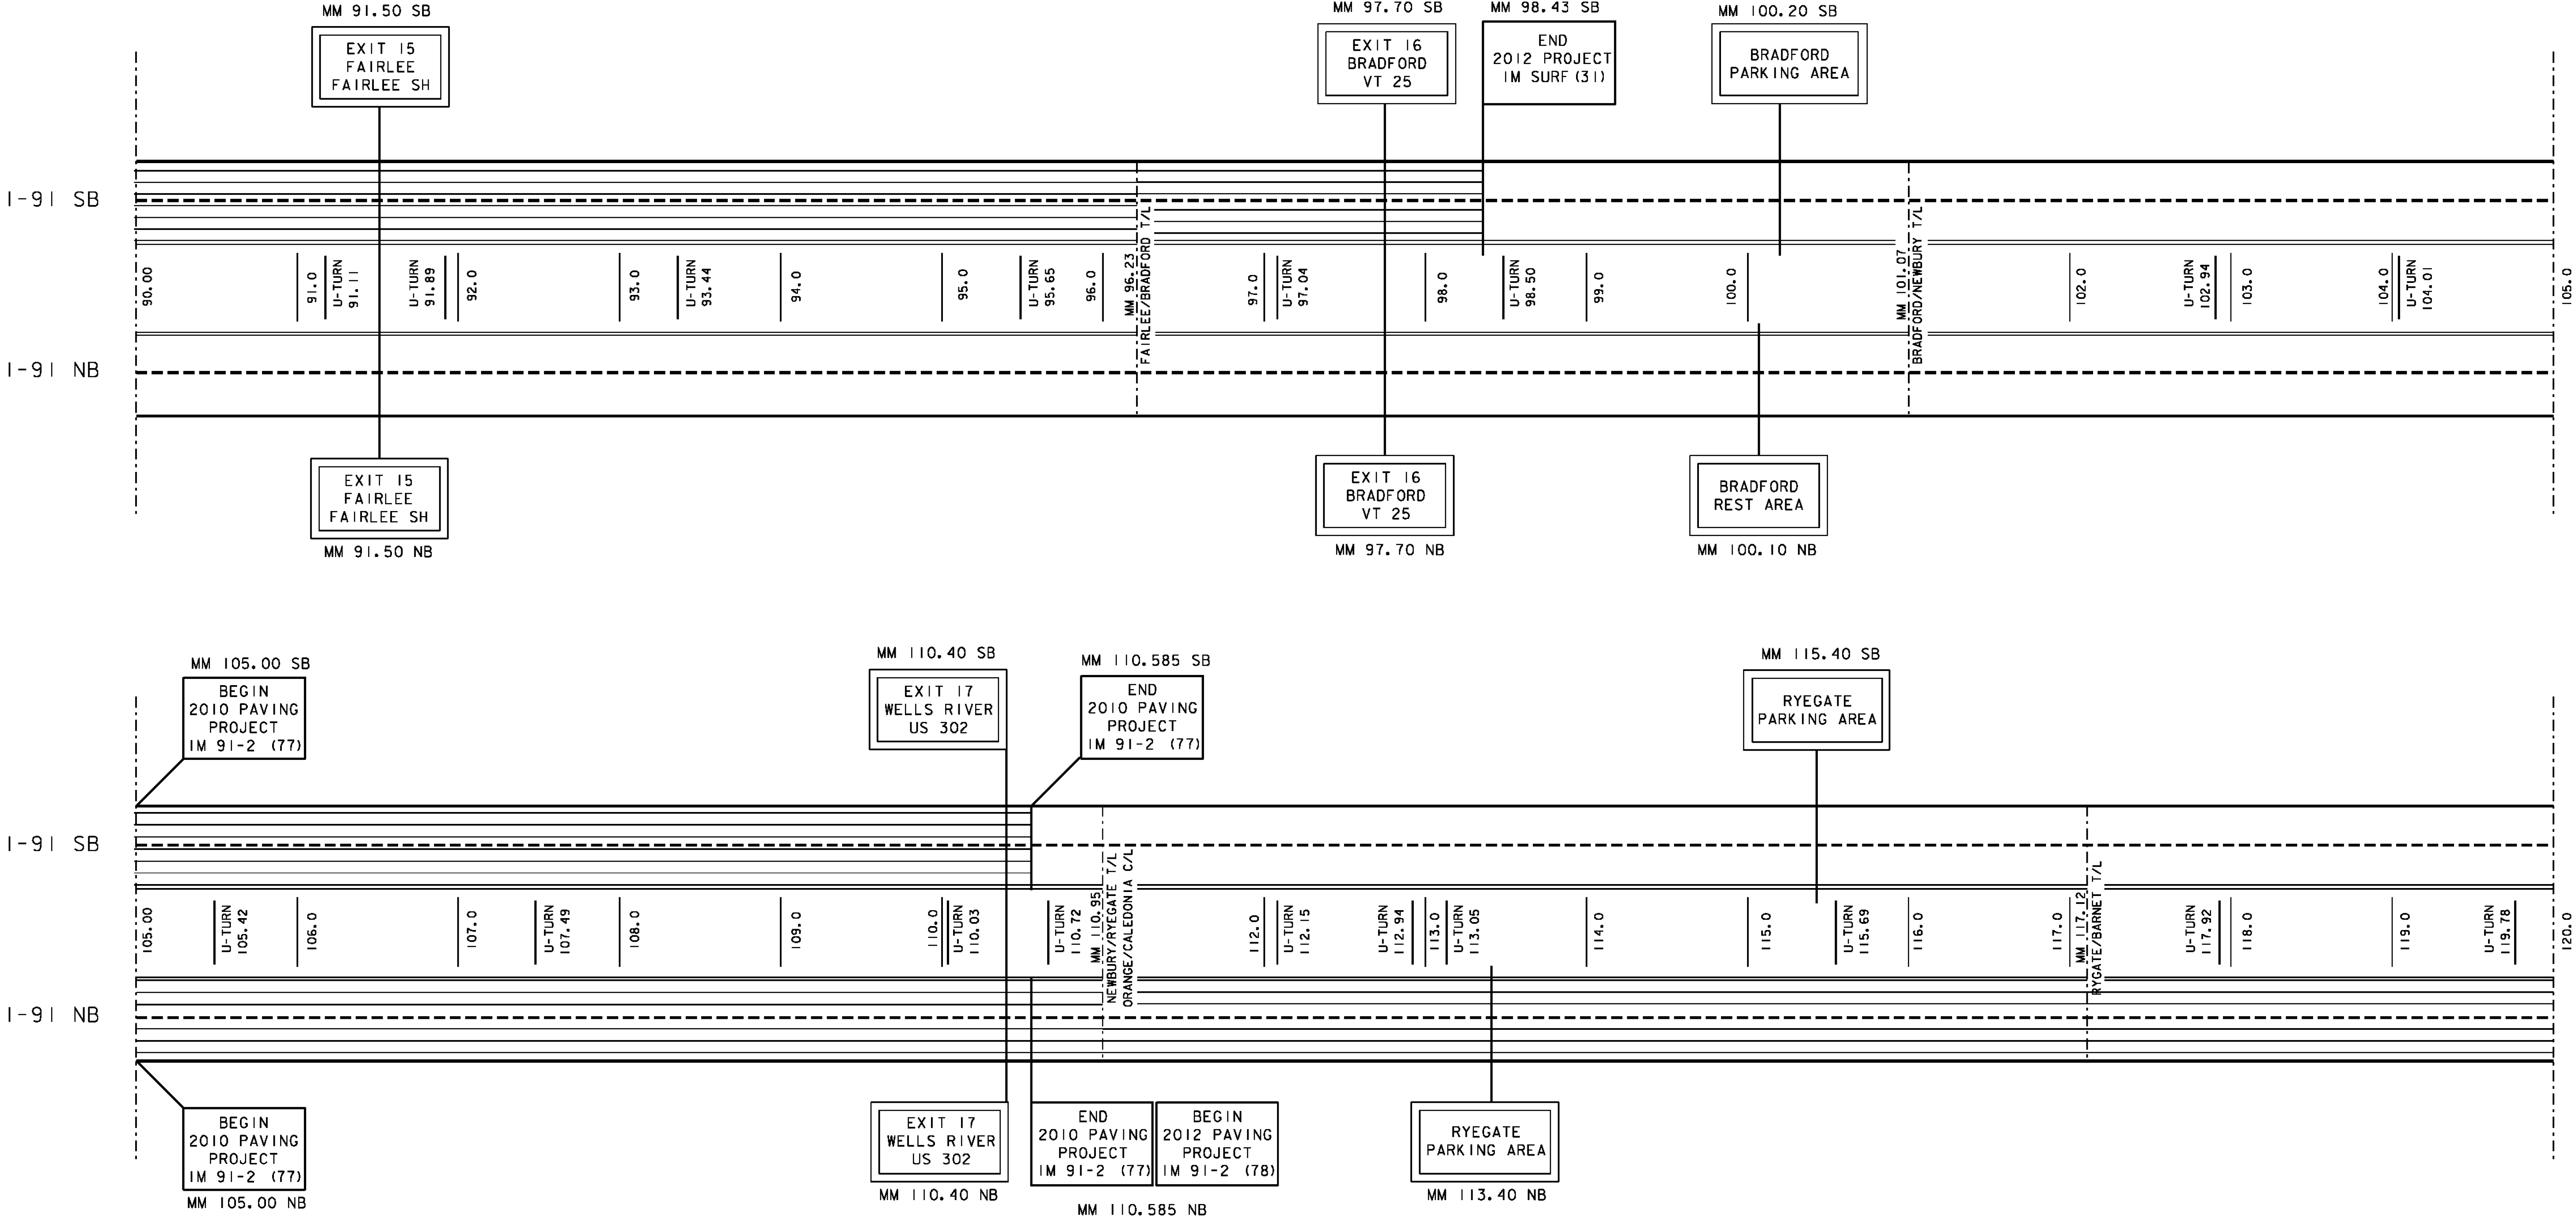

- LEGEND
- [Hatched Box] = AREA NOT TO BE PAINTED
 - [Vertical Lines Box] = AREA TO BE DONE AT NIGHT
 - [Solid Line] = 6'' SOLID WHITE LINE
 - [Dashed Line] = 6'' DASHED WHITE LINE
 - [Double Solid Line] = 6'' SOLID YELLOW LINE

NOT TO SCALE

I-91 MAINLINE TREATMENT SCHEMATIC SHEET 4	PROJECT NAME: STATEWIDE	
	PROJECT NUMBER: IMG MARK (I12)	
	FILE NAME: I1k274.dgn	PLOT DATE: 25-JAN-2012
	PROJECT LEADER: A GAMBLE	DRAWN BY: KAS
IPARM FLIE: 11k274ms9.i		SHEET 24 OF 29