


STATE OF VERMONT AGENCY OF TRANSPORTATION

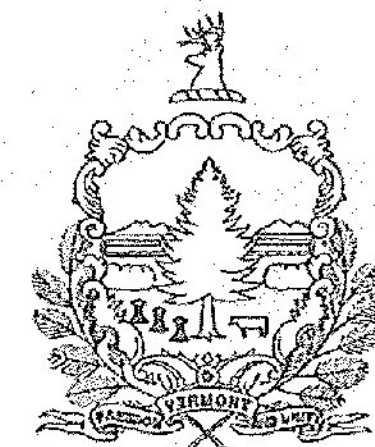

PROPOSED IMPROVEMENT BRIDGE PROJECT



TOWN OF HARTFORD
COUNTY OF WINDSOR

ROUTE NO : INTERSTATE 91 BRIDGE NO : 43 N/S

PROJECT LOCATION: I-91 EXIT 11


PROJECT DESCRIPTION: DEMOLITION OF EXISTING BRIDGES AND REPLACEMENT WITH NEW SINGLE SPAN BRIDGES.

	NORTH BOUND	SOUTH BOUND
LENGTH OF STRUCTURE:	136.16 FEET	136.16 FEET
LENGTH OF ROADWAY:	88.84 FEET	88.84 FEET
LENGTH OF PROJECT:	225.00 FEET	225.00 FEET

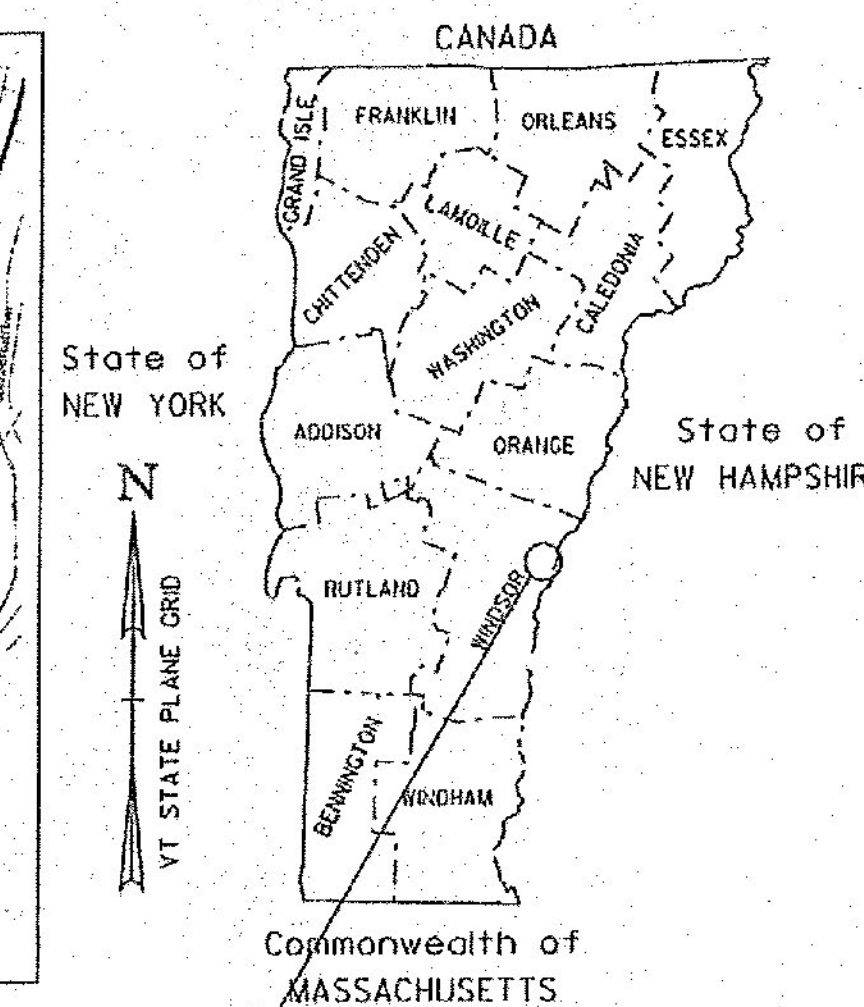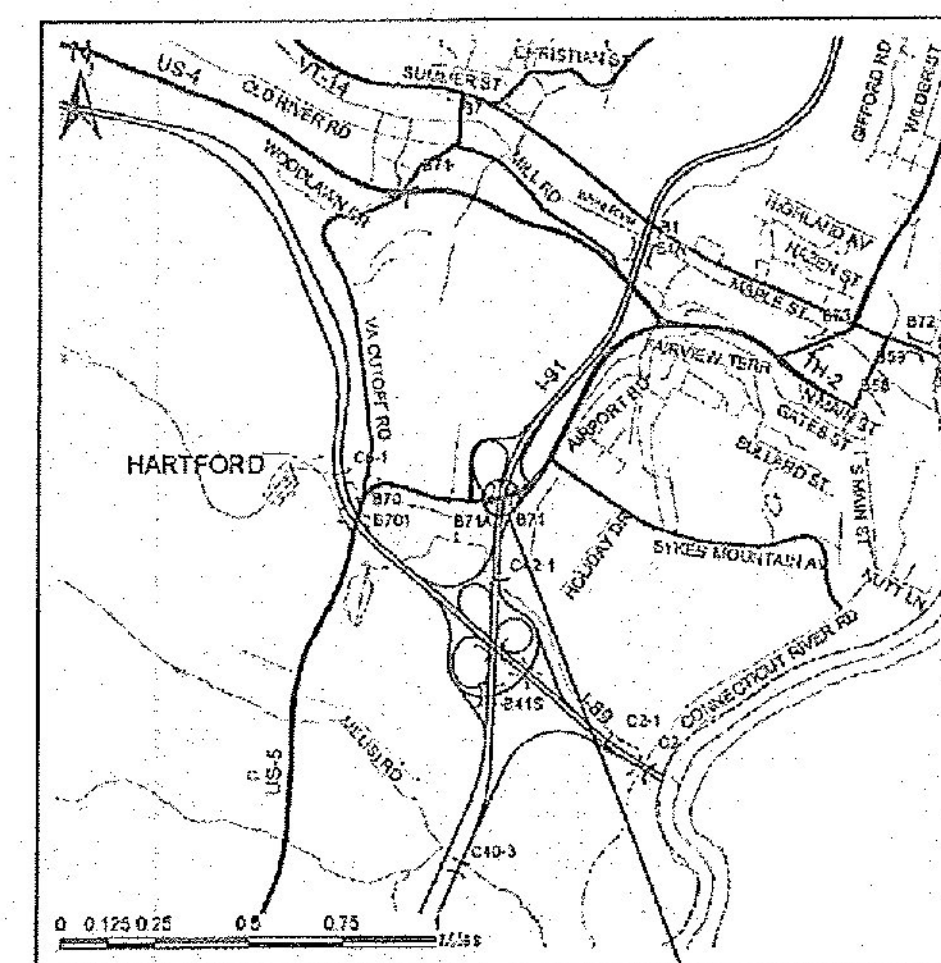


HARTFORD
1M 091-2 (79)

RECORD PLANS	
CONTRACTOR:	PCL CIVIL CONSTRUCTORS, INC. - TAMPA, FL
RESIDENT ENGINEER:	CHRIS BARKER
CONSTRUCTION BEGAN:	MARCH 6, 2015
CONSTRUCTION COMPLETE:	OCTOBER 30, 2015
RECORD PLANS BY:	CHRIS BARKER & JESSE IVES
I HEREBY CERTIFY THAT ALL THE CONSTRUCTION REQUIRED BY THIS SET OF DRAWINGS HAS BEEN ACCOMPLISHED AS INDICATED HEREIN.	
BY:	<i>[Signature]</i> RESIDENT ENGINEER
DATE:	02/24/17
NOTE: Any further information concerning final quantities, amounts or other details relative to this project may be found at Central Files in the electronic archives.	

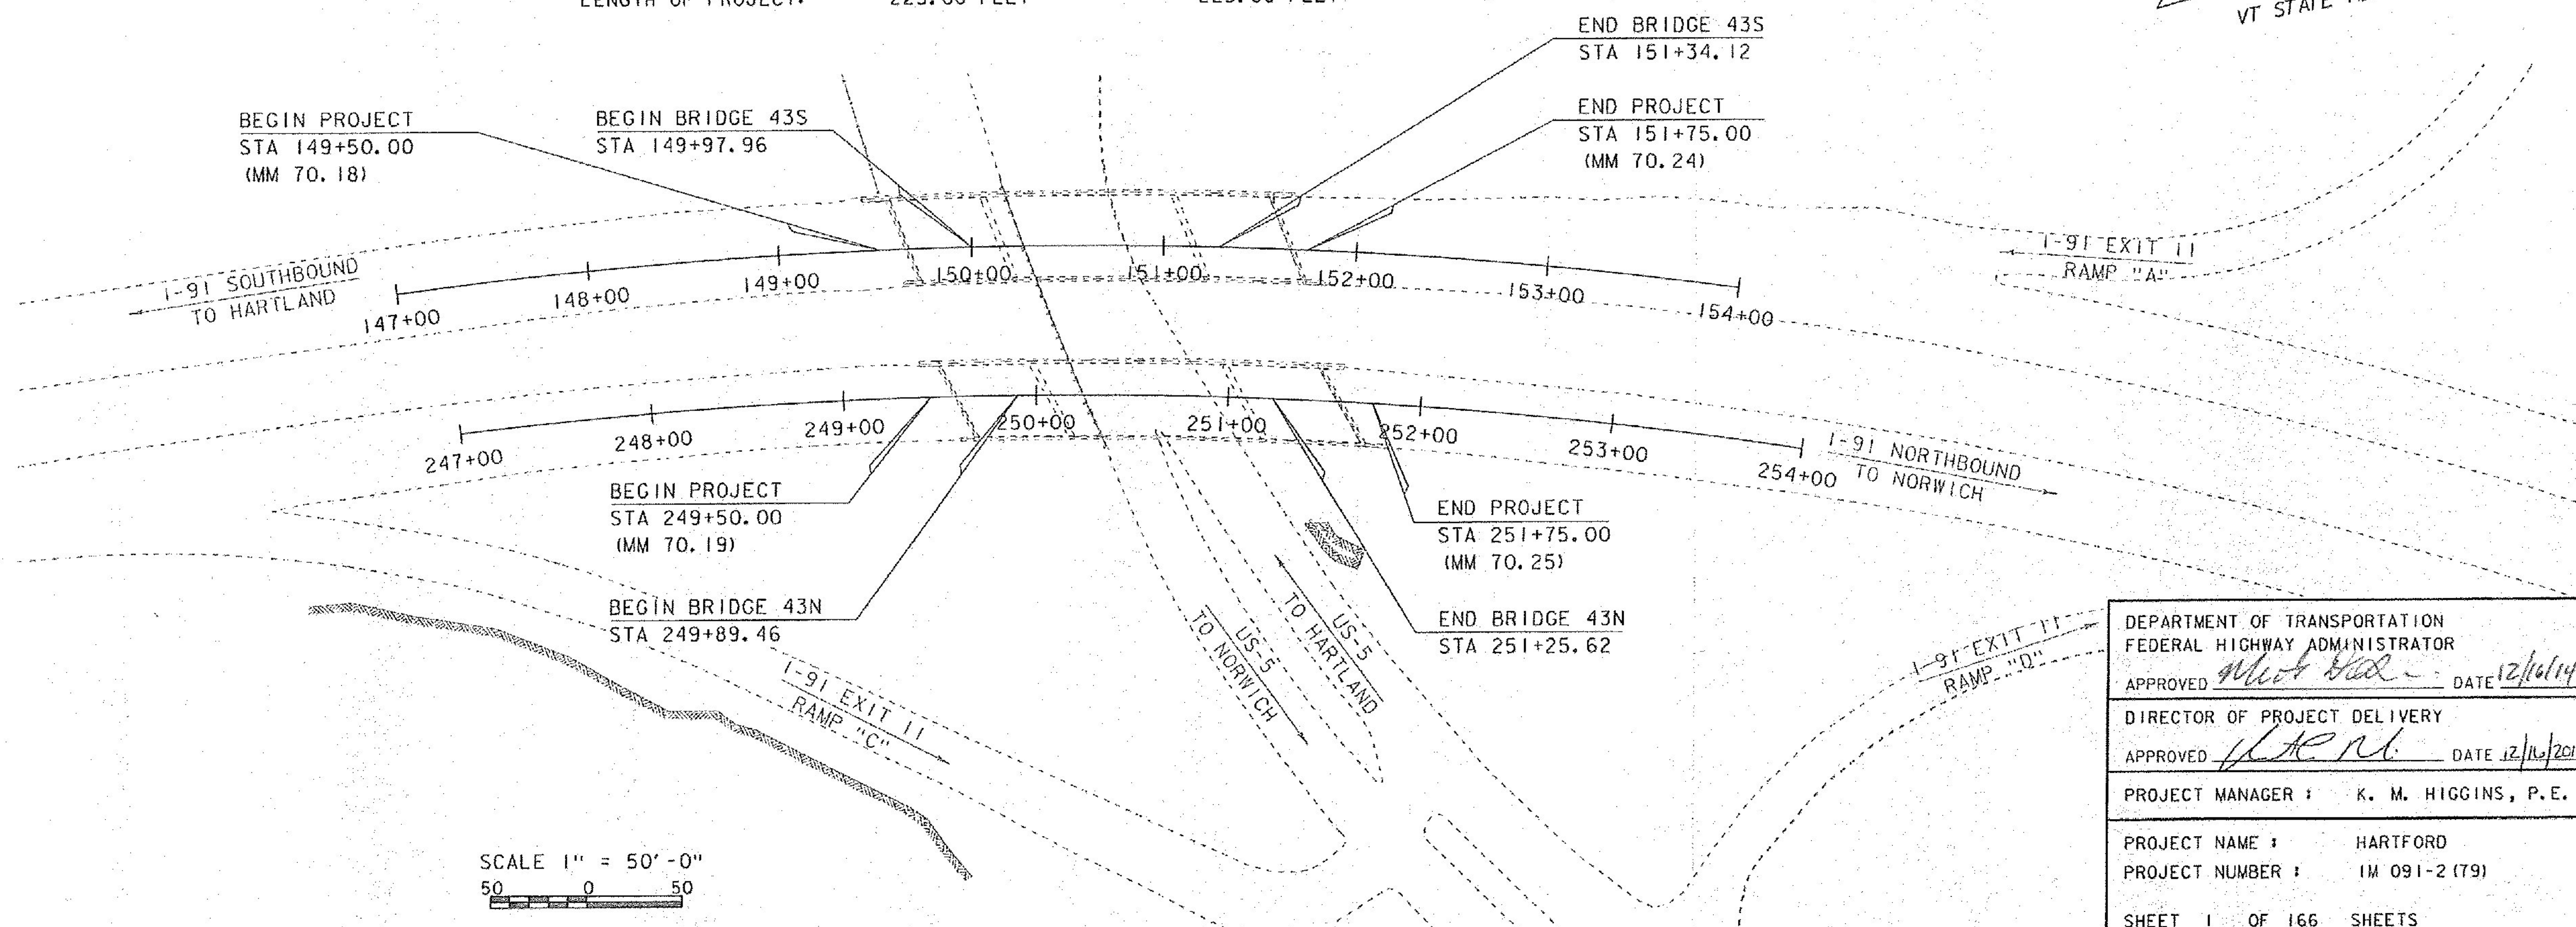

CONSTRUCTION IS TO BE CARRIED ON IN ACCORDANCE WITH THESE PLANS AND THE STANDARD SPECIFICATIONS FOR CONSTRUCTION DATED 2011, AS APPROVED BY THE FEDERAL HIGHWAY ADMINISTRATION ON JULY 20, 2011 FOR USE ON THIS PROJECT, INCLUDING ALL SUBSEQUENT REVISIONS AND SUCH REVISED SPECIFICATIONS AND SPECIAL PROVISIONS AS ARE INCORPORATED IN THESE PLANS.

QUALITY ASSURANCE PROGRAM : LEVEL 1	
SURVEYED BY :	R. GILMAN
SURVEYED DATE :	02/11/2013
DATUM	
VERTICAL	NAVD88
HORIZONTAL	NAD83 (2011)

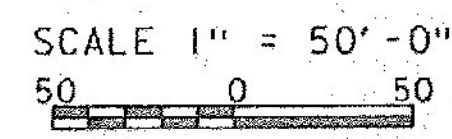

DEPARTMENT OF TRANSPORTATION FEDERAL HIGHWAY ADMINISTRATOR	
APPROVED <i>[Signature]</i>	DATE 12/10/14
DIRECTOR OF PROJECT DELIVERY	
APPROVED <i>[Signature]</i>	DATE 12/10/2014
PROJECT MANAGER : K. M. HIGGINS, P.E.	
PROJECT NAME : HARTFORD	
PROJECT NUMBER : 1M 091-2 (79)	
SHEET 1 OF 166 SHEETS	