

CURVE I-91 SOUTH	CURVE I-91 NORTH
DELTA = 39° 10' 51"	DELTA = 39° 14' 03"
D = 2° 12' 13"	D = 2° 13' 30"
R = 2600.00'	R = 2575.00'
T = 925.33'	T = 917.78'
L = 1777.98'	L = 1763.27'
E = 159.75'	E = 158.67'
e (max) = 0.06	e (max) = 0.06

PI #1 I-91 SB
STA 155+85.89


PI #1 I-91 NB
STA 255+42.33

MATCHLINE 253+25.00

I-91 SOUTHBOUND
TO HARTLAND

I-91 EXIT II
SB ON RAMP "A"

HVCTRL
10

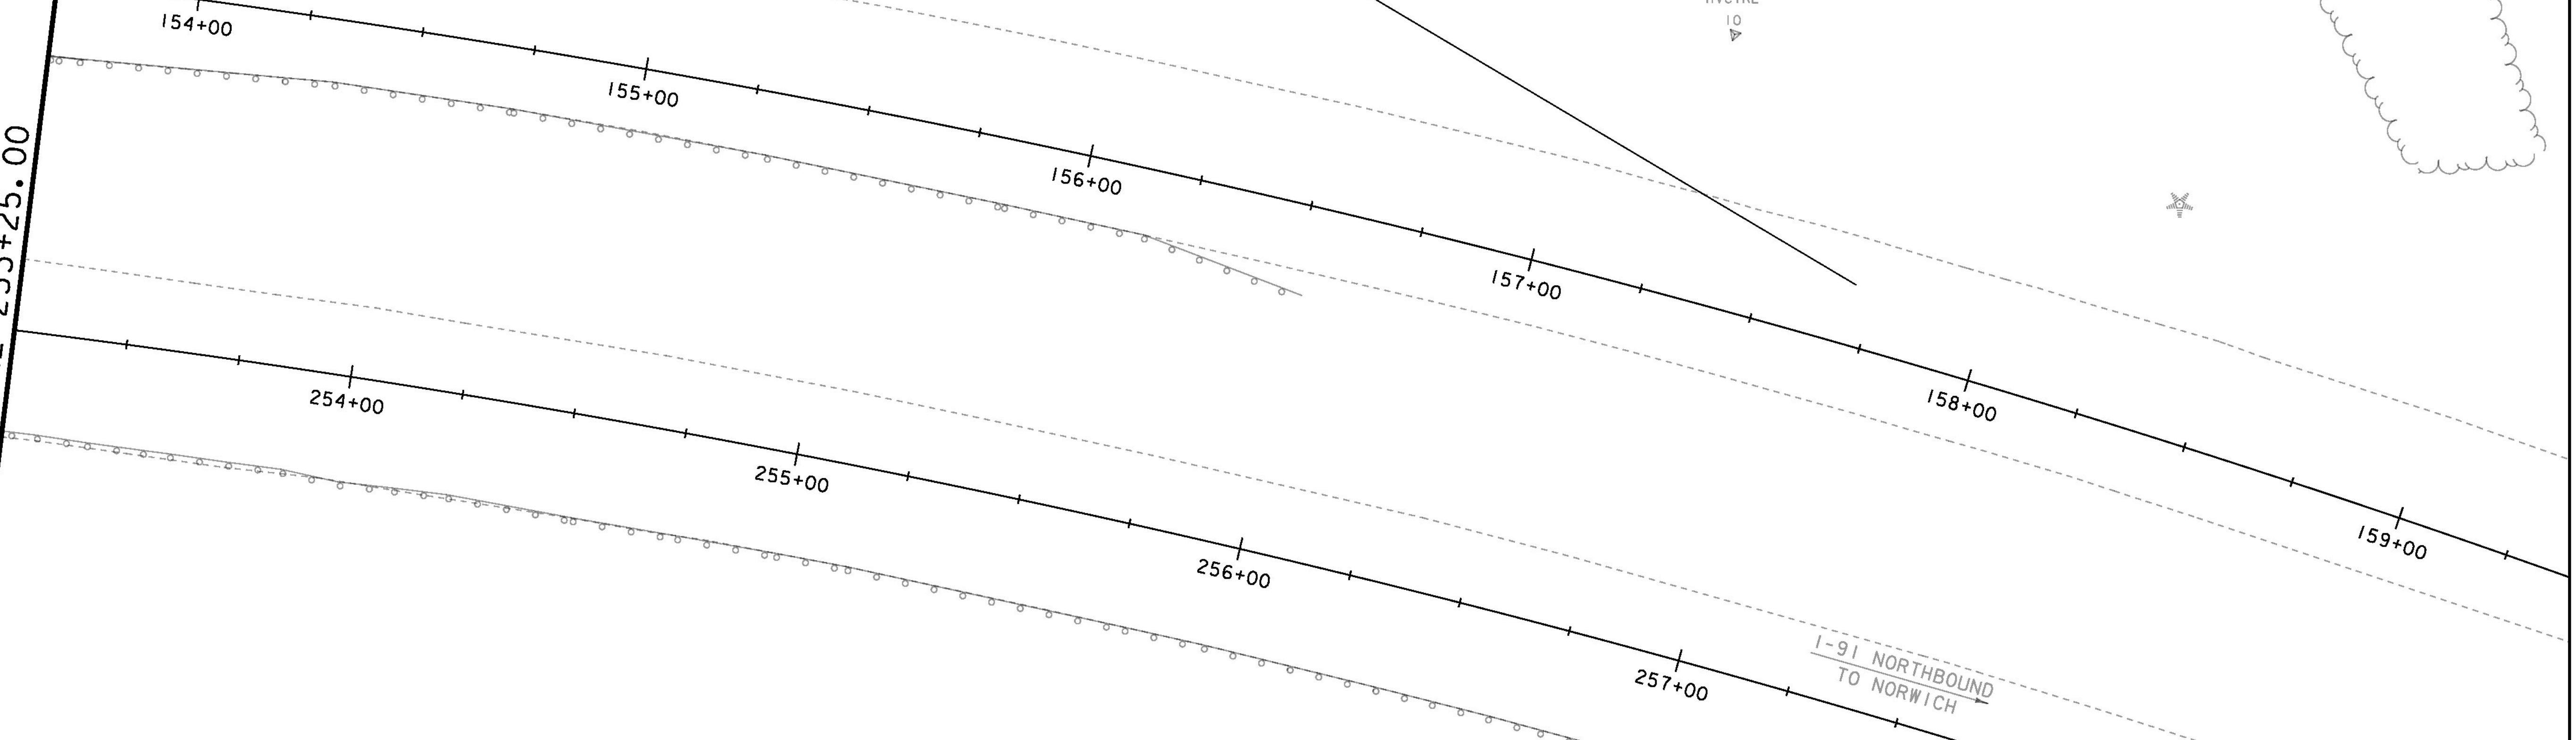

LAYOUT SHEET 3

SCALE 1" = 20' - 0"
20 0 20

I-91 EXIT II
RAMP "D"

PROJECT NAME: HARTFORD	PLOT DATE: 15-DEC-2014
PROJECT NUMBER: IM 091-2(79)	DRAWN BY: K. FRIEDLAND
FILE NAME: I2a132\sl2a132bdr.dgn	CHECKED BY: J. SALVATORI
PROJECT LEADER: K. HIGGINS	SHEET 23 OF 166
DESIGNED BY: W. LAMMER	
LAYOUT SHEET 3	