


REMOVAL AND DISPOSAL OF GUARDRAIL
STA 350+90.77 - 353+74.00 RT

REMOVING AND RESETTING LIGHT POLE
STA 351+78.39 RT

REMOVING AND RESETTING FENCE
STA 351+06.24 - 351+95.34 RT

VERTICAL GRANITE CURB
STA 351+00.00 + 354+75.00 LT

GRANITE SLOPE EDGING
STA 353+54.40 - 355+73.10 RT
STA 356+04.25 - 356+95.35 RT

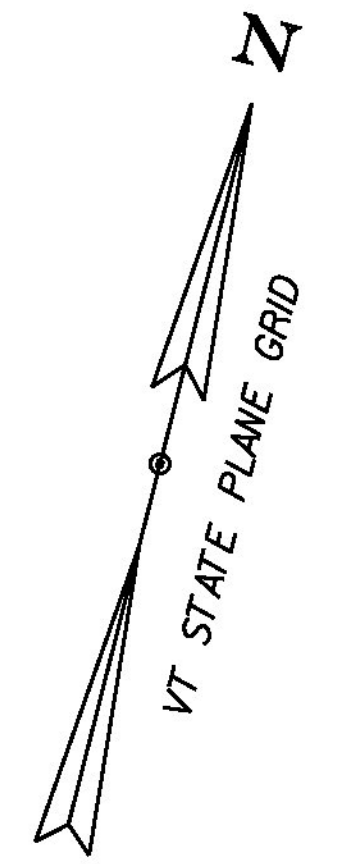

MATCHLINE 350+50.00

MATCHLINE 355+50.00

US5 PC#2
STA 350+97.02

US5 PT#3 / PC#4
STA 355+13.06

US 5 SOUTHBOUND
TO HARTLAND

US 5 NORTHBOUND
TO WILDER

US5 PI#2
STA 352+41.96

US5 PT#2
STA 353+83.19

US5 PC#3
STA 354+27.79

US5 PI#3
STA 354+70.45

US-5 CURVE (2)
DELTA = 22°24'00"
D = 7°49'38"
R = 732.00'
T = 144.94'
L = 286.18'
E = 14.21'

US-5 CURVE (3)
DELTA = 4°59'07"
D = 5°50'47"
R = 980.00'
T = 42.66'
L = 85.27'
E = 0.93'

US 5 LAYOUT SHEET 2

SCALE 1" = 20' - 0"
20 0 20

PROJECT NAME: HARTFORD
PROJECT NUMBER: IM 09I-2(79)

FILE NAME: s12a132bdr_rte5.dgn
PROJECT LEADER: K. HIGGINS
DESIGNED BY: W. LAMMER
US 5 LAYOUT SHEET 2

PLOT DATE: 15-DEC-2014
DRAWN BY: K. FRIEDLAND
CHECKED BY: J. SALVATORI
SHEET 27 OF 166